


STATE OF VERMONT  
AGENCY OF TRANSPORTATION

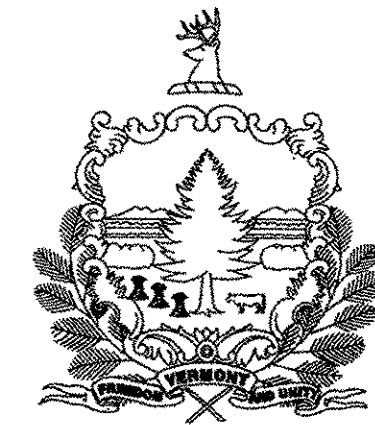

PROPOSED IMPROVEMENT  
BRIDGE PROJECT


TOWN OF BETHEL  
COUNTY OF WINDSOR

ROUTE NO : VT 12      BRIDGE NO : 31

PROJECT LOCATION : BEGINNING AT A POINT ON VT 12 IN BETHEL APPROXIMATELY 0.75 KM FROM  
THE VT 107 JUNCTION AND EXTENDING SOUTHERLY ALONG VT 12 FOR A  
DISTANCE OF 130 METERS.

PROJECT DESCRIPTION : CONSTRUCTION OF A TEMPORARY BRIDGE WITH RELATED ROADWAY APPROACH AND CHANNEL WORK

LENGTH OF STRUCTURE : 60.960 METERS.  
LENGTH OF ROADWAY : 69.040 METERS.  
LENGTH OF PROJECT : 130.000 METERS.

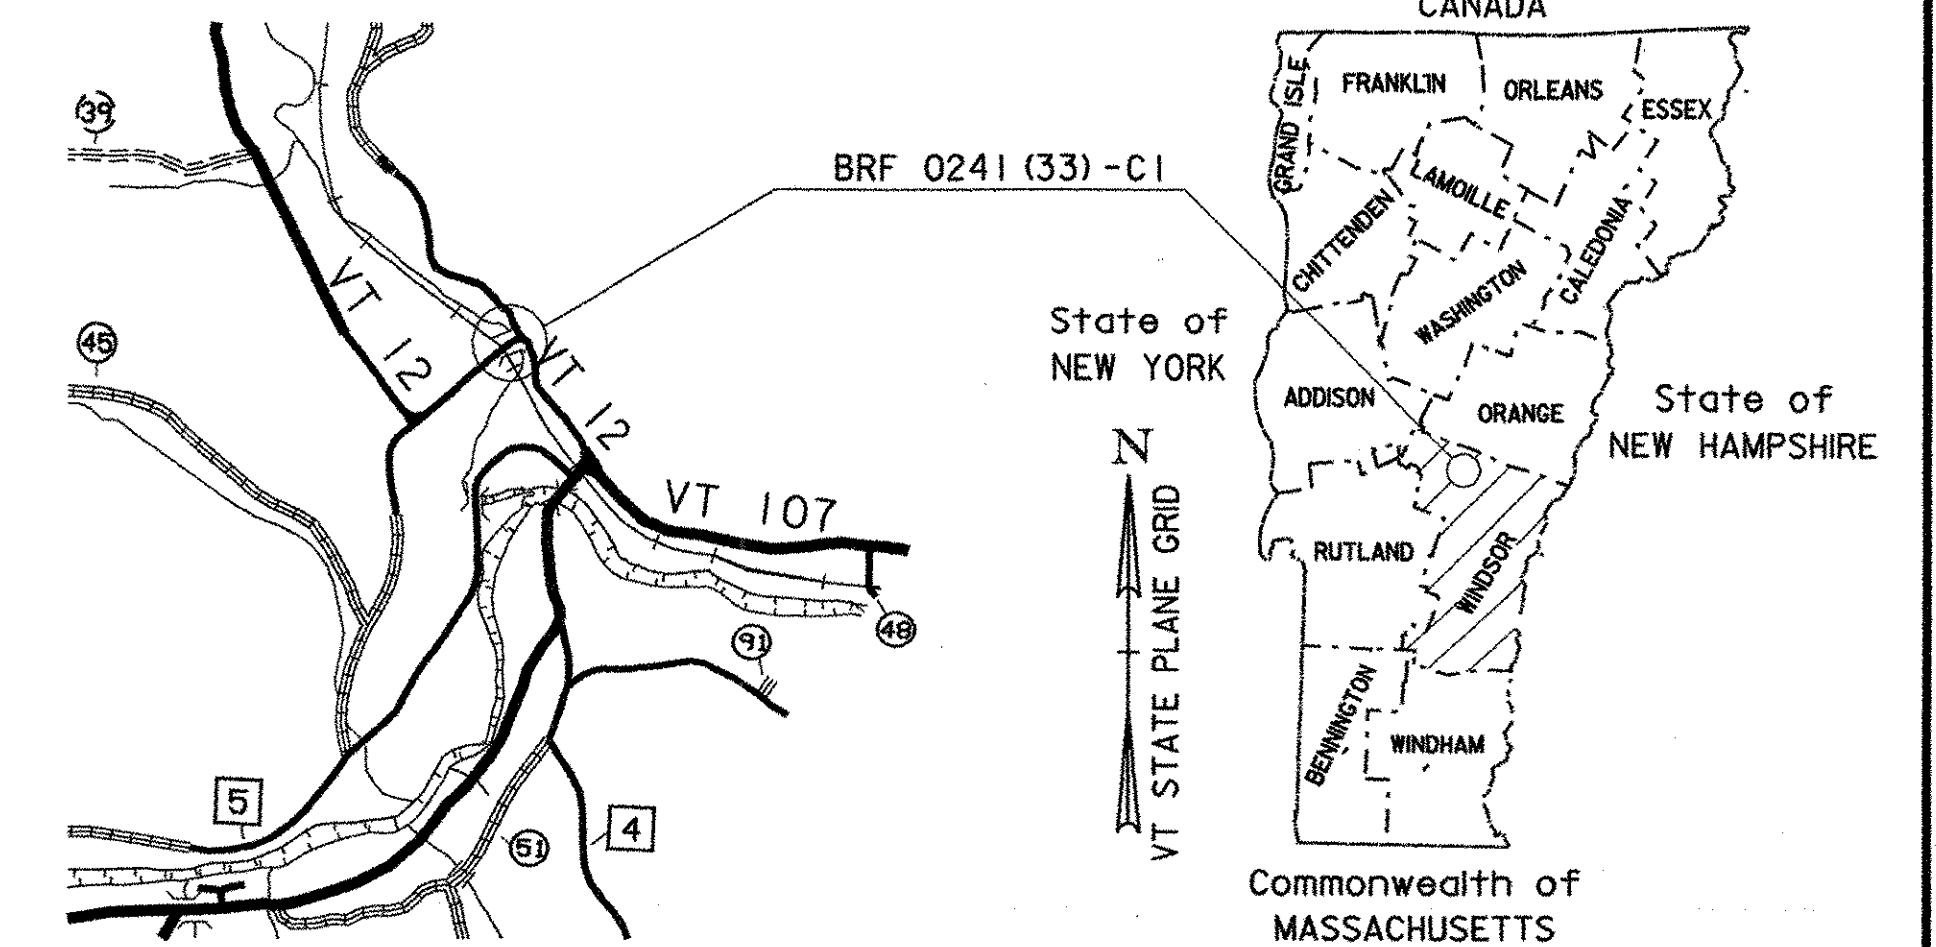


RECORD PLANS

CONTRACTOR: WINTERSSET, INC. - LYNDONVILLE, VT  
RESIDENT ENGINEER: WILL STODDARD  
CONSTRUCTION BEGAN: SEPTEMBER 2, 2003  
CONSTRUCTION COMPLETE: AUGUST 12, 2004  
RECORD PLANS BY: WILL STODDARD & J. GIMORE

I HEREBY CERTIFY THAT ALL THE CONSTRUCTION REQUIRED BY THIS SET  
OF DRAWINGS HAS BEEN ACCOMPLISHED AS INDICATED HEREIN.

BY *Will Stoddard* RESIDENT ENGINEER  
DATE 5-24-07

NOTE: Any further information concerning final quantities, amounts or other details  
relative to this project may be found at Central Files in the electronic archives.

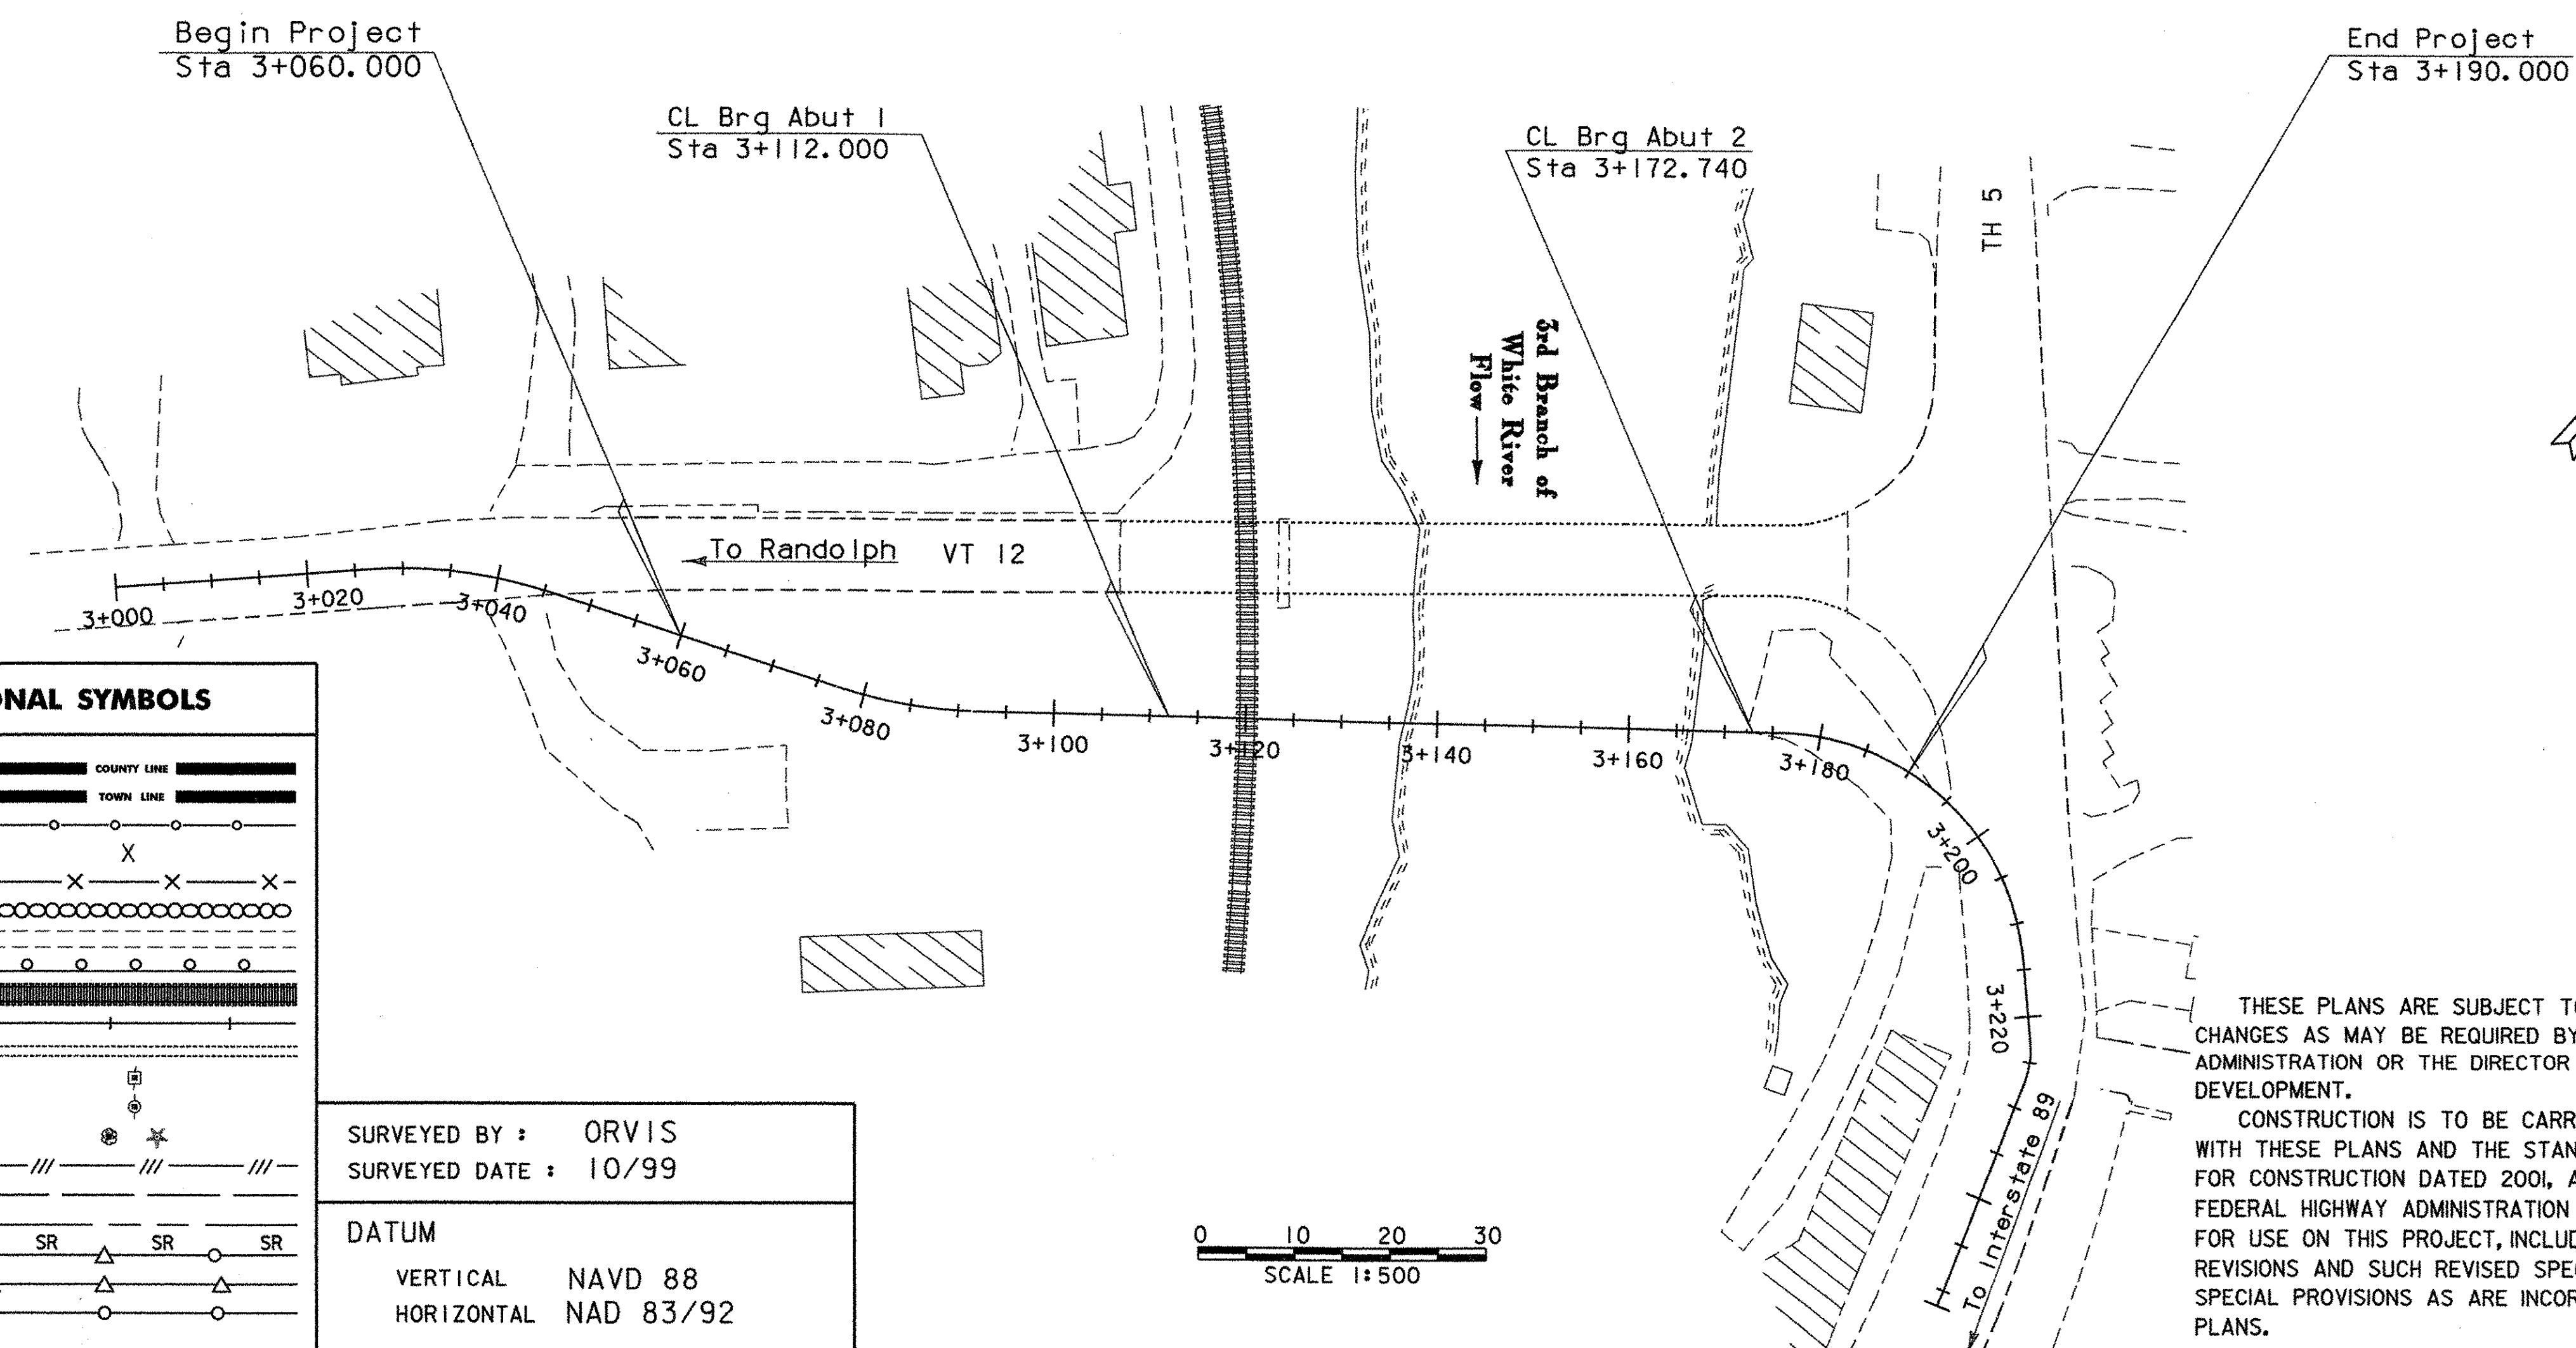

CONVENTIONAL SYMBOLS

|                    |  |
|--------------------|--|
| COUNTY LINE        |  |
| TOWN LINE          |  |
| LIMITS OF ACCESS   |  |
| POINT OF ACCESS    |  |
| FENCE LINE         |  |
| STONE WALL         |  |
| TRAVELED WAY       |  |
| GUARD RAIL         |  |
| RAILROAD           |  |
| SURVEY LINE        |  |
| CULVERT            |  |
| POWER POLE         |  |
| TELEPHONE POLE     |  |
| TREES              |  |
| CONTROL OF ACCESS  |  |
| PROPERTY LINE      |  |
| R.O.W. TAKING LINE |  |
| SLOPE RIGHTS       |  |
| TOP OF CUT         |  |
| TOE OF SLOPE       |  |

SURVEYED BY : ORVIS  
SURVEYED DATE : 10/99

DATUM  
VERTICAL NAVD 88  
HORIZONTAL NAD 83/92

0 10 20 30  
SCALE 1:500

THESE PLANS ARE SUBJECT TO SUCH ENGINEERING  
CHANGES AS MAY BE REQUIRED BY THE FEDERAL HIGHWAY  
ADMINISTRATION OR THE DIRECTOR OF PROJECT  
DEVELOPMENT.

CONSTRUCTION IS TO BE CARRIED ON IN ACCORDANCE  
WITH THESE PLANS AND THE STANDARD SPECIFICATIONS  
FOR CONSTRUCTION DATED 2001, AS APPROVED BY THE  
FEDERAL HIGHWAY ADMINISTRATION ON JANUARY 4, 2001  
FOR USE ON THIS PROJECT, INCLUDING ALL SUBSEQUENT  
REVISIONS AND SUCH REVISED SPECIFICATIONS AND  
SPECIAL PROVISIONS AS ARE INCORPORATED IN THESE  
PLANS.

**Metric**

UNLESS NOTED OTHERWISE  
STATIONS ARE IN KILOMETERS  
ELEVATIONS ARE IN METERS  
DIMENSIONS ARE IN MILLIMETERS

DIRECTOR OF PROJECT DEVELOPMENT  
APPROVED: *C. P. Williams* DATE 7/3/03  
PROJECT MANAGER : C. P. Williams  
PROJECT NAME : Bethel  
PROJECT NUMBER : BRF 0241 (33) -C1  
SHEET 1 OF 47 SHEETS



INDEX OF SHEETS:

- 1. TITLE SHEET
- 2. PRELIMINARY INFORMATION SHEET
- 3. TYPICAL SECTIONS
- 4-5. QUANTITY SHEET
- 6-7. SURVEY TIE INFORMATION
- 8-9. LAYOUT SHEETS
- 10-11. PROFILE SHEETS
- 12-13. TRAFFIC CONTROL SHEETS
- 14-15. TRAFFIC SIGN SUMMARY
- 16. DRAINAGE DETAIL SHEET
- 17-18. BORING LAYOUT
- 19. BORING LOGS
- 20. EROSION CONTROL SHEET
- 21. GUARD RAIL AND CURB LAYOUT
- 22. GENERAL NOTES
- 23. ABUTMENT #1 DETAILS
- 24. EXPANSION JOINT DETAILS
- 25. ABUTMENT #2 DETAILS
- 26. END OF BRIDGE DETAILS
- 27. ABUTMENT RETAINING STRUCTURE DETAILS
- 28. RAIL ATTACHMENT DETAIL
- 29. REINFORCING STEEL SCHEDULE
- 30-31. RIGHT-OF-WAY SHEETS
- 32-38. TEMPORARY DETOUR CROSS SECTIONS
- 39-40. TOWN HIGHWAY 5 CROSS SECTIONS
- 41-42. BETHEL MILLS DRIVE CROSS SECTIONS
- 43-47. CHANNEL CROSS SECTIONS

INDEX OF STANDARDS:

|           |          |
|-----------|----------|
| C-1M      | 01-03-00 |
| C-2BM     | 01-03-00 |
| C-3M      | 01-03-00 |
| D-8M      | 01-03-00 |
| D-9M      | 01-13-97 |
| D-15M     | 01-13-97 |
| E-100M    | 06-13-97 |
| E-101M    | 06-13-97 |
| E-102M    | 06-13-97 |
| E-102AM   | 06-13-97 |
| E-106M    | 06-13-97 |
| E-107M    | 06-13-97 |
| E-107AM   | 06-13-97 |
| E-110M    | 06-13-97 |
| E-121M    | 06-13-97 |
| E-140M    | 06-13-97 |
| E-143M    | 06-13-97 |
| E-170M    | 06-13-97 |
| E-171AM   | 06-13-97 |
| E-171BM   | 06-13-97 |
| E-171CM   | 06-13-97 |
| E-172M    | 06-13-97 |
| E-175M    | 06-13-97 |
| F-2M      | 01-03-00 |
| G-1M      | 06-13-97 |
| G-1DM     | 06-13-97 |
| SB-R6-82M | 07-10-97 |
| T-1M      | 06-13-97 |
| T-2M      | 06-13-97 |

FINAL HYDRAULICS REPORT C-1:

Drainage Area: 352 sq.km

Peak Flow Data:

Q2.33 - 169.9 cms  
Q10 - 283.2 cms  
Q25 - 348.3 cms  
Q50 - 396.4 cms  
Q100 - 509.7 cms

Temporary Bridge:

Structure Type: Mabey Bailey Truss  
Clear Span (Normal To Stream): 59m  
Vertical Clearance Above Streambed: 12.3m  
Waterway Area: 522 sq.m

Water Surface Elevations at:

Q2.33 = 170.9m Velocity = 1.7 m/s  
Q10 = 171.9m Velocity = 2.2 m/s  
Q25 = 172.1m Velocity = 2.6 m/s  
Q50 = 172.4m Velocity = 2.7 m/s  
Q100 = 173.1m Velocity = 3.1 m/s

Average Low Elevation of Superstructure: 179.3m

Vertical Clearance @ Q100 = 6.2m

Roadway Overtopping Elevation: 175.7m

Permit Information:

Average Daily Flow: 8 cms  
Ordinary Low Water: 4 cms 168.3m (Top of Dam controls low flow elevations)  
Ordinary High Water: 73 cms 169.8m

Required Channel Protection: Type II Stone Fill

LOAD RATING TO BE PROVIDED BY MABEY UNIVERSAL BRIDGE SYSTEM

DESIGN CRITERIA:

- DESIGN LIVE LOAD AASHTO MS-18
- DESIGN SPAN 60.96 m
- ALLOWABLE LOAD FOR SPREAD FOOTINGS ON SOIL 190 kpa ON LEDGE 476 kpa
- ALLOWABLE LOAD FOR PILING N/A TYPE ESTIMATED LENGTH
- STRUCTURAL STEEL AASHTO GRADE N/A
- REINFORCING STEEL GRADE 420
- CONCRETE CLASS A  $f_c = 30$  MPa  
CONCRETE CLASS B  $f_c = 25$  MPa  
SILICA FUME CONCRETE  $f_c = 35$  MPa

TRAFFIC MAINTENANCE:

- IS TRAFFIC TO BE MAINTAINED? YES IF YES, ON EXISTING STRUCTURE YES OR ON TEMPORARY BRIDGE N/A
- TEMPORARY BRIDGE REQUIREMENTS: ONE OR TWO WAY N/A TRAFFIC CONTROL SIGNALS REQUIRED N/A  
MINIMUM N/A

ARE SIDEWALKS REQUIRED? N/A IF SO, ON WHAT SIDE? N/A

STATE OF VERMONT  
AGENCY OF TRANSPORTATION

Town Of Bethel Bridge No. 31  
Log Sta.  
Highway No. VT 12 Surv. Sta.

VT 12 Over White River and NECR

Preliminary Information for Contract 1

Designed By K.M.HIGGINS Drawn By K.M.HIGGINS  
Checked By C.P.WILLIAMS Date 12/02 Bridge Design Supervisor C.P.WILLIAMS Date 12/02

PROJECT Bethel PROJECT NO.  
BRF 0241 (33)-C1

I.G.C. Info. /96j250/s96j250pi-cl.dgn s96j250pi-cl.i


Bridge Sheet No. Sheet 2 of 47

TRAFFIC DATA

| YEAR | ADT   | DHV   | % D | % T | ADTT |
|------|-------|-------|-----|-----|------|
| 2004 | 6,300 | 820   | 52  | 3   | 200  |
| 2024 | 8,400 | 1,000 | 52  | 1   | 130  |


20 year ESAL for flexible pavement from 2004 to 2024: 1,350,000  
40 year ESAL for flexible pavement from 2004 to 2044: 3,148,000  
Design speed: 40 km/h



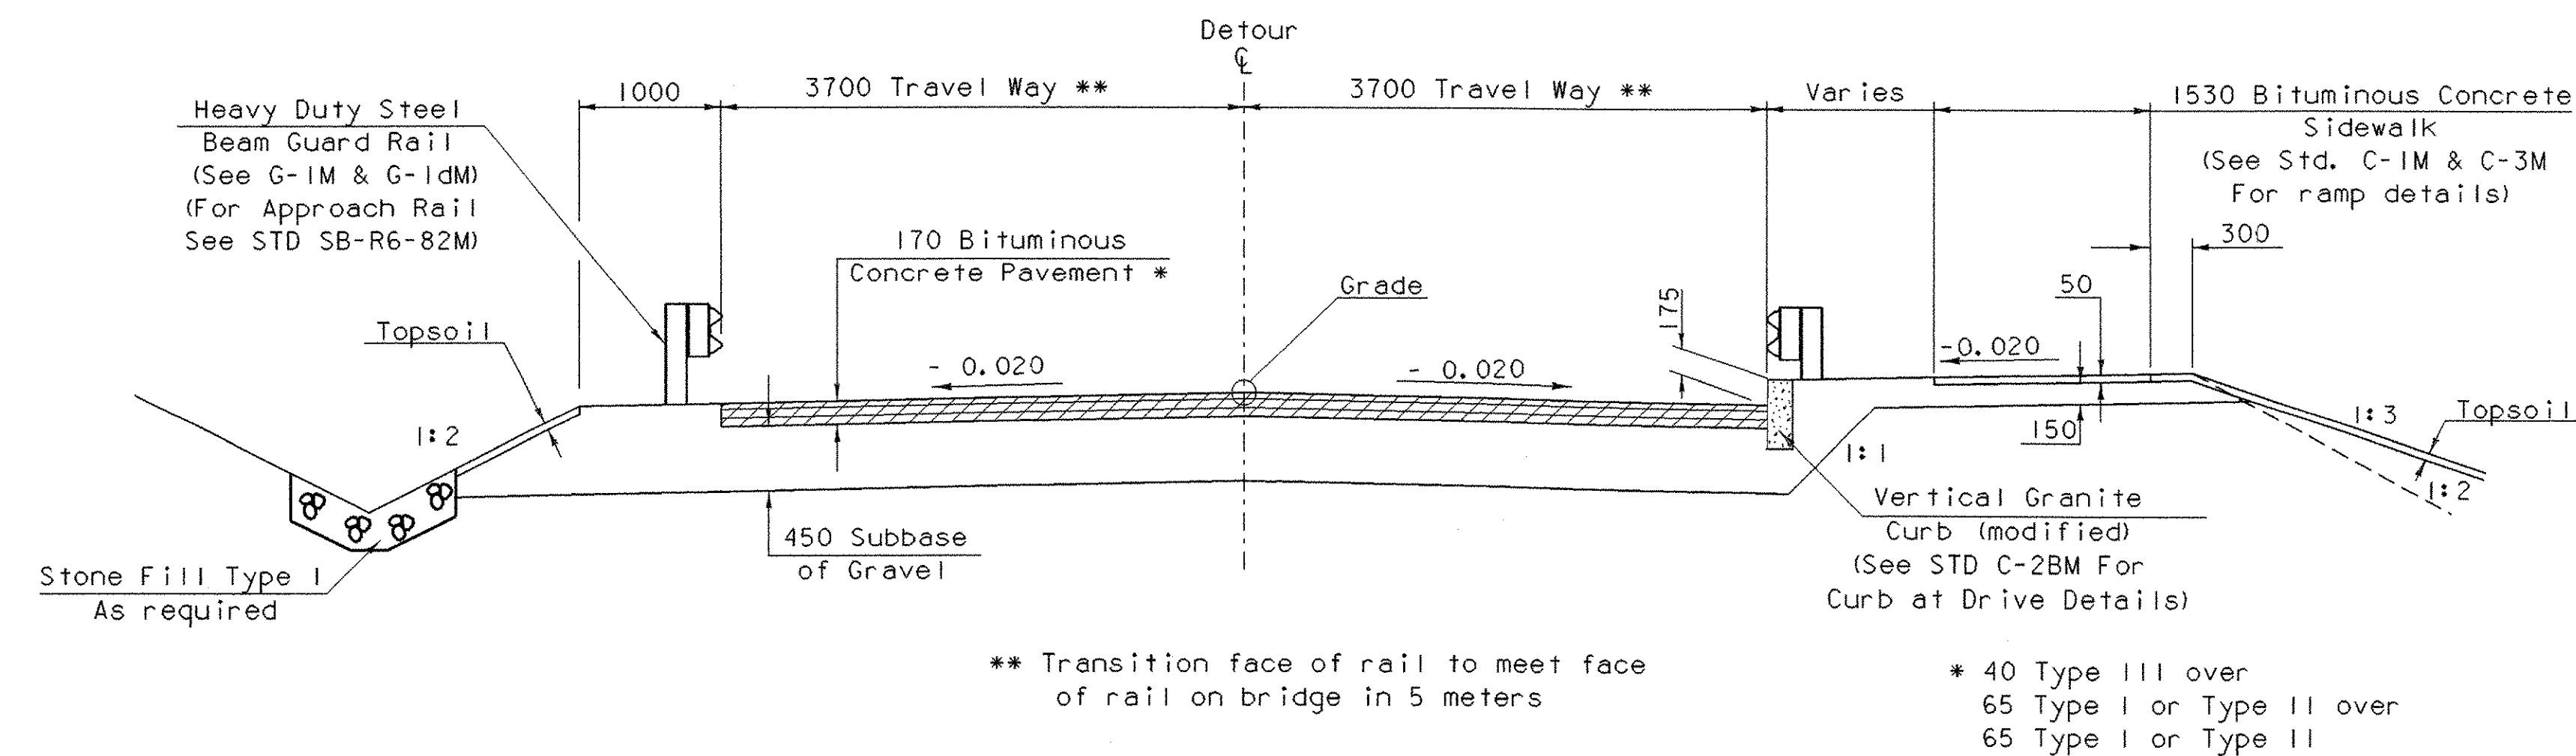

DETOUR ROADWAY TYPICAL SECTION


SCALE = 1 : 40

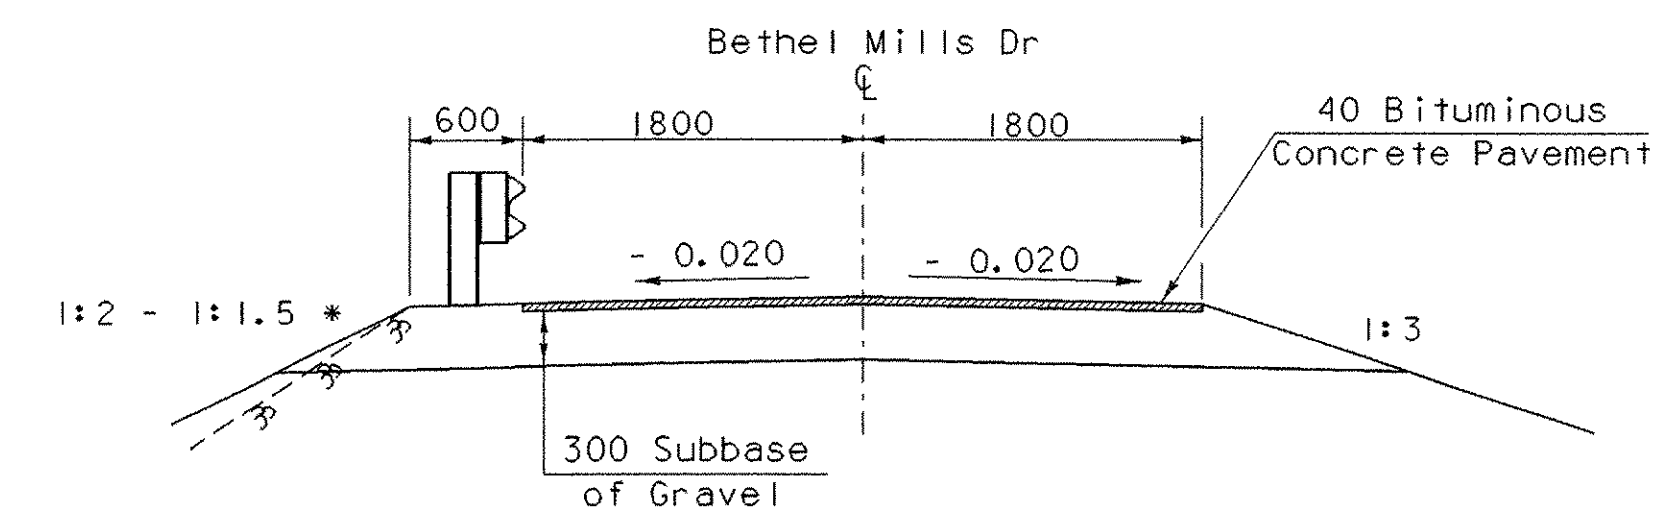

\* On slopes greater than 1:2 use Stone Fill Type I

BETHEL MILLS DRIVE TYPICAL SECTION


SCALE = 1 : 40

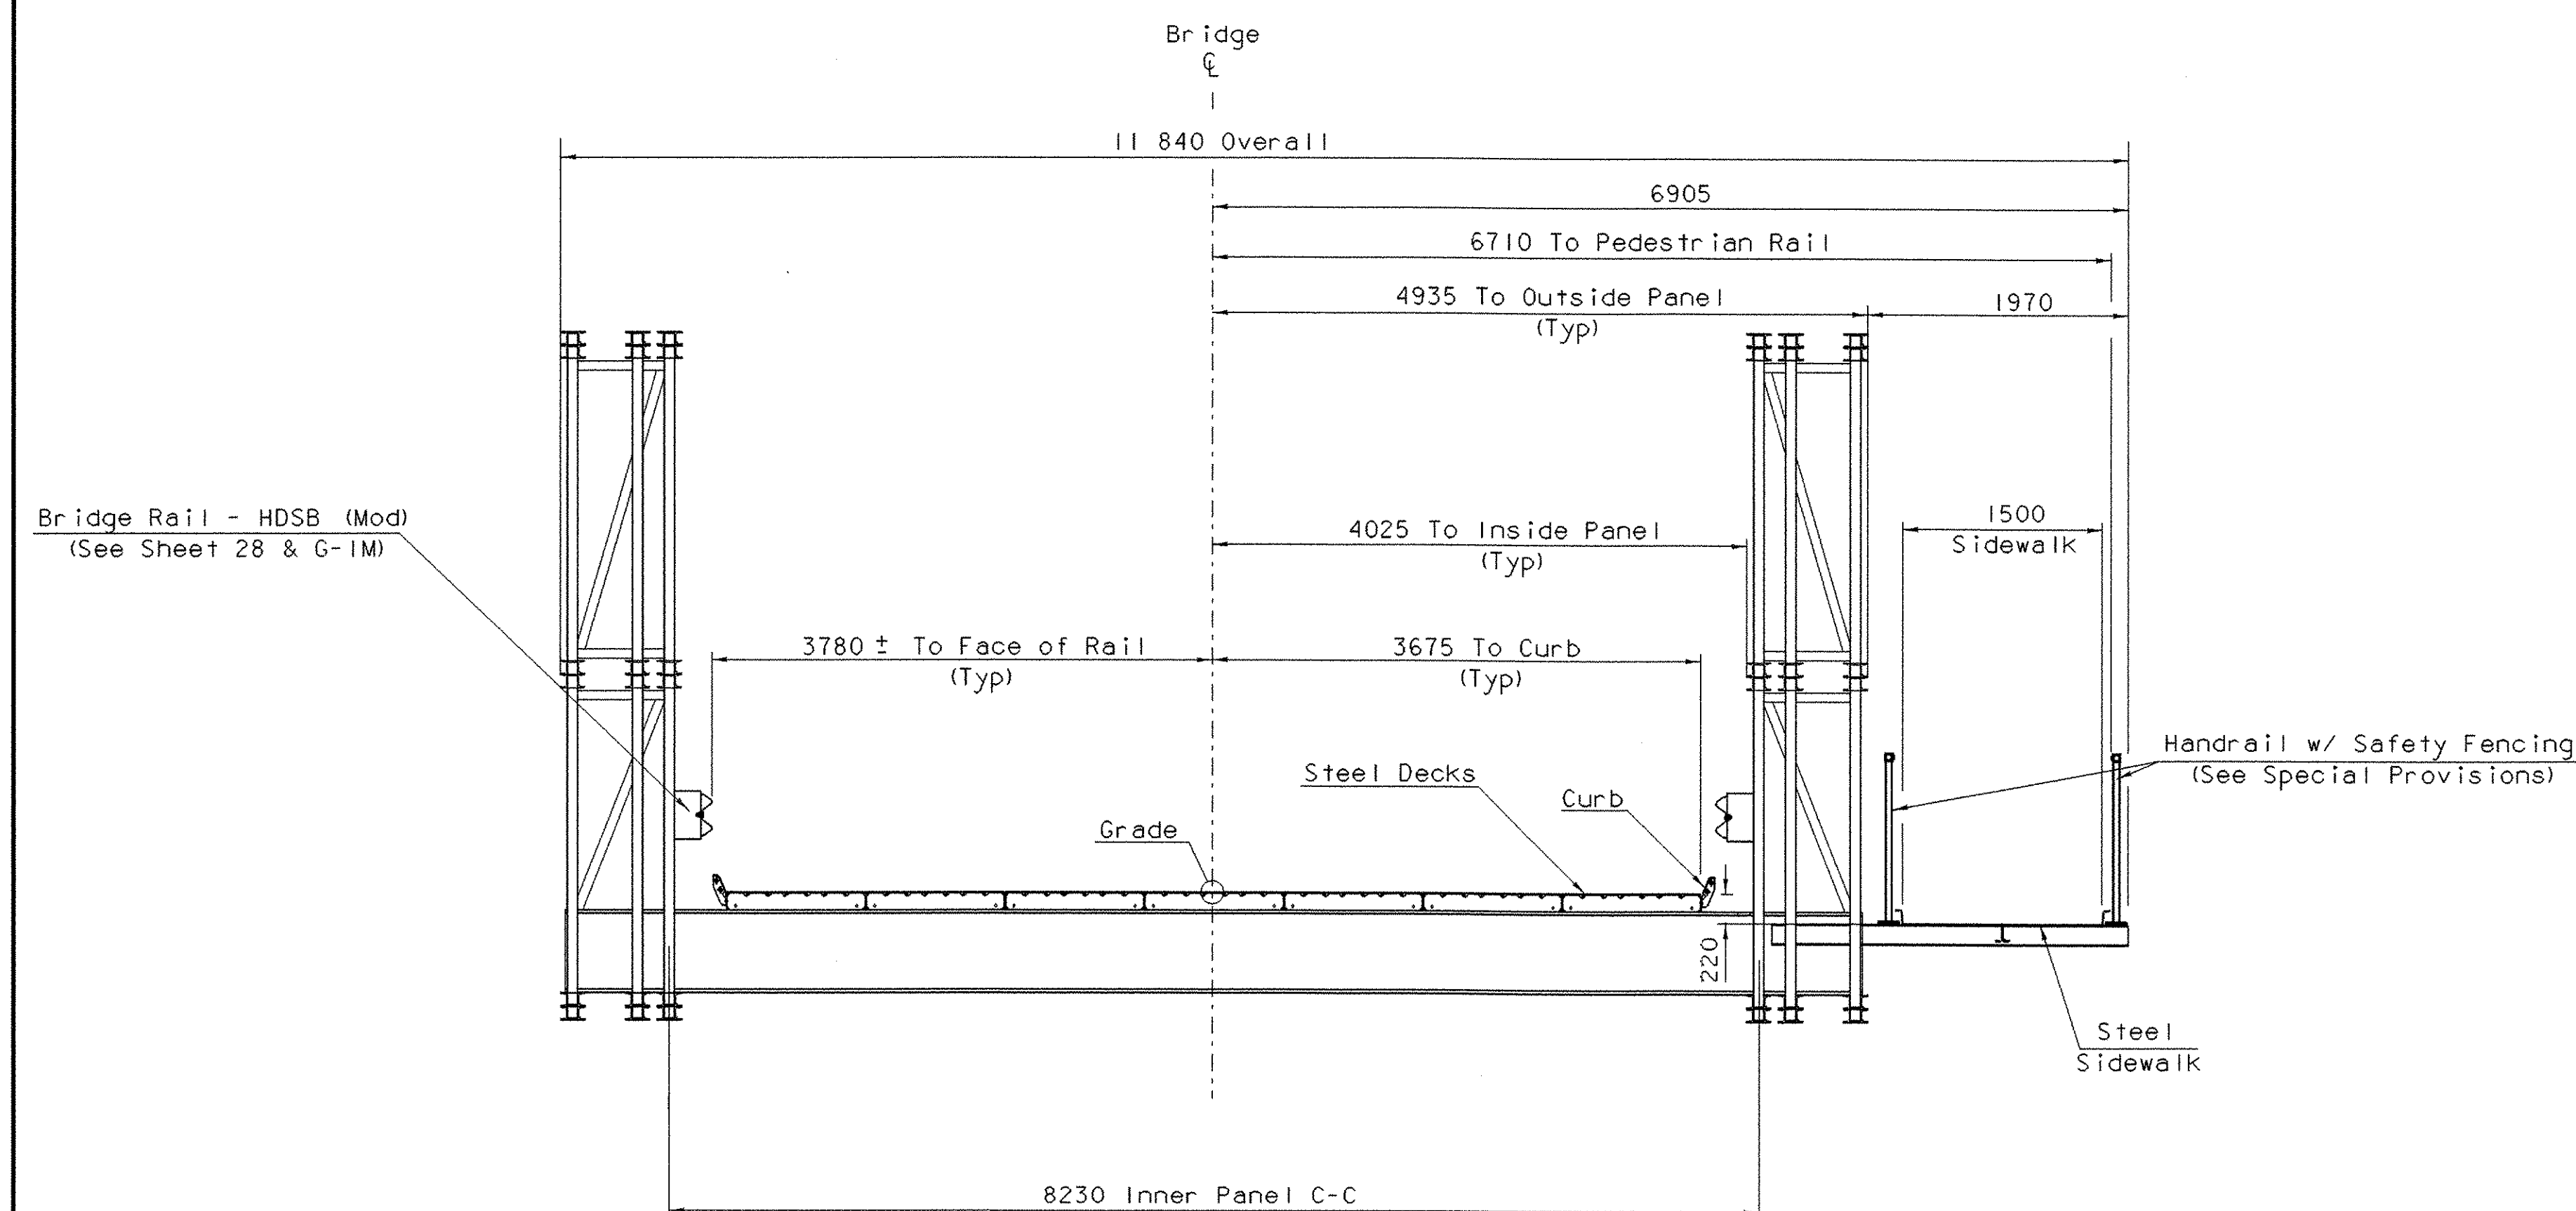

TEMPORARY BRIDGE TYPICAL SECTION

SCALE = 1 : 40

| MATERIAL ITEM            | TOLERANCE             |
|--------------------------|-----------------------|
| PAVEMENT                 | ±5 mm TOTAL THICKNESS |
| AGGREGATE SURFACE COURSE | ±10 mm                |
| BASE COURSE              | ±10 mm                |
| SUBBASE                  | ±30 mm                |
| SAND BORROW              | ±30 mm                |
| GRANULAR BORROW          | ±30 mm                |

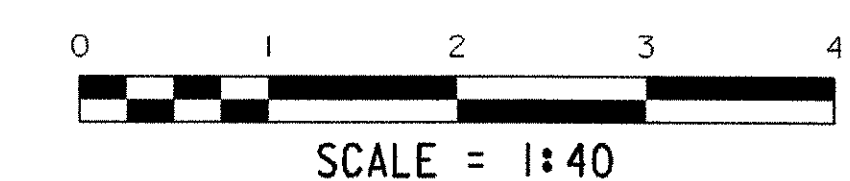

|                                                       |                                    |
|-------------------------------------------------------|------------------------------------|
| PROJECT:<br>BETHEL                                    | PROJECT NO.:<br>BRF 0241 (33) - C1 |
| DESIGN FILE NAME: 96j250/structures/s96j250typ-cl.dgn | PLOT DATE: 09-JUL-2003             |
| IPARM FILE NAME: s96j250typ-cl.i                      | DESIGNED BY: C. P. WILLIAMS        |
| SQUAD LEADER: C. P. WILLIAMS                          | DRAWN BY: K.M.HIGGINS              |
| TYPICAL SECTIONS                                      | CHECKED BY:                        |
|                                                       | SHEET: 3 OF 47                     |



QUANTITY SHEET



| SUMMARY OF ESTIMATED QUANTITIES |  |                  |  |  |          |  |  |          |  |  |                  |  |                | TOTALS |                    |                    | DESCRIPTORS |                  |       | DETAILED SUMMARY OF QUANTITIES |                                                               |                   |                   |      |       |
|---------------------------------|--|------------------|--|--|----------|--|--|----------|--|--|------------------|--|----------------|--------|--------------------|--------------------|-------------|------------------|-------|--------------------------------|---------------------------------------------------------------|-------------------|-------------------|------|-------|
|                                 |  | Super<br>Struct. |  |  | Abut. #1 |  |  | Abut. #2 |  |  | Roadway          |  | E & C<br>Items |        | Erosion<br>Control | BRIDGE<br>QUANTITY | ROUND       | GRAND<br>TOTAL   | FINAL | UNIT                           | ITEMS                                                         | ITEM NUMBER       | QUANTITIES        | UNIT | ITEMS |
|                                 |  |                  |  |  |          |  |  |          |  |  | 1                |  |                |        |                    |                    |             | 1                |       | LS                             | CLEARING AND GRUBBING (Including Individual Trees and Stumps) | 201.10            |                   |      |       |
|                                 |  |                  |  |  |          |  |  |          |  |  | 320              |  |                |        |                    |                    |             | 320              |       | CM                             | COMMON EXCAVATION                                             | 203.15            |                   |      |       |
|                                 |  |                  |  |  |          |  |  |          |  |  | 320              |  |                |        |                    |                    |             | 320              |       | CM                             | EARTH BORROW                                                  | 203.30            |                   |      |       |
|                                 |  |                  |  |  |          |  |  |          |  |  |                  |  |                |        | 10                 |                    |             | 10               |       | CM                             | TRENCH EXCAVATION OF EARTH                                    | 204.20            |                   |      |       |
|                                 |  |                  |  |  |          |  |  | 25       |  |  |                  |  |                |        |                    |                    |             | 25               |       | CM                             | STRUCTURE EXCAVATION                                          | 204.25            |                   |      |       |
|                                 |  |                  |  |  | 980      |  |  | 320      |  |  | 10               |  |                |        |                    |                    |             | 890              |       | CM                             | GRANULAR BACKFILL FOR STRUCTURES                              | 204.90            |                   |      |       |
|                                 |  |                  |  |  |          |  |  |          |  |  | 930              |  |                |        |                    |                    |             | 930              |       | SM                             | COLD PLANING-BIT.PAVEMENT                                     | 210.10            |                   |      |       |
|                                 |  |                  |  |  |          |  |  |          |  |  | 500              |  |                |        | 10                 |                    |             | 510              |       | CM                             | SUBBASE OF GRAVEL                                             | 301.15            |                   |      |       |
|                                 |  |                  |  |  |          |  |  |          |  |  | <del>150</del>   |  |                |        |                    |                    |             | <del>150</del>   |       | <del>KG</del>                  | <del>EMULSIFIED ASPHALT</del>                                 | <del>404.65</del> |                   |      |       |
|                                 |  |                  |  |  |          |  |  |          |  |  | 497              |  |                |        |                    |                    |             | 497              |       | T                              | BITUMINOUS CONCRETE PAVEMENT (PG 58-34)                       | 408.25            |                   |      |       |
|                                 |  |                  |  |  | 23       |  |  | 23       |  |  | 5                |  |                |        |                    |                    |             | 51               |       | CM                             | CONCRETE, CLASS B                                             | 501.25            |                   |      |       |
|                                 |  |                  |  |  | 1910     |  |  | 1910     |  |  | 190              |  |                |        |                    |                    |             | 4010             |       | KG                             | REINFORCING STEEL                                             | 507.15            |                   |      |       |
|                                 |  | 9                |  |  |          |  |  |          |  |  |                  |  |                |        |                    |                    |             | 9                |       | M                              | BRIDGE EXPANSION JOINT (MOD)                                  | 516.10            |                   |      |       |
|                                 |  | 130              |  |  |          |  |  |          |  |  |                  |  |                |        |                    |                    |             | 130              |       | M                              | BRIDGE RAILING - HD STEEL BEAM/CURB MOUNTED (MOD)             | 525.40            |                   |      |       |
|                                 |  | 1                |  |  |          |  |  |          |  |  |                  |  |                |        |                    |                    |             | 1                |       | LS                             | MAINTENANCE OF TRAFFIC FOR BRIDGE PROJECTS                    | 527.10            |                   |      |       |
|                                 |  | 1                |  |  |          |  |  |          |  |  |                  |  |                |        |                    |                    |             | 1                |       | LS                             | TWO-WAY TEMPORARY BRIDGE (MOD-1)                              | 528.11            |                   |      |       |
|                                 |  | 1                |  |  |          |  |  |          |  |  |                  |  |                |        |                    |                    |             | 1                |       | LS                             | TWO-WAY TEMPORARY BRIDGE (MOD-2)                              | 528.11            |                   |      |       |
|                                 |  |                  |  |  |          |  |  |          |  |  | 20               |  |                |        |                    |                    |             | 20               |       | M                              | **BEGIN PIPE OPTION**                                         |                   |                   |      |       |
|                                 |  |                  |  |  |          |  |  |          |  |  | 20               |  |                |        |                    |                    |             | 20               |       | M                              | 450 mm CSP 1.63 mm (68 mm X 12 mm)                            | 601.0015          |                   |      |       |
|                                 |  |                  |  |  |          |  |  |          |  |  | 20               |  |                |        |                    |                    |             | 20               |       | M                              | 450 mm CAAP 1.52 mm (68 mm X 12 mm)                           | 601.0215          |                   |      |       |
|                                 |  |                  |  |  |          |  |  |          |  |  | 20               |  |                |        |                    |                    |             | 20               |       | M                              | 450 mm CPEP                                                   | 601.0915          |                   |      |       |
|                                 |  |                  |  |  |          |  |  |          |  |  | 2                |  |                |        |                    |                    |             | 2                |       | EACH                           | 450 mm CSP ELBOW 1.63 mm (68 mm X 12 mm)                      | 601.5015          |                   |      |       |
|                                 |  |                  |  |  |          |  |  |          |  |  | 2                |  |                |        |                    |                    |             | 2                |       | EACH                           | 450 mm CAAP ELBOW 1.52 mm (68 mm X 12 mm)                     | 601.5215          |                   |      |       |
|                                 |  |                  |  |  |          |  |  |          |  |  | 2                |  |                |        |                    |                    |             | 2                |       | EACH                           | 450 mm CPEP ELBOW                                             | 601.5814          |                   |      |       |
|                                 |  **END PIPE OPTION**                                           |                   |                   |      |       |
|                                 |  |                  |  |  |          |  |  |          |  |  | 10               |  |                |        |                    |                    |             | 10               |       | M                              | CLEANING CULVERT PIPE IN PLACE (0-600 mm INCLUSIVE)           | 601.965           |                   |      |       |
|                                 |  |                  |  |  |          |  |  |          |  |  | 1                |  |                |        |                    |                    |             | 1                |       | EACH                           | CHANGING ELEV. OF DROP INLETS, CATCH BASINS OR MANHOLES       | 604.40            |                   |      |       |
|                                 |  |                  |  |  |          |  |  |          |  |  | 2                |  |                |        |                    |                    |             | 2                |       | EACH                           | CAST IRON GRATE WITH FRAME TYPE E                             | 604.48            | <del>604.62</del> |      |       |
|                                 |  |                  |  |  |          |  |  |          |  |  | 2                |  |                |        |                    |                    |             | 2                |       | EACH                           | CAPPING EXISTING DROP INLETS                                  | 604.60            |                   |      |       |
|                                 |  |                  |  |  |          |  |  |          |  |  |                  |  |                |        | 5                  |                    |             | 5                |       | HR                             | ALL PURPOSE EXCAVATOR RENTAL, TYPE I                          | 608.25            |                   |      |       |
|                                 |  |                  |  |  |          |  |  |          |  |  | 5                |  |                |        |                    |                    |             | 5                |       | T                              | DUST AND ICE CONTROL WITH CALCIUM CHLORIDE                    | 609.15            |                   |      |       |
|                                 |  |                  |  |  |          |  |  |          |  |  | 10               |  |                |        | 10                 |                    |             | 20               |       | CM                             | STONE FILL, TYPE I                                            | 613.10            |                   |      |       |
|                                 |  |                  |  |  |          |  |  |          |  |  | 100              |  |                |        |                    |                    |             | 100              |       | M                              | VERTICAL GRANITE CURB (MOD)                                   | 618.21            |                   |      |       |
|                                 |  |                  |  |  |          |  |  |          |  |  | 21               |  |                |        |                    |                    |             | 21               |       | T                              | BITUMINOUS CONCRETE SIDEWALK                                  | 618.15            |                   |      |       |
|                                 |  |                  |  |  |          |  |  |          |  |  | 31               |  |                |        |                    |                    |             | 31               |       | M                              | CHAIN-LINK FENCE, 1.2 M                                       | 620.11            |                   |      |       |
|                                 |  |                  |  |  |          |  |  |          |  |  | 14               |  |                |        |                    |                    |             | 14               |       | M                              | CHAIN-LINK FENCE, 1.8 M                                       | 620.12            |                   |      |       |
|                                 |  |                  |  |  |          |  |  |          |  |  | 7                |  |                |        |                    |                    |             | 7                |       | M                              | GATE FOR CHAIN-LINK FENCE, 1.8 M                              | 620.16            |                   |      |       |
|                                 |  |                  |  |  |          |  |  |          |  |  | 25               |  |                |        |                    |                    |             | 25               |       | M                              | REMOVAL OF EXISTING FENCE                                     | 620.55            |                   |      |       |
|                                 |  |                  |  |  |          |  |  |          |  |  | 150              |  |                |        |                    |                    |             | 150              |       | M                              | HEAVY DUTY STEEL BEAM GUARD RAIL                              | 621.21            |                   |      |       |
|                                 |  |                  |  |  |          |  |  |          |  |  | <del>3 - 6</del> |  |                |        |                    |                    |             | <del>3 - 6</del> |       | EACH                           | ANCHOR FOR STEEL BEAM RAIL                                    | 621.80            |                   |      |       |
|                                 |  |                  |  |  |          |  |  |          |  |  | 20               |  |                |        |                    |                    |             | 20               |       | M                              | TEMPORARY TRAFFIC BARRIER                                     | 621.90            |                   |      |       |
|                                 |  |                  |  |  |          |  |  |          |  |  | 200              |  |                |        |                    |                    |             | 200              |       | HR                             | FLAGGERS                                                      | 630.15            |                   |      |       |
|                                 |  |                  |  |  |          |  |  |          |  |  | 1                |  |                |        |                    |                    |             | 1                |       | LS                             | FIELD OFFICE-ENGINEERS                                        | 631.10            |                   |      |       |
|                                 |  |                  |  |  |          |  |  |          |  |  |                  |  |                |        |                    |                    |             | 1                |       | LS                             | TESTING EQUIPMENT - CONCRETE                                  | 631.16            |                   |      |       |
|                                 |  |                  |  |  |          |  |  |          |  |  | <del>1</del>     |  |                |        |                    |                    |             | <del>1</del>     |       | <del>LS</del>                  | <del>TESTING EQUIPMENT - BITUMINOUS</del>                     | <del>631.17</del> |                   |      |       |
|                                 |  |                  |  |  |          |  |  |          |  |  | 1                |  |                |        |                    |                    |             | 1                |       | LU                             | FIELD OFFICE - TELEPHONE (NABI)                               | 631.25            |                   |      |       |



# QUANTITY SHEET



| SUMMARY OF ESTIMATED QUANTITIES |  |                  |  |  |          |  |  |          |  |  |         |  |             |  |                    | TOTALS             |       |                | DESCRIPTIONS |      |       | DETAILED SUMMARY OF QUANTITIES                       |         |  |             |            |      |       |  |  |  |  |  |  |
|---------------------------------|--|------------------|--|--|----------|--|--|----------|--|--|---------|--|-------------|--|--------------------|--------------------|-------|----------------|--------------|------|-------|------------------------------------------------------|---------|--|-------------|------------|------|-------|--|--|--|--|--|--|
|                                 |  | Super<br>Struct. |  |  | Abut. #1 |  |  | Abut. #2 |  |  | Roadway |  | E & C Items |  | Erosion<br>Control | BRIDGE<br>QUANTITY | ROUND | GRAND<br>TOTAL | FINAL        | UNIT | ITEMS |                                                      |         |  | ITEM NUMBER | QUANTITIES | UNIT | ITEMS |  |  |  |  |  |  |
|                                 |  |                  |  |  |          |  |  |          |  |  | 1       |  |             |  |                    |                    |       | 1              |              |      | LS    | MOBILIZATION                                         | 635.10  |  |             |            |      |       |  |  |  |  |  |  |
|                                 |  |                  |  |  |          |  |  |          |  |  | 420     |  |             |  |                    |                    |       | 420            |              |      | M     | 100 mm WHITE LINE                                    | 646.20  |  |             |            |      |       |  |  |  |  |  |  |
|                                 |  |                  |  |  |          |  |  |          |  |  | 460     |  |             |  |                    |                    |       | 460            |              |      | M     | 100 mm YELLOW LINE                                   | 646.21  |  |             |            |      |       |  |  |  |  |  |  |
|                                 |  |                  |  |  |          |  |  |          |  |  | 13      |  |             |  |                    |                    |       | 13             |              |      | M     | 600 mm STOP BAR                                      | 646.26  |  |             |            |      |       |  |  |  |  |  |  |
|                                 |  |                  |  |  |          |  |  |          |  |  | 4       |  |             |  |                    |                    |       | 4              |              |      | EACH  | LETTER OR SYMBOL                                     | 646.30  |  |             |            |      |       |  |  |  |  |  |  |
|                                 |  |                  |  |  |          |  |  |          |  |  | 8       |  |             |  |                    |                    |       | 8              |              |      | M     | CROSSWALK MARKING W/DIAGONAL LINES                   | 646.31  |  |             |            |      |       |  |  |  |  |  |  |
|                                 |  |                  |  |  |          |  |  |          |  |  | 10      |  |             |  |                    |                    |       | 10             |              |      | SM    | REMOVAL OF EXISTING PAVEMENT MARKINGS                | 646.85  |  |             |            |      |       |  |  |  |  |  |  |
|                                 |  |                  |  |  |          |  |  |          |  |  |         |  |             |  | 200                |                    |       | 200            |              |      | SM    | GEOTEXTILE FOR SILT FENCE                            | 649.51  |  |             |            |      |       |  |  |  |  |  |  |
|                                 |  |                  |  |  |          |  |  |          |  |  |         |  |             |  | 40                 |                    |       | 40             |              |      | SM    | GEOTEXTILE FOR FILTER CURTAIN                        | 649.61  |  |             |            |      |       |  |  |  |  |  |  |
|                                 |  |                  |  |  |          |  |  |          |  |  |         |  |             |  | 40                 |                    |       | 40             |              |      | KG    | SEED                                                 | 651.15  |  |             |            |      |       |  |  |  |  |  |  |
|                                 |  |                  |  |  |          |  |  |          |  |  |         |  |             |  | 20                 |                    |       | 20             |              |      | KG    | SEED-WINTER RYE                                      | 651.17  |  |             |            |      |       |  |  |  |  |  |  |
|                                 |  |                  |  |  |          |  |  |          |  |  |         |  |             |  | 1000               |                    |       | 1000           |              |      | KG    | FERTILIZER                                           | 651.18  |  |             |            |      |       |  |  |  |  |  |  |
|                                 |  |                  |  |  |          |  |  |          |  |  |         |  |             |  | 1                  |                    |       | 1              |              |      | T     | AGRICULTURAL LIMESTONE                               | 651.20  |  |             |            |      |       |  |  |  |  |  |  |
|                                 |  |                  |  |  |          |  |  |          |  |  |         |  |             |  | 1                  |                    |       | 1              |              |      | T     | HAY MULCH                                            | 651.25  |  |             |            |      |       |  |  |  |  |  |  |
|                                 |  |                  |  |  |          |  |  |          |  |  |         |  |             |  | 50                 |                    |       | 50             |              |      | EACH  | HAY BALES FOR EROSION CONTROL                        | 651.26  |  |             |            |      |       |  |  |  |  |  |  |
|                                 |  |                  |  |  |          |  |  |          |  |  |         |  |             |  | 20                 |                    |       | 20             |              |      | CM    | TOPSOIL                                              | 651.35  |  |             |            |      |       |  |  |  |  |  |  |
|                                 |  |                  |  |  |          |  |  |          |  |  |         |  |             |  | 1                  |                    |       | 1              |              |      | LS    | EROSION & SEDIMENT CONTROL PLAN                      | 652.10  |  |             |            |      |       |  |  |  |  |  |  |
|                                 |  |                  |  |  |          |  |  |          |  |  |         |  |             |  | 50                 |                    |       | 50             |              |      | HR    | MONITORING EROSION & SEDIMENT CONTROL PLAN           | 652.20  |  |             |            |      |       |  |  |  |  |  |  |
|                                 |  |                  |  |  |          |  |  |          |  |  |         |  |             |  | 1                  |                    |       | 1              |              |      | LU    | FIELD MAINTENANCE OF EROSION & SEDIMENT CONTROL PLAN | 652.30  |  |             |            |      |       |  |  |  |  |  |  |
|                                 |  |                  |  |  |          |  |  |          |  |  |         |  |             |  | 40                 |                    |       | 40             |              |      | SM    | EROSION MATTING                                      | 654.10  |  |             |            |      |       |  |  |  |  |  |  |
|                                 |  |                  |  |  |          |  |  |          |  |  | 4       |  |             |  |                    |                    |       | 4              |              |      | SM    | TRAFFIC SIGNS, TYPE A                                | 675.20  |  |             |            |      |       |  |  |  |  |  |  |
|                                 |  |                  |  |  |          |  |  |          |  |  | 48      |  |             |  |                    |                    |       | 48             |              |      | M     | FLANGED CHANNEL SIGN POST                            | 675.301 |  |             |            |      |       |  |  |  |  |  |  |
|                                 |  |                  |  |  |          |  |  |          |  |  | 5       |  |             |  |                    |                    |       | 5              |              |      | EACH  | REMOVING SIGNS                                       | 675.50  |  |             |            |      |       |  |  |  |  |  |  |
|                                 |  |                  |  |  |          |  |  |          |  |  | 5       |  |             |  |                    |                    |       | 5              |              |      | EACH  | ERECTING SALVAGED SIGNS                              | 675.60  |  |             |            |      |       |  |  |  |  |  |  |
|                                 |  |                  |  |  |          |  |  |          |  |  | 1       |  |             |  |                    |                    |       | 1              |              |      | EACH  | REMOVE & RESETTING LIGHT POLE                        | 679.25  |  |             |            |      |       |  |  |  |  |  |  |
| |


## GPS CONTROL POINTS

## HVCTRL #1

STANDARD DISC STAMPED

CLEVELAND

N = 145575.6400




E = 488269.5070

ELEV. = 176.700

DESCRIBED BY VERMONT AGENCY OF TRANSPORTATION 1996 (DJM)  
GENERAL LOCATION BETHEL, 1.4 MILES (2.3 KM) SW OF BETHEL VILLAGE. TO REACH FROM THE JUNCTION OF VT 107 AND VT 12 SOUTH OF BETHEL, PROCEED EASTERLY ALONG VT 107 AND VT 12 FOR APPROX 0.3 M (1.0 FT) TO THE MARK ON THE LEFT. THE MARK IS DIRECTLY OPPOSITE CLEVELAND BROOK ROAD, 25.5 FT (7.8 M) NORTH FROM THE CENTERLINE OF VT 107 AND VT 12. OWNERSHIP STATE OF VERMONT STATION MARK IS A STATE OF VERMONT SURVEY MARK SET IN THE TOP OF A 12 INCH DIAMETER CONCRETE POST SET FLUSH WITH GROUND. IT IS 25.5 FT (7.8 M) NORTH OF CENTERLINE VT 107 AND VT 12, 4.5 FT (1.4 M) NORTH OF 3 CABLE GUARD RAIL, 45 FT (13.7 M) SOUTHEAST FROM COMBINATION POLE 4/49/57, 15 FT (4.6 M) SOUTH OF THE NORTH END OF A 4 FT (1.2 M) X 5 FT (1.5 M) CONCRETE BOX, 72 FT (21.9 M) NORTH OF THE SOUTH END OF A 4 FT (1.2 M) X 5 FT (1.5 M) CONCRETE BOX.






- \* HORIZONTAL CONTROL IS FROM: BETHEL BR# 022-1(14) BY: R.GILMAN FROM THAT FILE POINTS 8 AND 9 WERE USED TO CREATE POINT 18.  
\* DESCRIPTION PROVIDED BY VERMONT AGENCY OF TRANSPORTATION GEODETIC SURVEY UNIT

## TRAVERSE TIES

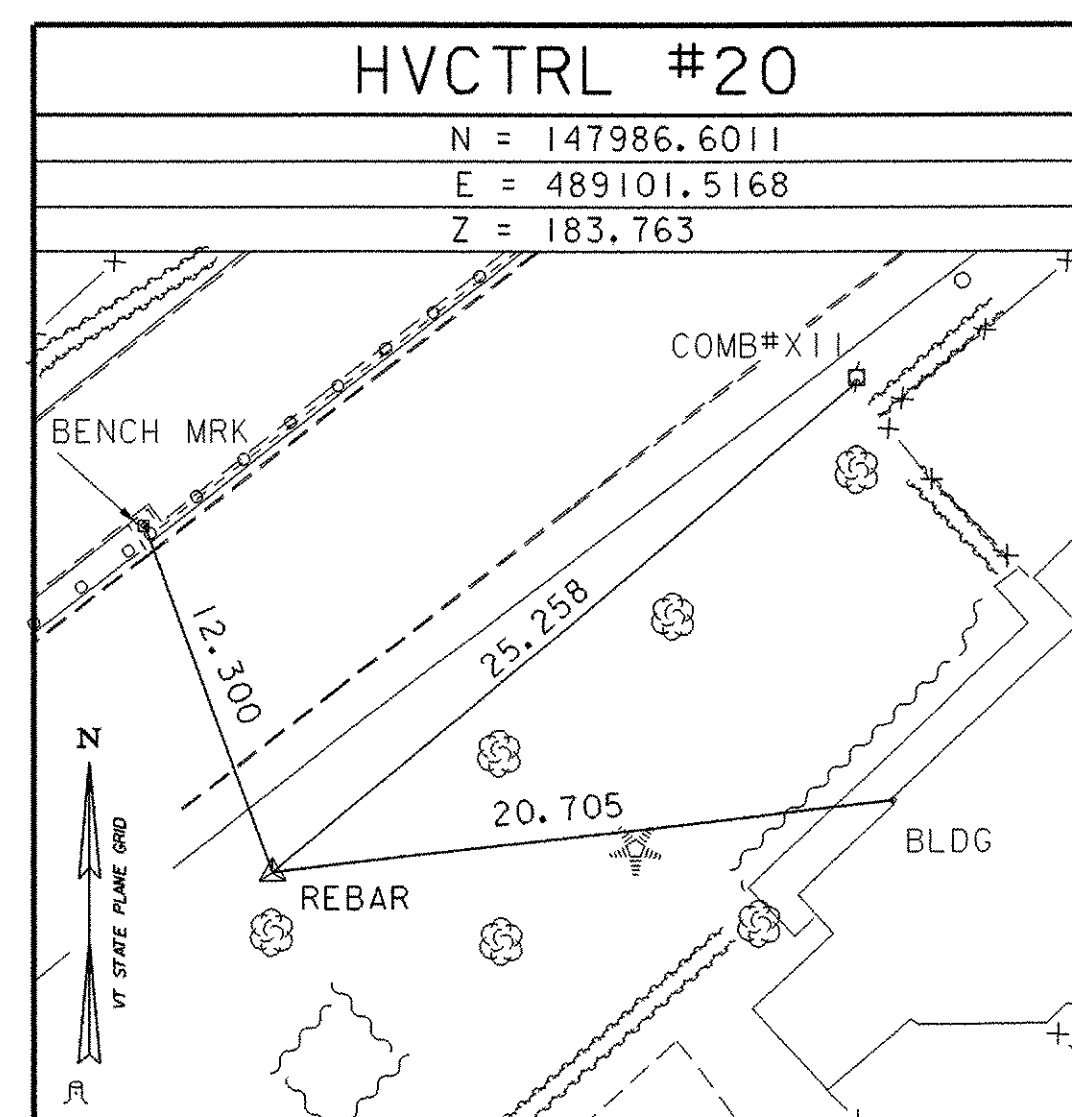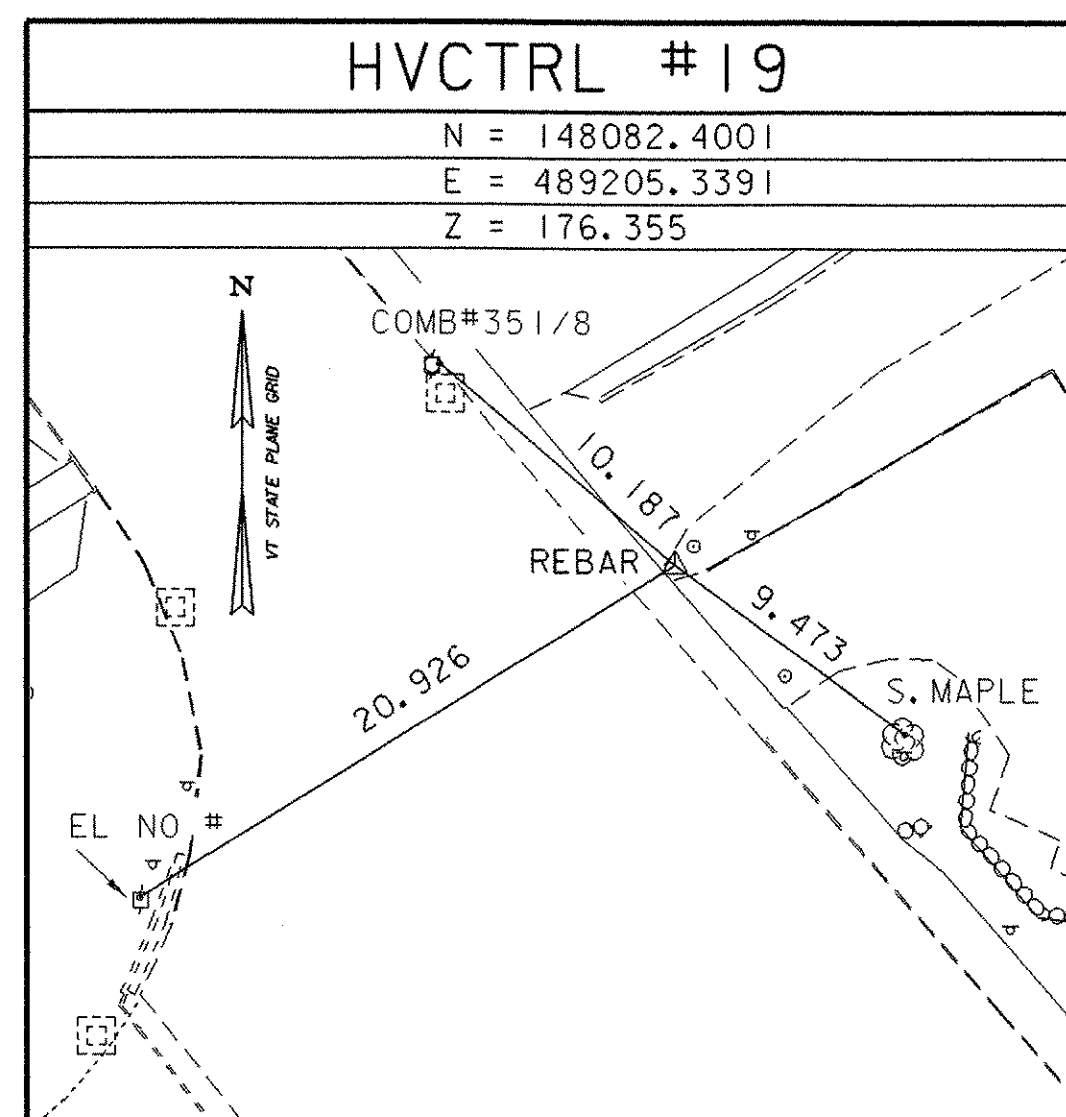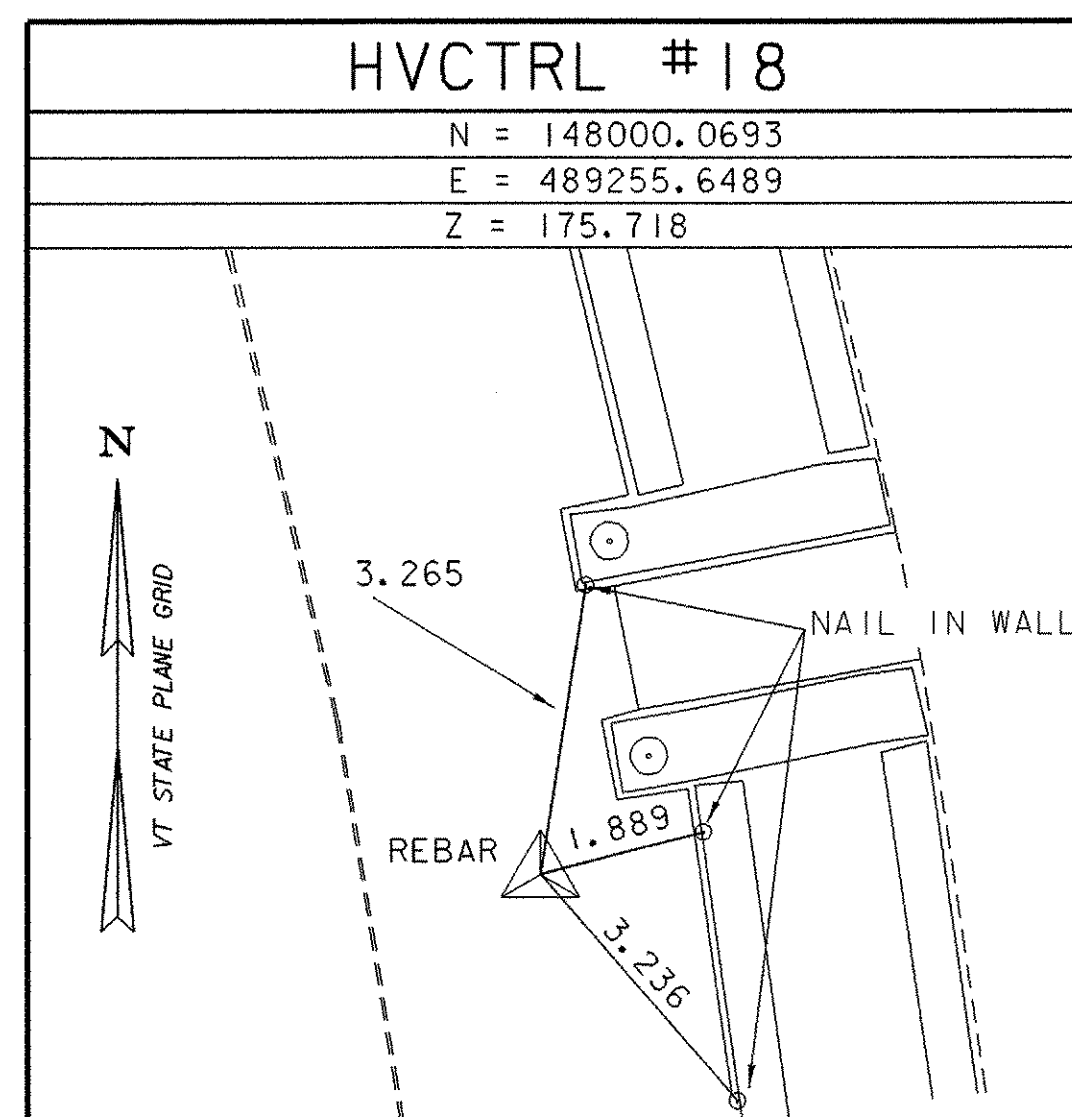

\* MAIN TRAVERSE COMPLETED: OCTOBER 04, 1999 BY L. ORVIS & J. HULETT


## ALIGNMENT TIES

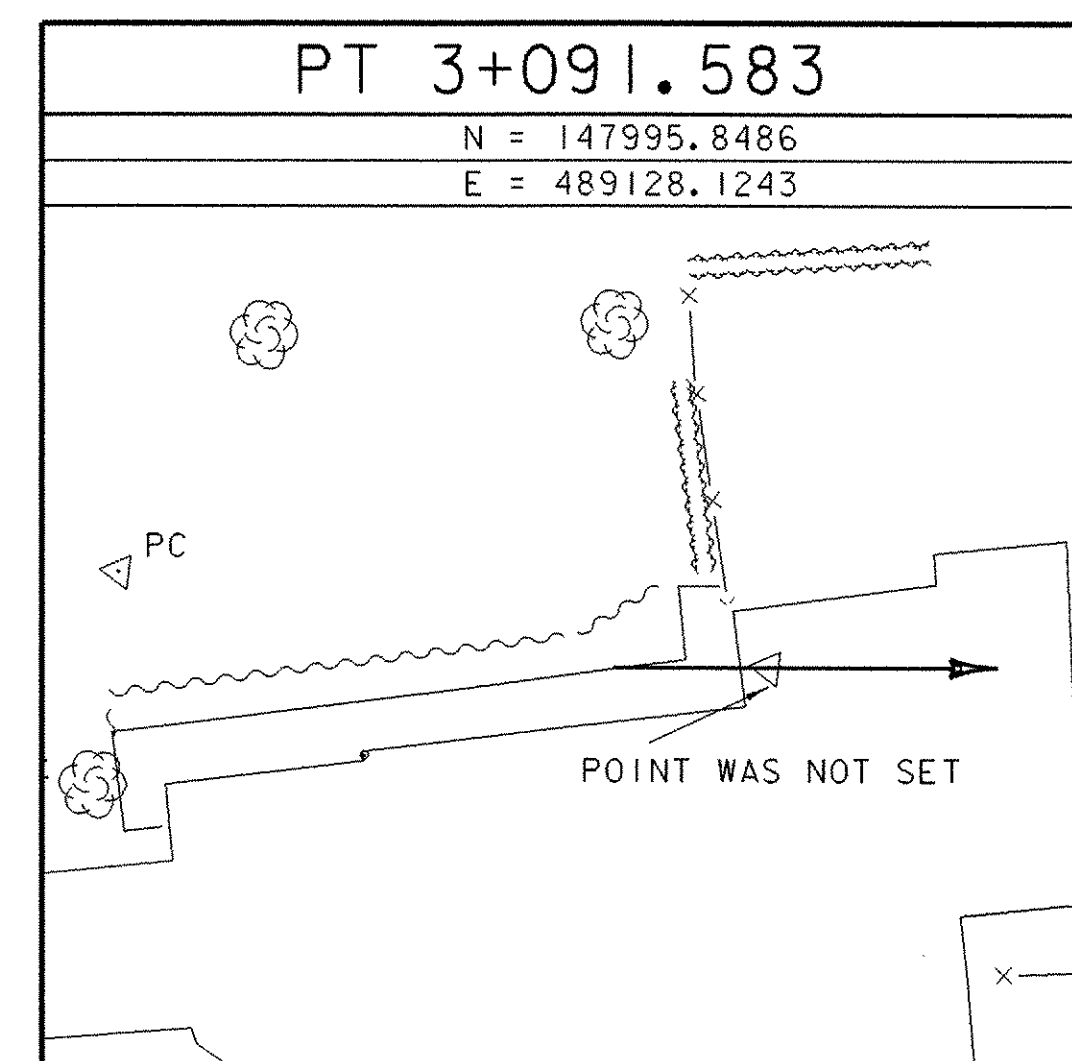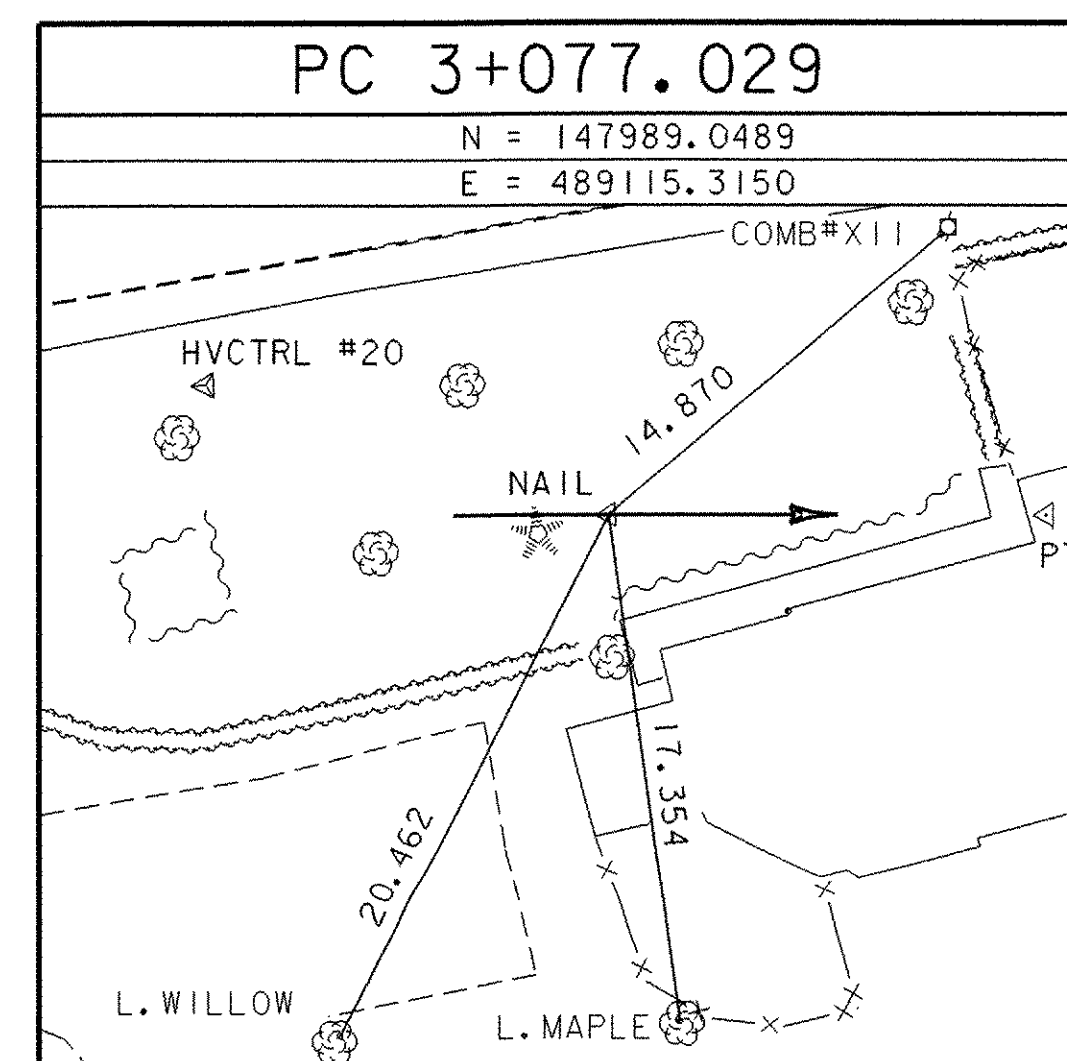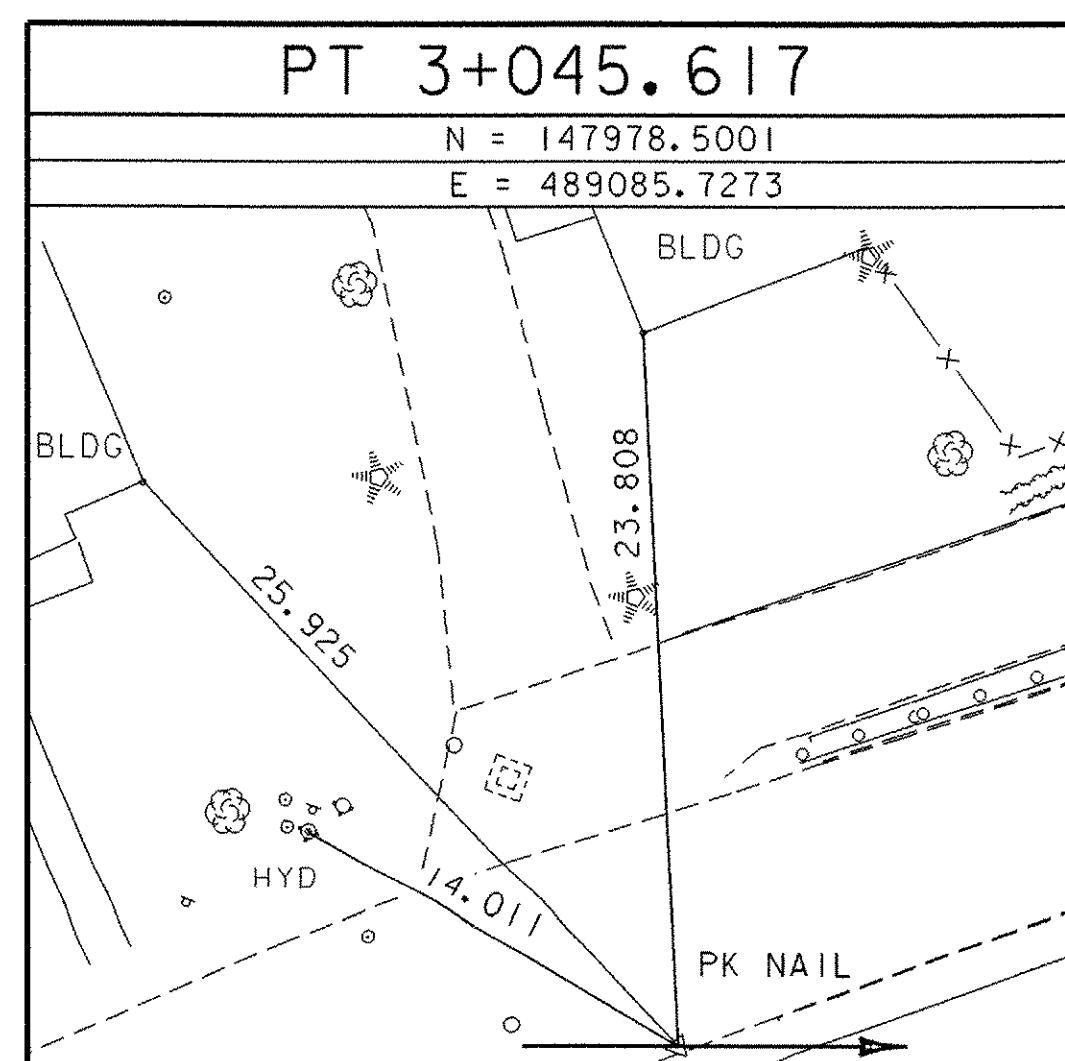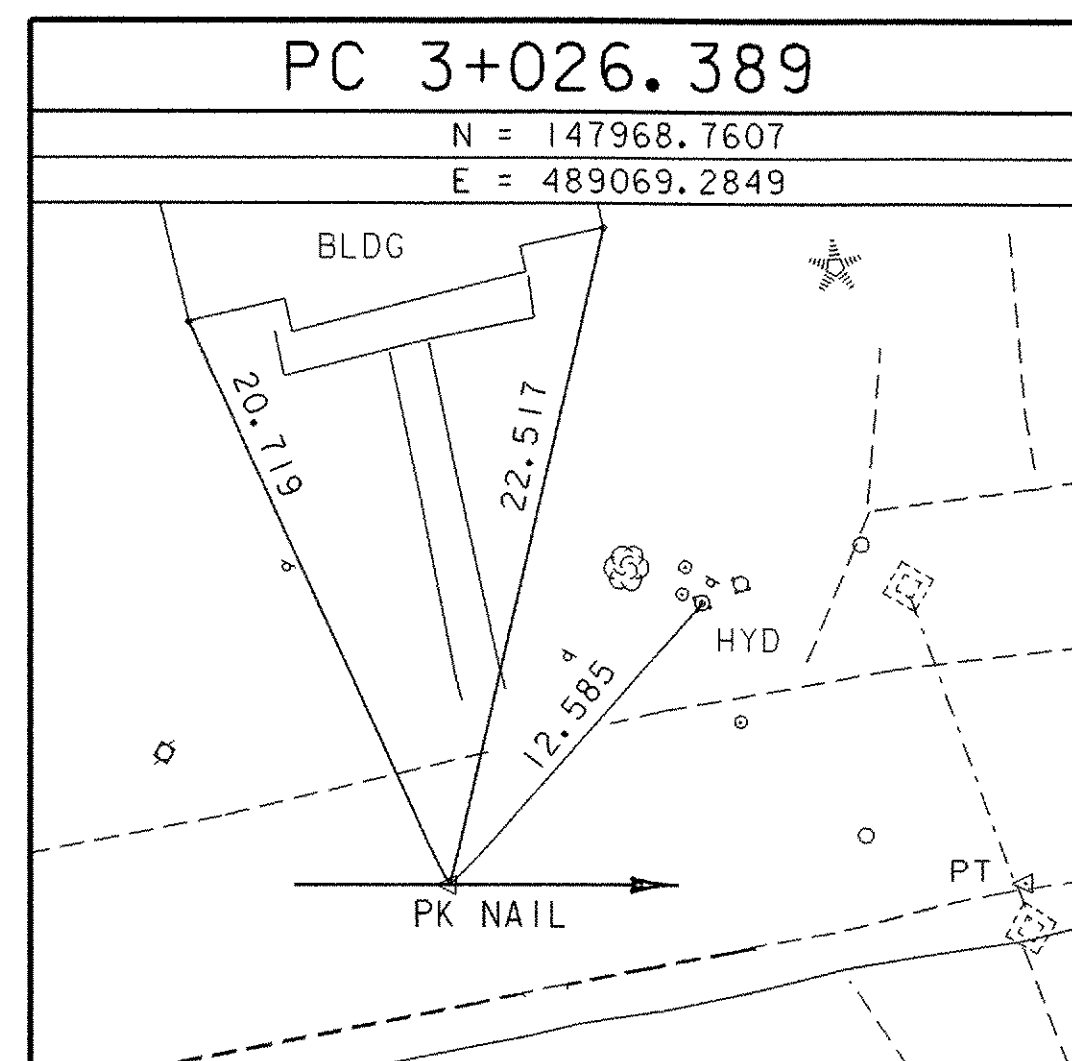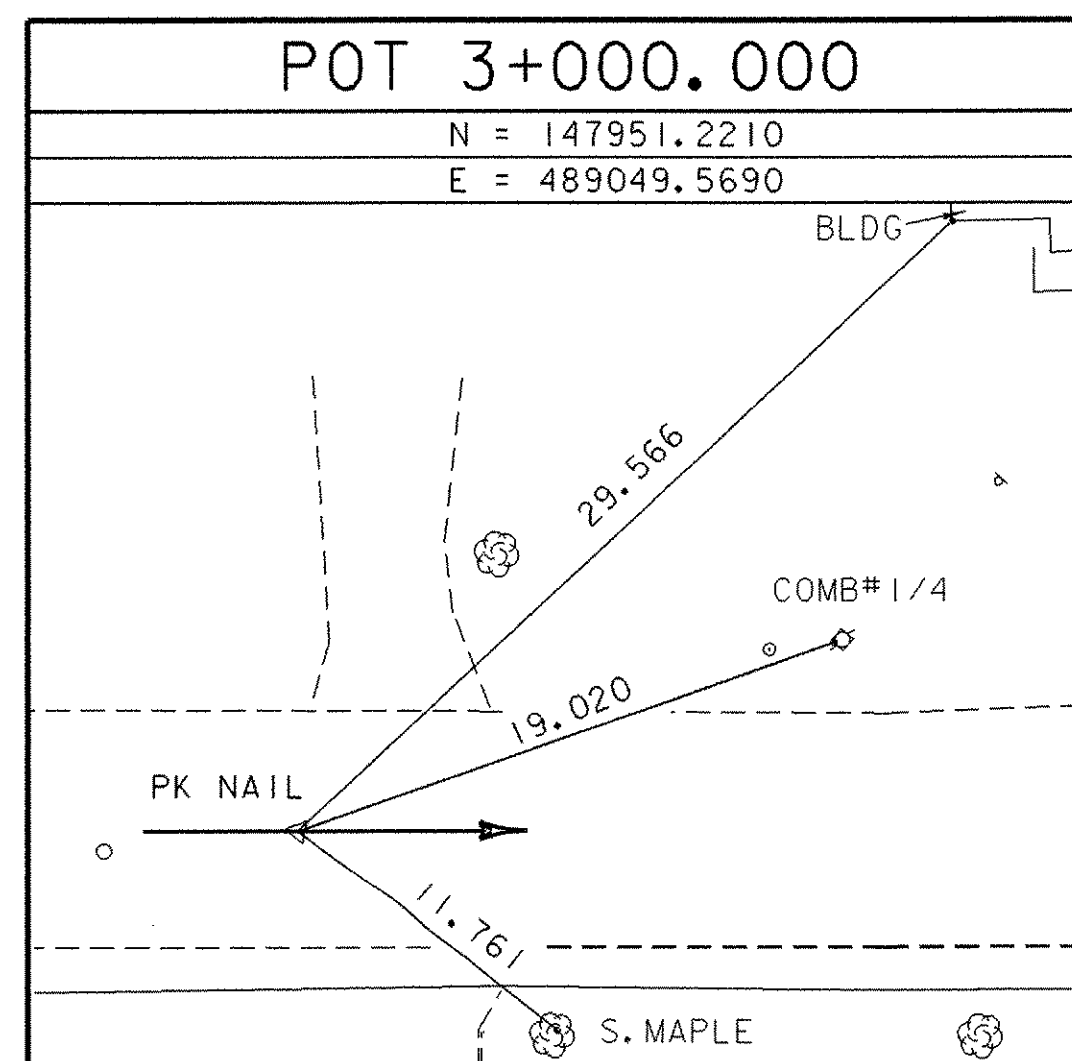

\* ALIGNMENT STAKED ON JANUARY 19, 2002 BY R. GILMAN, P. WINTERS & D. BREER

DATUM  
VERTICAL NAVD 88  
HORIZONTAL NAD 83/92

Metric

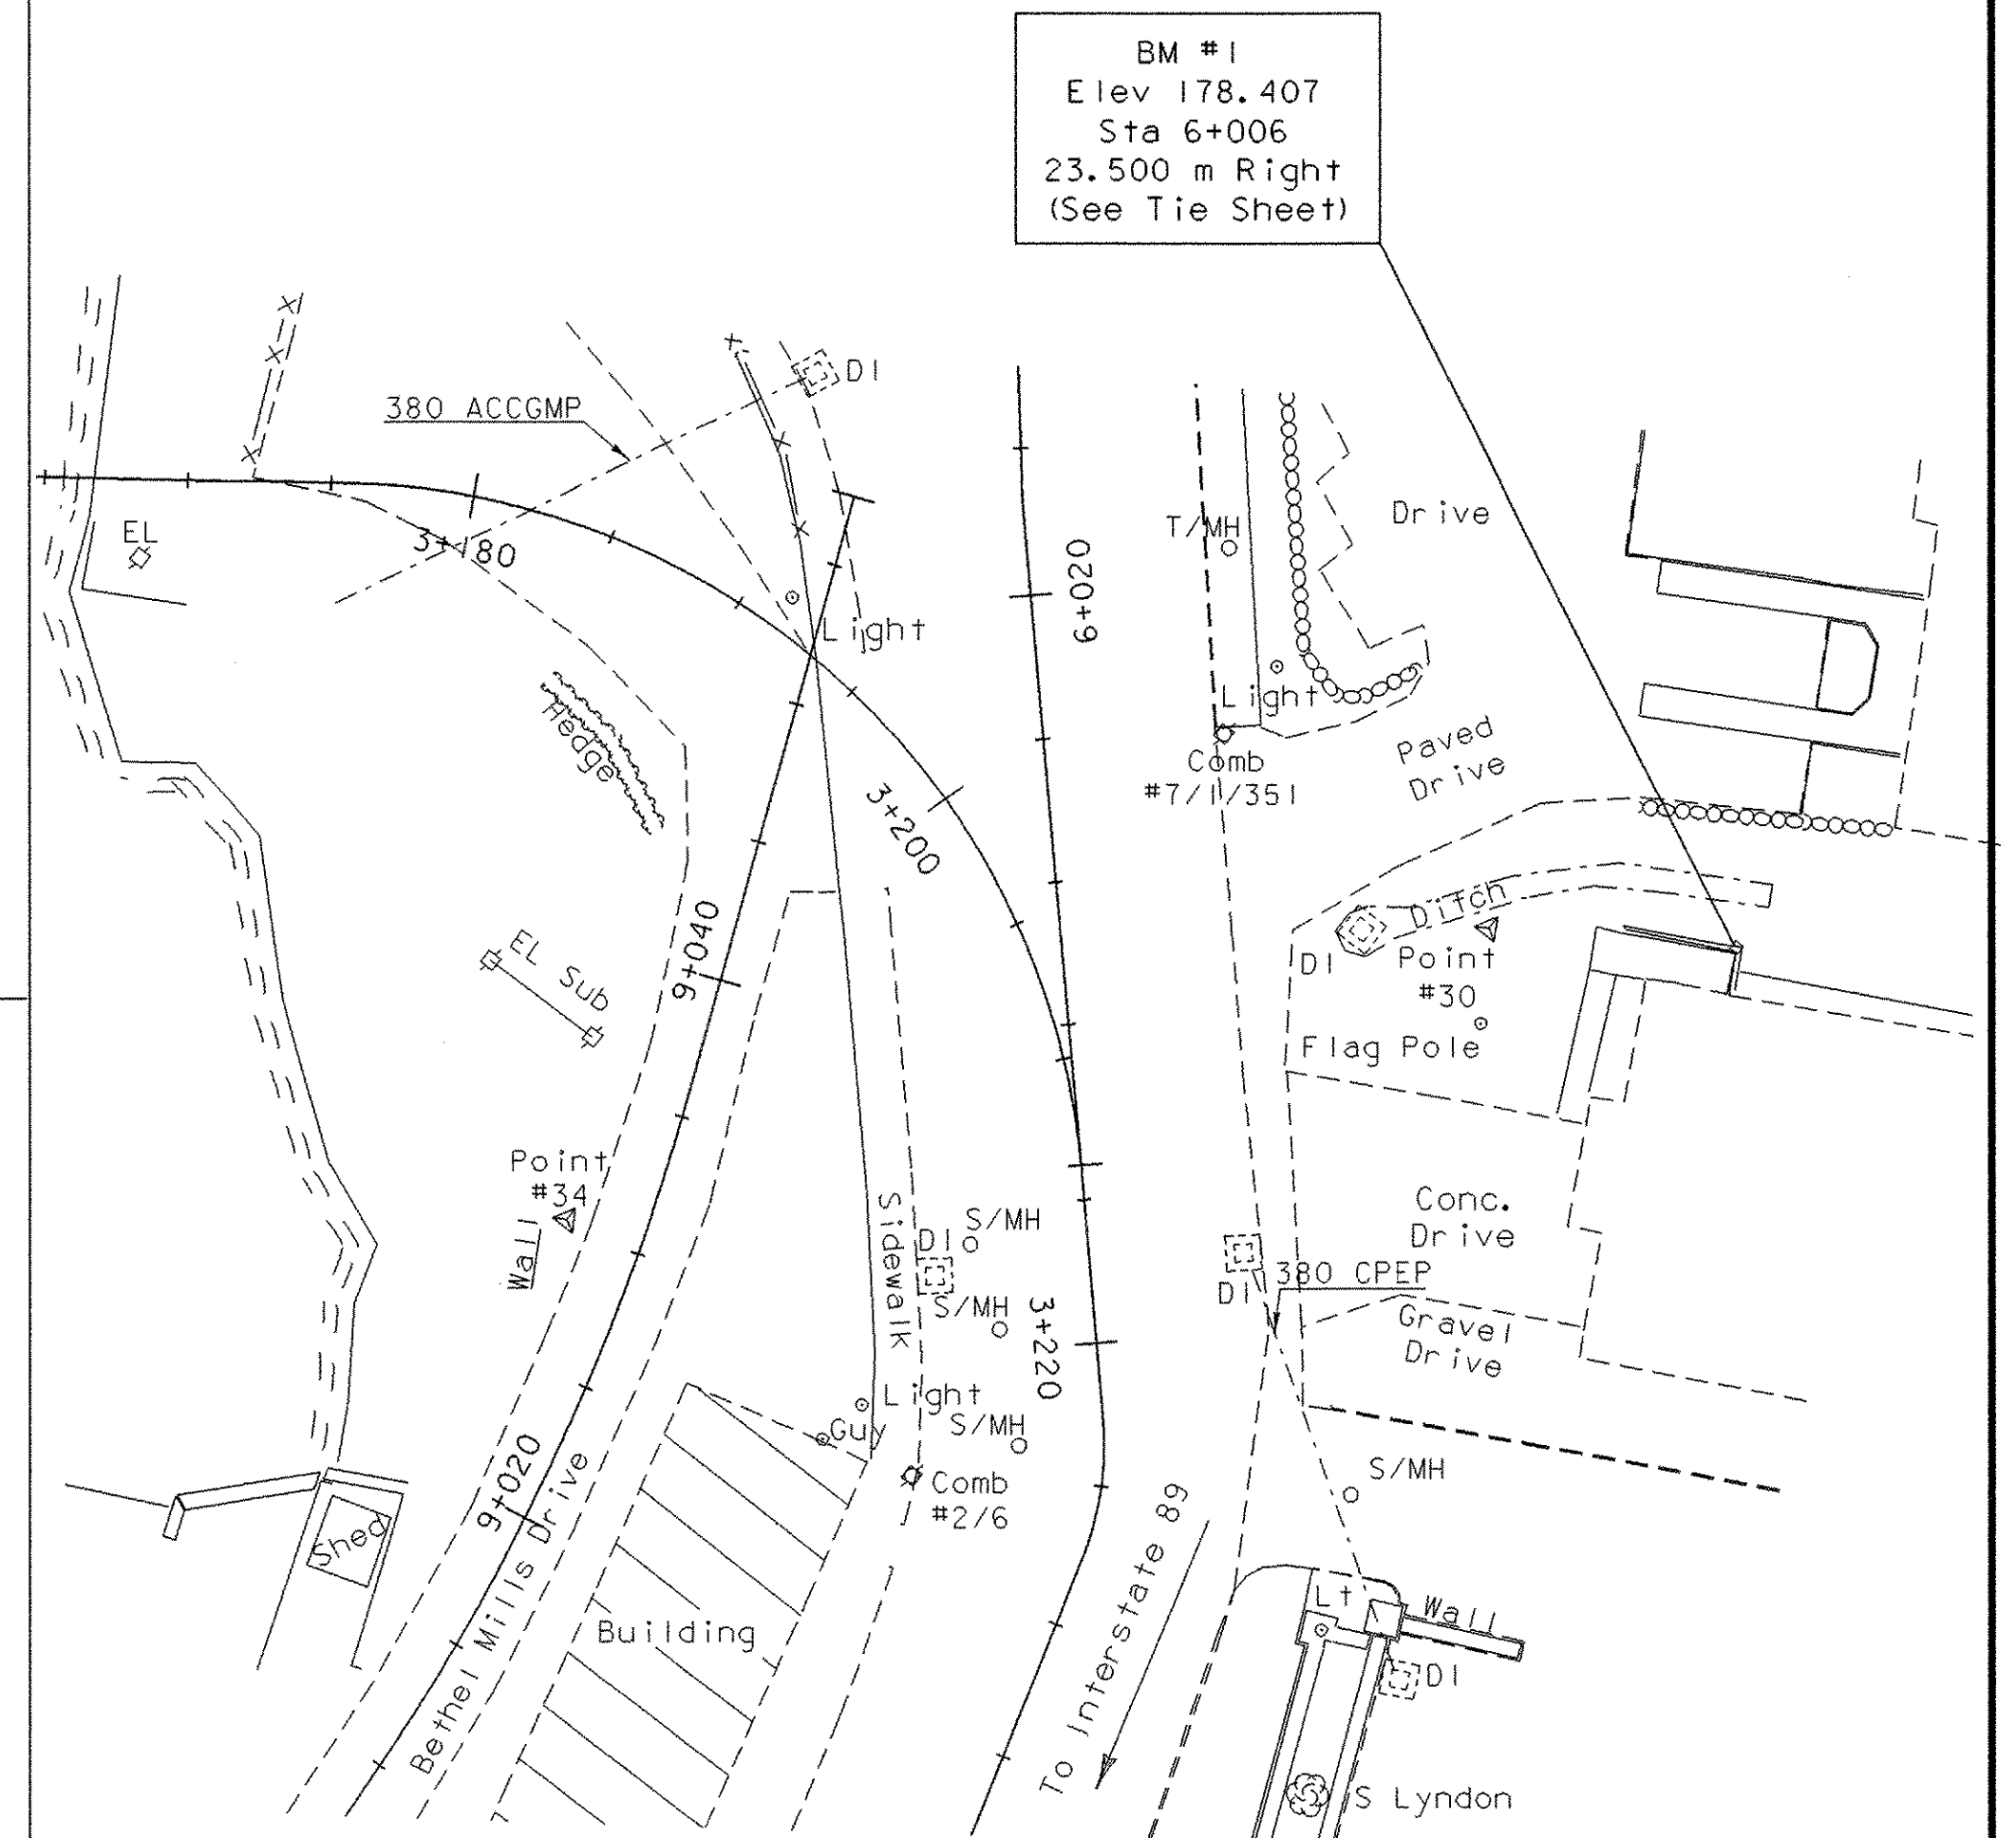

## BENCH MARK #1 LOCATION

PROJECT: BETHEL  
DESIGN FILE NAME: s96j250/STRUCTURES/s96j250tie-cl.dgn  
IPARM FILE NAME: s96j250tie2-cl.i  
SURVEYED BY: ORVIS  
SQUAD LEADER: C. P. WILLIAMS  
ALIGNMENT TIE INFORMATION






PROJECT NO.: BRF 024(33)-CI  
PLOT DATE: 09-JUL-2003  
SURVEY DATE: 10/99  
DRAWN BY: J. HULETT  
SHEET: 6 OF 47



## GPS CONTROL POINTS

## TRAVERSE TIES

## ALIGNMENT TIES

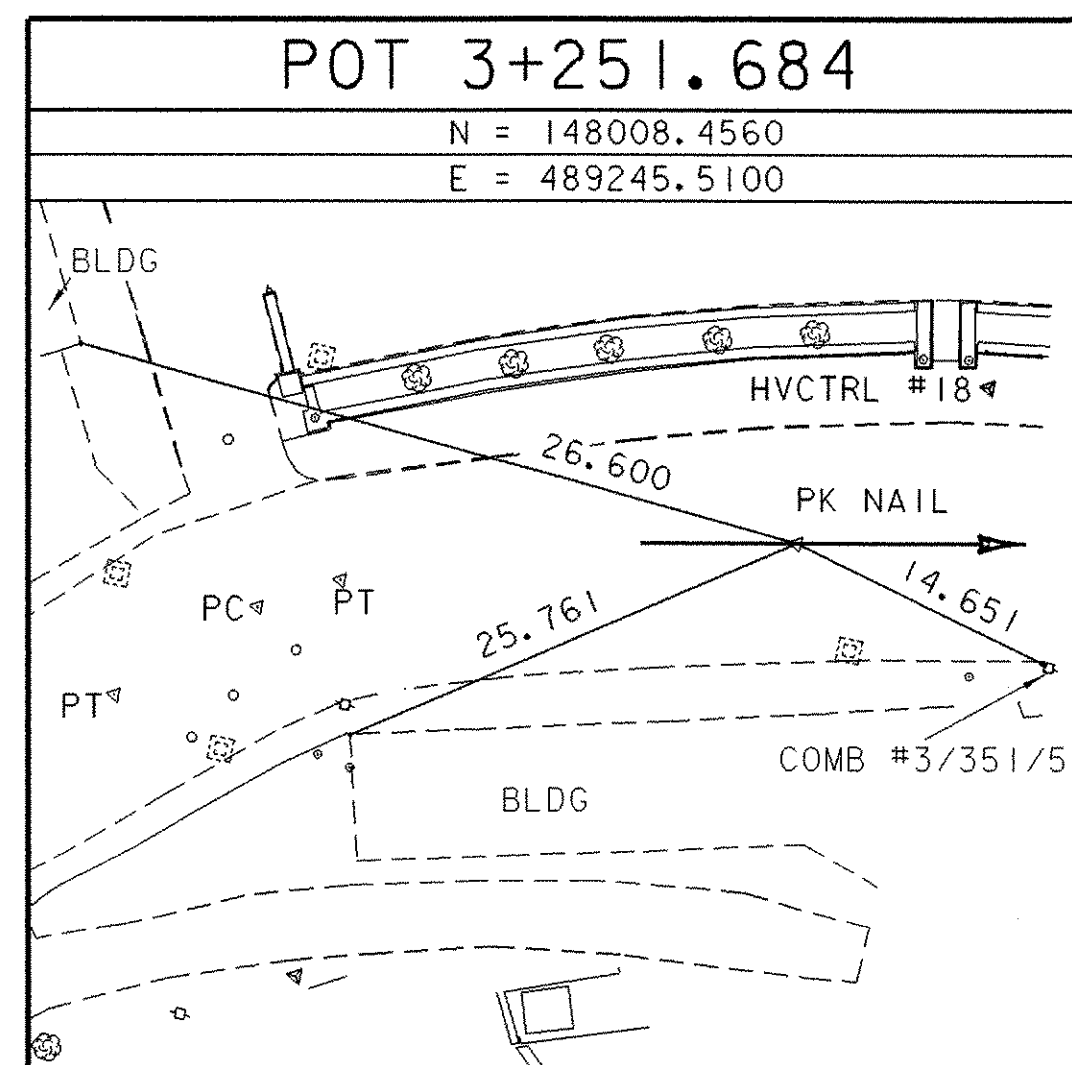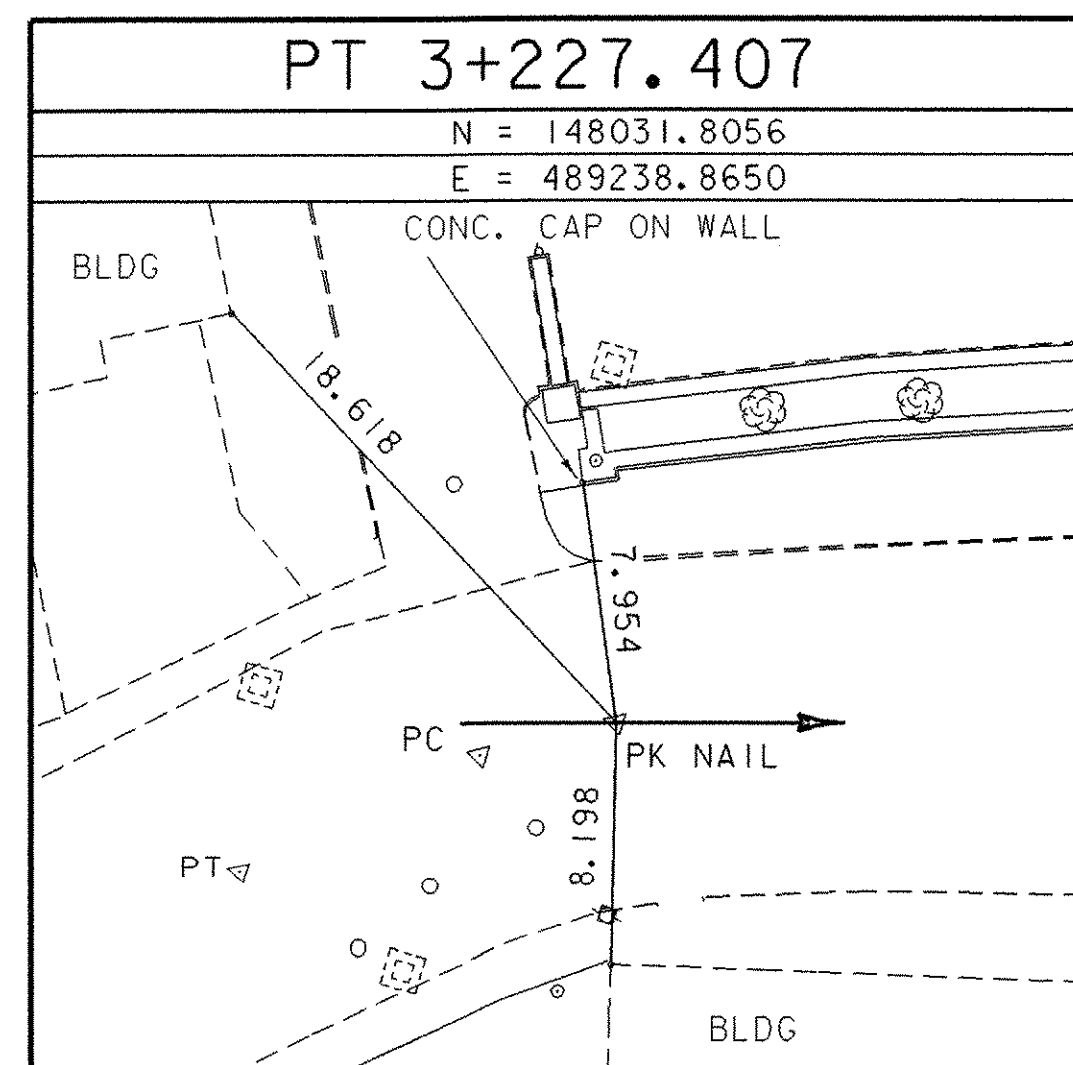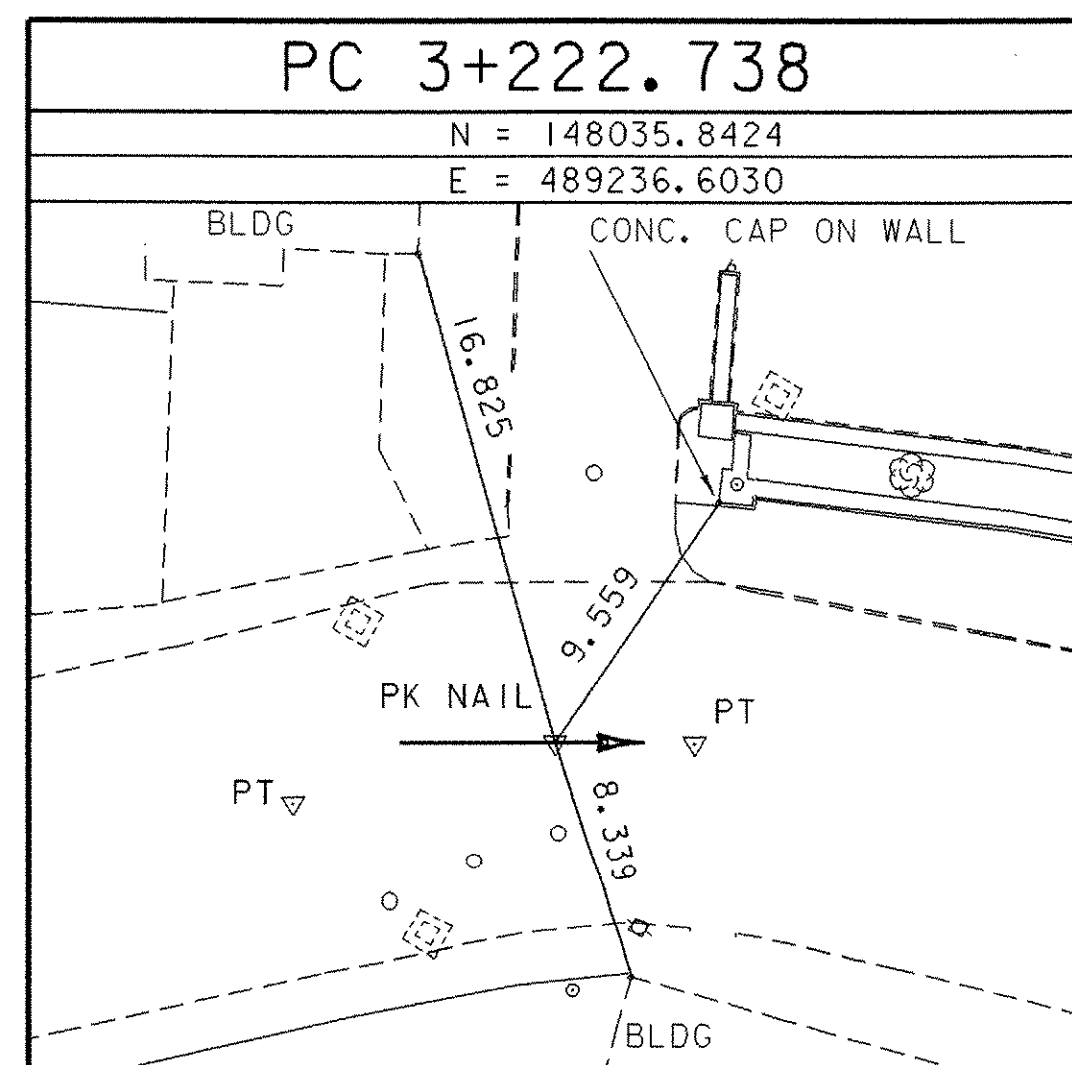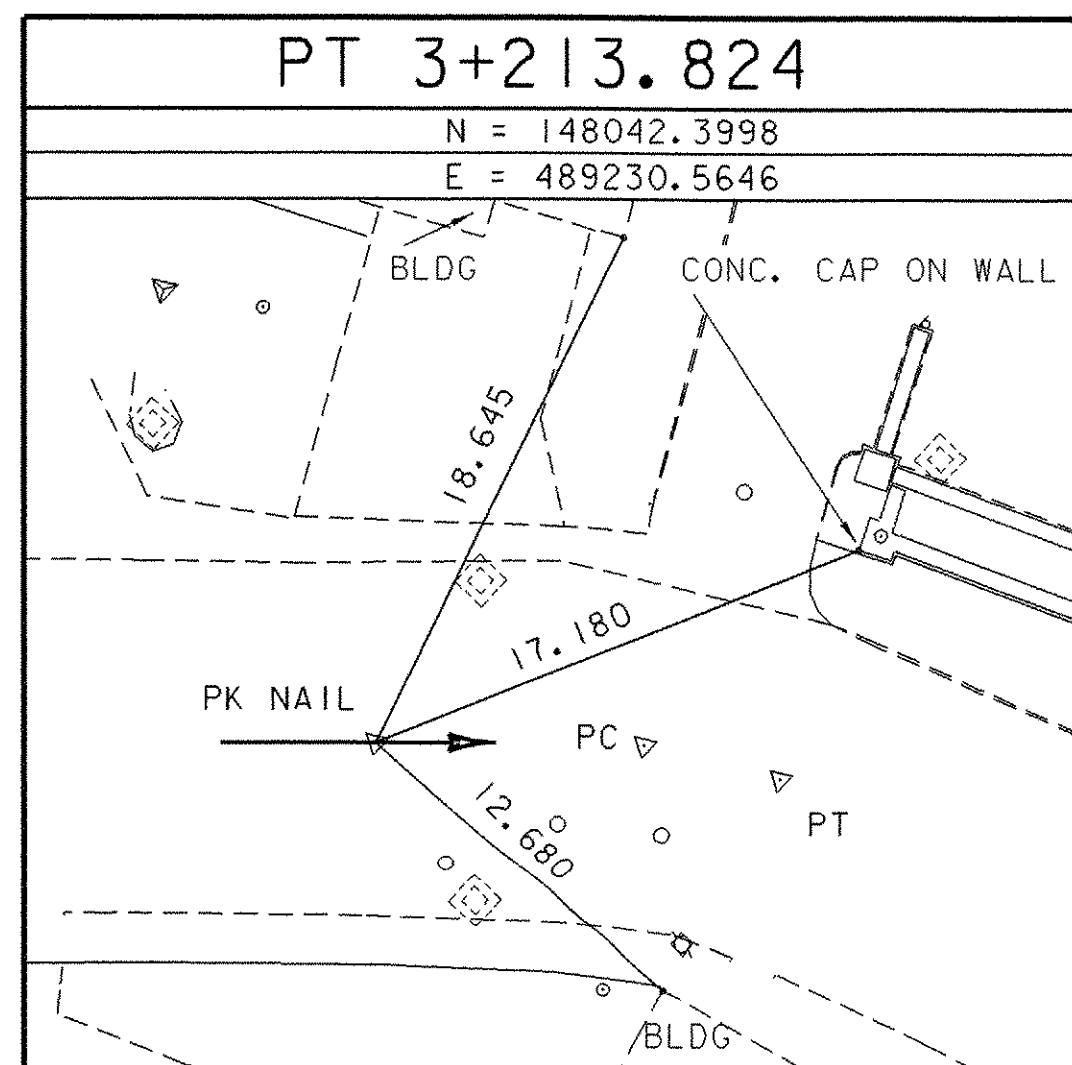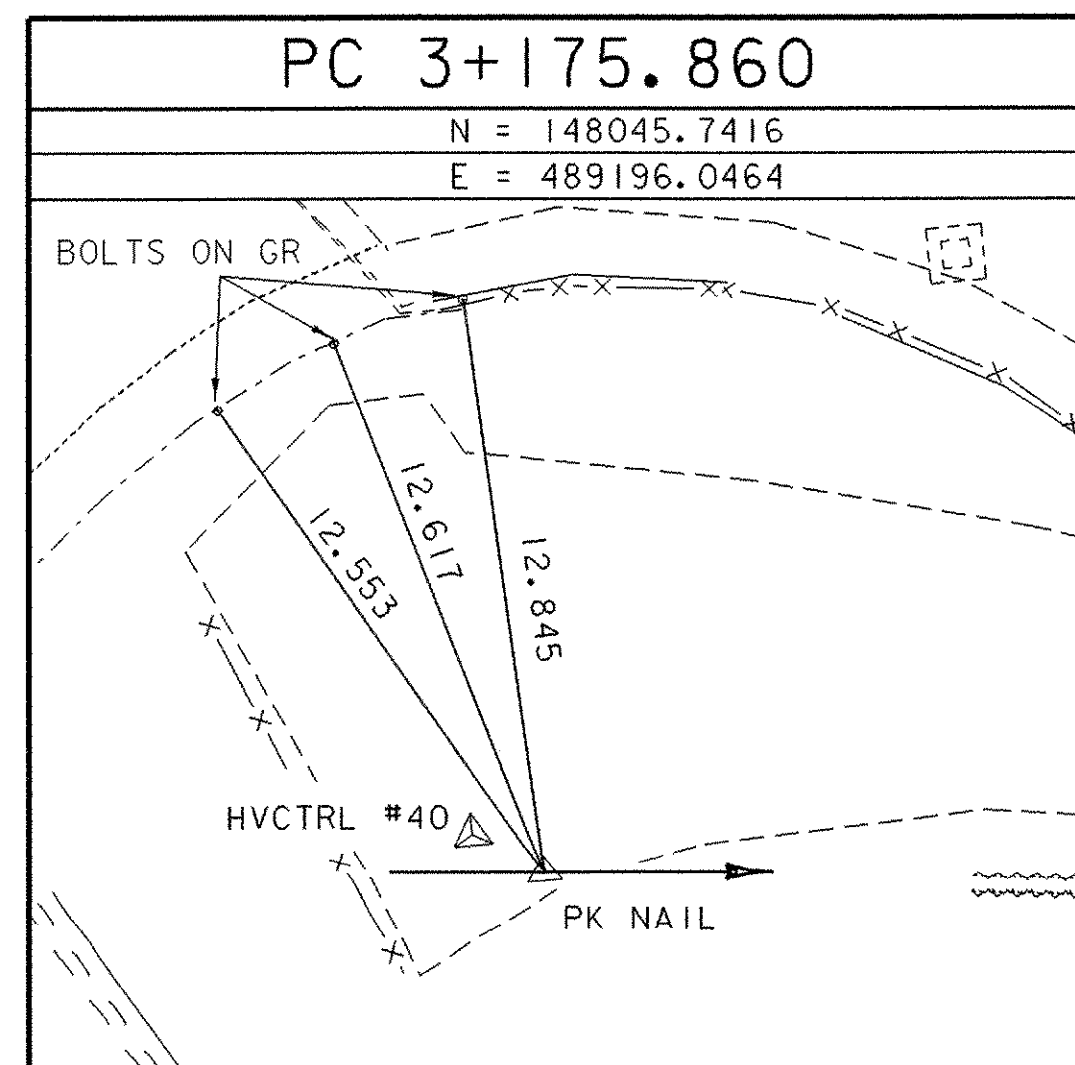

\* ALIGNMENT STAKED ON JANUARY 19, 2002 BY R.GILMAN, P.WINTERS & D.BREER

DATUM

VERTICAL NAVD 88

HORIZONTAL NAD 83/92

PROJECT: BETHEL

PROJECT NO.: BRF 024(33)-CI

DESIGN FILE NAME: 96j250/STRUCTURES/s96j250+ie-cl.dgn

IPARM FILE NAME: s96j250+ie3-cl.i

PLOT DATE: 09-JUL-2003

SURVEYED BY: ORVIS

SURVEY DATE: 10/99


SQUAD LEADER: C. P. WILLIAMS

DRAWN BY: J. HULET

ALIGNMENT/TRAVERSE TIE INFORMATION

SHEET: 7 OF 47




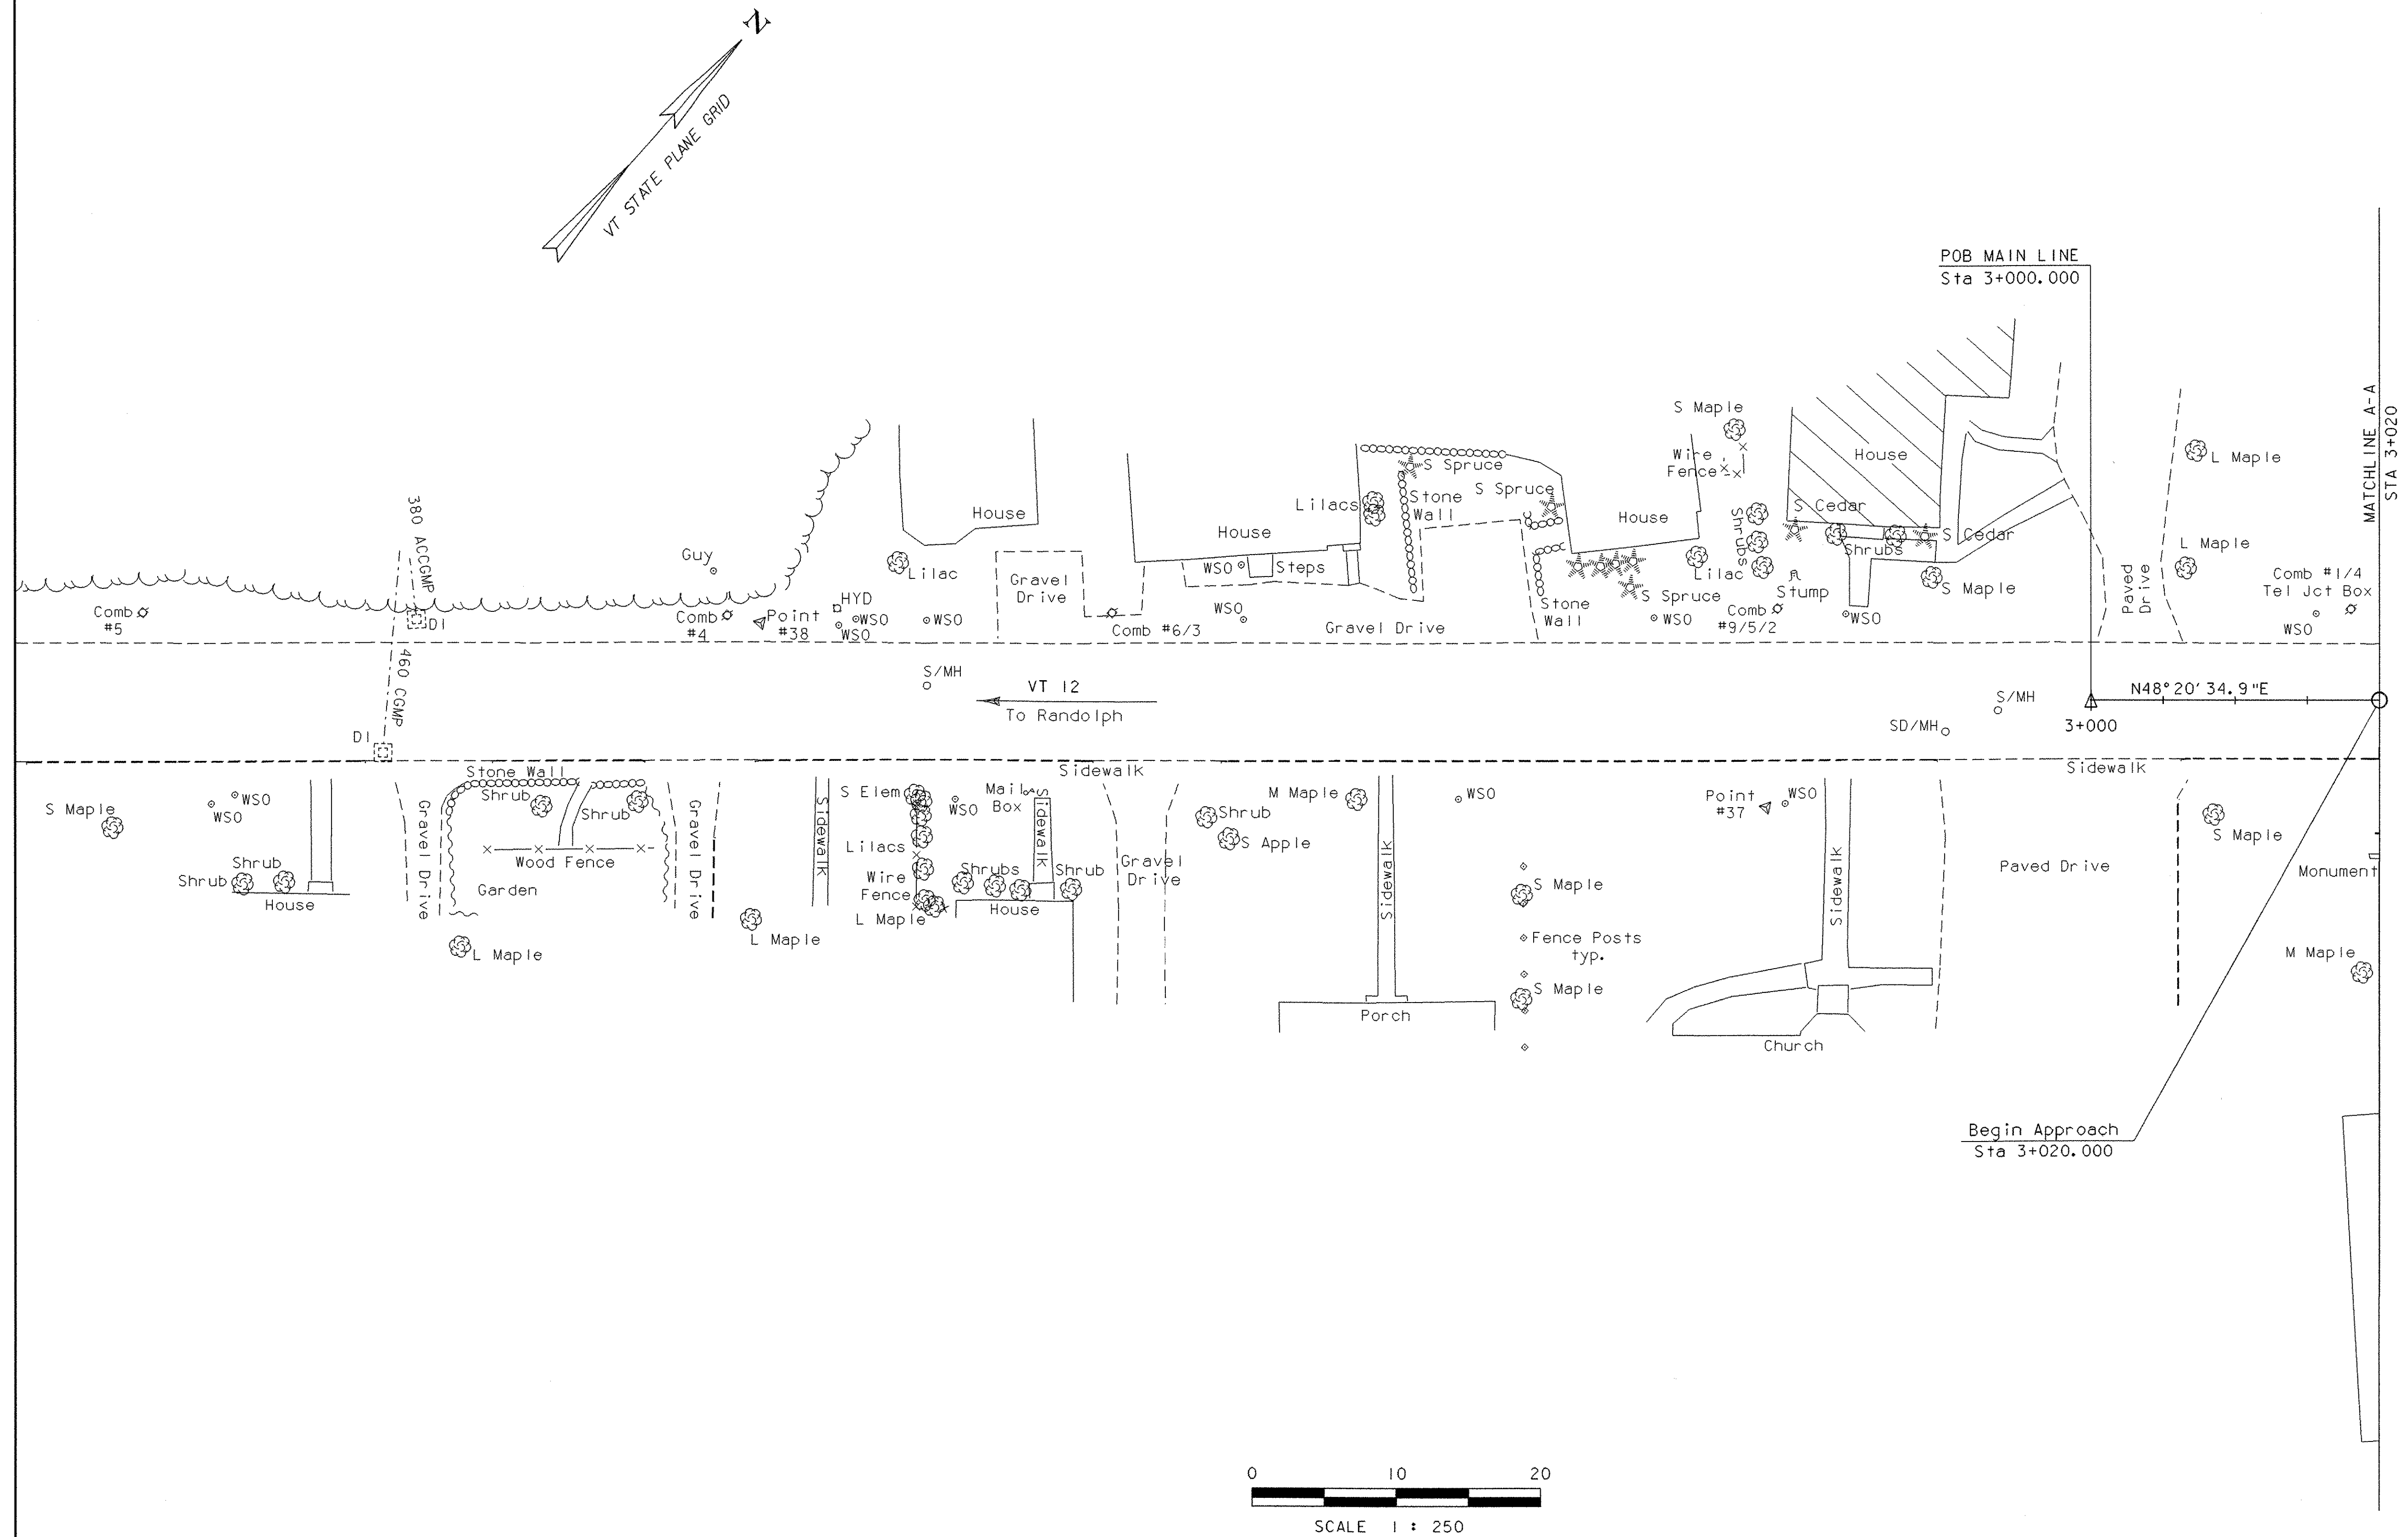

| DATUM      |           |
|------------|-----------|
| VERTICAL   | NAVD 88   |
| HORIZONTAL | NAD 83/92 |

|                   |                                     |               |                    |
|-------------------|-------------------------------------|---------------|--------------------|
| PROJECT:          | BETHEL                              | PROJECT NO. : | BRF 0241 (33) - C1 |
| DESIGN FILE NAME: | 96j250/structures/s96j250bdr-cl.dgn | PLOT DATE:    | 09-JUL-2003        |
| IPARM FILE NAME:  | s96j2501a1-cl.i                     | SURVEY DATE:  | 10/99              |
| SURVEYED BY:      | ORVIS                               | DRAWN BY:     | KMH                |
| SQUAD LEADER:     | C. P. WILLIAMS                      | SHEET:        | 8 OF 47            |
| LAYOUT SHEET      | 1                                   |               |                    |



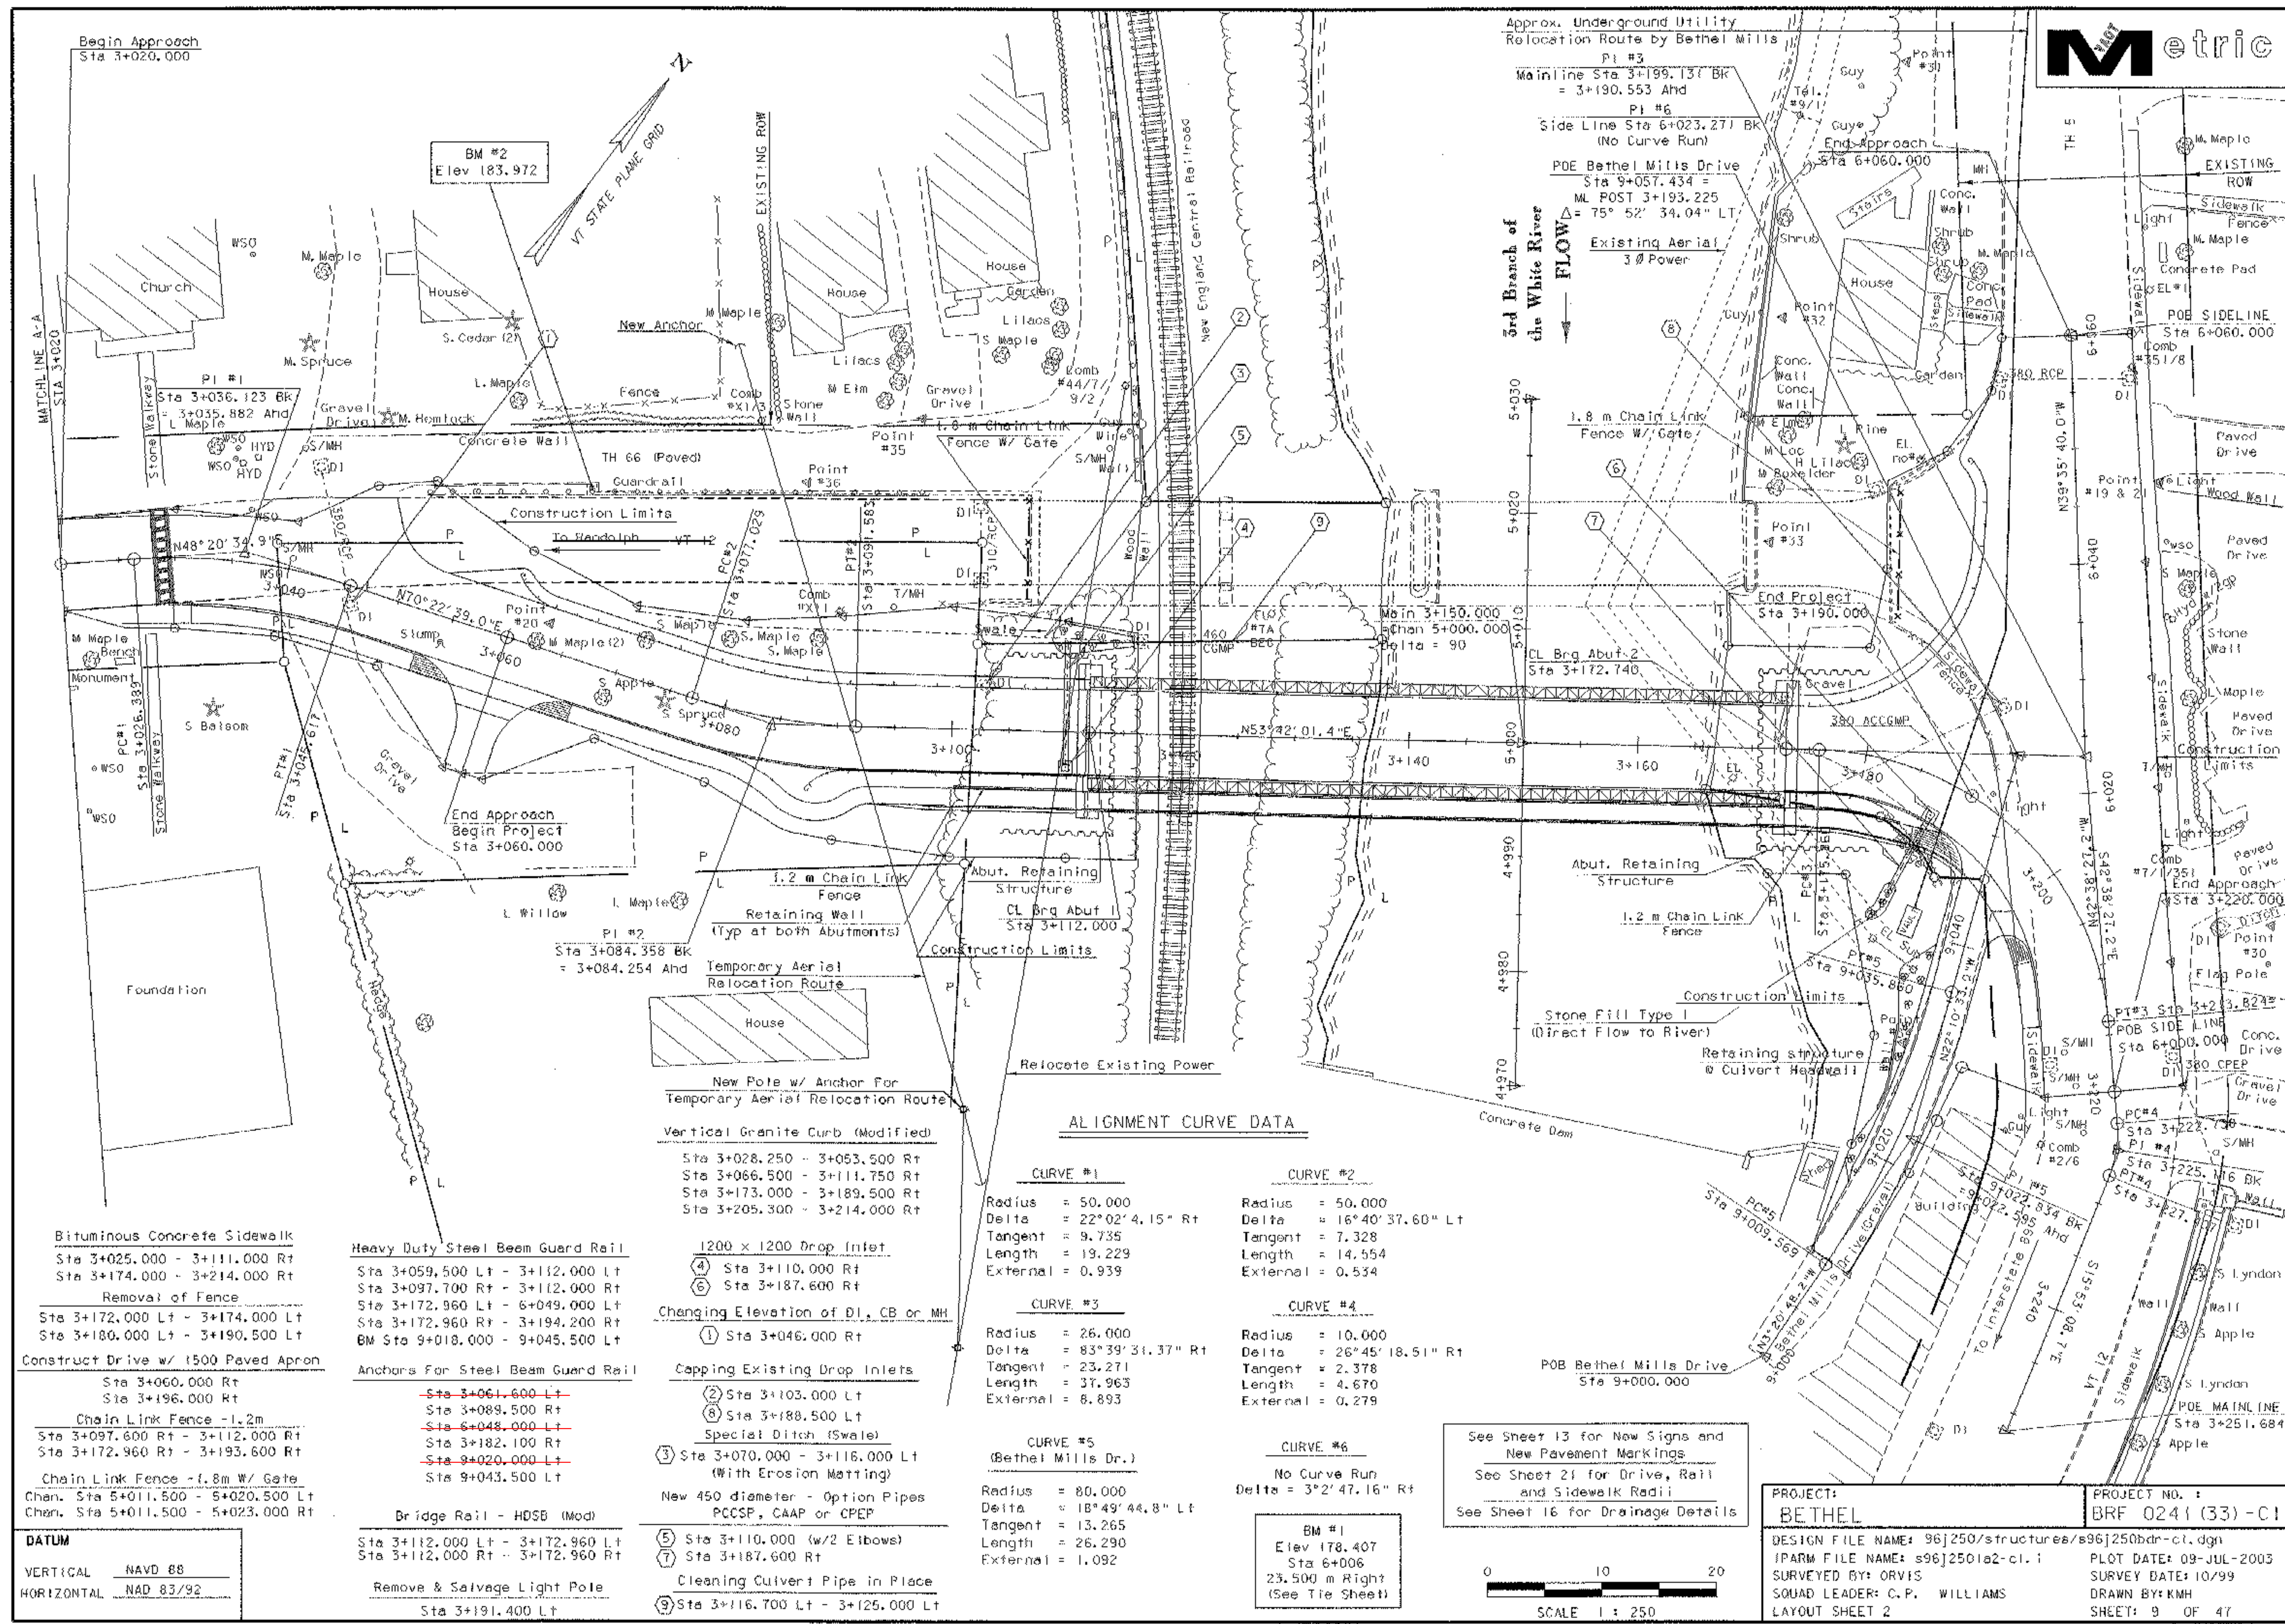

Approx. Underground Utility  
Relocation Route by Bethel Mills  
PI #3  
Mainline Sta 3+199.131 BK  
= 3+190.553 Ahd  
PI #6  
Side Line Sta 6+023.271 BK  
(No Curve Run)  
POE Bethel Mills Drive  
Sta 9+057.434 =  
ML POST 3+193.225  
= 75° 52' 34.04" LT  
Existing Aerial  
3 Ø Power

3rd Branch of  
the White River  
FLOW

ALIGNMENT CURVE DATA

Vertical Granite Curb (Modified)

Sta 3+028.250 - 3+053.500 Rt  
Sta 3+066.500 - 3+111.750 Rt  
Sta 3+173.000 - 3+189.500 Rt  
Sta 3+205.300 - 3+214.000 Rt

CURVE #1

Radius = 50.000  
Delta = 22°02'4.15" Rt  
Tangent = 9.735  
Length = 19.229  
External = 0.939

CURVE #2

Radius = 50.000  
Delta = 16°40'37.60" Lt  
Tangent = 7.328  
Length = 14.554  
External = 0.534

CURVE #3

Radius = 26.000  
Delta = 83°39'31.37" Rt  
Tangent = 23.271  
Length = 37.963  
External = 8.893

CURVE #4

Radius = 10.000  
Delta = 26°45'18.51" Rt  
Tangent = 2.378  
Length = 4.670  
External = 0.279

CURVE #5  
(Bethel Mills Dr.)


Radius = 80.000  
Delta = 18°49'44.8" Lt  
Tangent = 13.265  
Length = 26.290  
External = 1.092

CURVE #6

No Curve Run  
Delta = 3°2'47.16" Rt

BM #1  
Elev 178.407  
Sta 6+006  
23.500 m Right  
(See Tie Sheet)

See Sheet 13 for New Signs and  
New Pavement Markings  
See Sheet 21 for Drive, Rail  
and Sidewalk Radii  
See Sheet 16 for Drainage Details

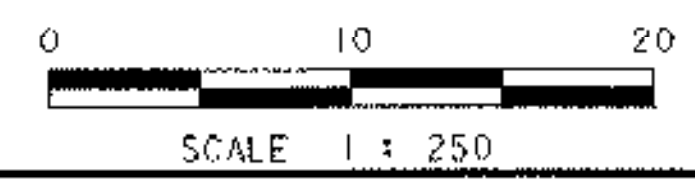

Bituminous Concrete Sidewalk  
Sta 3+025.000 - 3+111.000 Rt  
Sta 3+174.000 - 3+214.000 Rt

Removal of Fence  
Sta 3+172.000 Lt - 3+174.000 Lt  
Sta 3+180.000 Lt - 3+190.500 Lt

Construct Drive w/ 1500 Paved Apron  
Sta 3+060.000 Rt  
Sta 3+196.000 Rt

Chain Link Fence - 1.2m  
Sta 3+097.600 Rt - 3+112.000 Rt  
Sta 3+172.960 Rt - 3+193.600 Rt

Chain Link Fence - 1.8m W/ Gate  
Chan. Sta 5+011.500 - 5+020.500 Lt  
Chan. Sta 5+011.500 - 5+023.000 Rt

DATUM  
VERTICAL NAVD 88  
HORIZONTAL NAD 83/92

Heavy Duty Steel Beam Guard Rail

Sta 3+059.500 Lt - 3+112.000 Lt  
Sta 3+097.700 Rt - 3+112.000 Rt  
Sta 3+172.960 Lt - 6+049.000 Lt  
Sta 3+172.960 Rt - 3+194.200 Rt  
BM Sta 9+018.000 - 9+045.500 Lt

Anchors for Steel Beam Guard Rail

~~Sta 3+061.600 Lt~~  
~~Sta 3+089.500 Rt~~  
~~Sta 6+048.000 Lt~~  
~~Sta 3+182.100 Rt~~  
~~Sta 9+020.000 Lt~~  
Sta 9+043.500 Lt

Bridge Rail - HDSB (Mod)

Sta 3+112.000 Lt - 3+172.960 Lt  
Sta 3+112.000 Rt - 3+172.960 Rt

Remove & Salvage Light Pole  
Sta 3+191.400 Lt

1200 x 1200 Drop Inlet

④ Sta 3+110.000 Rt  
⑥ Sta 3+187.600 Rt

Changing Elevation of DI, CB or MH

① Sta 3+046.000 Rt

Capping Existing Drop Inlets

② Sta 3+103.000 Lt  
⑧ Sta 3+188.500 Lt  
Special Ditch (Swale)  
③ Sta 3+070.000 - 3+116.000 Lt  
(With Erosion Matting)


New 450 diameter - Option Pipes  
PCCSP, CAAP or CPEP

⑤ Sta 3+110.000 (w/2 Elbows)  
⑦ Sta 3+187.600 Rt



Cleaning Culvert Pipe in Place  
⑨ Sta 3+116.700 Lt - 3+125.000 Lt

|                                                        |                                           |
|--------------------------------------------------------|-------------------------------------------|
| PROJECT:<br><b>BETHEL</b>                              | PROJECT NO.:<br><b>BRF 0241 (33) - C1</b> |
| DESIGN FILE NAME: s96j250/structures/s96j250bdr-cl.dgn | PLOT DATE: 09-JUL-2003                    |
| IPARM FILE NAME: s96j250la2-cl.i                       | SURVEY DATE: 10/99                        |
| SURVEYED BY: ORVIS                                     | DRAWN BY: KMH                             |
| SQUAD LEADER: C.P. WILLIAMS                            | SHEET: 9 OF 47                            |
| LAYOUT SHEET 2                                         |                                           |




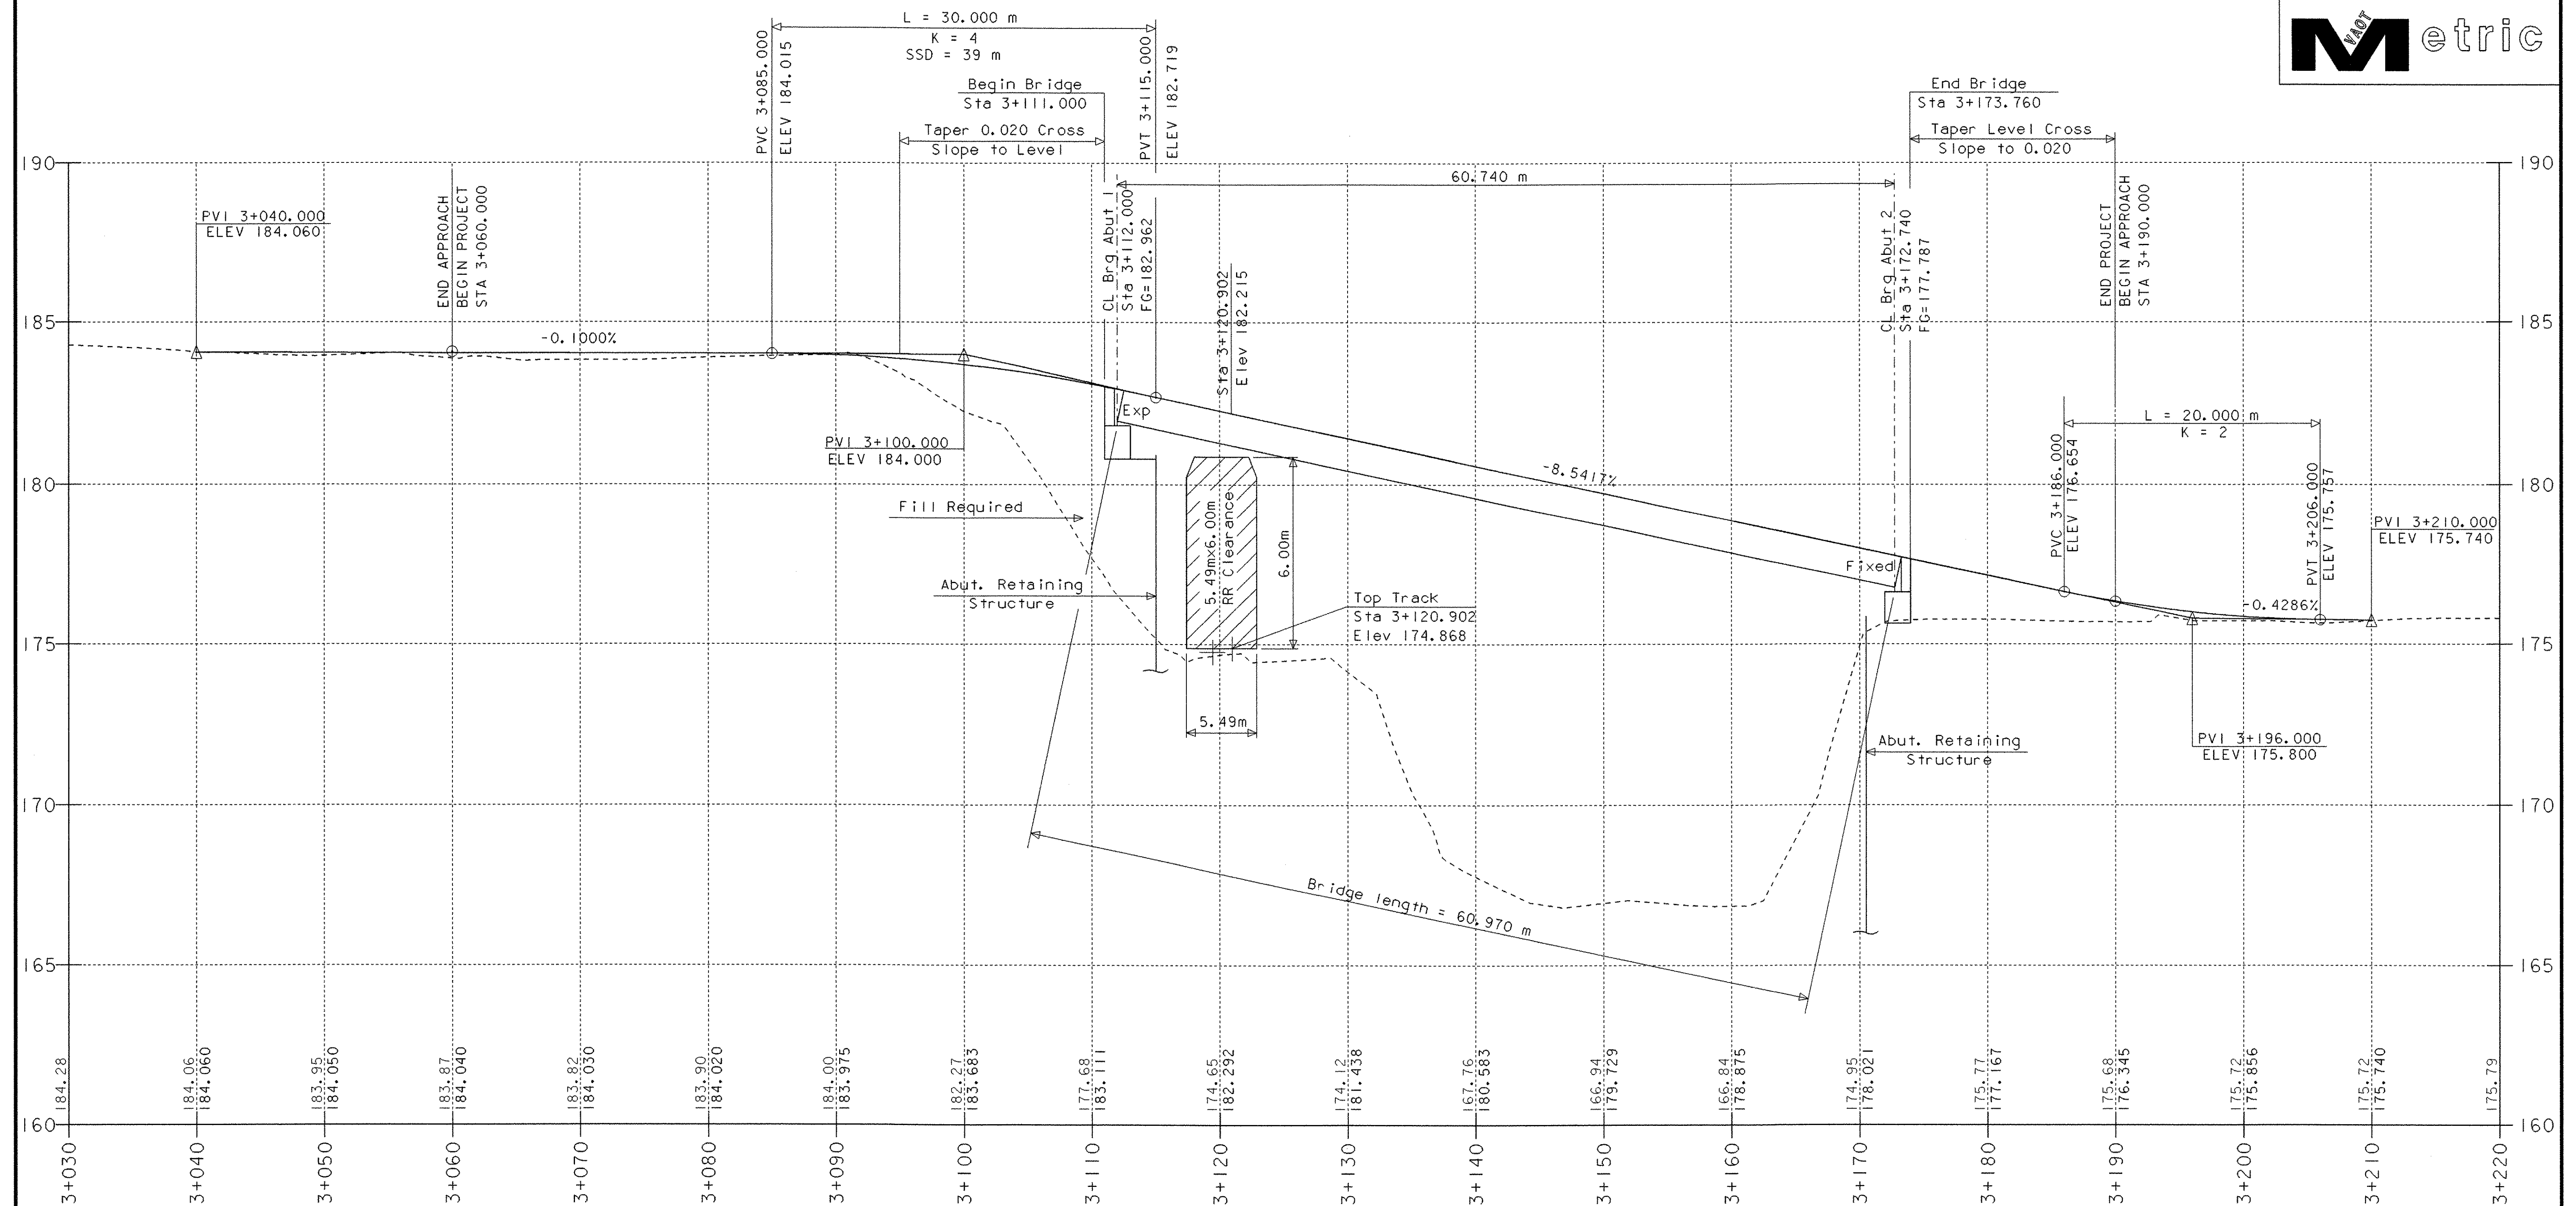

## Profile Along Temporary Detour

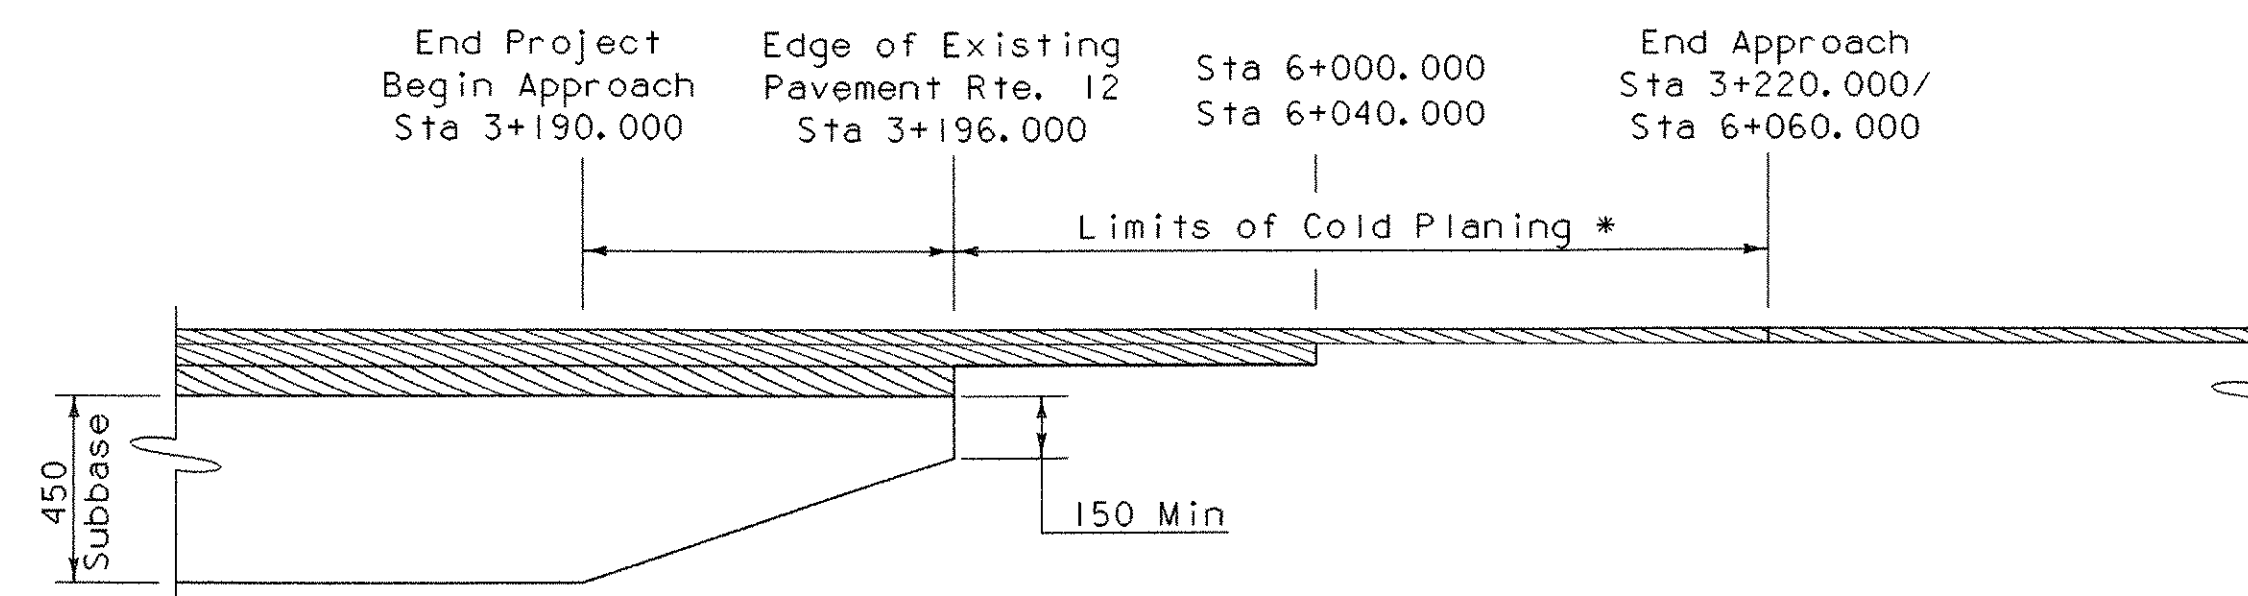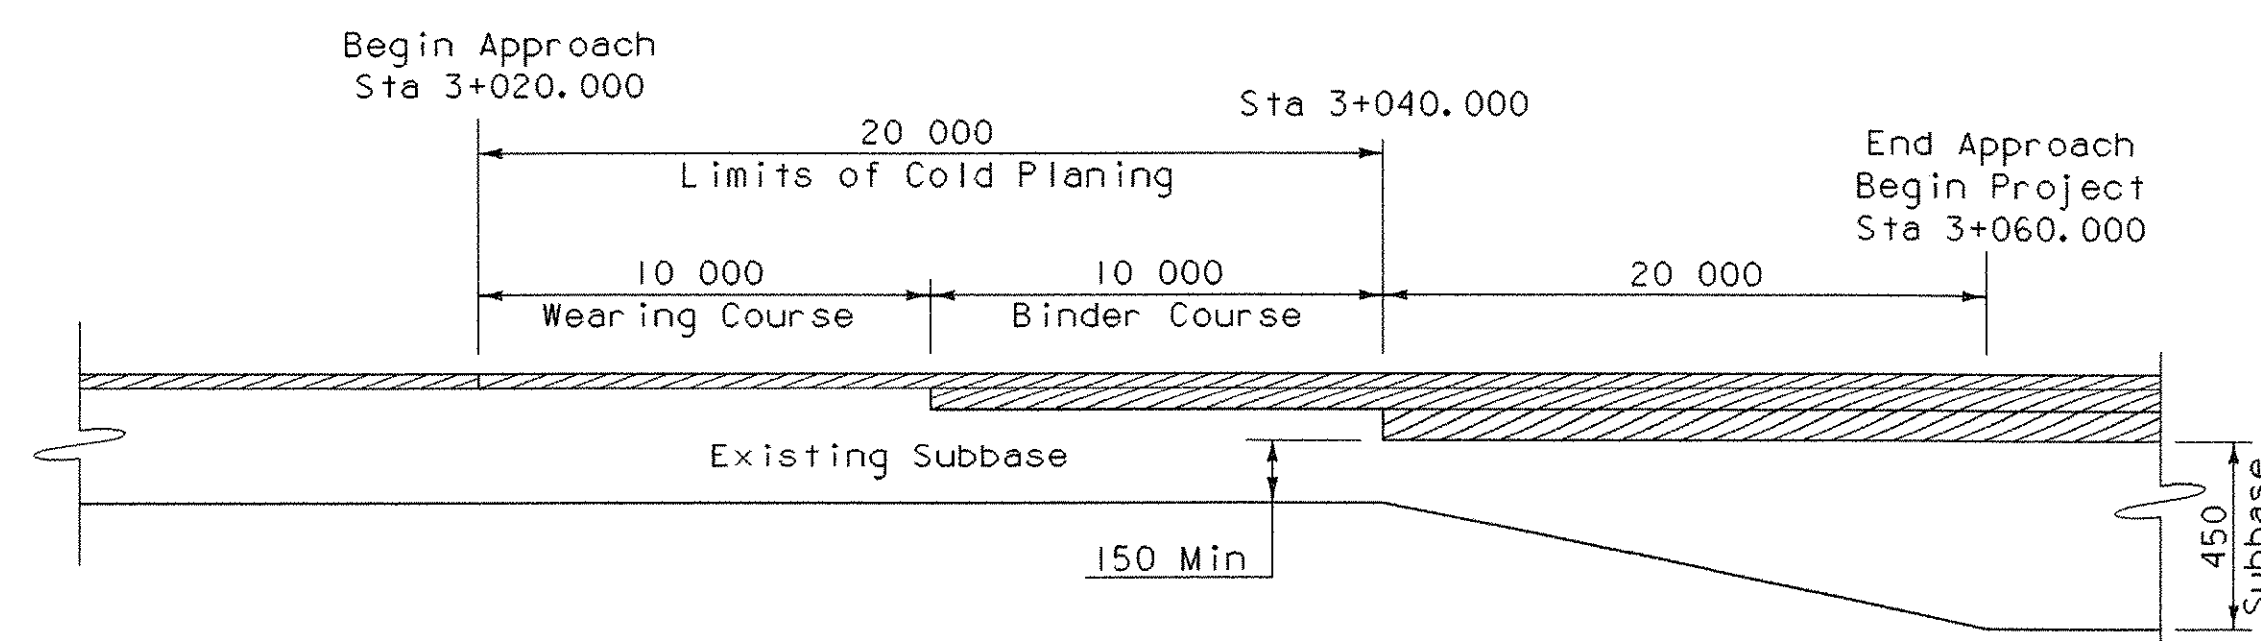

\* Limits of Cold Planing may be adjusted in the field as deemed necessary by the resident engineer.

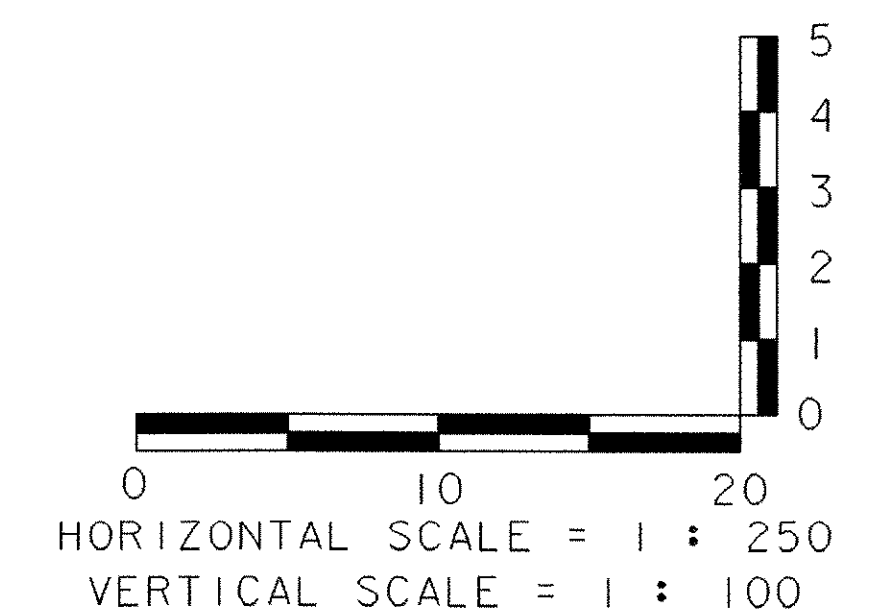


DATUM  
VERTICAL NAVD 88  
HORIZONTAL NAD 83/92

SUBBASE TAPER AT BEGIN PROJECT  
NTS


SUBBASE TAPER AT END PROJECT  
NTS

|                                                       |                                           |
|-------------------------------------------------------|-------------------------------------------|
| PROJECT:<br><b>BETHEL</b>                             | PROJECT NO.:<br><b>BRF 0241 (33) - C1</b> |
| DESIGN FILE NAME: 96j250/structures/s96j250pro-cl.dgn | PLOT DATE: 09-JUL-2003                    |
| IPARM FILE NAME: s96j250prl-cl.i                      | SURVEYED BY: ORVIS                        |
| SQUAD LEADER: C. P. WILLIAMS                          | DRAWN BY: KMH                             |
| TEMPORARY DETOUR PROFILE                              | SHEET: 10 OF 47                           |




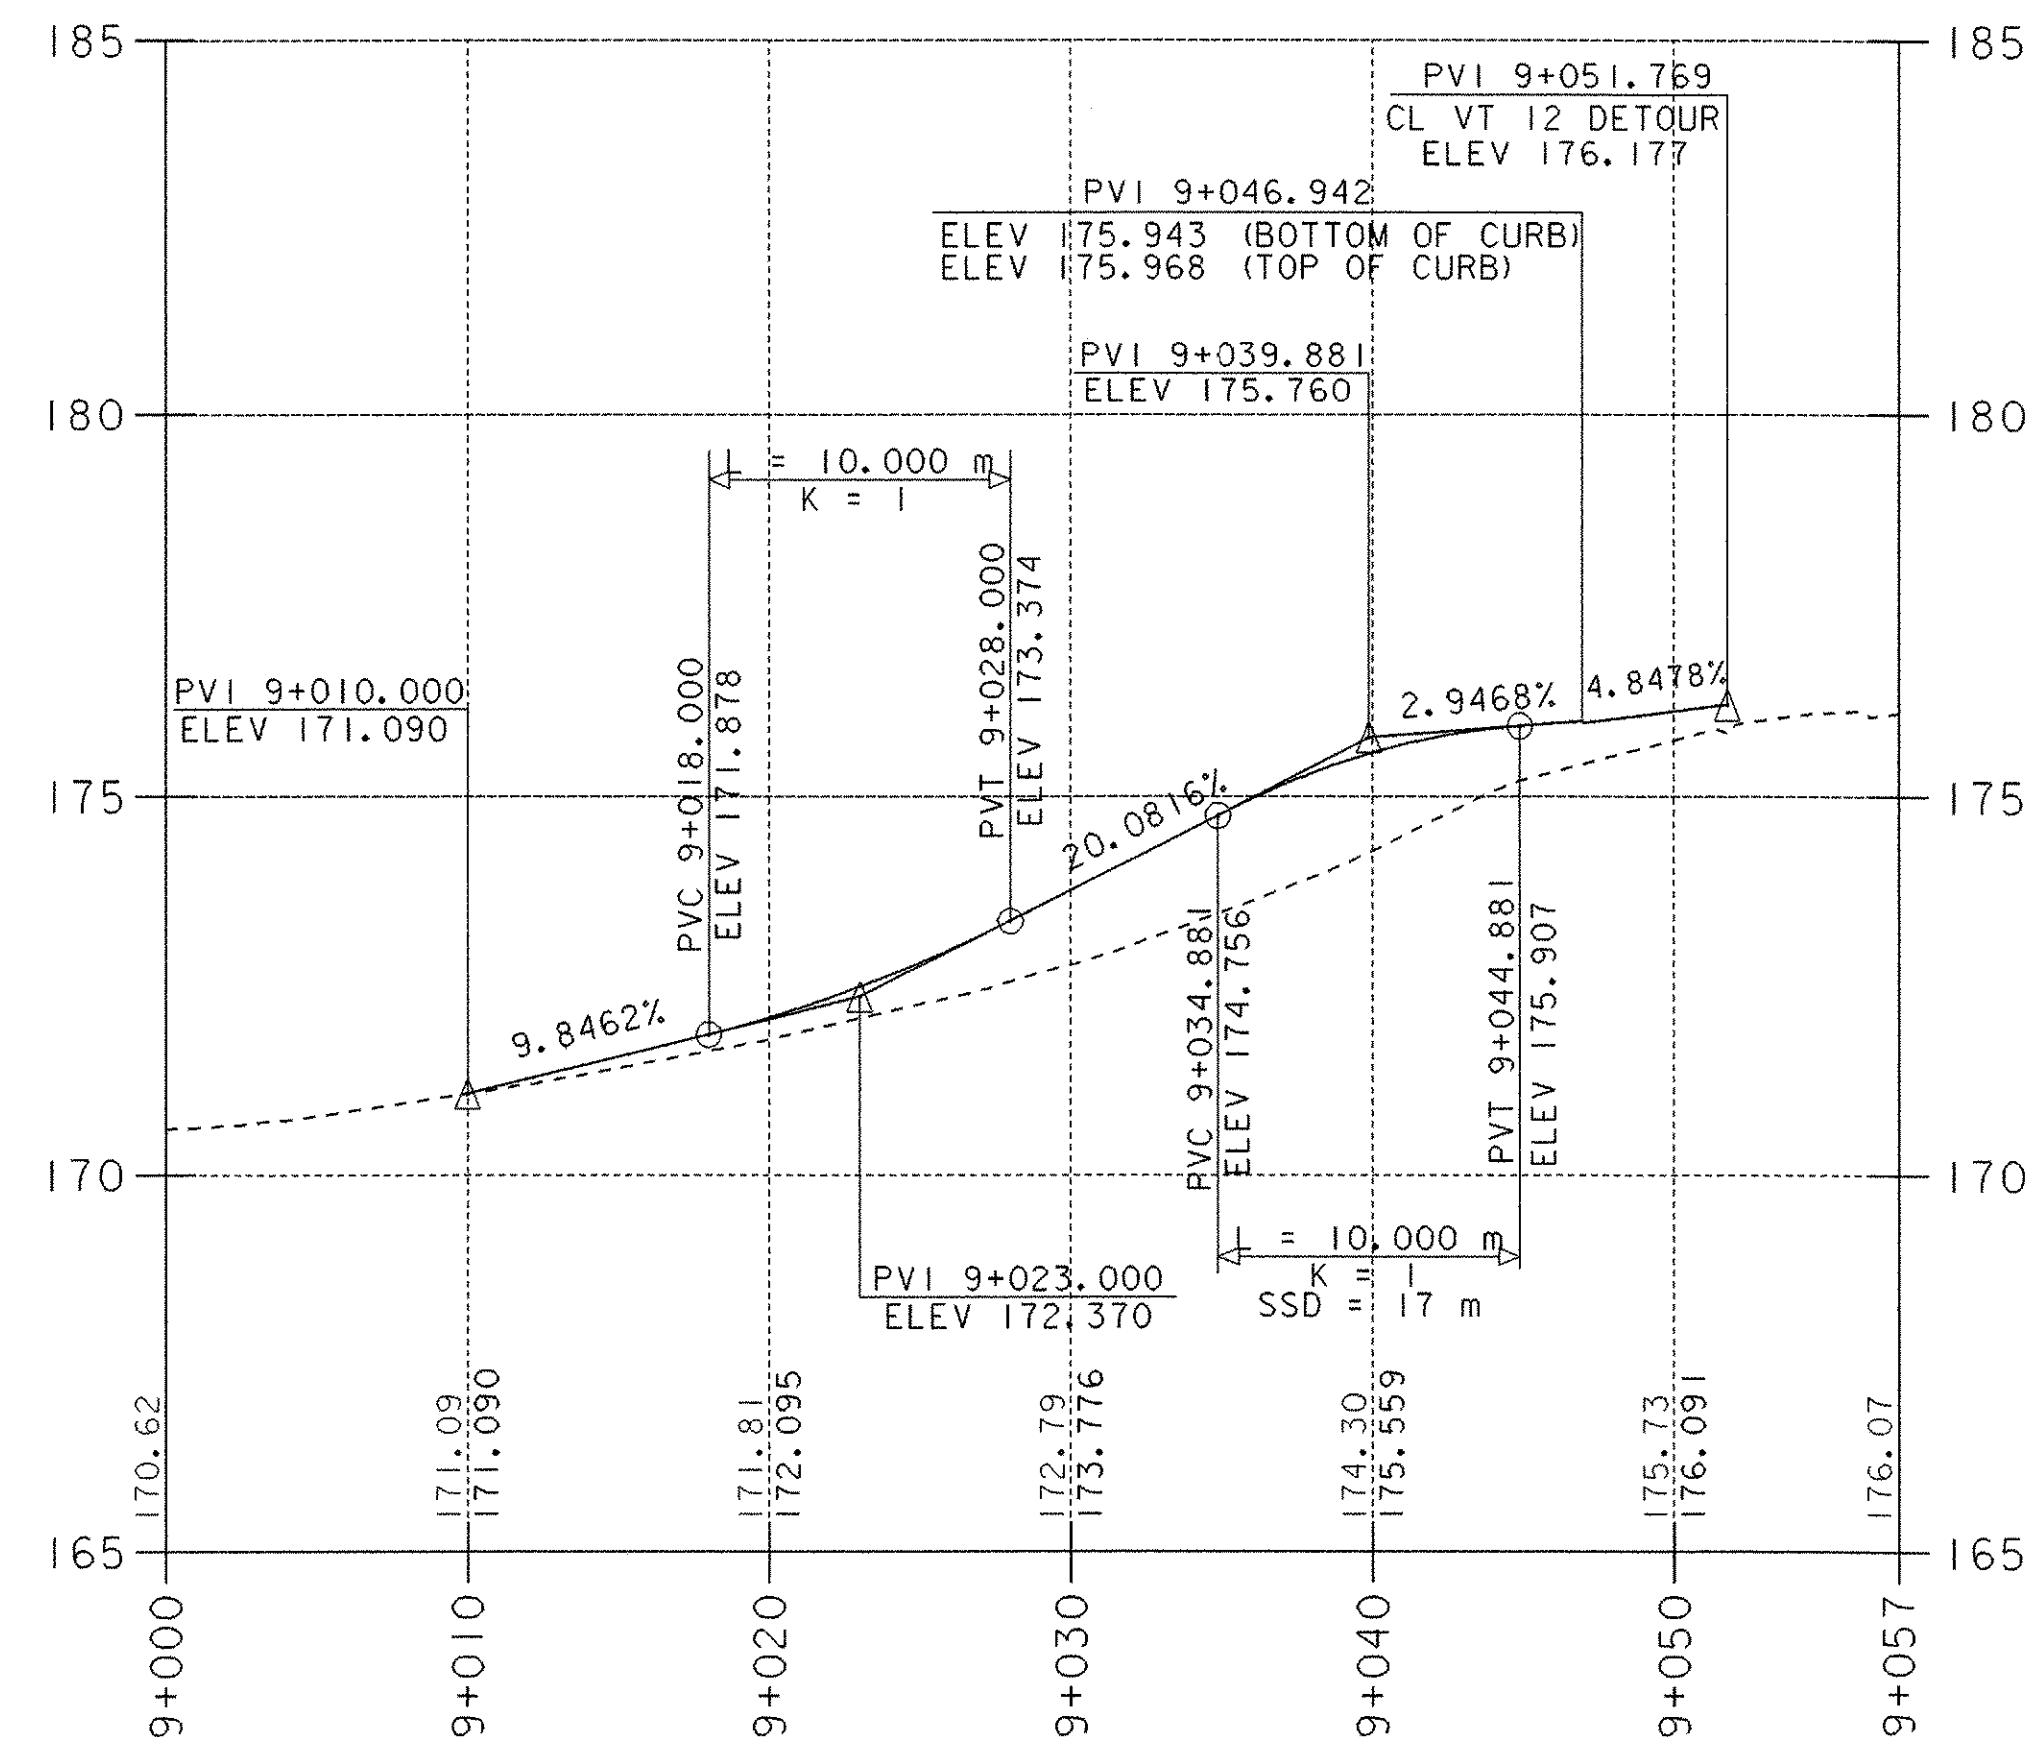

**Profile Bethel Mills Drive**

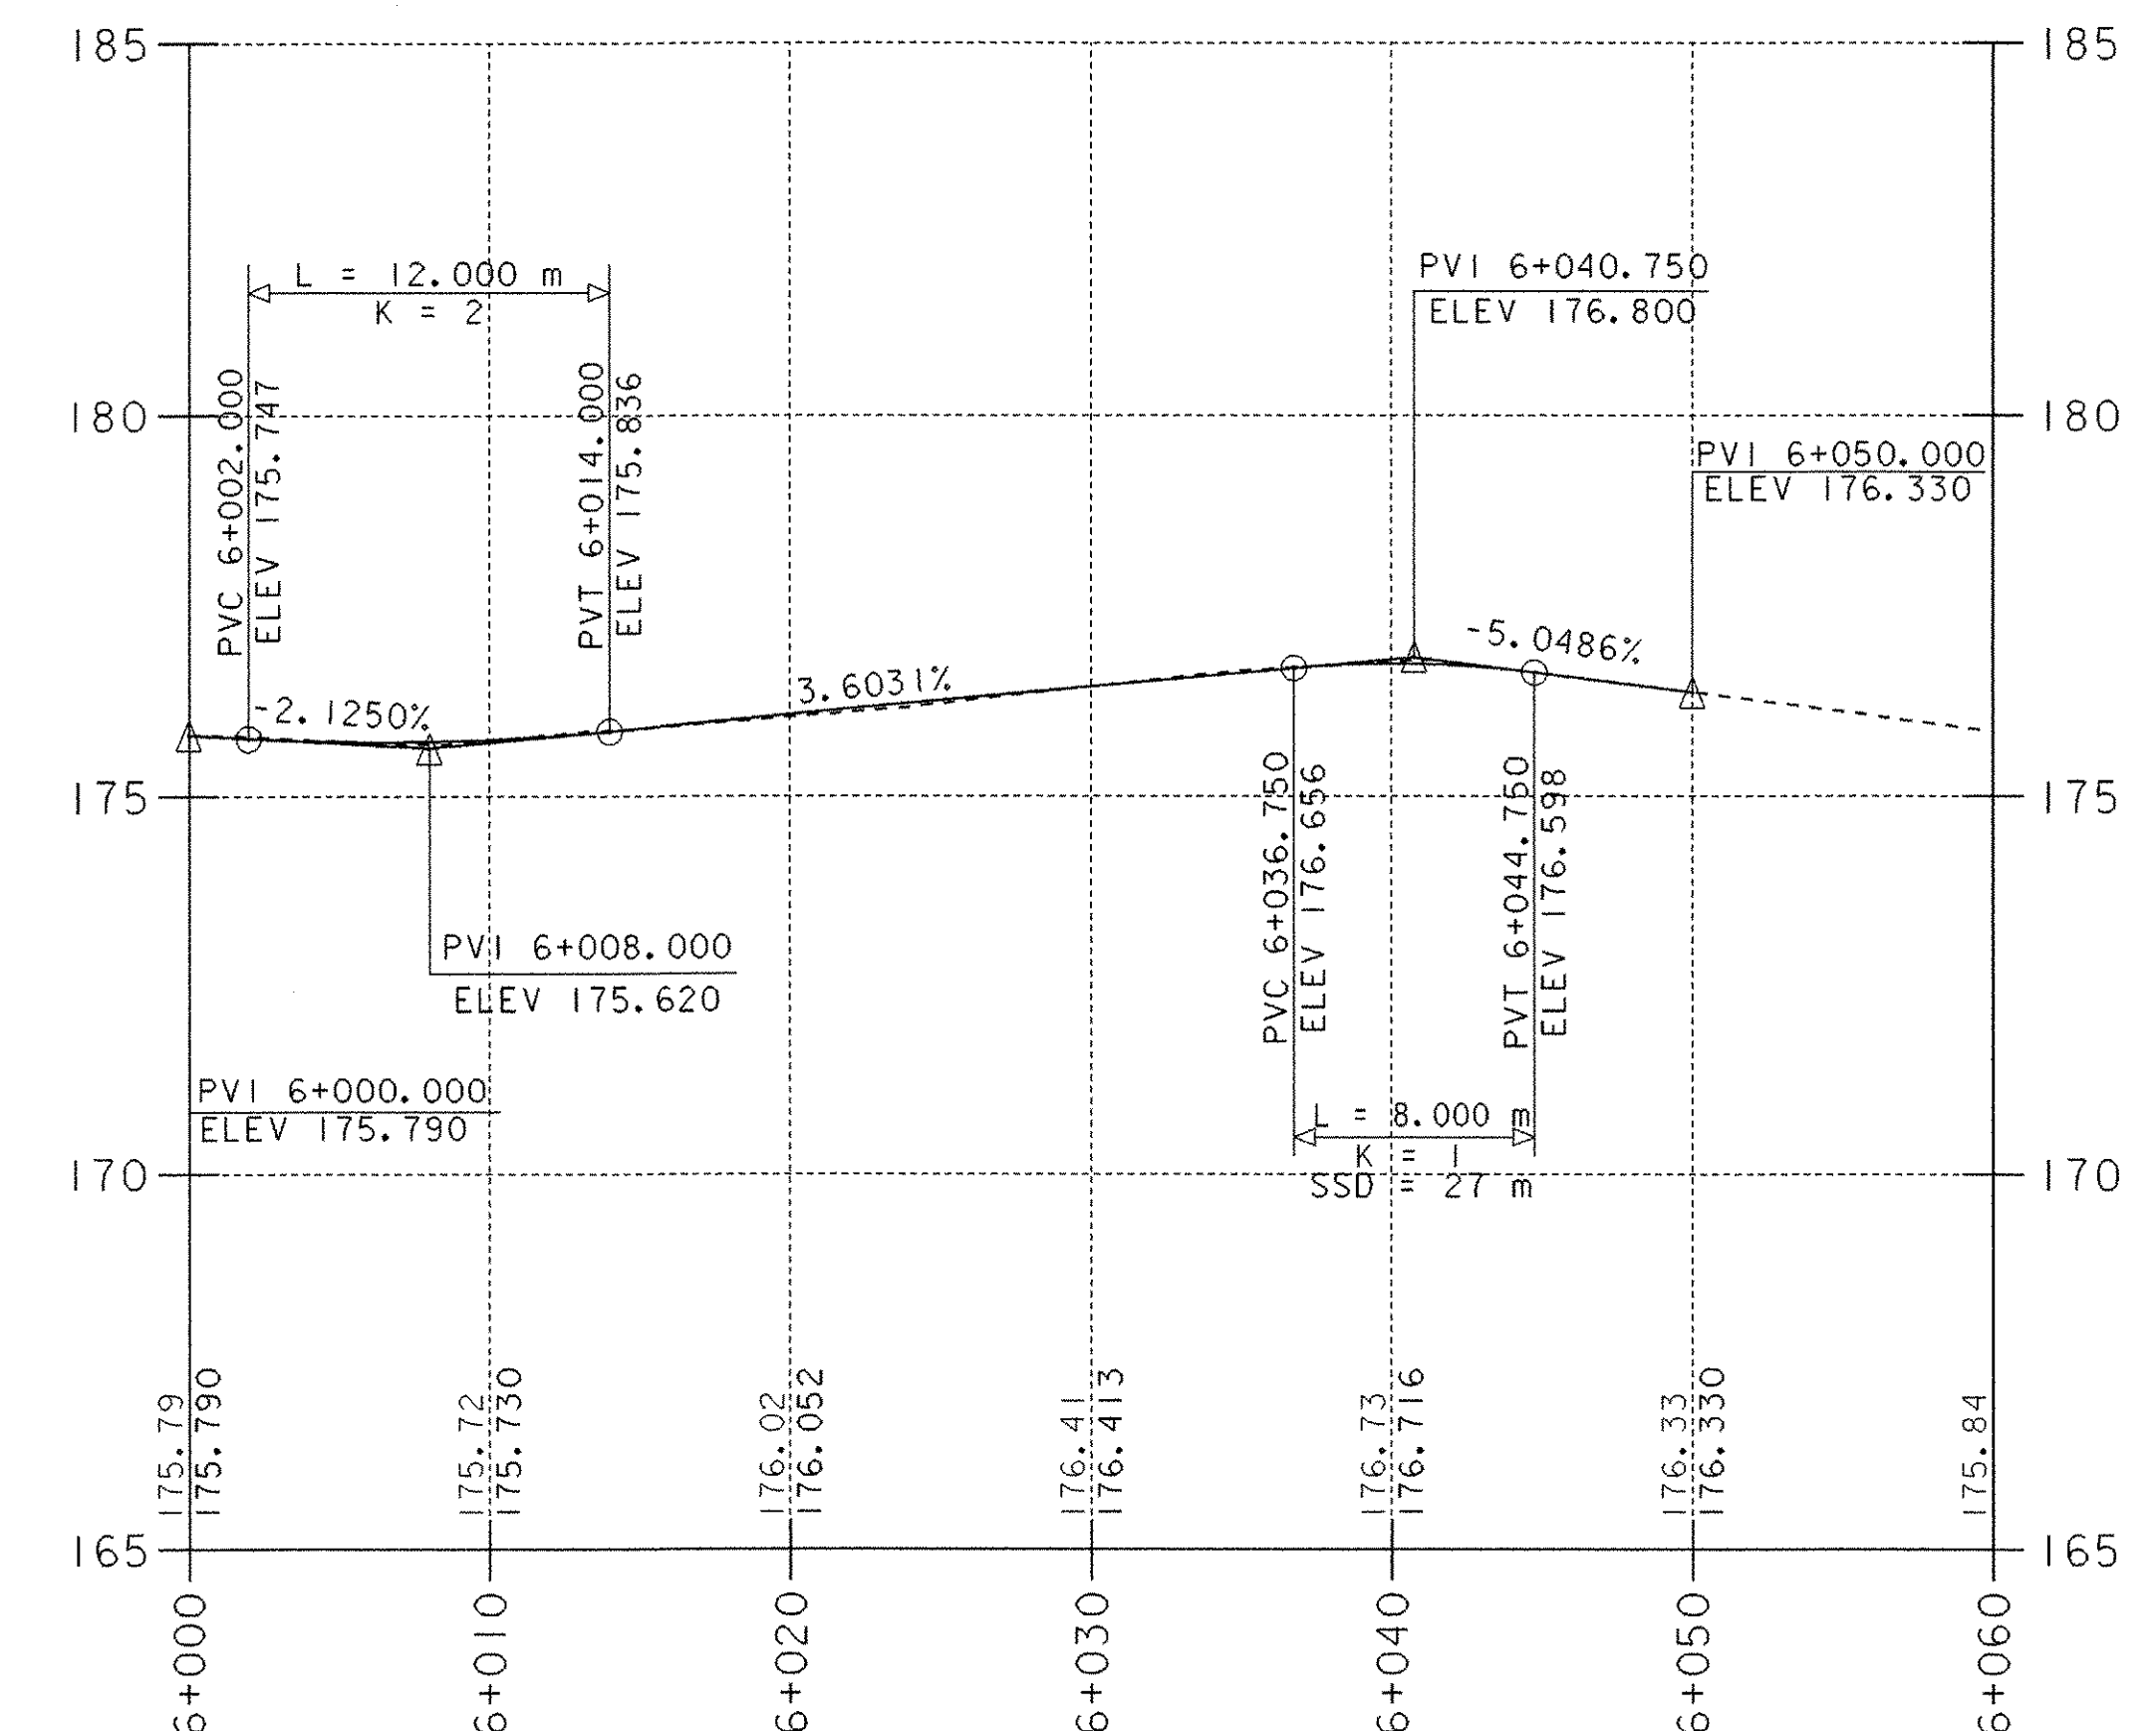


**Profile Along TH 5**

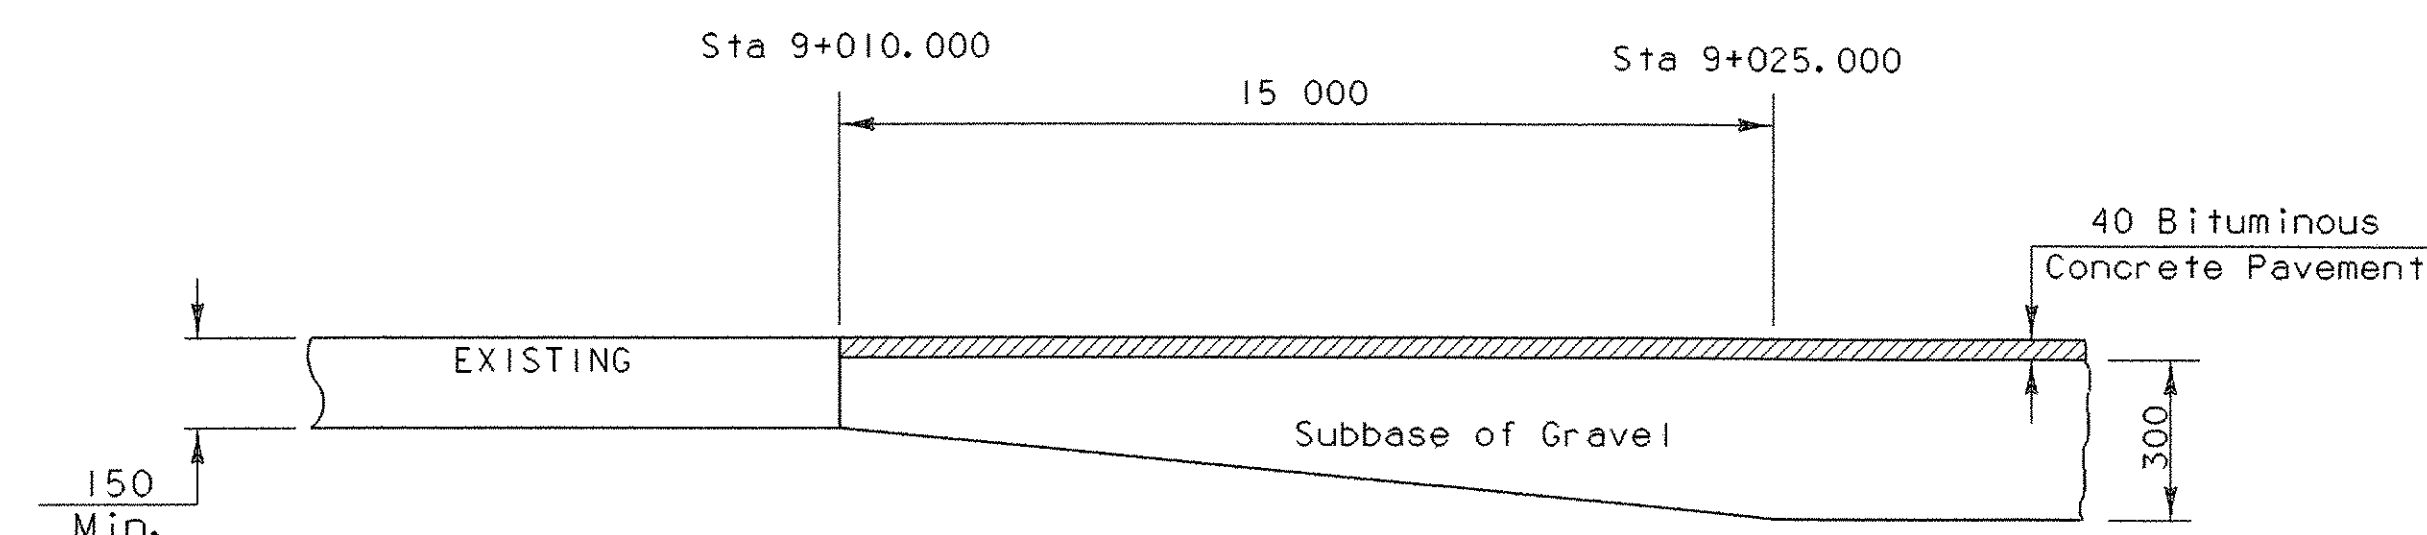

**SUBBASE TAPER BETHEL MILLS DRIVE**


NTS

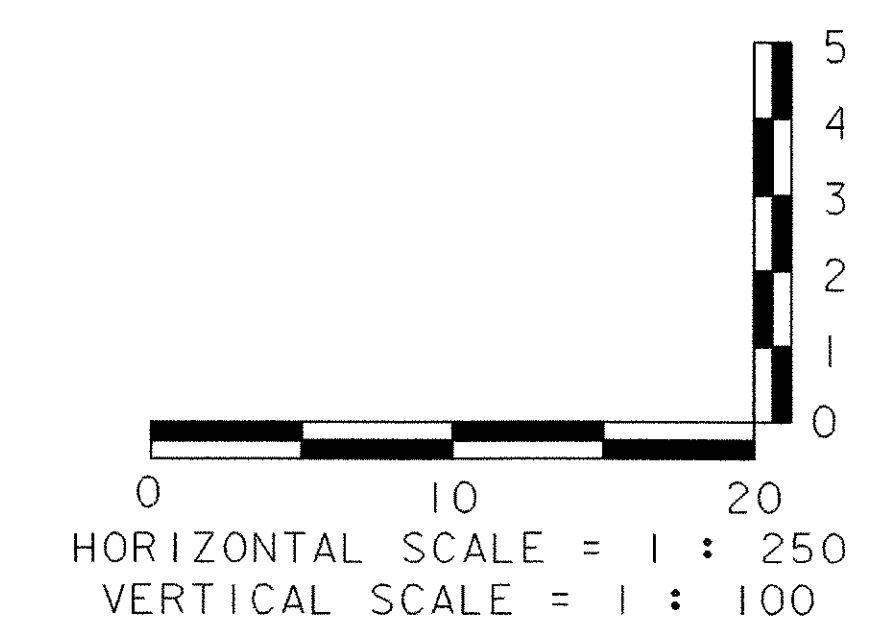

| DATUM      |           |
|------------|-----------|
| VERTICAL   | NAVD 88   |
| HORIZONTAL | NAD 83/92 |

|                                                       |                        |
|-------------------------------------------------------|------------------------|
| PROJECT:                                              | PROJECT NO. :          |
| BETHEL                                                | BRF 0241 (33) - C1     |
| DESIGN FILE NAME: 96j250/structures/s96j250pro-cl.dgn | PLOT DATE: 09-JUL-2003 |
| IPARM FILE NAME: s96j250pr2-cl.i                      | SURVEY DATE: 10/99     |
| SQUAD LEADER: C. P. WILLIAMS                          | DRAWN BY: KMH          |
| BETHEL MILLS DRIVE & TH5 PROFILE                      | SHEET: 11 OF 47        |



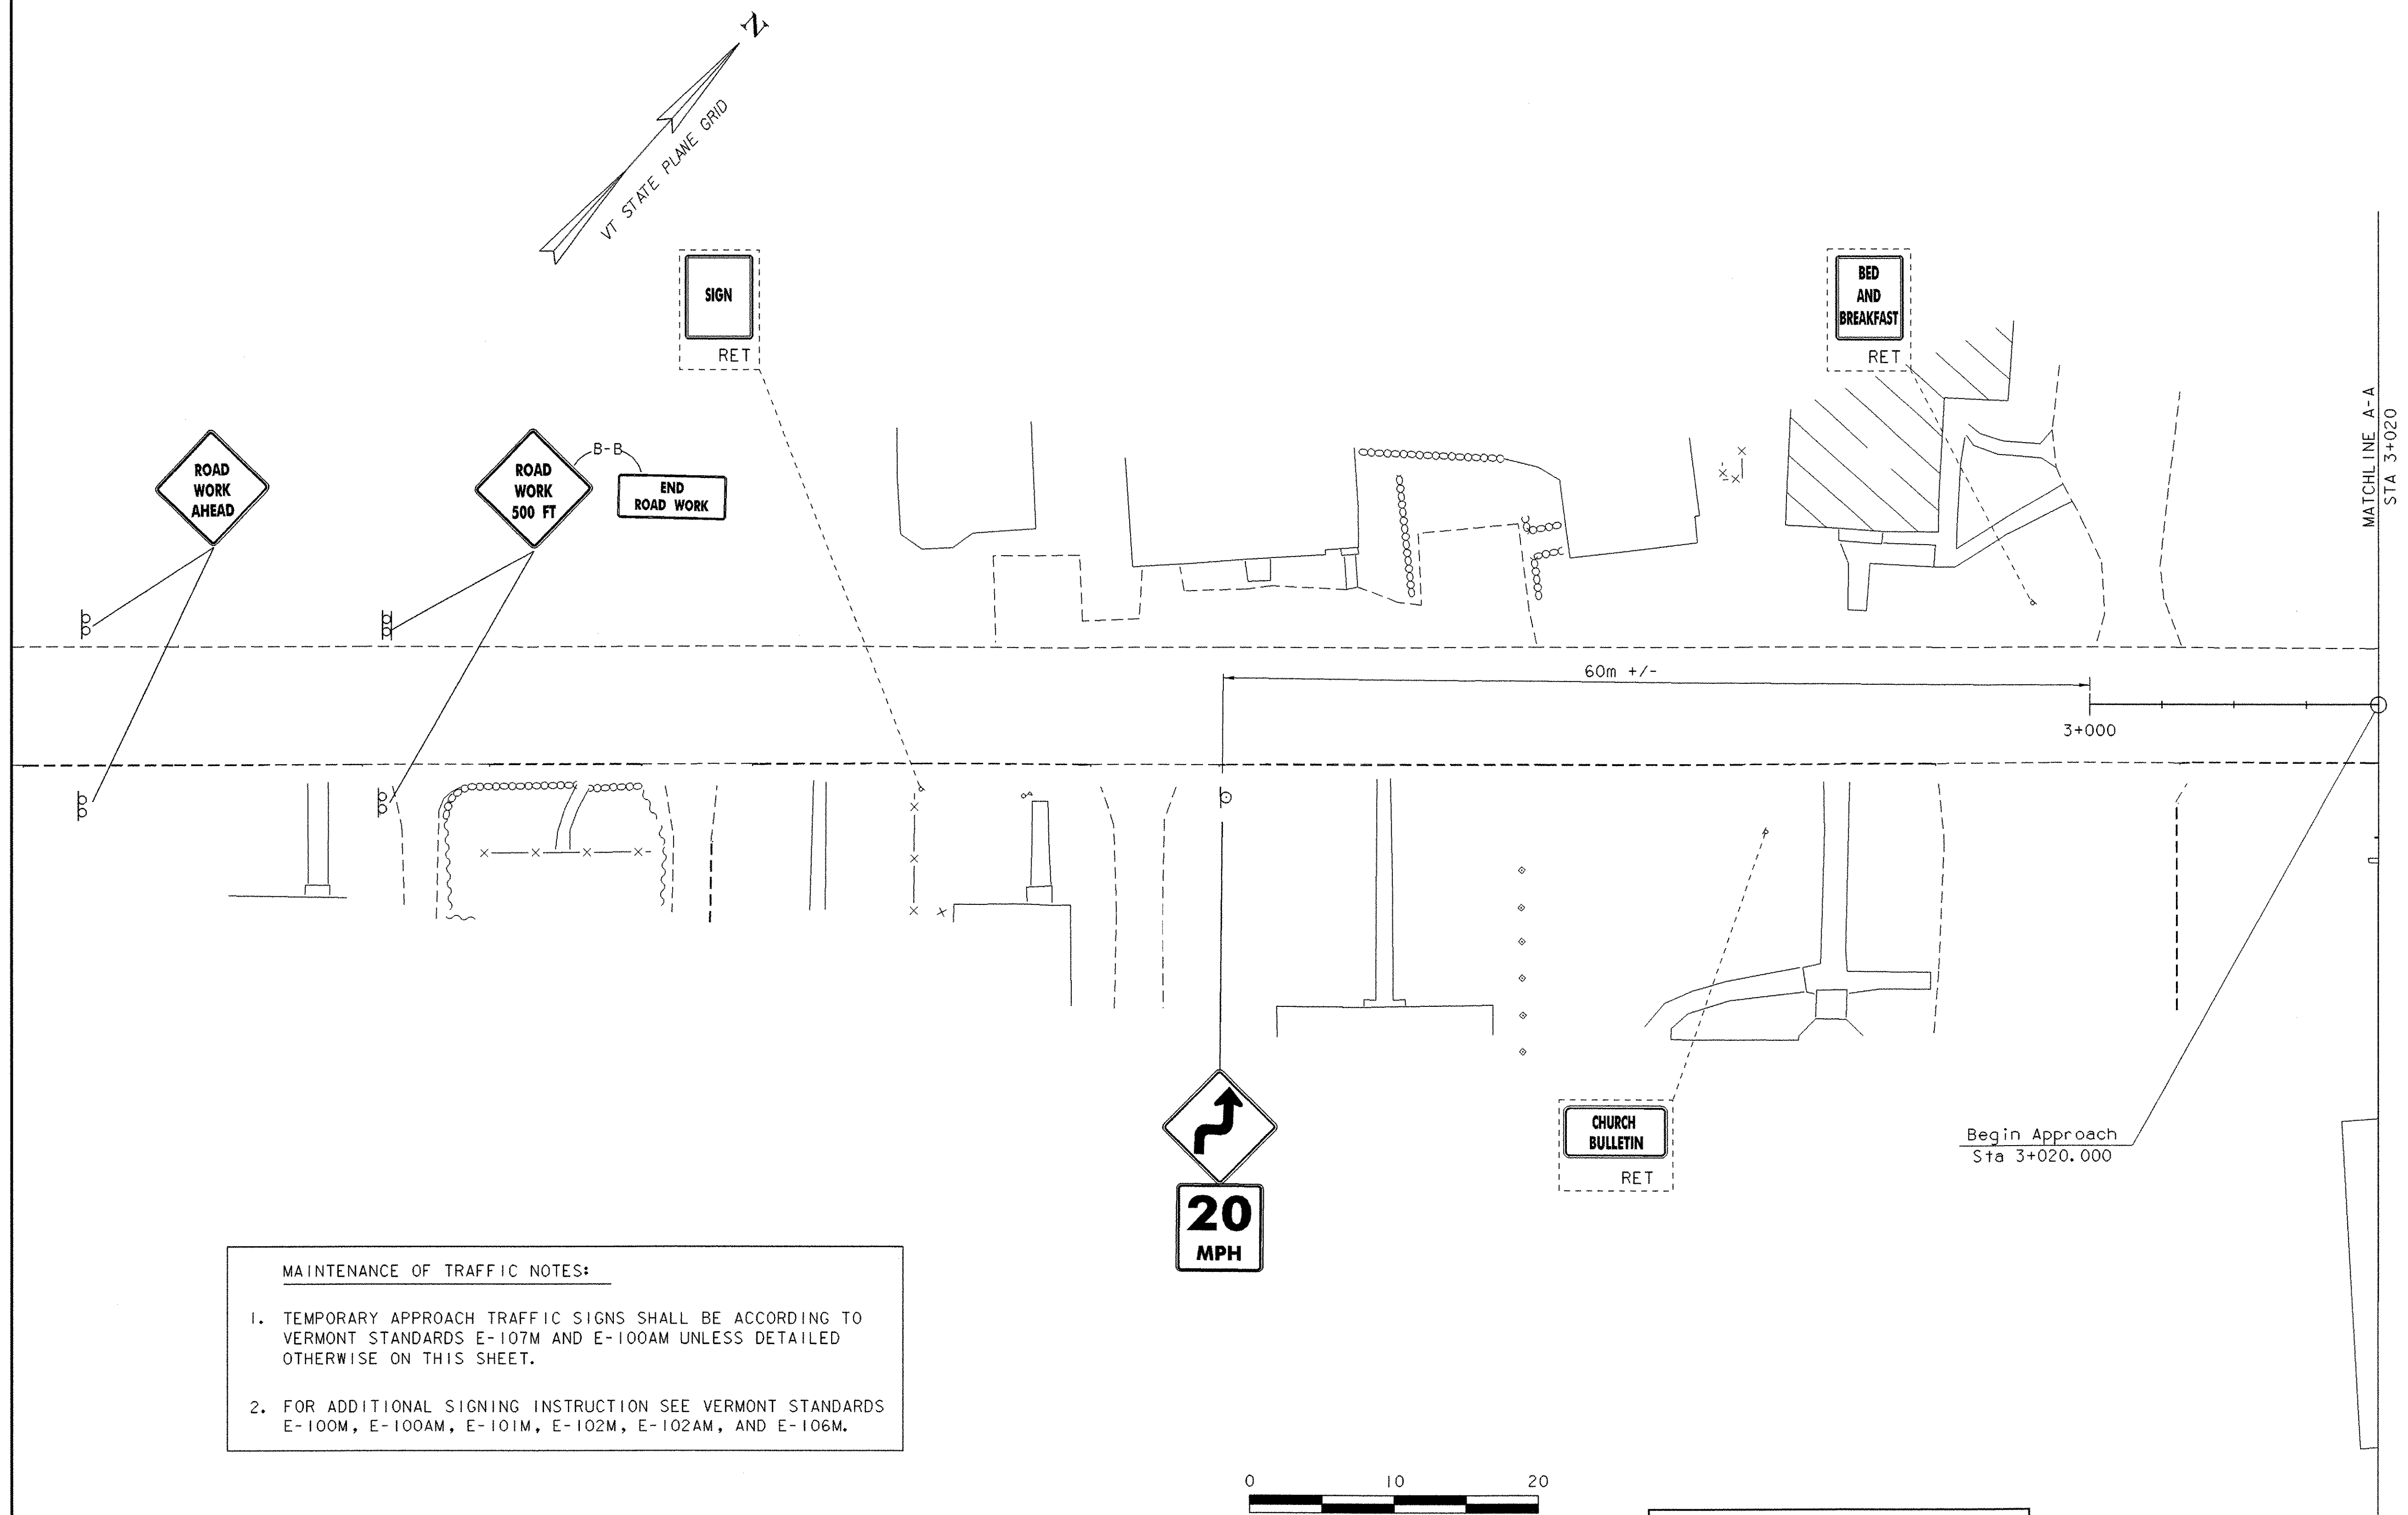

**MAINTENANCE OF TRAFFIC NOTES:**

1. TEMPORARY APPROACH TRAFFIC SIGNS SHALL BE ACCORDING TO VERMONT STANDARDS E-107M AND E-100AM UNLESS DETAILED OTHERWISE ON THIS SHEET.
2. FOR ADDITIONAL SIGNING INSTRUCTION SEE VERMONT STANDARDS E-100M, E-100AM, E-101M, E-102M, E-102AM, AND E-106M.

**SIGN LEGEND**

ALL SIGNS AND POSTS WILL BE NEW UNLESS OTHERWISE NOTED:

R - REMOVE  
R&S - REMOVE & SALVAGE  
S - SALVAGE  
RET - RETAIN

**DATUM**

VERTICAL NAVD 88  
HORIZONTAL NAD 83/92

**PROJECT:**

BETHEL

**PROJECT NO. :**

BRF 0241 (33) - C1

DESIGN FILE NAME: 96j250/structures/s96j250bdr-cl.dgn

IPARM FILE NAME: s96j250trfi-cl.i

SURVEYED BY: ORVIS

SQUAD LEADER: C. P. WILLIAMS

TRAFFIC CONTROL SHEET 1

PLOT DATE: 09-JUL-2003

SURVEY DATE: 10/99



DRAWN BY: T. ANDERSON

SHEET: 12 OF 47





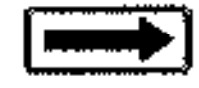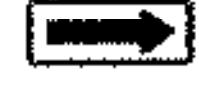

| KILOMETER<br>MARKER,<br>STATION,<br>OR<br>SIGN NUMBER                                                                                                                                                             | SIGN<br>LEGEND                                                                                         | SIGN<br>DIMENSIONS |     | NEW & SALVAGED SIGNS |       |              |             | EXIST<br>POST<br>NO.<br>OF<br>POSTS | NEW SIGN POSTS  |                      |           |    |                            |             |                 |                         |    |     |     |               |     |                              |                         | REMARKS | SIGN DETAIL |              |                                     |                                     |                                                          |          |          |
|-------------------------------------------------------------------------------------------------------------------------------------------------------------------------------------------------------------------|--------------------------------------------------------------------------------------------------------|--------------------|-----|----------------------|-------|--------------|-------------|-------------------------------------|-----------------|----------------------|-----------|----|----------------------------|-------------|-----------------|-------------------------|----|-----|-----|---------------|-----|------------------------------|-------------------------|---------|-------------|--------------|-------------------------------------|-------------------------------------|----------------------------------------------------------|----------|----------|
|                                                                                                                                                                                                                   |                                                                                                        |                    |     | "A"                  | "B"   | SALV<br>SIGN | SALV<br>TIS |                                     | FLANGED CHANNEL | SQUARE STEEL<br>(mm) |           |    | TUBULAR ALUMINUM<br>Ø (mm) |             |                 | TUBULAR STEEL<br>Ø (mm) |    |     |     | W-SHAPE STEEL |     | DETAIL<br>ON SHEET<br>NUMBER | STD.<br>SHEET<br>NUMBER |         |             |              |                                     |                                     |                                                          |          |          |
|                                                                                                                                                                                                                   |                                                                                                        | kg/m               | 44  |                      |       |              |             |                                     |                 | 50                   | 63        | 75 | 100                        | 100<br>MOD. | FOUND-<br>ATION | 75                      | 89 | 100 | 125 | FTG. SIZE     |     |                              |                         |         | WEIGHT      | POST<br>SIZE |                                     |                                     |                                                          |          |          |
|                                                                                                                                                                                                                   |                                                                                                        1.7           | 3.0 |                              |                         |         |             |              | 4.5                                 | 3.4                                 | 3.9                                                      | 5.0      | 1.9      |
|                                                                                                                                                                                                                   |                                                                                                        |                    |     |                      |       |              |             |                                     | OPTION ITEMS    |                      |           | 6+022.3<br><del>6+037.000</del> RT                                                                                                                                                                                |                       | I                  |     |                      |       | I            |             |                                     |                 |                      | X<br>4.27 |    |                            |             |                 |                         |    |     |     |               |     |                              |                         |         |             |              | ERECT SALVAGED SIGN<br>6+022.300 RT |                                     |                                                          |          |          |
| 6+022.3<br><del>6+037.000</del> RT                                                                                                                                                                                |                       | I                  |     |                      |       | I            |             |                                     ERECT SALVAGED SIGN<br>6+022.300 RT |                                     |                                                          |          |          |
| 6+022.3<br><del>6+037.000</del> RT                                                                                                                                                                                |                       | I                  |     |                      |       | I            |             |                                     ERECT SALVAGED SIGN<br>6+022.300 RT |                                     |                                                          |          |          |
| 6+032.4<br><del>6+051.500</del> LT                                                                                                                                                                                |  0120<br>1404<br>0176 | I                  |     |                      |       | 2<br>+       |             |                                     |                 |                      | X<br>3.66 |    |                            |             |                 |                         |    |     |     |               |     |                              |                         |         |             |              | ERECT SALVAGED SIGN<br>6+032.400 LT |                                     |                                                          |          |          |
| 6+032.3<br><del>6+051.500</del> LT                                                                                                                                                                                |                       | I                  |     |                      |       | I            |             |                                     |                 |                      | X<br>3.81 |    |                            |             |                 |                         |    |     |     |               |     |                              |                         |         |             |              | ERECT SALVAGED SIGN<br>6+032.350 LT |                                     |                                                          |          |          |
| 3+190.000 LT                                                                                                                                                                                                      |  REMOVAL              | I                  |     |                      REMOVE SIGN                         |                                     |                                                          |          |          |
| 3+080.000 LT                                                                                                                                                                                                      |                       | I                  | 750 | 750                  | 0.563 |              |             |                                     |                 |                      | X<br>4.45 |    |                            |             |                 |                         |    |     |     |               |     |                              |                         |         |             |              |                                     | W11-2                               |                                                          | E - 152M |          |
| 3+080.000 LT                                                                                                                                                                                                      |                       | I                  | 600 | 200                  | 0.120 |              |             S4 - 3                              |                                                          | E - 153M |          |
| 6+007<br><del>6+030.600</del> RT                                                                                                                                                                                  |                     | I                  |     |                      |       | I            |             |                                     |                 |                      | X<br>4.27 |    |                            |             |                 |                         |    |     |     |               |     |                              |                         |         |             |              |                                     | ERECT SALVAGED SIGN<br>6+007.000 RT |                                                          |          |          |
| 6+007<br><del>6+030.600</del> RT                                                                                                                                                                                  |                     | I                  |     |                      |       | I            |             |                                     ERECT SALVAGED SIGN<br>6+007.000 RT |                                                          |          |          |
| 6+007<br><del>6+030.600</del> RT                                                                                                                                                                                  |                     | I                  |     |                      |       | I            |             |                                     ERECT SALVAGED SIGN<br>6+007.000 RT |                                                          |          |          |
| 6+030.2<br><del>6+050.000</del> LT                                                                                                                                                                                |                     | I                  |     |                      |       | I            |             |                                     |                 |                      | X<br>4.27 |    |                            |             |                 |                         |    |     |     |               |     |                              |                         |         |             |              |                                     | ERECT SALVAGED SIGN<br>6+030.200 LT |                                                          |          |          |
| 6+030.2<br><del>6+050.000</del> LT                                                                                                                                                                                |                     | I                  |     |                      |       | I            |             |                                     ERECT SALVAGED SIGN<br>6+030.200 LT |                                                          |          |          |
| 6+030.2<br><del>6+050.000</del> LT                                                                                                                                                                                |                     | I                  |     |                      |       | I            |             |                                     ERECT SALVAGED SIGN<br>6+030.200 LT |                                                          |          |          |
| 2+940, RT<br><del>SEE LAYOUT<br/>SHEET</del>                                                                                                                                                                      |                     |                    | 750 | 750                  | 0.563 |              |             |                                     |                 |                      | X<br>4.57 |    |                            |             |                 |                         |    |     |     |               |     |                              |                         |         |             |              |                                     |                                     | COLOR SHALL BE BLACK<br>ON REFLECTORIZED YELLOW<br>W1-3R |          | E - 101M |
| 2+940, RT<br><del>SEE LAYOUT<br/>SHEET</del>                                                                                                                                                                      |                     |                    | 450 | 450                  | 0.203 |              |             |                                     |                 |                      | X         |    |                            |             |                 |                         |    |     |     |               |     |                              |                         |         |             |              |                                     |                                     | W13-1                                                    |          | E - 155M |
| 3+209.000 RT                                                                                                                                                                                                      |                     |                    | 600 | 750                  | 0.450 |              |             |                                     |                 |                      | X<br>3.96 |    |                            |             |                 |                         |    |     |     |               |     |                              |                         |         |             |              |                                     |                                     | R2-1                                                     |          | E - 142M |
| FINAL POST LENGTHS ARE TO BE DETERMINED<br>IN THE FIELD. POST SIZES ARE COMPUTED<br>BASED ON INFORMATION FURNISHED ON THE<br>STANDARD SHEETS AND THE TRAFFIC & SAFETY<br>DIVISION'S "SIGN POST DESIGN GUIDELINE." | |






|                                 |                          |              |                       |
|---------------------------------|--------------------------|--------------|-----------------------|
| PROJECT NAME:                   | <b>BETHEL</b>            |              |                       |
| PROJECT NUMBER:                 | <b>BRF 0241 (33)-C1</b>  |              |                       |
| FILE NAME:                      | <b>s96\250drn-c1.xls</b> | PLOT DATE:   | <b>02/11/2003</b>     |
| PROJECT LEADER:                 | <b>C. P. WILLIAMS</b>    | DRAWN BY:    | <b>K. M. HIGGINS</b>  |
| DESIGNED BY:                    | <b>K. M. HIGGINS</b>     | CHECKED BY:  | <b>C. P. WILLIAMS</b> |
| <b>DRAINAGE DETAIL SHEET #1</b> |                          | <b>SHEET</b> | <b>17 OF 47</b>       |



## SOIL CLASSIFICATION

## AASHTO

|    |                                   |
|----|-----------------------------------|
| A1 | Gravel and Sand                   |
| A3 | Fine Sand                         |
| A2 | Silty or Clayey Gravel and Sand   |
| A4 | Silty Soil - Low Compressibility  |
| A5 | Silty Soil - Highly Compressible  |
| A6 | Clayey Soil - Low Compressibility |
| A7 | Clayey Soil - Highly Compressible |

## ROCK QUALITY DESIGNATION

| R.Q.D. (%) | ROCK DESCRIPTION |
|------------|------------------|
| <25        | Very Poor        |
| 25 to 50   | Poor             |
| 51 to 75   | Fair             |
| 76 to 90   | Good             |
| >90        | Excellent        |

## SHEAR STRENGTH

| UNDRAINED SHEAR STRENGTH IN kPa | CONSISTENCY |
|---------------------------------|-------------|
| <12                             | Very Soft   |
| 12-24                           | Soft        |
| 24-48                           | Med. Stiff  |
| 48-96                           | Stiff       |
| 96-192                          | Very Stiff  |
| >192                            | Hard        |

## CORRELATION GUIDE OF "N" TO DENSITY/CONSISTENCY

| DENSITY (GRANULAR SOILS) |                  | CONSISTENCY (COHESIVE SOILS) |                  |
|--------------------------|------------------|------------------------------|------------------|
| N                        | DESCRIPTIVE TERM | N                            | DESCRIPTIVE TERM |
| <5                       | Very Loose       | <2                           | Very Soft        |
| 5-10                     | Loose            | 2-4                          | Soft             |
| 11-24                    | Med. Dense       | 5-8                          | Med. Stiff       |
| 25-50                    | Dense            | 9-15                         | Stiff            |
| >50                      | Very Dense       | 16-30                        | Very Stiff       |
|                          |                  | 31-60                        | Hard             |
|                          |                  | >60                          | Very Hard        |

## COMMONLY USED SYMBOLS

|          |                                                                                                                                                               |
|----------|---------------------------------------------------------------------------------------------------------------------------------------------------------------|
| ▼        | Water Elevation                                                                                                                                               |
| ⊙        | Standard Penetration Boring                                                                                                                                   |
| ⊕        | Auger Boring                                                                                                                                                  |
| ⊖        | Rod Sounding                                                                                                                                                  |
| S        | Sample                                                                                                                                                        |
| N        | Standard Penetration Test<br>Blow Count Per 300 mm For:<br>50.8 mm O.D. Sampler<br>35.0 mm I.D. Sampler<br>Hammer Weight Of 63.5 kg.<br>Hammer Fall Of 762 mm |
| VS       | Field Vane Shear Test                                                                                                                                         |
| US       | Undisturbed Soil Sample                                                                                                                                       |
| B        | Blast                                                                                                                                                         |
| DC       | Diamond Core                                                                                                                                                  |
| MD       | Mud Drill                                                                                                                                                     |
| WA       | Wash Ahead                                                                                                                                                    |
| HSA      | Hollow Stem Auger                                                                                                                                             |
| AX       | Core Size 30.1mm                                                                                                                                              |
| BX       | Core Size 42.0 mm                                                                                                                                             |
| NX       | Core Size 54.7 mm                                                                                                                                             |
| M        | Double Tube Core Barrel Used                                                                                                                                  |
| LL       | Liquid Limit                                                                                                                                                  |
| PL       | Plastic Limit                                                                                                                                                 |
| PI       | Plasticity Index                                                                                                                                              |
| NP       | Non Plastic                                                                                                                                                   |
| w        | Moisture Content (Dry Wgt. Basis)                                                                                                                             |
| D        | Dry                                                                                                                                                           |
| M        | Moist                                                                                                                                                         |
| MTW      | Moist To Wet                                                                                                                                                  |
| W        | Wet                                                                                                                                                           |
| Sat      | Saturated                                                                                                                                                     |
| Bo       | Boulder                                                                                                                                                       |
| Gr       | Gravel                                                                                                                                                        |
| Sa       | Sand                                                                                                                                                          |
| Si       | Silt                                                                                                                                                          |
| Cl       | Clay                                                                                                                                                          |
| HP       | Hardpan                                                                                                                                                       |
| Le       | Ledge                                                                                                                                                         |
| NLTD     | No Ledge To Depth                                                                                                                                             |
| CNPF     | Can Not Penetrate Further                                                                                                                                     |
| TLOB     | To Ledge Or Boulder                                                                                                                                           |
| NR       | No Recovery                                                                                                                                                   |
| Rec.     | Recovery                                                                                                                                                      |
| 1/2 Rec. | Percent Recovery                                                                                                                                              |
| RQD      | Rock Quality Designation                                                                                                                                      |
| CBR      | California Bearing Ratio                                                                                                                                      |
| <        | Less Than                                                                                                                                                     |
| >        | Greater Than                                                                                                                                                  |
| R        | Refusal (N > 100)                                                                                                                                             |

## COLOR

|     |        |      |              |
|-----|--------|------|--------------|
| blk | Black  | pnk  | Pink         |
| bl  | Blue   | pu   | Purple       |
| brn | Brown  | rd   | Red          |
| dk  | Dark   | tn   | Tan          |
| gry | Gray   | wh   | White        |
| gn  | Green  | yel  | Yellow       |
| lt  | Light  | mltc | Multicolored |
| or  | Orange |      |              |

## DEFINITIONS (AASHTO)

**BEDROCK (LEDGE)** - Rock in its native location of indefinite thickness.

**BOULDER** - A rock fragment with an average dimension > 304.8 mm.

**COBBLE** - Rock fragments with an average dimension between 76.2 and 304.8 mm.

**GRAVEL** - Rounded particles of rock < 76.2 mm and > 2 mm (#10 sieve).

**SAND** - Particles of rock < 2 mm (#10 sieve) and > 75 µm (#200 sieve).

**SILT** - Soil < 75 µm (#200 sieve), non or slightly plastic and exhibits no strength when air-dried.

**CLAY** - Fine grained soil, exhibits plasticity when moist and considerable strength when air-dried.

**VARVED** - Alternate layers of silt and clay.

**HARDPAN** - Extremely dense soil, cemented layer, not softened when wet.


**MUCK** - Soft organic soil (containing > 10% organic material).

**MOISTURE CONTENT** - Weight of water divided by dry weight of soil.

**FLOWING SAND** - Granular soil so saturated (loose) that it flows into drill casing during extraction of wash rod.

**STRIKE** - Angle from magnetic north to line of intersection of bed with a horizontal plane.

**DIP** - Inclination of bed with a horizontal plane.

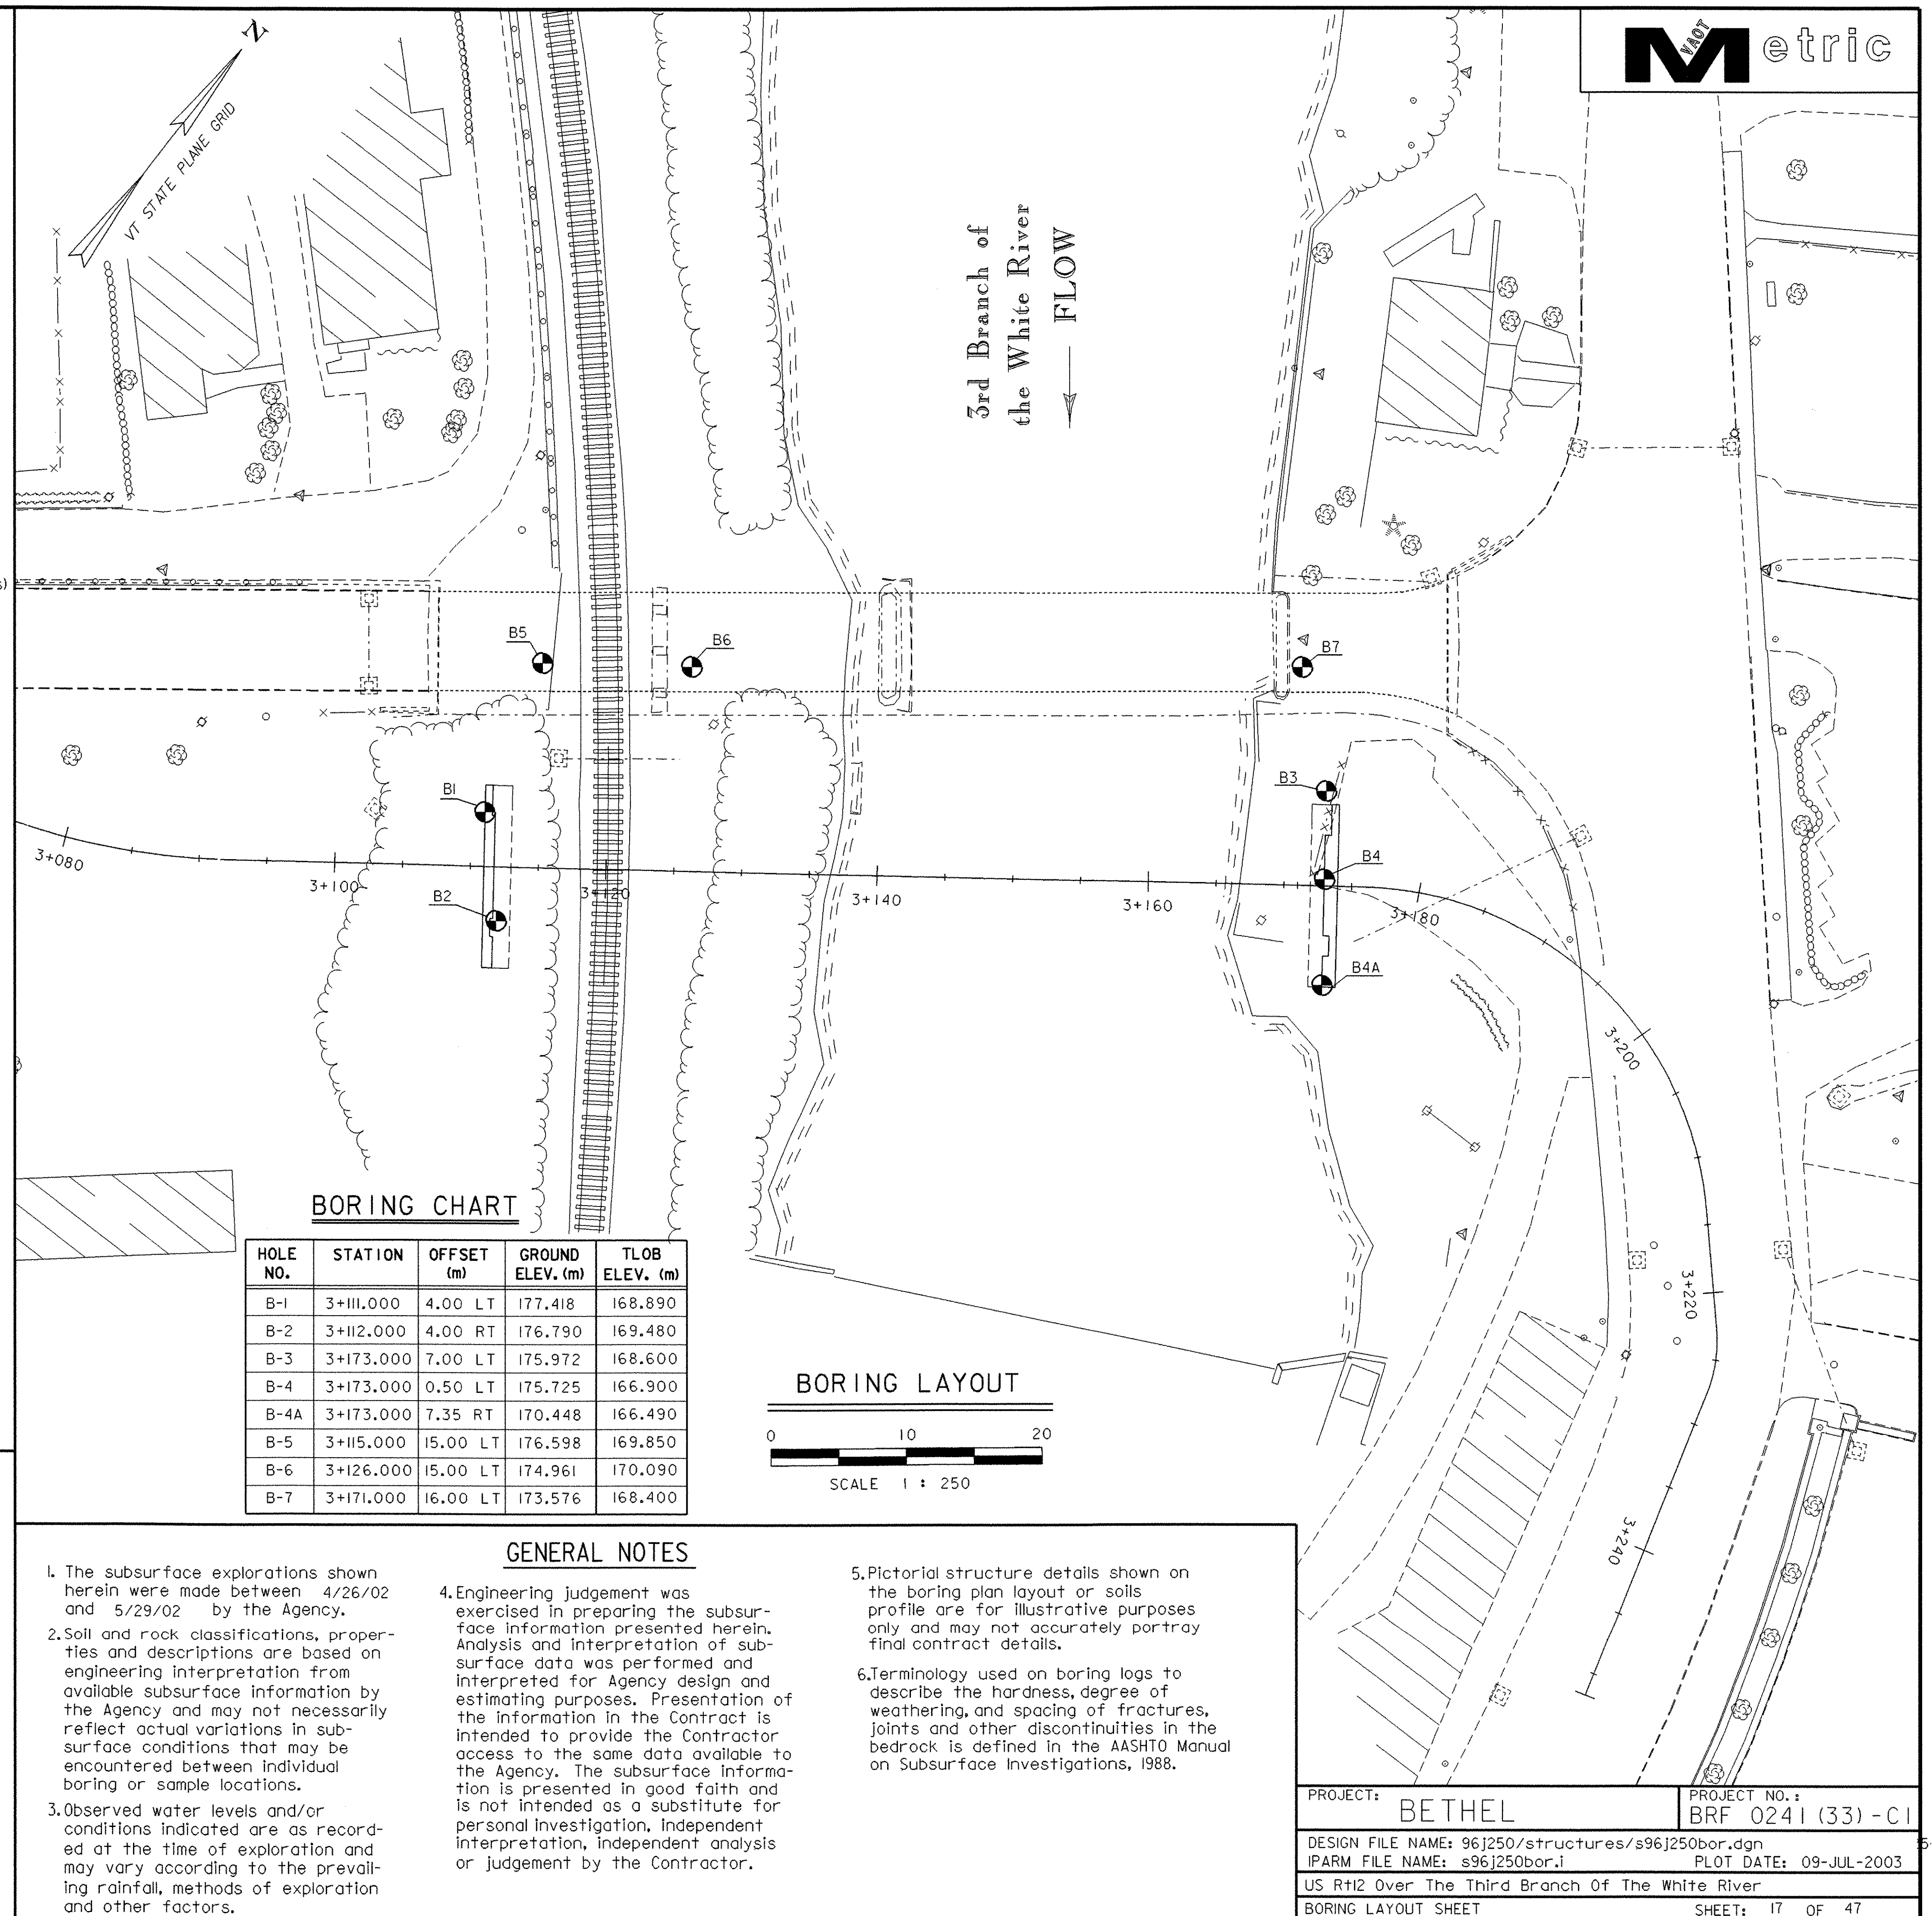



| STATE OF VERMONT<br>AGENCY OF TRANSPORTATION<br>MATERIALS & RESEARCH DIVISION<br>SUBSURFACE INFORMATION                                                                                                 |        |                                                                         |                       |           |                                                                                                   |           |            |    |    |
|---------------------------------------------------------------------------------------------------------------------------------------------------------------------------------------------------------|--------|-------------------------------------------------------------------------|-----------------------|-----------|---------------------------------------------------------------------------------------------------|-----------|------------|----|----|
| PROJECT NAME: BETHEL<br>SITE NAME: BR 31<br>STATION: 3+110.00<br>GROUND EL.: 177.418                                                                                                                    |        |                                                                         |                       |           | HOLE NO.: B-1<br>SHEET 1 OF 1<br>DATE STARTED: 5/23/02<br>DATE COMPLETED: 5/28/02                 |           |            |    |    |
| BORING CREW<br>CREW CHIEF: TALLMAN<br>DRILLER: YOUNG<br>LOGGER: SOMERS<br>ADDITIONAL CREW:                                                                                                              |        |                                                                         |                       |           | PROJECT NUMBER: BRF 0241(33) C/1<br>SITE NO.: VT 12<br>OFFSET: -4.00<br>G.W. DEPTH: Hole caved in |           |            |    |    |
| DEPTH                                                                                                                                                                                                   | SYMBOL | CLASSIFICATION OF MATERIALS<br>(Description)                            | BLOWS<br>PER<br>0.3 m | M.C.<br>% | GRAVEL<br>%                                                                                       | SAND<br>% | FINES<br>% | LL | PI |
|                                                                                                                                                                                                         |        | A-2-4, SiSa, brn-gry, Moist,<br>Rec. = 0.33m                            | 4                     | 16.9      | 10                                                                                                | 66.4      | 23.6       |    |    |
|                                                                                                                                                                                                         |        | A-4, SaSi, gry, Moist,<br>Rec. = 0.50m                                  | 18                    | 22        | 1.4                                                                                               | 30.5      | 68.1       |    |    |
|                                                                                                                                                                                                         |        | A-4, SaSi, gry, Moist,<br>Rec. = 0.56m                                  | 51                    | 12.8      | 16                                                                                                | 35.5      | 48.5       |    |    |
|                                                                                                                                                                                                         |        | BXMD, 5.48m-6.04m, Broke<br>through Boulder                             |                       |           |                                                                                                   |           |            |    |    |
|                                                                                                                                                                                                         |        | BXMD, 6.24m-6.84m, Broke<br>through Boulder                             |                       |           |                                                                                                   |           |            |    |    |
|                                                                                                                                                                                                         |        | A-2-4, SiSaGr, gry, Moist,<br>Rec. = 0.10m                              | R                     | 11.5      | 37.4                                                                                              | 35.4      | 27.2       |    |    |
|                                                                                                                                                                                                         |        | BXMD, 7.80m-8.10m, Broke<br>through Boulder                             |                       |           |                                                                                                   |           |            |    |    |
|                                                                                                                                                                                                         |        | Run#1: BXMD, 8.53m-10.05m,<br>Rec. = 1.52m,<br>See Geologist's Report.  | RUN                   | REC%      | RODZ                                                                                              | Dip°      |            |    |    |
|                                                                                                                                                                                                         |        |                                                                         | 1                     | 100       | 80                                                                                                | 50        |            |    |    |
|                                                                                                                                                                                                         |        | Run#2: BXMD, 10.05m-11.57m,<br>Rec. = 1.52m,<br>See Geologist's Report. | 2                     | 100       | 95                                                                                                | 50        |            |    |    |
| Hole stopped @ 11.57m                                                                                                                                                                                   |        |                                                                         |                       |           |                                                                                                   |           |            |    |    |
| Driller's Notes:<br>1. No ground water elevation. Hole caved in. 05/28/02<br>2. Moved hole 1.00m to the west.                                                                                           |        |                                                                         |                       |           |                                                                                                   |           |            |    |    |
| GEOLOGIST'S REPORT:<br><br>Run#1: Light gray hornblende gneiss, Hard to very hard,<br>Unweathered, Competent.<br><br>Run#2: Light gray hornblende gneiss, Hard to very hard,<br>Unweathered, Competent. |        |                                                                         |                       |           |                                                                                                   |           |            |    |    |

| STATE OF VERMONT<br>AGENCY OF TRANSPORTATION<br>MATERIALS & RESEARCH DIVISION<br>SUBSURFACE INFORMATION                                                                                     |        |                                                                        |                       |           |                                                                                    |           |            |    |    |
|---------------------------------------------------------------------------------------------------------------------------------------------------------------------------------------------|--------|------------------------------------------------------------------------|-----------------------|-----------|------------------------------------------------------------------------------------|-----------|------------|----|----|
| PROJECT NAME: BETHEL<br>SITE NAME: BR 31<br>STATION: 3+112.00<br>GROUND EL.: 176.790                                                                                                        |        |                                                                        |                       |           | HOLE NO.: B-2<br>SHEET 1 OF 1<br>DATE STARTED: 5/21/02<br>DATE COMPLETED: 5/21/02  |           |            |    |    |
| BORING CREW<br>CREW CHIEF: TALLMAN<br>DRILLER: TALLMAN<br>LOGGER: SOMERS<br>ADDITIONAL CREW:                                                                                                |        |                                                                        |                       |           | PROJECT NUMBER: BRF 0241(33) C/1<br>SITE NO.: VT 12<br>OFFSET: 4.00<br>G.W. DEPTH: |           |            |    |    |
| DEPTH                                                                                                                                                                                       | SYMBOL | CLASSIFICATION OF MATERIALS<br>(Description)                           | BLOWS<br>PER<br>0.3 m | M.C.<br>% | GRAVEL<br>%                                                                        | SAND<br>% | FINES<br>% | LL | PI |
|                                                                                                                                                                                             |        | A-4, SiSa, Lt/gry, Moist,<br>Rec. = 0.40m                              | 16                    | 13.3      | 2.2                                                                                | 51.6      | 46.2       |    |    |
|                                                                                                                                                                                             |        | A-4, SiSa, brn-gry, Moist,<br>Rec. = 0.28m                             | 47                    | 24.8      | 0.2                                                                                | 61.8      | 38         |    |    |
|                                                                                                                                                                                             |        | A-4, SiSa, brn-gry, Moist,<br>Rec. = 0.30m                             | 42                    | 21.5      |                                                                                    | 56.1      | 43.9       |    |    |
|                                                                                                                                                                                             |        | A-2-4, SiGrSa, gry, Moist,<br>Rec. = 0.25m                             | R                     | 12.7      | 35.1                                                                               | 39.2      | 25.7       |    |    |
|                                                                                                                                                                                             |        | Broken Rock or Possible<br>Ledge at 6.40m                              |                       |           |                                                                                    |           |            |    |    |
|                                                                                                                                                                                             |        | Run#1: BXMD, 7.31m-8.83m,<br>Rec. = 1.23m,<br>See Geologist's Report.  | RUN                   | REC%      | RODZ                                                                               | Dip°      |            |    |    |
|                                                                                                                                                                                             |        |                                                                        | 1                     | 81        | 70                                                                                 | 50        |            |    |    |
|                                                                                                                                                                                             |        | Run#2: BXMD, 8.83m-10.35m,<br>Rec. = 1.52m,<br>See Geologist's Report. | 2                     | 100       | 95                                                                                 | 50        |            |    |    |
| Hole stopped @ 10.35m                                                                                                                                                                       |        |                                                                        |                       |           |                                                                                    |           |            |    |    |
| GEOLOGIST'S REPORT:<br><br>Run#1: Gray hornblende gneiss, Hard to very hard,<br>Unweathered, Competent.<br><br>Run#2: Gray hornblende gneiss, Hard to very hard,<br>Unweathered, Competent. |        |                                                                        |                       |           |                                                                                    |           |            |    |    |

| STATE OF VERMONT<br>AGENCY OF TRANSPORTATION<br>MATERIALS & RESEARCH DIVISION<br>SUBSURFACE INFORMATION                                                                      |        |                                                                                    |                       |           |                                                                                     |           |            |    |    |
|------------------------------------------------------------------------------------------------------------------------------------------------------------------------------|--------|------------------------------------------------------------------------------------|-----------------------|-----------|-------------------------------------------------------------------------------------|-----------|------------|----|----|
| PROJECT NAME: BETHEL<br>SITE NAME: BR 31<br>STATION: 3+173.00<br>GROUND EL.: 175.972                                                                                         |        |                                                                                    |                       |           | HOLE NO.: B-3<br>SHEET 1 OF 1<br>DATE STARTED: 4/26/02<br>DATE COMPLETED: 4/26/02   |           |            |    |    |
| BORING CREW<br>CREW CHIEF: TALLMAN<br>DRILLER: TALLMAN<br>LOGGER: SOMERS<br>ADDITIONAL CREW:                                                                                 |        |                                                                                    |                       |           | PROJECT NUMBER: BRF 0241(33) C/1<br>SITE NO.: VT 12<br>OFFSET: -7.00<br>G.W. DEPTH: |           |            |    |    |
| DEPTH                                                                                                                                                                        | SYMBOL | CLASSIFICATION OF MATERIALS<br>(Description)                                       | BLOWS<br>PER<br>0.3 m | M.C.<br>% | GRAVEL<br>%                                                                         | SAND<br>% | FINES<br>% | LL | PI |
|                                                                                                                                                                              |        | A-2-4, SiSa, brn, Moist,<br>Rec. = 0.29m                                           | 2                     | 17.9      | 14                                                                                  | 62.4      | 23.6       |    |    |
|                                                                                                                                                                              |        | A-2-4, Sa, brn, Moist,<br>Rec. = 0.18m                                             | 4                     | 16.5      | 7.6                                                                                 | 72.6      | 19.8       |    |    |
|                                                                                                                                                                              |        | A-2-4, SiSa, brn, Moist,<br>Rec. = 0.28m                                           | 2                     | 17.2      | 8.4                                                                                 | 67.6      | 24         |    |    |
|                                                                                                                                                                              |        | Visual Class: Broken Brick,<br>red, Dry, Rec. = 0.31m                              | 8                     | 24.8      |                                                                                     |           |            |    |    |
|                                                                                                                                                                              |        | Visual Class: Various Fill<br>Material, red-brn, Moist,<br>Rec. = 0.22m            | 10                    | 13.9      |                                                                                     |           |            |    |    |
|                                                                                                                                                                              |        | A-4, SaSi, brn, Moist,<br>Rec. = 0.53m                                             | 2                     | 29.3      | 12.3                                                                                | 41.1      | 46.6       |    |    |
|                                                                                                                                                                              |        | A-4, SaSi, brn, Moist, Rec. 0.11m<br>VC: Weathered Rock, gry, Dry,<br>Rec. = 0.11m | 32.7<br>13.7          | 0.1       | 46                                                                                  | 53.9      |            |    |    |
|                                                                                                                                                                              |        | Run#1: BXDC, 7.37m-8.87m,<br>Rec. = 1.47m,<br>See Geologist's Report.              | RUN                   | REC%      | RODZ                                                                                | Dip°      |            |    |    |
|                                                                                                                                                                              |        |                                                                                    | 1                     | 98        | 56                                                                                  | 40        |            |    |    |
|                                                                                                                                                                              |        | Run#2: BXDC, 8.87m-10.37m,<br>Rec. = 1.42m,<br>See Geologist's Report.             | 2                     | 95        | 52                                                                                  | 40        |            |    |    |
| Hole stopped @ 10.37m                                                                                                                                                        |        |                                                                                    |                       |           |                                                                                     |           |            |    |    |
| GEOLOGIST'S REPORT:<br><br>Run#1: Light gray hornblende gneiss, Hard to very hard, Unweathered,<br>Competent.<br><br>Run#2: Same as Run#1, but with quartz veins, Competent. |        |                                                                                    |                       |           |                                                                                     |           |            |    |    |


| STATE OF VERMONT<br>AGENCY OF TRANSPORTATION<br>MATERIALS & RESEARCH DIVISION<br>SUBSURFACE INFORMATION                                                                                                                                     |        |                                                                                       |                       |           |                                                                                                               |           |            |    |    |
|---------------------------------------------------------------------------------------------------------------------------------------------------------------------------------------------------------------------------------------------|--------|---------------------------------------------------------------------------------------|-----------------------|-----------|---------------------------------------------------------------------------------------------------------------|-----------|------------|----|----|
| PROJECT NAME: BETHEL<br>SITE NAME: BR 31<br>STATION: 3+173.00<br>GROUND EL.: 175.725                                                                                                                                                        |        |                                                                                       |                       |           | HOLE NO.: B-4<br>SHEET 1 OF 1<br>DATE STARTED: 4/29/02<br>DATE COMPLETED: 4/29/02                             |           |            |    |    |
| BORING CREW<br>CREW CHIEF: TALLMAN<br>DRILLER: TALLMAN<br>LOGGER: RUSSELL<br>ADDITIONAL CREW:                                                                                                                                               |        |                                                                                       |                       |           | PROJECT NUMBER: BRF 0241(33) C/1<br>SITE NO.: VT 12<br>OFFSET: -0.50<br>G.W. DEPTH: No water found (04/29/02) |           |            |    |    |
| DEPTH                                                                                                                                                                                                                                       | SYMBOL | CLASSIFICATION OF MATERIALS<br>(Description)                                          | BLOWS<br>PER<br>0.3 m | M.C.<br>% | GRAVEL<br>%                                                                                                   | SAND<br>% | FINES<br>% | LL | PI |
|                                                                                                                                                                                                                                             |        | No Rec.                                                                               | 8                     |           |                                                                                                               |           |            |    |    |
|                                                                                                                                                                                                                                             |        | A-3, Sa, brn, Moist,<br>Rec. = 0.23m                                                  | 5                     | 28.1      | 0.2                                                                                                           | 89.9      | 9.9        |    |    |
|                                                                                                                                                                                                                                             |        | A-1-b, SiSaGr, brn, Moist,<br>Rec. = 0.07m, Particles of<br>Brick were within sample. | 3                     | 12        | 48.8                                                                                                          | 29.7      | 21.5       |    |    |
|                                                                                                                                                                                                                                             |        | A-4, SaSi, brn, Moist,<br>Rec. = 0.25m                                                | 4                     | 30        | 16.4                                                                                                          | 38.4      | 45.2       |    |    |
|                                                                                                                                                                                                                                             |        | A-4, SaSi, gry, Moist,<br>Rec. = 0.10m, Wood particles<br>were within sample.         | 4                     | 41.7      | 4                                                                                                             | 41        | 55         |    |    |
|                                                                                                                                                                                                                                             |        | Run#1: BXMD, 8.83m-10.35m,<br>Rec. = 1.50m,<br>See Geologist's Report.                | RUN                   | REC%      | RODZ                                                                                                          | Dip°      |            |    |    |
|                                                                                                                                                                                                                                             |        |                                                                                       | 1                     | 99        | 88                                                                                                            | 40        |            |    |    |
|                                                                                                                                                                                                                                             |        | Run#2: BXMD, 10.35m-11.87m,<br>Rec. = 1.48m,<br>See Geologist's Report.               | 2                     | 97        | 92                                                                                                            | 40        |            |    |    |
| Hole stopped @ 11.87m                                                                                                                                                                                                                       |        |                                                                                       |                       |           |                                                                                                               |           |            |    |    |
| Driller's Notes:<br>1. No ground water elevation found. 04/29/02                                                                                                                                                                            |        |                                                                                       |                       |           |                                                                                                               |           |            |    |    |
| GEOLOGIST'S REPORT:<br><br>Run#1: Light gray hornblende gneiss with quartz veins, Hard to very hard,<br>Unweathered, Competent.<br><br>Run#2: Light gray hornblende gneiss with quartz veins, Hard to very hard,<br>Unweathered, Competent. |        |                                                                                       |                       |           |                                                                                                               |           |            |    |    |

|                                            |                        |
|--------------------------------------------|------------------------|
| PROJECT:                                   | PROJECT NO.:           |
| BETHEL                                     | BRF 0241 (33) C/1      |
| DESIGN FILE NAME: /M&R/96j250/mj250bor.dgn | PLOT DATE: 09-JUL-2003 |
| IPARM FILE NAME: s96j250bor2.i             | SURVEY DATE:           |
| SURVEYED BY:                               | DRAWN BY: J. TOUCHETTE |
| SQUAD LEADER: C.C. BENDA                   | SHEET: 18 OF 47        |
| DATE: 06/02 BORING LOGS                    |                        |



| STATE OF VERMONT<br>AGENCY OF TRANSPORTATION<br>MATERIALS & RESEARCH DIVISION<br>SUBSURFACE INFORMATION                                                                                                                                                                                             |                         |                                                                                                                                                                                                                |                       | HOLE NO.: B-4A<br>SHEET 1 OF 1<br>DATE STARTED: 5/7/02<br>DATE COMPLETED: 5/10/02               |             |           |            |    |    |     |      |      |      |  |  |  |
|-----------------------------------------------------------------------------------------------------------------------------------------------------------------------------------------------------------------------------------------------------------------------------------------------------|-------------------------|----------------------------------------------------------------------------------------------------------------------------------------------------------------------------------------------------------------|-----------------------|-------------------------------------------------------------------------------------------------|-------------|-----------|------------|----|----|-----|------|------|------|--|--|--|
| PROJECT NAME: BETHEL<br>SITE NAME: BR 31<br>STATION: 3+173.00<br>GROUND EL.: 170.448                                                                                                                                                                                                                |                         |                                                                                                                                                                                                                |                       | PROJECT NUMBER: BRF 0241(33) C/1<br>SITE NO.: VT 12<br>OFFSET: 7.35<br>G.W. DEPTH: 180 05/10/02 |             |           |            |    |    |     |      |      |      |  |  |  |
| BORING CREW<br>CREW CHIEF: TALLMAN<br>DRILLER: TALLMAN<br>LOGGER: RUSSELL<br>ADDITIONAL CREW:                                                                                                                                                                                                       |                         |                                                                                                                                                                                                                |                       | BORING RIG: SMALL SKID RIG<br>BORING TYPE: WASH BORE<br>SAMPLE TYPE: SPLIT BARREL               |             |           |            |    |    |     |      |      |      |  |  |  |
| DEPTH                                                                                                                                                                                                                                                                                               | SYMBOL                  | CLASSIFICATION OF MATERIALS<br><i>(Description)</i>                                                                                                                                                            | BLOWS<br>PER<br>0.3 m | M.C.<br>%                                                                                       | GRAVEL<br>% | SAND<br>% | FINES<br>% | LL | PI |     |      |      |      |  |  |  |
| 5                                                                                                                                                                                                                                                                                                   |                         | A-4, GrSiSa & Wood, brn, Moist<br>Rec. = 0.05m                                                                                                                                                                 | 3                     | 42.5                                                                                            | 20.9        | 40.5      | 38.6       |    |    |     |      |      |      |  |  |  |
|                                                                                                                                                                                                                                                                                                     |                         | Into Wood at 2.10m                                                                                                                                                                                             |                       |                                                                                                 |             |           |            |    |    |     |      |      |      |  |  |  |
|                                                                                                                                                                                                                                                                                                     |                         | No sample, Wood sections                                                                                                                                                                                       |                       |                                                                                                 |             |           |            |    |    |     |      |      |      |  |  |  |
|                                                                                                                                                                                                                                                                                                     | Top of bedrock @ 3.96 m |                                                                                                                                                                                                                |                       |                                                                                                 |             |           |            |    |    |     |      |      |      |  |  |  |
|                                                                                                                                                                                                                                                                                                     |                         | Run#1: BXMDC, 3.96m-5.48m,<br>Rec. = 1.52m,<br>See Geologist's Report.                                                                                                                                         |                       |                                                                                                 |             |           |            |    |    | RUN | REC% | ROD% | Dip° |  |  |  |
|                                                                                                                                                                                                                                                                                                     |                         | 1                                                                                                                                                                                                              |                       |                                                                                                 |             |           |            |    |    | 100 | 75   | 40   |      |  |  |  |
|                                                                                                                                                                                                                                                                                                     |                         | Run#2: BXMDC, 5.48m-7.00m,<br>Rec. = 1.52m,<br>See Geologist's Report.                                                                                                                                         |                       |                                                                                                 |             |           |            |    |    | 2   | 100  | 90   | 40   |  |  |  |
|                                                                                                                                                                                                                                                                                                     |                         | Hole stopped @ 7.0m                                                                                                                                                                                            |                       |                                                                                                 |             |           |            |    |    |     |      |      |      |  |  |  |
|                                                                                                                                                                                                                                                                                                     | 10                      | Driller's Notes:<br><br>1. Drillers had a difficult time drilling through<br>three sections of wood timber. Each timber was about six<br>inches thick.<br><br>2. Ground water elevation was 1.80m on 05/10/02. |                       |                                                                                                 |             |           |            |    |    |     |      |      |      |  |  |  |
|                                                                                                                                                                                                                                                                                                     |                         | GEOLOGISTS' REPORT:                                                                                                                                                                                            |                       |                                                                                                 |             |           |            |    |    |     |      |      |      |  |  |  |
| Run#1: 3.96m-5.00m, Gray garnetiferous hornblende gneiss with greenstone,<br>Highly deformed foliation, Moderately hard,<br>Unweathered, Competent.<br><br>5.00m-5.45m, Light gray hornblende gneiss, Hard to very hard,<br>Unweathered, Competent.<br><br>5.45m-5.48m, Same as beginning of Run#1. |                         |                                                                                                                                                                                                                |                       |                                                                                                 |             |           |            |    |    |     |      |      |      |  |  |  |
| Run#2: 5.48m-6.03m, Gray garnetiferous hornblende gneiss with greenstone<br>and quartz veins, Highly deformed foliation,<br>Moderately hard, Unweathered, Competent.<br><br>6.03m-7.00m, Light gray hornblende gneiss, Hard to very hard,<br>Unweathered, Competent.                                |                         |                                                                                                                                                                                                                |                       |                                                                                                 |             |           |            |    |    |     |      |      |      |  |  |  |



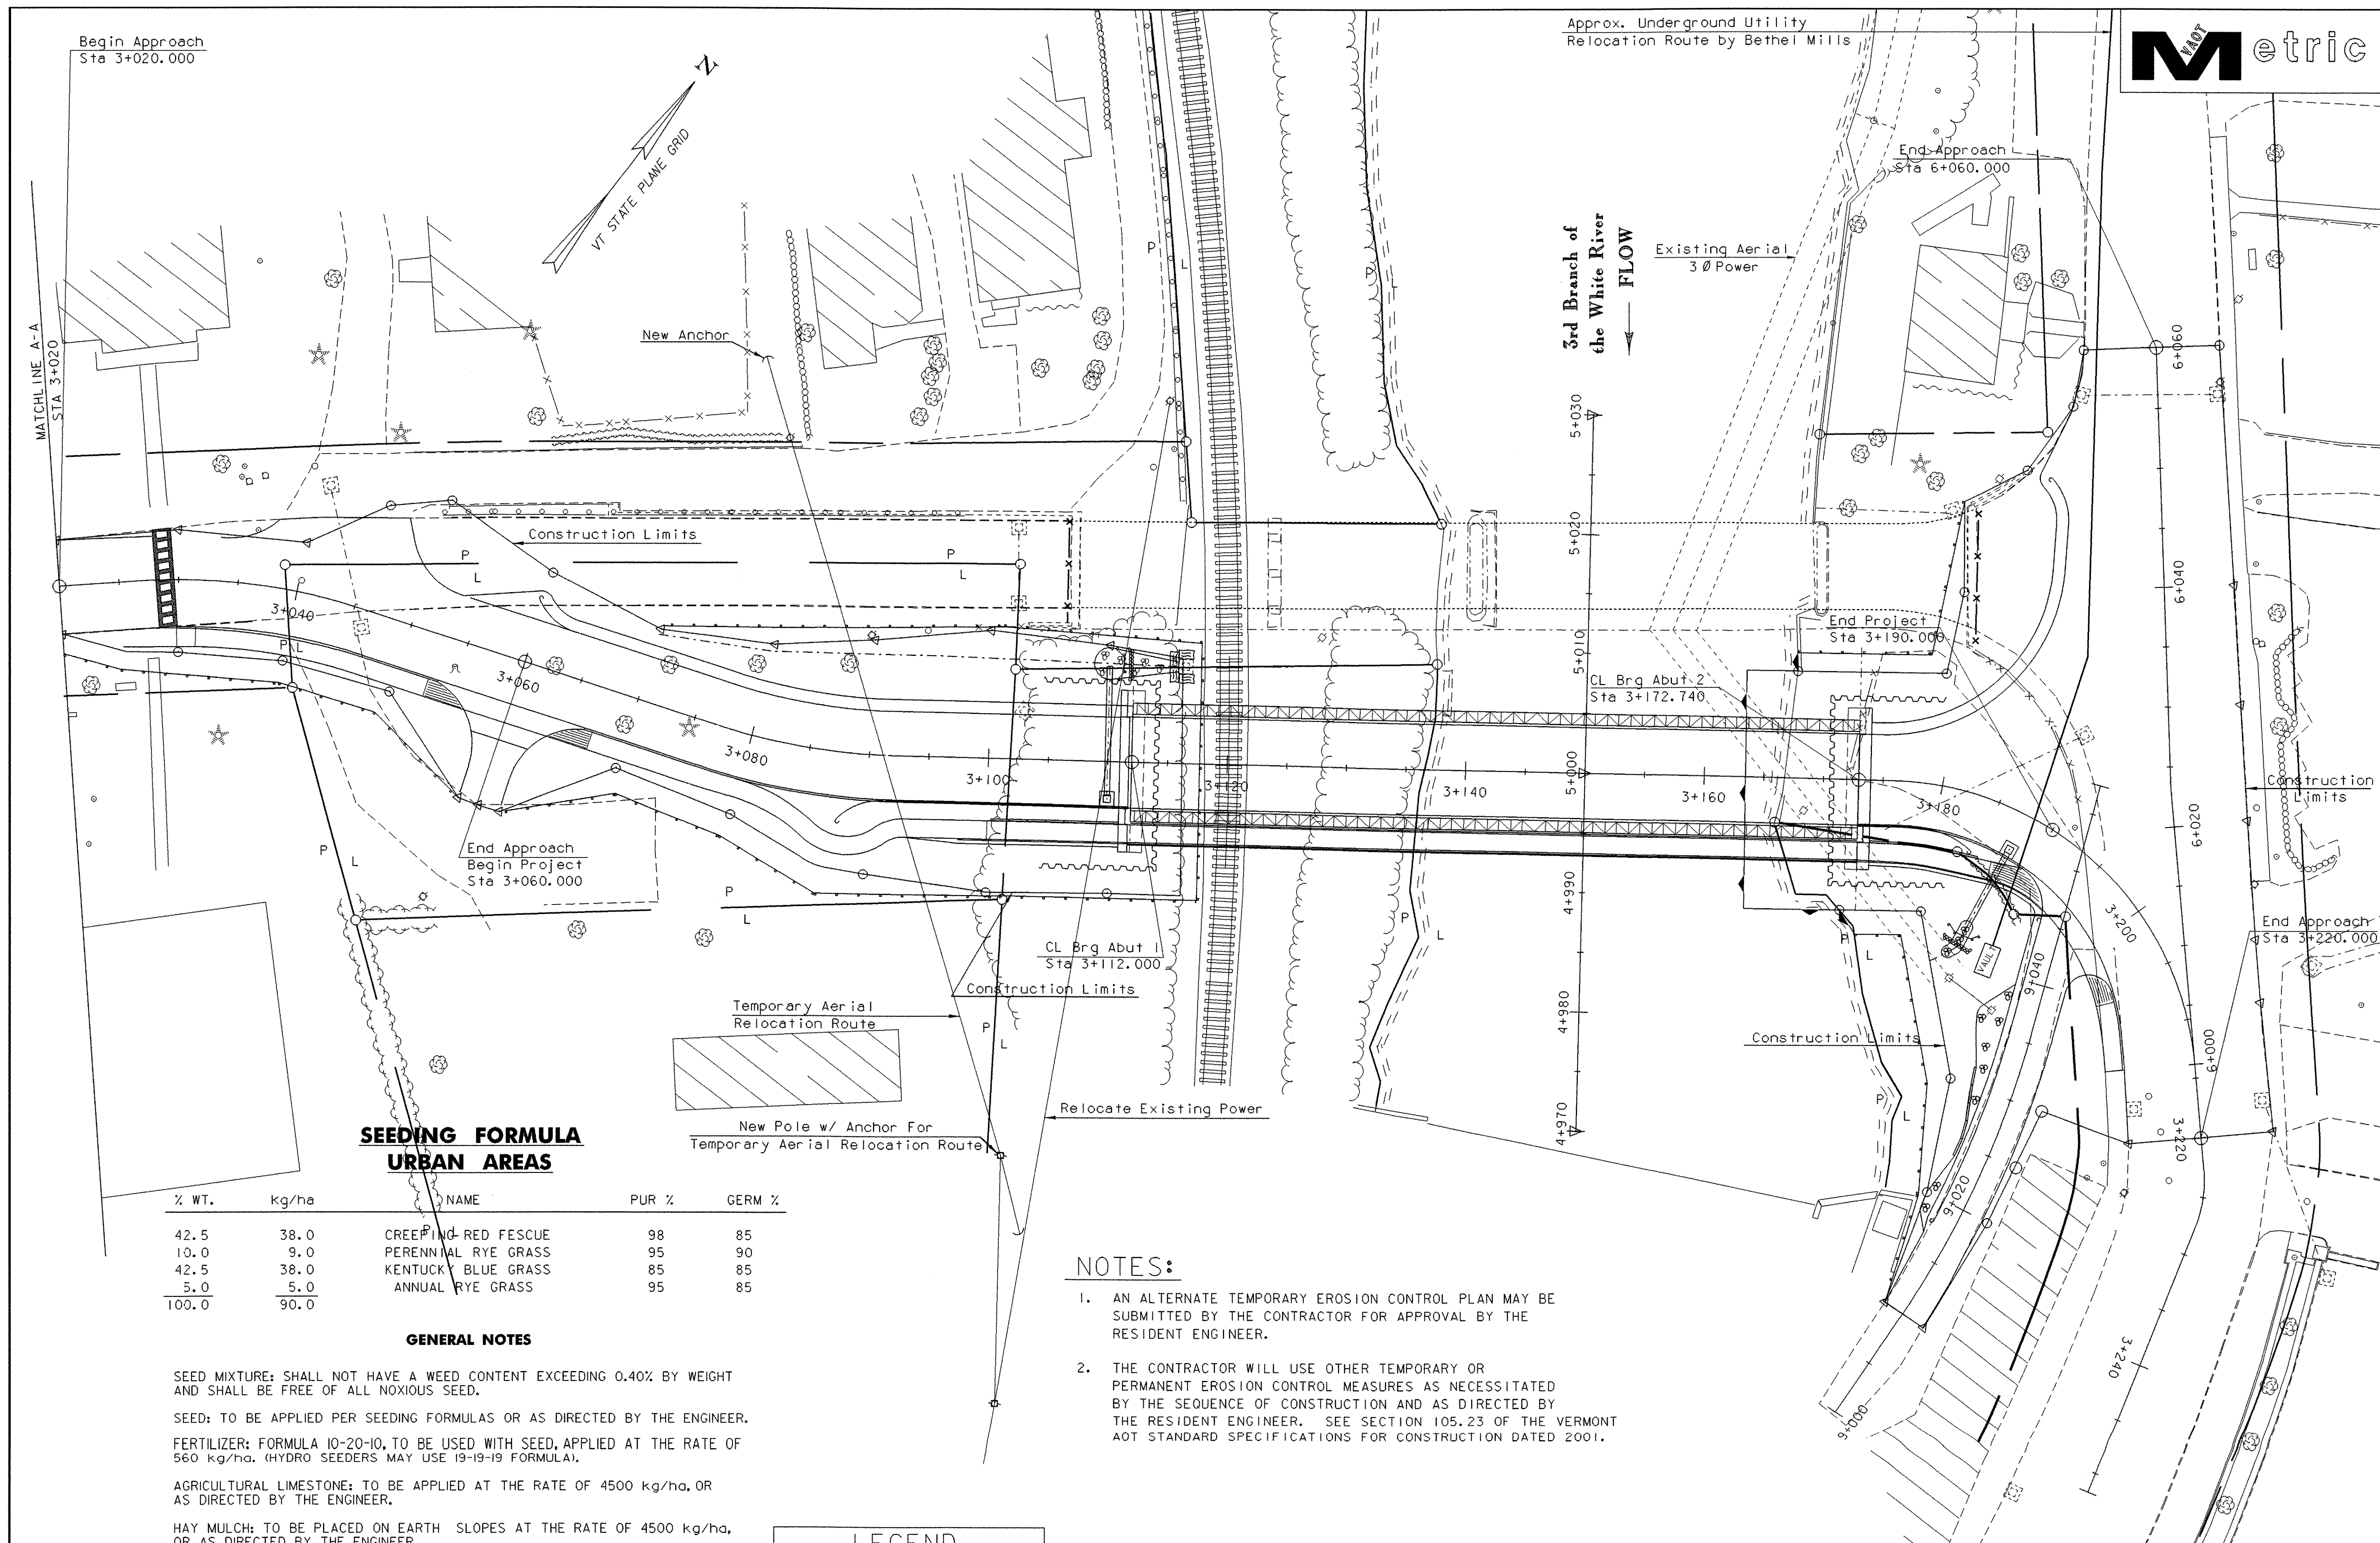

**SEEDING FORMULA  
URBAN AREAS**

| % WT. | kg/ha | NAME                | PUR % | GERM % |
|-------|-------|---------------------|-------|--------|
| 42.5  | 38.0  | CREEPING RED FESCUE | 98    | 85     |
| 10.0  | 9.0   | PERENNIAL RYE GRASS | 95    | 90     |
| 42.5  | 38.0  | KENTUCKY BLUE GRASS | 85    | 85     |
| 5.0   | 5.0   | ANNUAL RYE GRASS    | 95    | 85     |
| 100.0 | 90.0  |                     |       |        |

**GENERAL NOTES**

SEED MIXTURE: SHALL NOT HAVE A WEED CONTENT EXCEEDING 0.40% BY WEIGHT AND SHALL BE FREE OF ALL NOXIOUS SEED.

SEED: TO BE APPLIED PER SEEDING FORMULAS OR AS DIRECTED BY THE ENGINEER.

FERTILIZER: FORMULA 10-20-10, TO BE USED WITH SEED, APPLIED AT THE RATE OF 560 kg/ha. (HYDRO SEEDERS MAY USE 19-19-19 FORMULA).

AGRICULTURAL LIMESTONE: TO BE APPLIED AT THE RATE OF 4500 kg/ha, OR AS DIRECTED BY THE ENGINEER.

HAY MULCH: TO BE PLACED ON EARTH SLOPES AT THE RATE OF 4500 kg/ha, OR AS DIRECTED BY THE ENGINEER.

TOPSOIL: TO BE USED WITH SEED AS INDICATED ON THE PLANS, OR AS DIRECTED BY THE ENGINEER.

**NOTES:**

1. AN ALTERNATE TEMPORARY EROSION CONTROL PLAN MAY BE SUBMITTED BY THE CONTRACTOR FOR APPROVAL BY THE RESIDENT ENGINEER.
2. THE CONTRACTOR WILL USE OTHER TEMPORARY OR PERMANENT EROSION CONTROL MEASURES AS NECESSITATED BY THE SEQUENCE OF CONSTRUCTION AND AS DIRECTED BY THE RESIDENT ENGINEER. SEE SECTION 105.23 OF THE VERMONT AOT STANDARD SPECIFICATIONS FOR CONSTRUCTION DATED 2001.

**LEGEND**

- FABRIC CURTAIN
- SILT FENCE
- HAY BALES


**DATUM**

VERTICAL NAVD 88  
HORIZONTAL NAD 83/92

0 10 20  
SCALE 1 : 250

|                                                       |                                           |
|-------------------------------------------------------|-------------------------------------------|
| PROJECT:<br><b>BETHEL</b>                             | PROJECT NO. :<br><b>BRF 0241 (33) -C1</b> |
| DESIGN FILE NAME: 96j250/structures/s96j250ero-cl.dgn | PLOT DATE: 09-JUL-2003                    |
| IPARM FILE NAME: s96j250ero-cl.i                      | SURVEYED BY: ORVIS                        |
| SQUAD LEADER: C.P. WILLIAMS                           | DRAWN BY: T.G. Anderson                   |
| EROSION CONTROL SHEET                                 | SHEET: 19 OF 47                           |



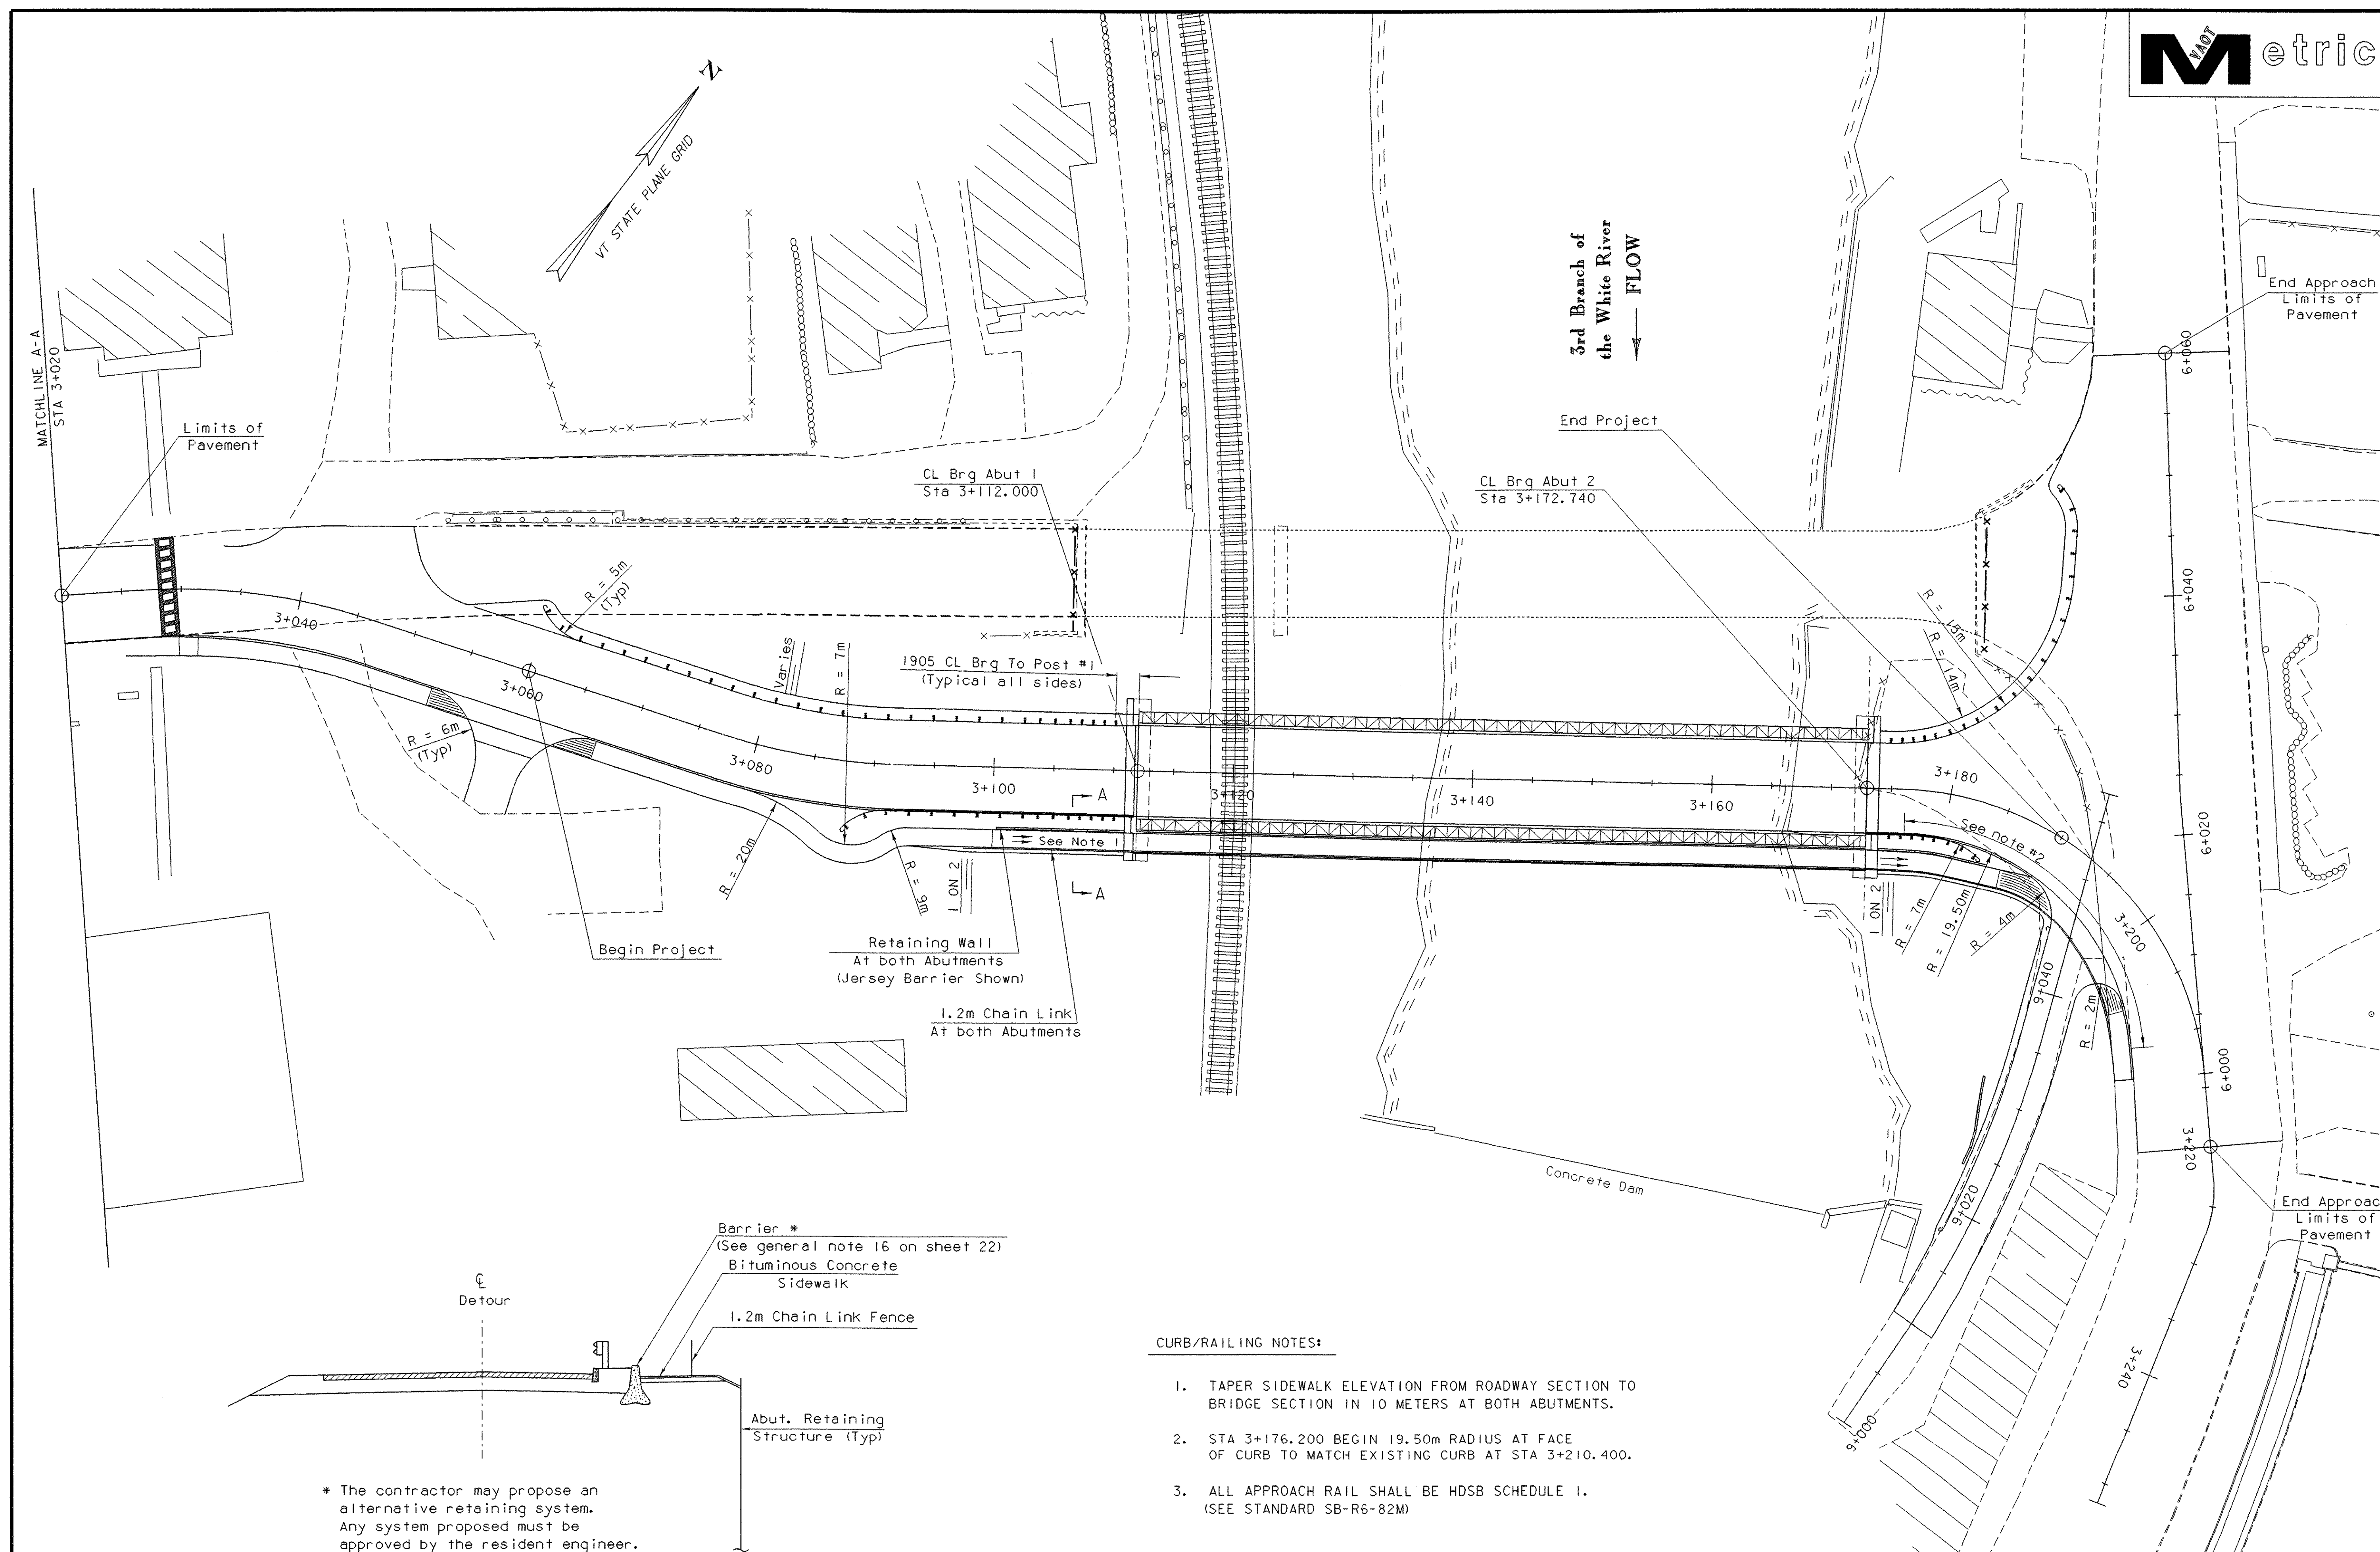

**CURB/RAILING NOTES:**

1. TAPER SIDEWALK ELEVATION FROM ROADWAY SECTION TO BRIDGE SECTION IN 10 METERS AT BOTH ABUTMENTS.
2. STA 3+176.200 BEGIN 19.50m RADIUS AT FACE OF CURB TO MATCH EXISTING CURB AT STA 3+210.400.
3. ALL APPROACH RAIL SHALL BE HDSB SCHEDULE 1. (SEE STANDARD SB-R6-82M)

\* The contractor may propose an alternative retaining system. Any system proposed must be approved by the resident engineer.

**DATUM**  
VERTICAL NAVD 88  
HORIZONTAL NAD 83/92

**SECTION A-A**  
NTS

0 10 20  
SCALE 1 : 250

|                                                        |                                           |
|--------------------------------------------------------|-------------------------------------------|
| PROJECT:<br><b>BETHEL</b>                              | PROJECT NO.:<br><b>BRF 0241 (33) - C1</b> |
| DESIGN FILE NAME: 96j250/structures/s96j250rail-cl.dgn | PLOT DATE: 09-JUL-2003                    |
| IPARM FILE NAME: s96j250rail-cl.i                      | SURVEY DATE: 10/99                        |
| SURVEYED BY: ORVIS                                     | DRAWN BY: T. G. Anderson                  |
| SQUAD LEADER: C.P. WILLIAMS                            | SHEET: 21 OF 47                           |
| RAIL AND CURB LAYOUT                                   |                                           |



PROJECT NOTES



1. All materials and construction shall conform to state of Vermont Agency of Transportation Standard Specifications for Construction, dated 2001, and its latest revisions, and the AASHTO standard specifications for highway bridges, dated 1996, and its latest revisions.
2. Design is for MS-18 live loading.
3. All dimensions shown on these drawings are horizontal or vertical and are given at 20 degrees C unless noted otherwise.
4. The purpose of this project is to install a Mabey bridge downstream from the existing bridge. The existing bridge and all utilities attached to it shall not be removed as part of this contract and shall not be disturbed. The resident engineer may require additional barricades, at both ends of the existing bridge, for increased safety at no additional cost to the state.
5. The superstructure depth has been assumed for the purpose of setting the vertical alignment. Adjustment in the vertical alignment grade may be necessary in order to maintain the 6.0 meter clearance required over the rail road. Any change in grade must be approved by the project manager.
6. The contractor shall notify the District Transportation Administrator for District 4 (Ann Kreis, telephone no. 802-295-8888) a minimum of two weeks prior to launching the temporary bridge.
7. A detail has been provided on these plans for connecting the heavy duty steel beam guard rail to the temporary bridge. The contractor may provide an alternate attachment subject to the approval of the resident engineer. This work shall be paid under the item 525.40 Bridge Railing - HDSB/Curb Mounted (Mod).
8. The contractor is responsible for making adjustments to water shutoffs and sewer manholes as required.
9. All traffic control items to remain in place after project completion shall be included in the item 527.10 "Maintenance of Traffic for Bridge Projects". All type III barricades to remain in place after project completion shall be anchored to the ground to prevent removal while in use. Anchorage shall meet the approval of the resident engineer. All costs associated with anchoring the barricades shall be paid for under the lump sum price bid for item 527.10 "Maintenance of Traffic for Bridge Projects".
10. The contractor shall notify the town of Bethel two weeks prior to diverting traffic onto the temporary bridge. Contact Delbert Cloud at 234-7340.
11. Access to all existing side roads, drives, and parking areas shall be maintained at all times during construction.
12. The intent of the signing package is to reuse all signs currently within the project limits. Any deviation from the signing plan as shown on the plans must meet the approval of the resident engineer. Any signs needing replacement or not shown on the plans shall be paid for under the appropriate contract items as shown on sheet 4.
13. All on and off project construction signs and barricades required for this project and/or ordered by the resident engineer will be the responsibility of the contractor and shall be paid for under the item 527.10 "Maintenance of Traffic for Bridge Projects". All signs and barricades shall be inspected and repaired as necessary daily. All signs and barricades shall be cleaned of dust and debris weekly.
14. The existing light pole at station 1+260 right will be carefully removed and stockpiled on the project for removal by town forces.
15. All granite curbing for this project shall be furnished by the Vermont Agency of Transportation. The contractor is responsible for loading and transporting the granite curb from the District 6 garage in Middlesex to the project location and its installation. All costs associated with loading, transporting and installing the curb is paid for under the item 616.21 Vertical Granite Curb (Mod). Contact Ernie Englehardt at 828-2693 to make arrangements for obtaining granite curb.

16. A retaining wall adjacent to the proposed sidewalk will be necessary from approximately 3+100 to 3+111 and 3+174 to 3+185. The plans have been developed assuming that concrete "Jersey" barrier be used for this wall. The contractor may elect to propose another type of wall at these locations to the Project Manager for approval. In any case, the required retaining wall will be paid under the item 621.90 "Temporary Traffic Barrier" and shall become the property of the State of Vermont.

TWO-WAY TEMPORARY BRIDGE (MOD 1)


17. Item 528.11 Two-Way Temporary Bridge (Mod 1) shall include the following:
18. The contractor will be responsible for obtaining the design and all drawings from Mabey Bridge & Shore. All drawings and loads obtained shall be submitted to the project manager for review.
19. The contractor will be responsible for the cost of all Mabey bridge components that are not in State inventory, including parts for the foot bridge (see list of components in Special Provisions). All new components will become the property of the State of Vermont after installation.
20. The contractor will be responsible for the cost of loading and transporting all necessary Mabey bridge components that are in State inventory, from the Mendon garage to the project site. All existing components will remain the property of the State of Vermont.
21. The contractor will be responsible for loading and transporting the deck panels from the Mendon garage to the coating applicator and having the panels coated with an anti-skid surface. See Special Provisions for more detail.
22. The contractor will be responsible for launching the Mabey bridge and for the cost of having a representative from Mabey Bridge & Shore at the site at the time of launching.

TWO-WAY TEMPORARY BRIDGE (MOD 2)

23. Item 528.11 Two-Way Temporary Bridge (Mod 2) shall include the following:
24. The contractor will be responsible for the cost of designing and constructing retaining structures to retain the roadway fill and support the bridge foundation at the abutment 1 and abutment 2 locations. See Special Provisions for more detail.
25. The contractor will be responsible for all communication and coordination with Mabey Bridge & Shore to obtain the loads applied from the Mabey bridge to the abutment foundation and retaining structure.
26. The upstream limits of the retaining structures must not extend beyond 7.5 meters from the Centerline of the detour so as not to interfere with the future construction of the permanent bridge.


|                                                          |                        |
|----------------------------------------------------------|------------------------|
| PROJECT:                                                 | PROJECT NO.:           |
| BETHEL                                                   | BRF 0241 (33) - C1     |
| DESIGN FILE NAME: s96j250/structures/s96j250notes-cl.dgn |                        |
| IPARM FILE NAME: s96j250notes-cl.i                       |                        |
| DESIGNED BY: K. M. HIGGINS                               | PLOT DATE: 09-JUL-2003 |
| SQUAD LEADER: C. P. WILLIAMS                             | CHECKED BY: K. Higgins |
| GENERAL NOTES                                            | SHEET: 22 OF 47        |



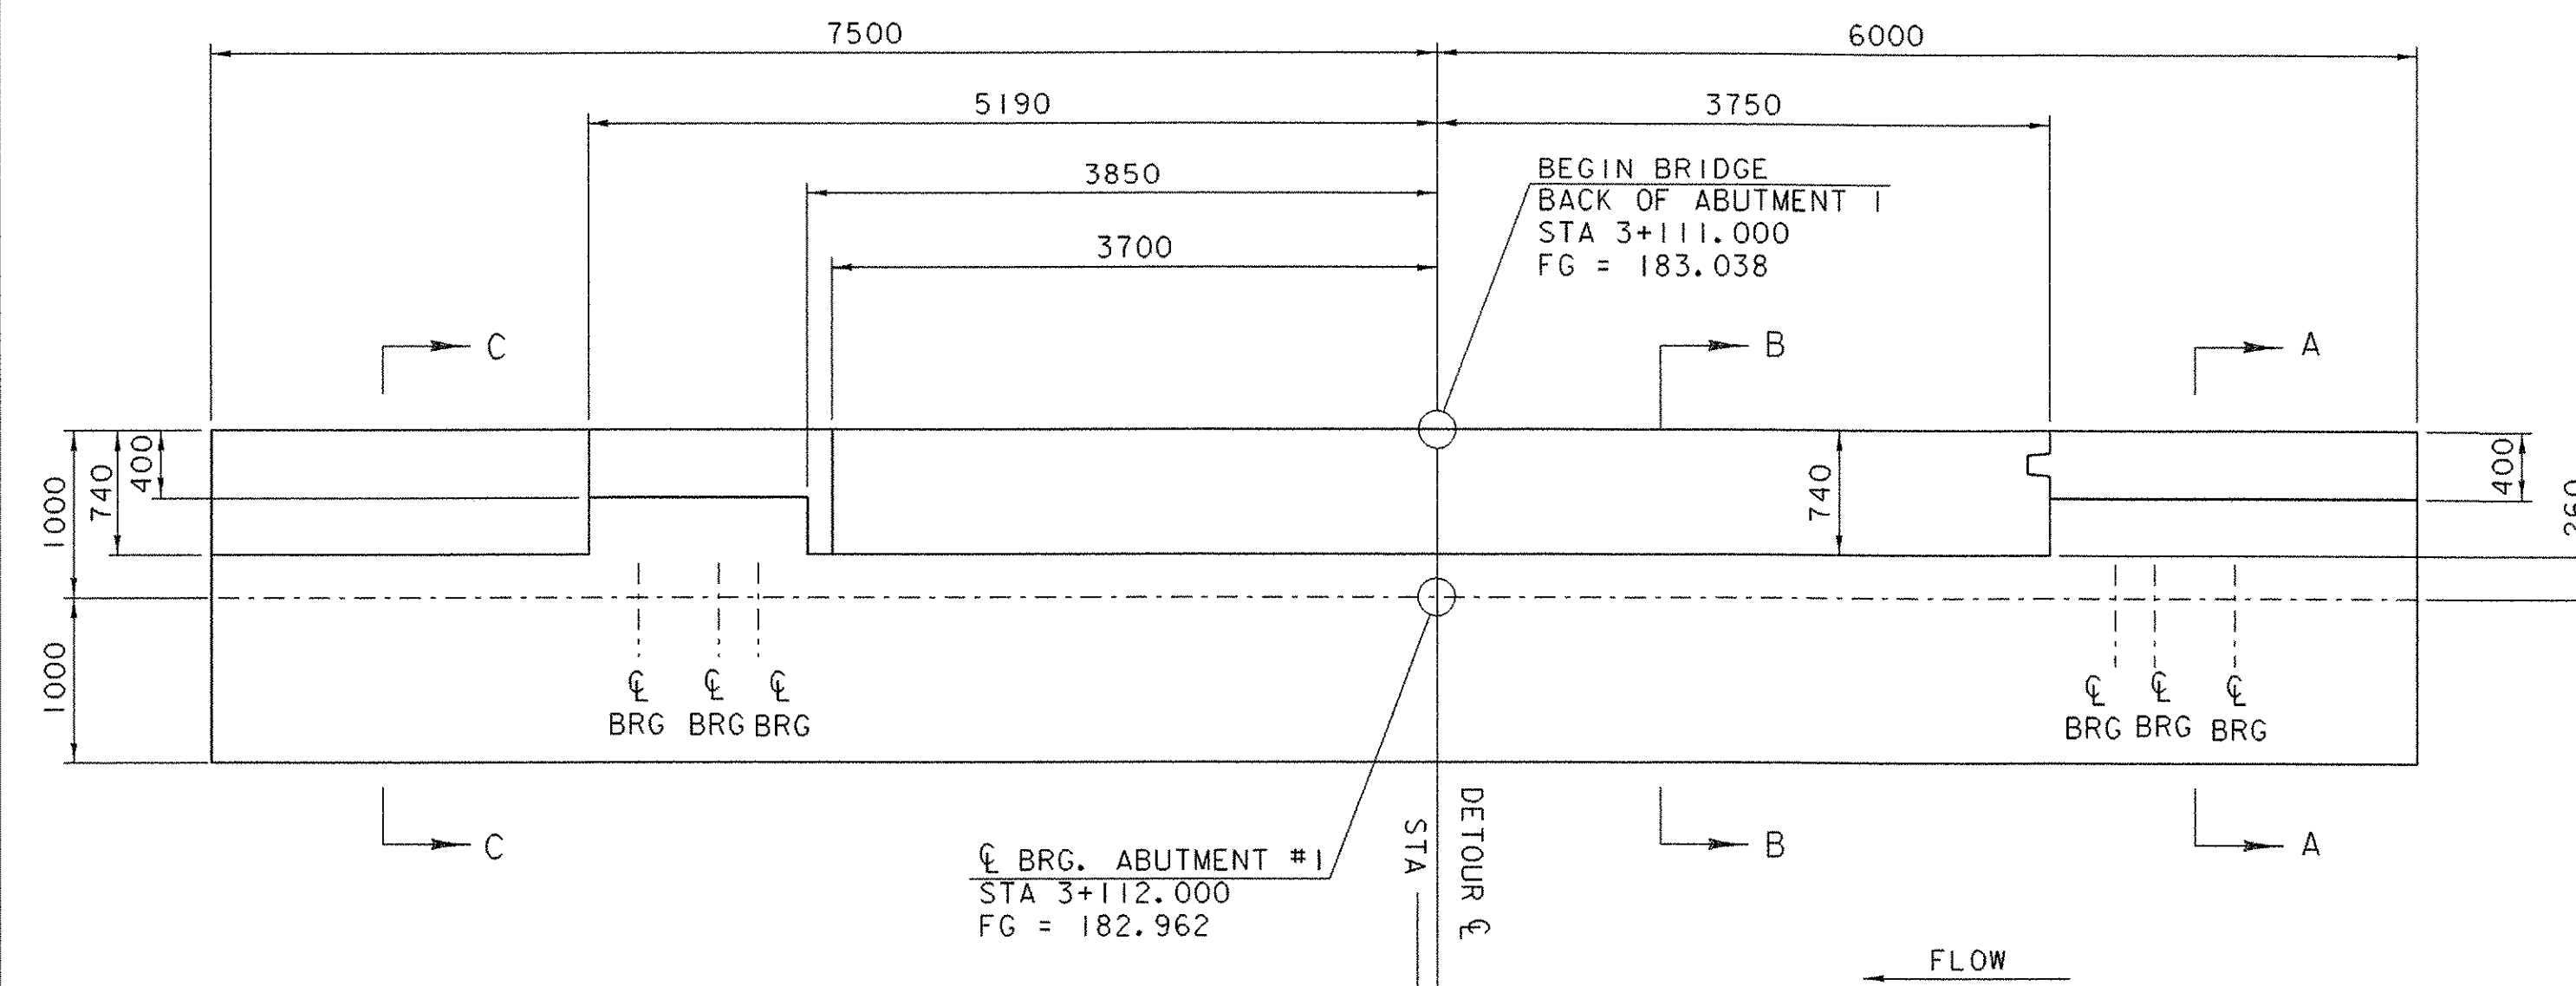


ABUTMENT NO. 1 DIMENSION PLAN

SCALE = 1:40

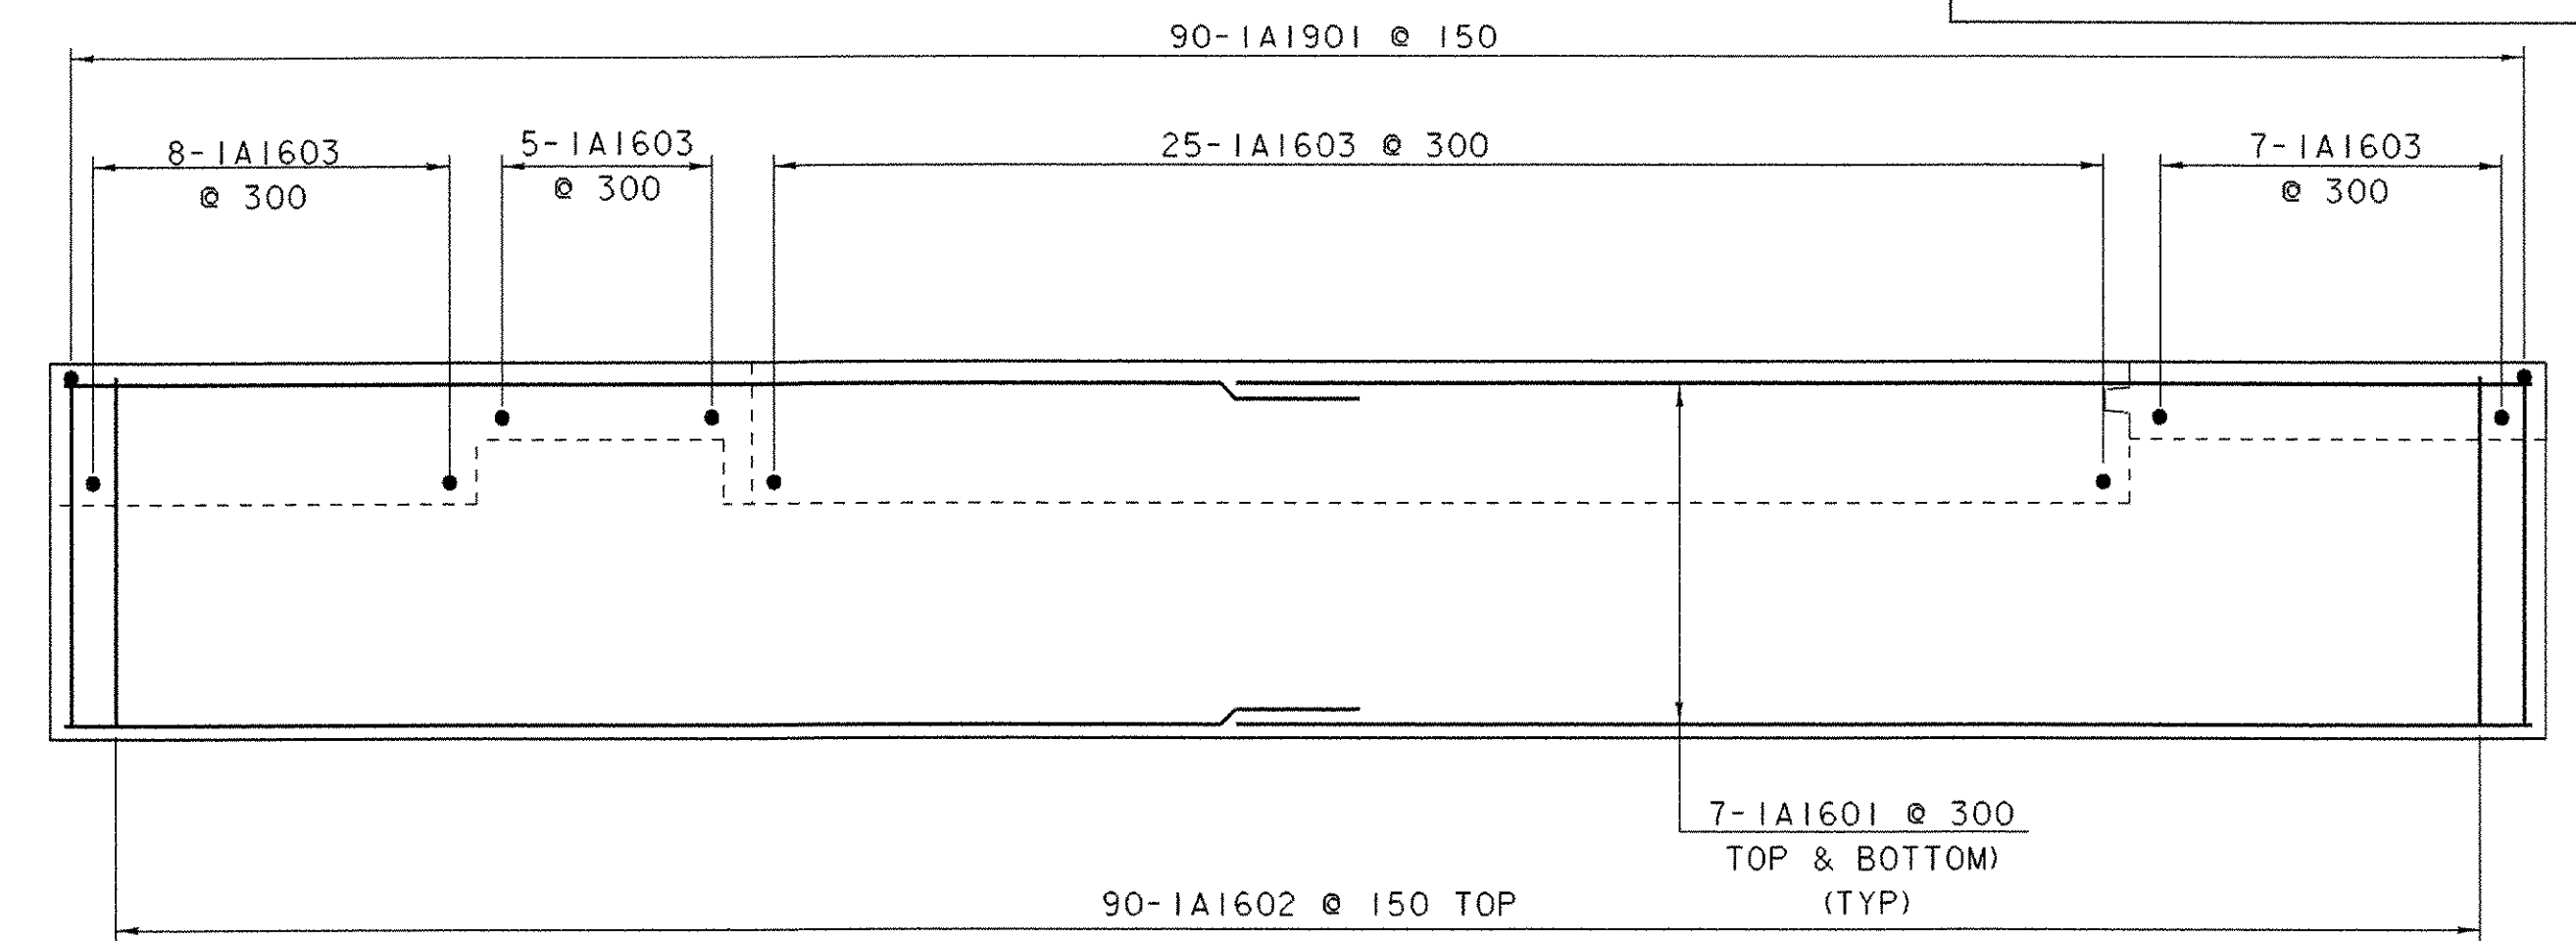


BRIDGE SEAT NO. 1 REINFORCEMENT PLAN

SCALE = 1:40

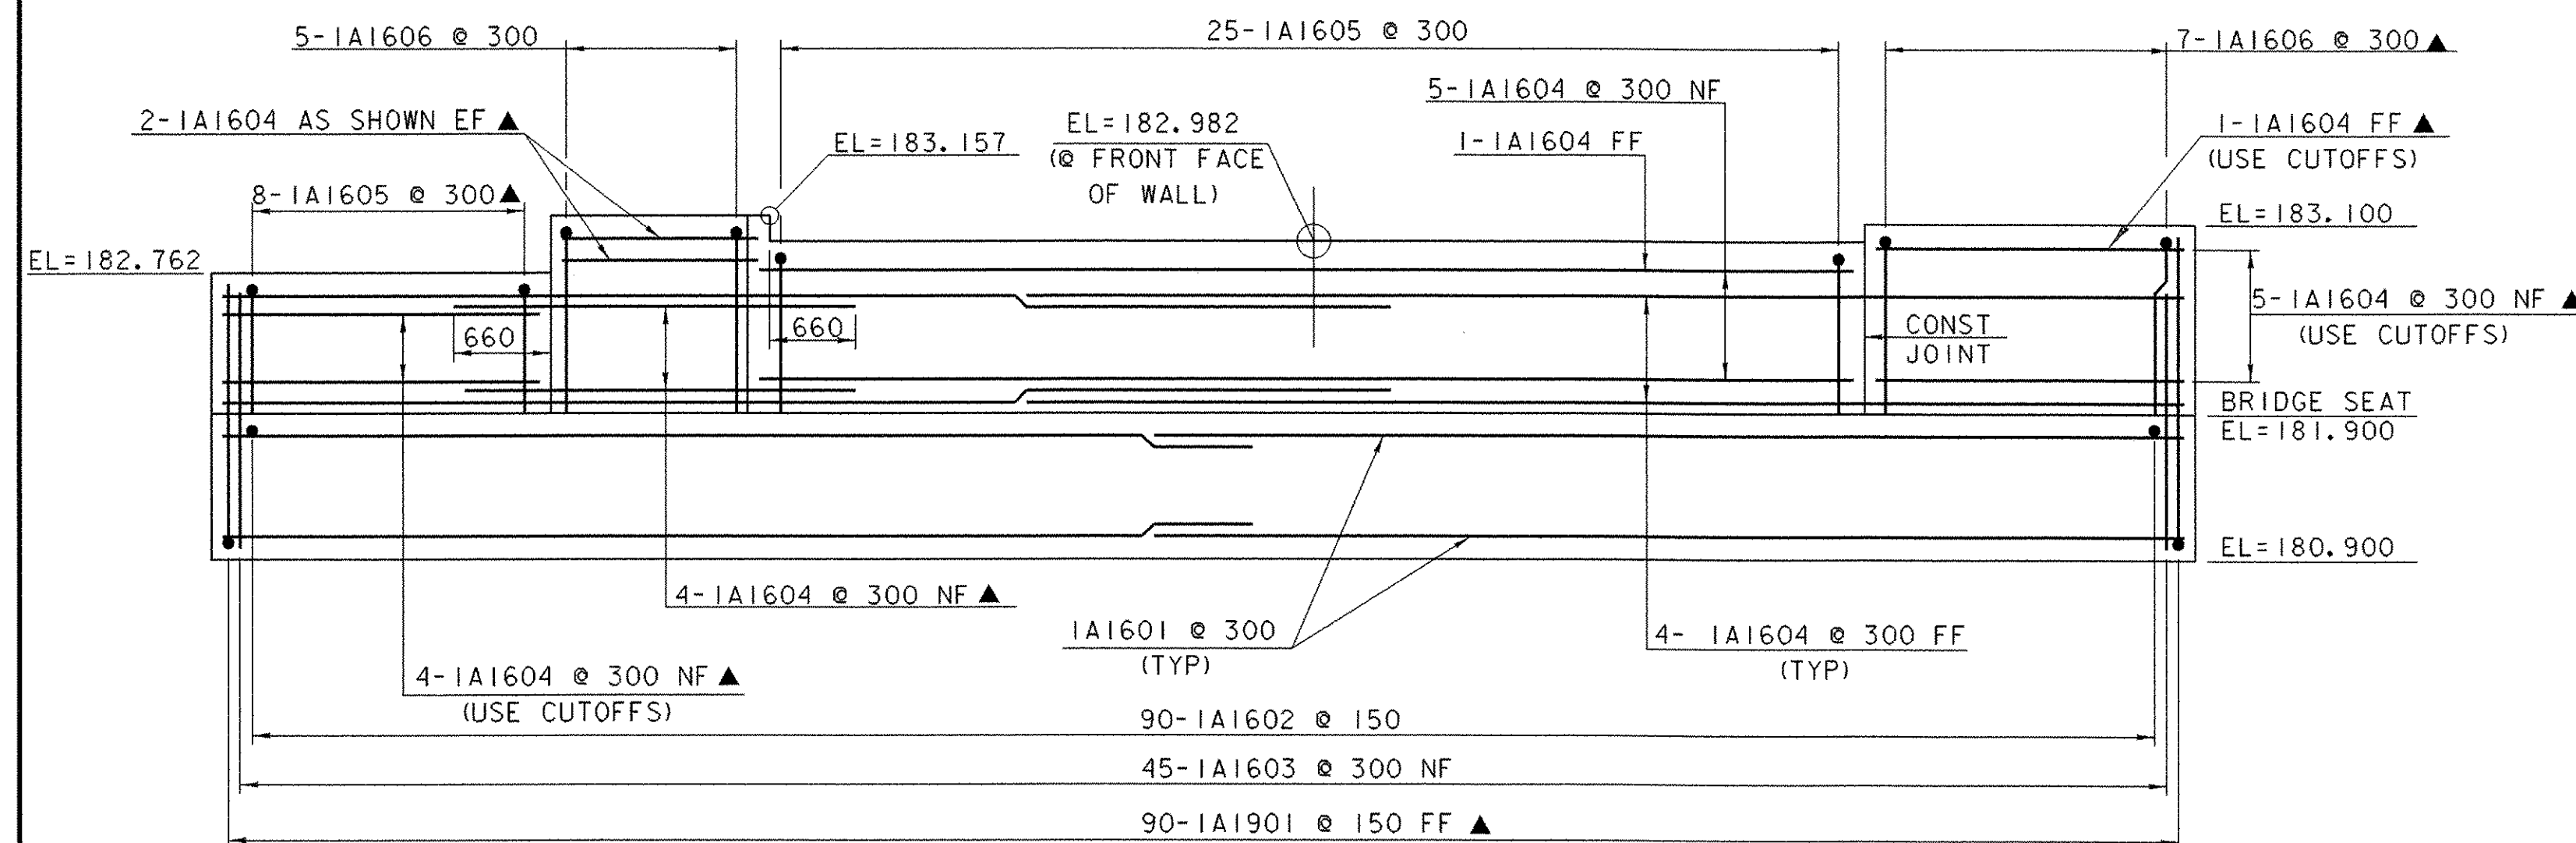

ABUTMENT NO. 1 ELEVATION

SCALE = 1:40

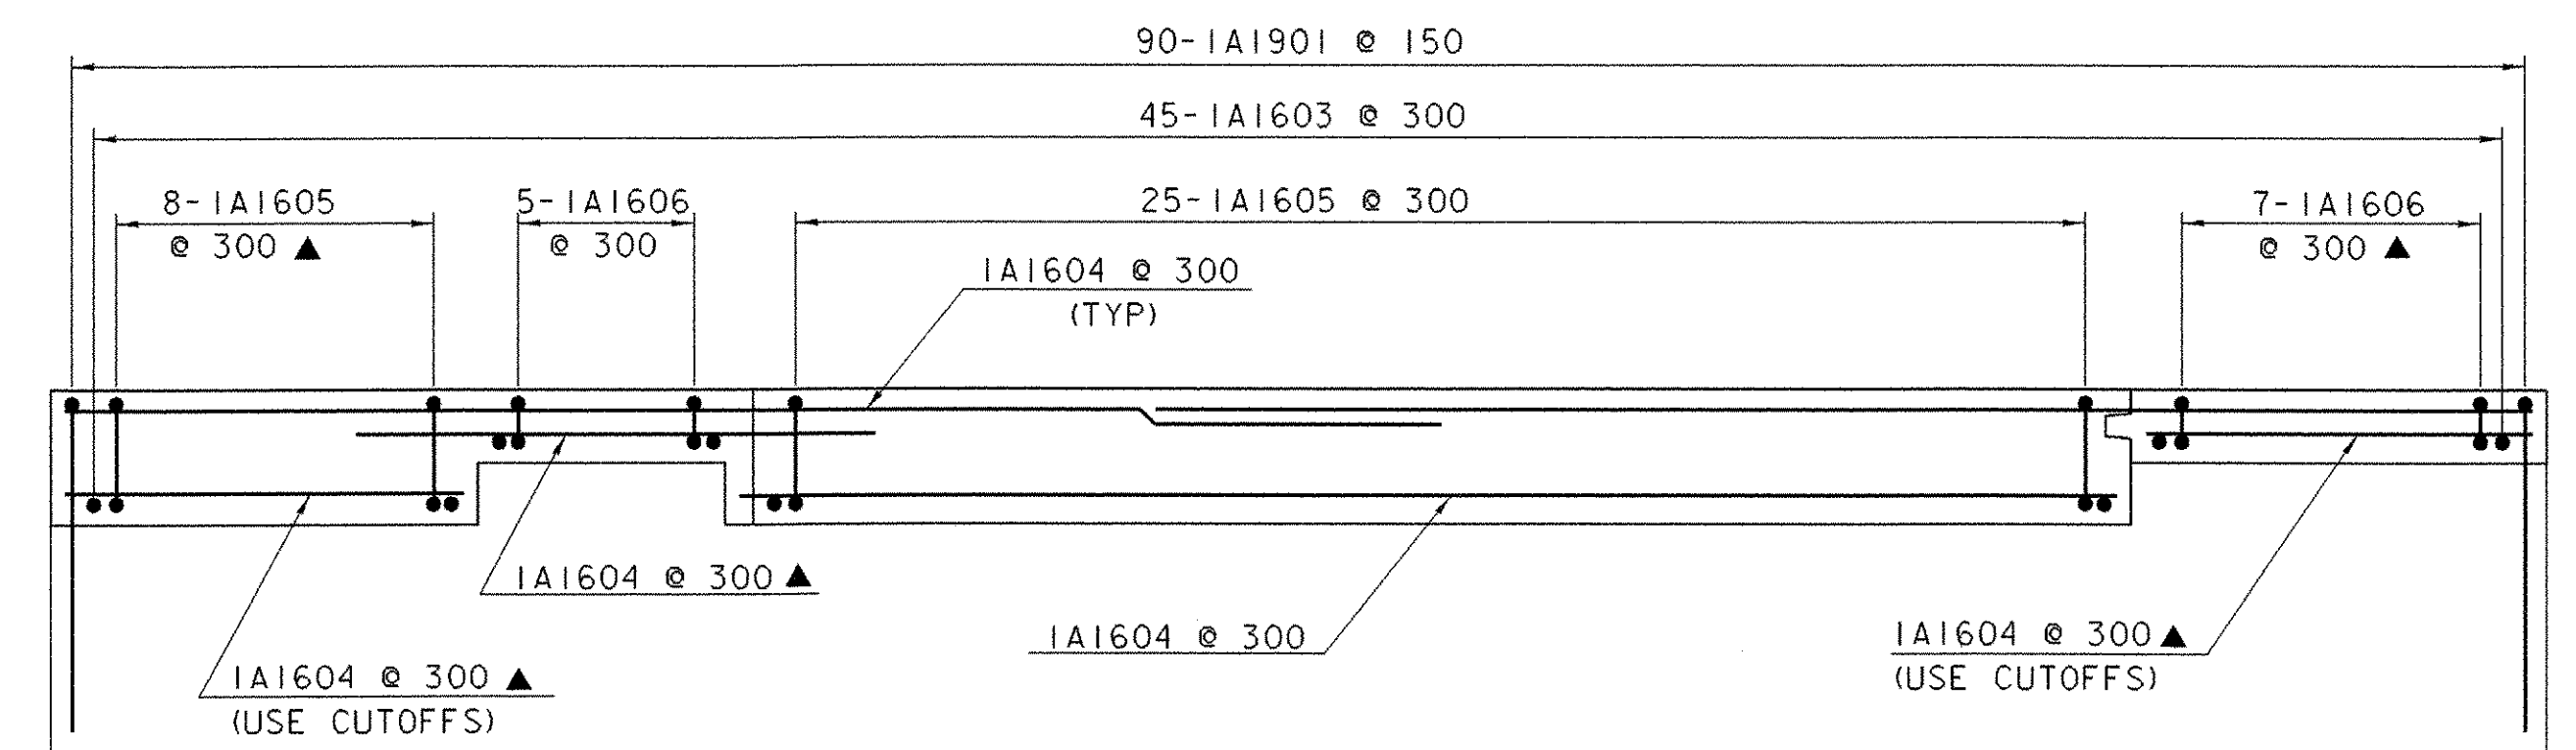




BACKWALL NO. 1 REINFORCEMENT PLAN

SCALE = 1:40

NOTE:  
ALL DIMENSIONS AND ELEVATIONS SHOWN ALONG  
BACKWALL ARE THEORETICAL. AFTER THE  
BRIDGE IS IN PLACE ALL DIMENSIONS SHALL  
BE VERIFIED AND ADJUSTED AS REQUIRED.


NOTE:

NF = NEAR FACE  
FF = FAR FACE  
EF = EACH FACE  
▲ = CUT TO FIT IN FIELD  
75 CLR. UNLESS OTHERWISE  
SPECIFIED ON THE PLANS.  
ALL LAPS 660 UNLESS OTHERWISE  
SPECIFIED ON THE PLANS.

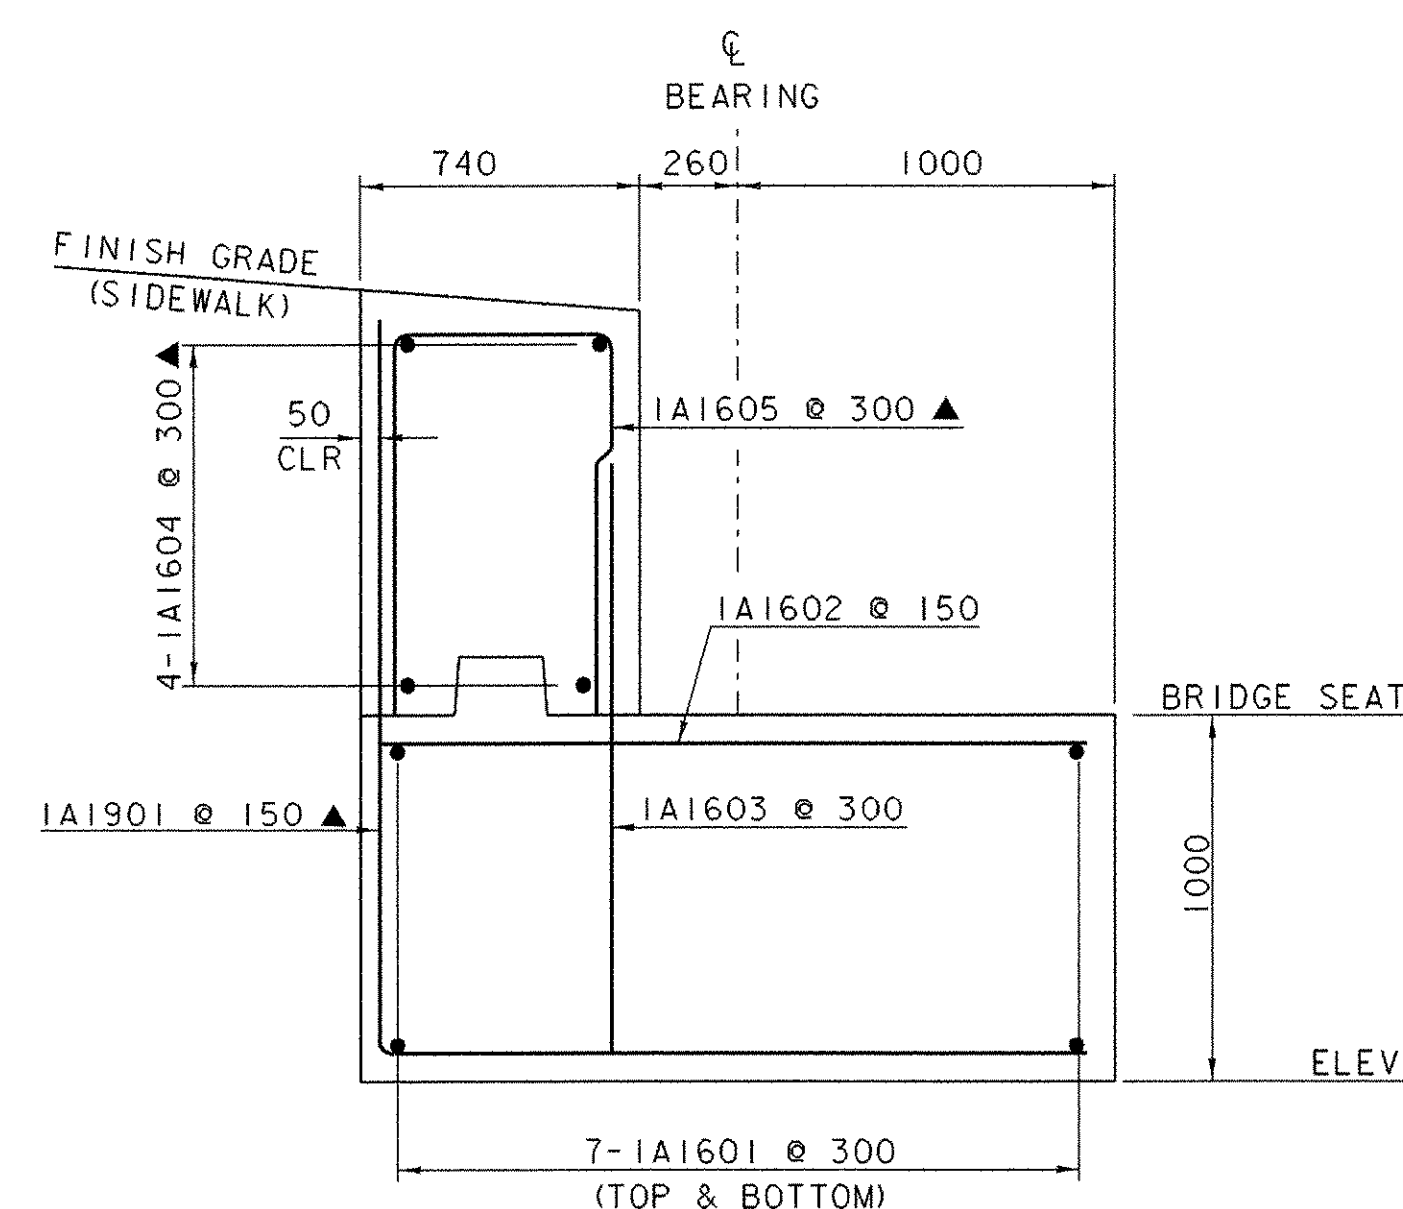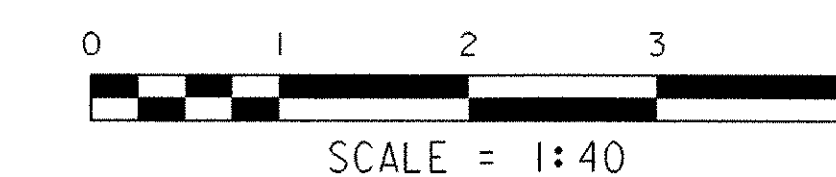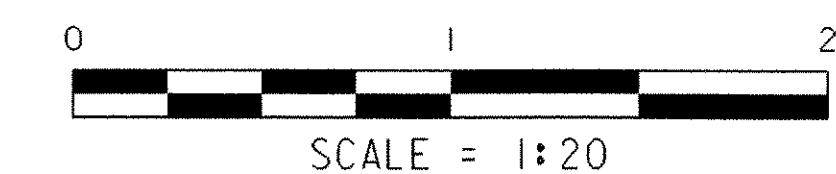

SECTION C-C


SCALE = 1:20

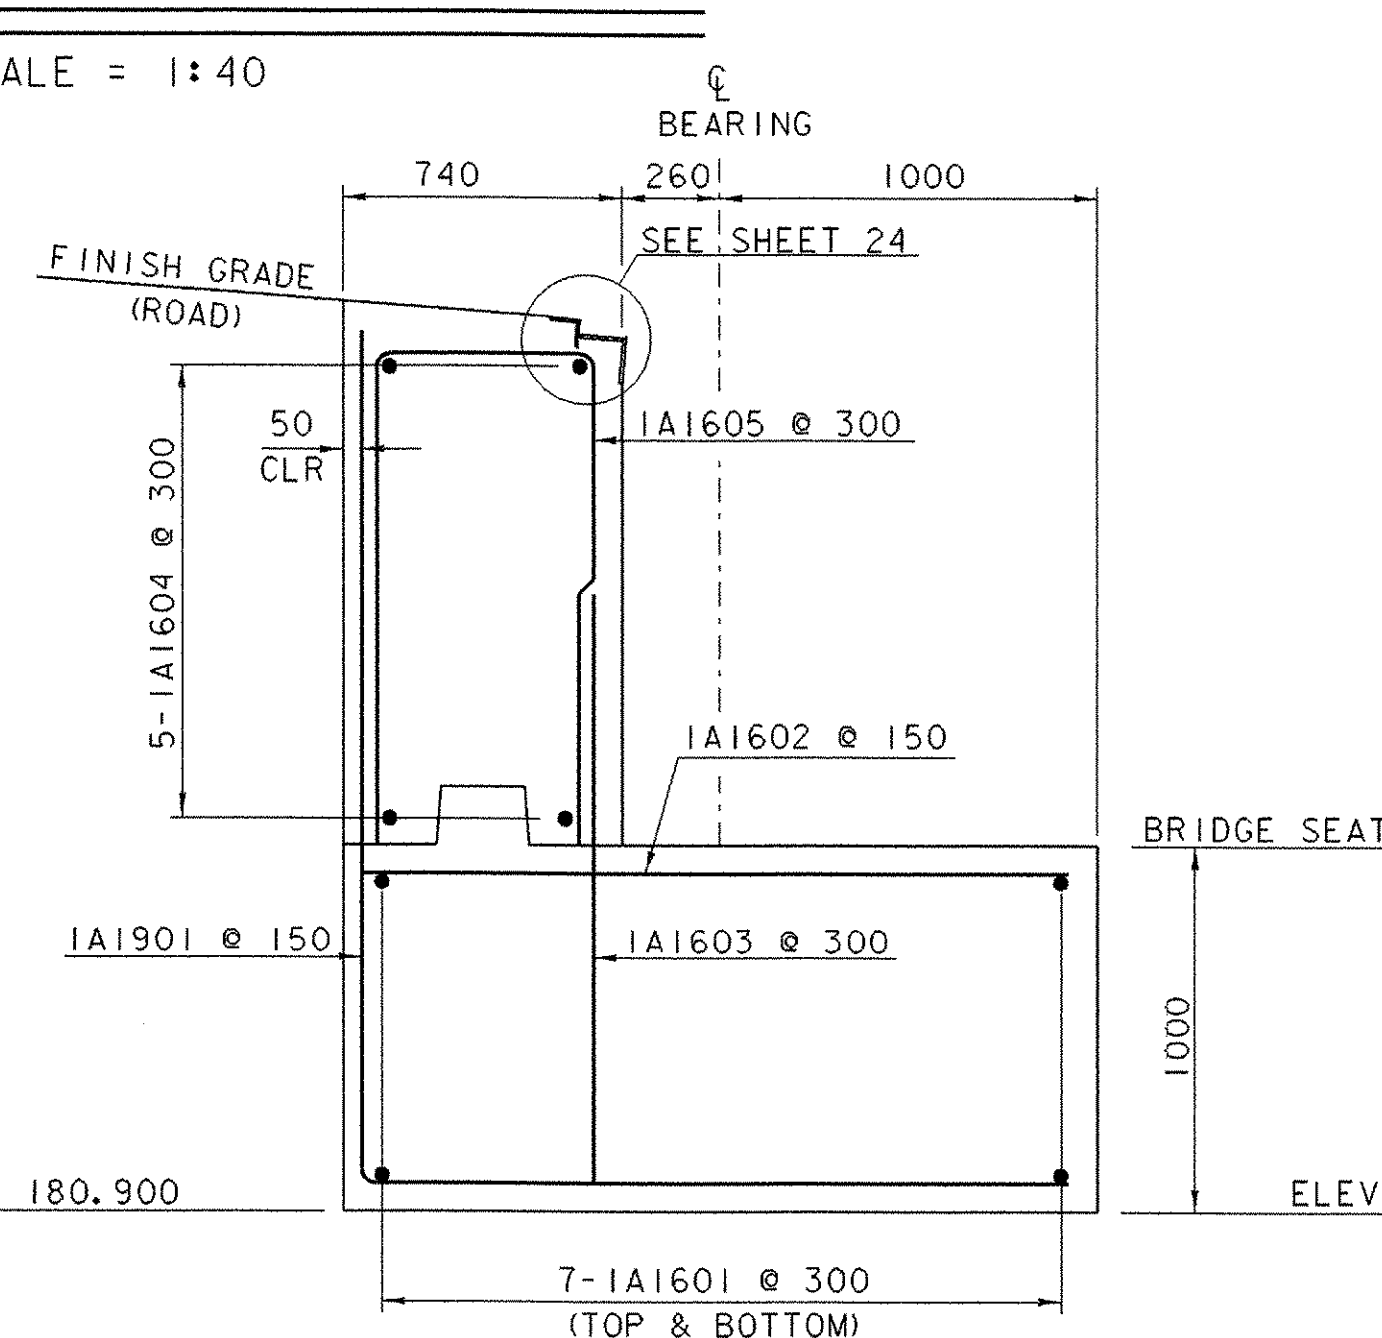

SECTION B-B

SCALE = 1:20

NOTE:  
POUR BACKWALL AFTER  
BRIDGE IS IN PLACE

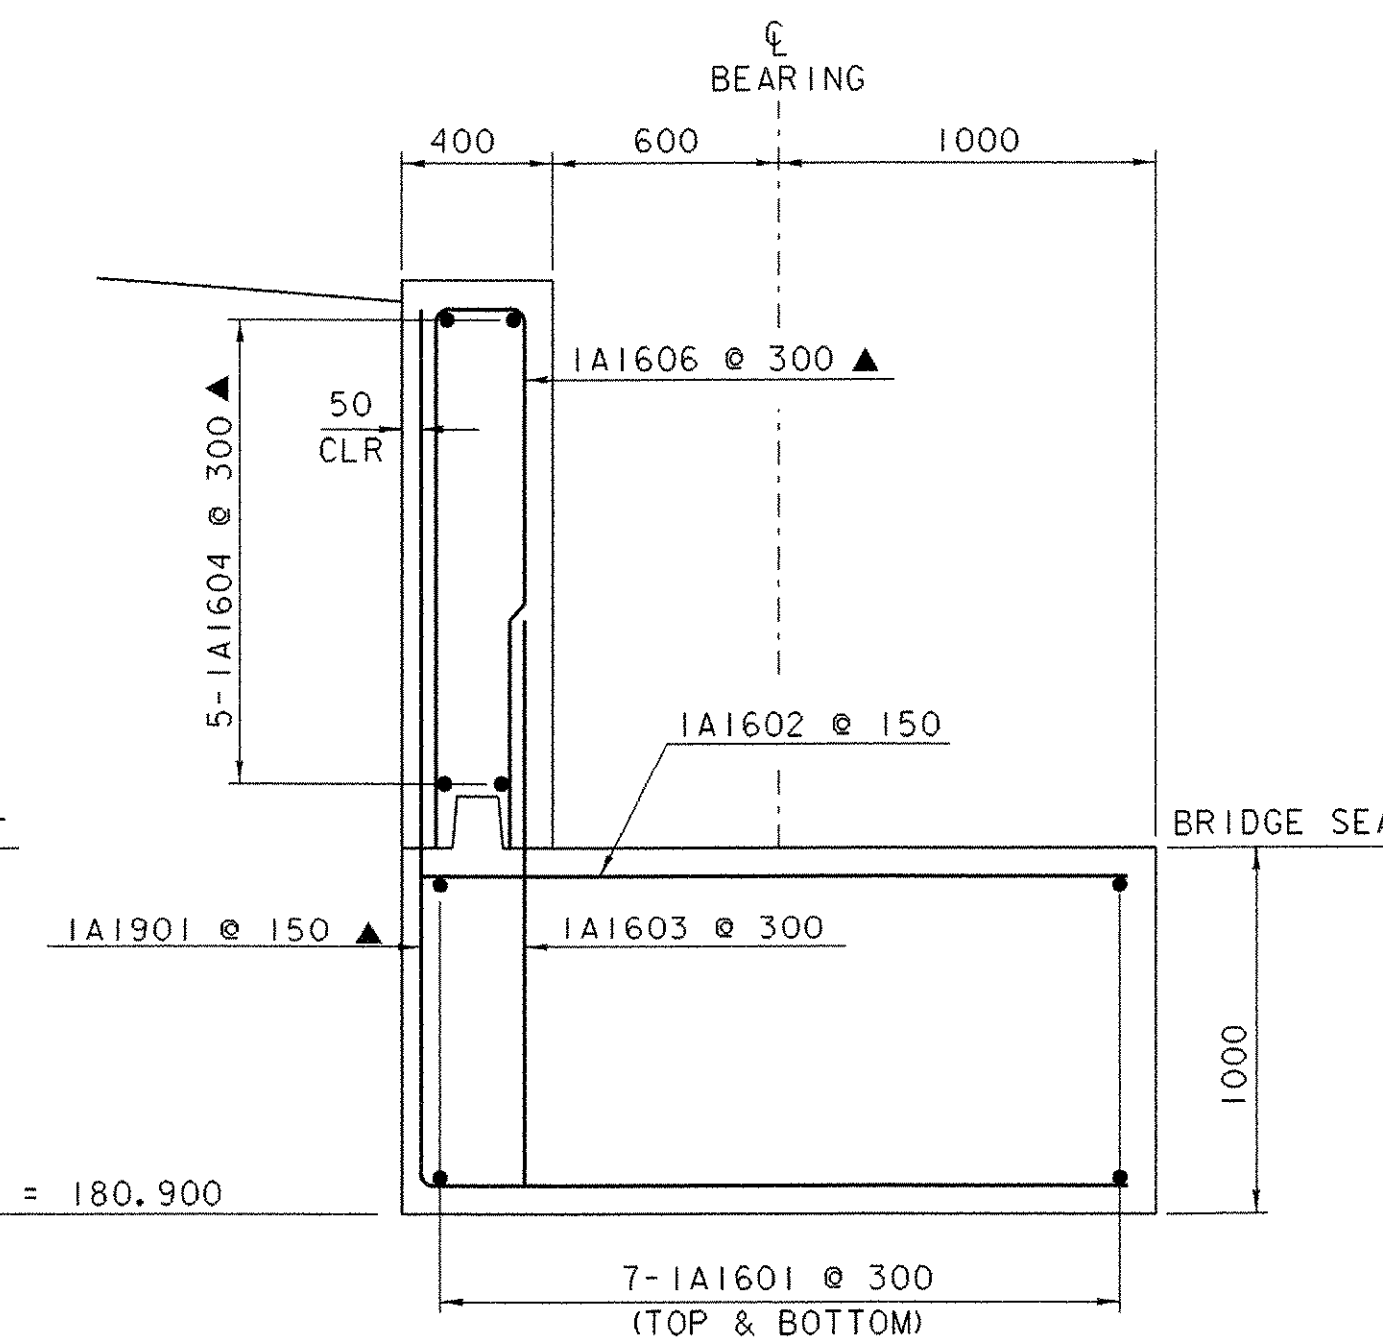

SECTION A-A


SCALE = 1:20

|                        |                                  |              |                    |
|------------------------|----------------------------------|--------------|--------------------|
| PROJECT:               | BETHEL                           | PROJECT NO.: | BRF 0241 (33) - C1 |
| DESIGN FILE NAME:      | 96j250/structures/sj250ab-cl.dgn | PLOT DATE:   | 09-JUL-2003        |
| IPARM FILE NAME:       | s96j250abi.i                     | DRAWN BY:    | K. M. HIGGINS      |
| DESIGNED BY:           | K. M. HIGGINS                    | CHECKED BY:  | C. P. WILLIAMS     |
| SQUAD LEADER:          | C. P. WILLIAMS                   | SHEET:       | 23 OF 47           |
| ABUTMENT NO. 1 DETAILS |                                  |              |                    |








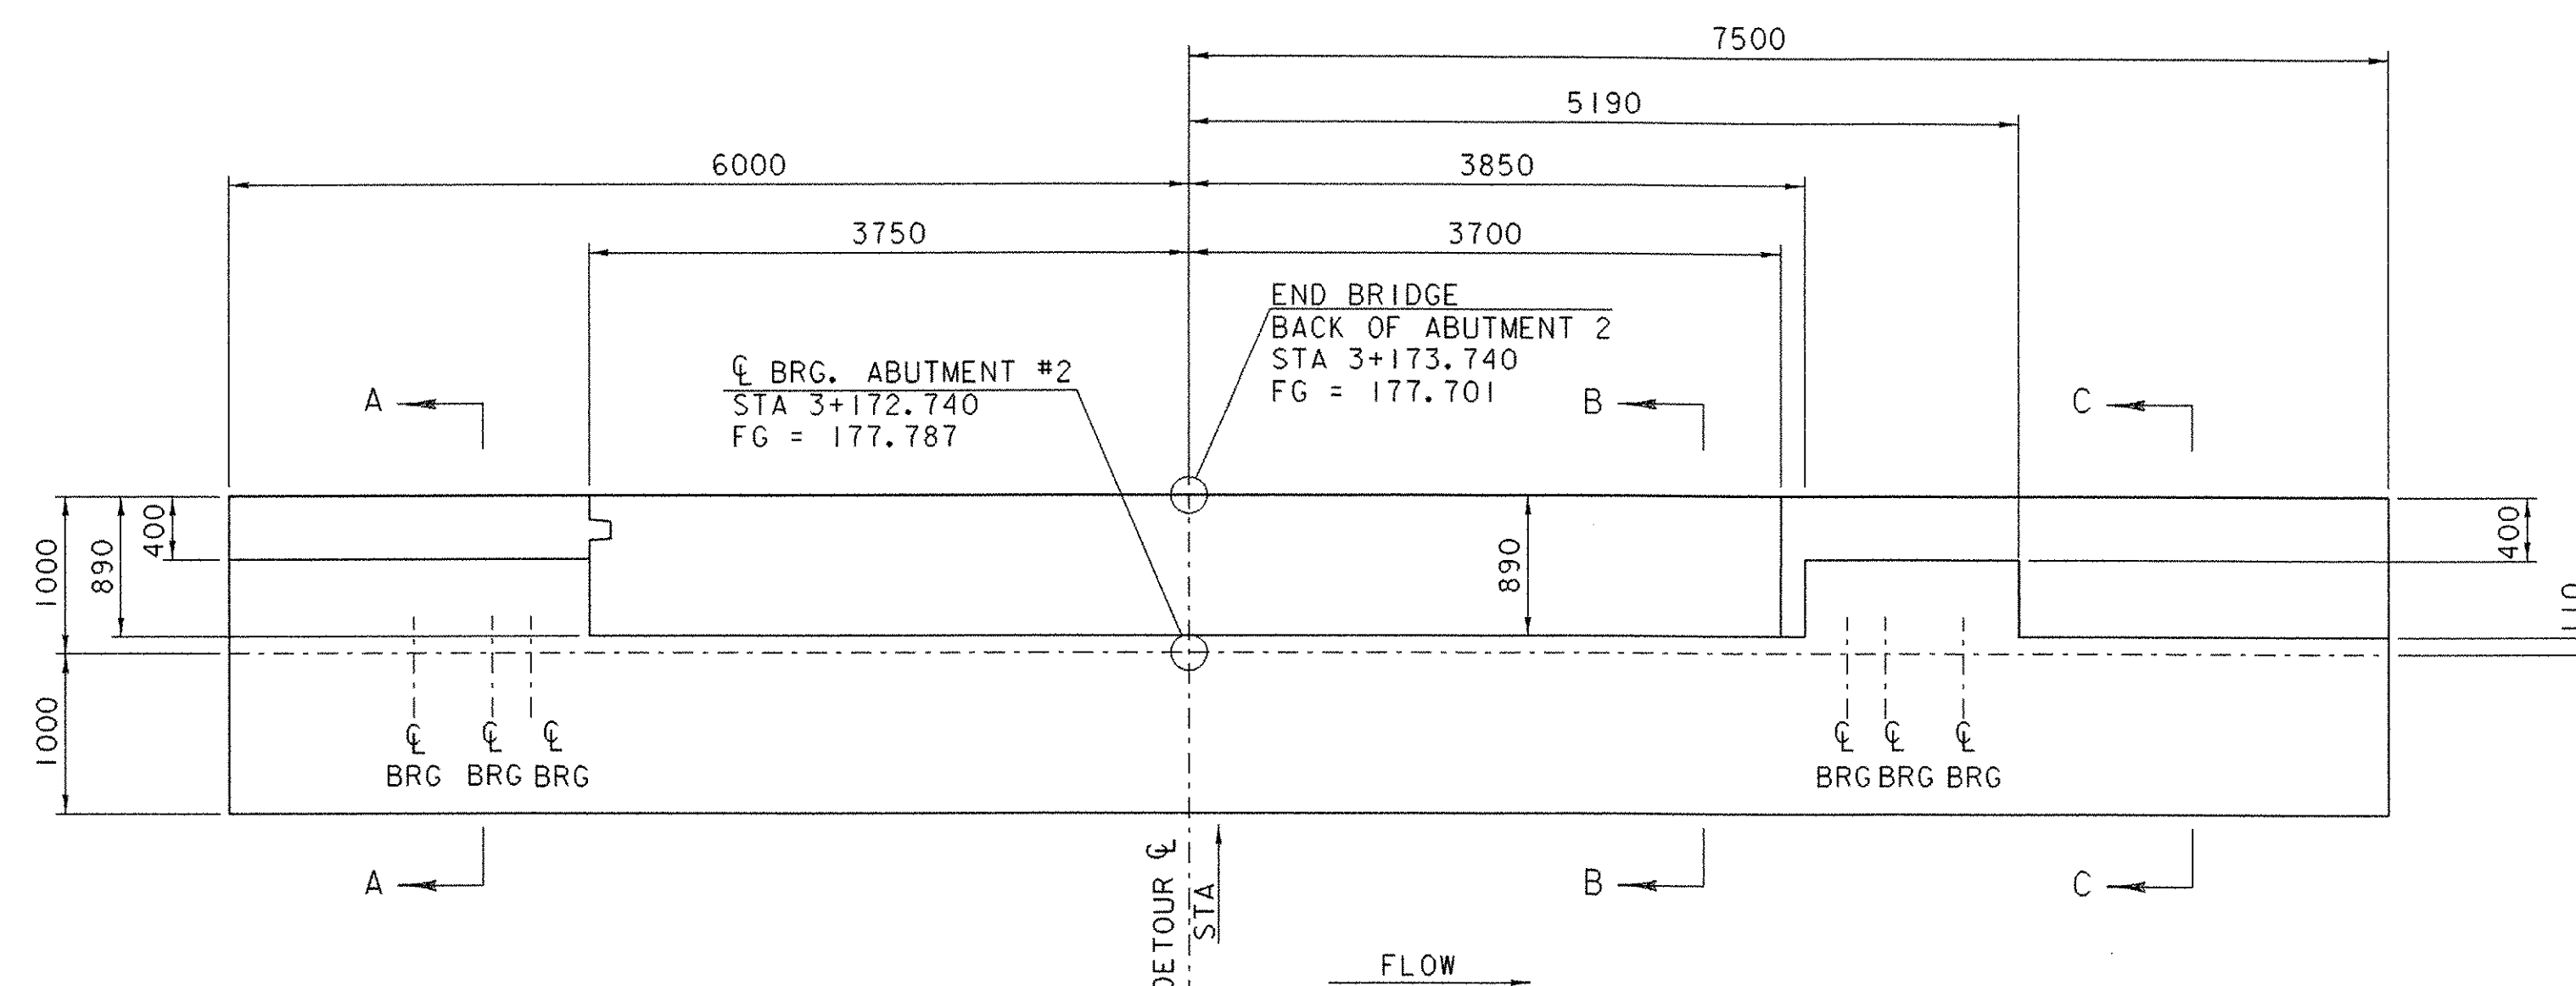


ABUTMENT NO. 2 DIMENSION PLAN

SCALE = 1:40

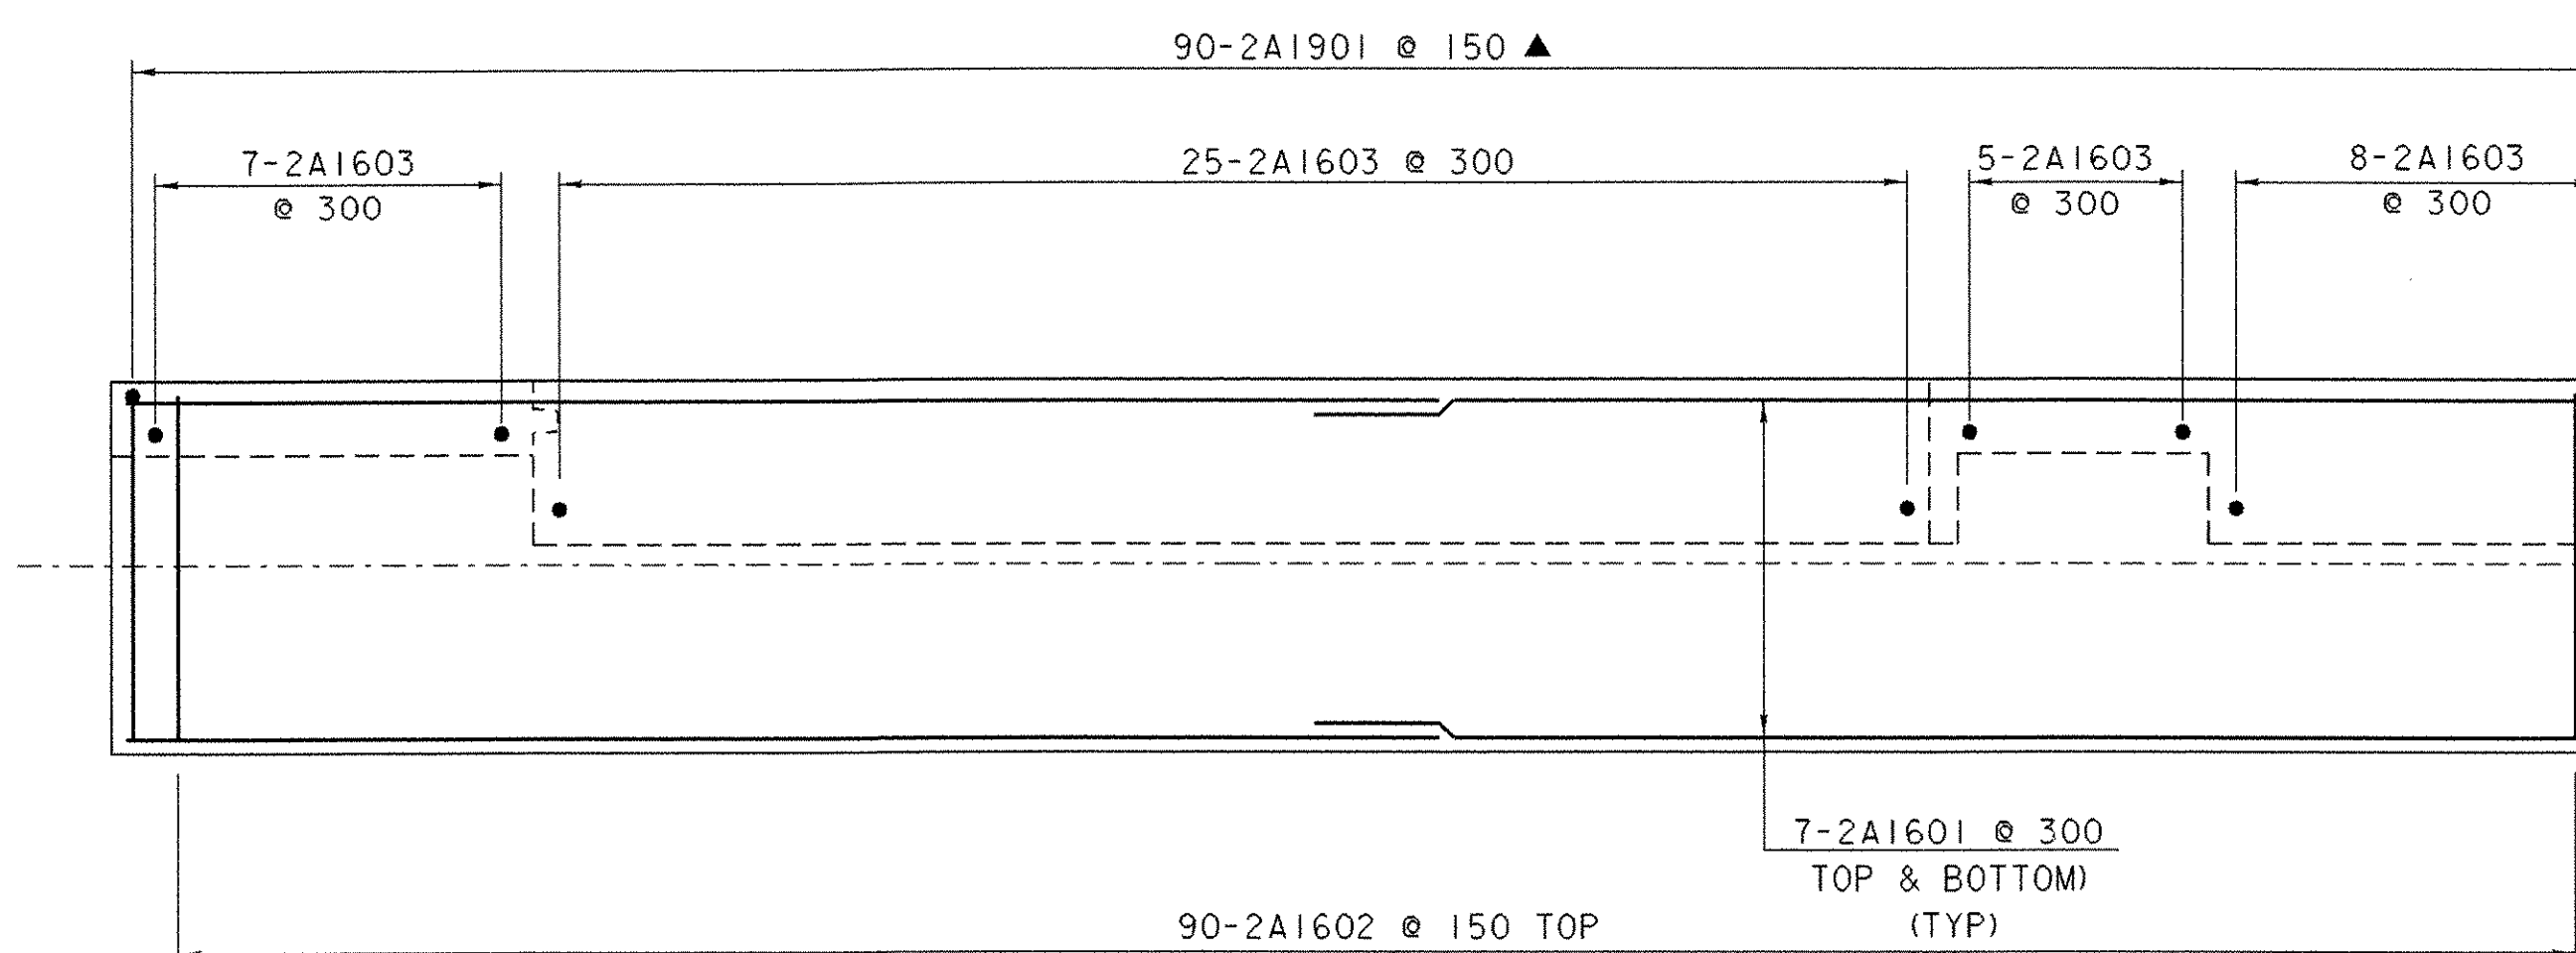


BRIDGE SEAT NO. 2 REINFORCEMENT PLAN

SCALE = 1:40

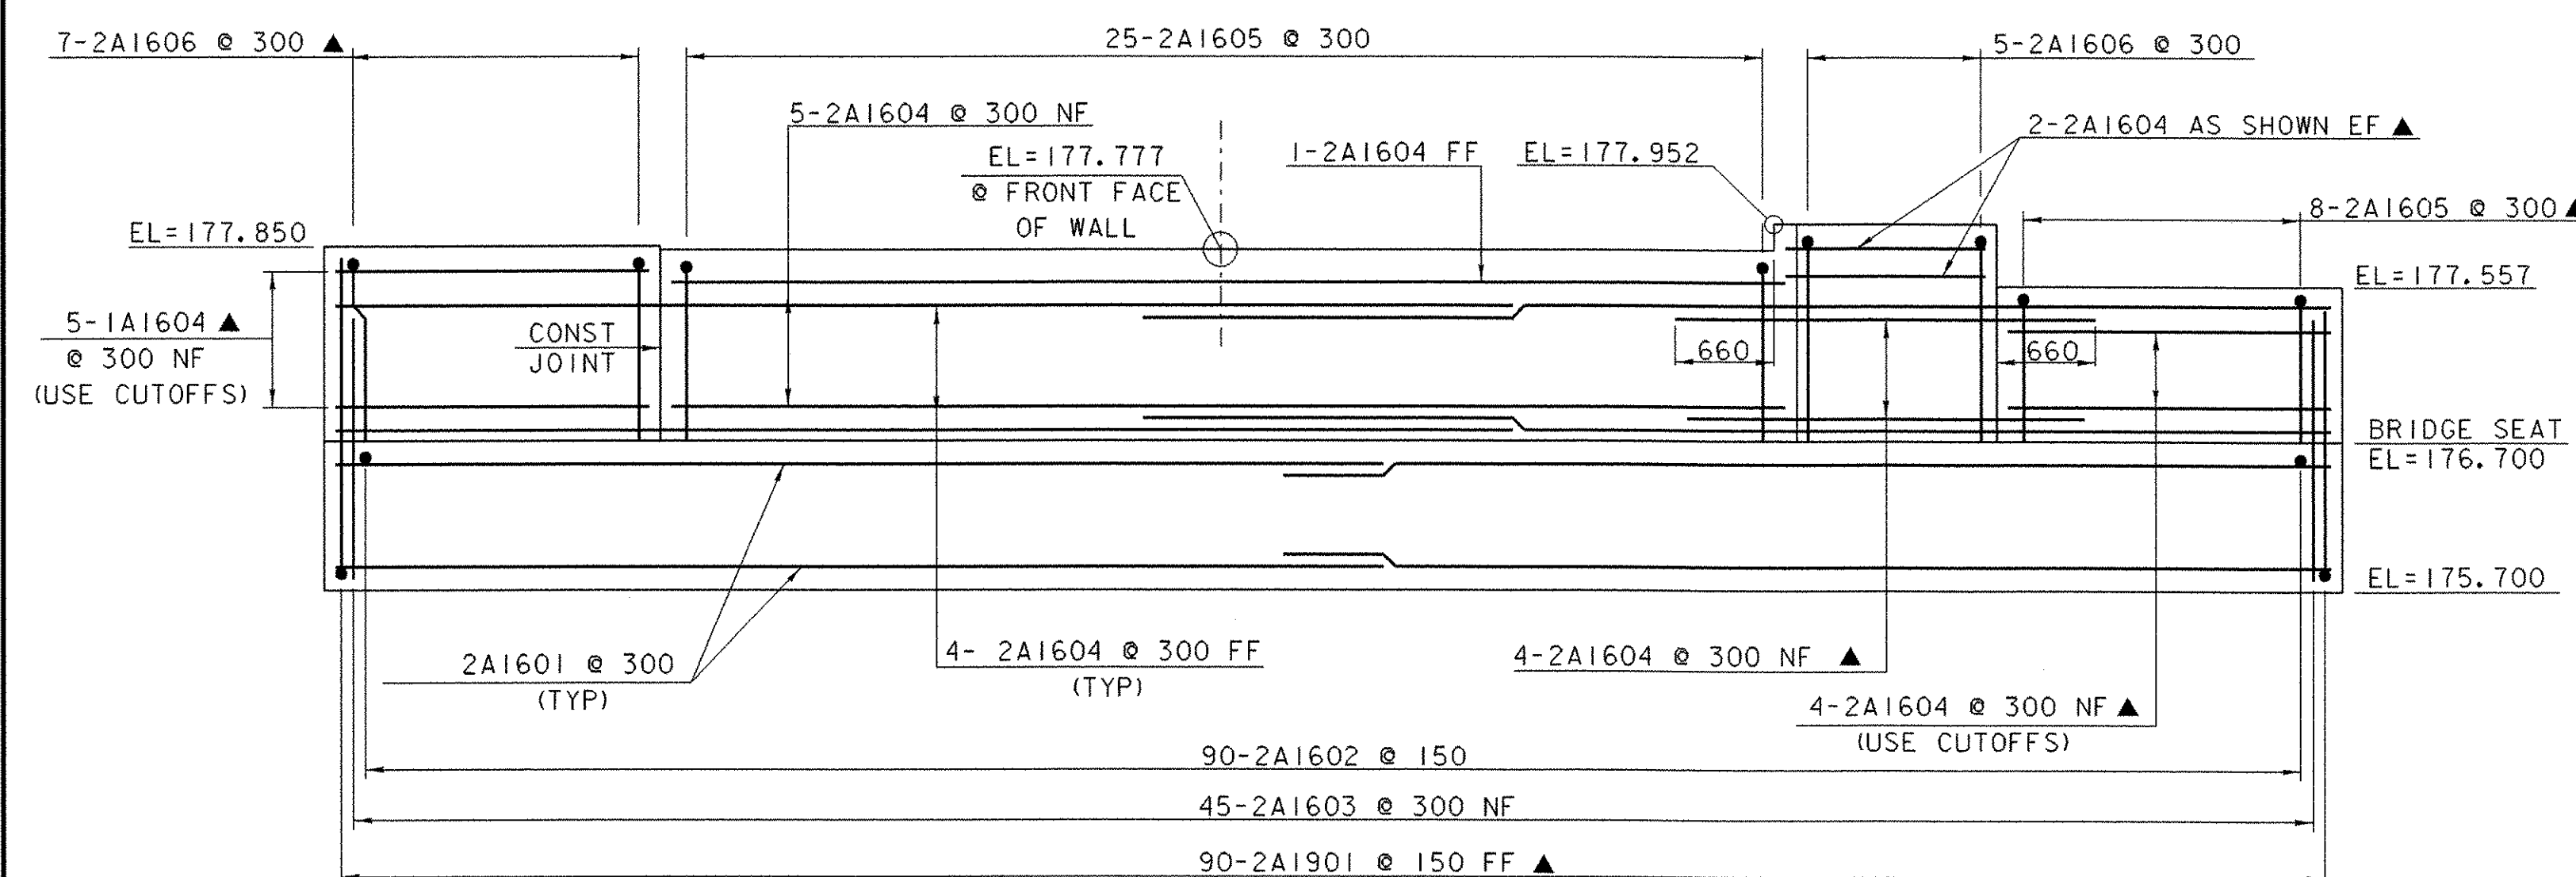


ABUTMENT NO. 2 ELEVATION

SCALE = 1:40

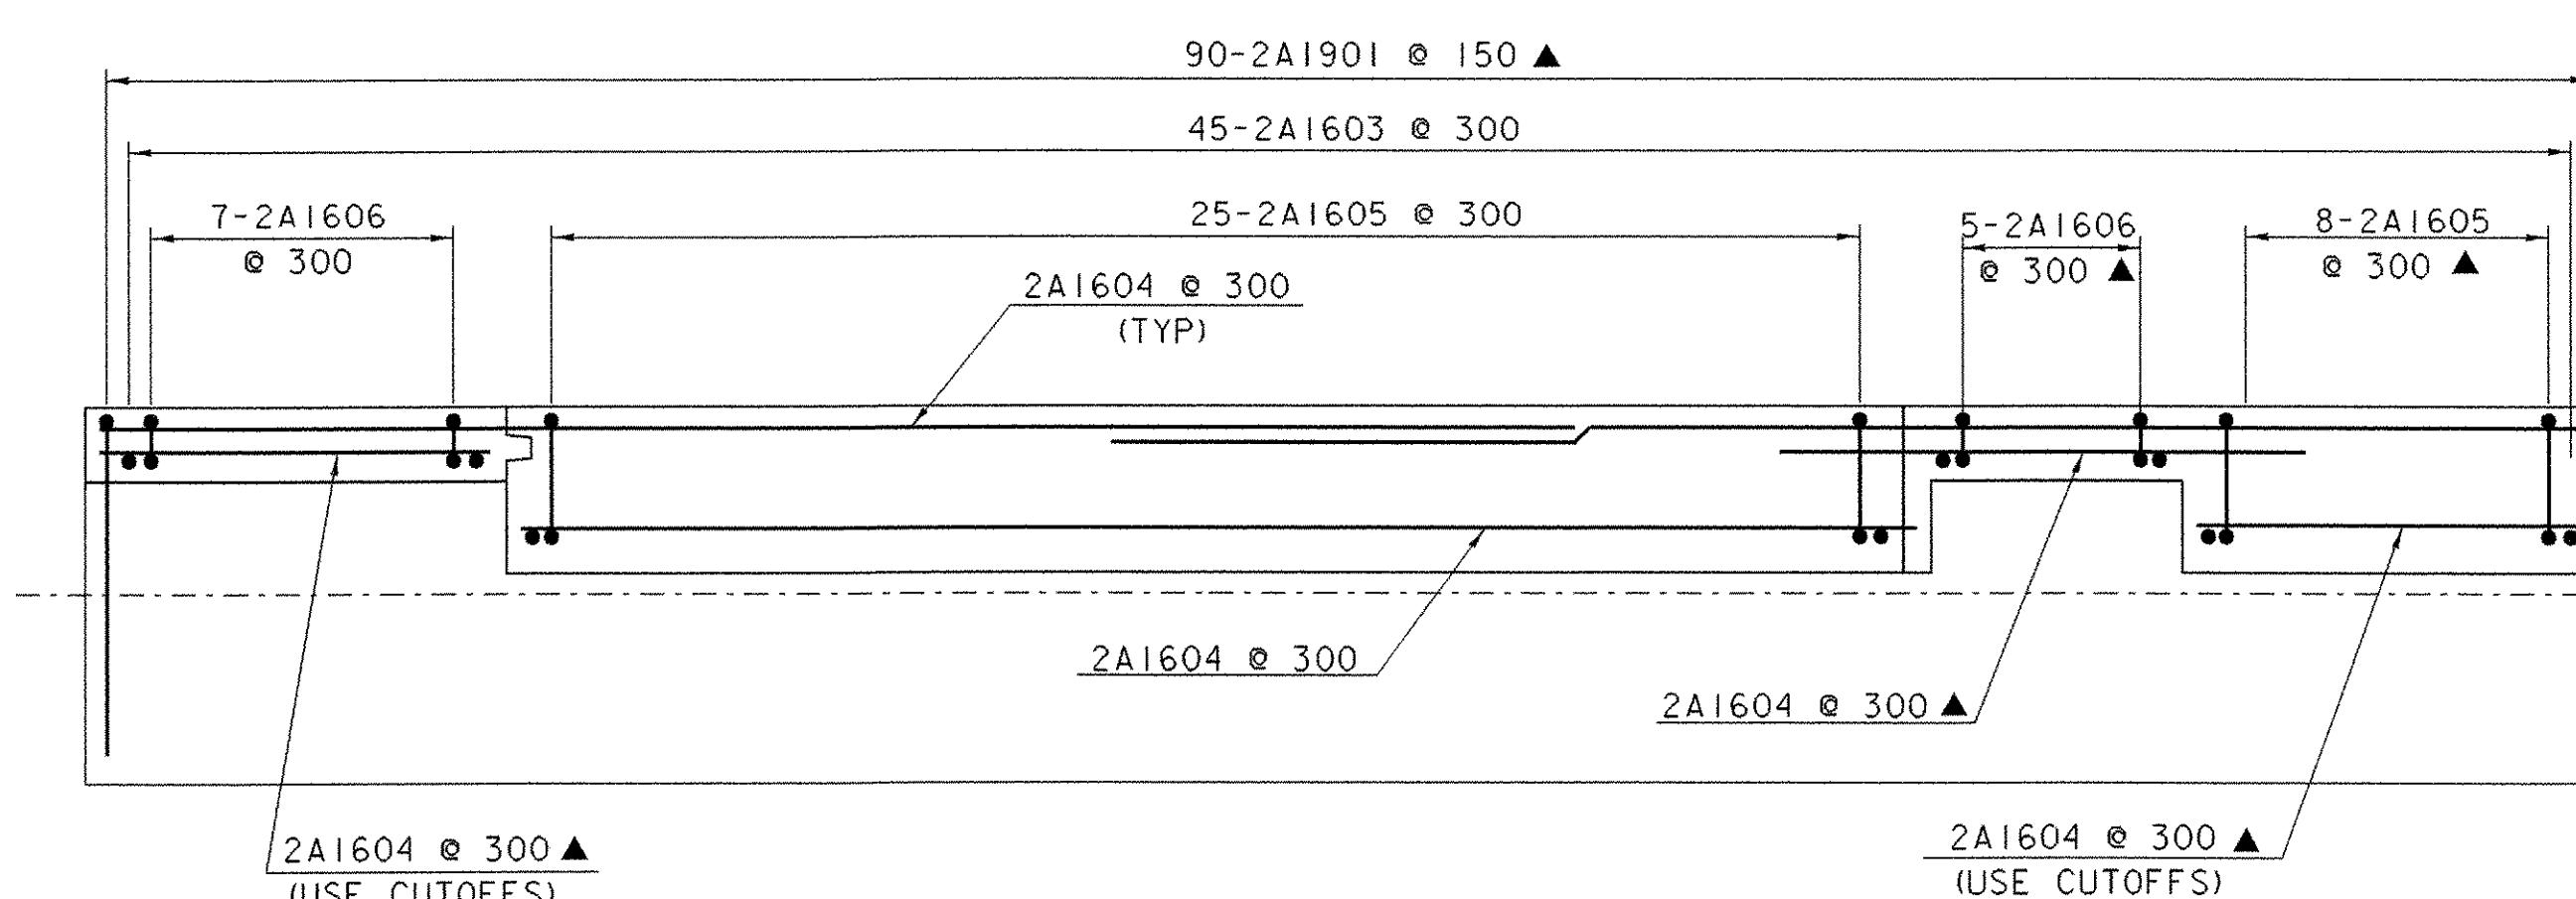


BACKWALL NO. 2 REINFORCEMENT PLAN

SCALE = 1:40

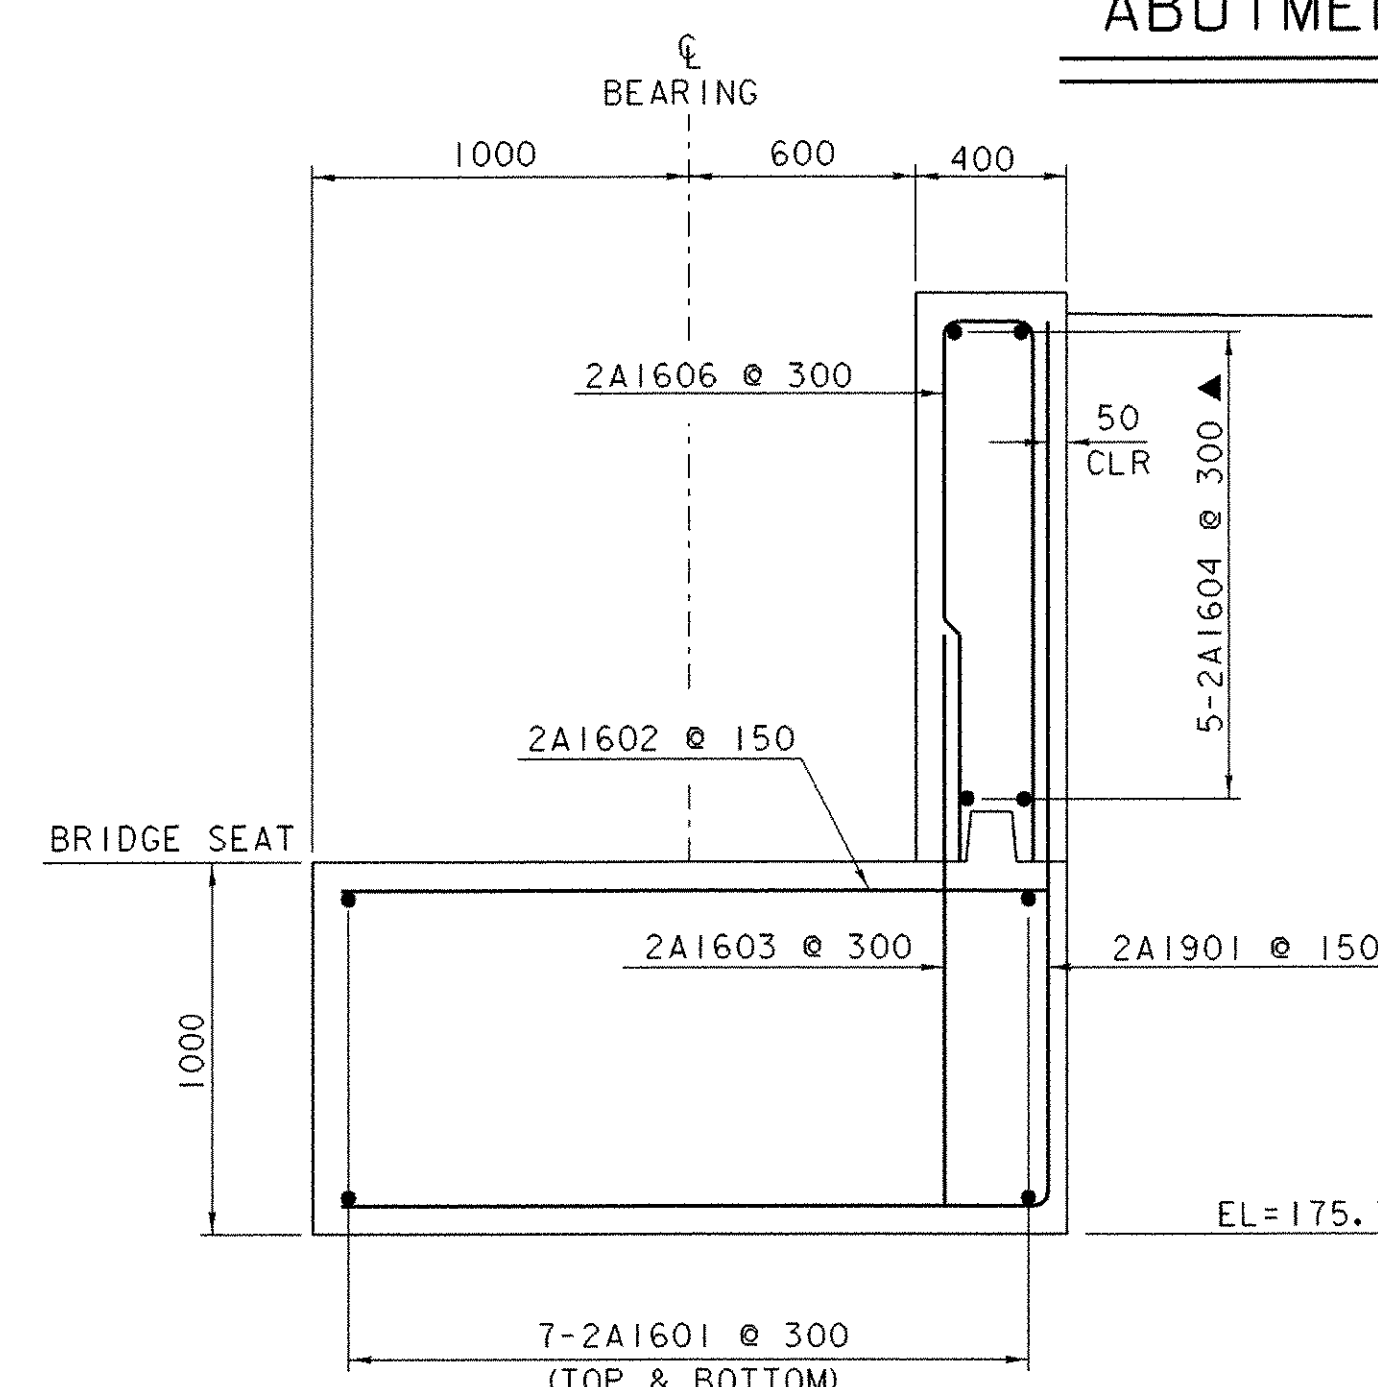


SECTION A-A

SCALE = 1:20

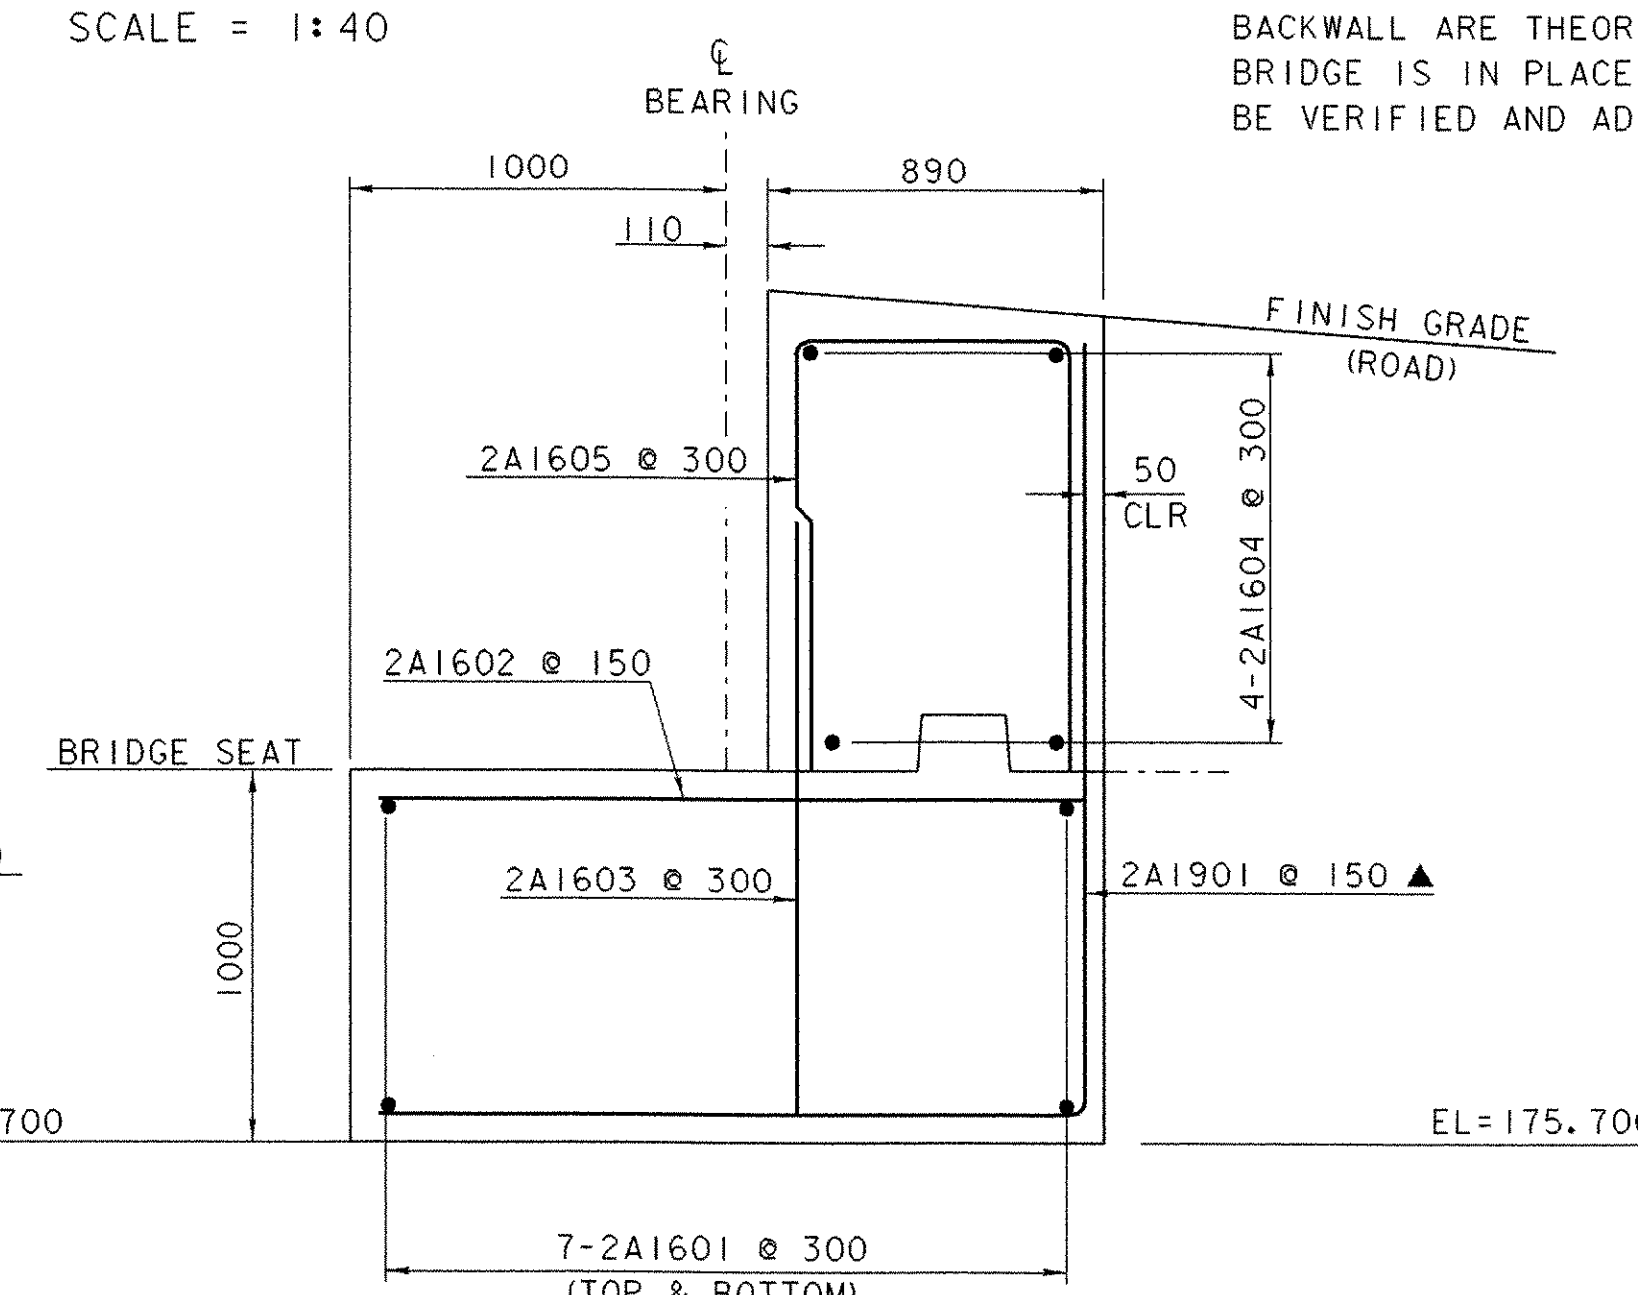

SECTION B-B

SCALE = 1:20

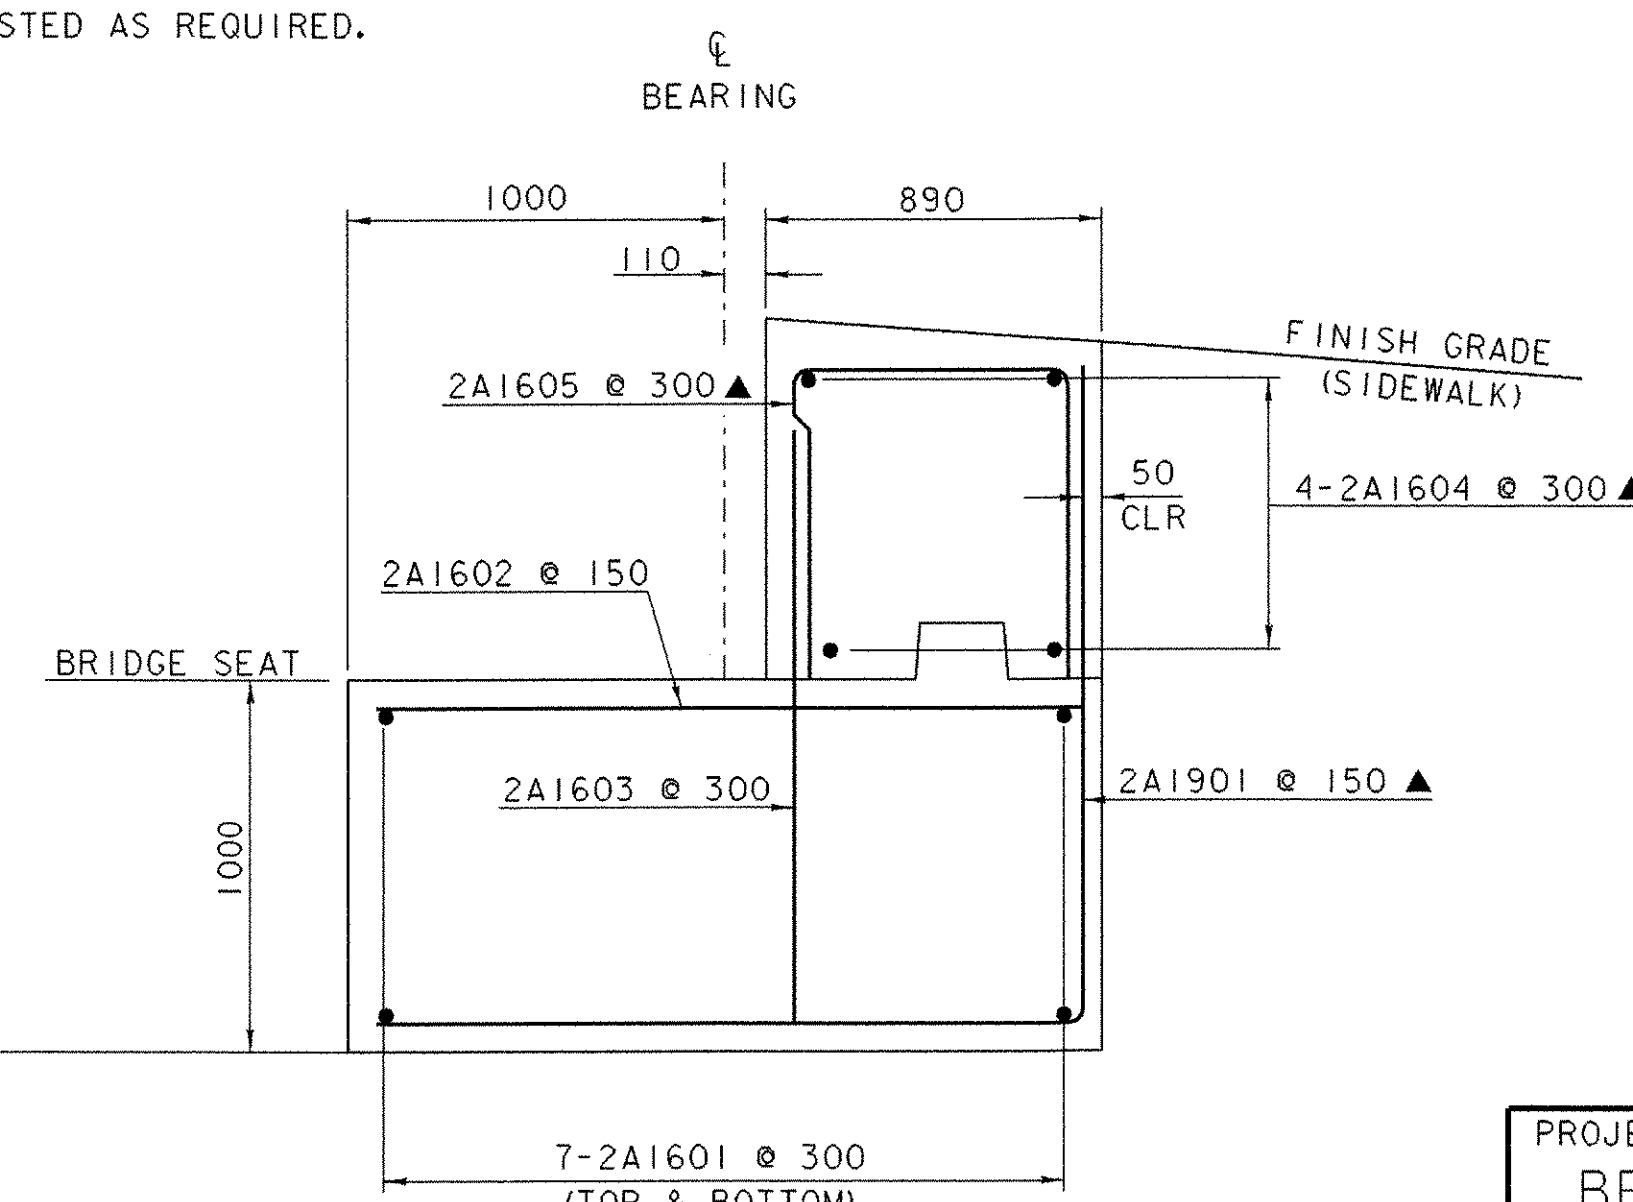

SECTION C-C

SCALE = 1:20

NOTE:  
ALL DIMENSIONS AND ELEVATIONS SHOWN ALONG  
BACKWALL ARE THEORETICAL. AFTER THE  
BRIDGE IS IN PLACE ALL DIMENSIONS SHALL  
BE VERIFIED AND ADJUSTED AS REQUIRED.

NOTE:  
POUR BACKWALL AFTER  
BRIDGE IS IN PLACE

NOTE:

NF = NEAR FACE  
FF = FAR FACE  
EF = EACH FACE  
▲ = CUT TO FIT IN FIELD  
75 CLR. UNLESS OTHERWISE  
SPECIFIED ON THE PLANS.  
ALL LAPS 660 UNLESS OTHERWISE  
SPECIFIED ON THE PLANS.




SCALE = 1:20



SCALE = 1:40


|                                                    |                                           |
|----------------------------------------------------|-------------------------------------------|
| PROJECT:<br><b>BETHEL</b>                          | PROJECT NO.:<br><b>BRF 0241 (33) - C1</b> |
| DESIGN FILE NAME: 96j250/structures/sj250ab-cl.dgn | PLOT DATE: 09-JUL-2003                    |
| IPARM FILE NAME: s96j250ab2.i                      | DRAWN BY: K. H. HIGGINS                   |
| DESIGNED BY: K. M. HIGGINS                         | CHECKED BY: C. P. WILLIAMS                |
| SQUAD LEADER: C. P. WILLIAMS                       | SHEET: 25 OF 47                           |
| ABUTMENT NO. 2 DETAILS                             |                                           |



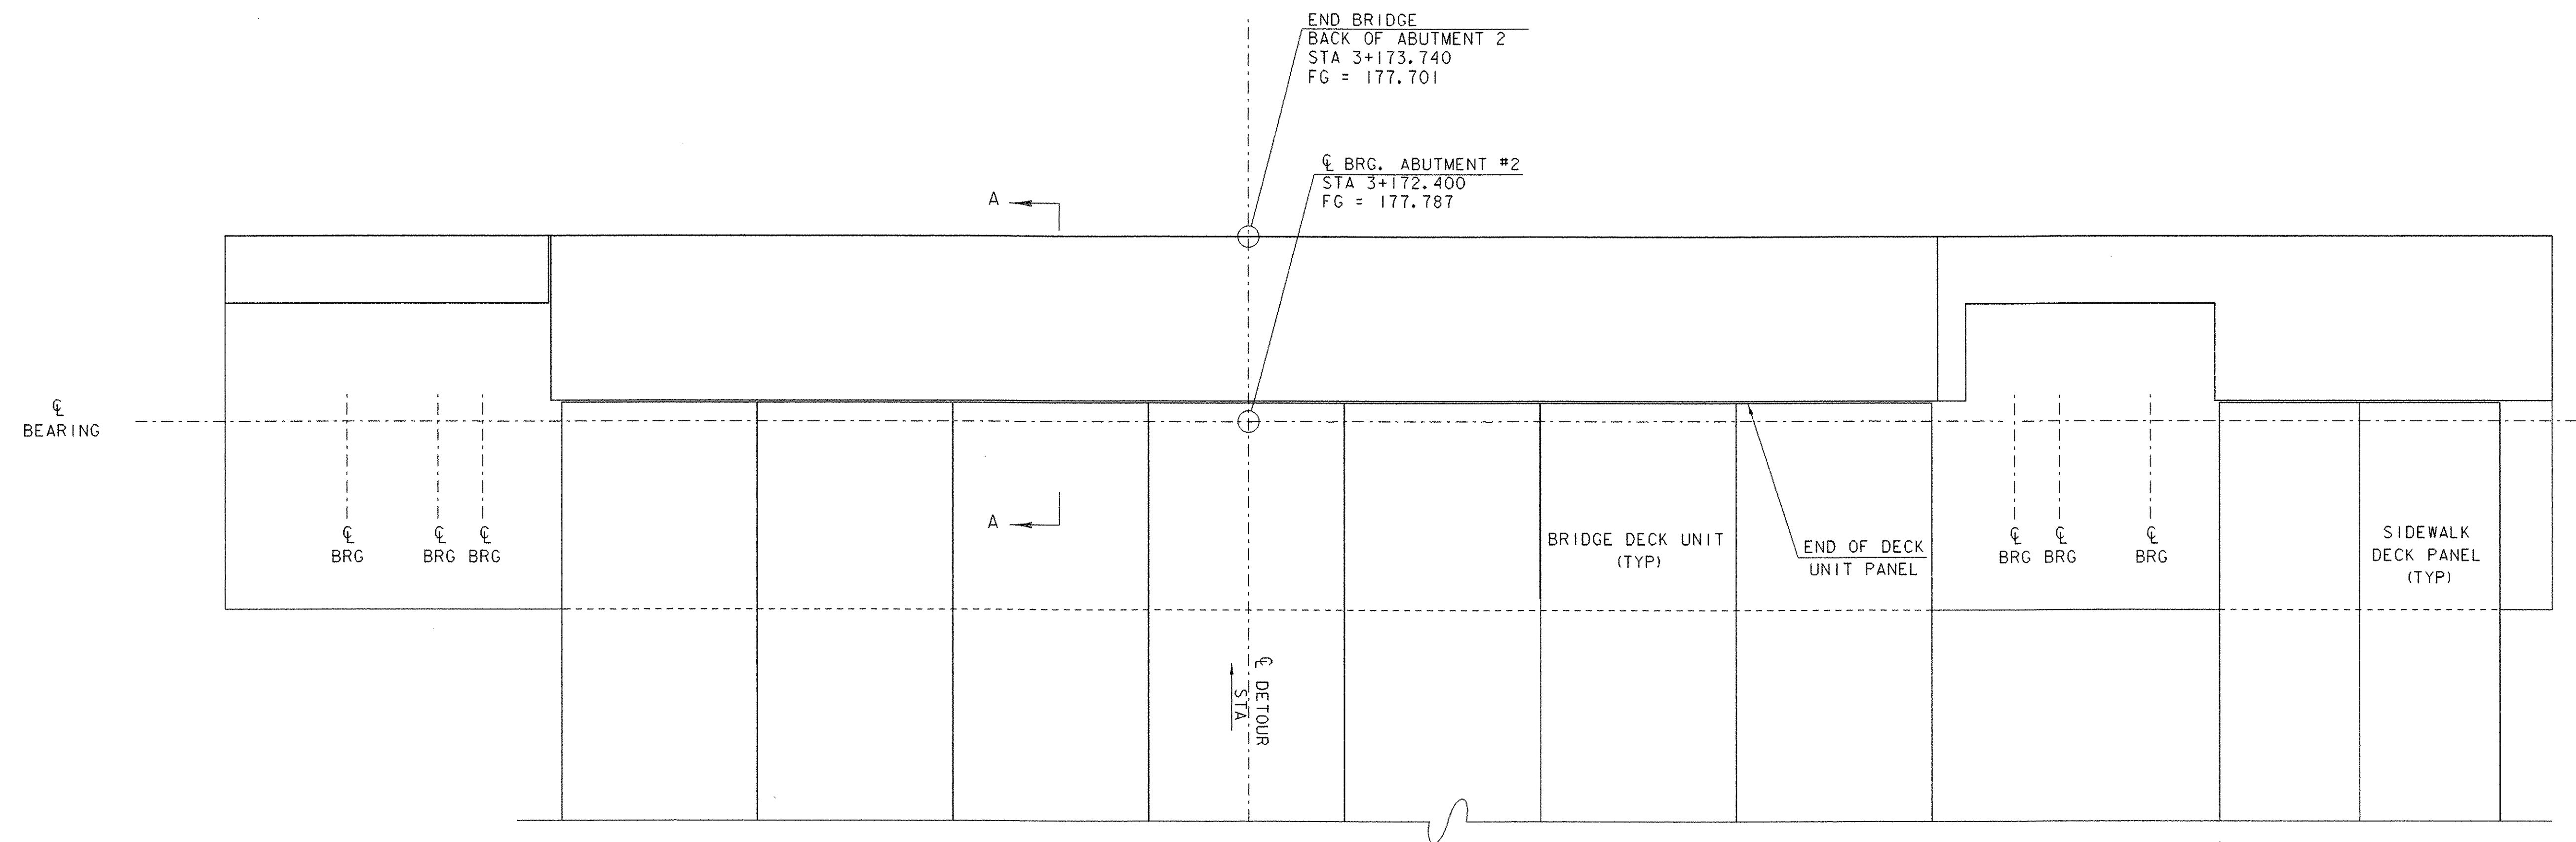


### END OF BRIDGE PLAN

SCALE = 1:20

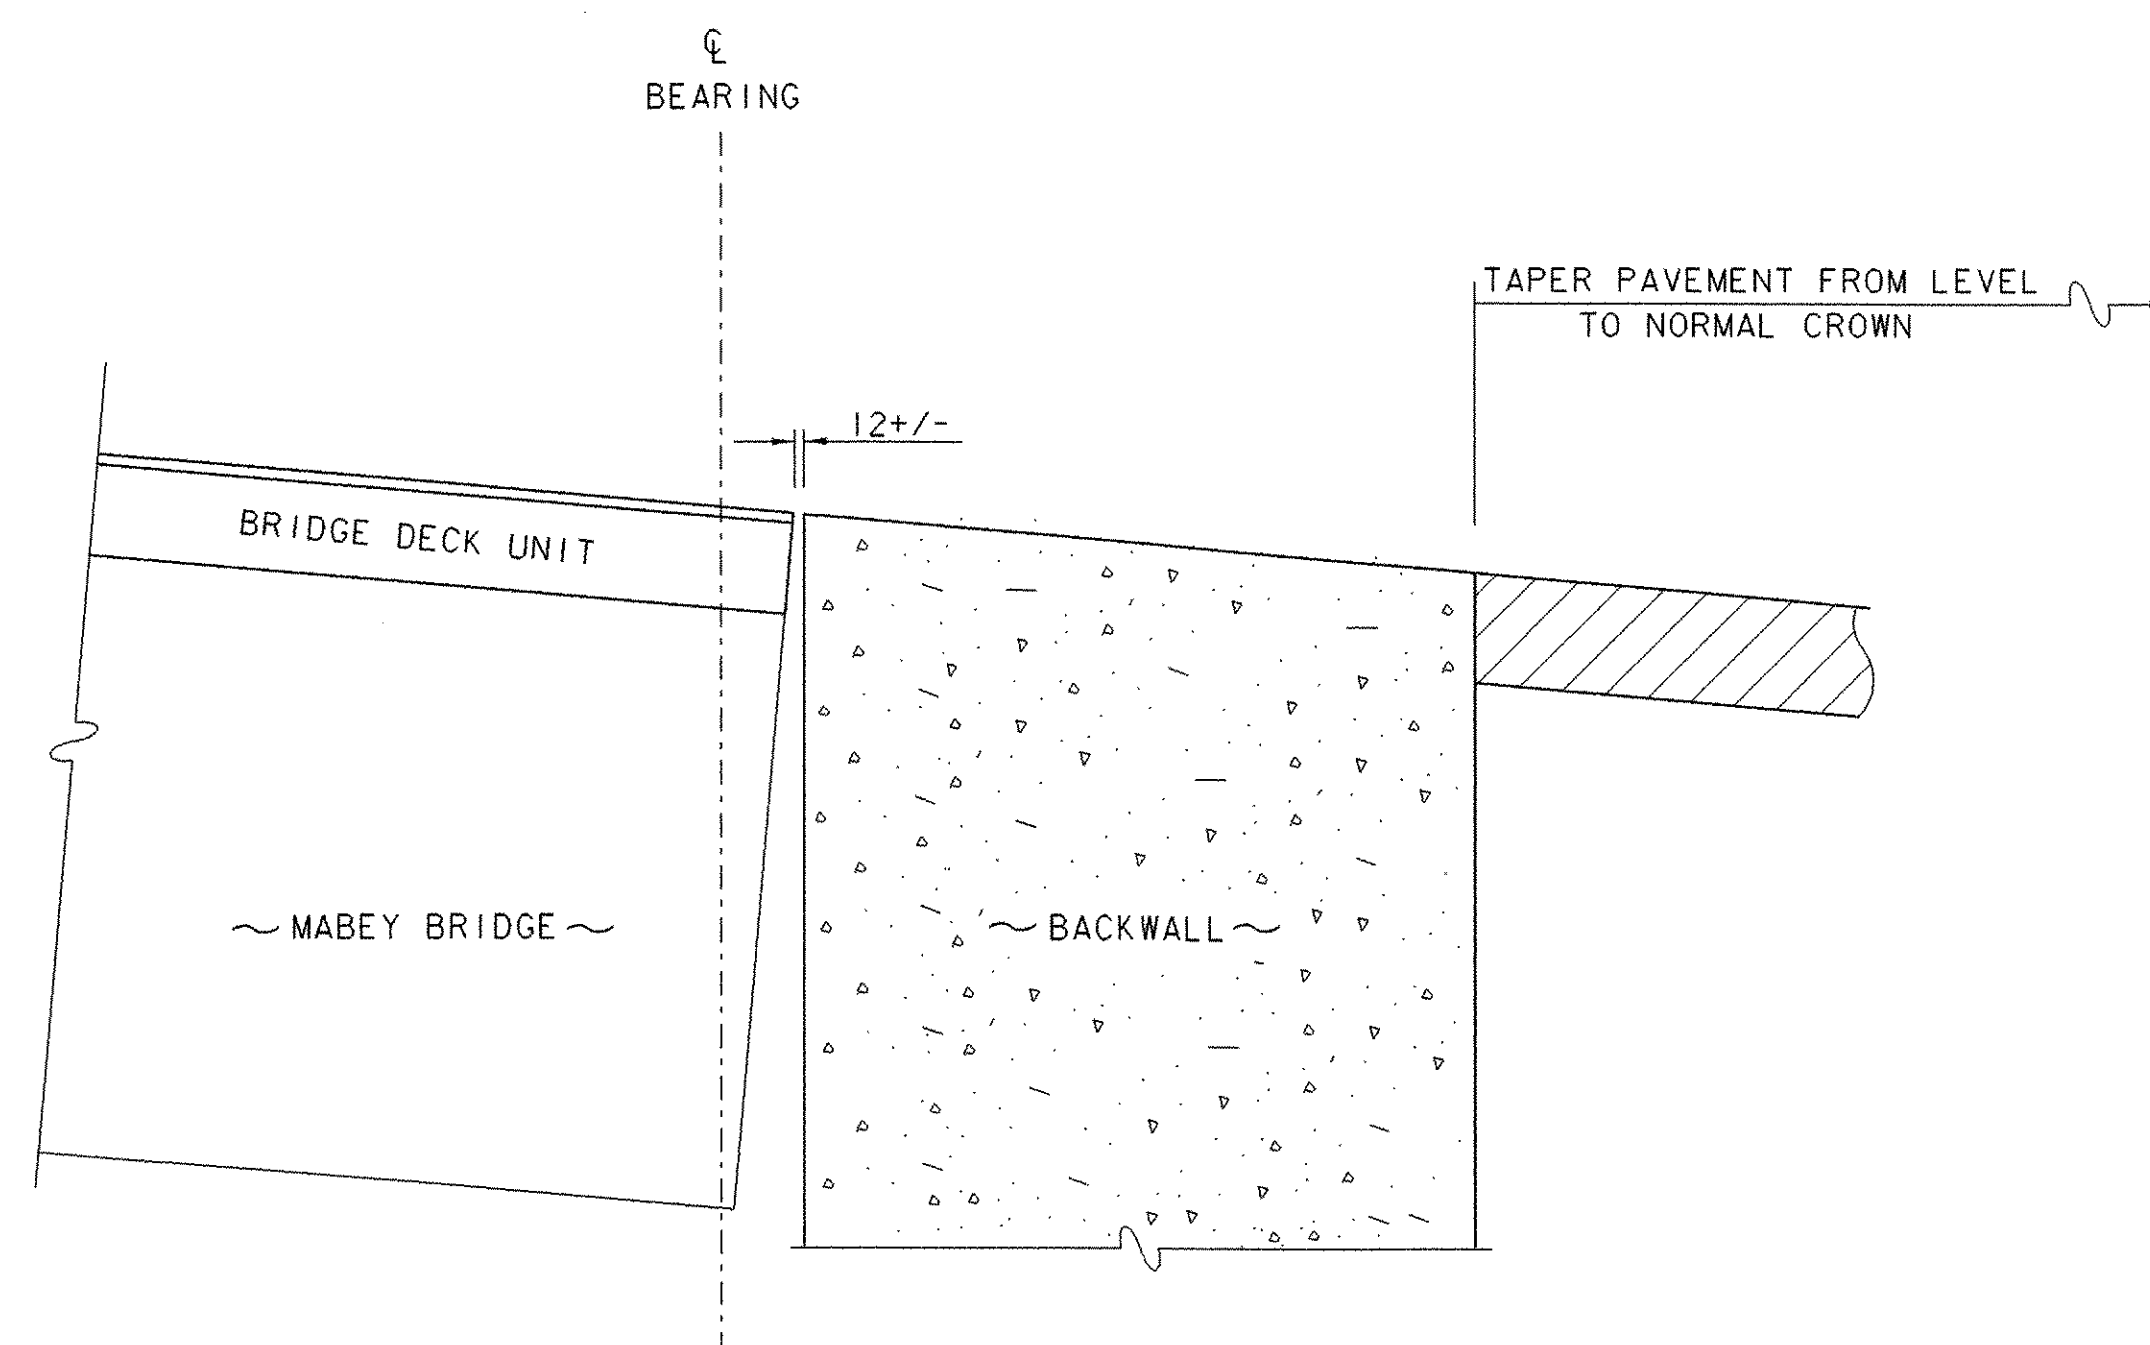


### SECTION A-A

SCALE = 1:10

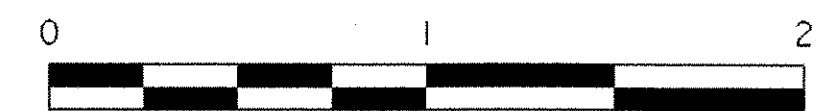


SCALE = 1:20

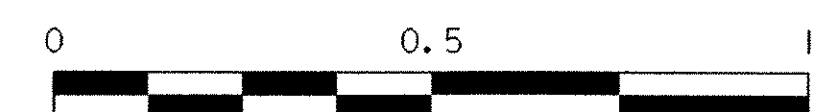



SCALE = 1:10

|                                                    |                                   |
|----------------------------------------------------|-----------------------------------|
| PROJECT:<br>BETHEL                                 | PROJECT NO.:<br>BRF 0241 (33) -C1 |
| DESIGN FILE NAME: 96j250/structures/sj250ab-cl.dgn | PLOT DATE: 09-JUL-2003            |
| IPARM FILE NAME: s96j250eb.i                       | DRAWN BY: K. M. HIGGINS           |
| DESIGNED BY: K. M. HIGGINS                         | CHECKED BY: C. P. WILLIAMS        |
| SQUAD LEADER: C. P. WILLIAMS                       | END OF BRIDGE DETAILS             |
|                                                    | SHEET: 26 OF 47                   |




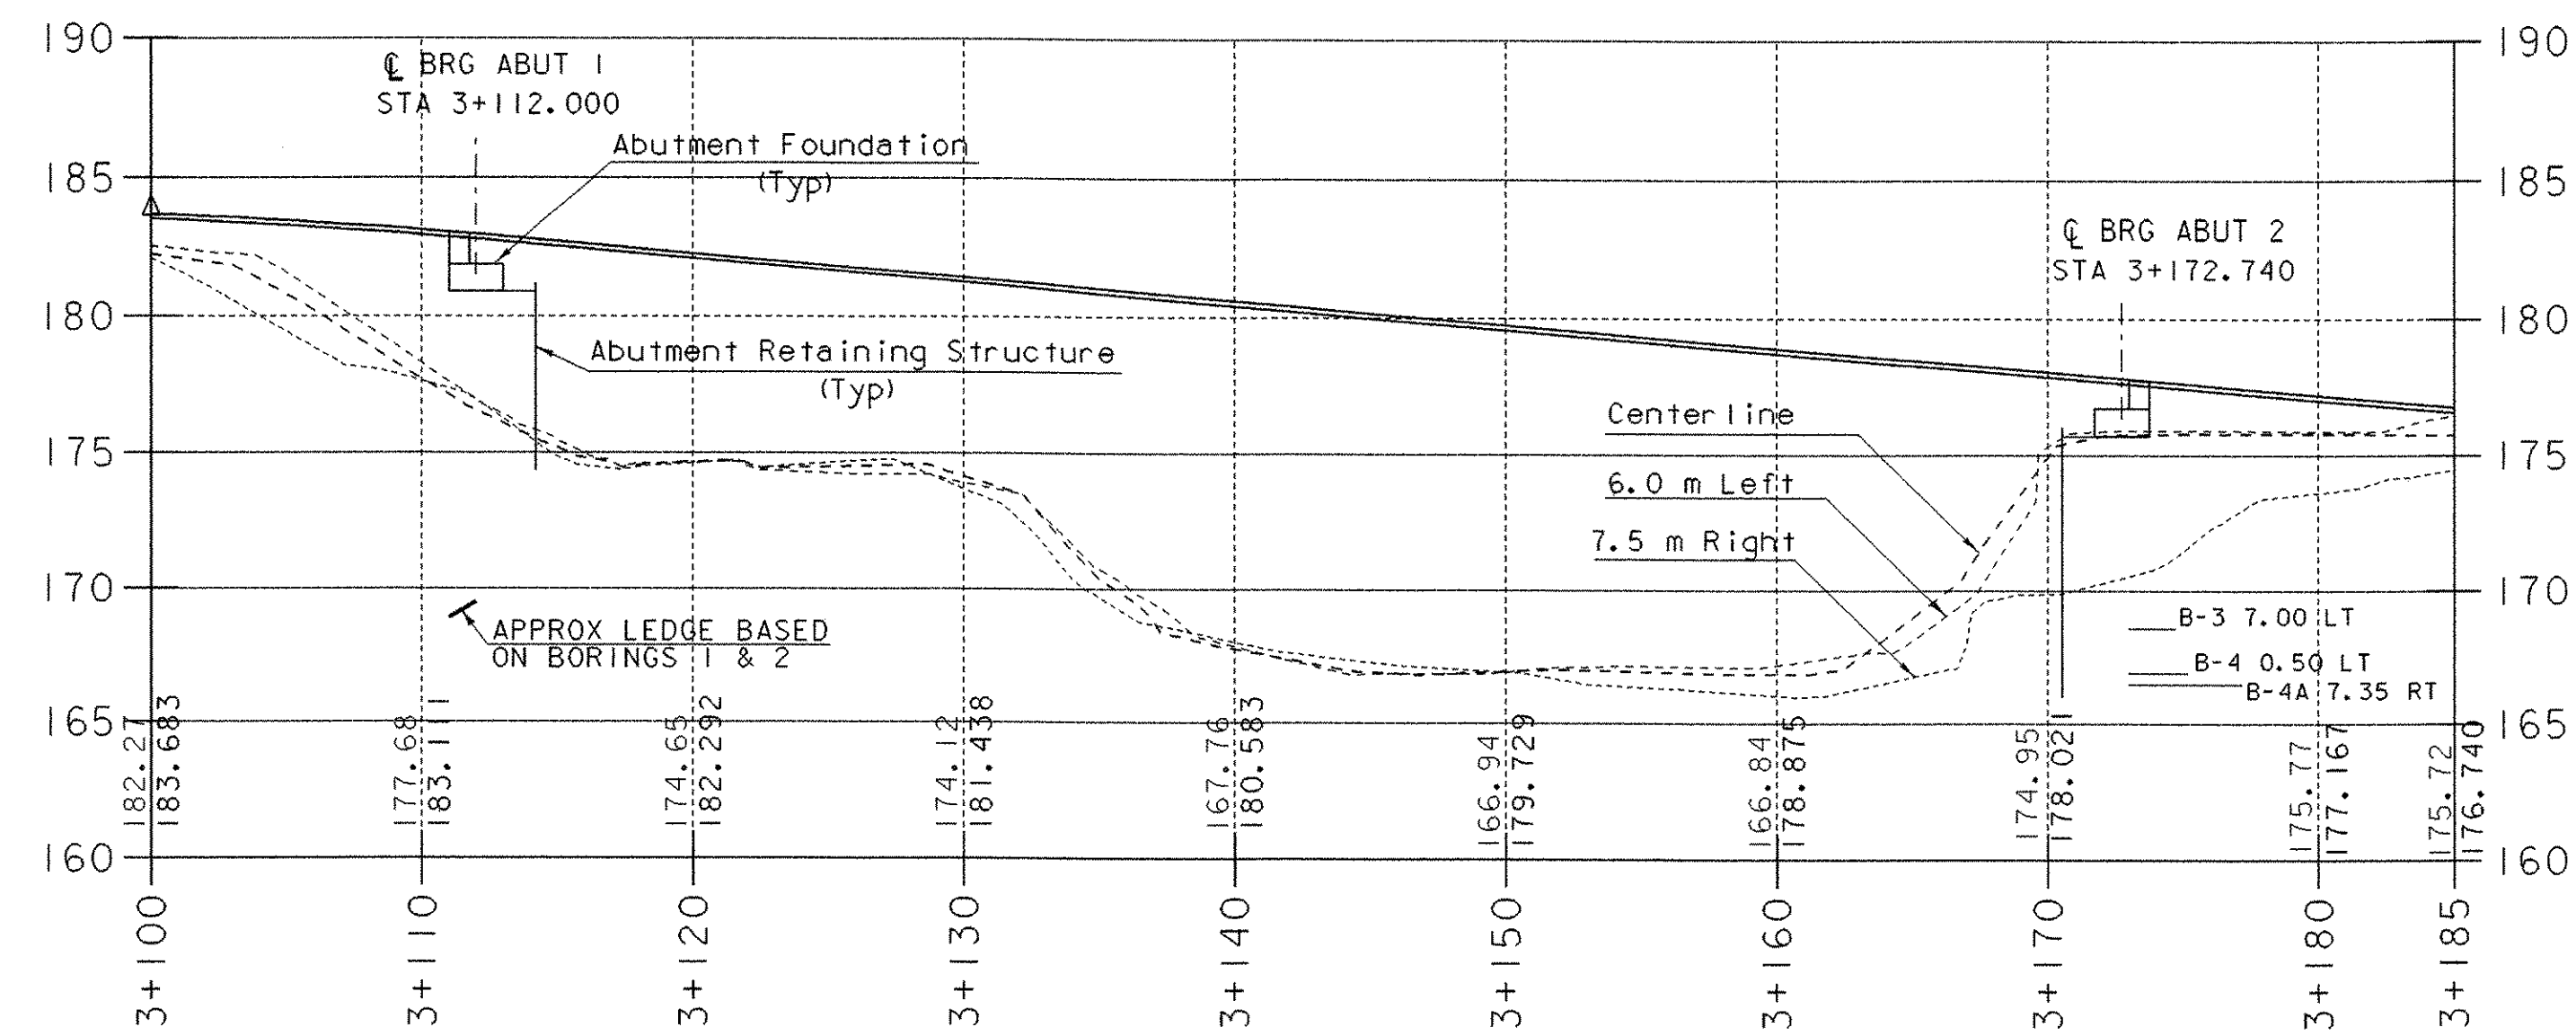

Profile Along Detour Centerline (with offsets)

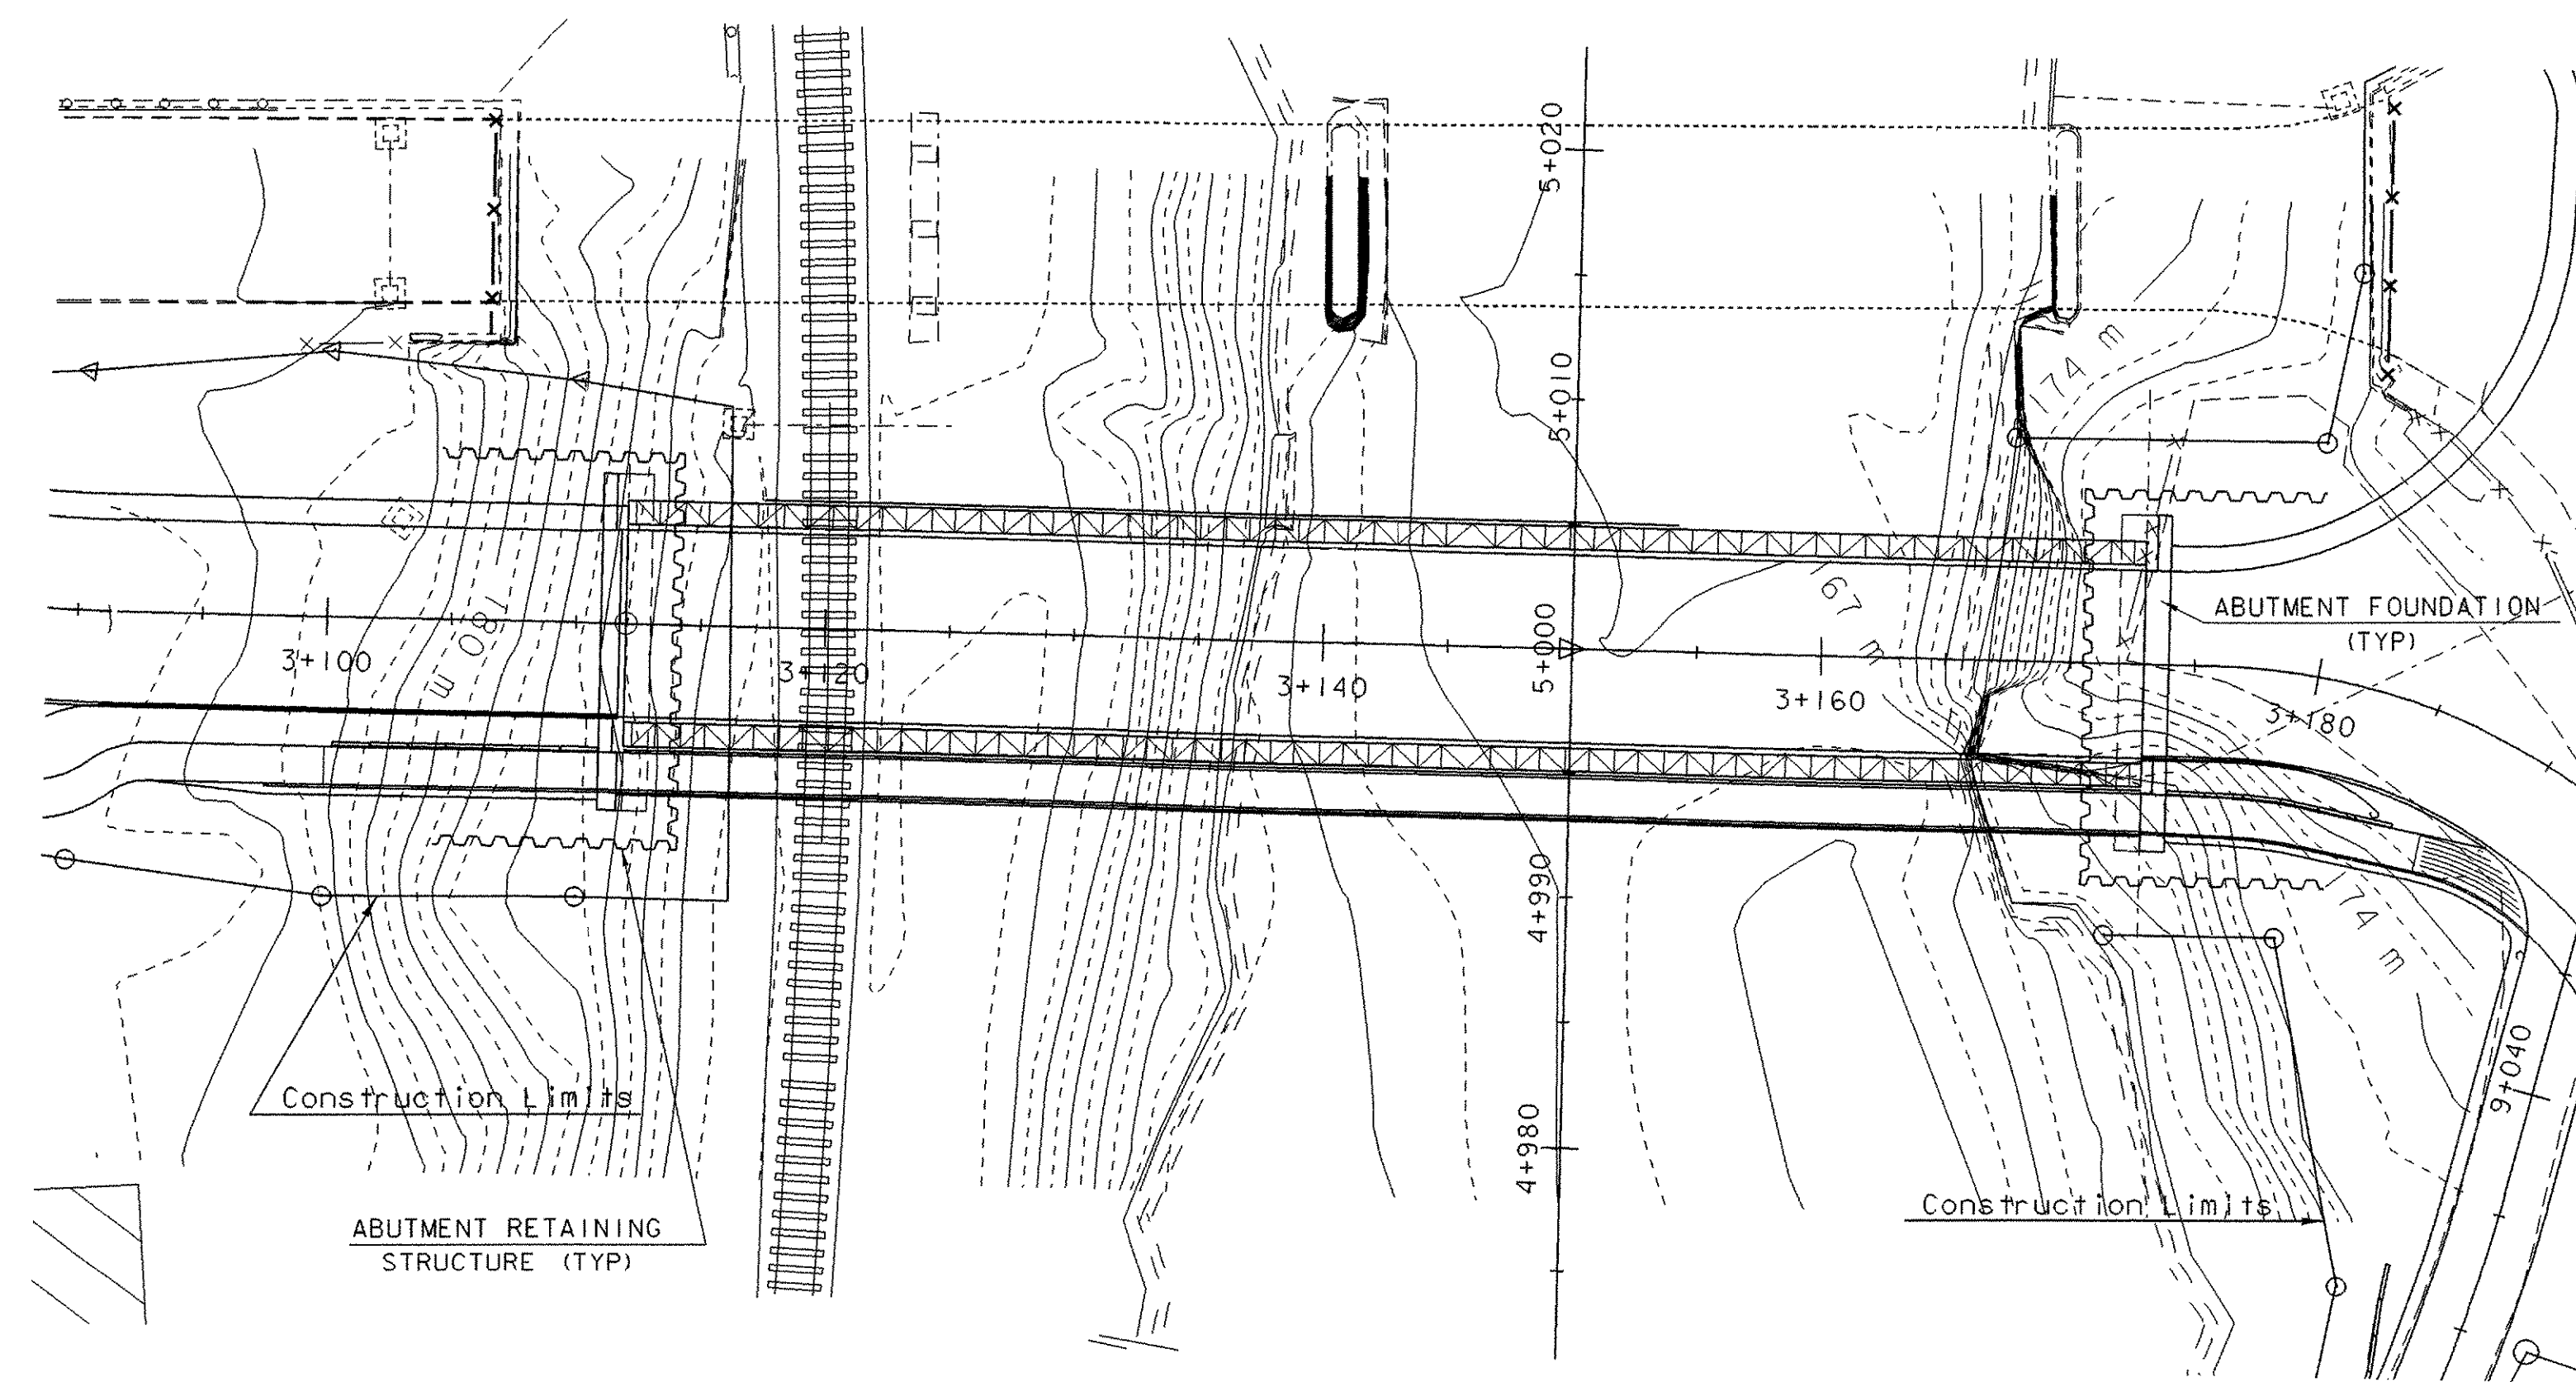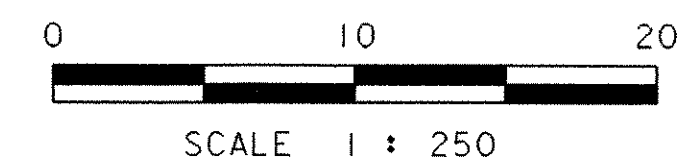

Plan View (with contours)

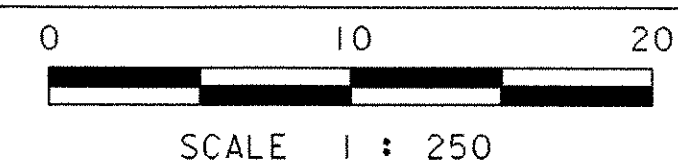

## Abutment Retaining Structure Notes



1. All fill required within the limits of the abutment retaining structure and up to the bottom of subbase elevation, shall be Granular Backfill for Structures and be paid under item 204.30 Granular Backfill for Structures.
2. All existing material within a horizontal distance of 1 meter from the abutment foundation shall be removed down to 600 millimeters below the proposed bottom of abutment foundation and filled with Granular Backfill for Structures. The excavation for the abutment foundation shall be paid for under the item 204.25 "Structure Excavation".
3. The abutment retaining structure shall extend a minimum of 0.3 meters and a maximum of 1.0 meters above the fill that it is retaining.
4. At the abutment 1 location, the abutment retaining structure shall extend a minimum of 1.0 meter into the existing ground. At the abutment 2 location, the abutment retaining structure shall extend to elevation 166.0 or to ledge, whichever is higher.
5. To avoid a potential conflict with the bridge constructed under contract 2, no portion of the abutment retaining structure shall extend further than 7.5 meters left of the proposed centerline.
6. See Special Provisions for more information.

PROJECT NAME: Bethel  
PROJECT NUMBER: BRF 0241(33) - CI

FILE NAME: s96j250abutret.dgn  
PROJECT LEADER: C. Williams  
DESIGNED BY: K. Higgins  
Abutment Retaining Structure

PLOT DATE: 09-JUL-2003  
DRAWN BY: C. Williams  
CHECKED BY: K. Higgins  
SHEET 27 OF 47



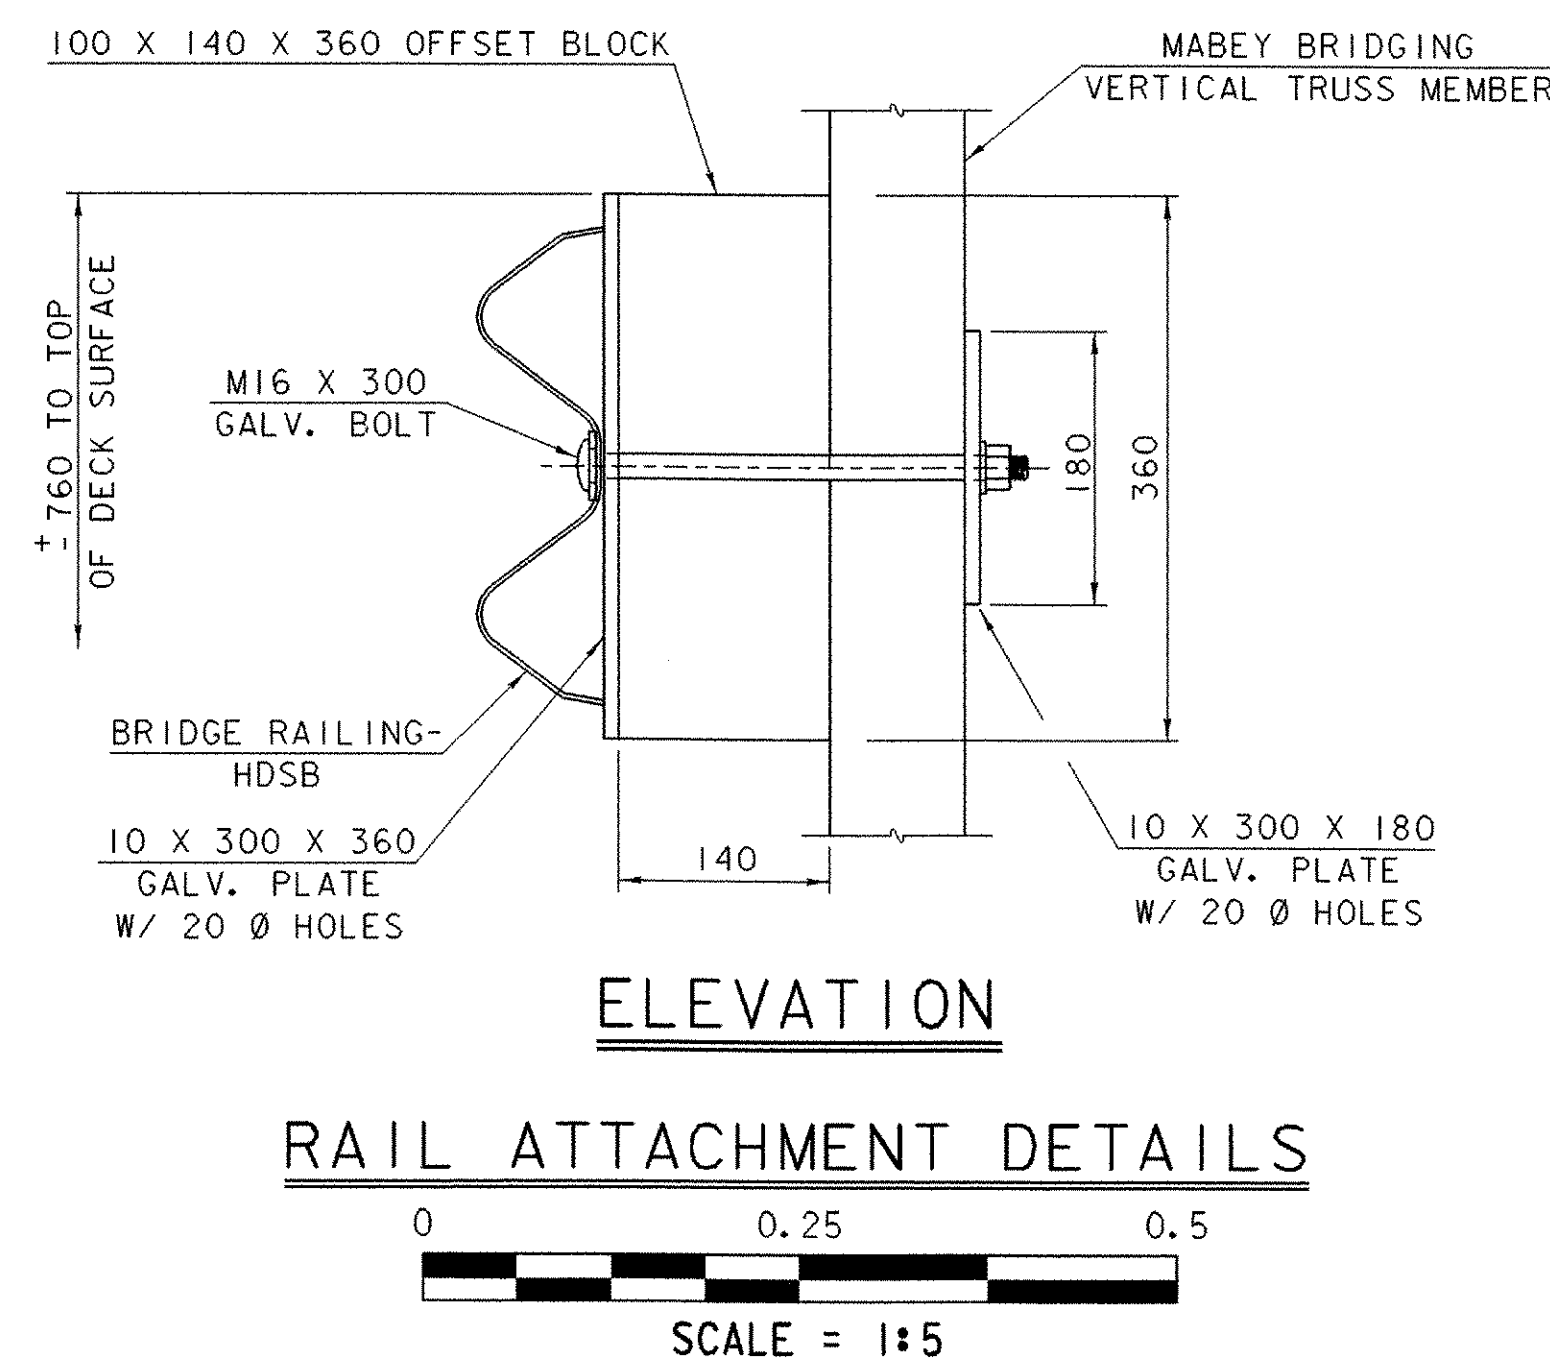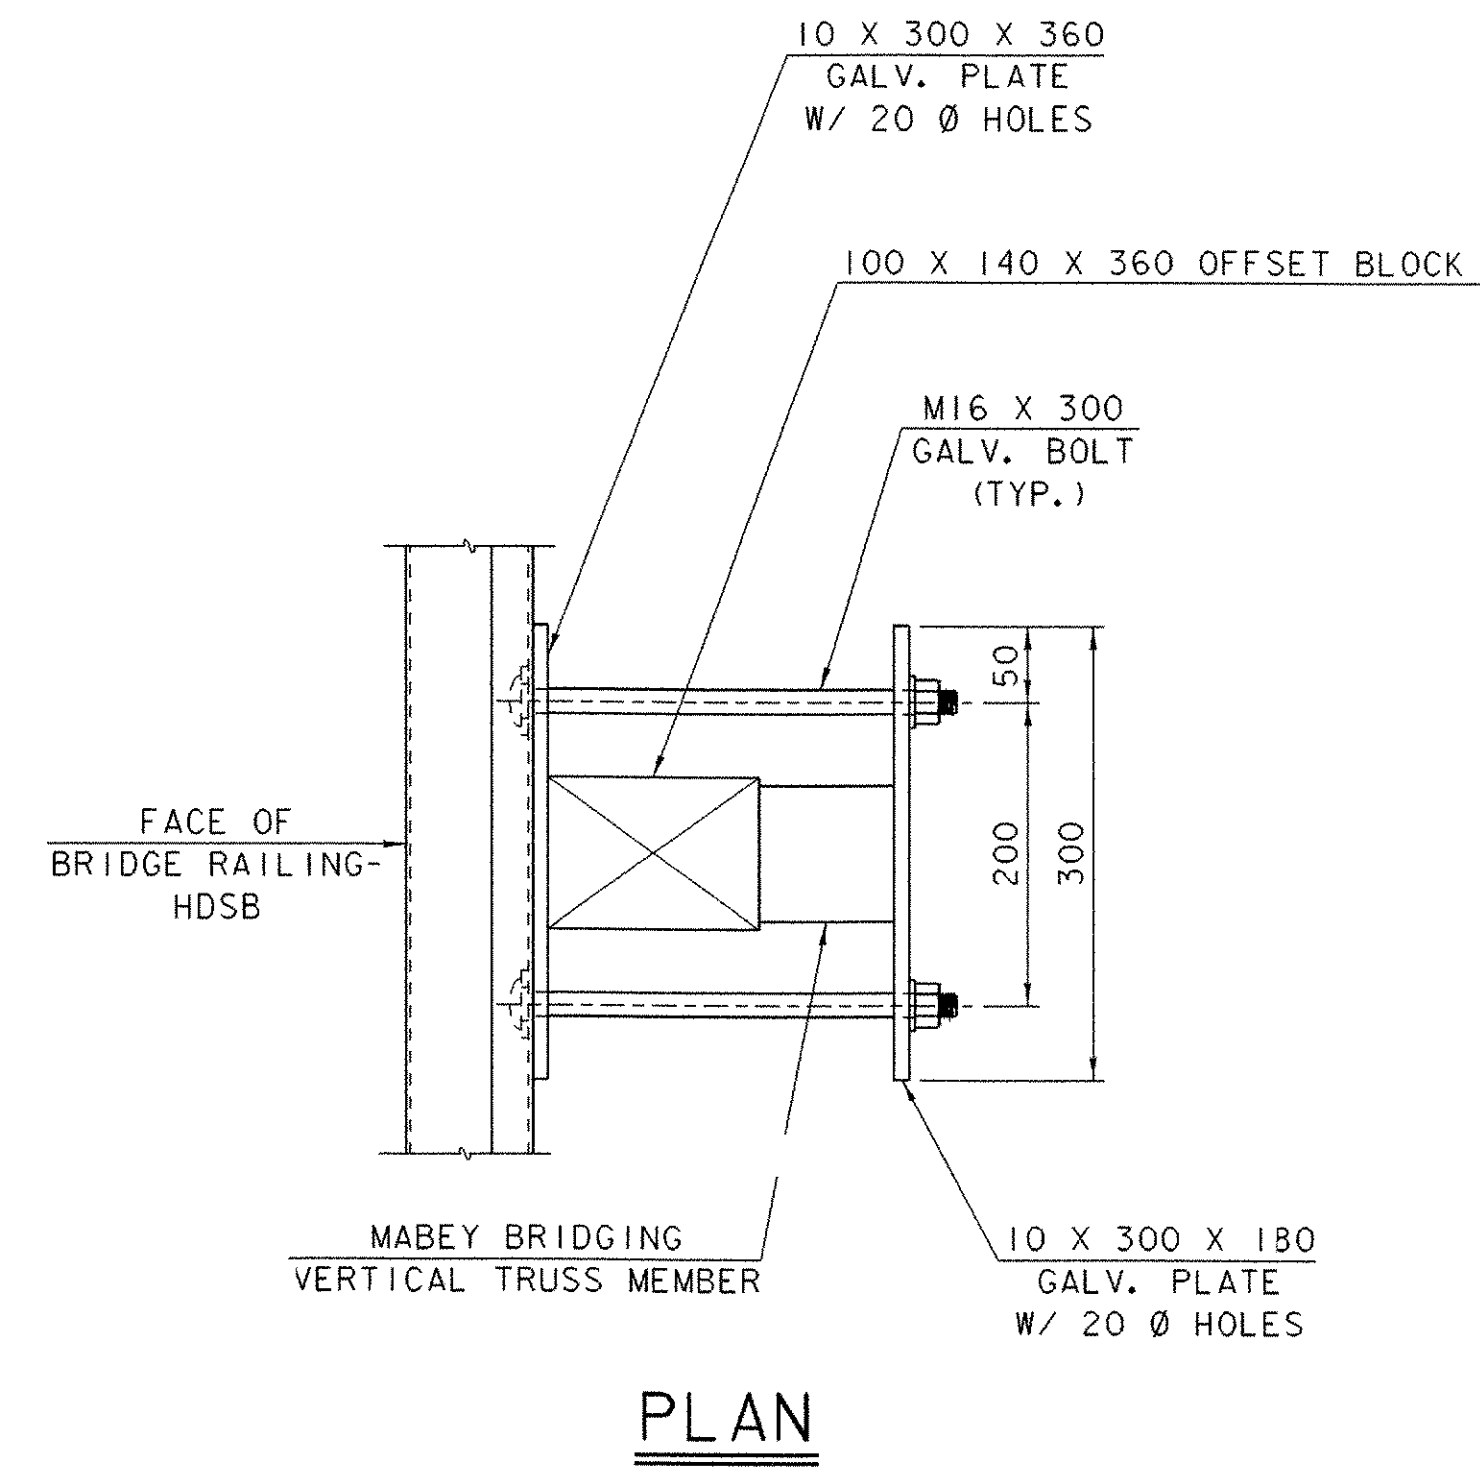

|                                                    |                          |
|----------------------------------------------------|--------------------------|
| PROJECT:                                           | PROJECT NO.:             |
| BETHEL                                             | BRF 0241 (33)            |
| DESIGN FILE NAME: 96j250/Structures/s96j250mis.dgn | PLOT DATE: 09-JUL-2003   |
| IPARM FILE NAME: s96j250misc.i                     | DESIGNED BY: K.M.HIGGINS |
| SQUAD LEADER: C.P. WILLIAMS                        | DRAWN BY: C.P.WILLIAMS   |
| RAIL ATTACHMENT DETAIL                             | CHECKED BY: K.M.HIGGINS  |
|                                                    | SHEET: 28 OF 47          |




REINFORCING STEEL SCHEDULE



~ NOTES ~

1. UNLESS OTHERWISE DESIGNATED, ALL BAR REINFORCEMENT FOR CONCRETE IN SIZES UP TO AND INCLUDING 55M SHALL CONFORM TO THE REQUIREMENTS OF THE "SPECIFICATIONS FOR DEFORMED BILLET-STEEL BARS FOR CONCRETE REINFORCEMENT", AASHTO M 31M (ASTM A 615M-SI). ALL BARS SHALL BE GRADE 420, UNLESS OTHERWISE DESIGNATED.
2. FOR TYPICAL BENDING DETAILS, RECOMMENDED PIN DIAMETER "D" OF BENDS AND HOOKS, AND OTHER STANDARD PRACTICE, SEE CURRENT CONCRETE REINFORCING STEEL INSTITUTE "MANUAL OF STANDARD PRACTICE".
3. BARS WHICH REQUIRE MORE ACCURATE BENDING THAN STANDARD PRACTICES SHOULD HAVE LIMITS INDICATED.
4. ALL DIMENSIONS ARE OUT TO OUT OF BAR EXCEPT "A" AND "G" ON STANDARD 180 DEGREE AND 135 DEGREE HOOKS.
5. "J" DIMENSION ON 180 DEGREE HOOKS TO BE SHOWN ONLY WHERE NECESSARY TO RESTRICT HOOK SIZE. OTHERWISE, STANDARD HOOKS ARE TO BE USED.
6. "H" DIMENSION ON STIRRUPS TO BE SHOWN ONLY WHEN NECESSARY TO MAINTAIN CLEARANCES.
7. WHERE SLOPE DIFFERS FROM 45 DEGREES, DIMENSIONS "H" AND "K" MUST BE SHOWN.
8. ▲ DENOTES BARS TO BE CUT IN FIELD.
9. \* DENOTES ONE EXTRA BAR ADDED FOR TESTING PURPOSES.
10. △ DENOTES TWO EXTRA BARS ADDED FOR TESTING PURPOSES.
11. E DENOTES EPOXY COATED REINFORCING STEEL.

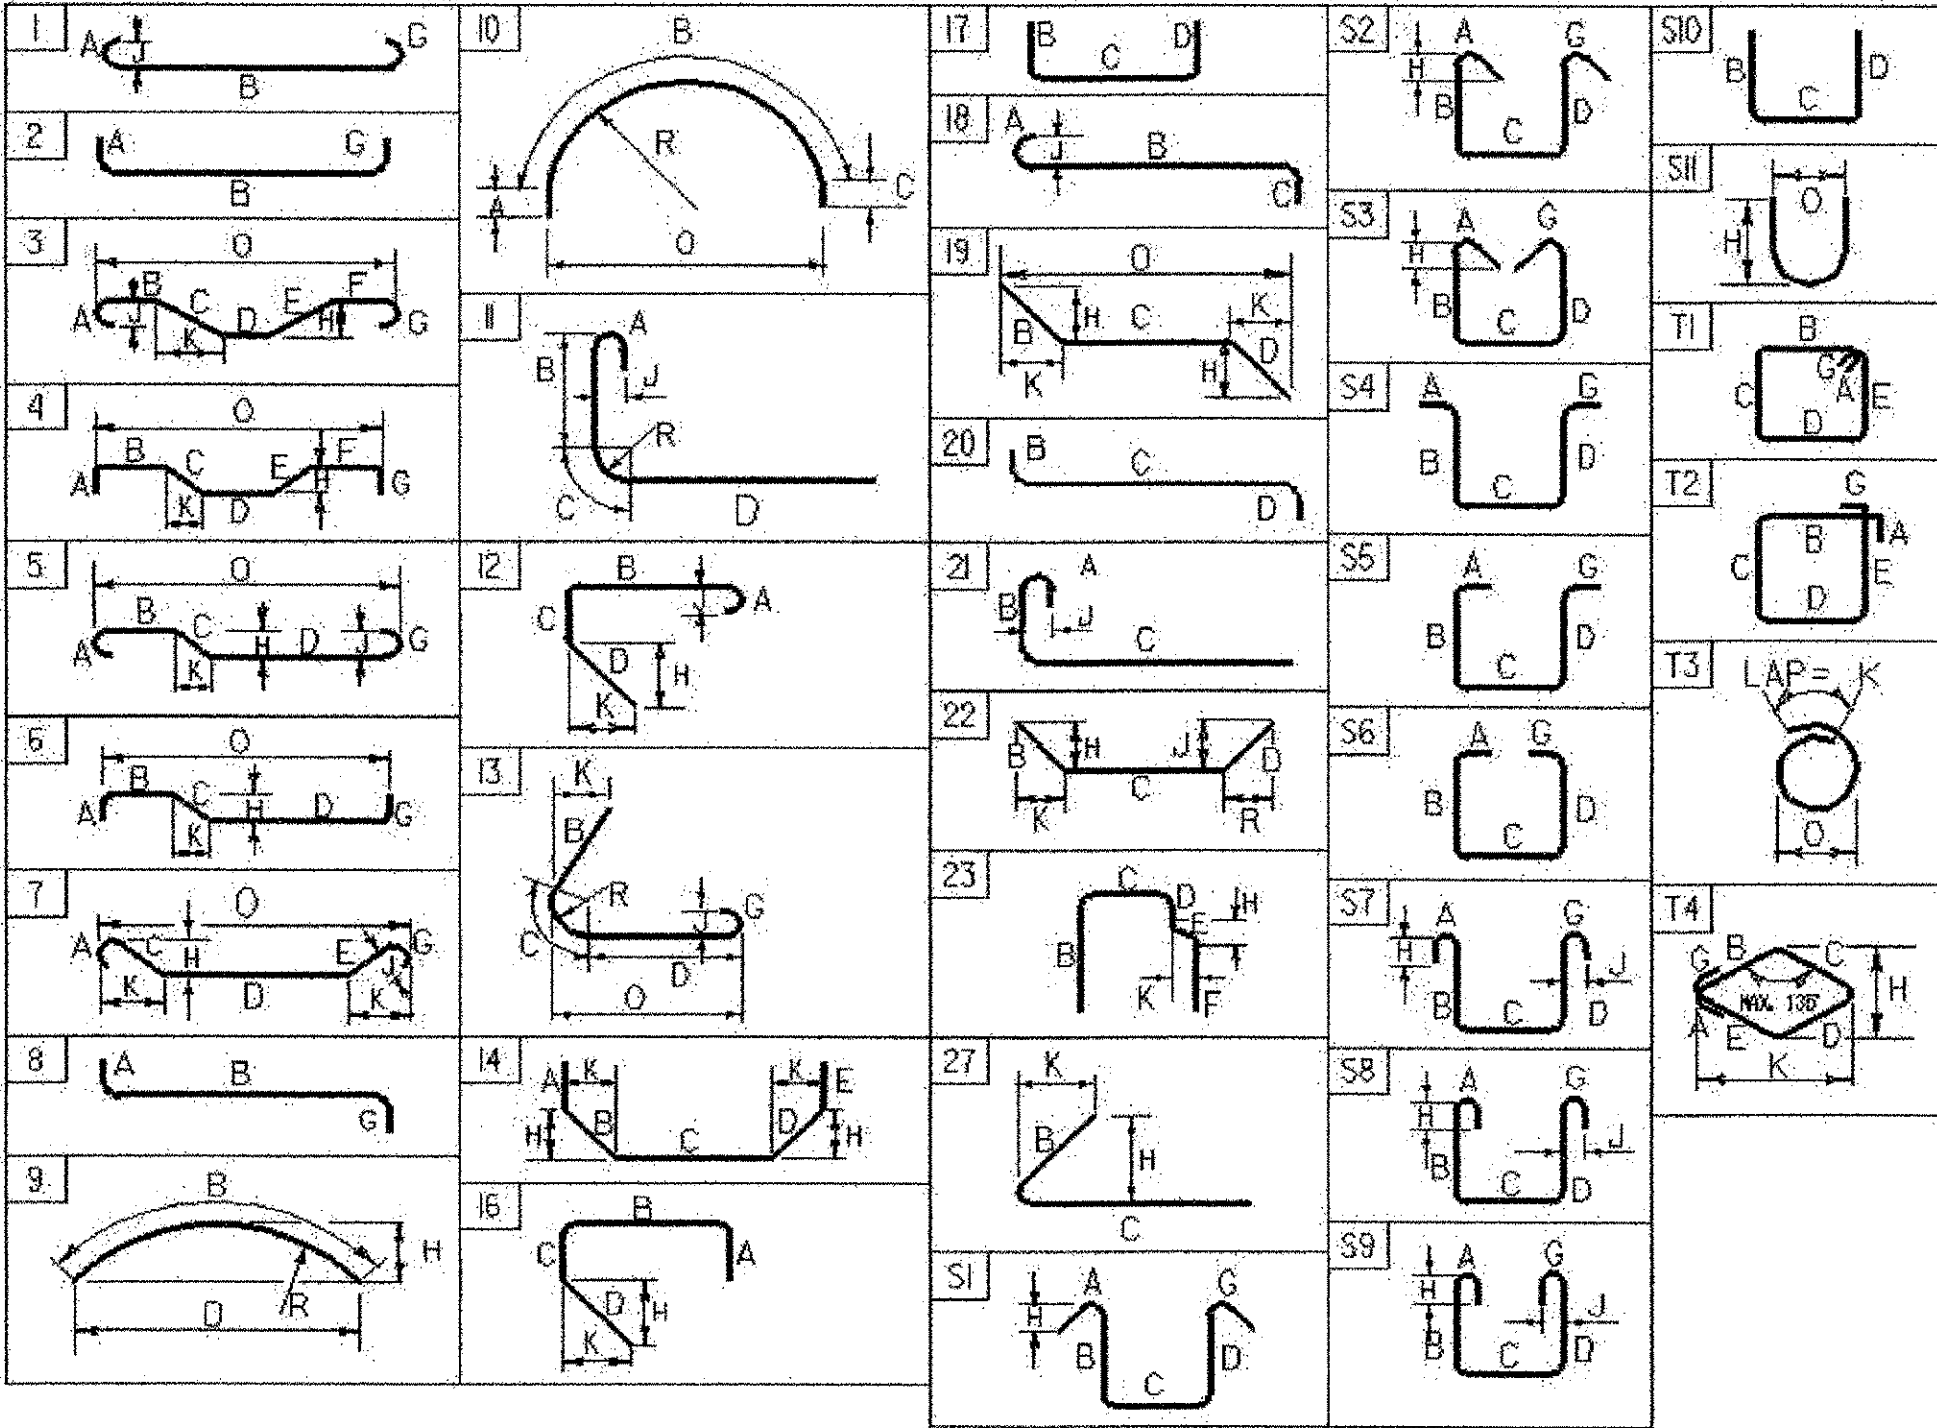

| ASTM STANDARD REINFORCING BARS |                     |                                  |                            |                |
|--------------------------------|---------------------|----------------------------------|----------------------------|----------------|
| BAR SIZE                       | NOMINAL MASS (kg/m) | NOMINAL DIMENSIONS ROUND SECTION |                            |                |
|                                |                     | DIAMETER (mm)                    | CROSS SECTIONAL AREA (mm²) | PERIMETER (mm) |
| #10                            | 0.560               | 9.5                              | 71                         | 29.84          |
| #13                            | 0.994               | 12.7                             | 129                        | 39.90          |
| #16                            | 1.552               | 15.9                             | 199                        | 49.95          |
| #19                            | 2.235               | 19.1                             | 284                        | 60.00          |
| #22                            | 3.042               | 22.2                             | 387                        | 69.74          |
| #25                            | 3.973               | 25.4                             | 510                        | 79.80          |
| #29                            | 5.060               | 28.7                             | 645                        | 90.16          |
| #32                            | 6.404               | 32.3                             | 819                        | 101.47         |
| #36                            | 7.907               | 35.8                             | 1006                       | 112.47         |
| #43                            | 11.380              | 43.0                             | 1452                       | 135.09         |
| #57                            | 20.240              | 57.3                             | 2581                       | 180.01         |

|                                     |                   |
|-------------------------------------|-------------------|
| PROJECT NAME:                       | BETHEL            |
| PROJECT NUMBER:                     | BRF 0241 (33)-c1  |
| FILE NAME:                          | s96j250rss-c1.xls |
| PROJECT MANAGER:                    | C.P. WILLIAMS     |
| DESIGNED BY:                        | K.M. HIGGINS      |
| REINFORCING STEEL SCHEDULE SHEET #1 |                   |
| PLOT DATE:                          | 1/3/2003          |
| DRAWN BY:                           | T. ANDERSON       |
| CHECKED BY:                         | C.P. WILLIAMS     |
| SHEET                               | 29 OF 47          |





STATE OF VERMONT  
AGENCY OF TRANSPORTATION  
RIGHT OF WAY PLANS  
DETAIL SHEET

TABLE OF PROJECT PROPERTY ACQUISITION

| PARCEL NO. | GRANTOR                                                             | SHEET NO. | BEGINNING STATION            | ENDING STATION | TAKING  | REM. | RIGHTS                             | TITLE TAKEN | DATE       | TOWN OR CITY RECORDED | BK. | PG.     | REMARKS                                                                                                                             | REVISION NO. | SHEET | DESCRIPTION OF REVISION                | DATE     | MADE BY | APPROVED BY |
|------------|---------------------------------------------------------------------|-----------|------------------------------|----------------|---------|------|------------------------------------|-------------|------------|-----------------------|-----|---------|-------------------------------------------------------------------------------------------------------------------------------------|--------------|-------|----------------------------------------|----------|---------|-------------|
| 1          | TOWN OF BETHEL                                                      | 11        | 3+038.61 LT.                 | 3+102.40 LT.   | 0.12HA± |      |                                    | OCD         | 12/13/2001 | BETHEL                | 82  | 317-318 | FORMERLY STATE OF VERMONT (0.30A±)                                                                                                  |              |       | ELECTRONIC REPRODUCIBLES TO STRUCTURES | 07-07-03 |         |             |
| 2          | PRATT, FRANK E. & PLACY, DIANE L.                                   | 11        | 3+060.00 RT.                 |                |         |      |                                    |             |            |                       |     |         | 3.6M GRAVEL(12') ROW OVER PARCEL NO. 1                                                                                              |              |       |                                        |          |         |             |
| 3          | C.V. PROPERTIES, INC. JOINED BY: NEW ENGLAND CENTRAL RAILROAD, INC. | 11        | 3+101.39 RT.                 | 3+137.41 LT.   |         |      | DETOUR (T) .08HA±                  |             |            |                       |     |         | 0.19A± TEMP. DETOUR INCLUDES TEMPORARY INSTALLATION OF BRIDGE, PILINGS, ABUTMENTS, EROSION CONTROL, DRAINAGE DEVICES, AND SIDEWALK. |              |       |                                        |          |         |             |
|            |                                                                     |           | 3+101.77 RT.<br>3+103.00 LT. | 3+102.87 LT.   |         |      | REMOVE (T)<br>INSTALL (T)          |             |            |                       |     |         | FENCE<br>CAPPING DROP INLET                                                                                                         |              |       |                                        |          |         |             |
| 4          | BETHEL MILLS, INC.                                                  | 11        | 3+165.99 RT.                 | 3+213.82 RT.   |         |      | CONST. EASE. (T) 67 SM±            |             |            |                       |     |         | INCLUDES EROSION CONTROL 721 S.F.±                                                                                                  |              |       |                                        |          |         |             |
|            |                                                                     |           | 3+165.99 RT.                 | 3+194.53 RT.   |         |      | DETOUR (T) 140 SM±                 |             |            |                       |     |         | INCLUDES TEMPORARY INSTALLATION OF BRIDGE, PILINGS, ABUTMENTS, EROSION CONTROL, AND SIDEWALK, 1,507 S.F.±                           |              |       |                                        |          |         |             |
|            |                                                                     |           | 3+187.60 RT.<br>3+189.00 RT. | 3+199.16 RT.   |         |      | CUL., DIT. & DR. (T)<br>REMOVE (T) |             |            |                       |     |         | ELECTRICAL LINES & SUB STATION                                                                                                      |              |       |                                        |          |         |             |
|            |                                                                     |           | 3+196.00 RT.<br>3+213.82 RT. | 3+243.04 RT.   |         |      | DRIVE (T)<br>INSTALL (T) 24 SM±    |             |            |                       |     |         | 3.6M PAVED(12')<br>EROSION CONTROL, 258 S.F.±                                                                                       |              |       |                                        |          |         |             |
| 5          | CENTRAL VERMONT PUBLIC SERVICE CORP.                                |           |                              |                |         |      |                                    |             |            |                       |     |         | UTILITY                                                                                                                             |              |       |                                        |          |         |             |
| 6          | VERIZON NEW ENGLAND, INC.                                           |           |                              |                |         |      |                                    |             |            |                       |     |         | UTILITY                                                                                                                             |              |       |                                        |          |         |             |
| 7          | ADELPHIA CABLE COMMUNICATIONS                                       |           |                              |                |         |      |                                    |             |            |                       |     |         | UTILITY                                                                                                                             |              |       |                                        |          |         |             |

ACCT.rdrawn  
\\vaot.cadd\filingscabinet\96j250\RightOfWay\vrj250d.dgn  
DATE PLOTTED 09-JUL-2003

DR. (P)- DRAINAGE RIGHT  
DIT. (P)- DITCHING RIGHT  
CH. (P)- CHANNEL RT.  
DRIVE (T)- DRIVE RIGHT  
CUL. (P)- CULVERT RIGHT  
[W]- WATER SOURCES

PRESENT R.O.W.  
TAKING WITHOUT ACCESS  
TAKING WITHOUT ACCESS ALONG PROPERTY LINE  
TAKING WITH ACCESS  
PERMANENT EASEMENT  
TEMPORARY EASEMENT

LEGEND  
--- C&T (P) ---  
... C&T (P) ...  
--- CONST. (T) ---  
SR SR  
P  
L  
△ △ △  
○ ○ ○


CLEARING & TRIMMING  
CLEAR ZONE  
CONSTRUCTION EASEMENT  
SLOPE RIGHTS  
PROPERTY LINE  
TOP OF CUT  
TOE OF SLOPE  
--- UE (P) --- PERMANENT UTILITY EASEMENT

APPROVED: ROGER P. DUMAS DATE: 08/29/02  
CHIEF, PLANS & TITLES






R. O. W. PLANS

BETHEL  
BRF 0241 ( 33 ) - C1  
10 11  
SHEET 30 OF 47



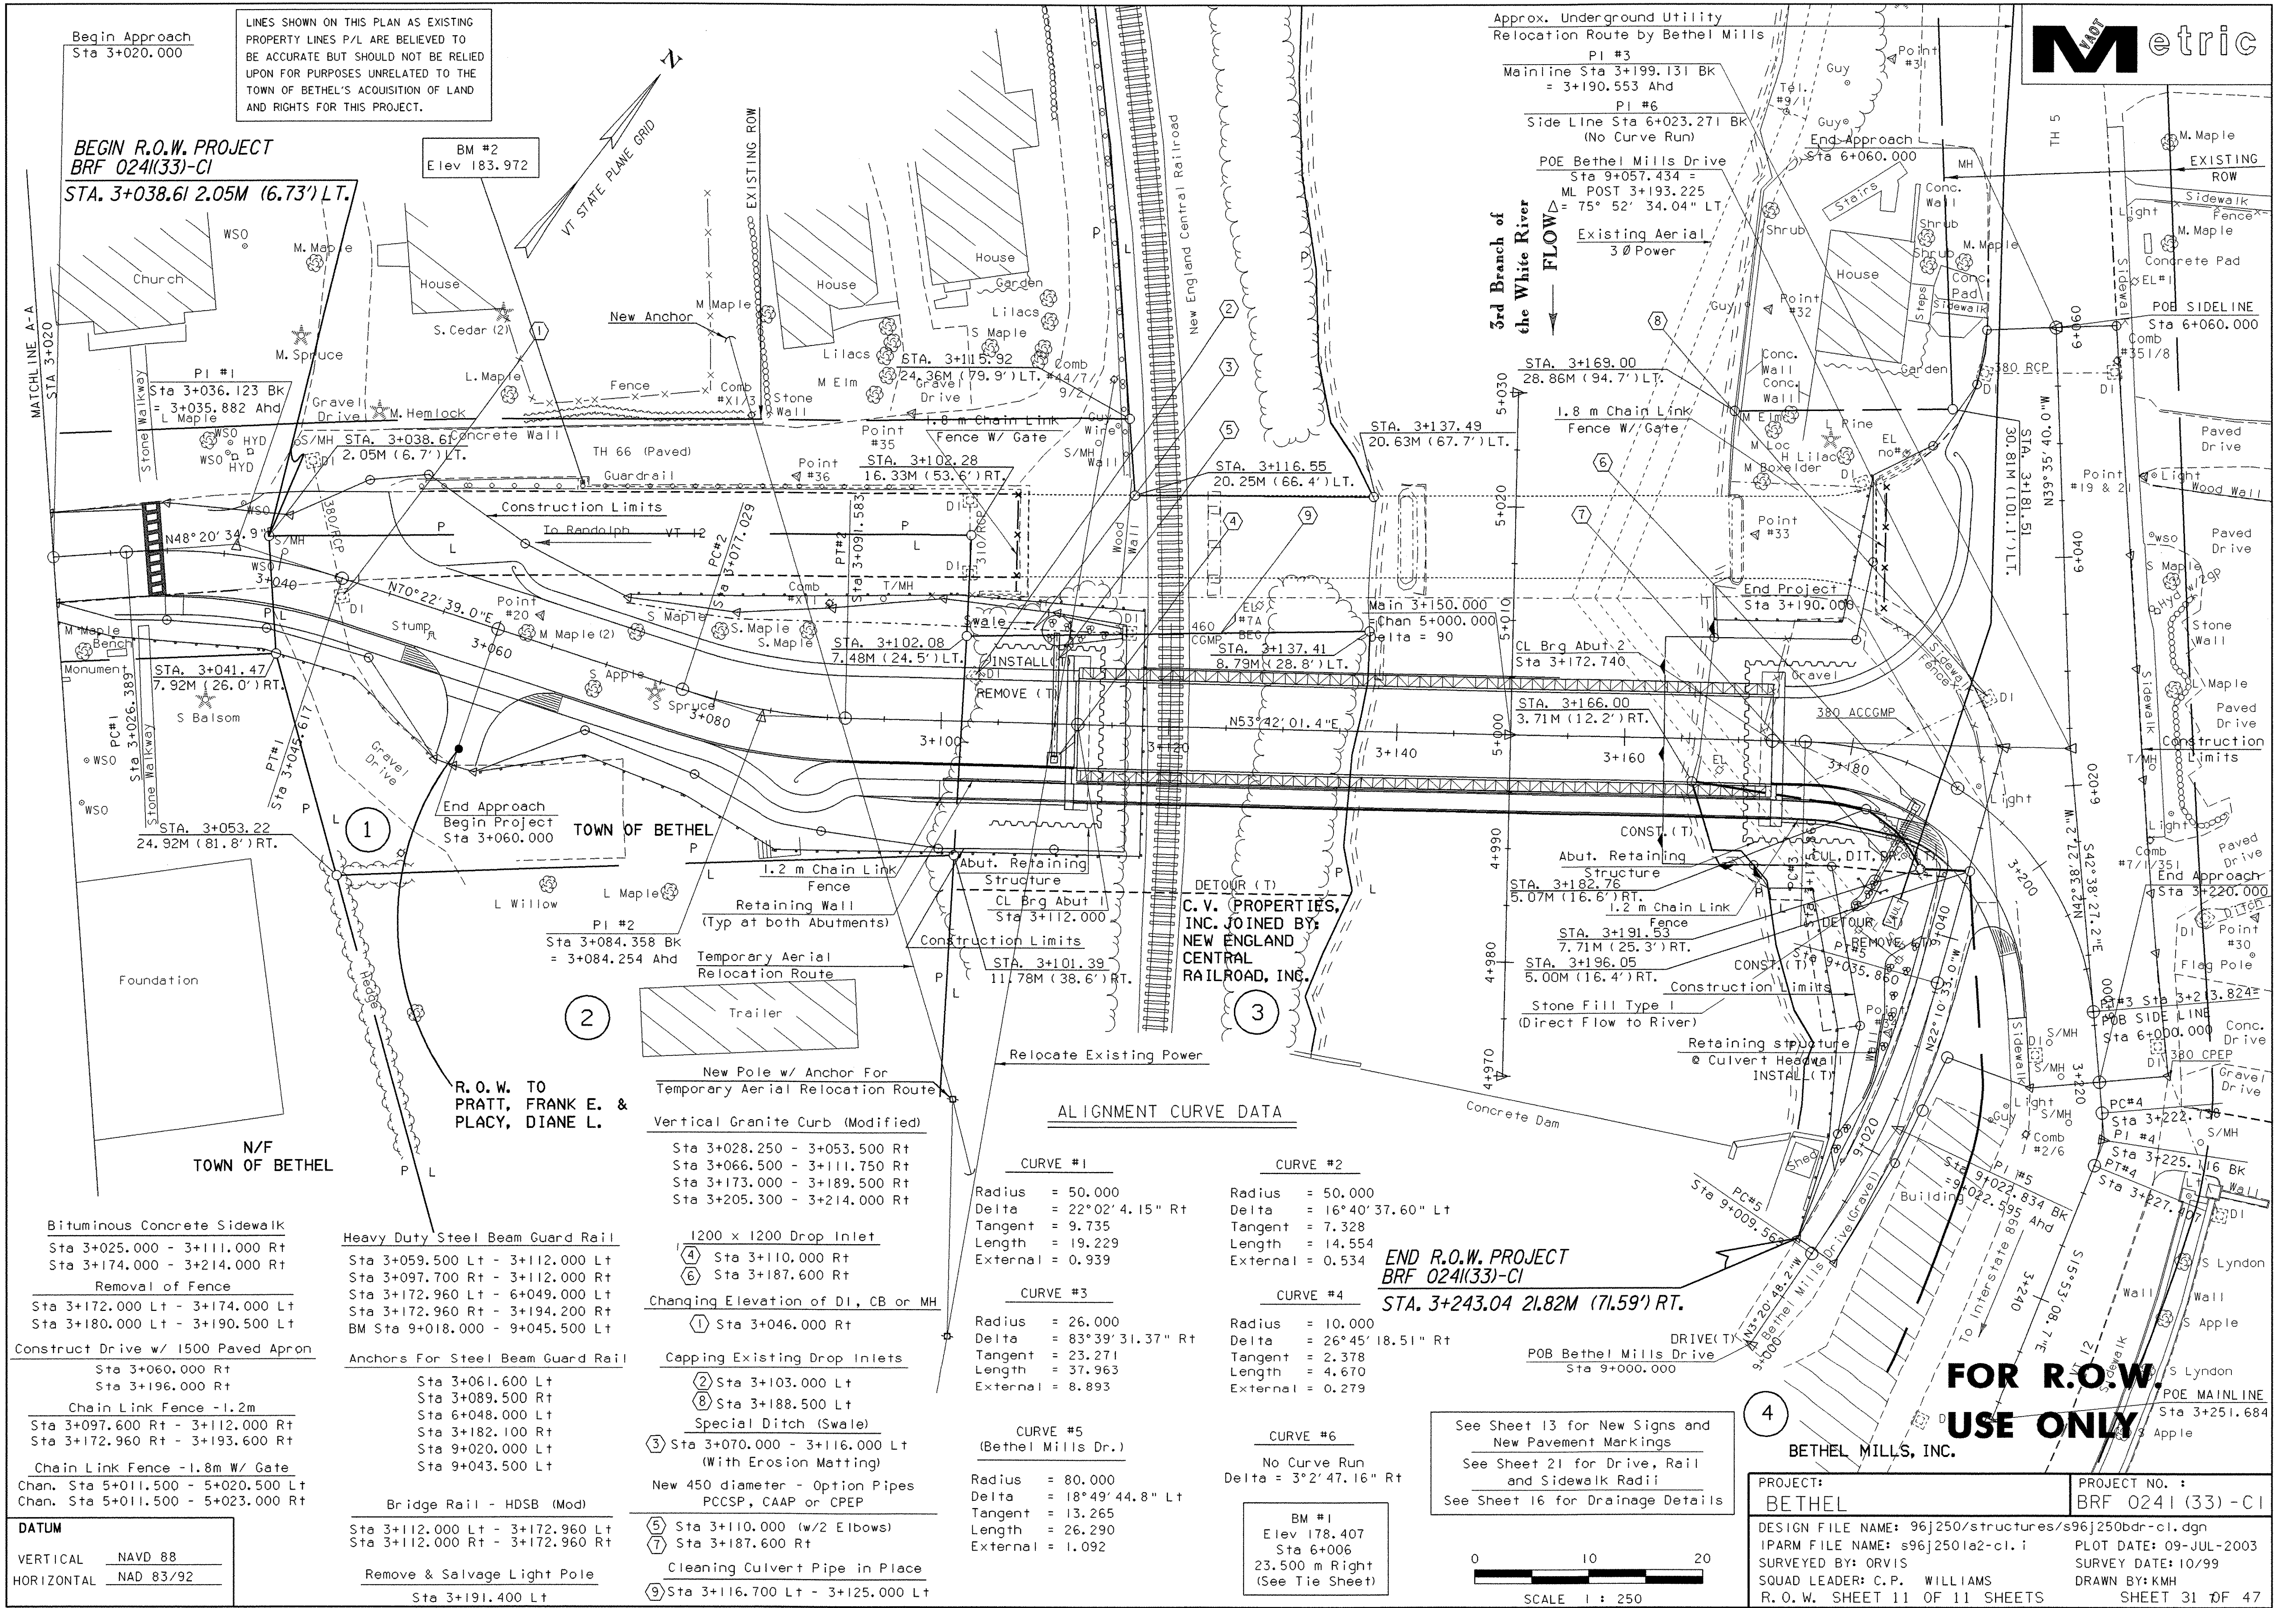








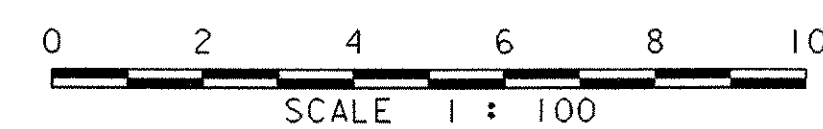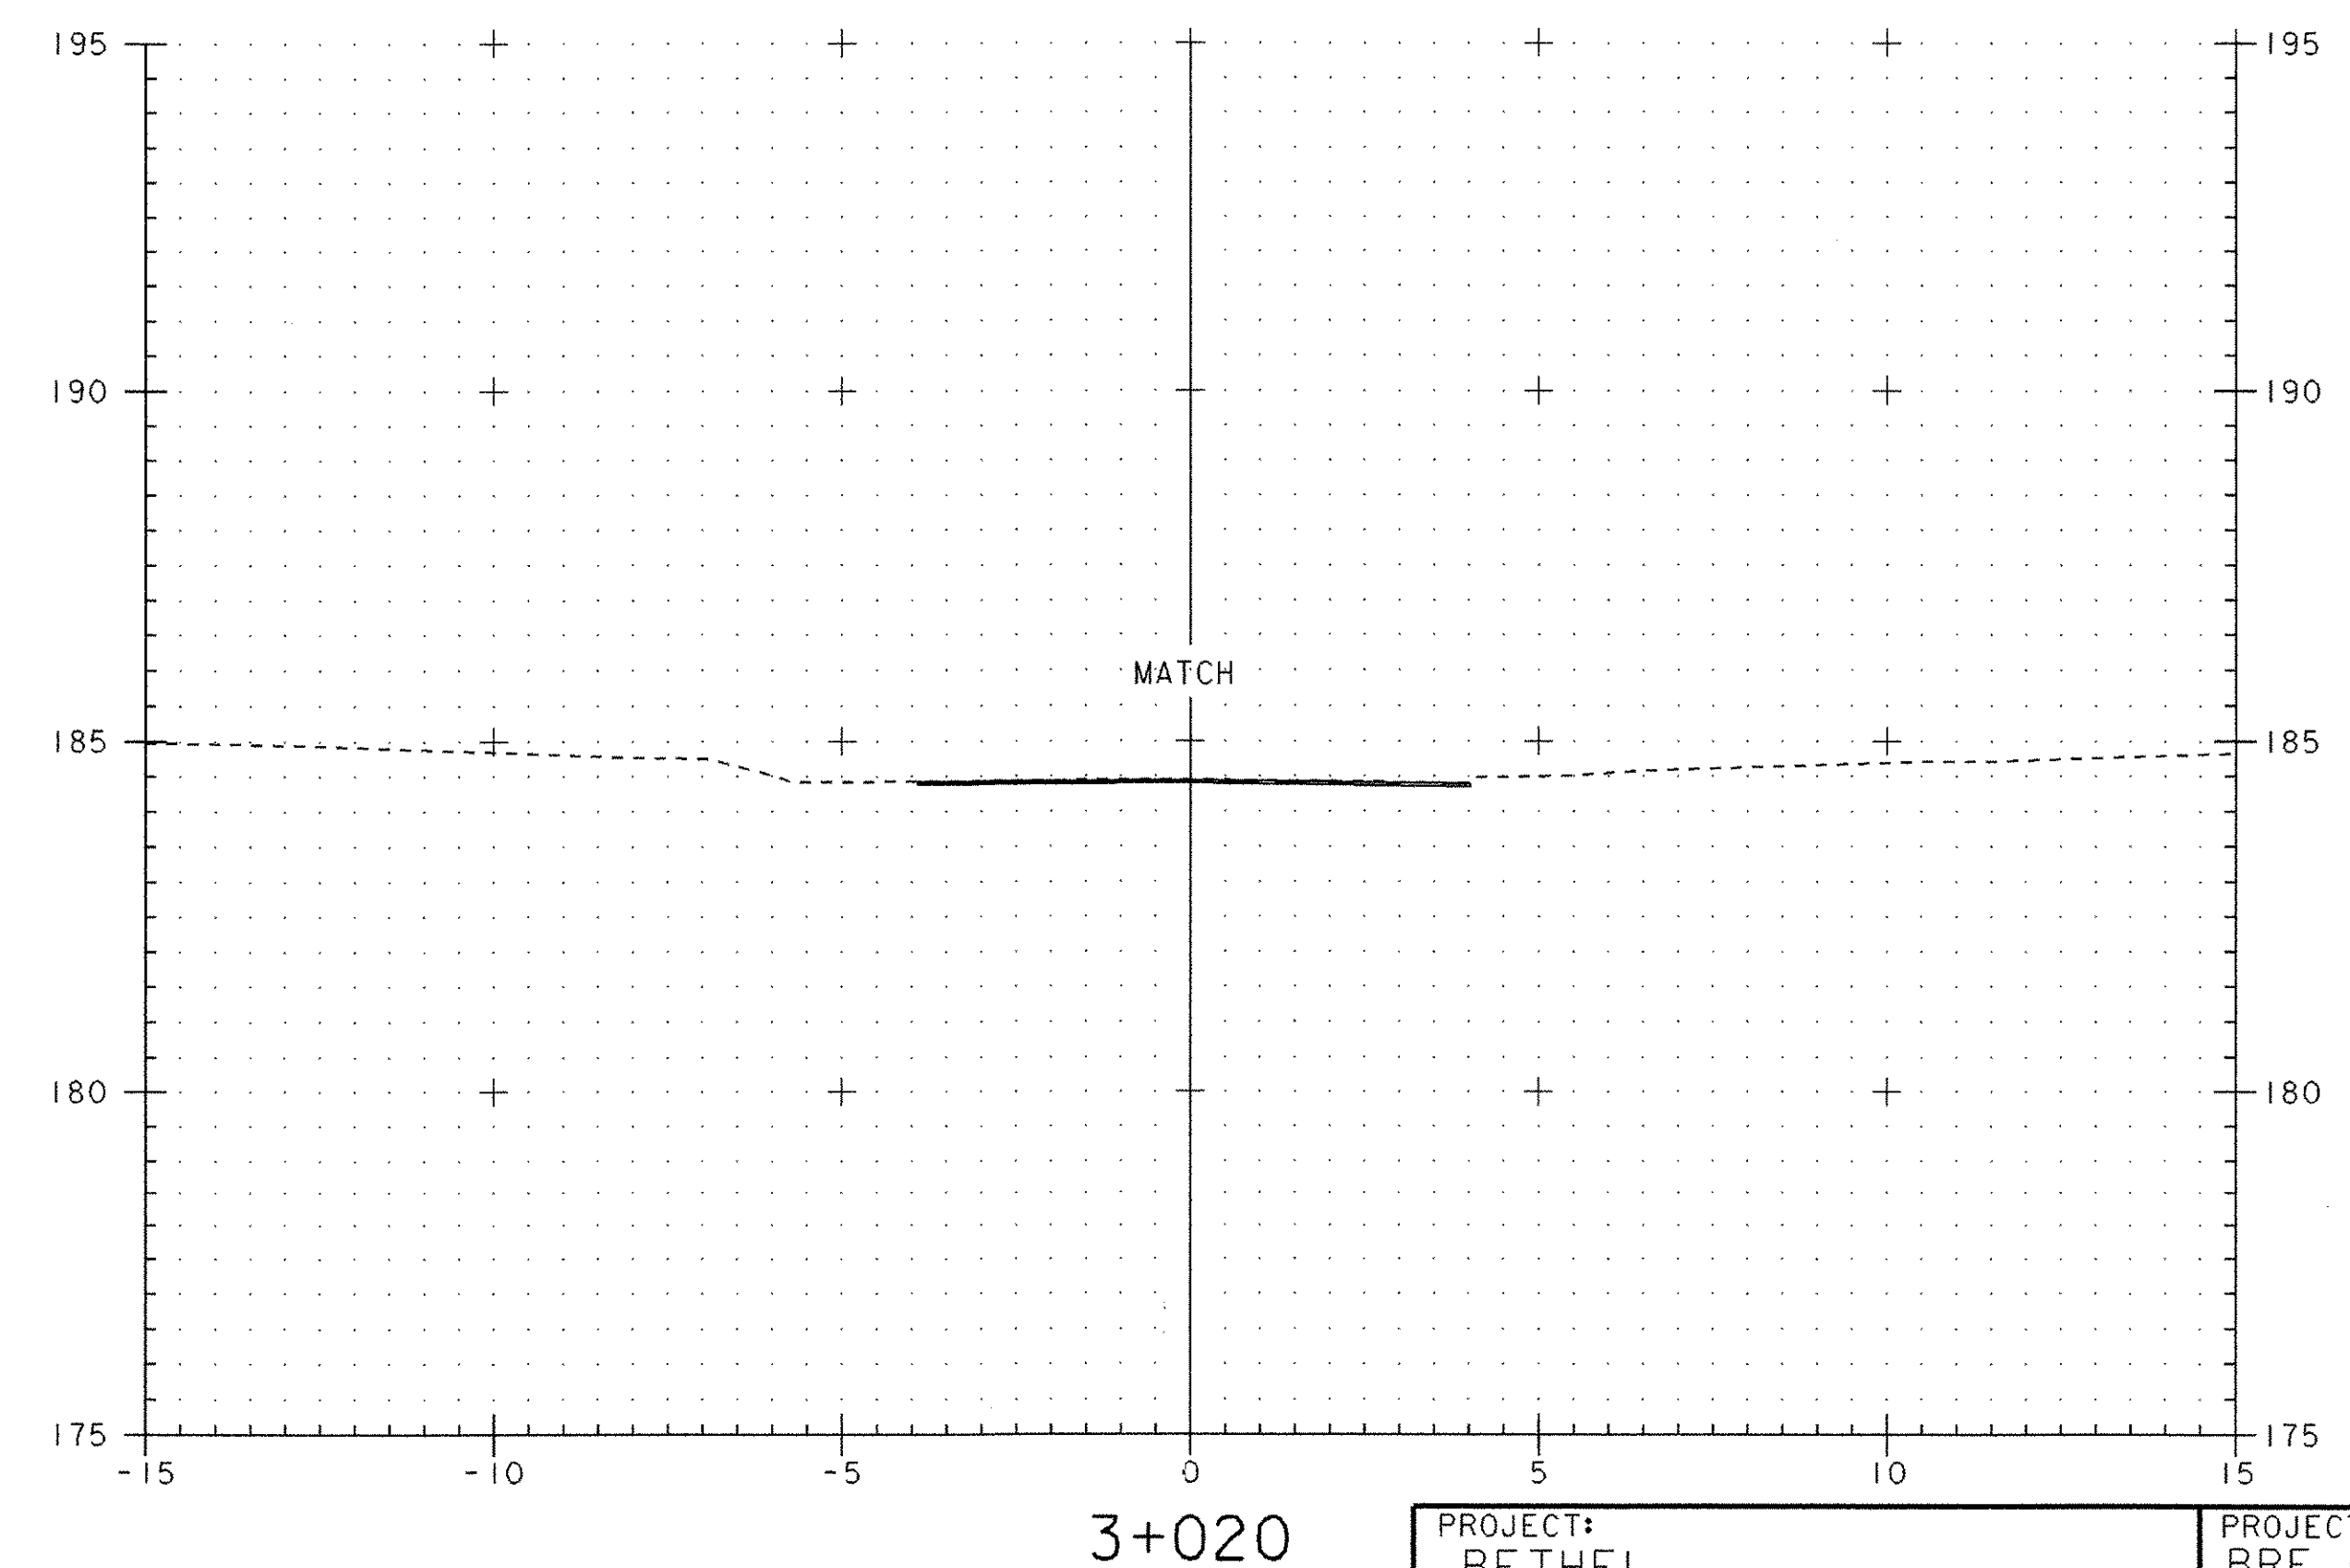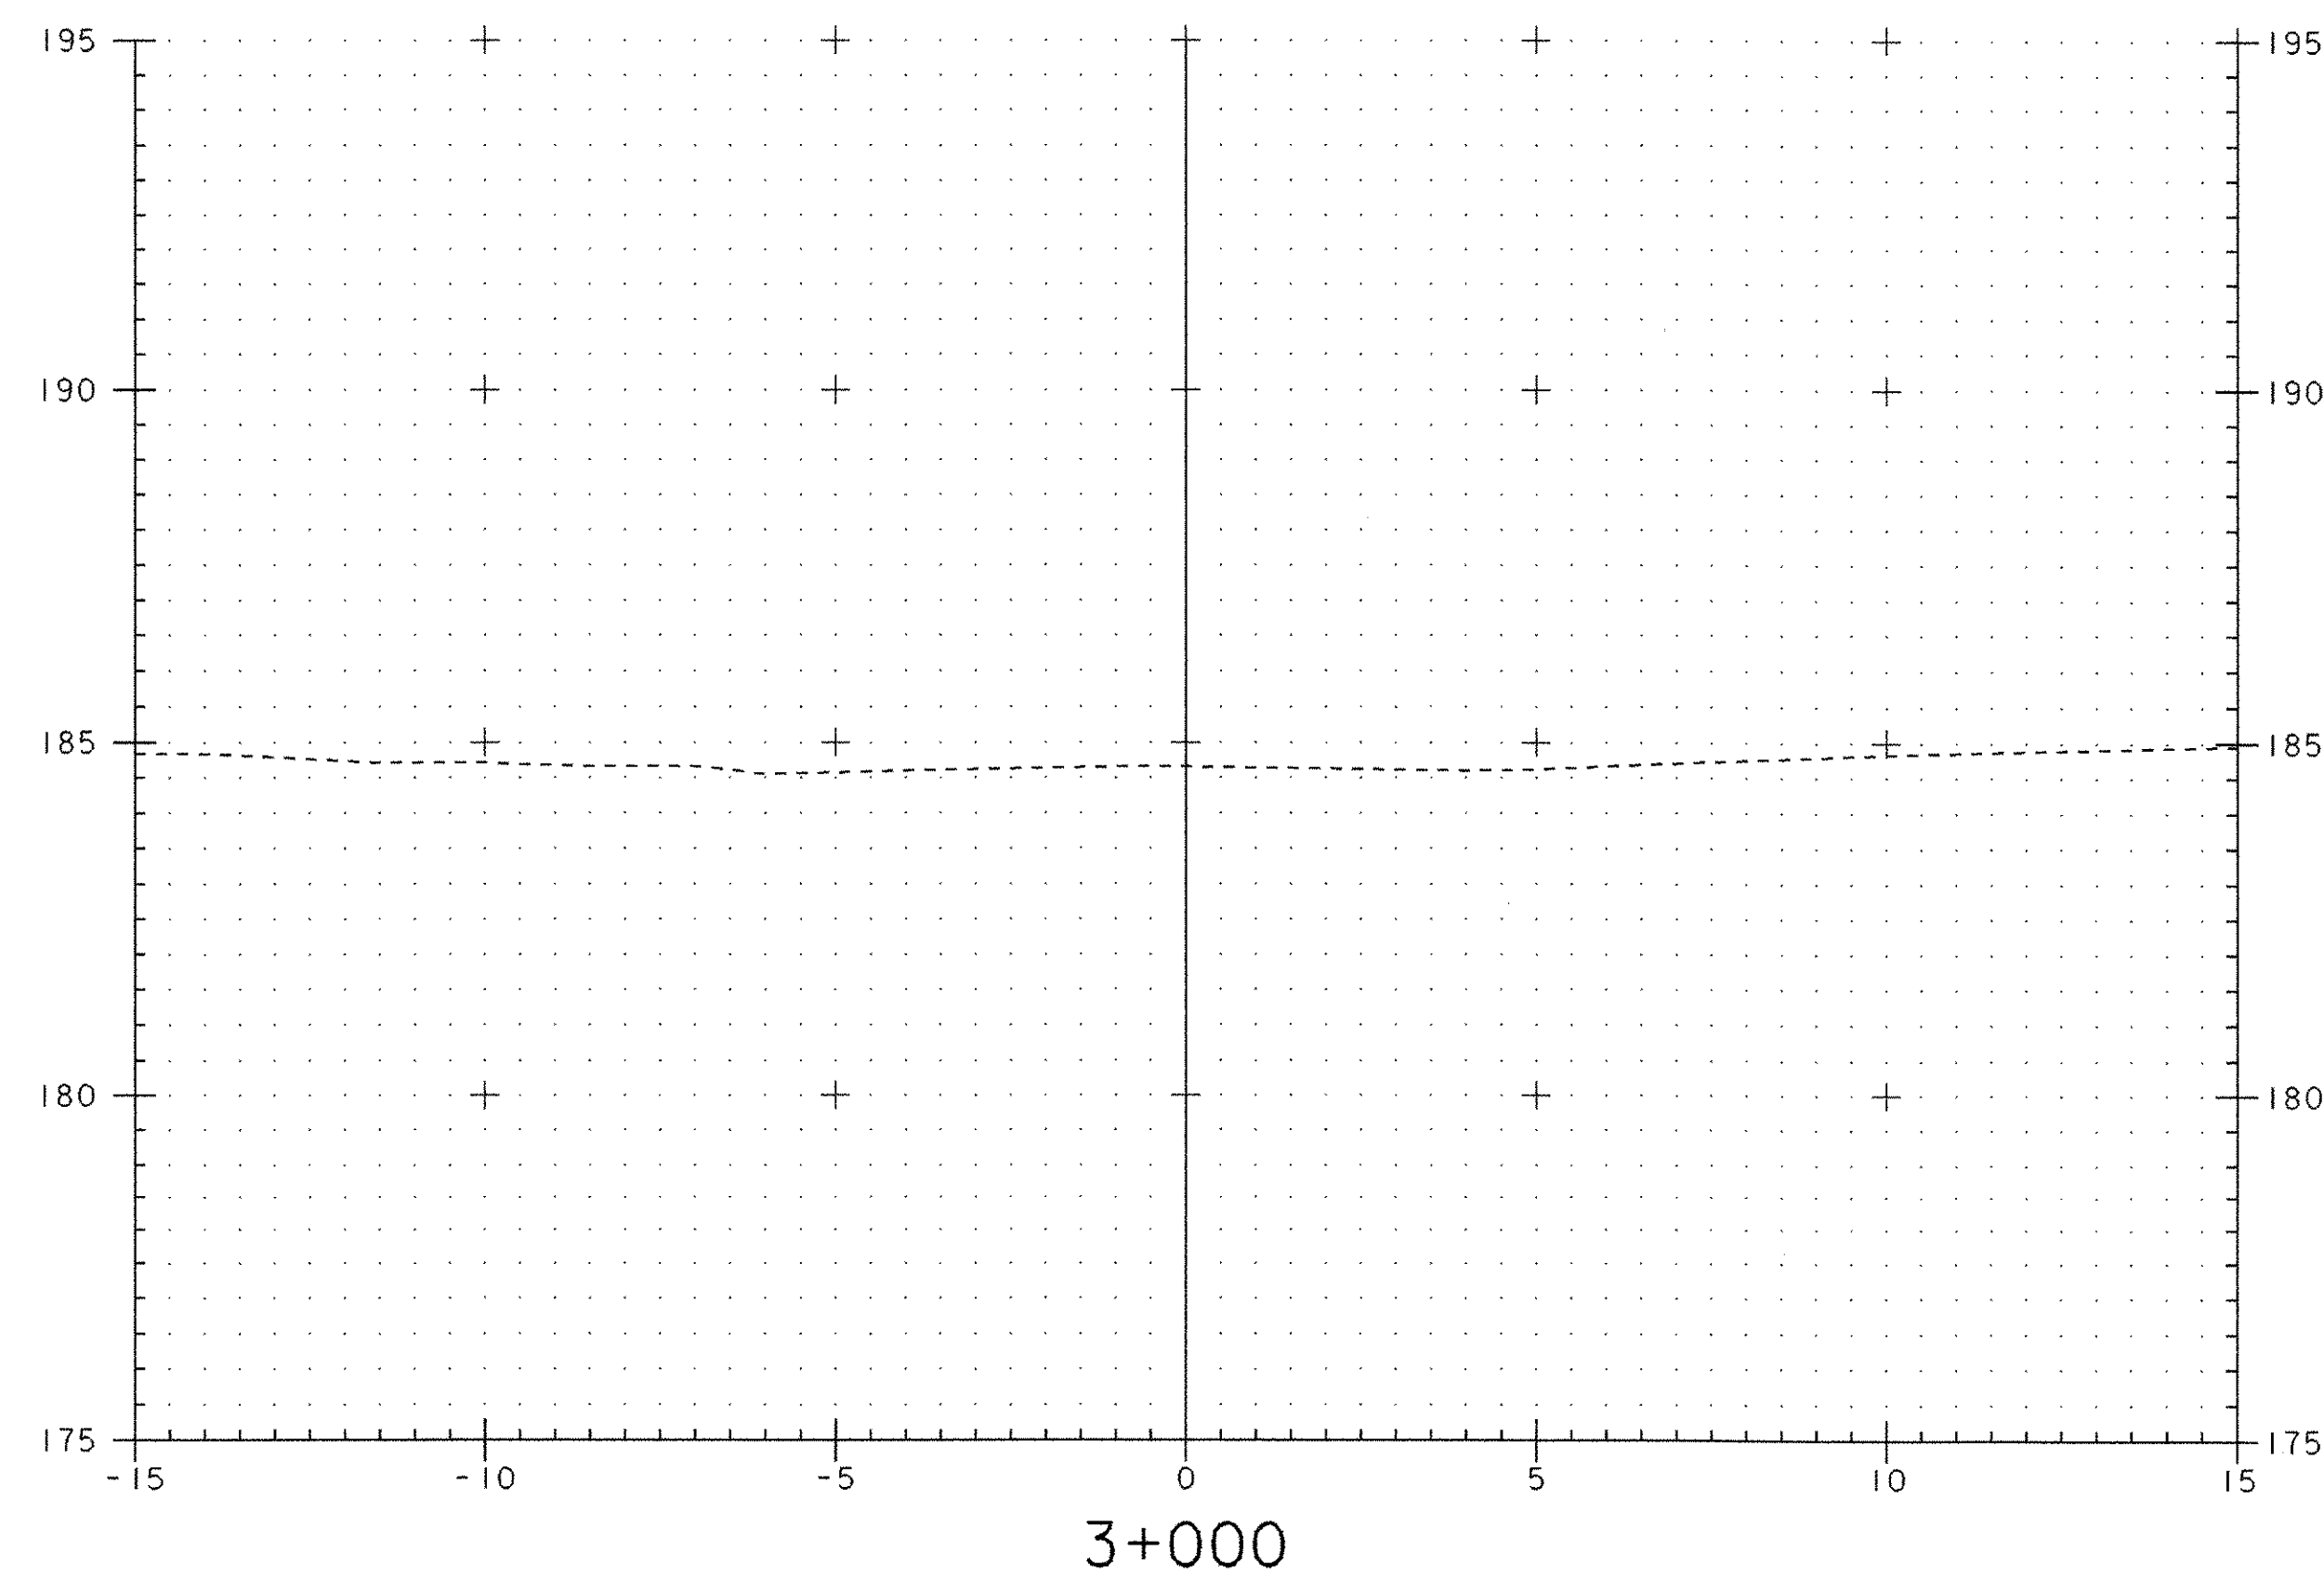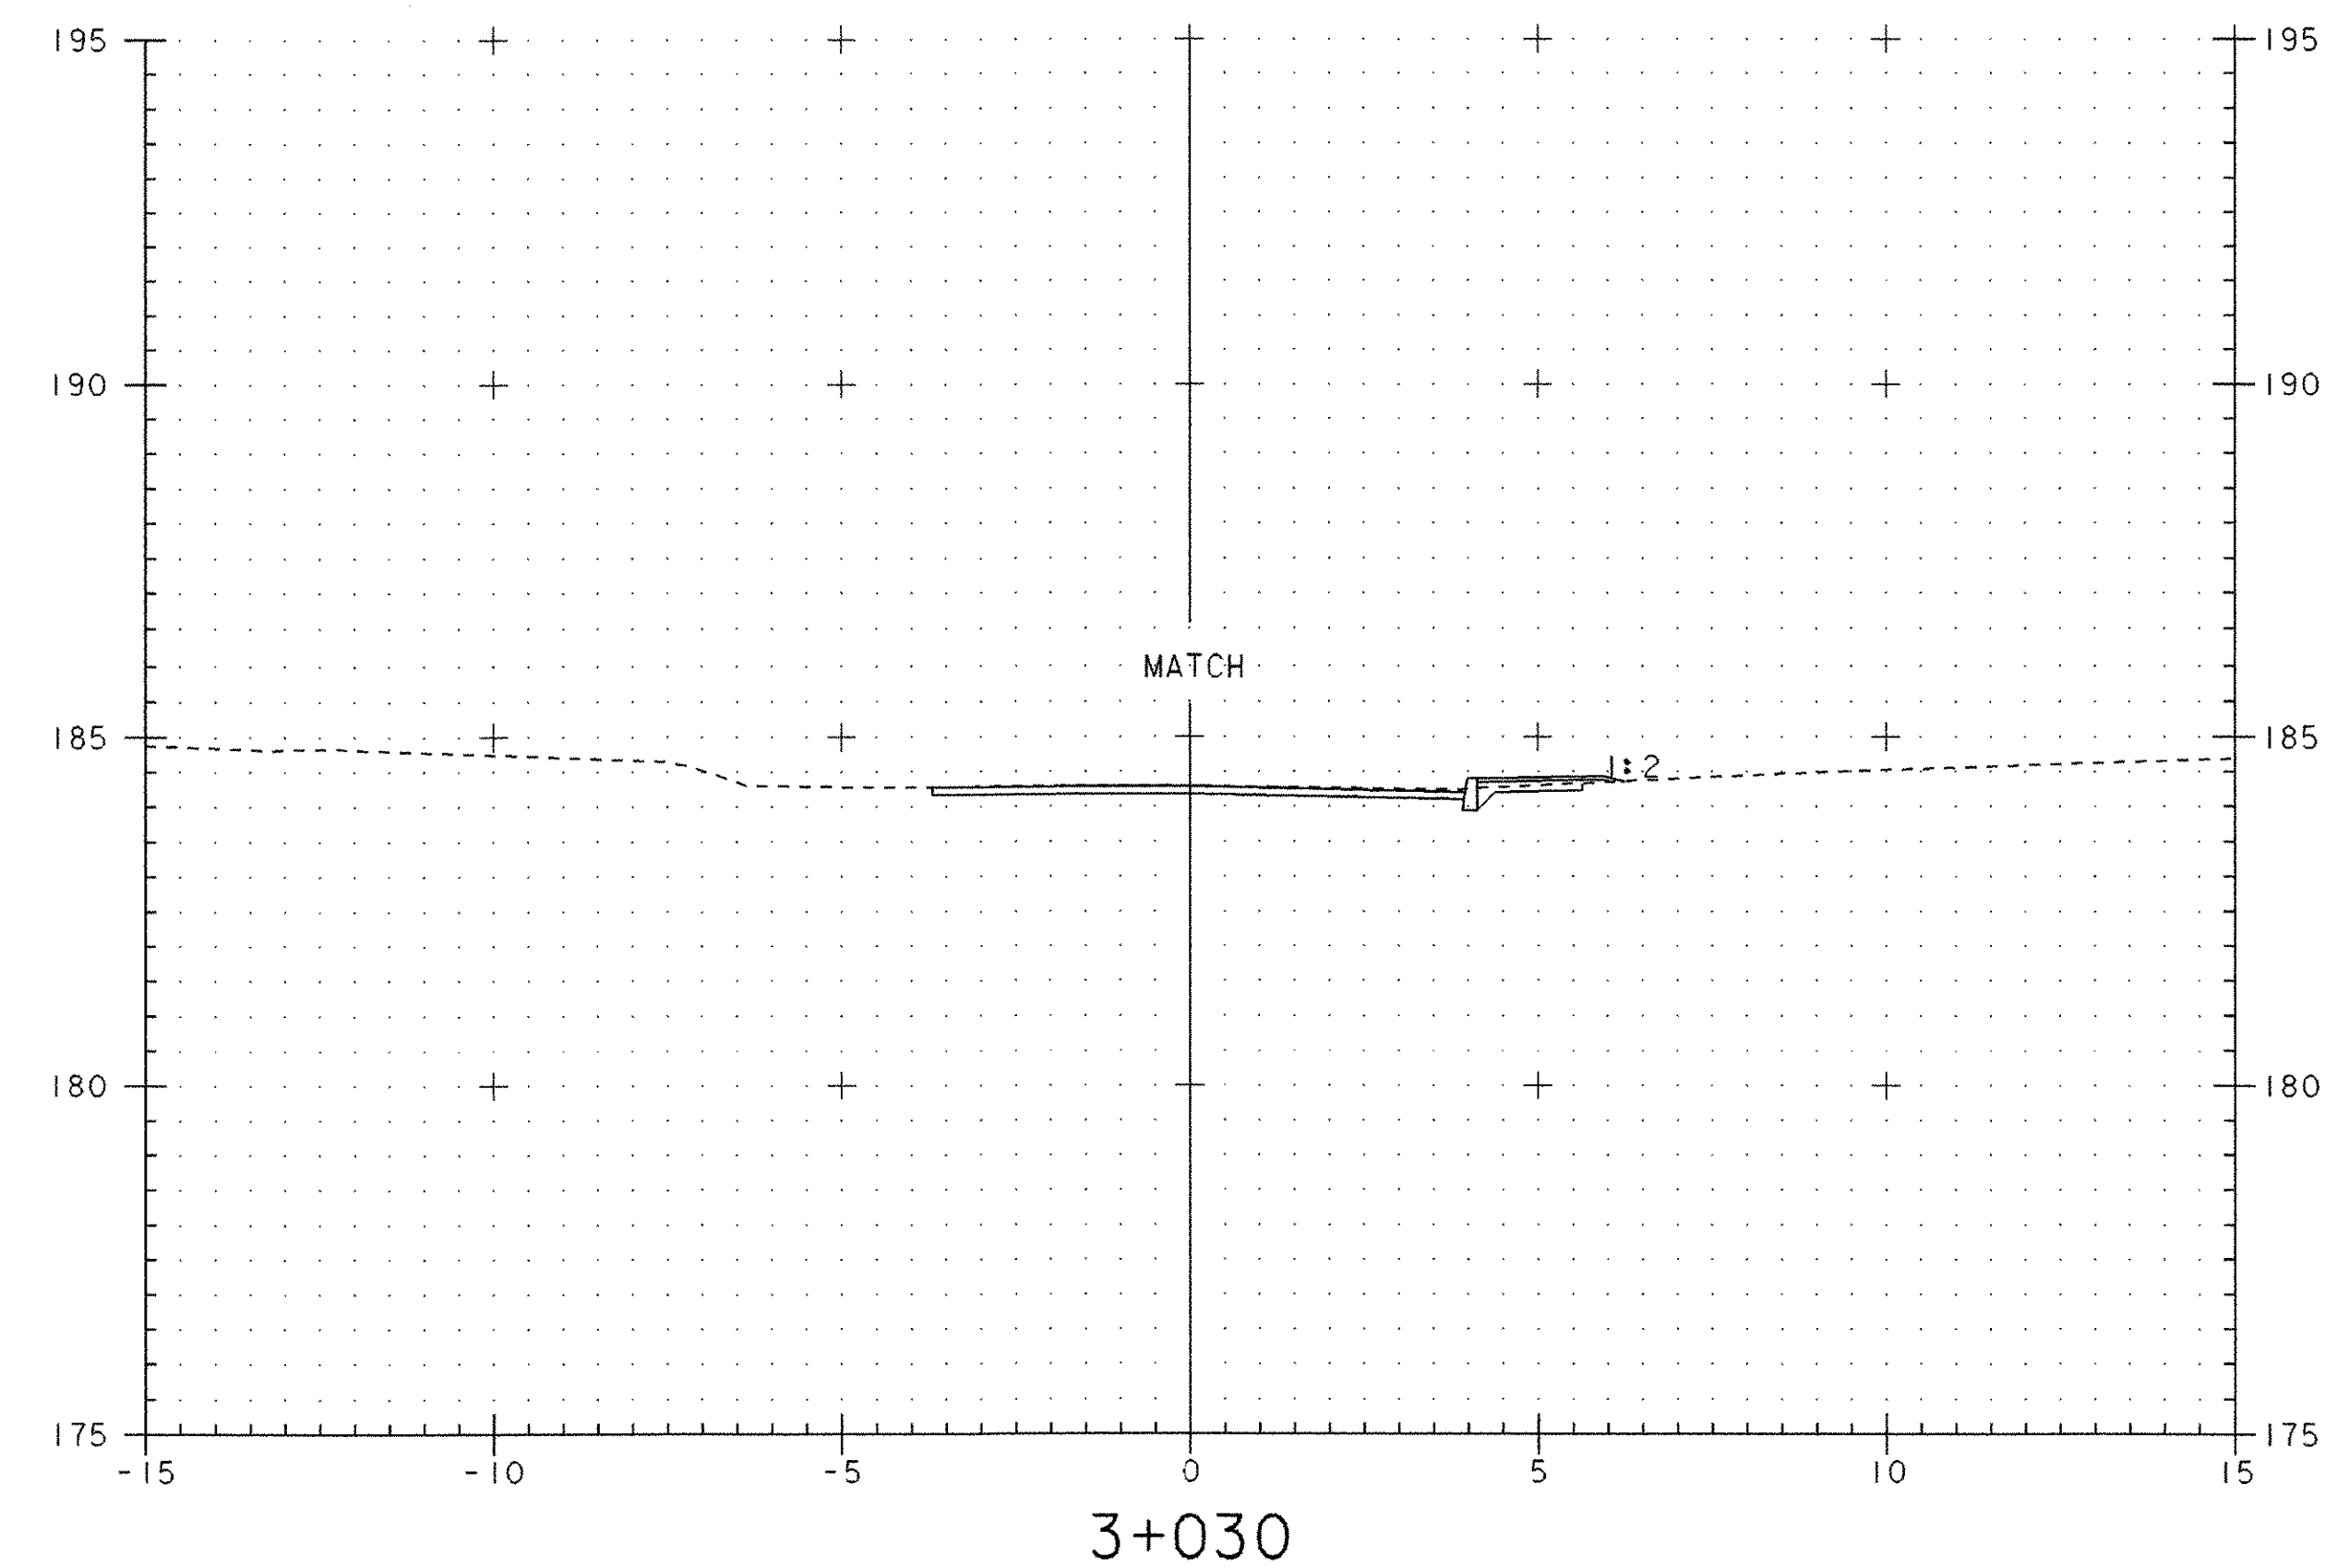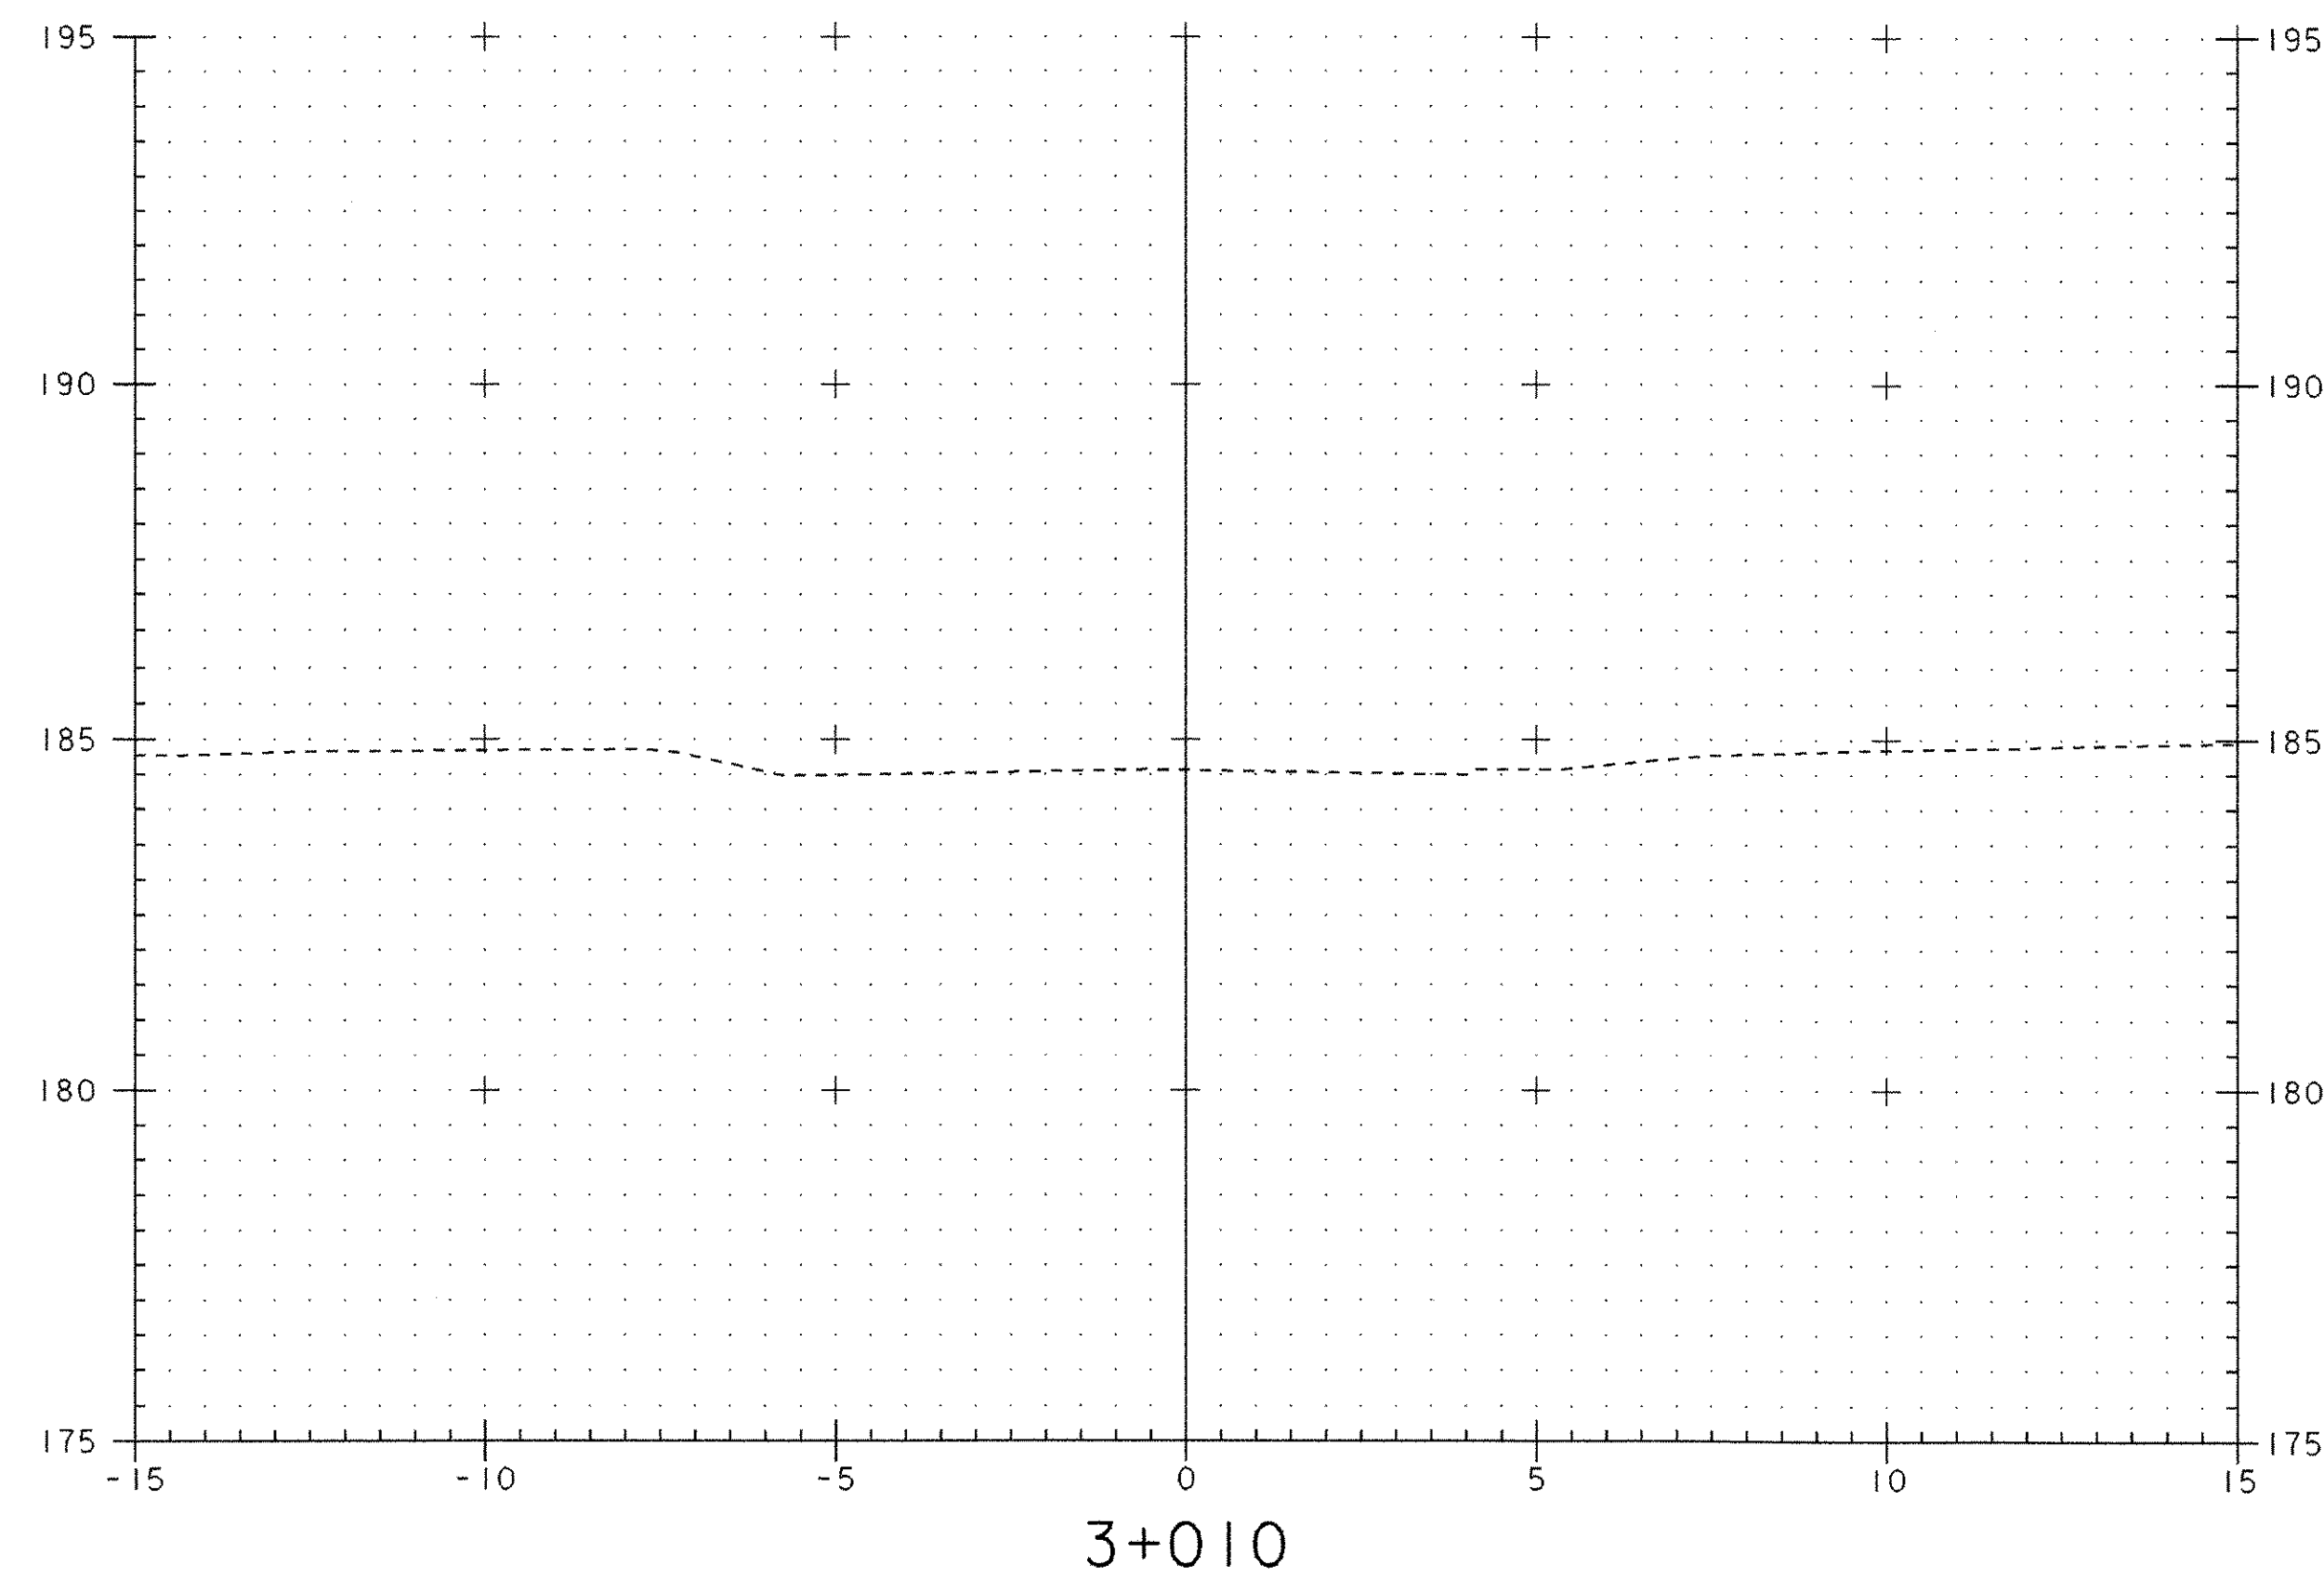

BEGIN APPROACH

|                                 |                                      |                  |                    |
|---------------------------------|--------------------------------------|------------------|--------------------|
| PROJECT:                        | BETHEL                               | PROJECT NO. :    | BRF 0241 (33) - C1 |
| DESIGN FILE NAME:               | 96j250/structures/s96j250xsec-cl.dgn | IPARM FILE NAME: | s1250xdel1.i       |
| TEMPORARY DETOUR CROSS SECTIONS |                                      |                  |                    |
| STA 3+000 Thru STA 3+030        |                                      |                  |                    |
|                                 |                                      | SHEET:           | 32 OF 47           |








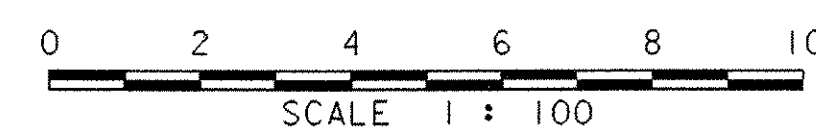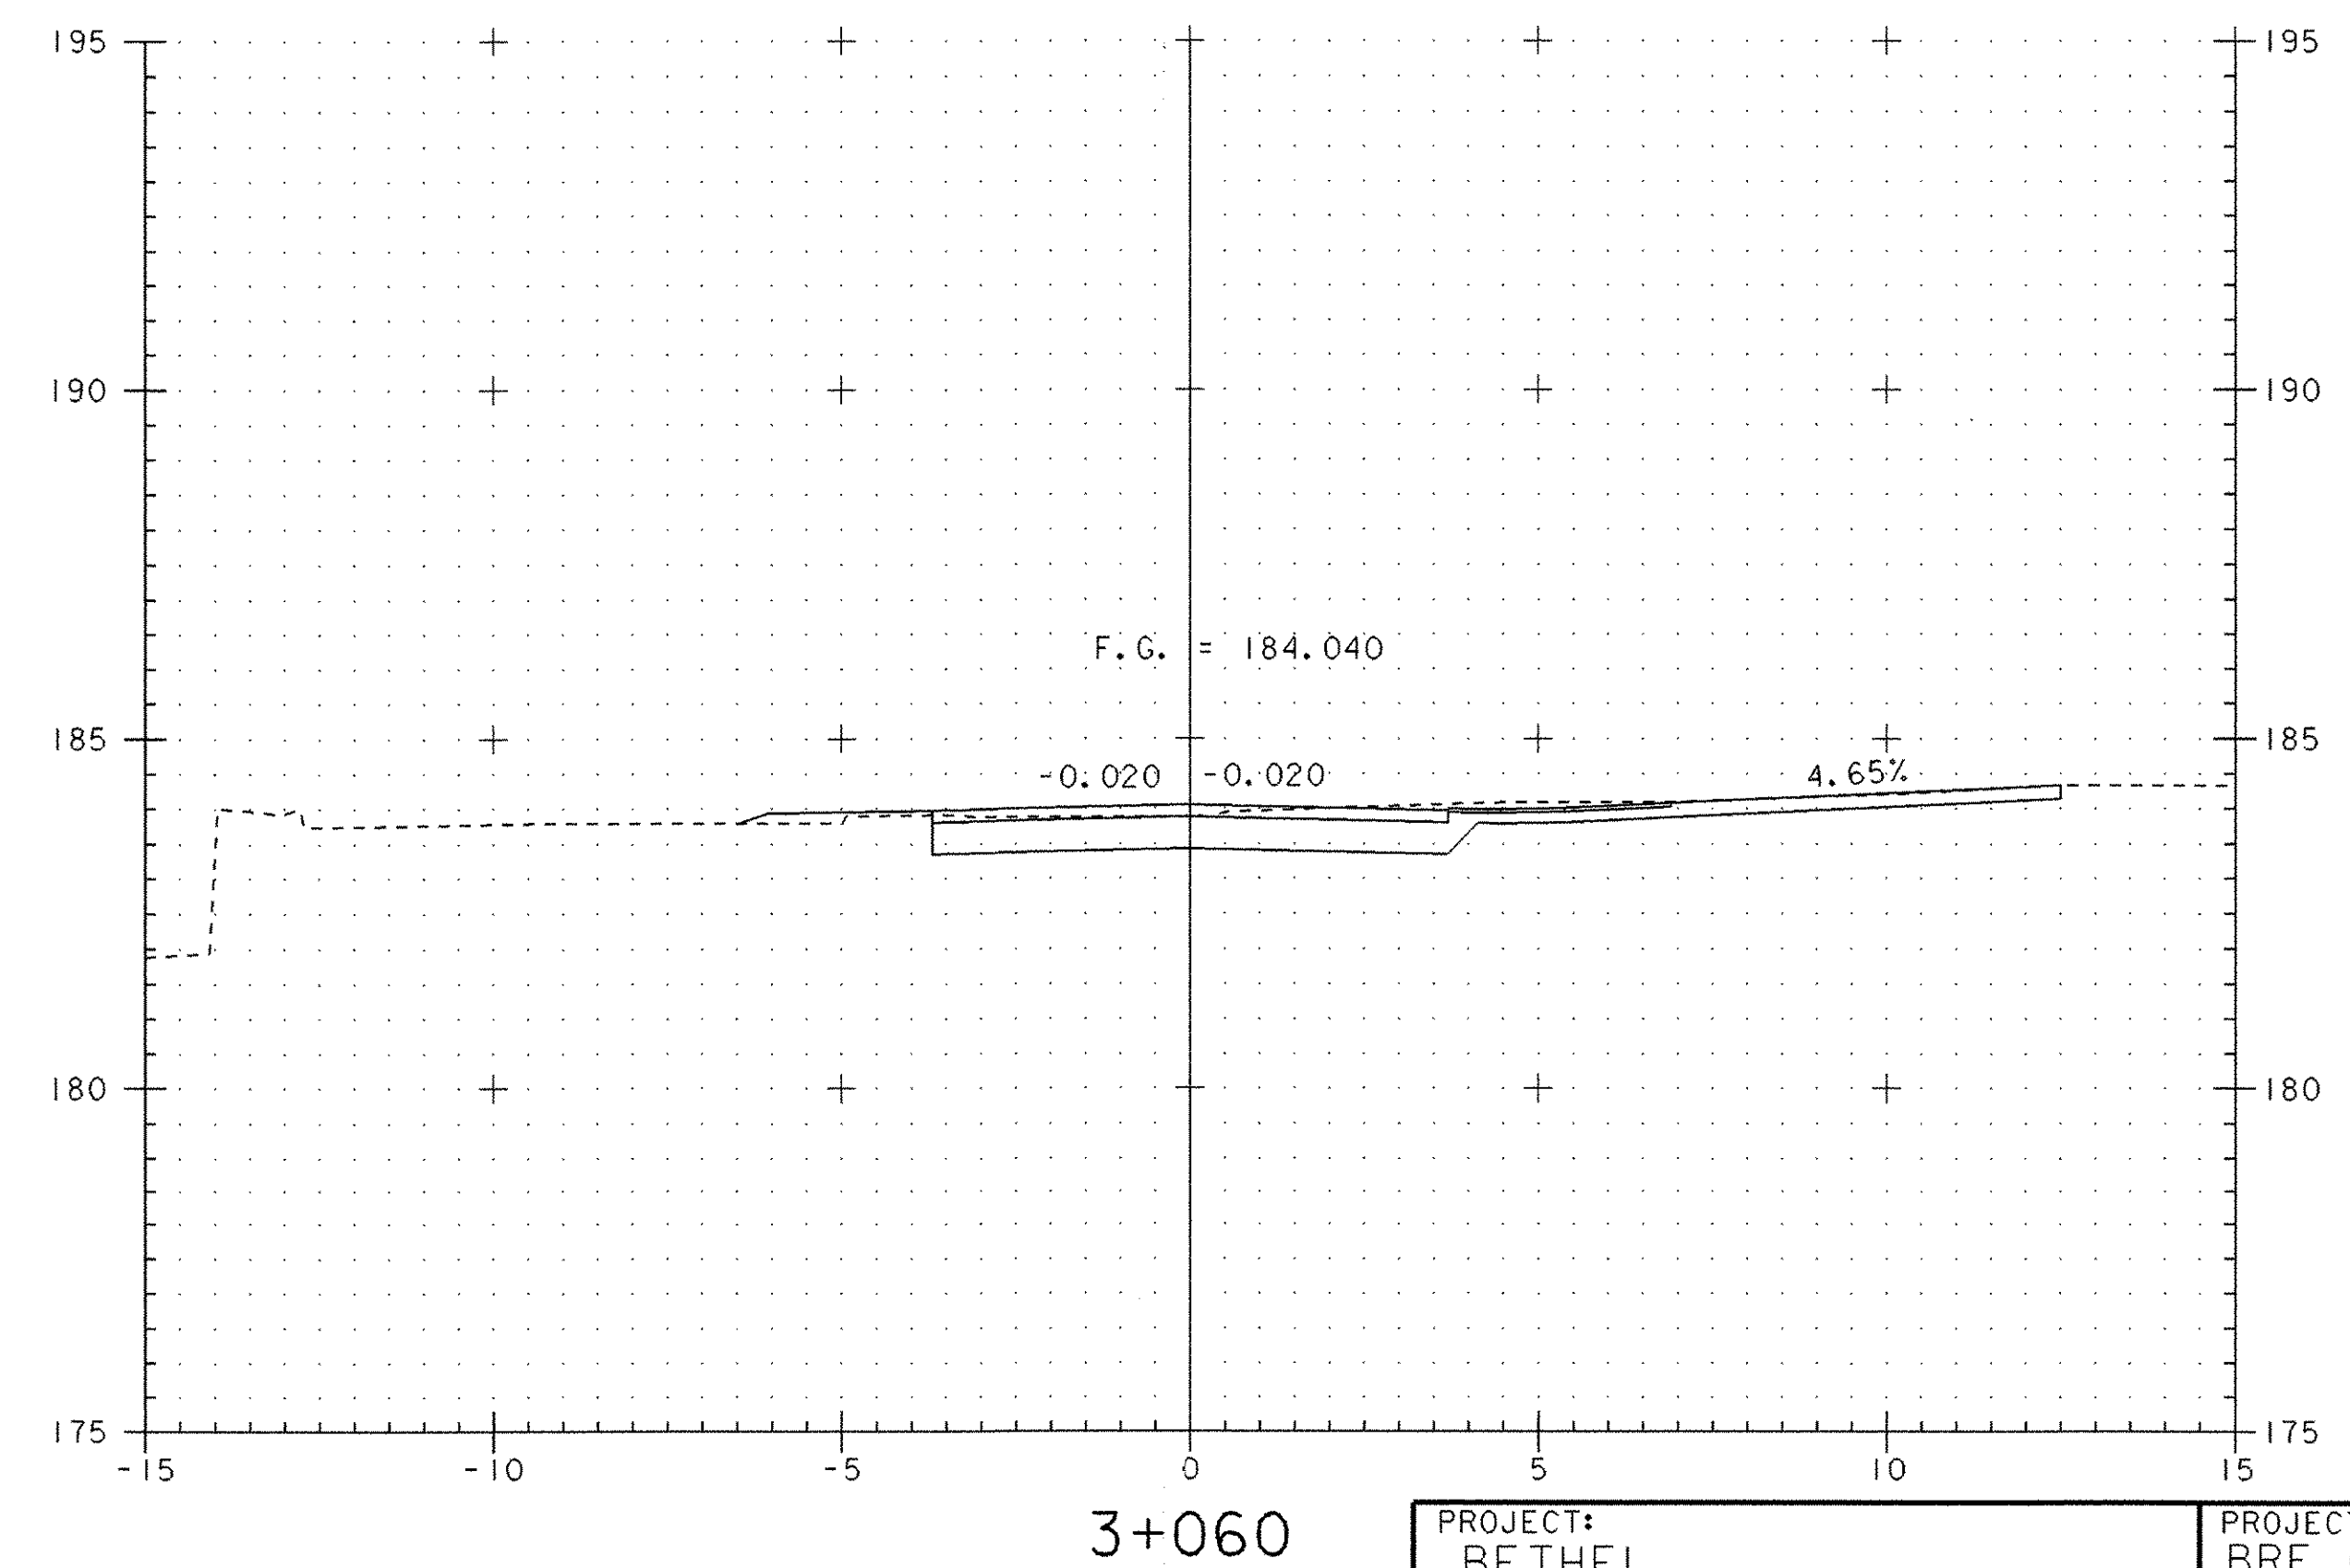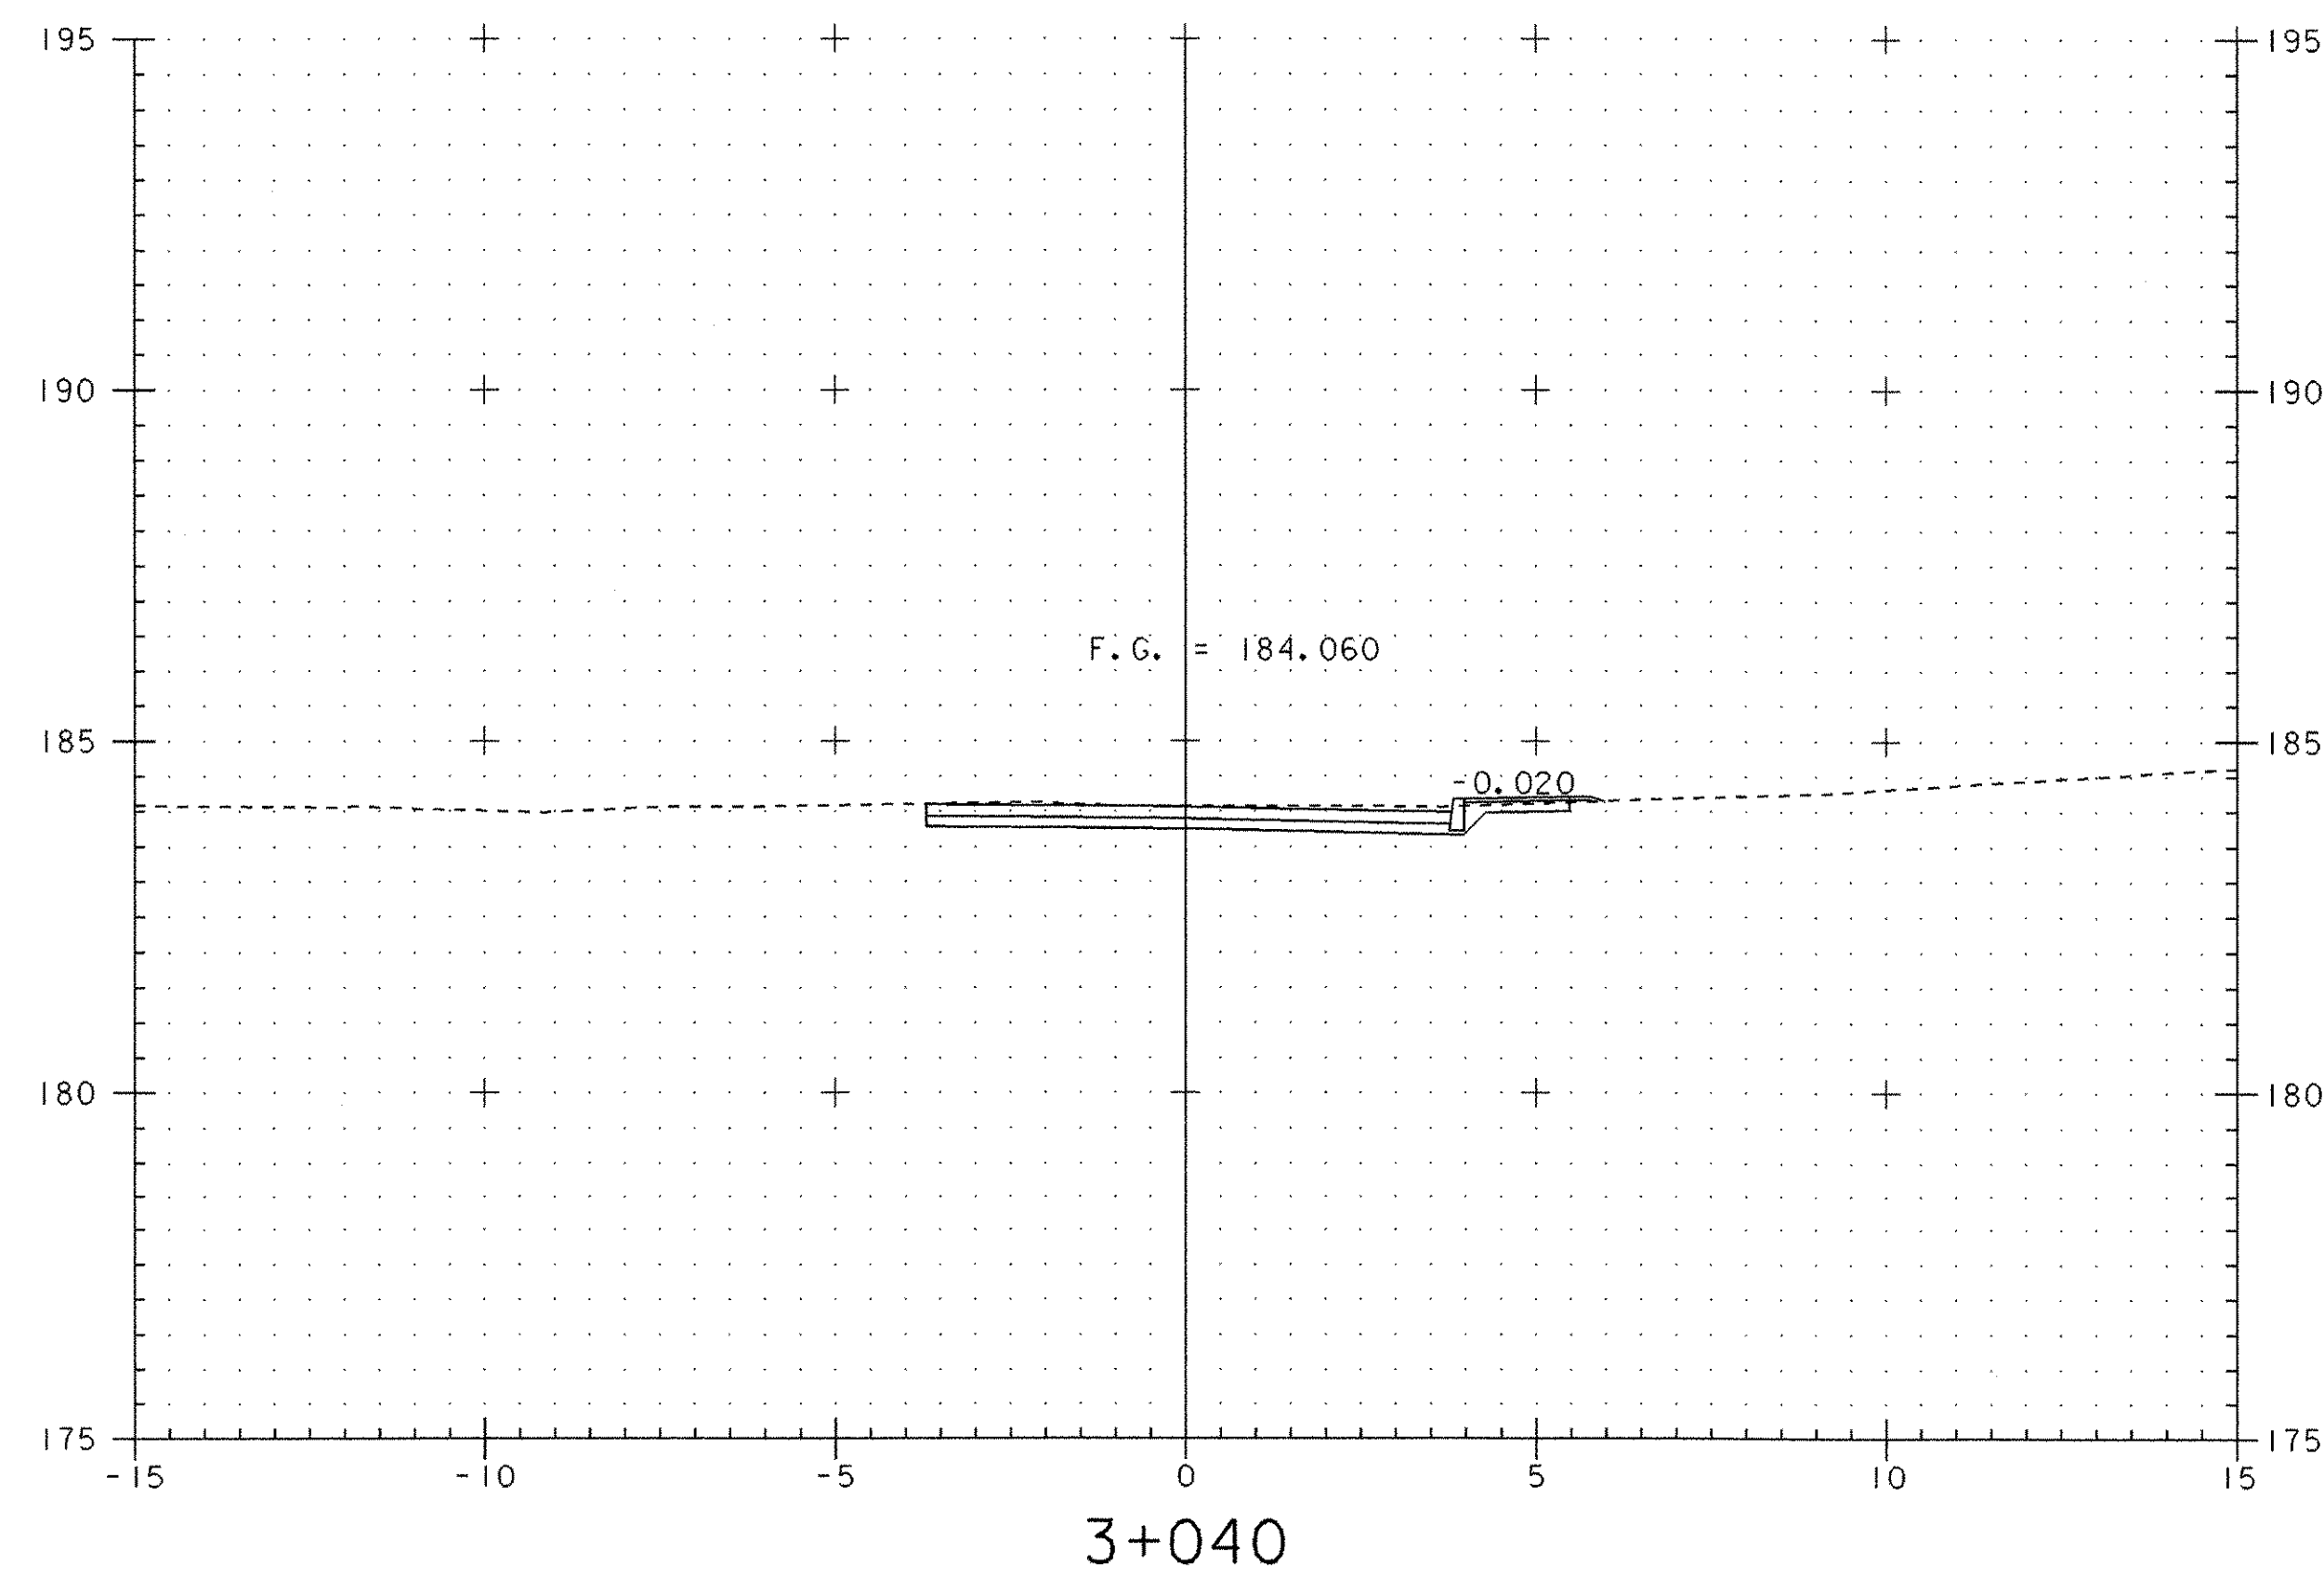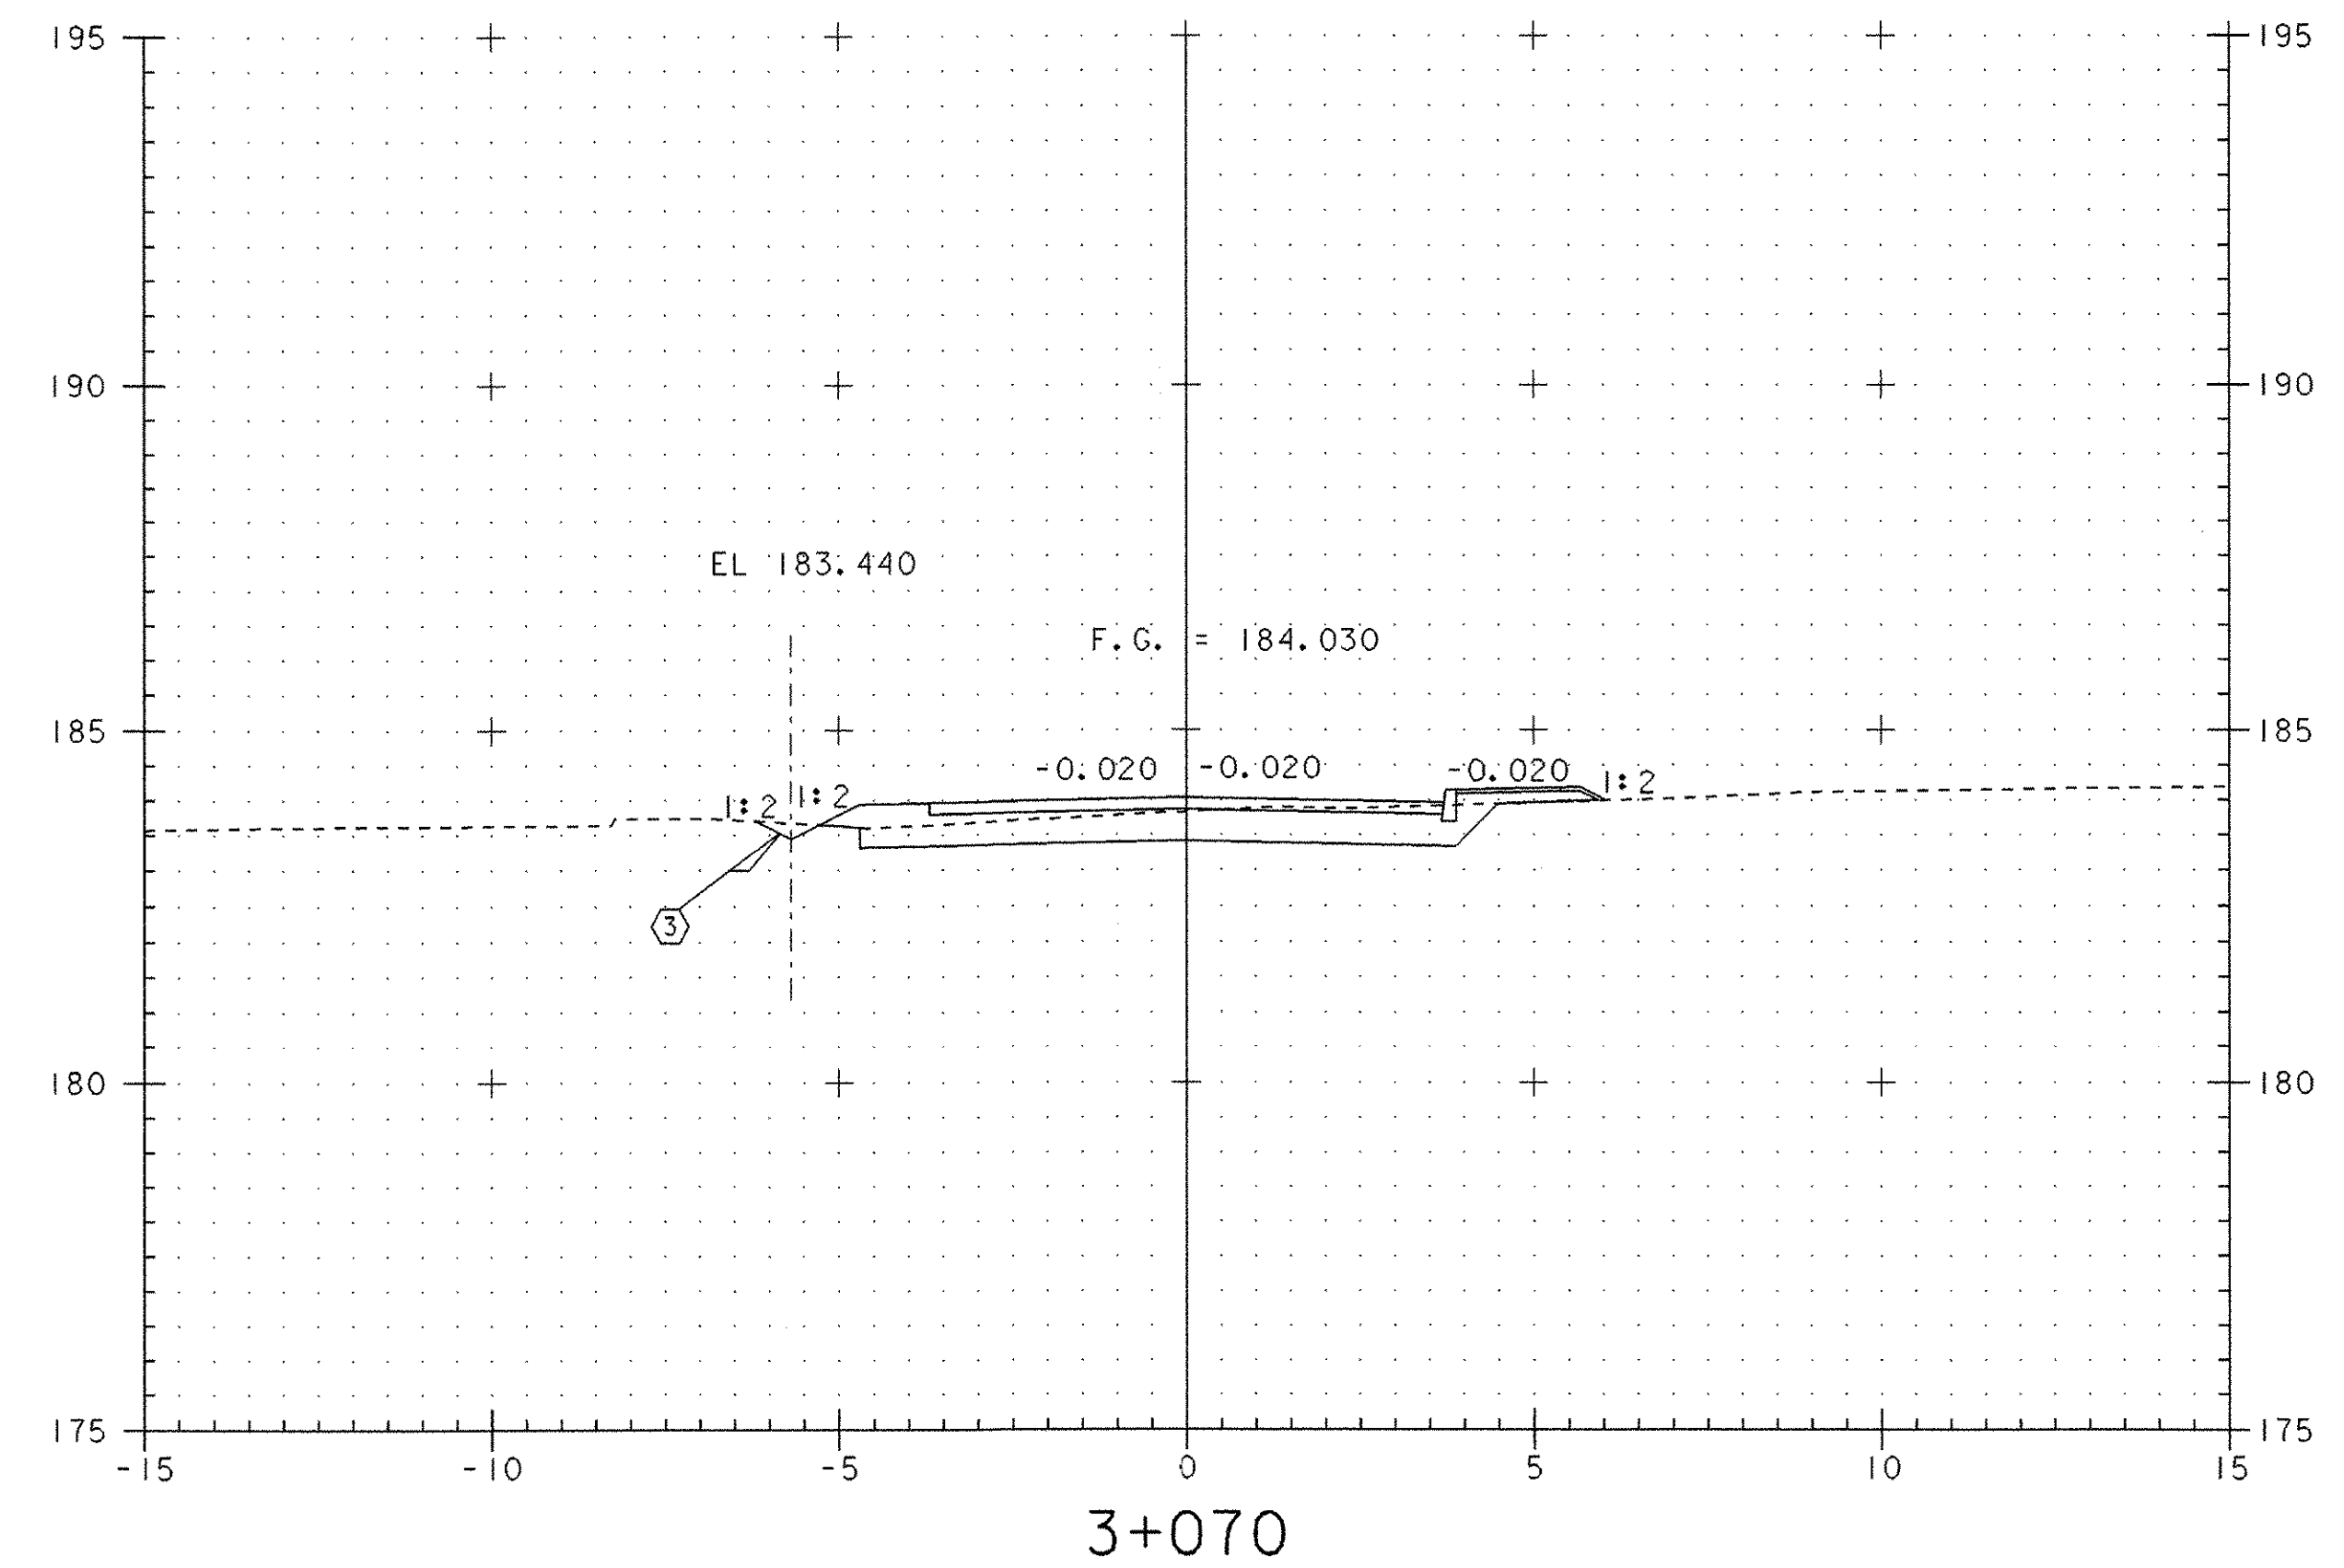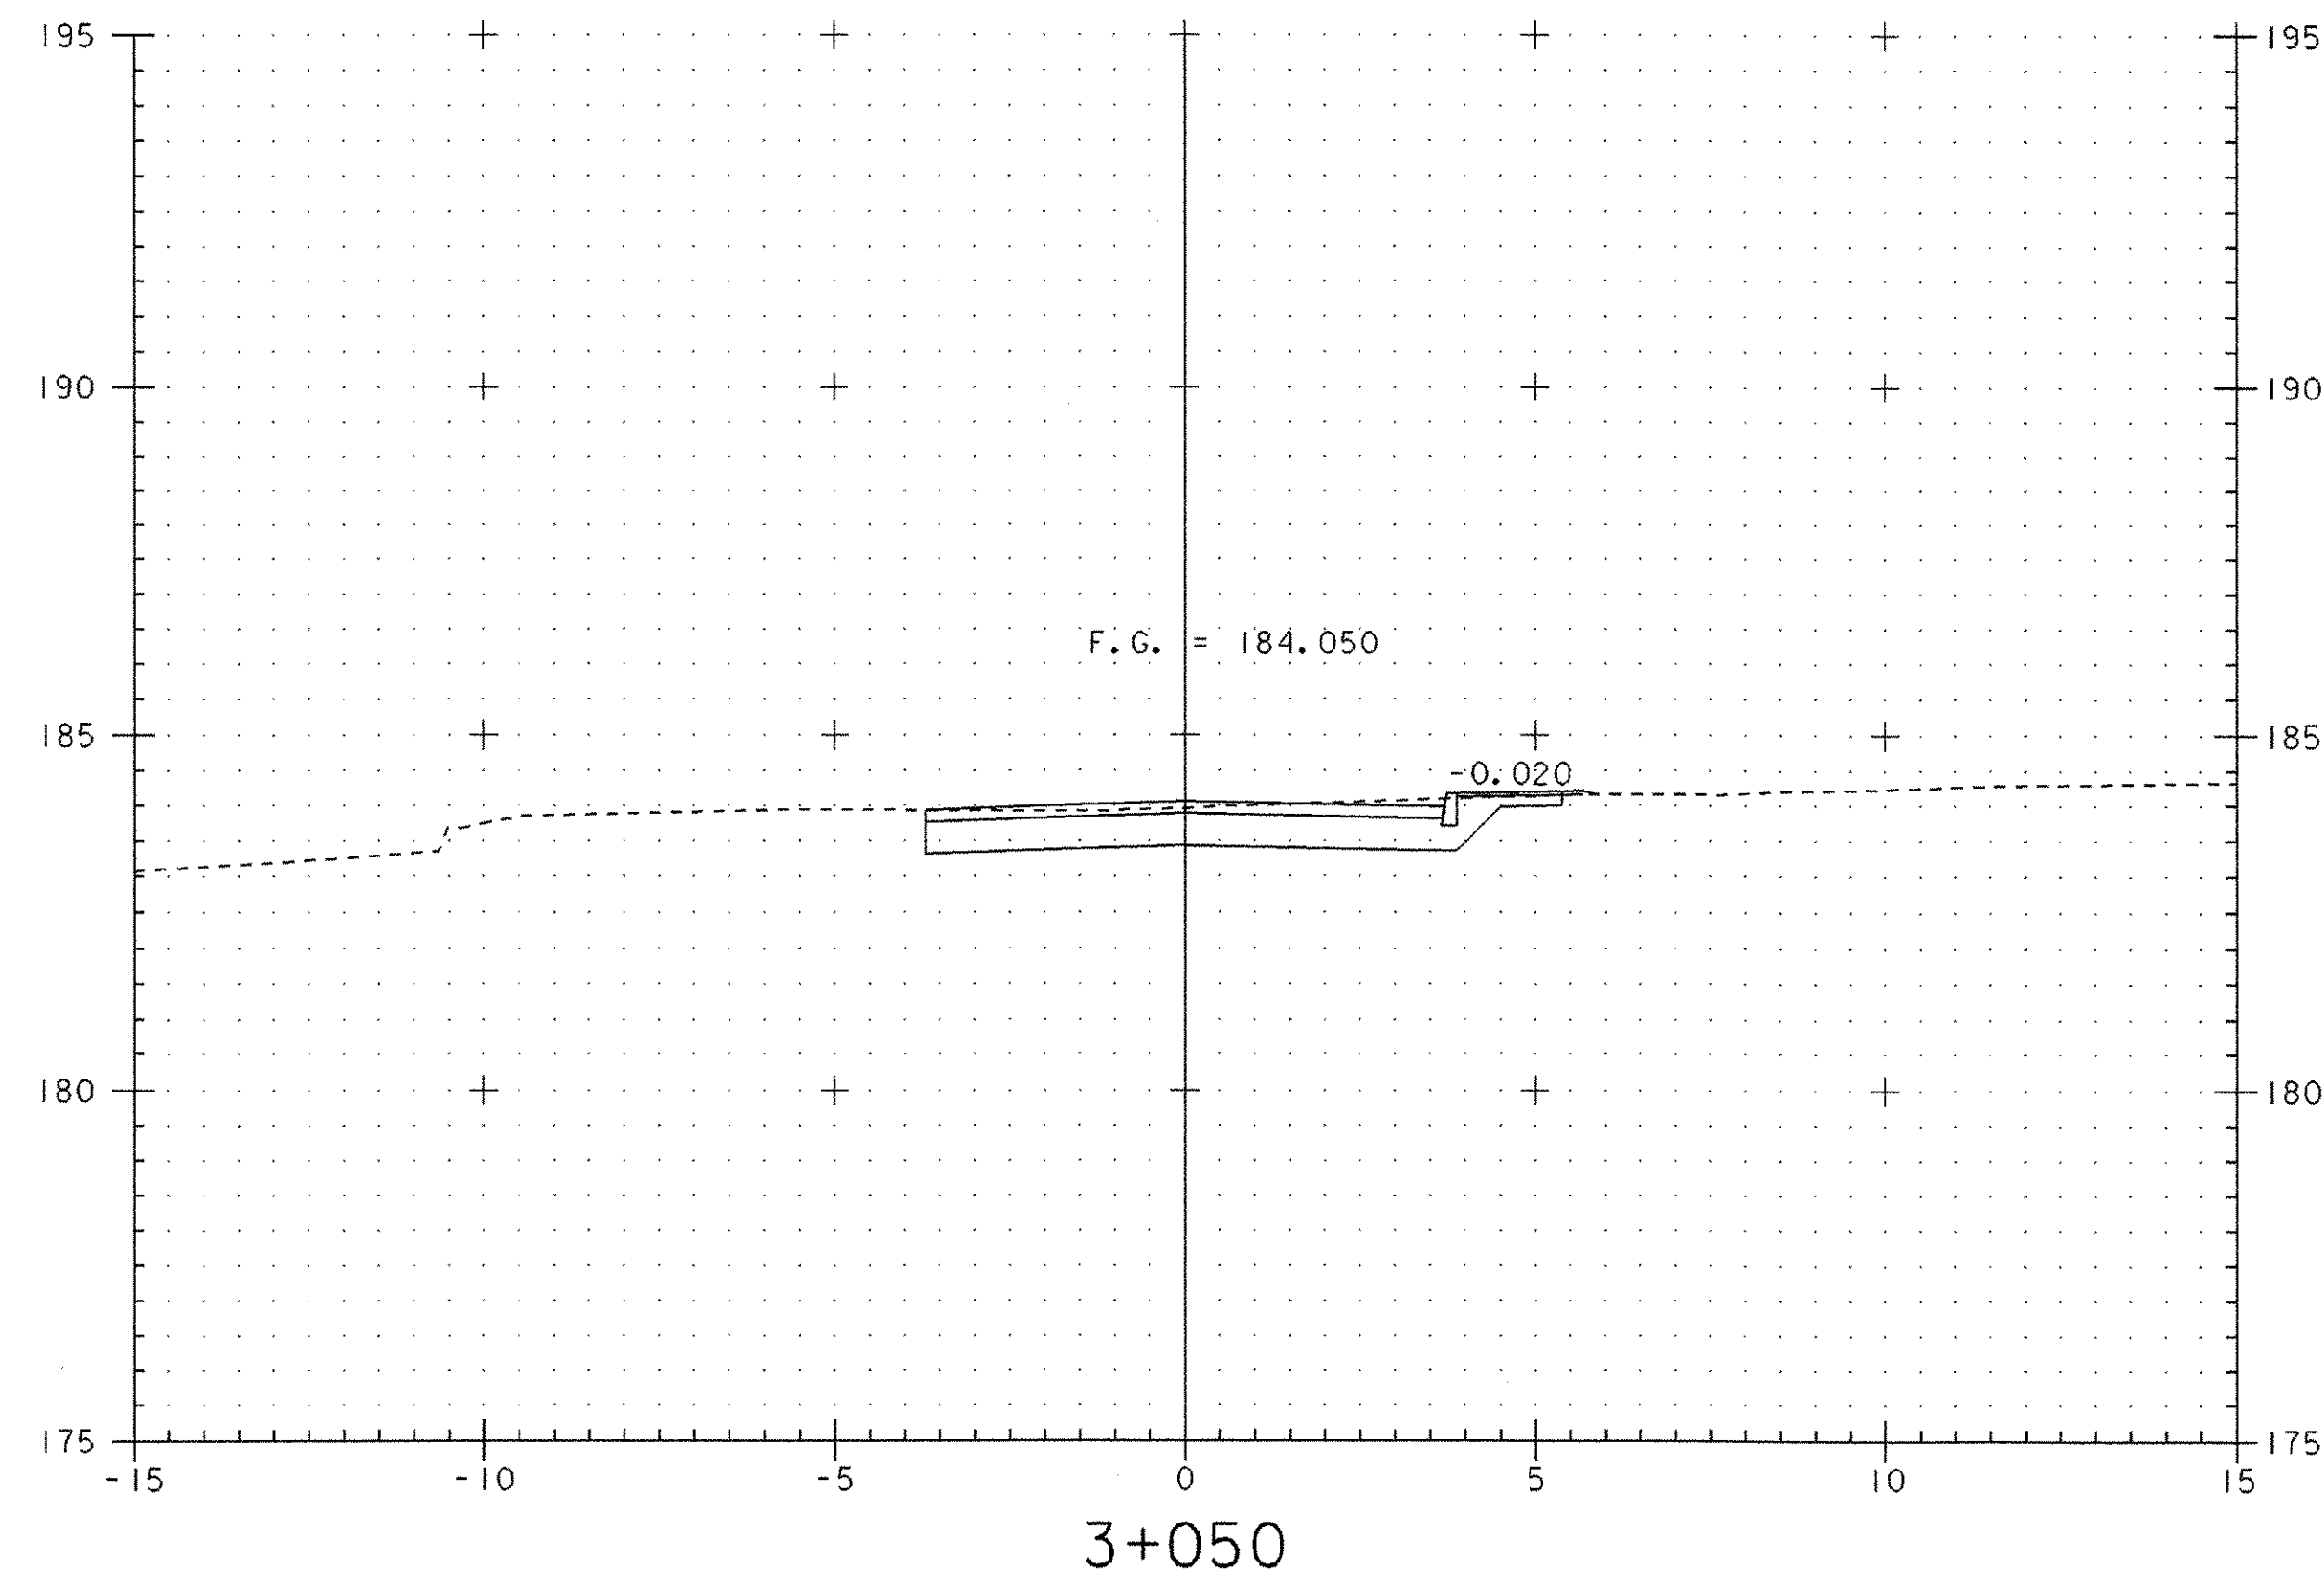

END APPROACH  
BEGIN PROJECT




|                                                        |                                     |
|--------------------------------------------------------|-------------------------------------|
| PROJECT:<br>BETHEL                                     | PROJECT NO. :<br>BRF 0241 (33) - C1 |
| DESIGN FILE NAME: 96j250/structures/s96j250xsec-c1.dgn | PLOT DATE: 09-JUL-2003              |
| IPARM FILE NAME: s1250xdet2.i                          |                                     |
| TEMPORARY DETOUR CROSS SECTIONS                        |                                     |
| STA 3+040 Thru STA 3+070                               | SHEET: 33 OF 47                     |



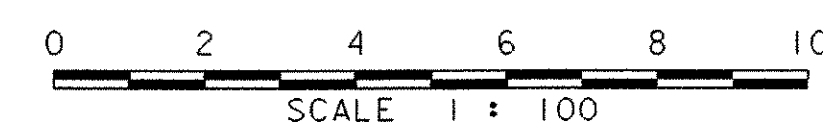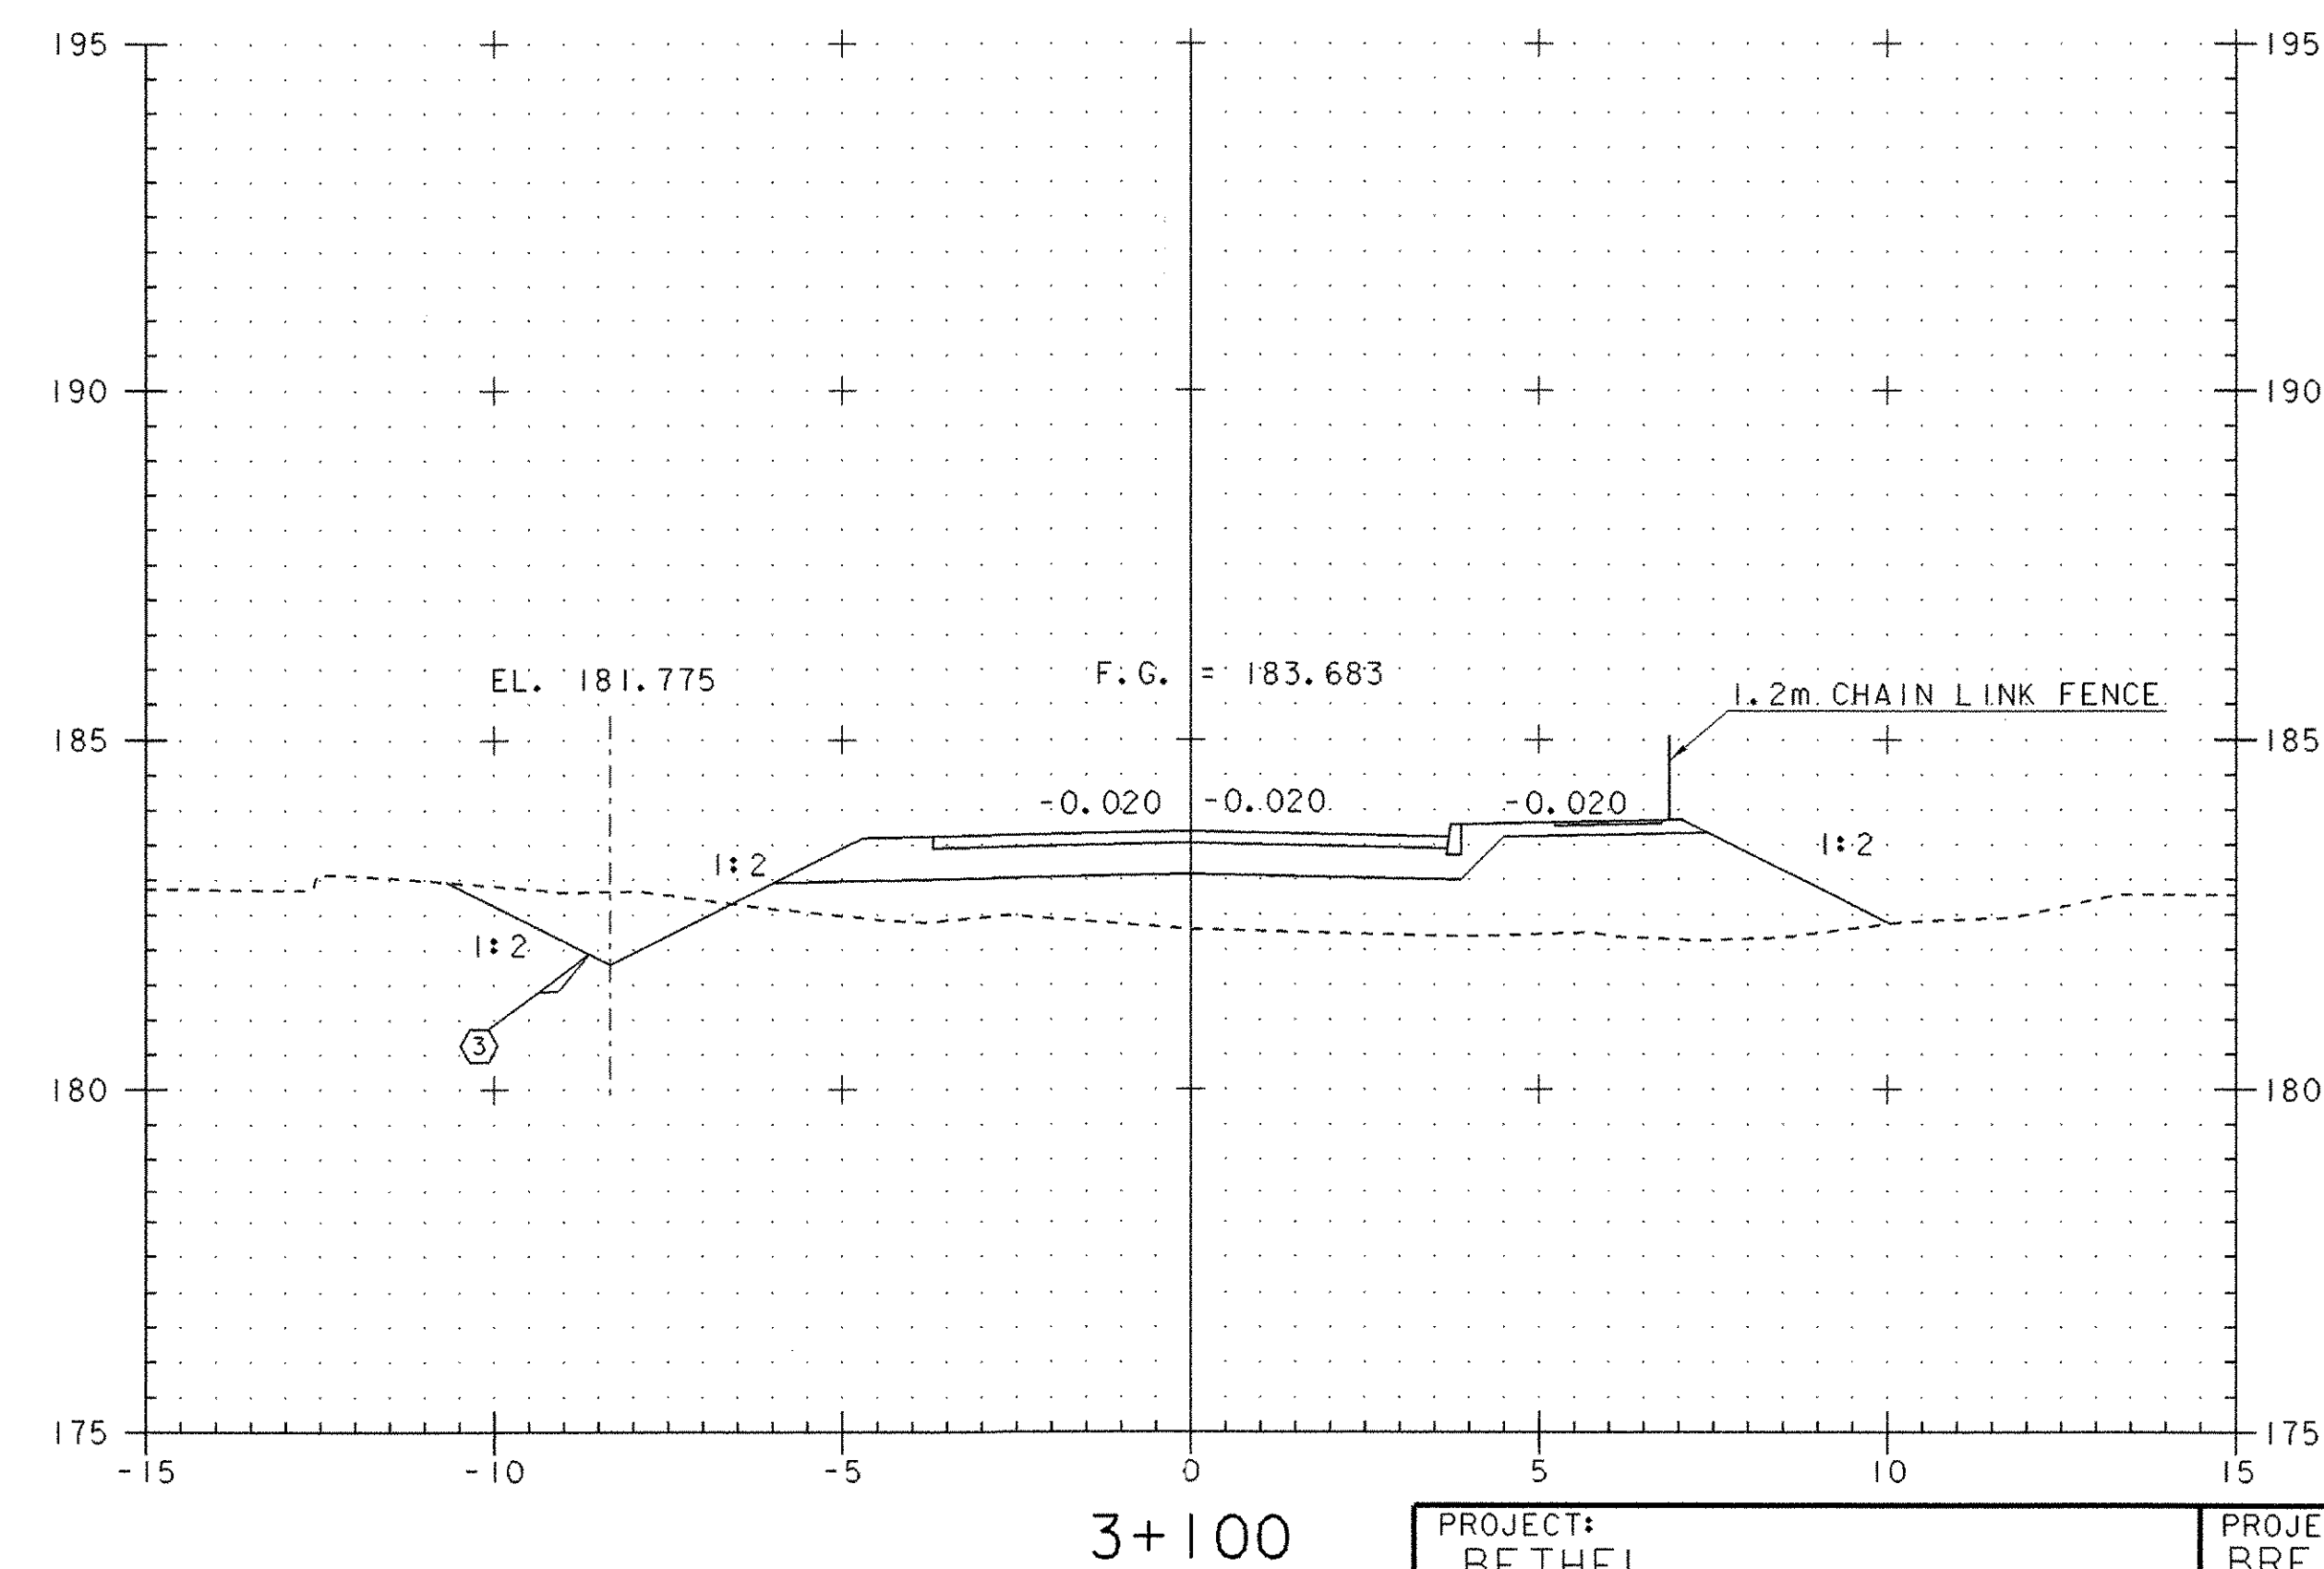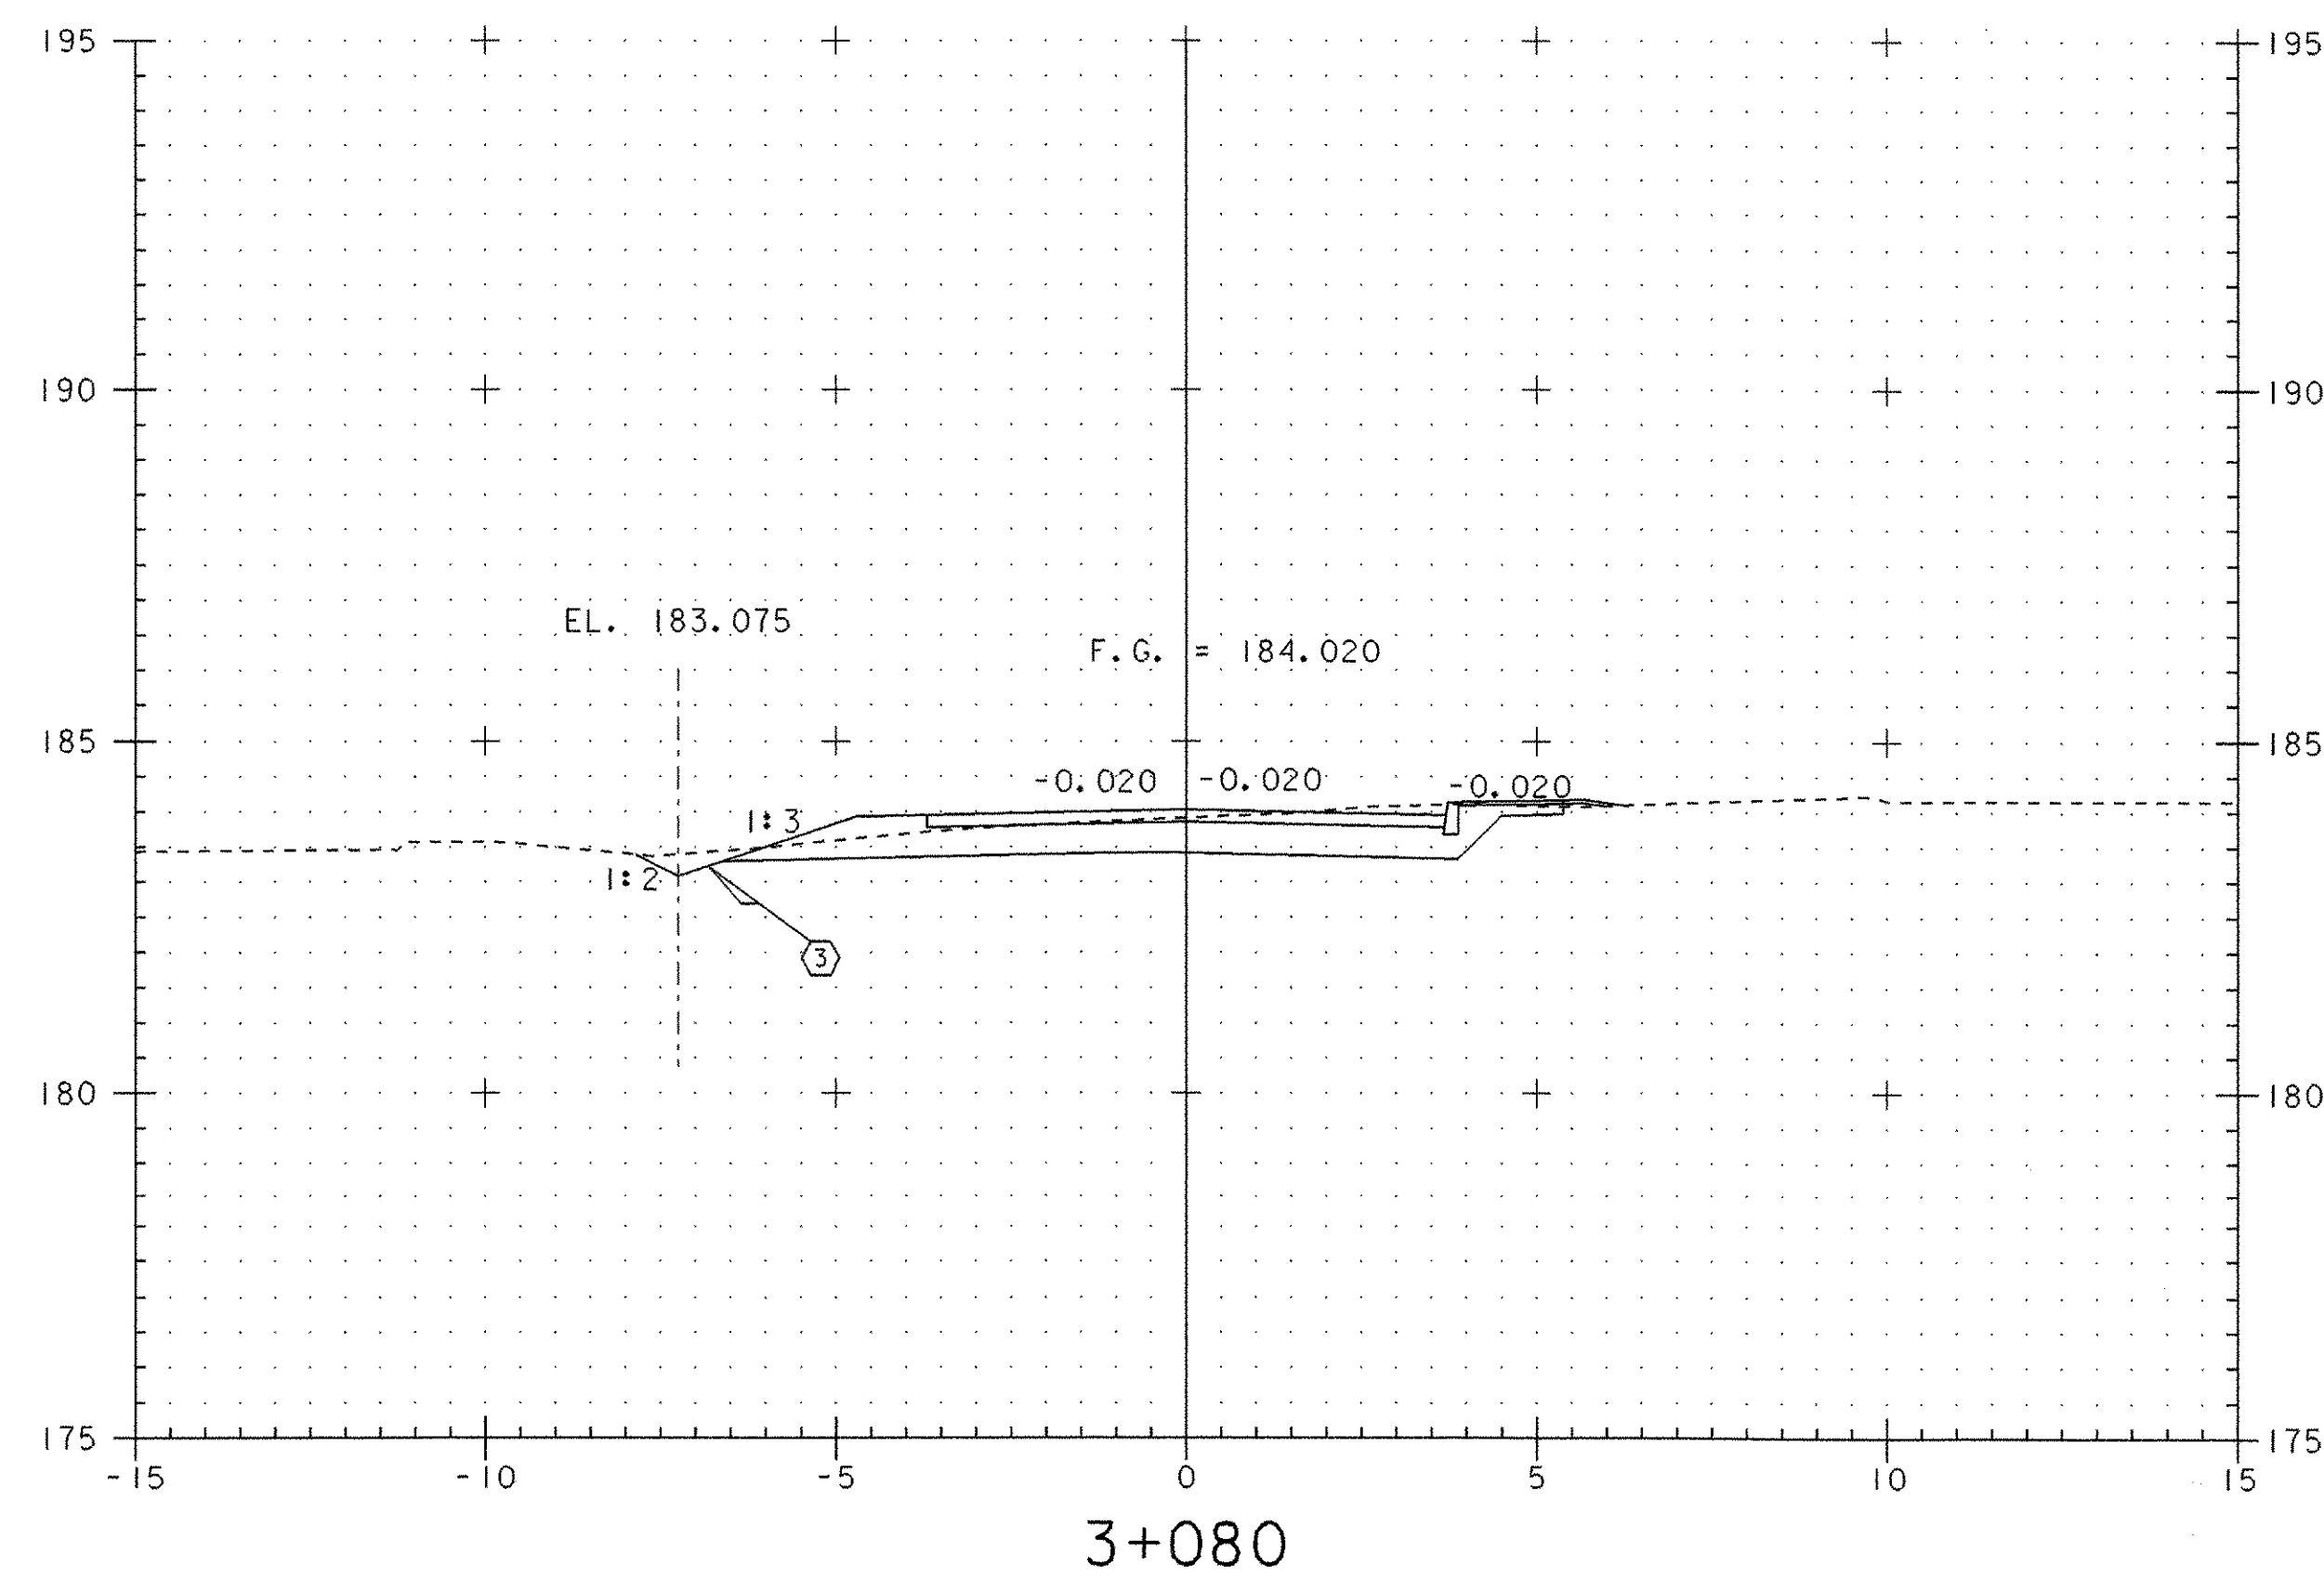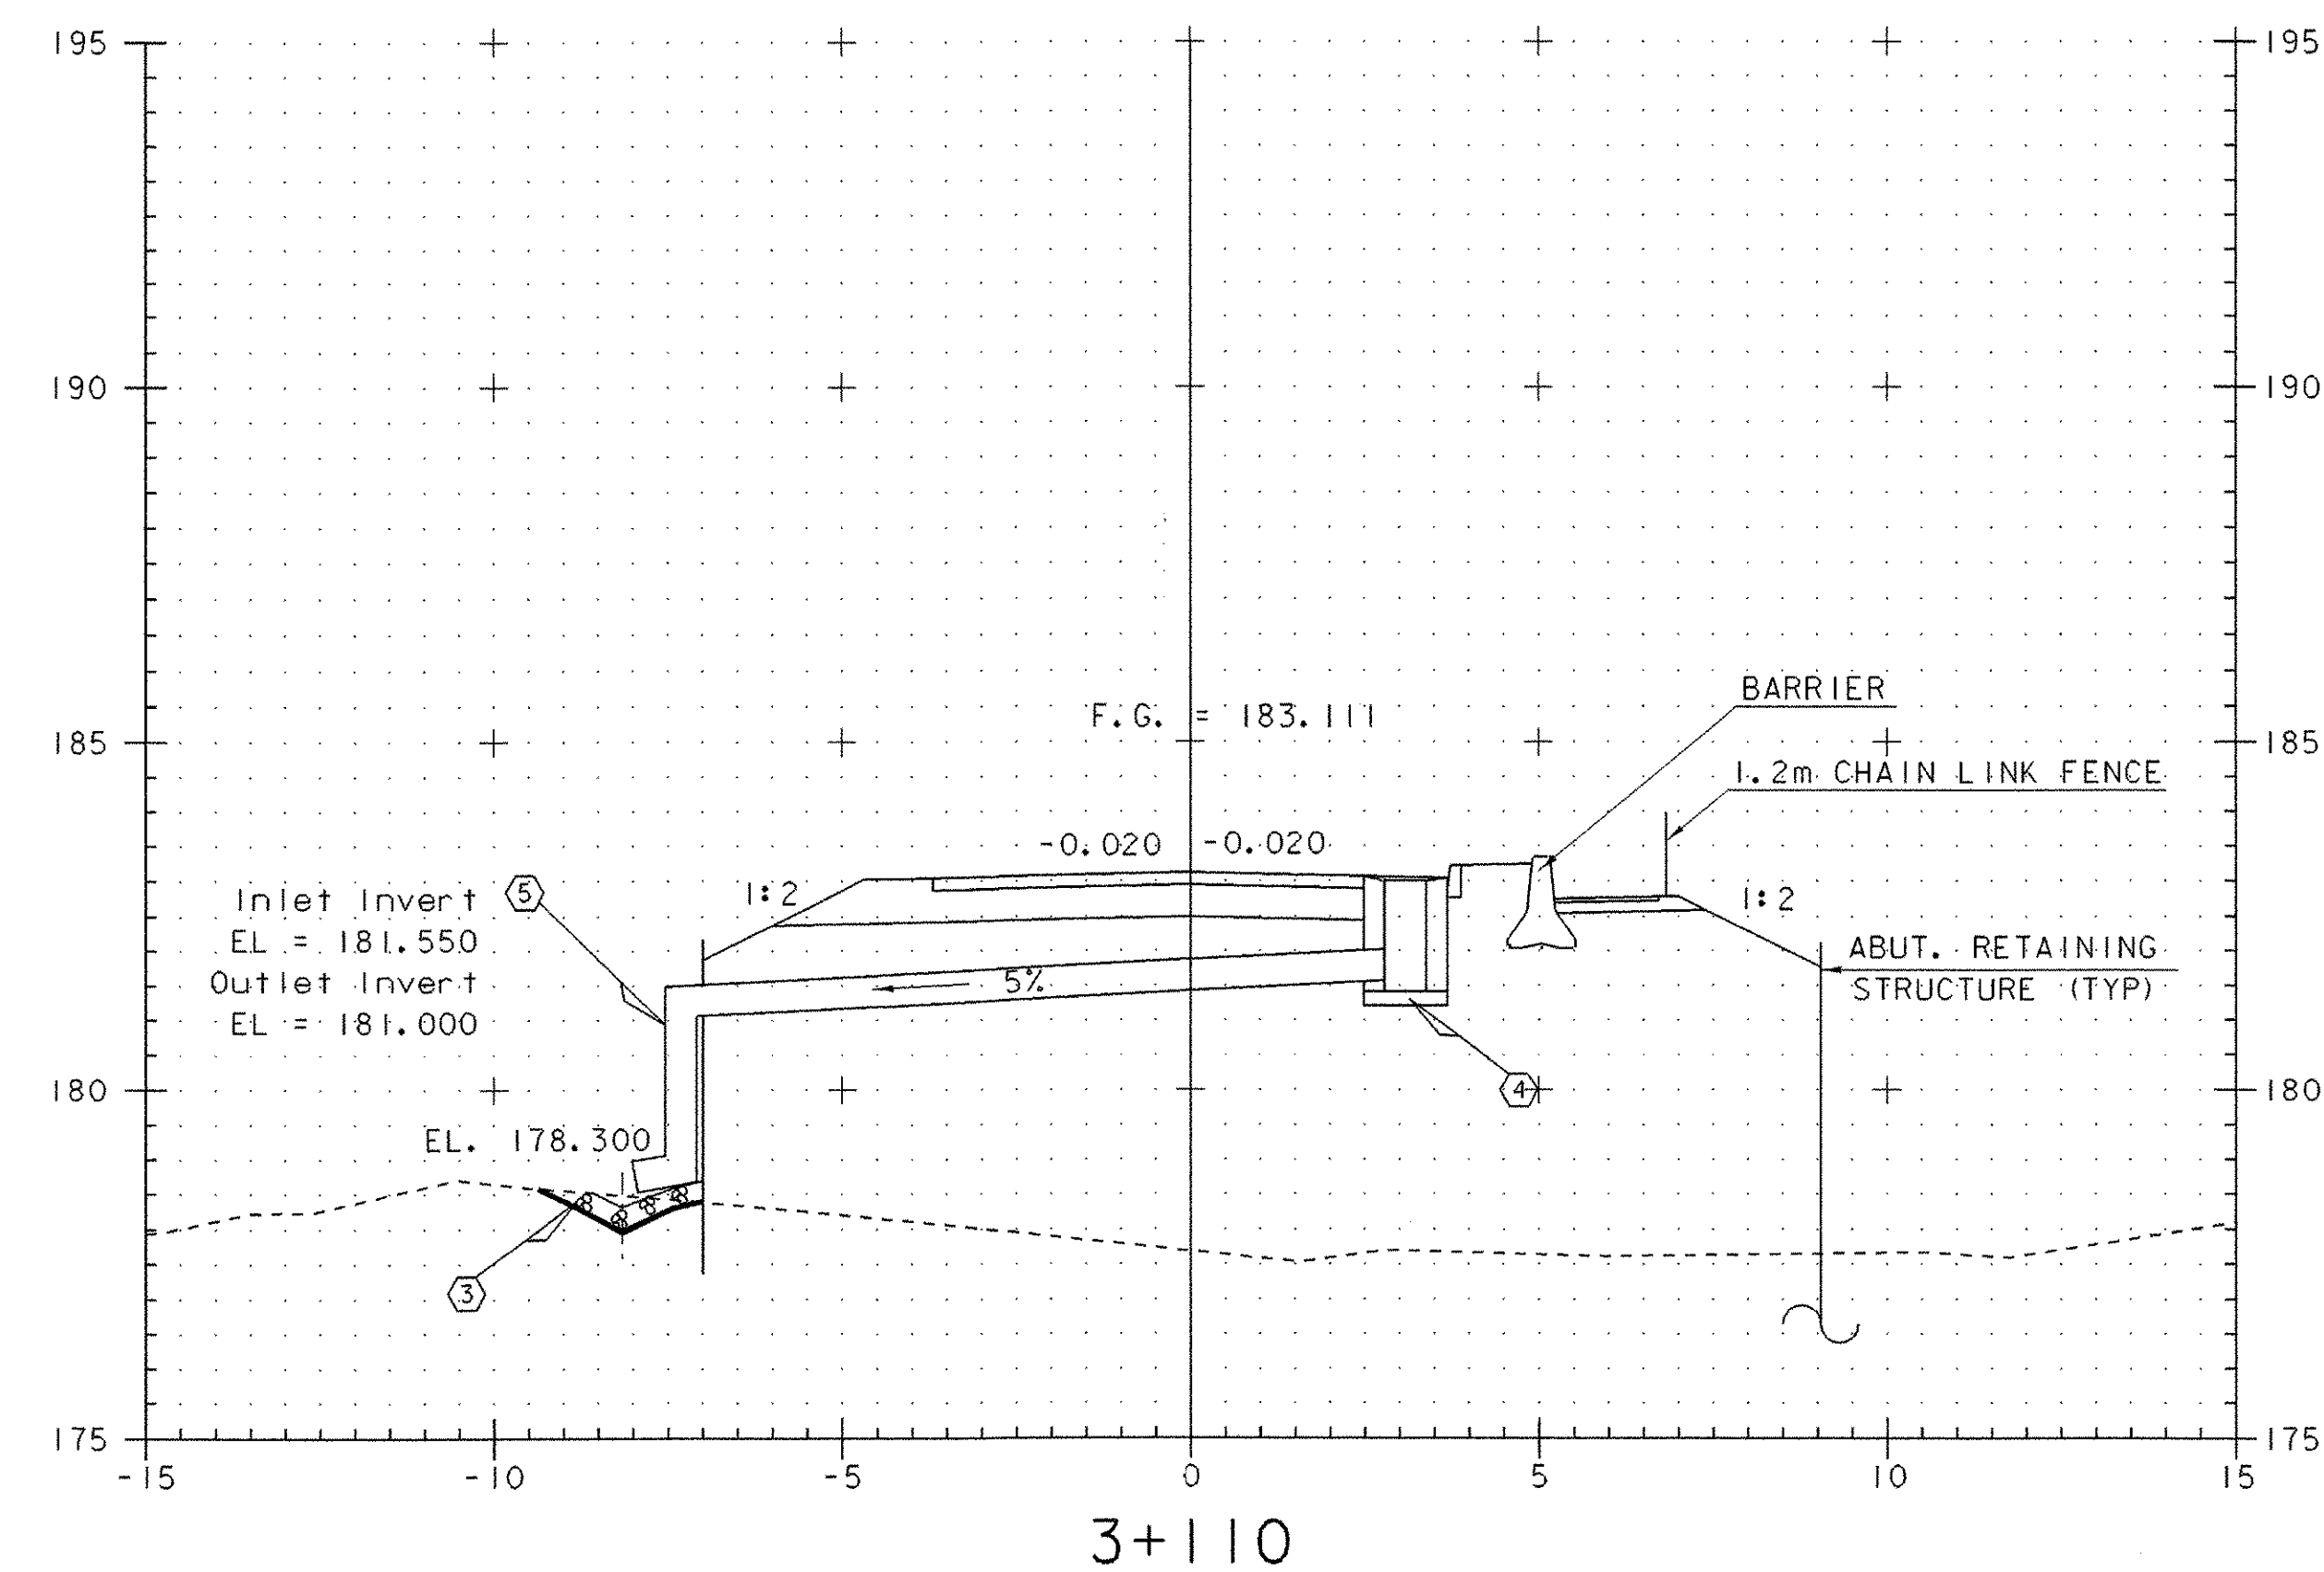
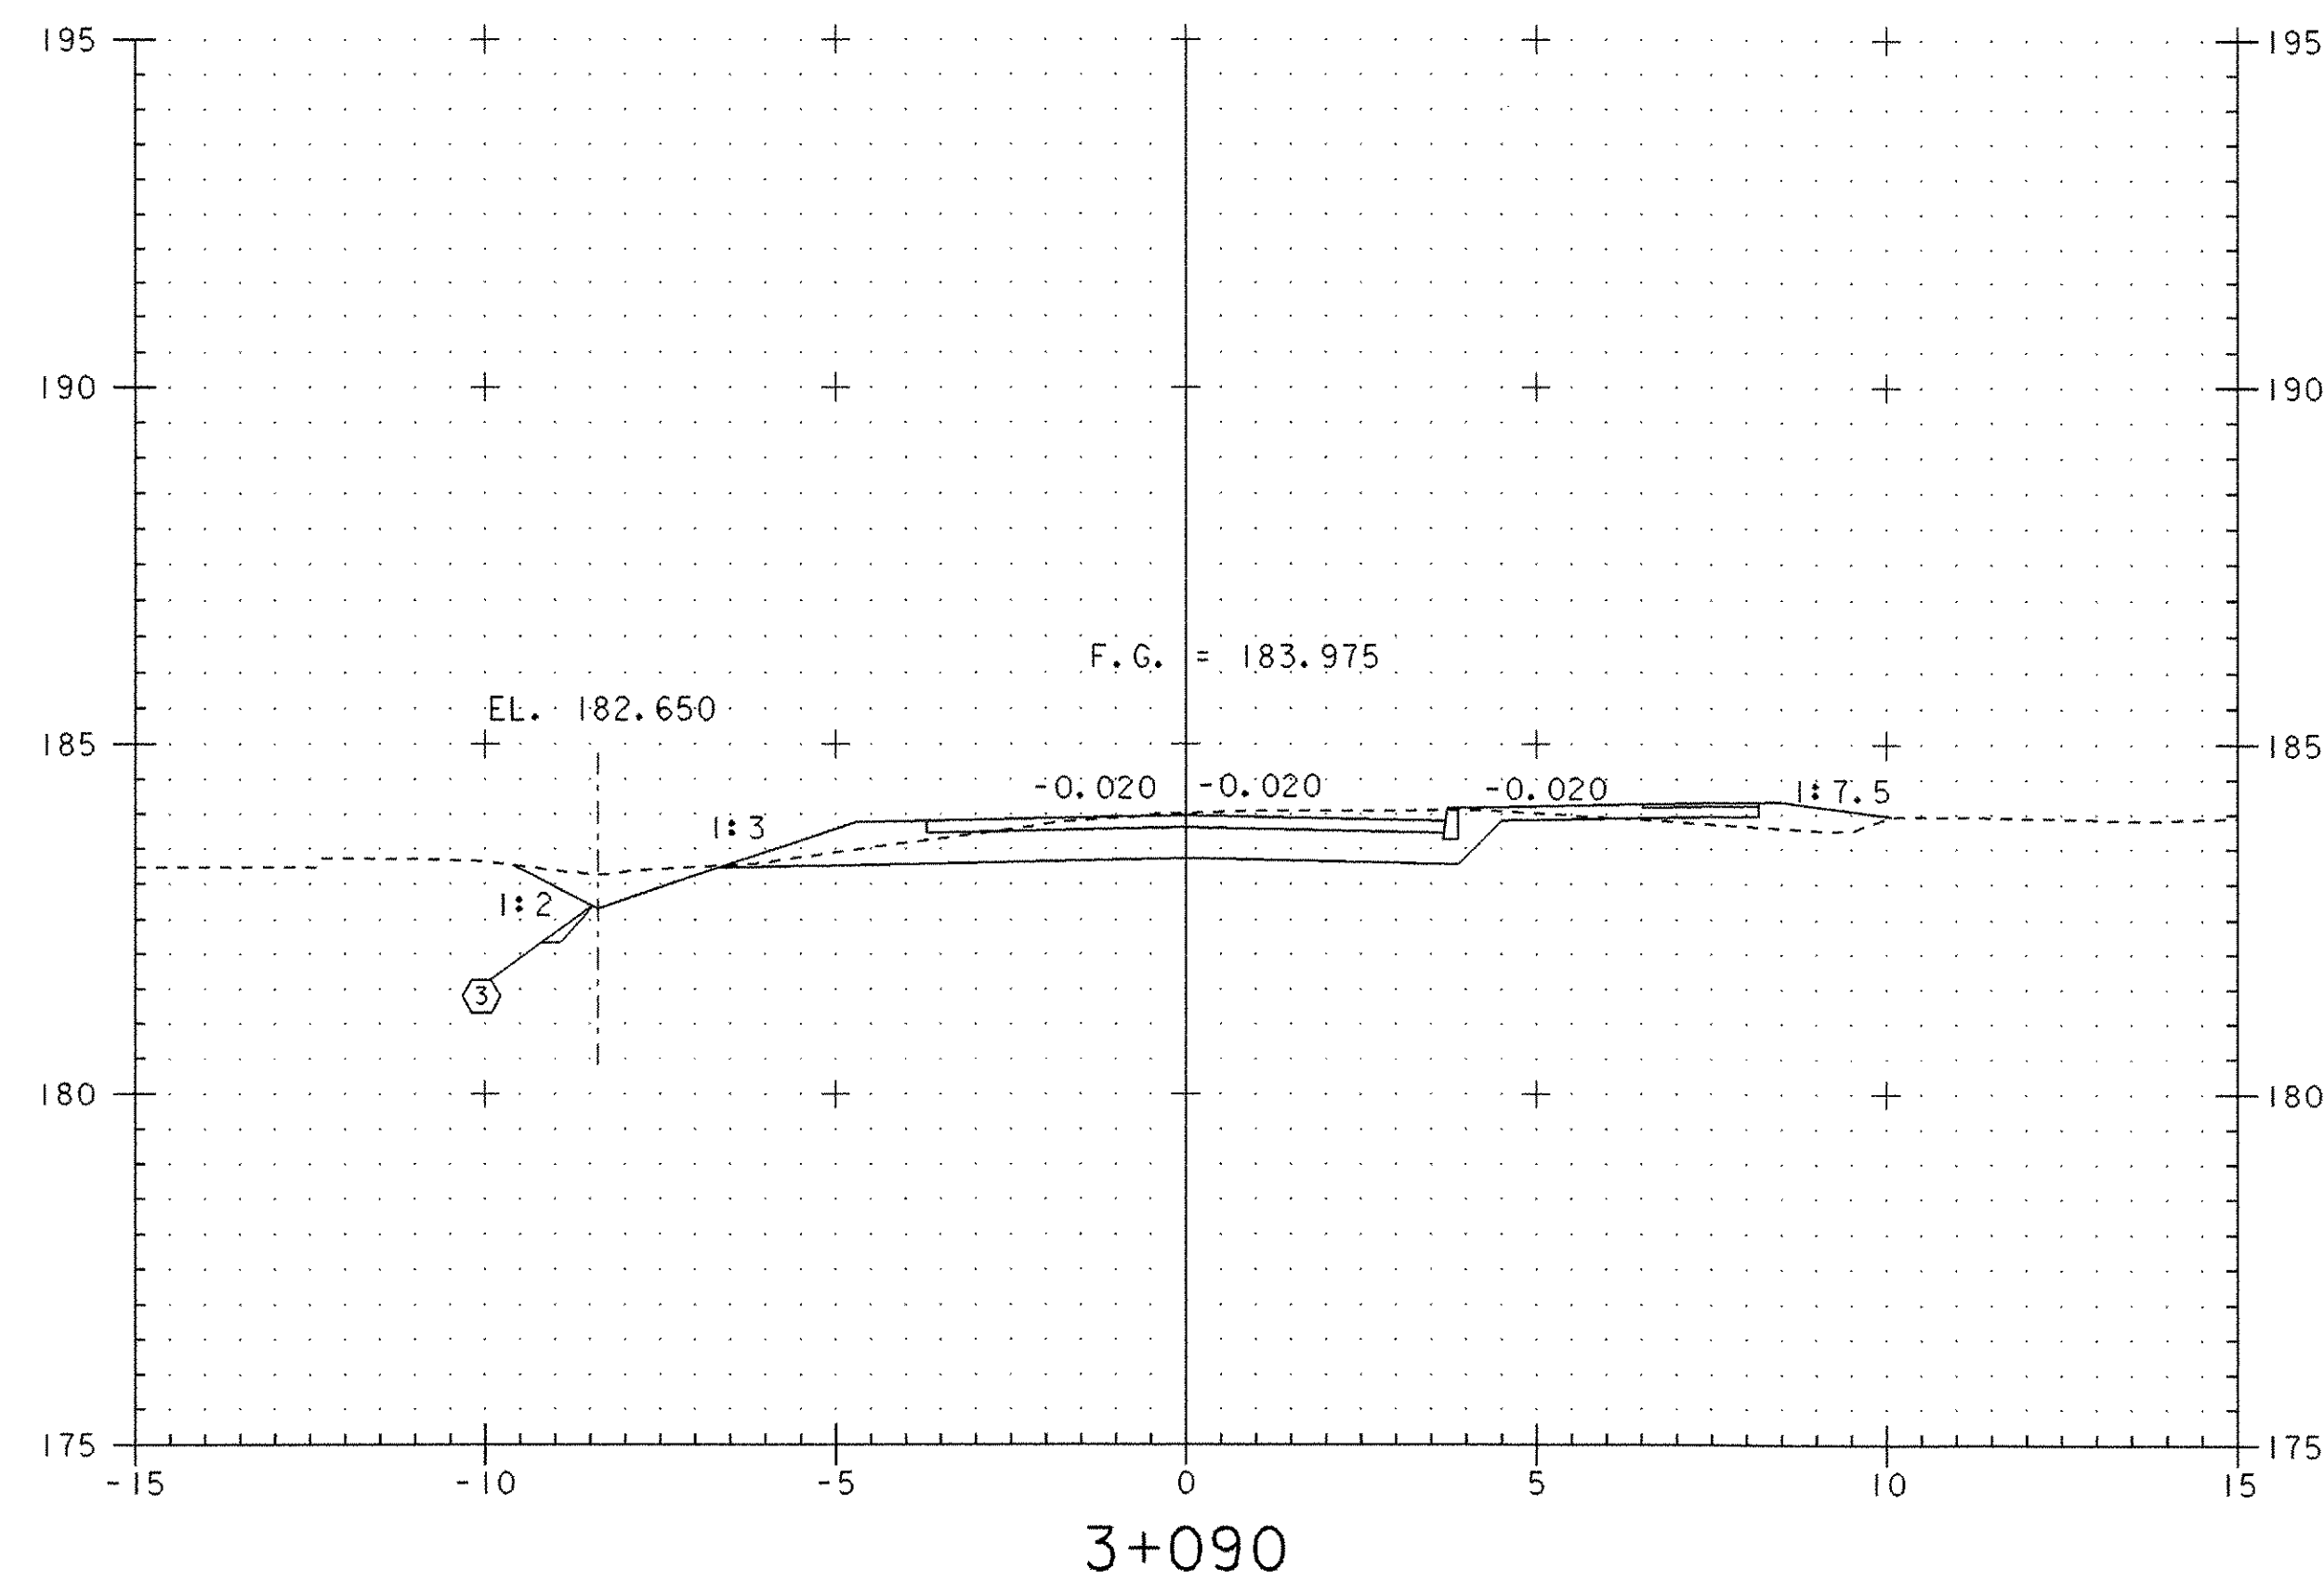


|                                                        |                                    |
|--------------------------------------------------------|------------------------------------|
| PROJECT:<br>BETHEL                                     | PROJECT NO.:<br>BRF 0241 (33) - C1 |
| DESIGN FILE NAME: 96j250/structures/s96j250xsec-cl.dgn | PLOT DATE: 09-JUL-2003             |
| IPARM FILE NAME: s1250xdef3.i                          |                                    |
| TEMPORARY DETOUR CROSS SECTIONS                        |                                    |
| STA 3+080 Thru STA 3+110                               | SHEET: 34 OF 47                    |





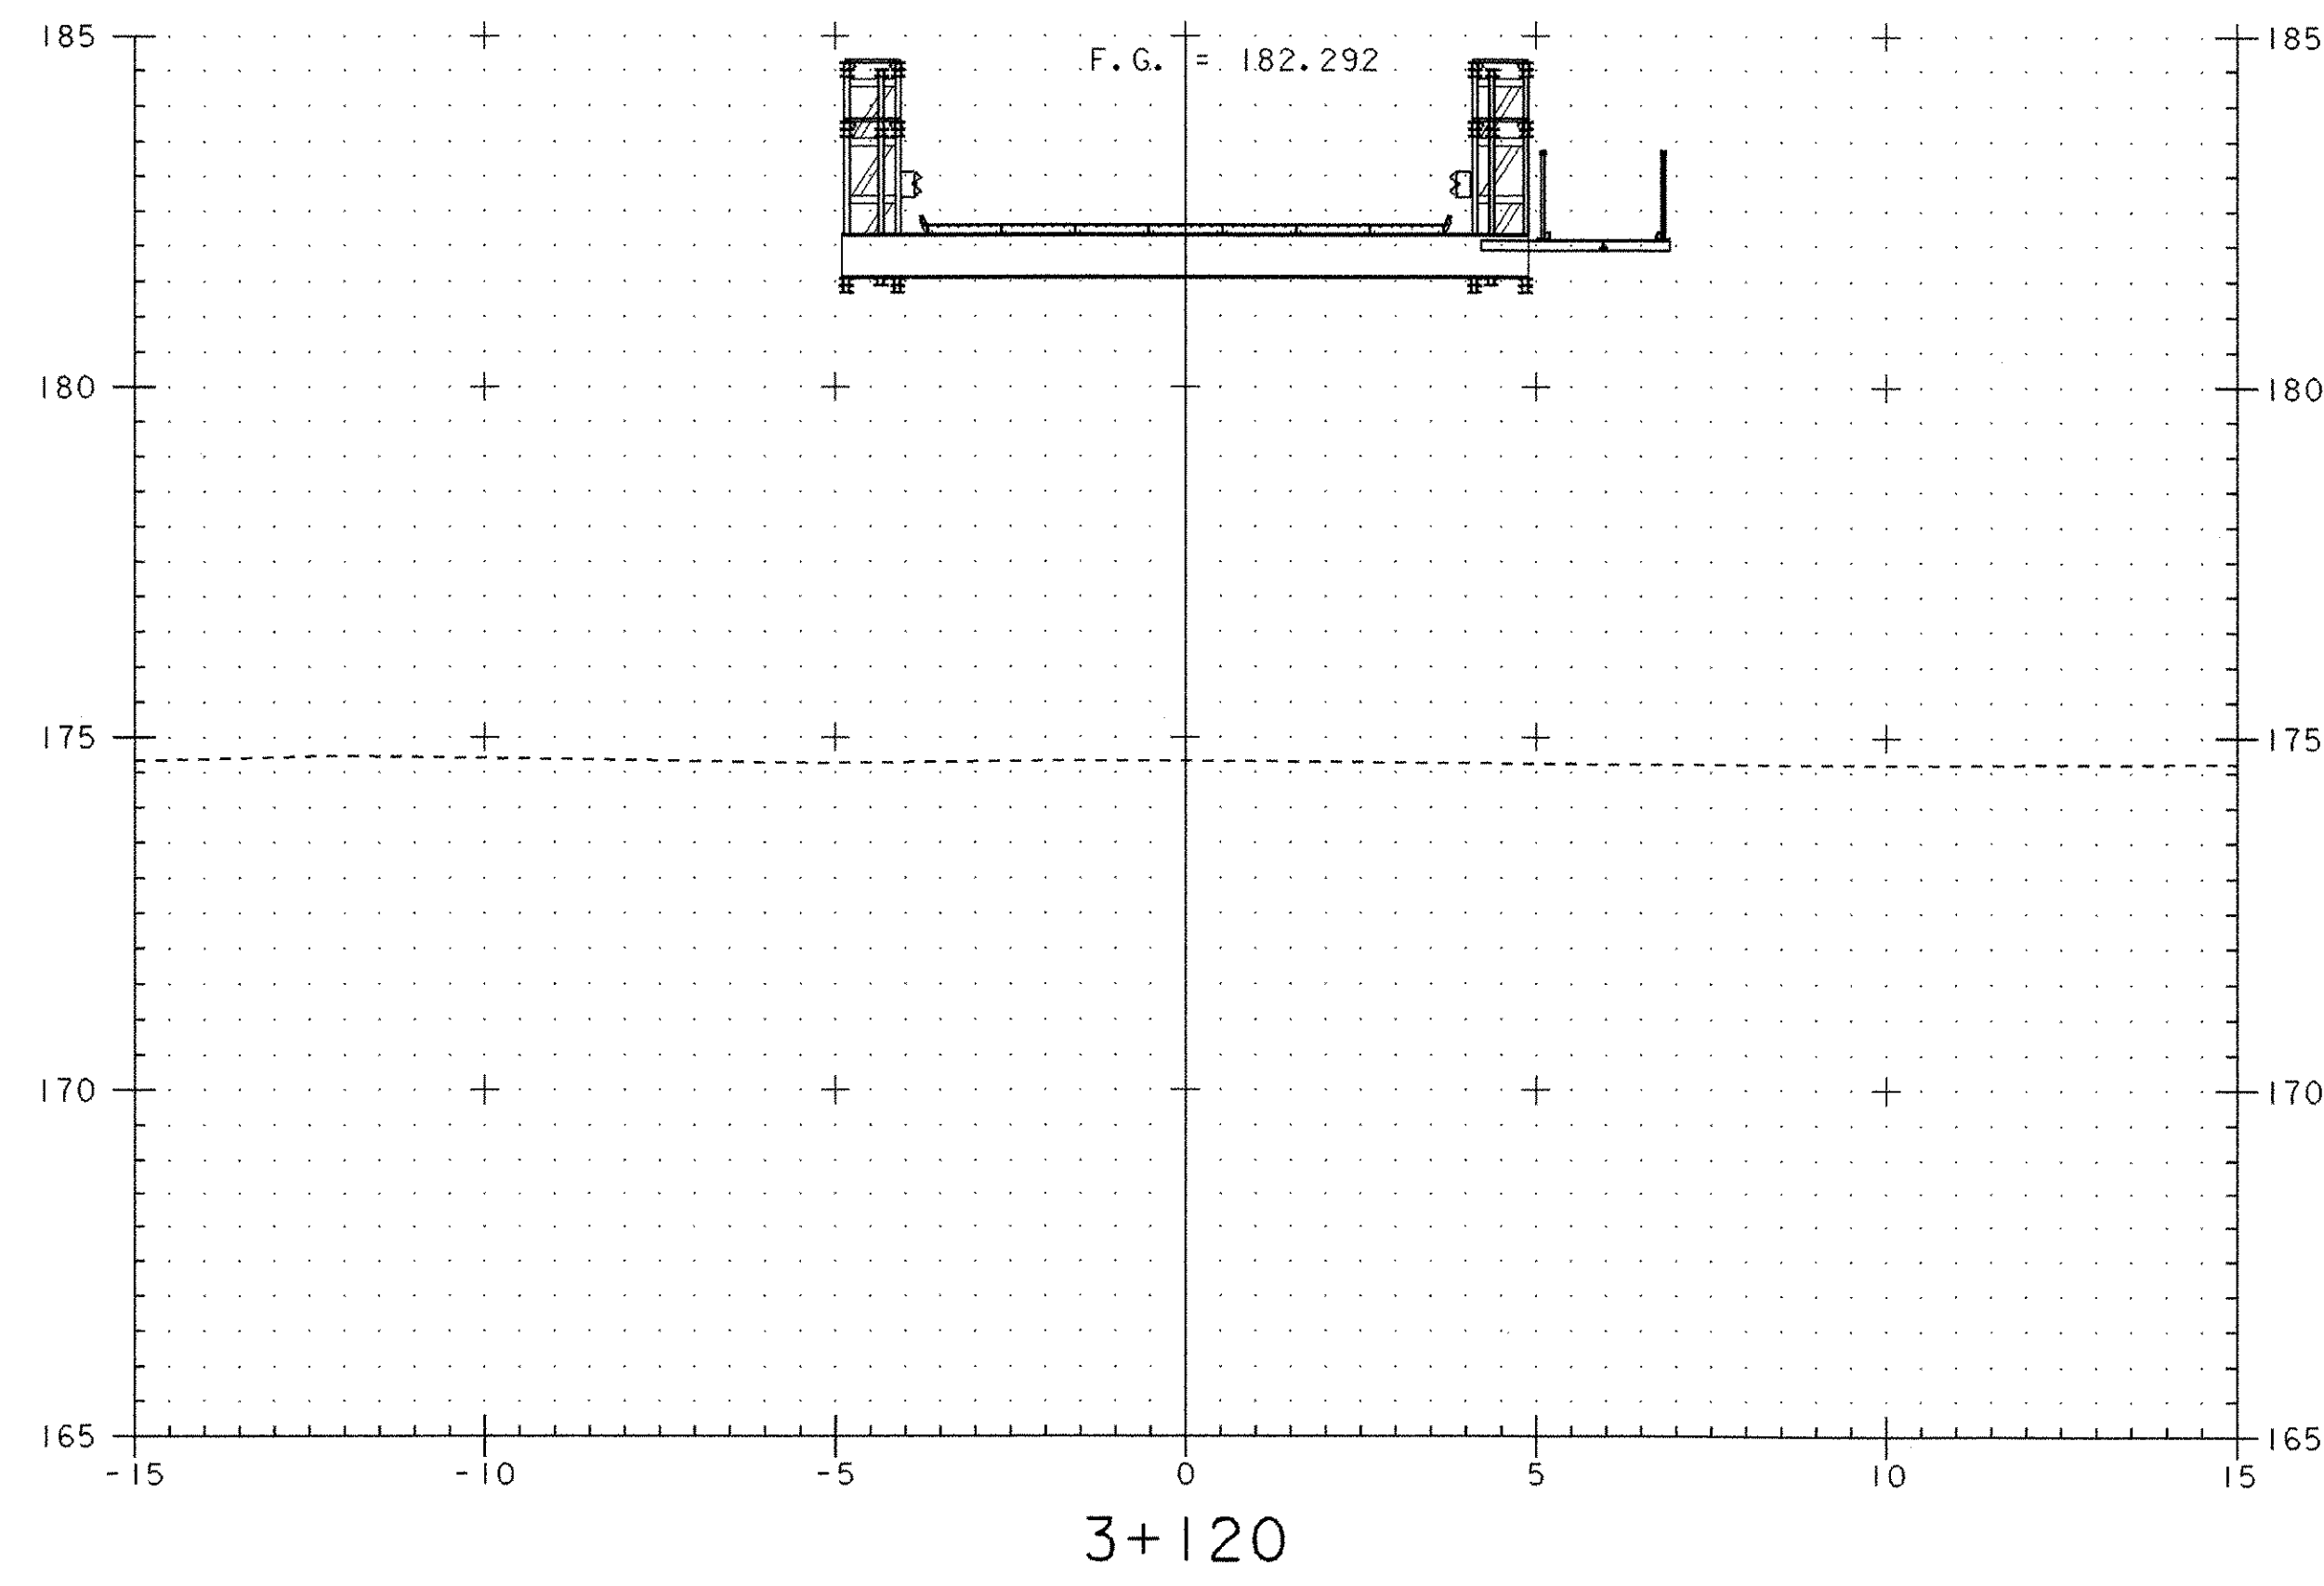
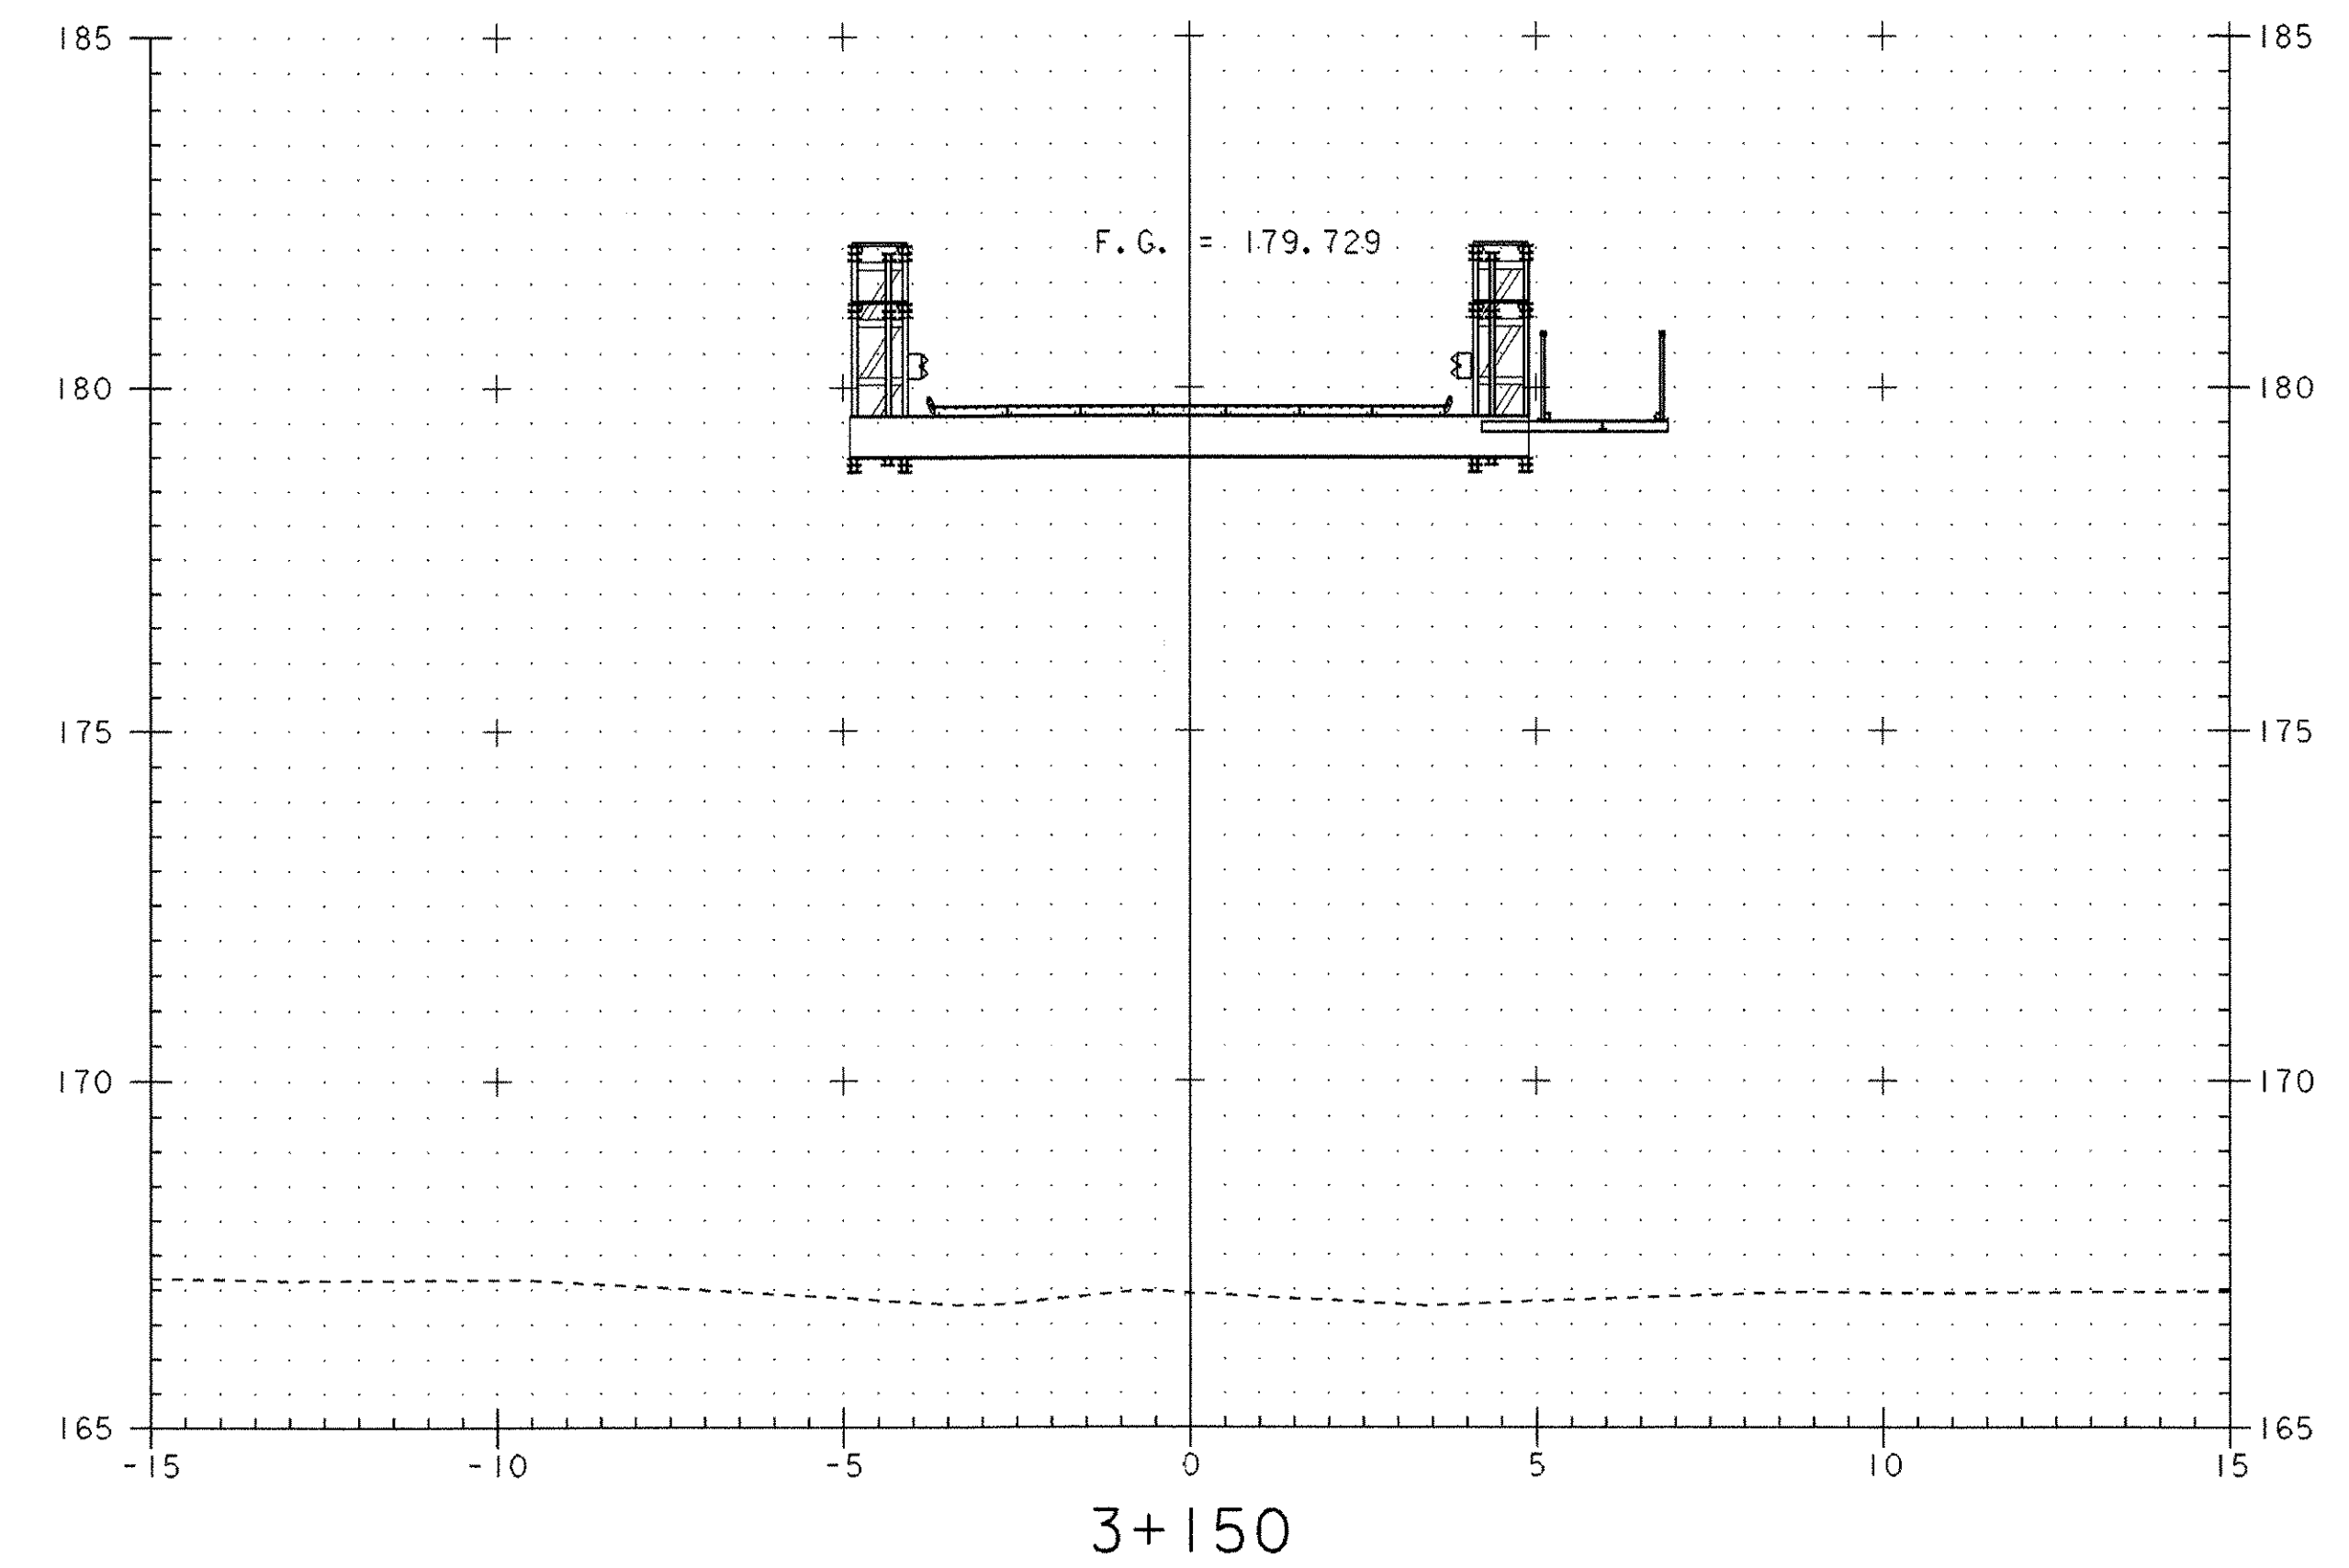
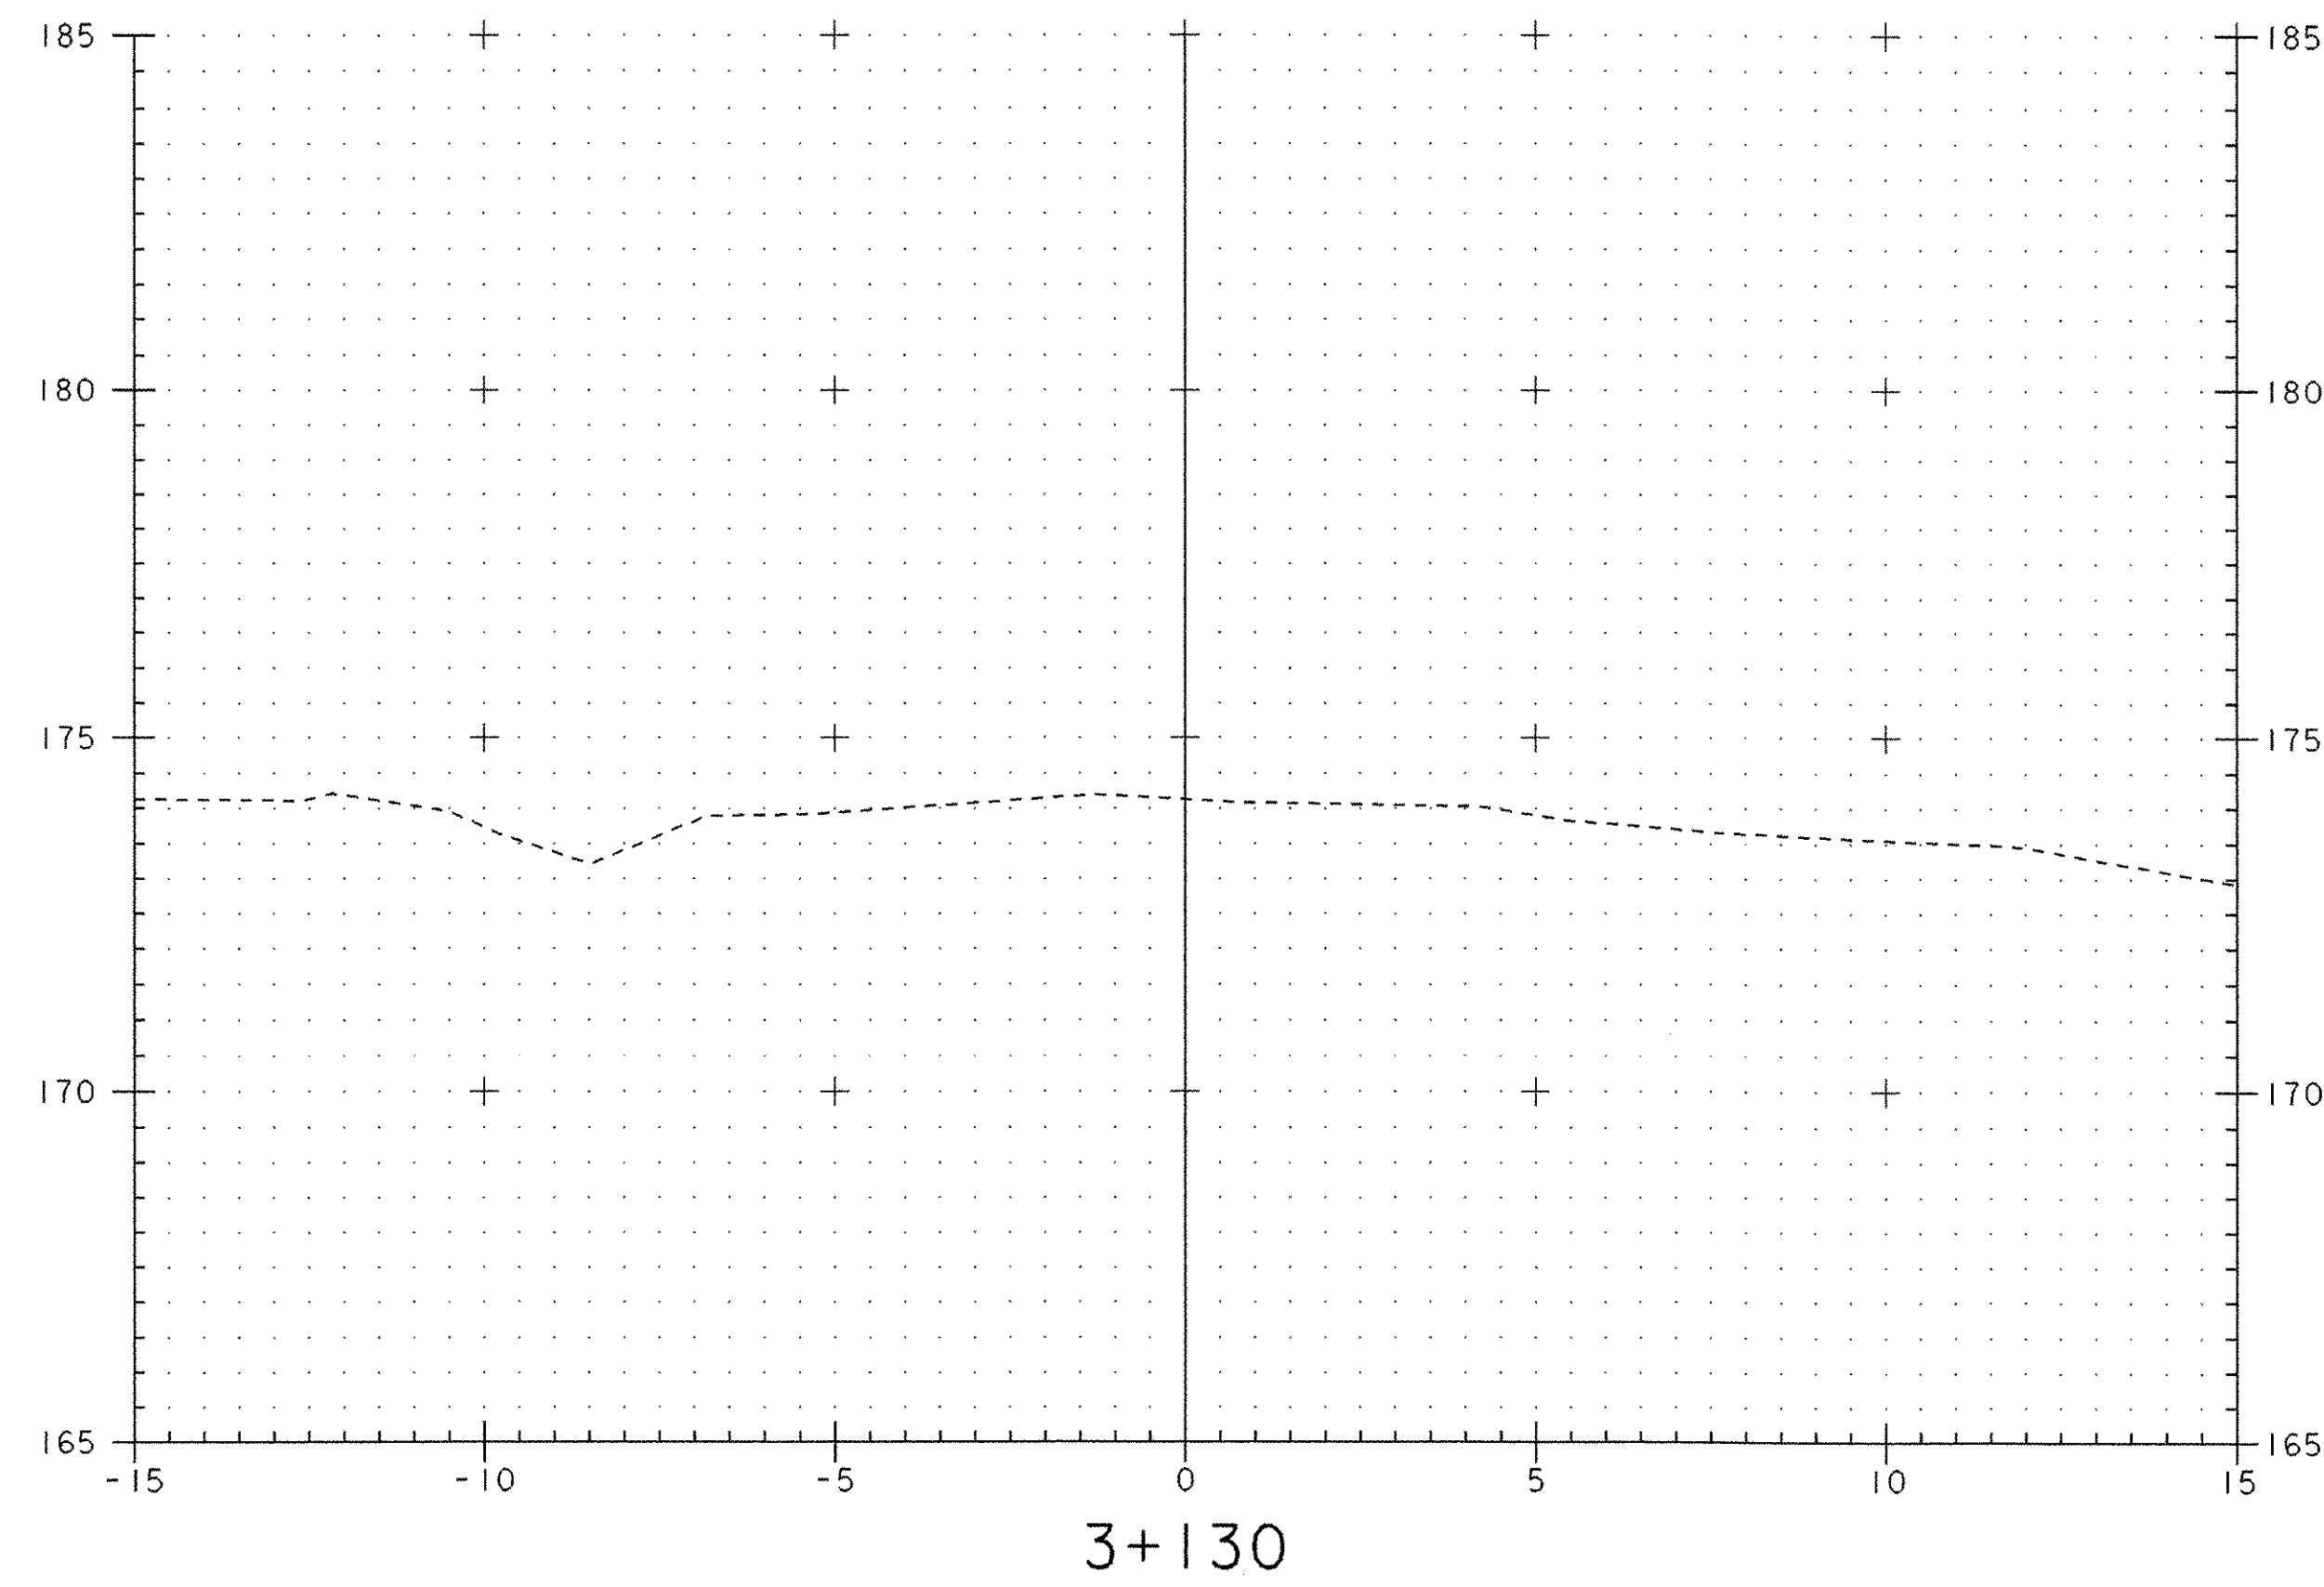


Begin Bridge  
Sta 3+111.000

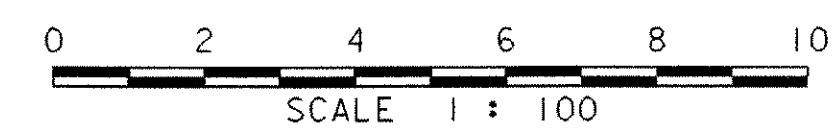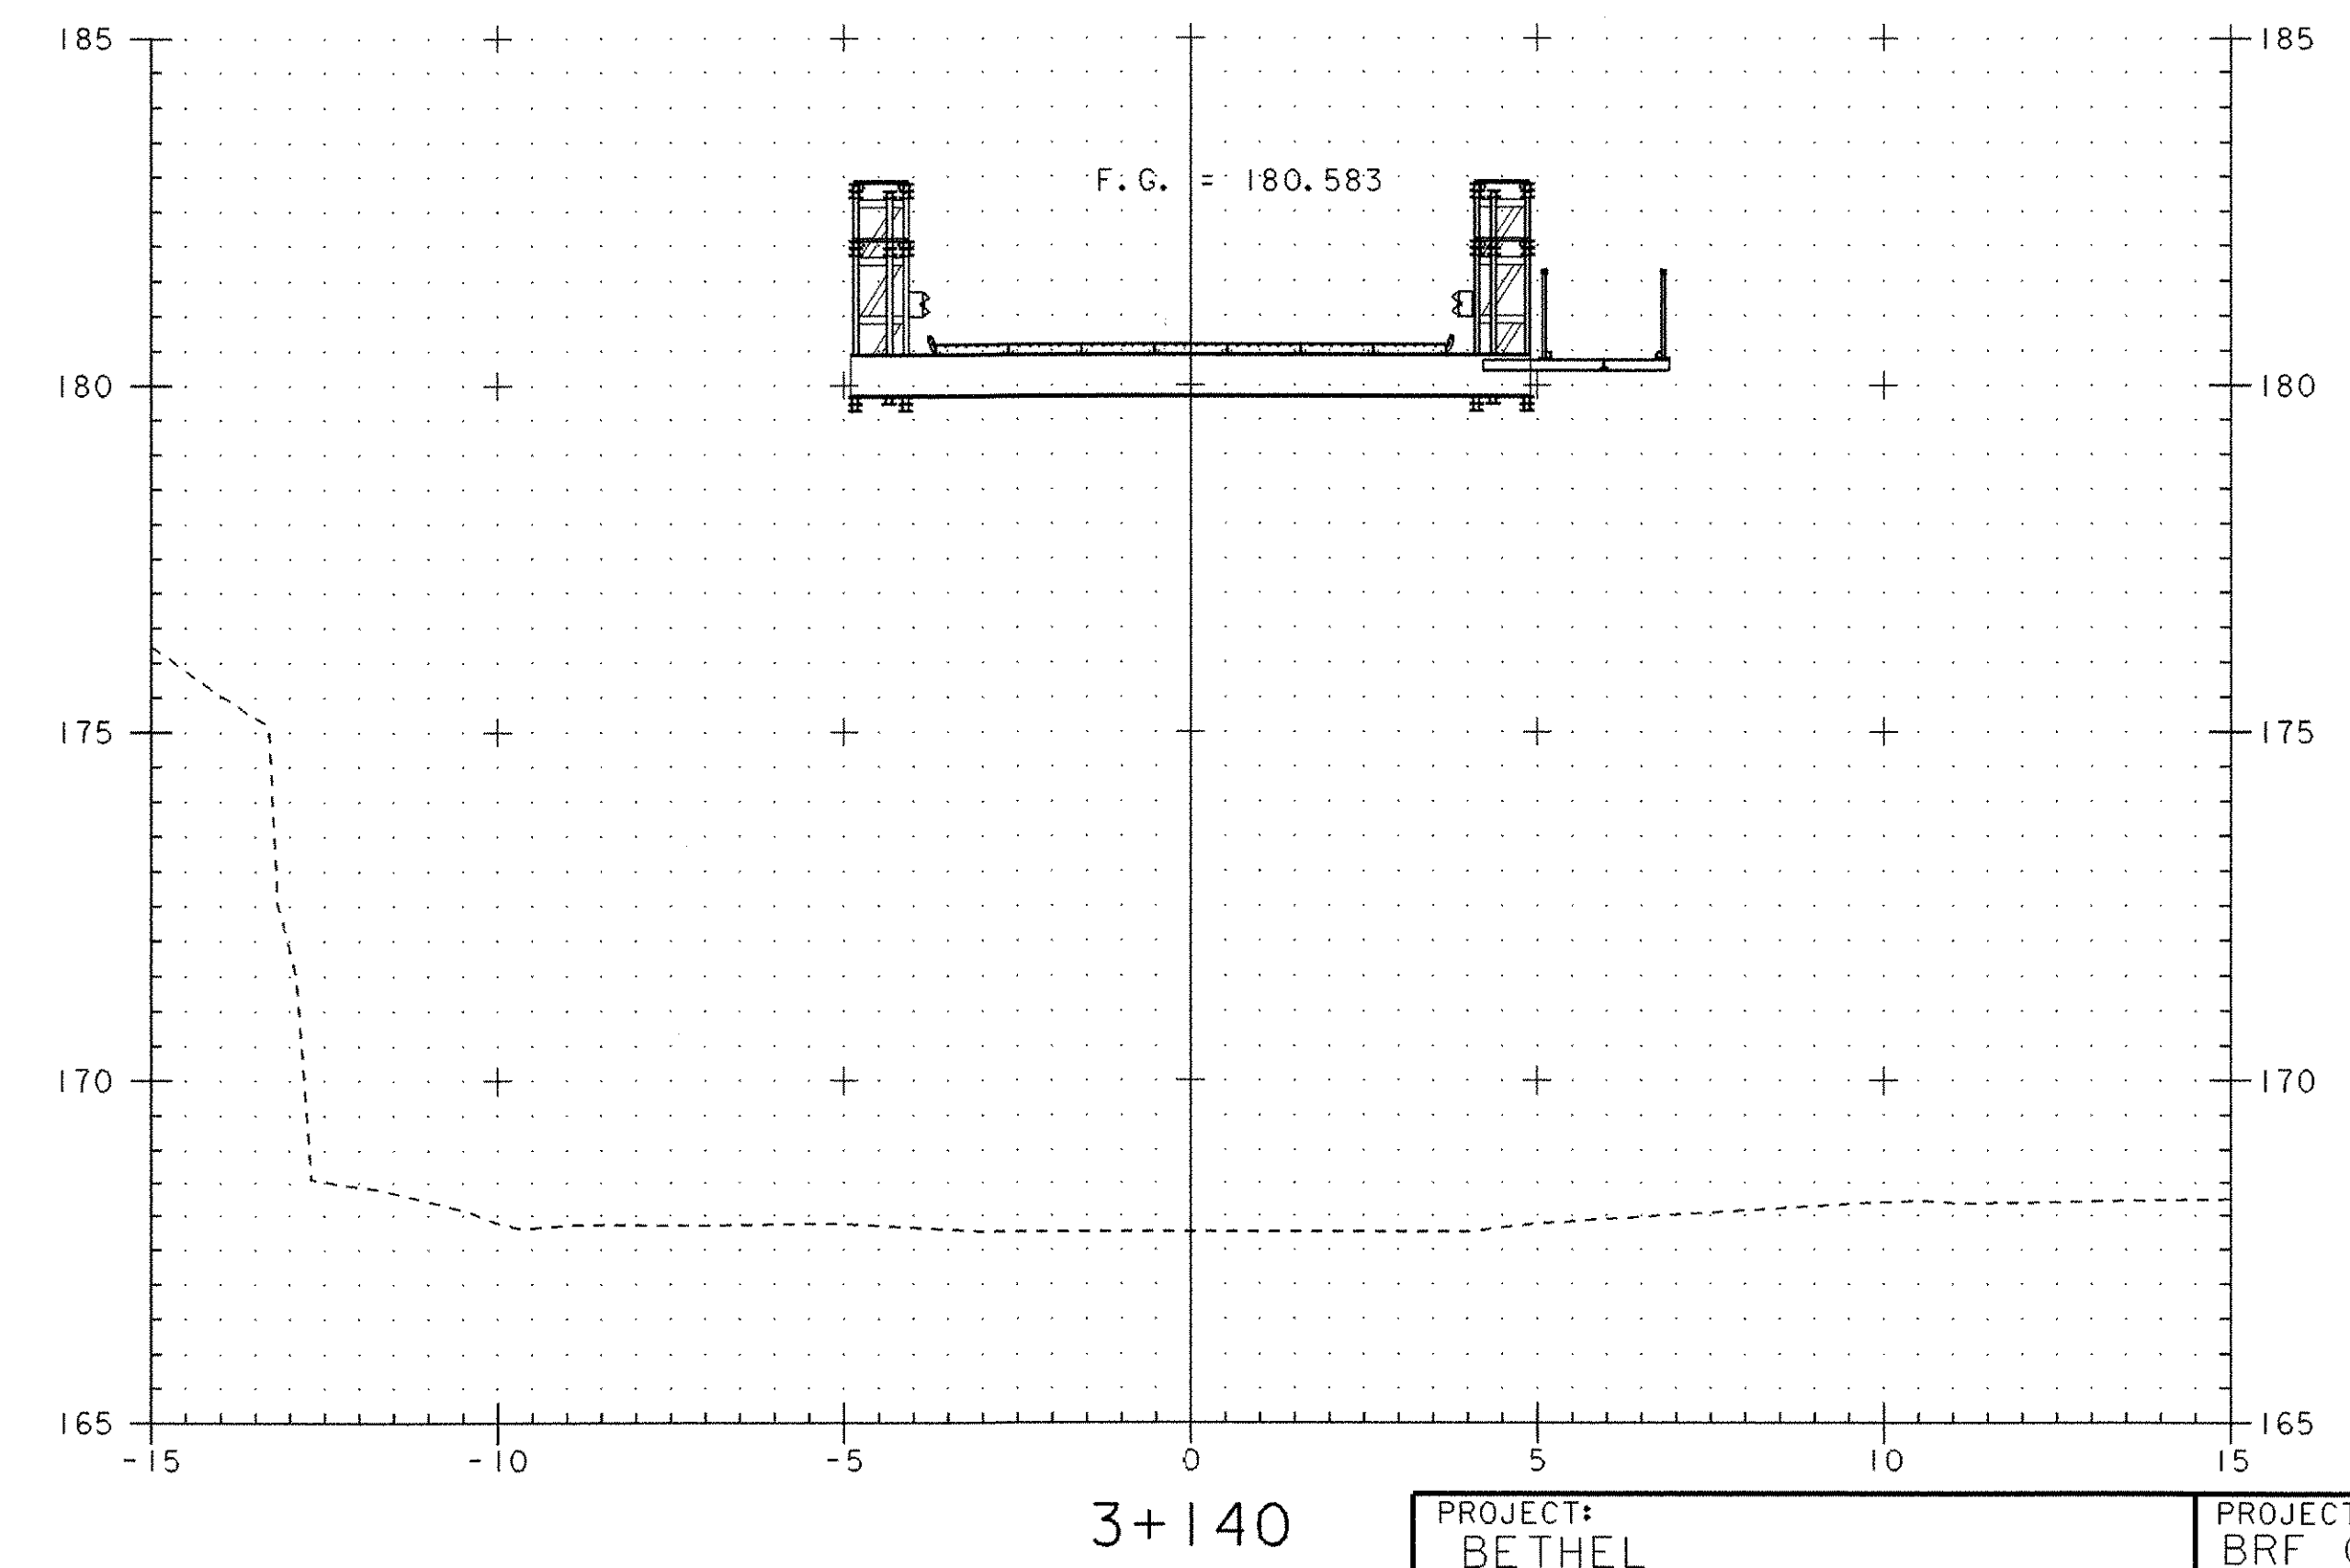






|                                 |                                      |                  |                    |
|---------------------------------|--------------------------------------|------------------|--------------------|
| PROJECT:                        | BETHEL                               | PROJECT NO. :    | BRF 0241 (33) - C1 |
| DESIGN FILE NAME:               | 96j250/structures/s96j250xsec-cl.dgn | IPARM FILE NAME: | s1250xdet4.i       |
| TEMPORARY DETOUR CROSS SECTIONS | STA 3+120 Thru STA 3+150             | PLOT DATE:       | 09-JUL-2003        |
|                                 |                                      | SHEET:           | 35 OF 47           |



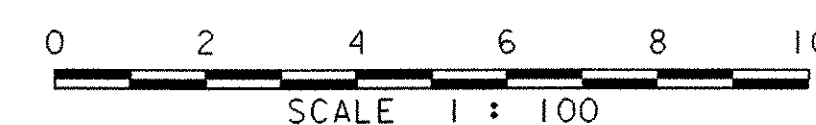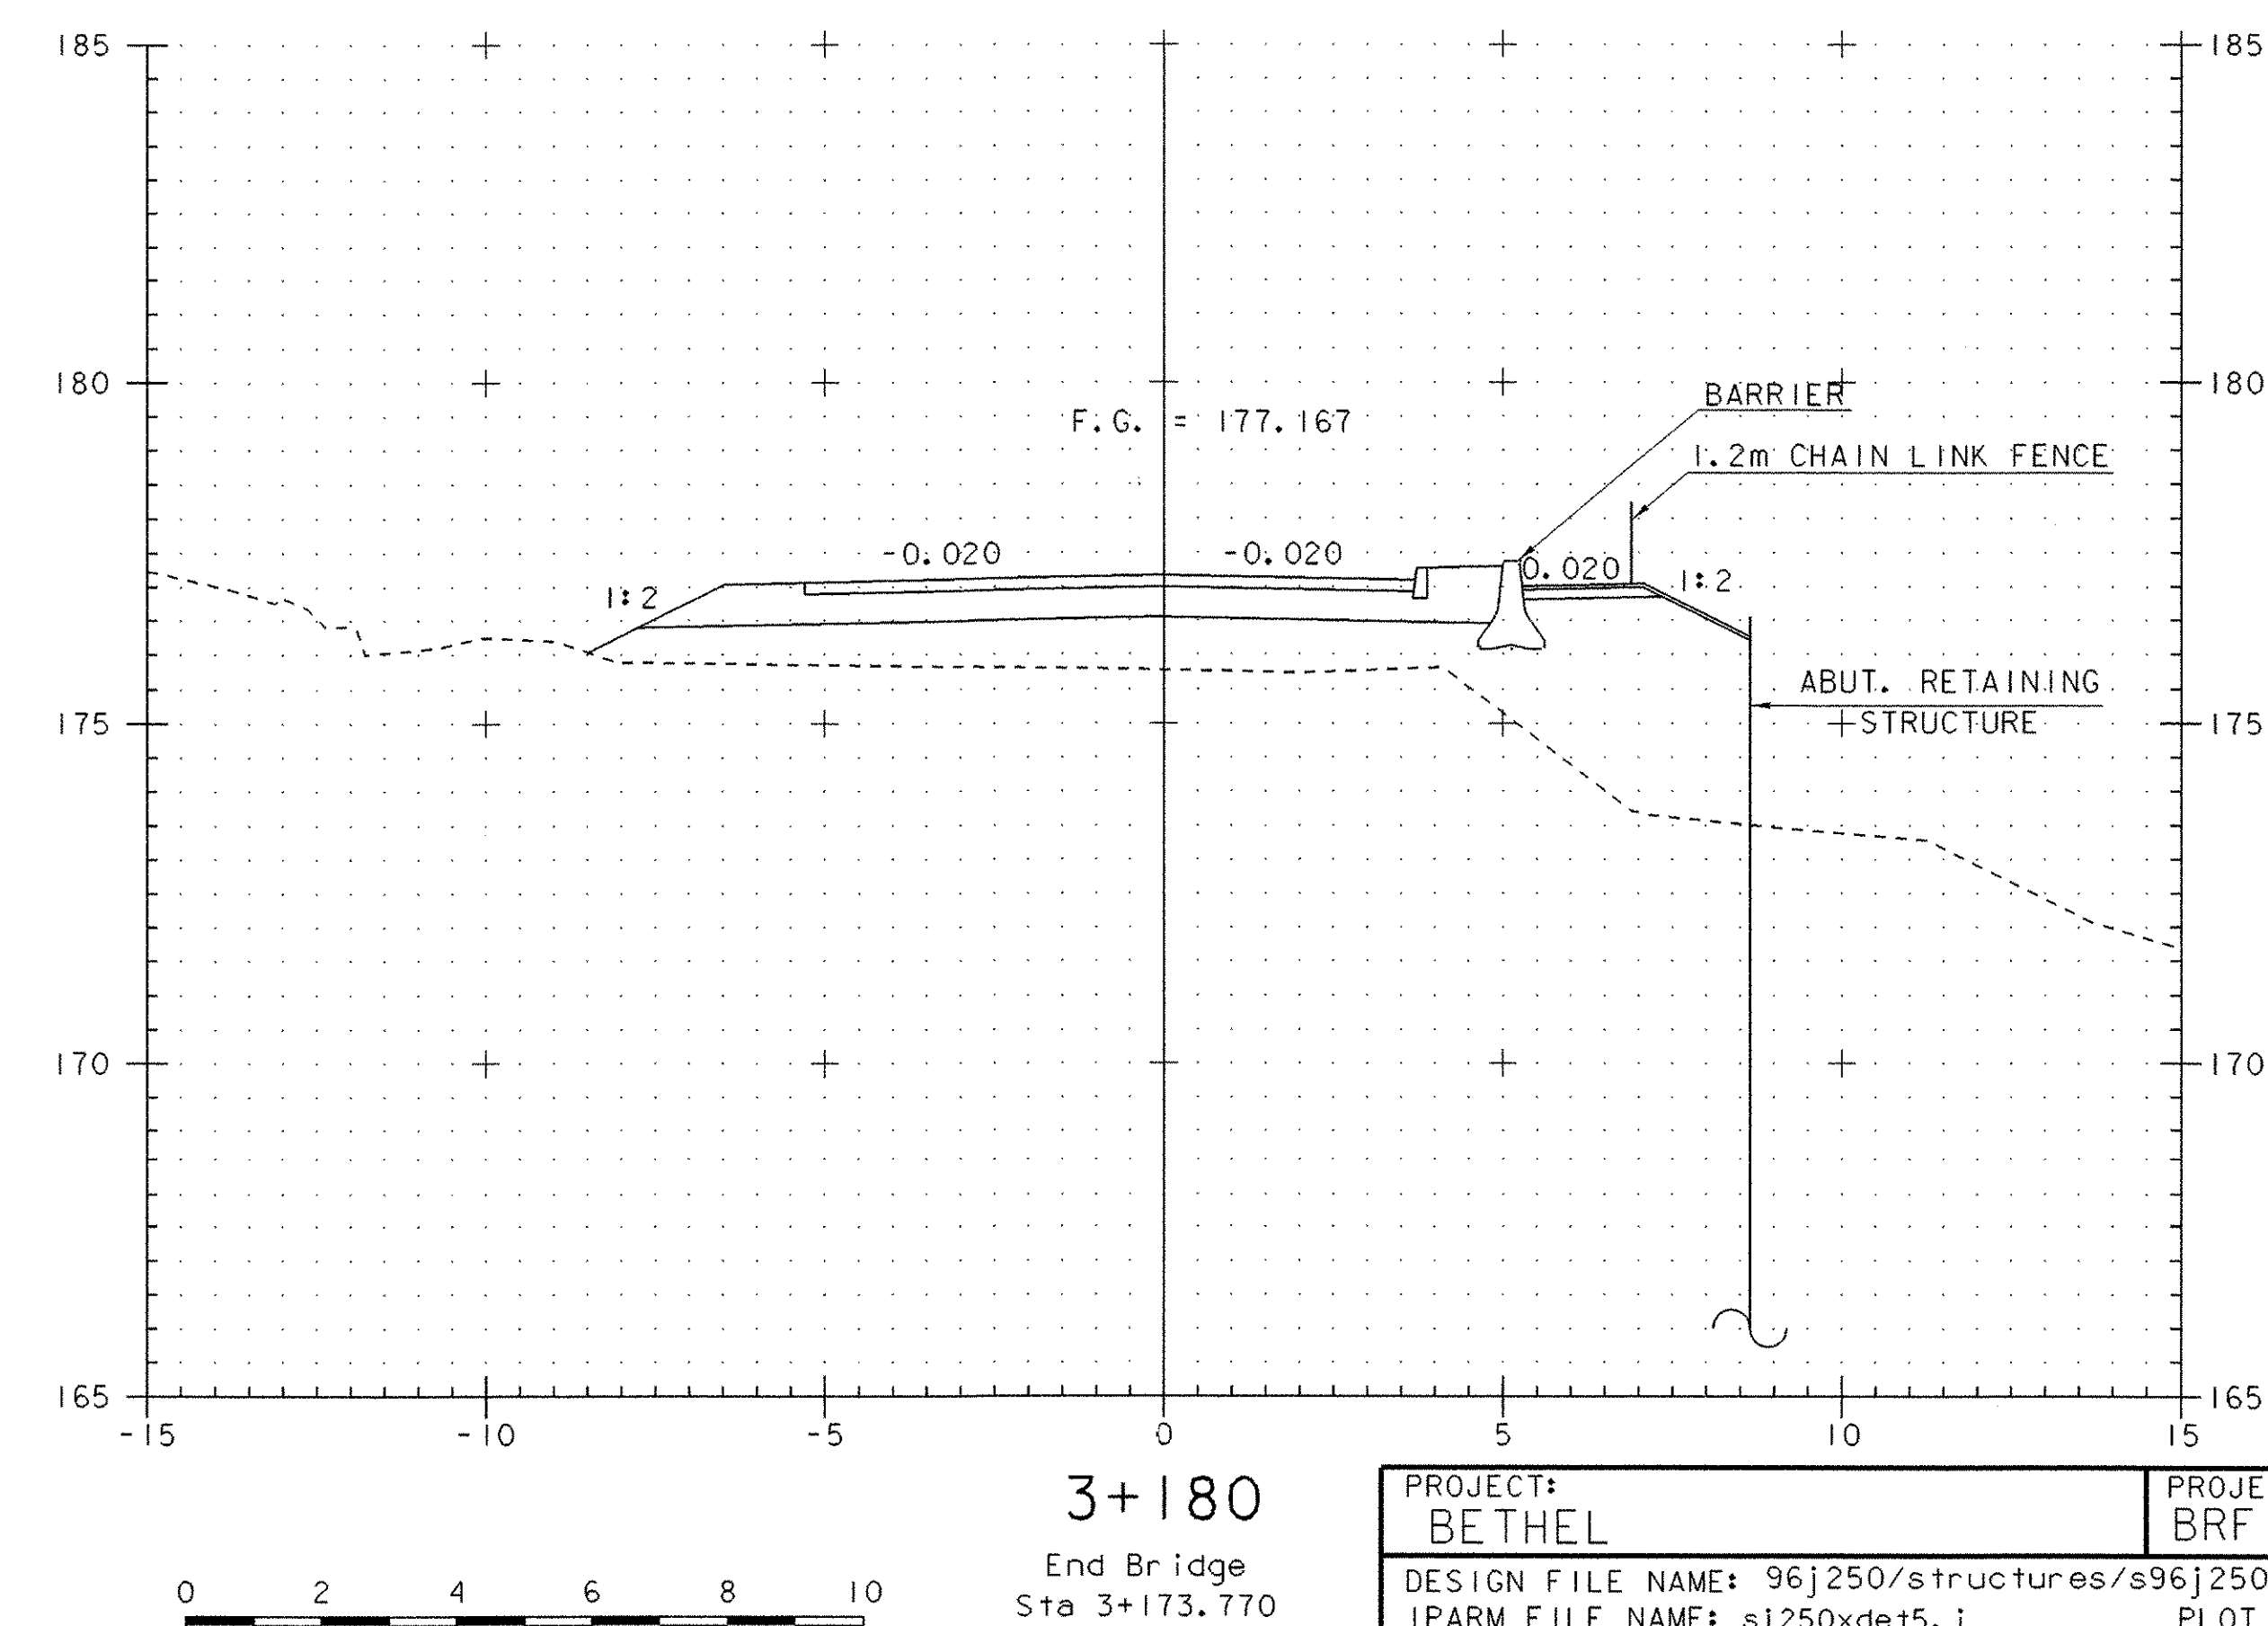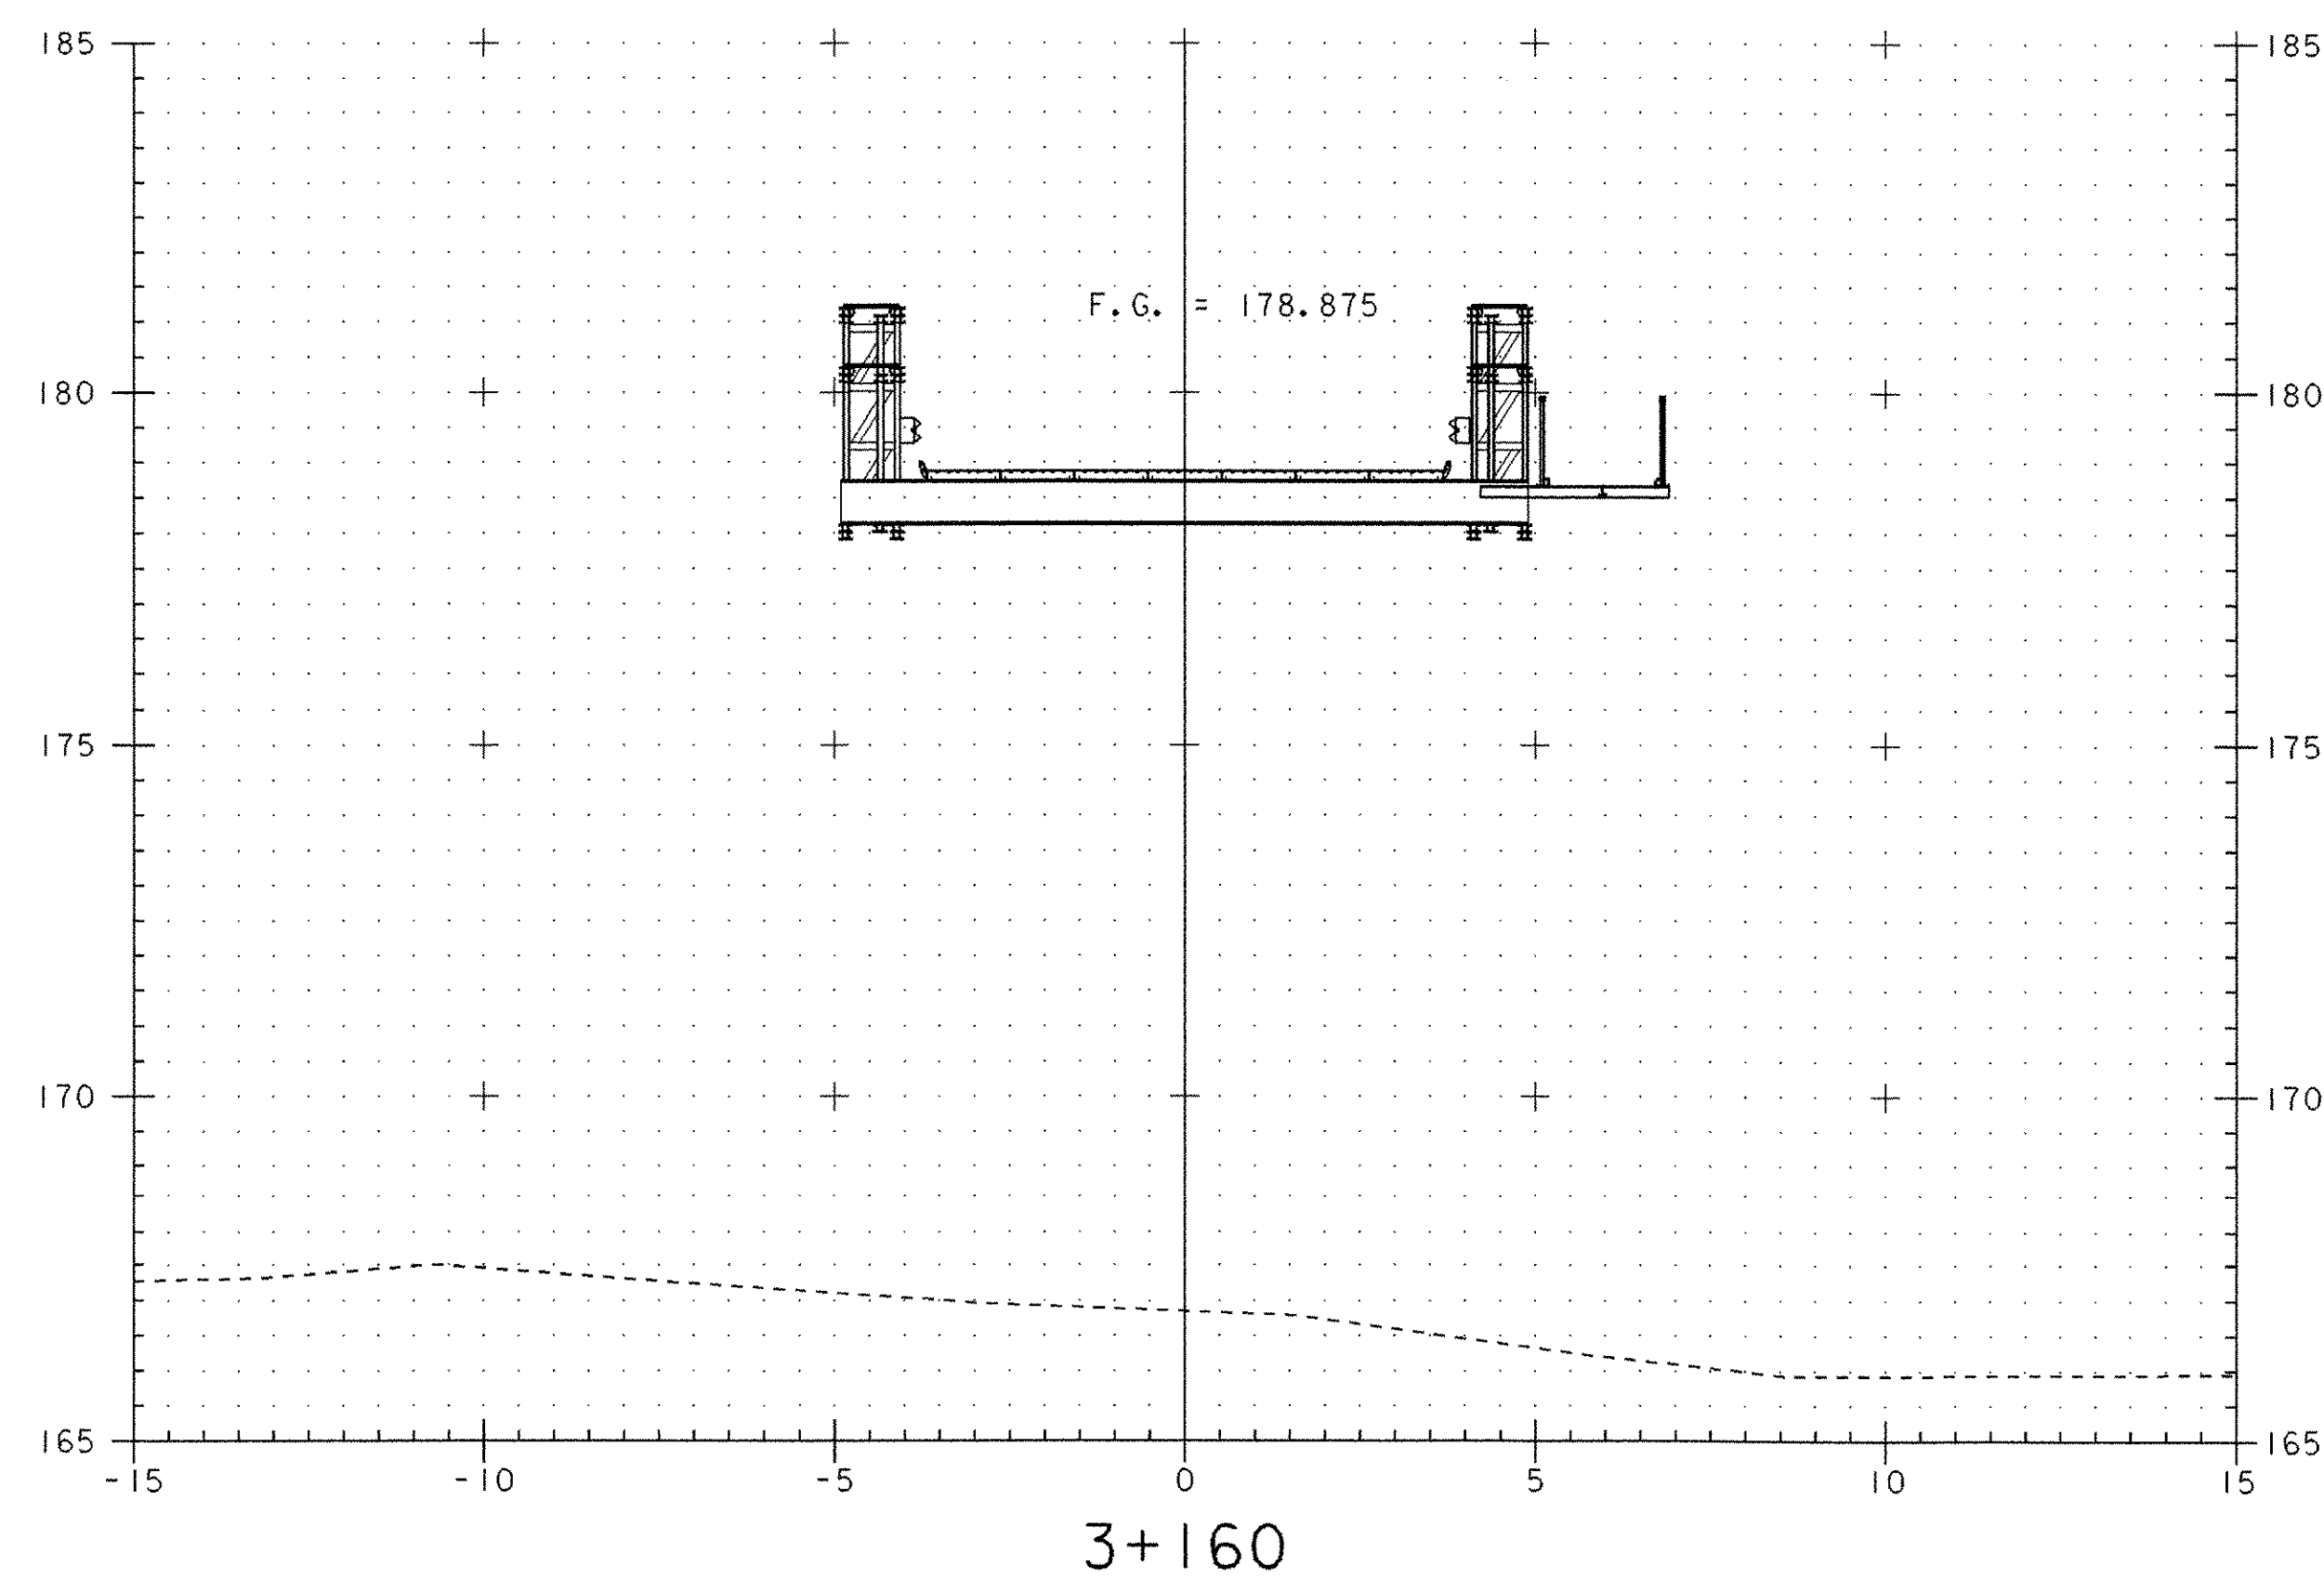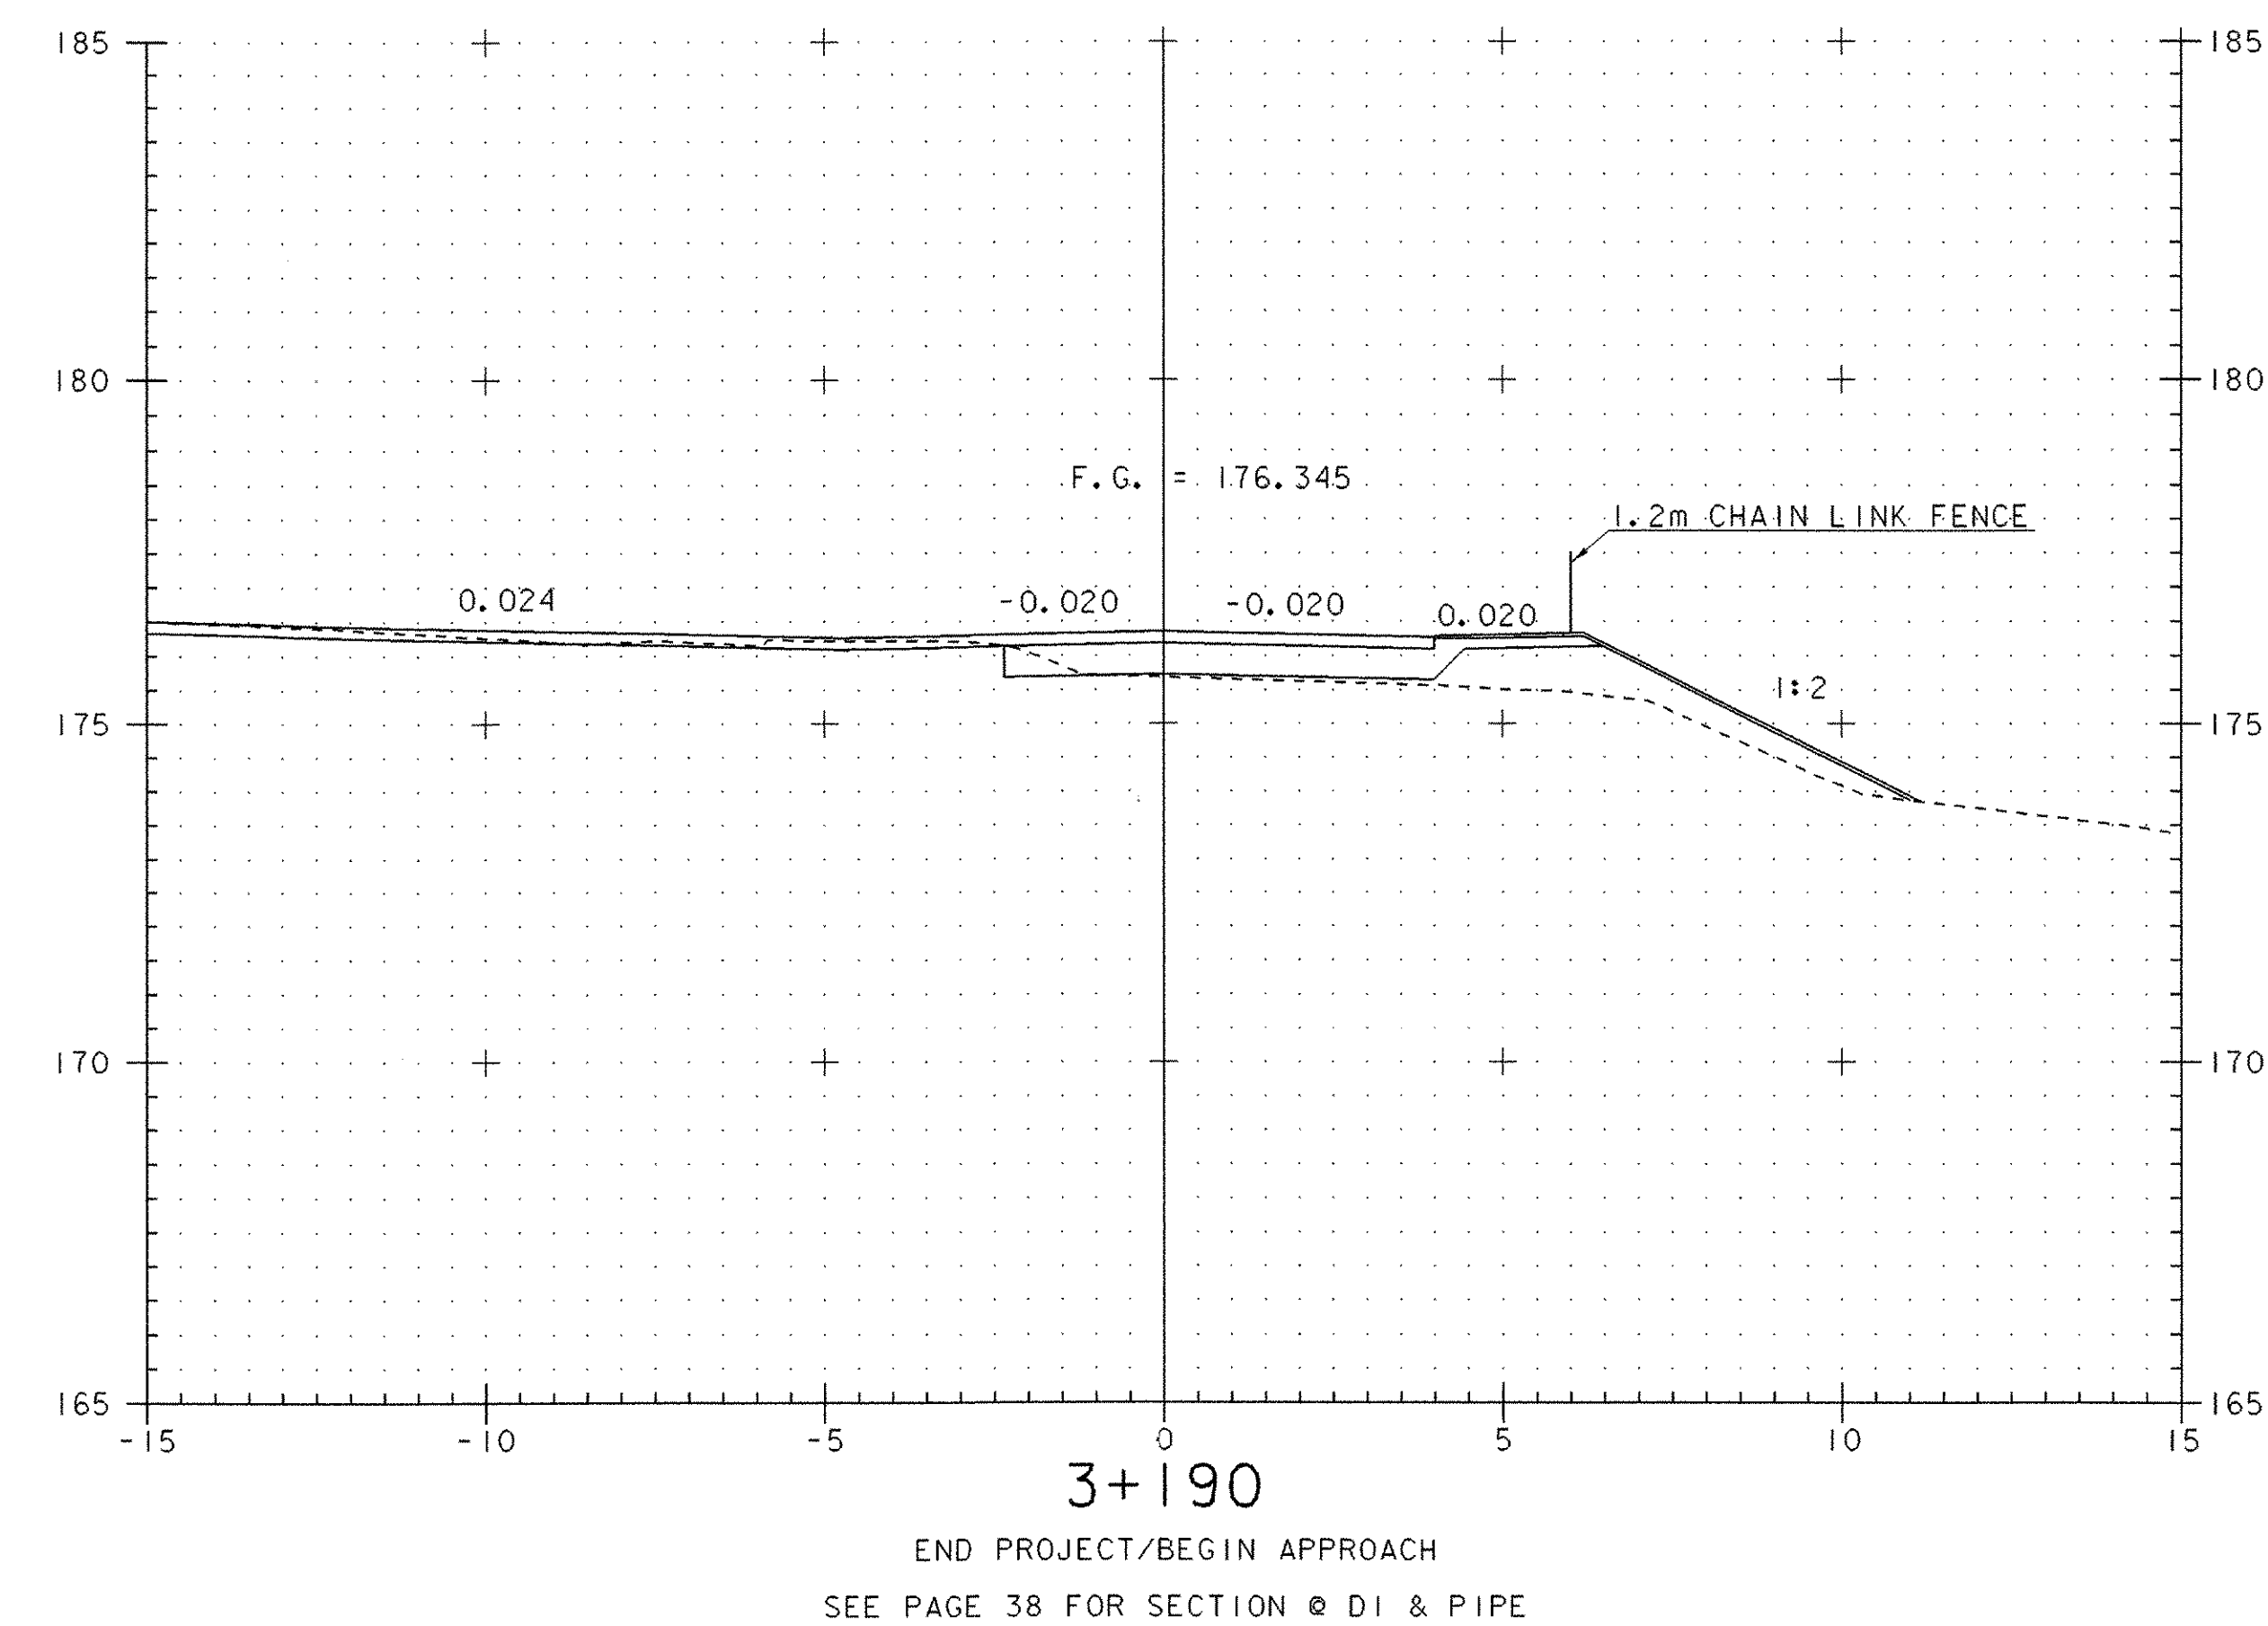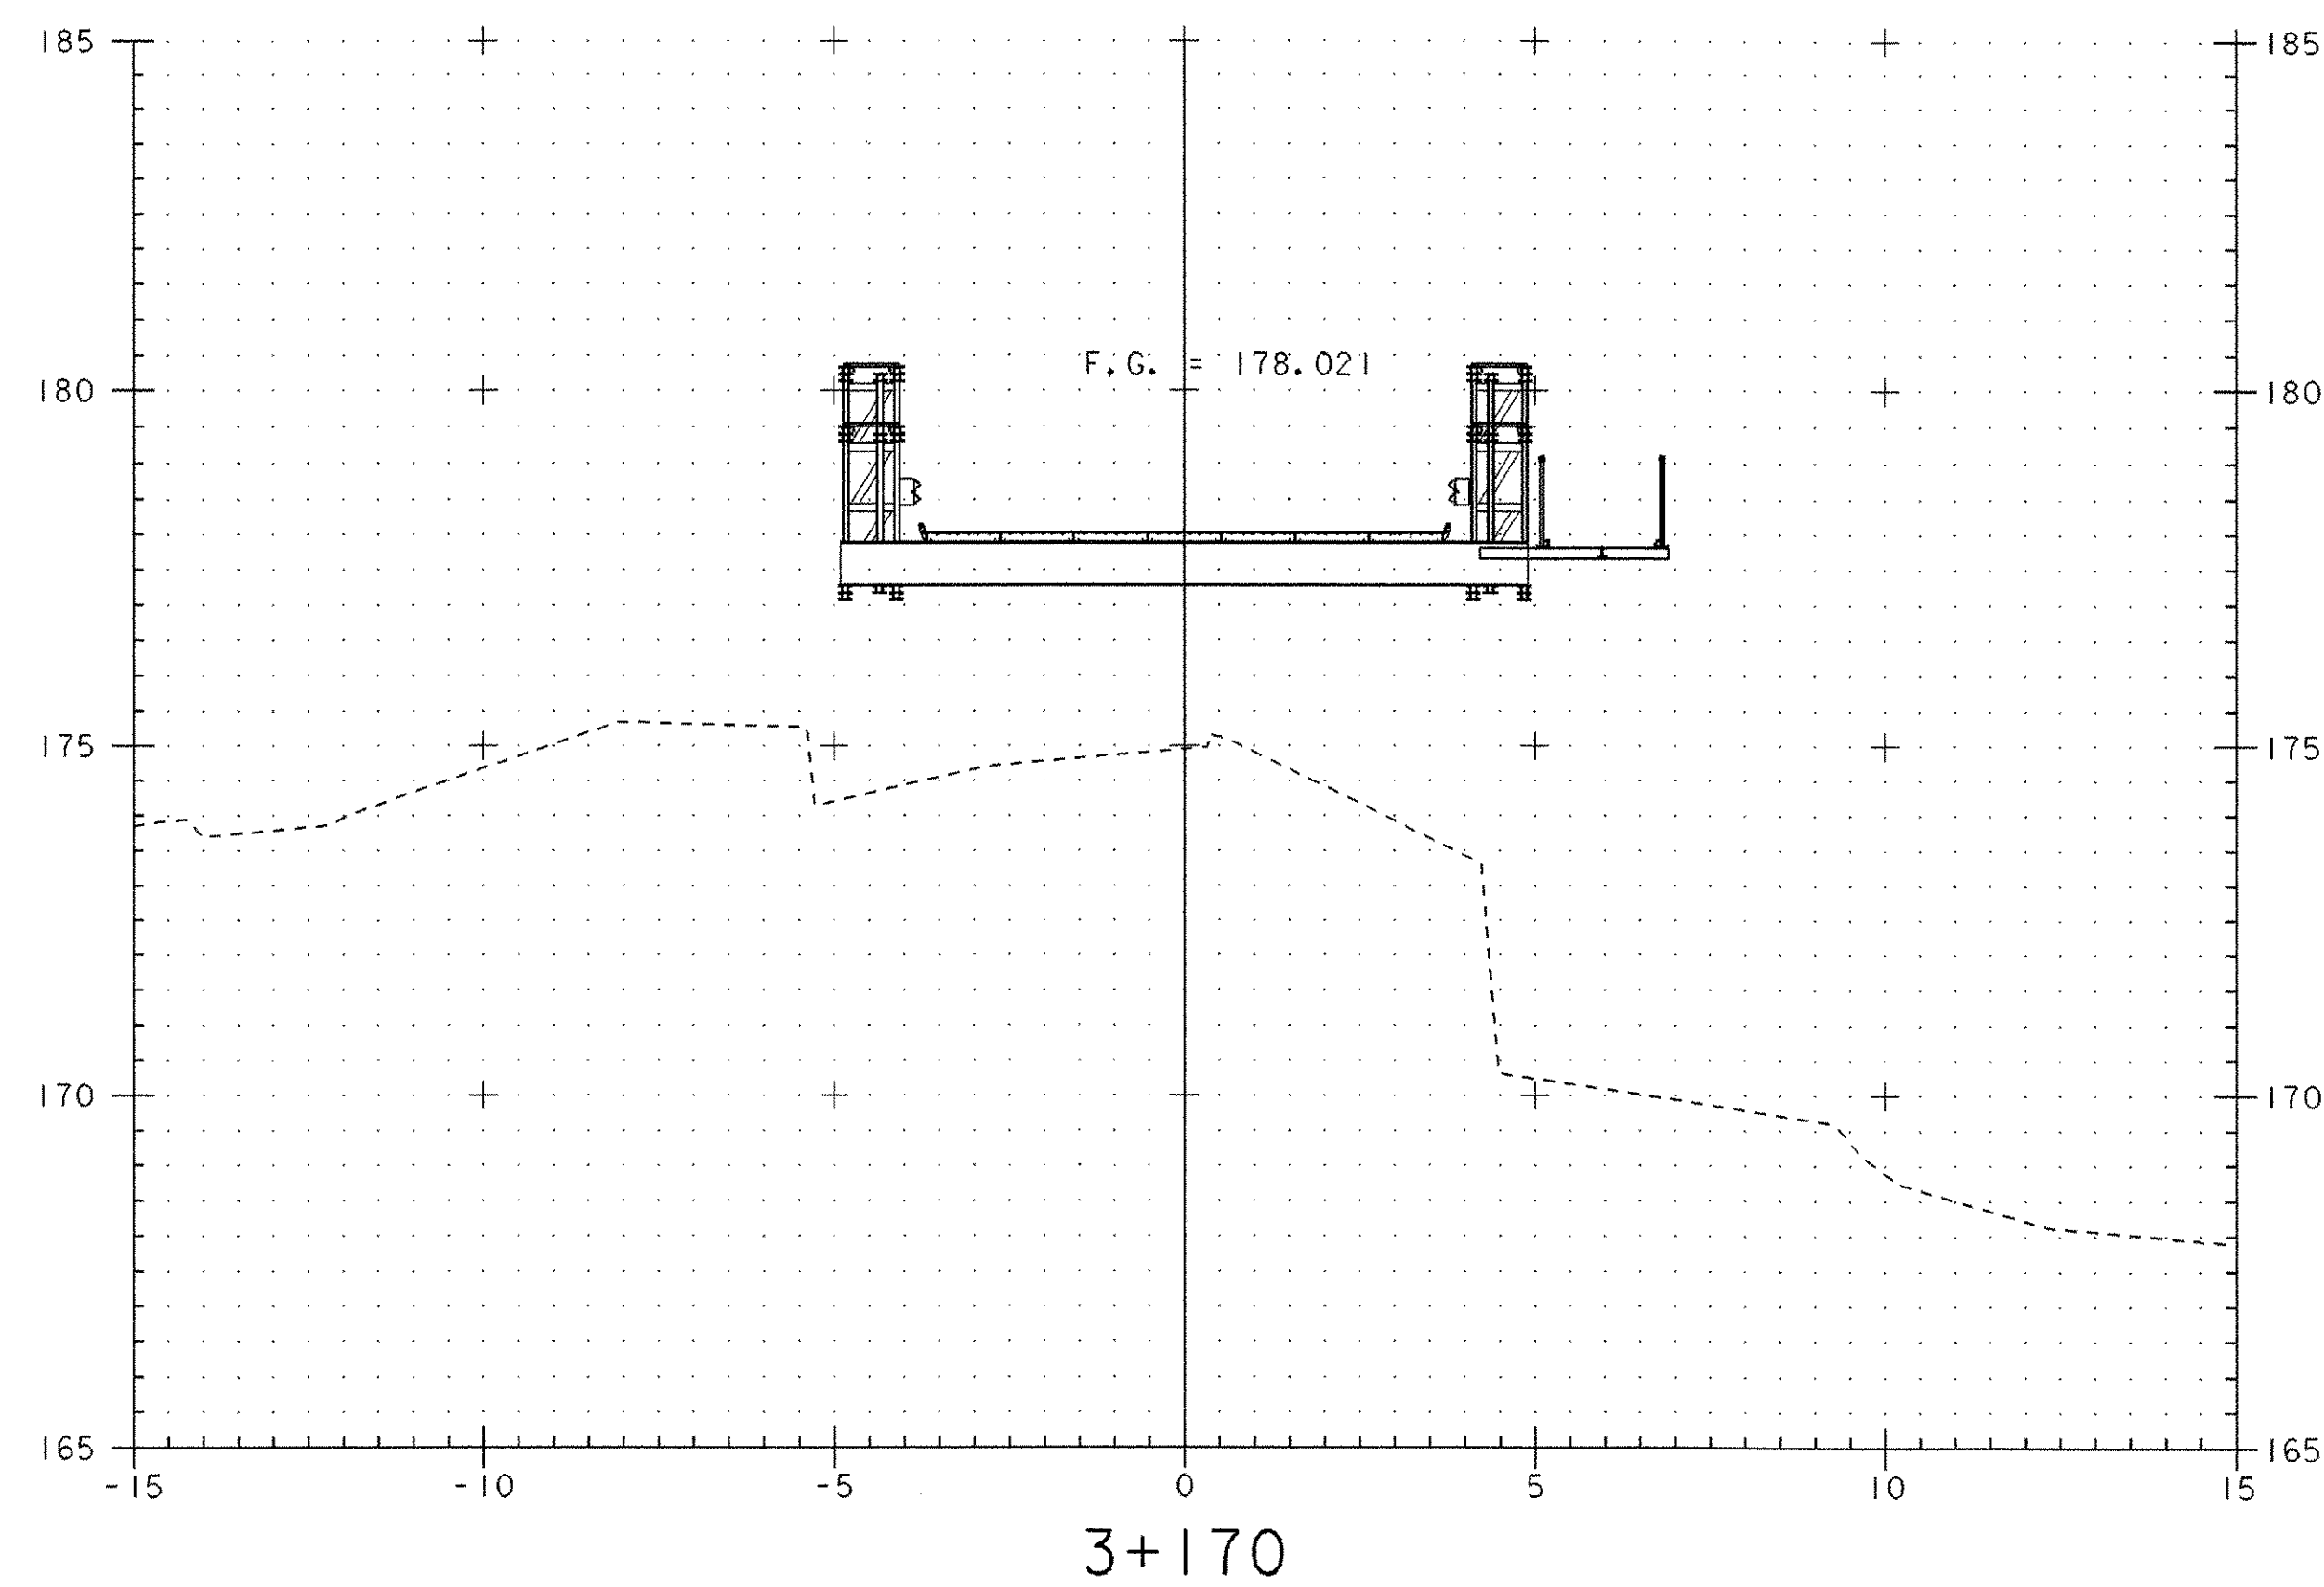

|                                                        |                                     |
|--------------------------------------------------------|-------------------------------------|
| PROJECT:<br>BETHEL                                     | PROJECT NO. :<br>BRF 0241 (33) - C1 |
| DESIGN FILE NAME: 96j250/structures/s96j250xsec-cl.dgn |                                     |
| IPARM FILE NAME: s1250xdet5.i                          | PLOT DATE: 09-JUL-2003              |
| TEMPORARY DETOUR CROSS SECTIONS                        |                                     |
| STA 3+160 Thru STA 3+190                               | SHEET: 36 OF 47                     |




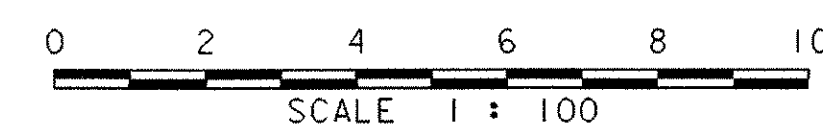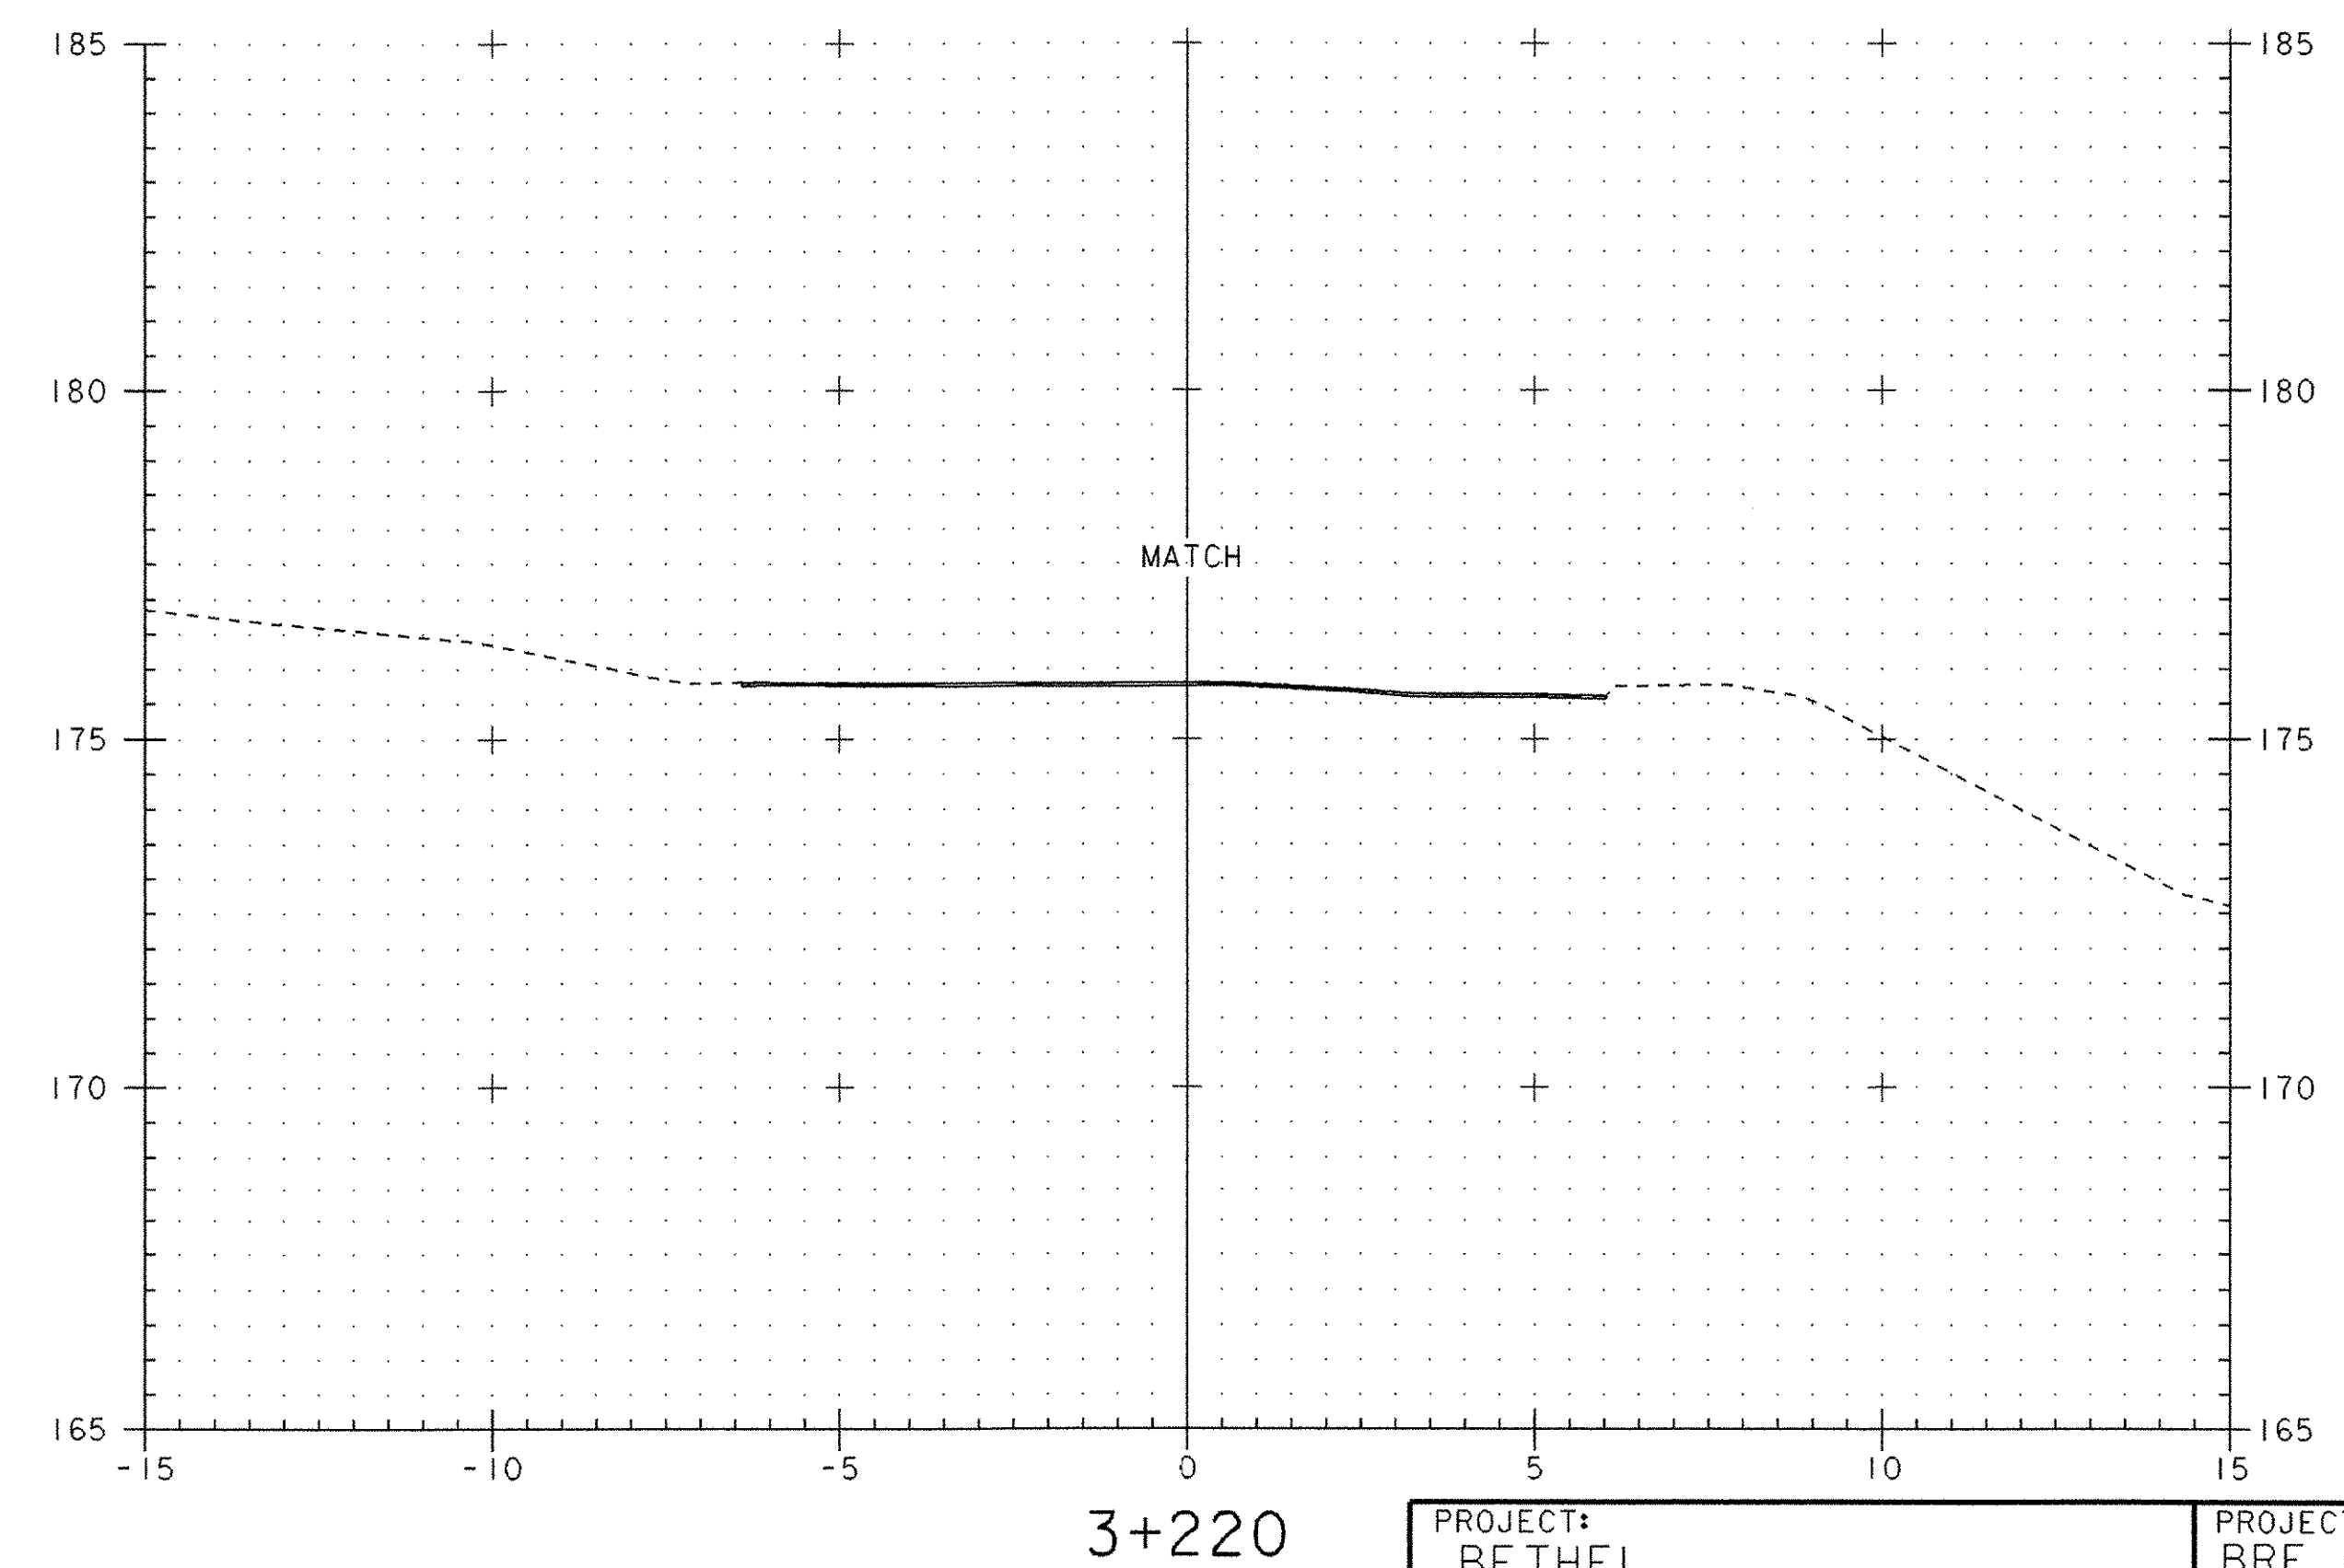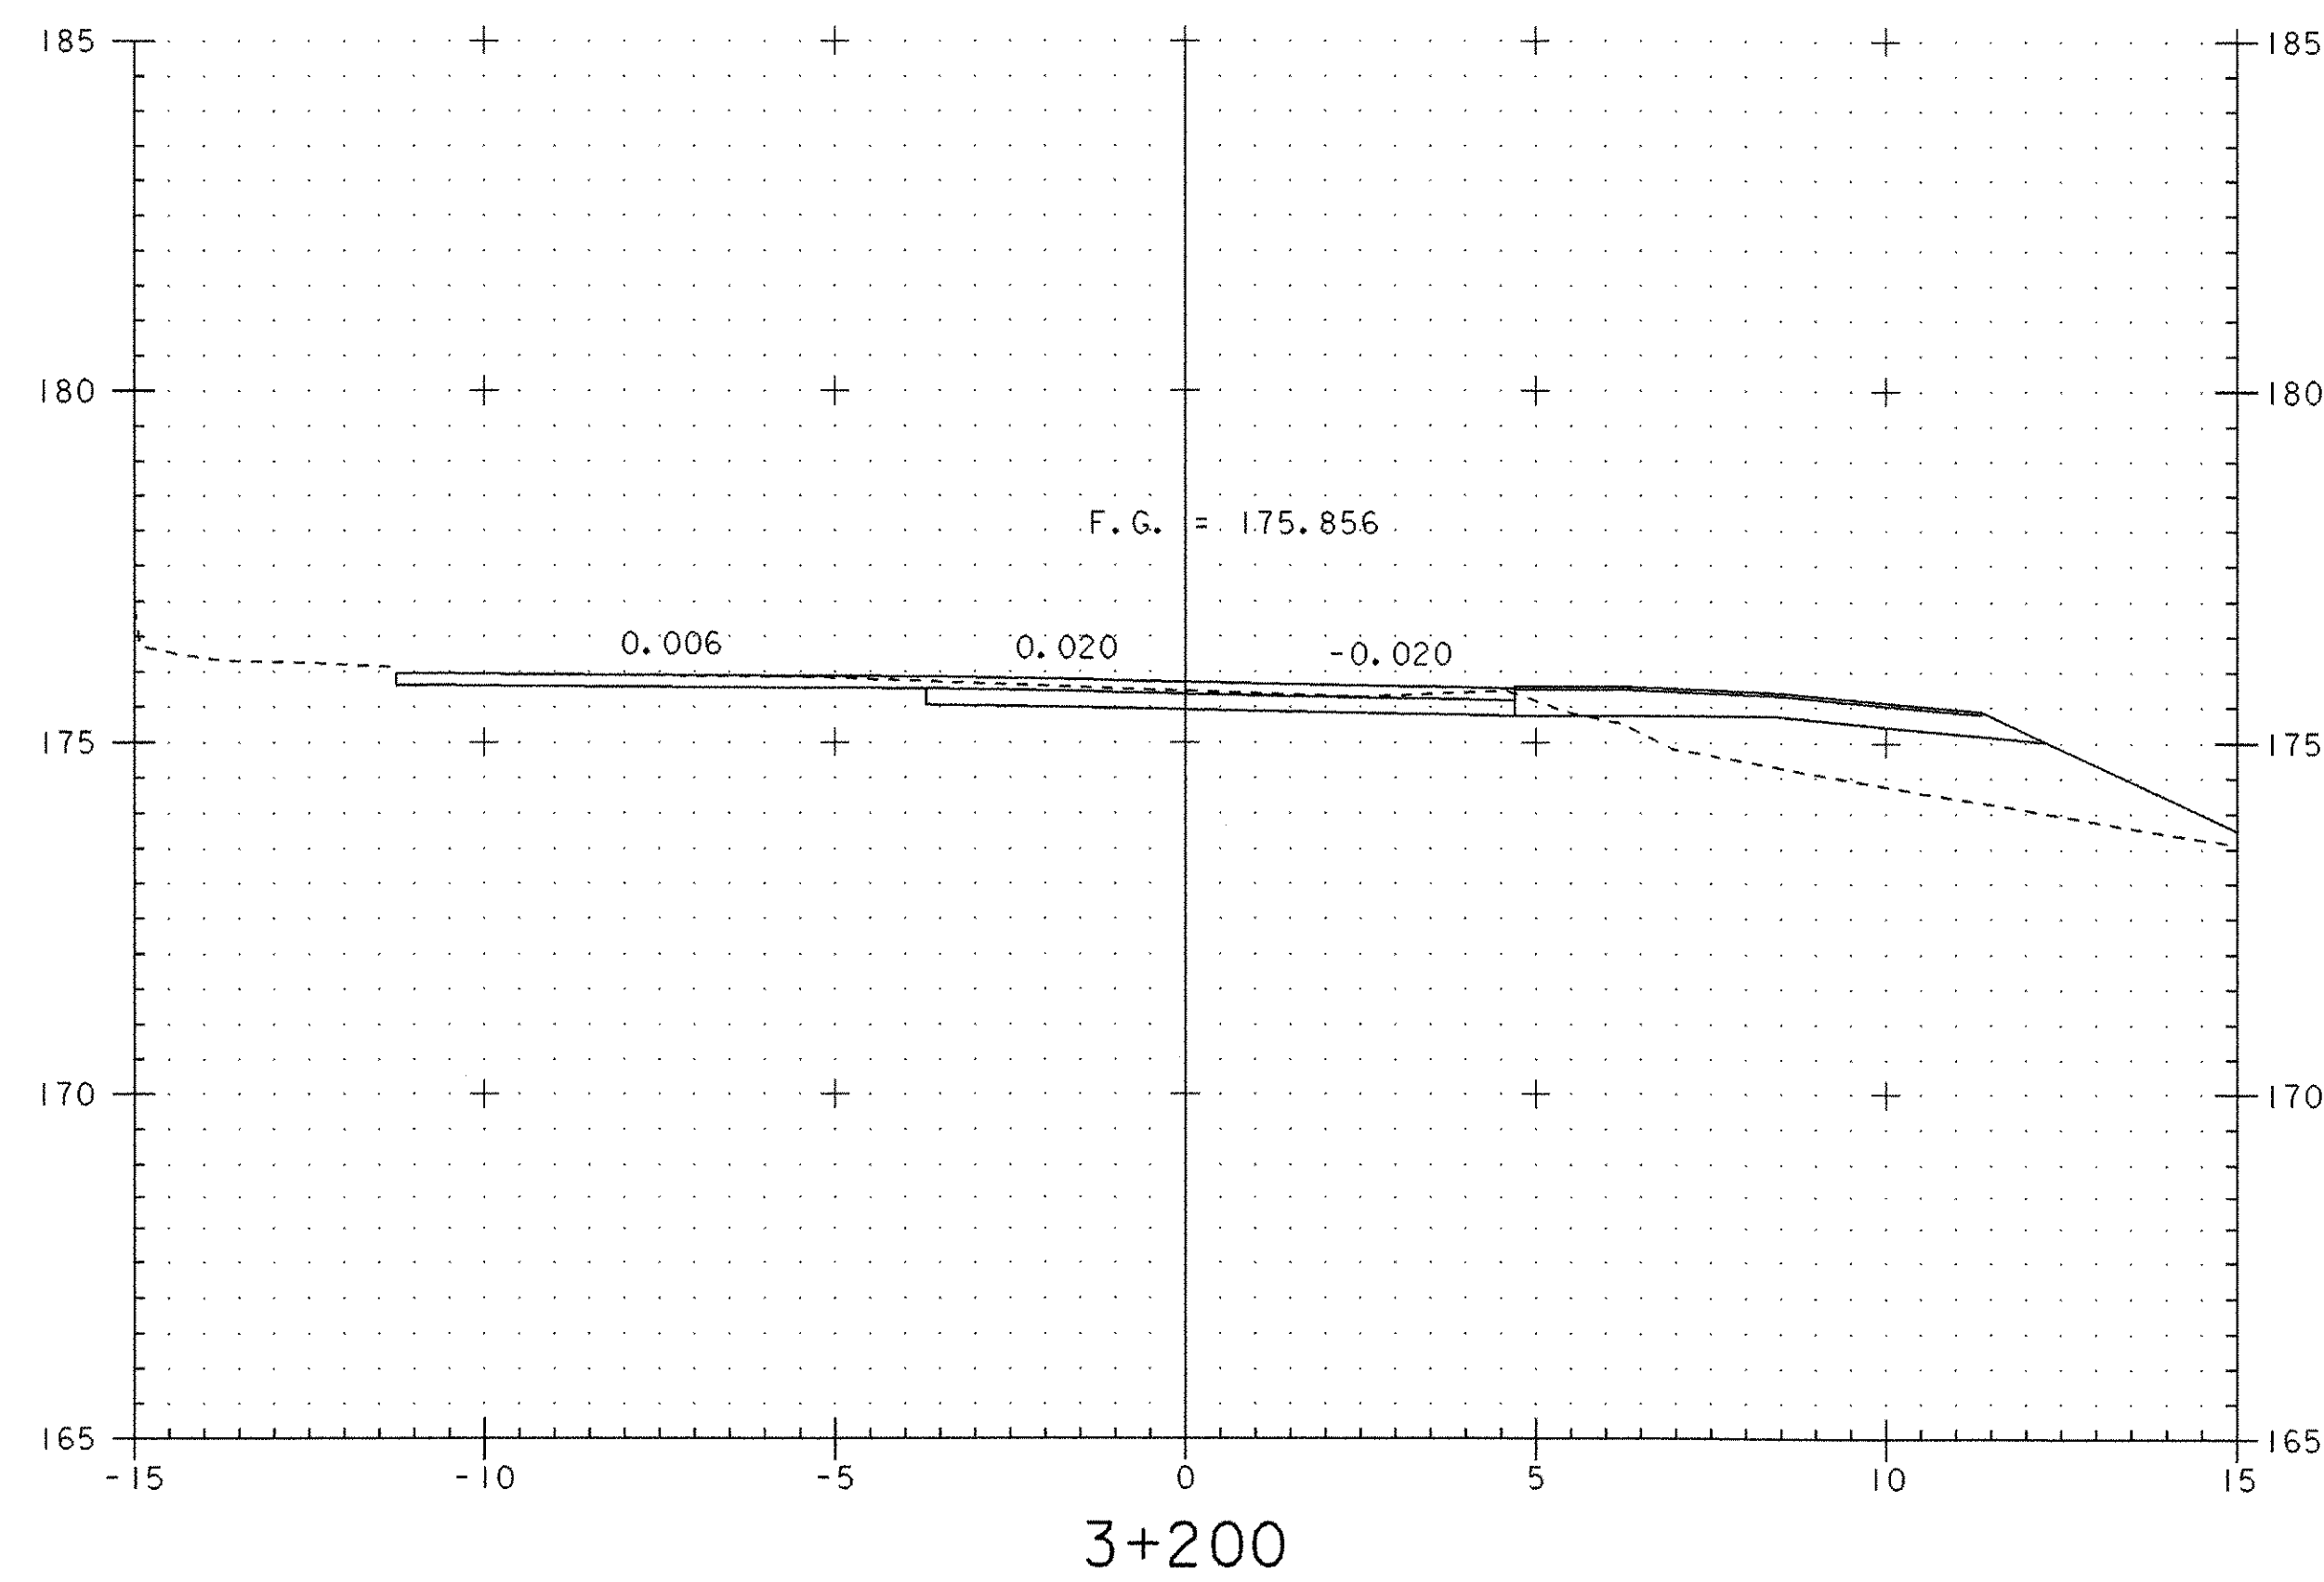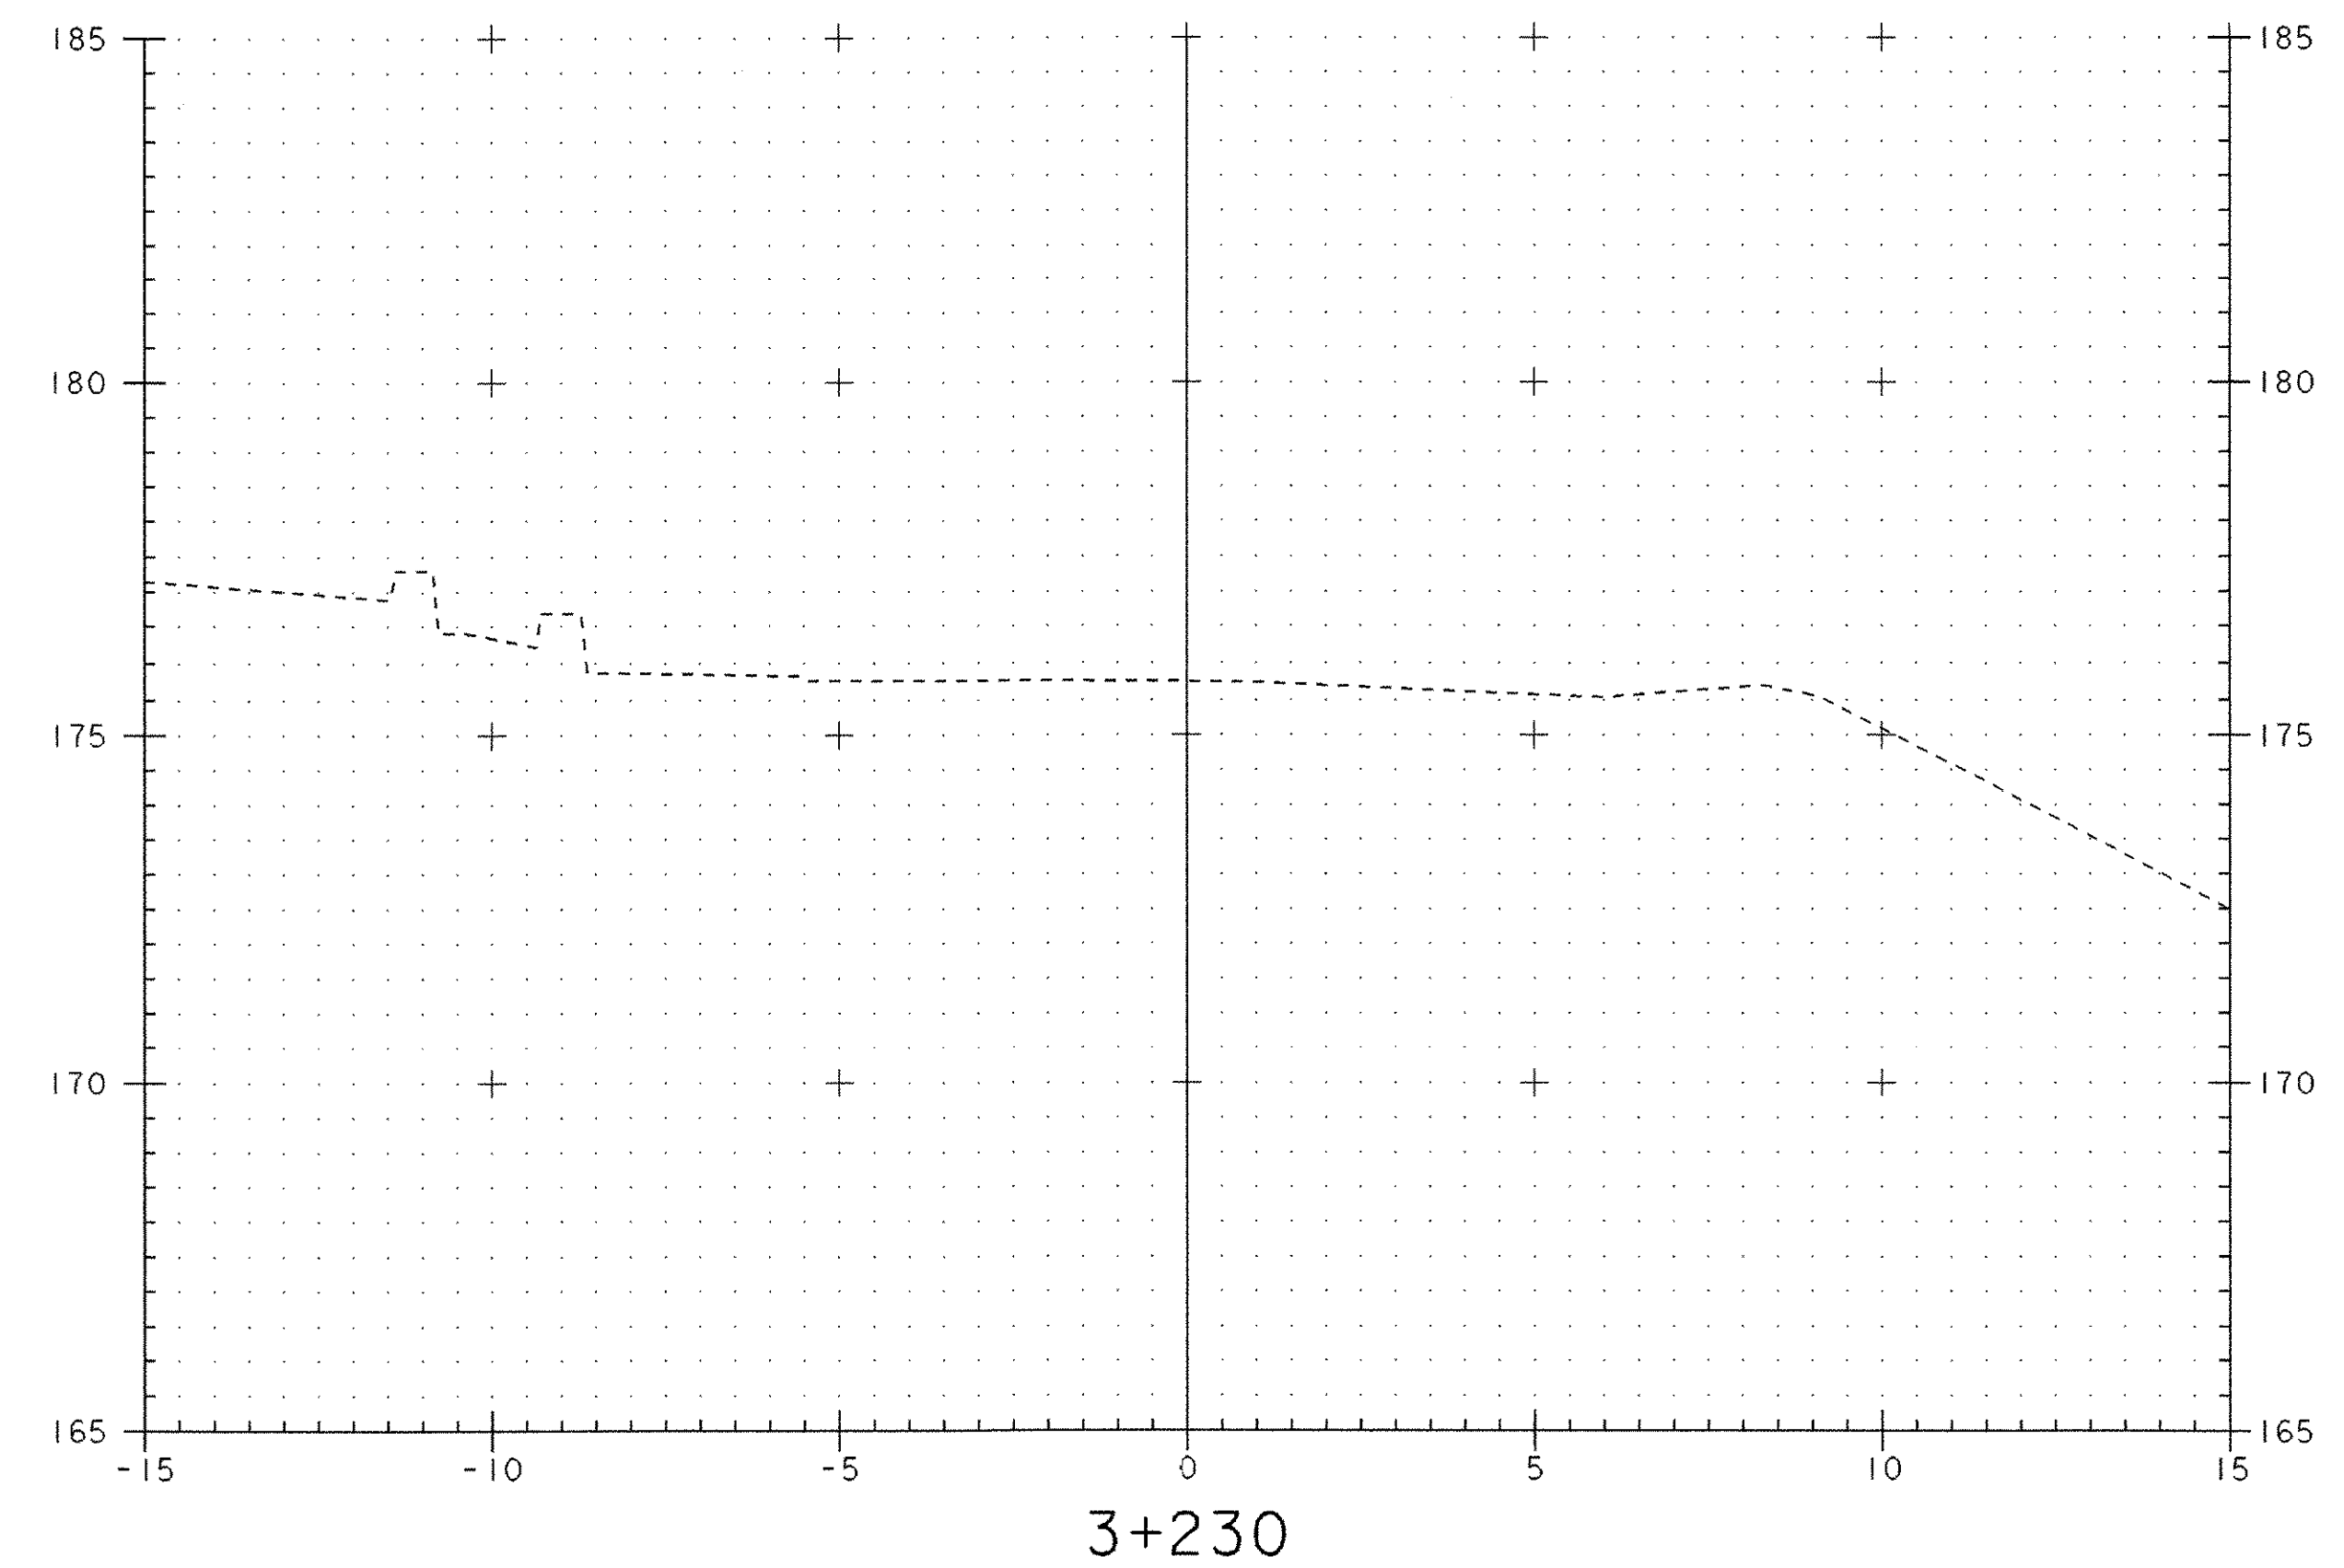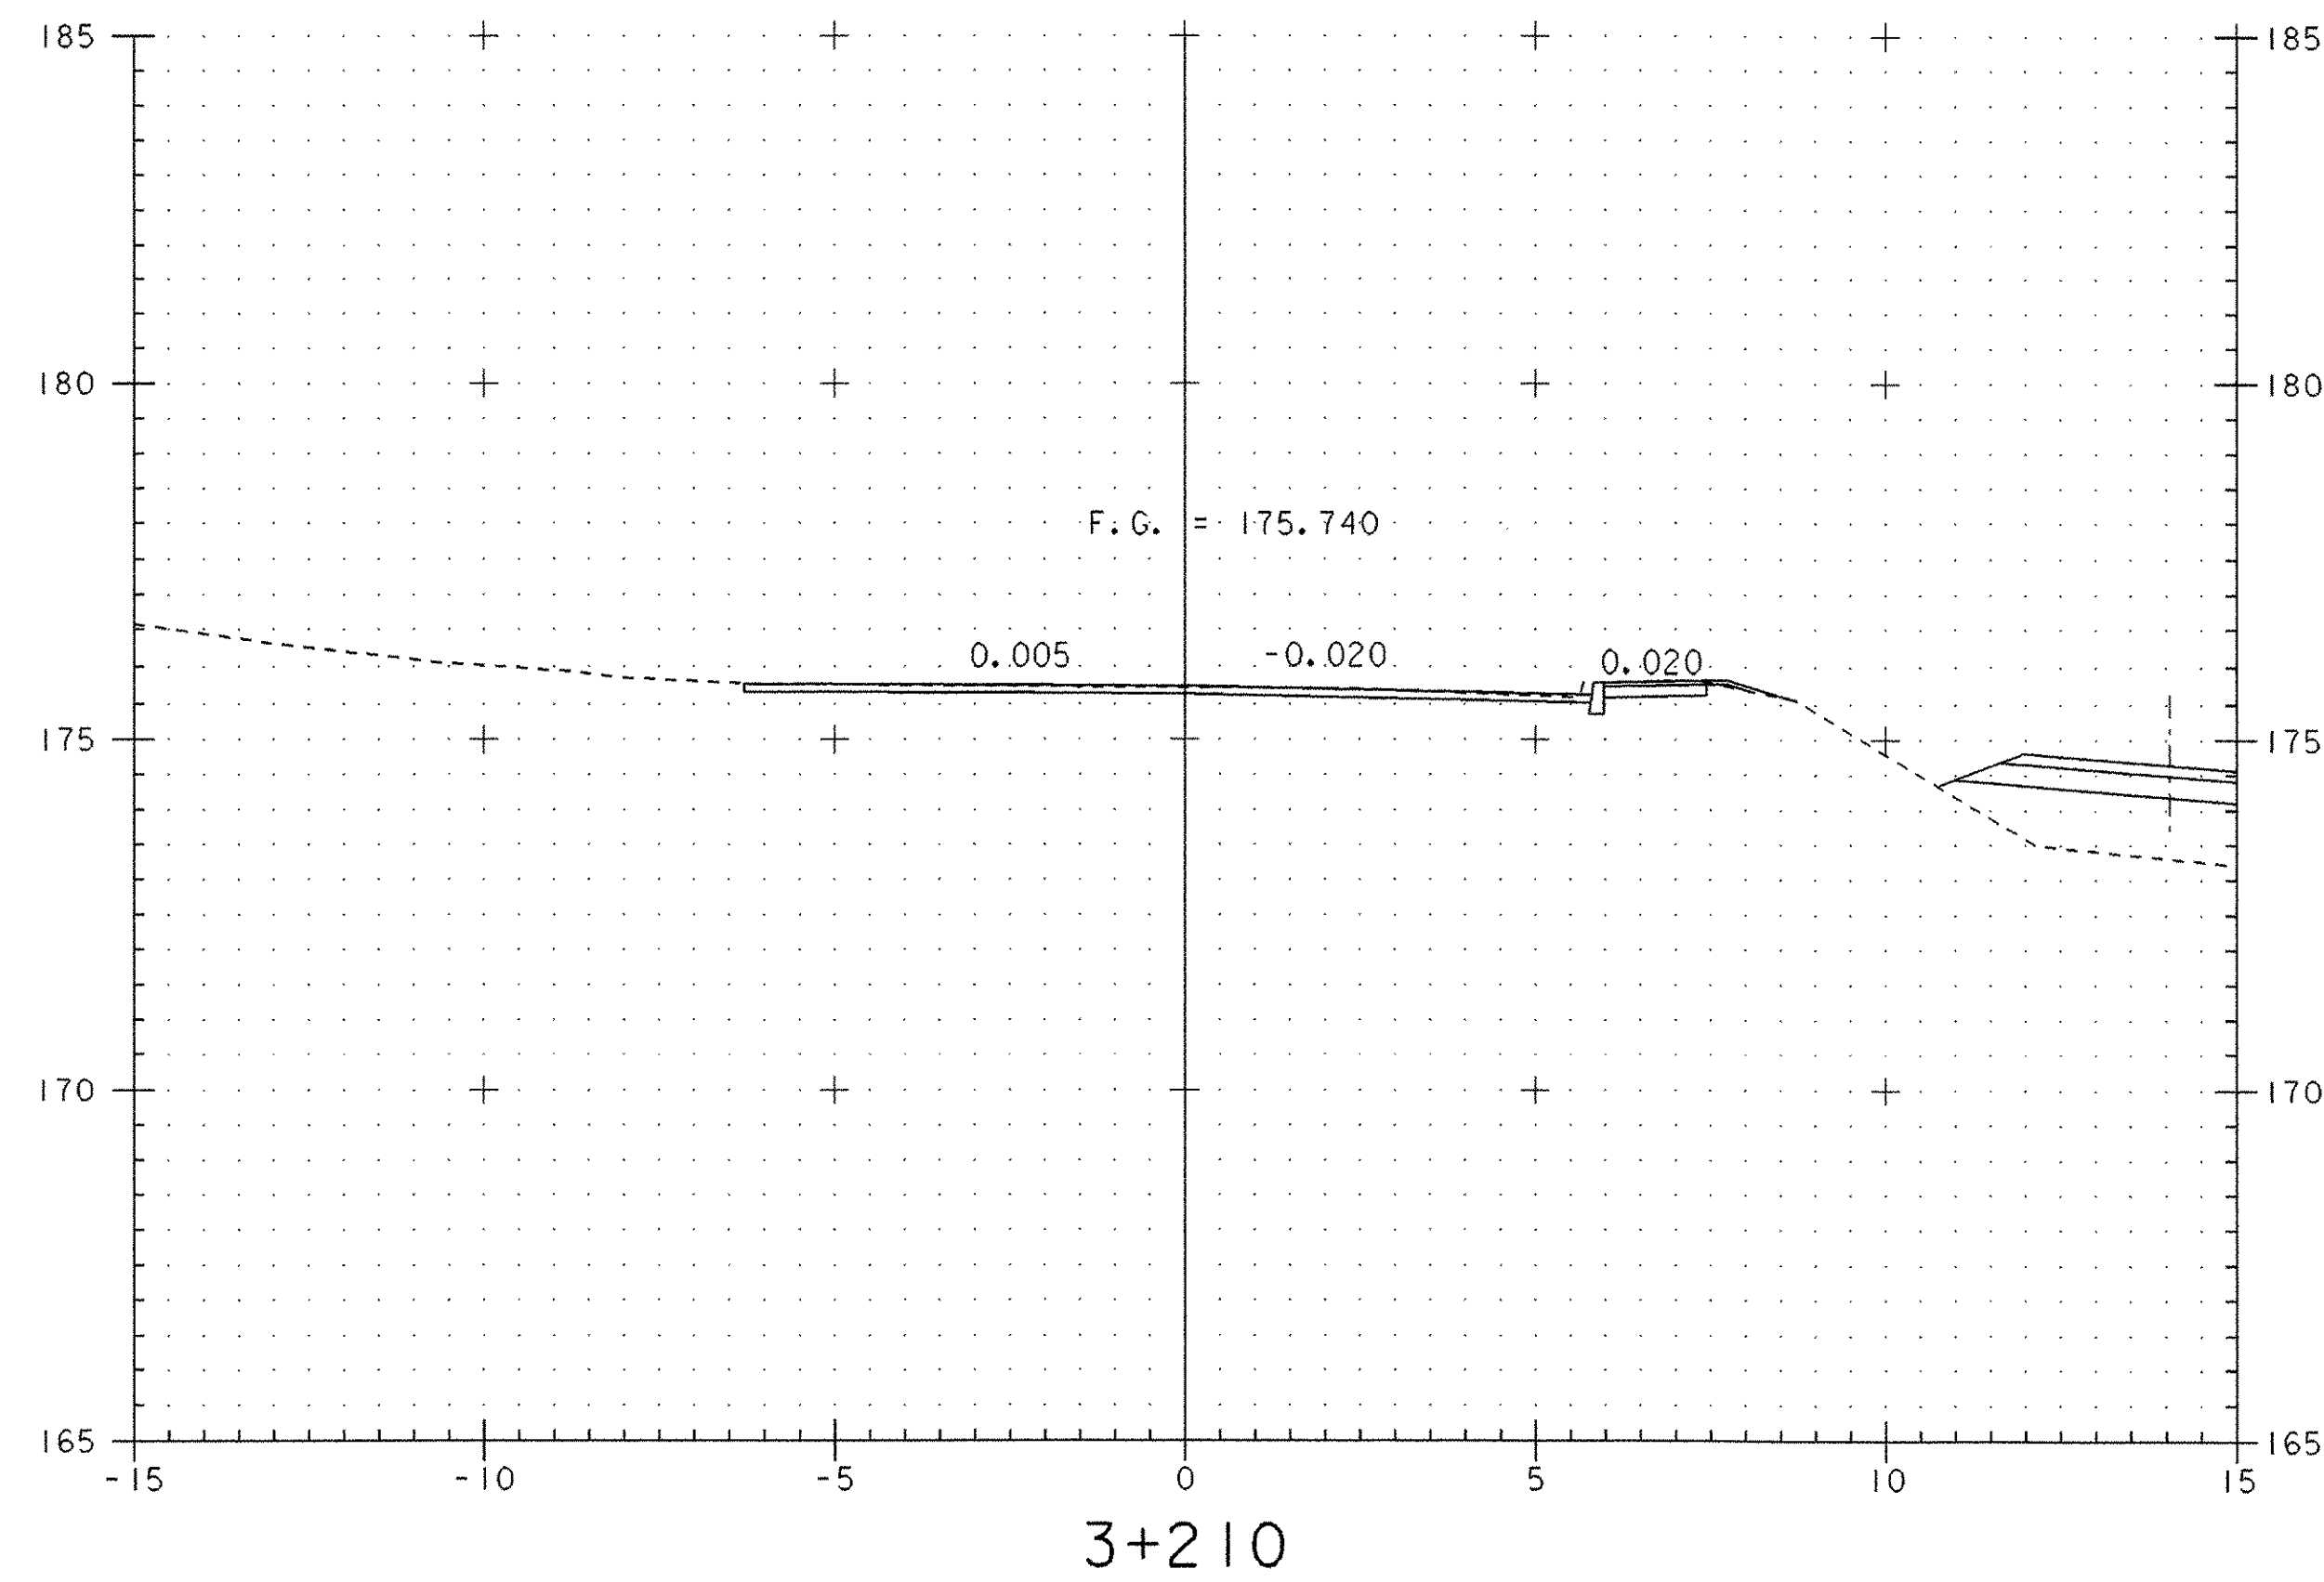


3+220  
End Approach

|                                                        |                                     |
|--------------------------------------------------------|-------------------------------------|
| PROJECT:<br>BETHEL                                     | PROJECT NO. :<br>BRF 0241 (33) - C1 |
| DESIGN FILE NAME: 96j250/structures/s96j250xsec-cl.dgn | PLOT DATE: 09-JUL-2003              |
| IPARM FILE NAME: s1250xdt6.i                           |                                     |
| TEMPORARY DETOUR CROSS SECTIONS                        |                                     |
| STA 3+200 Thru STA 3+230                               | SHEET: 37 OF 47                     |



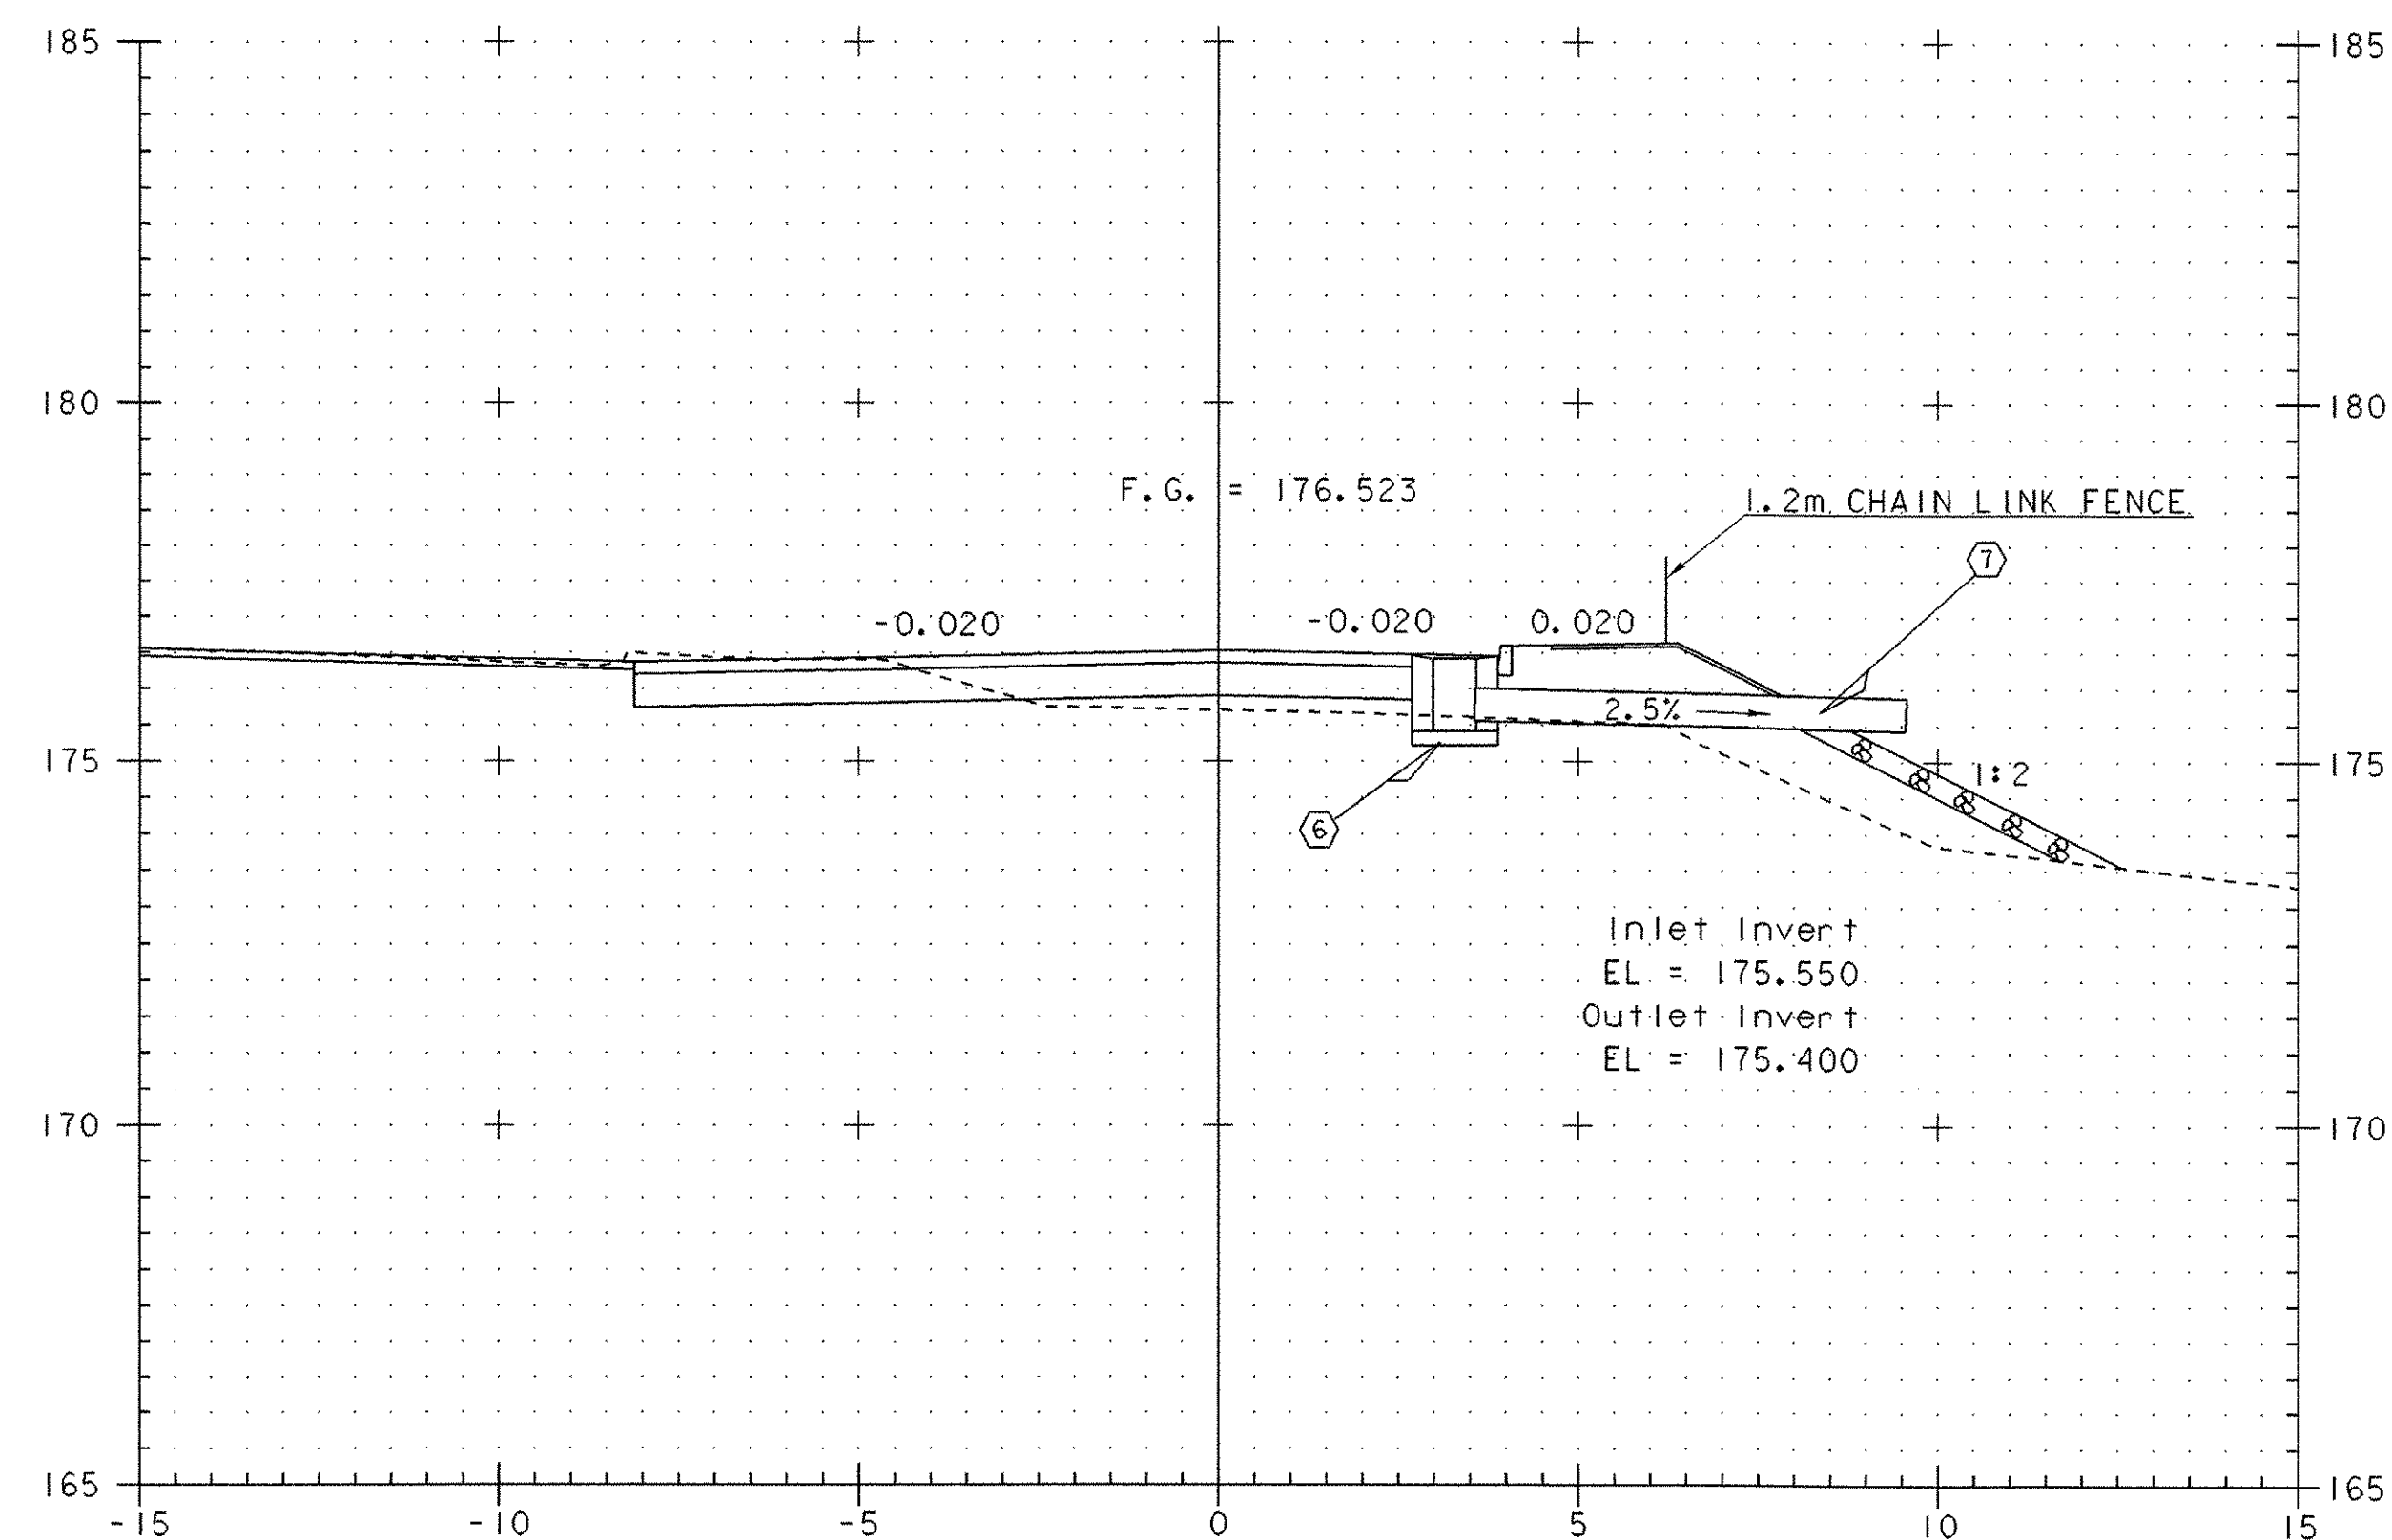

3+187.600  
SECTION AT PIPE





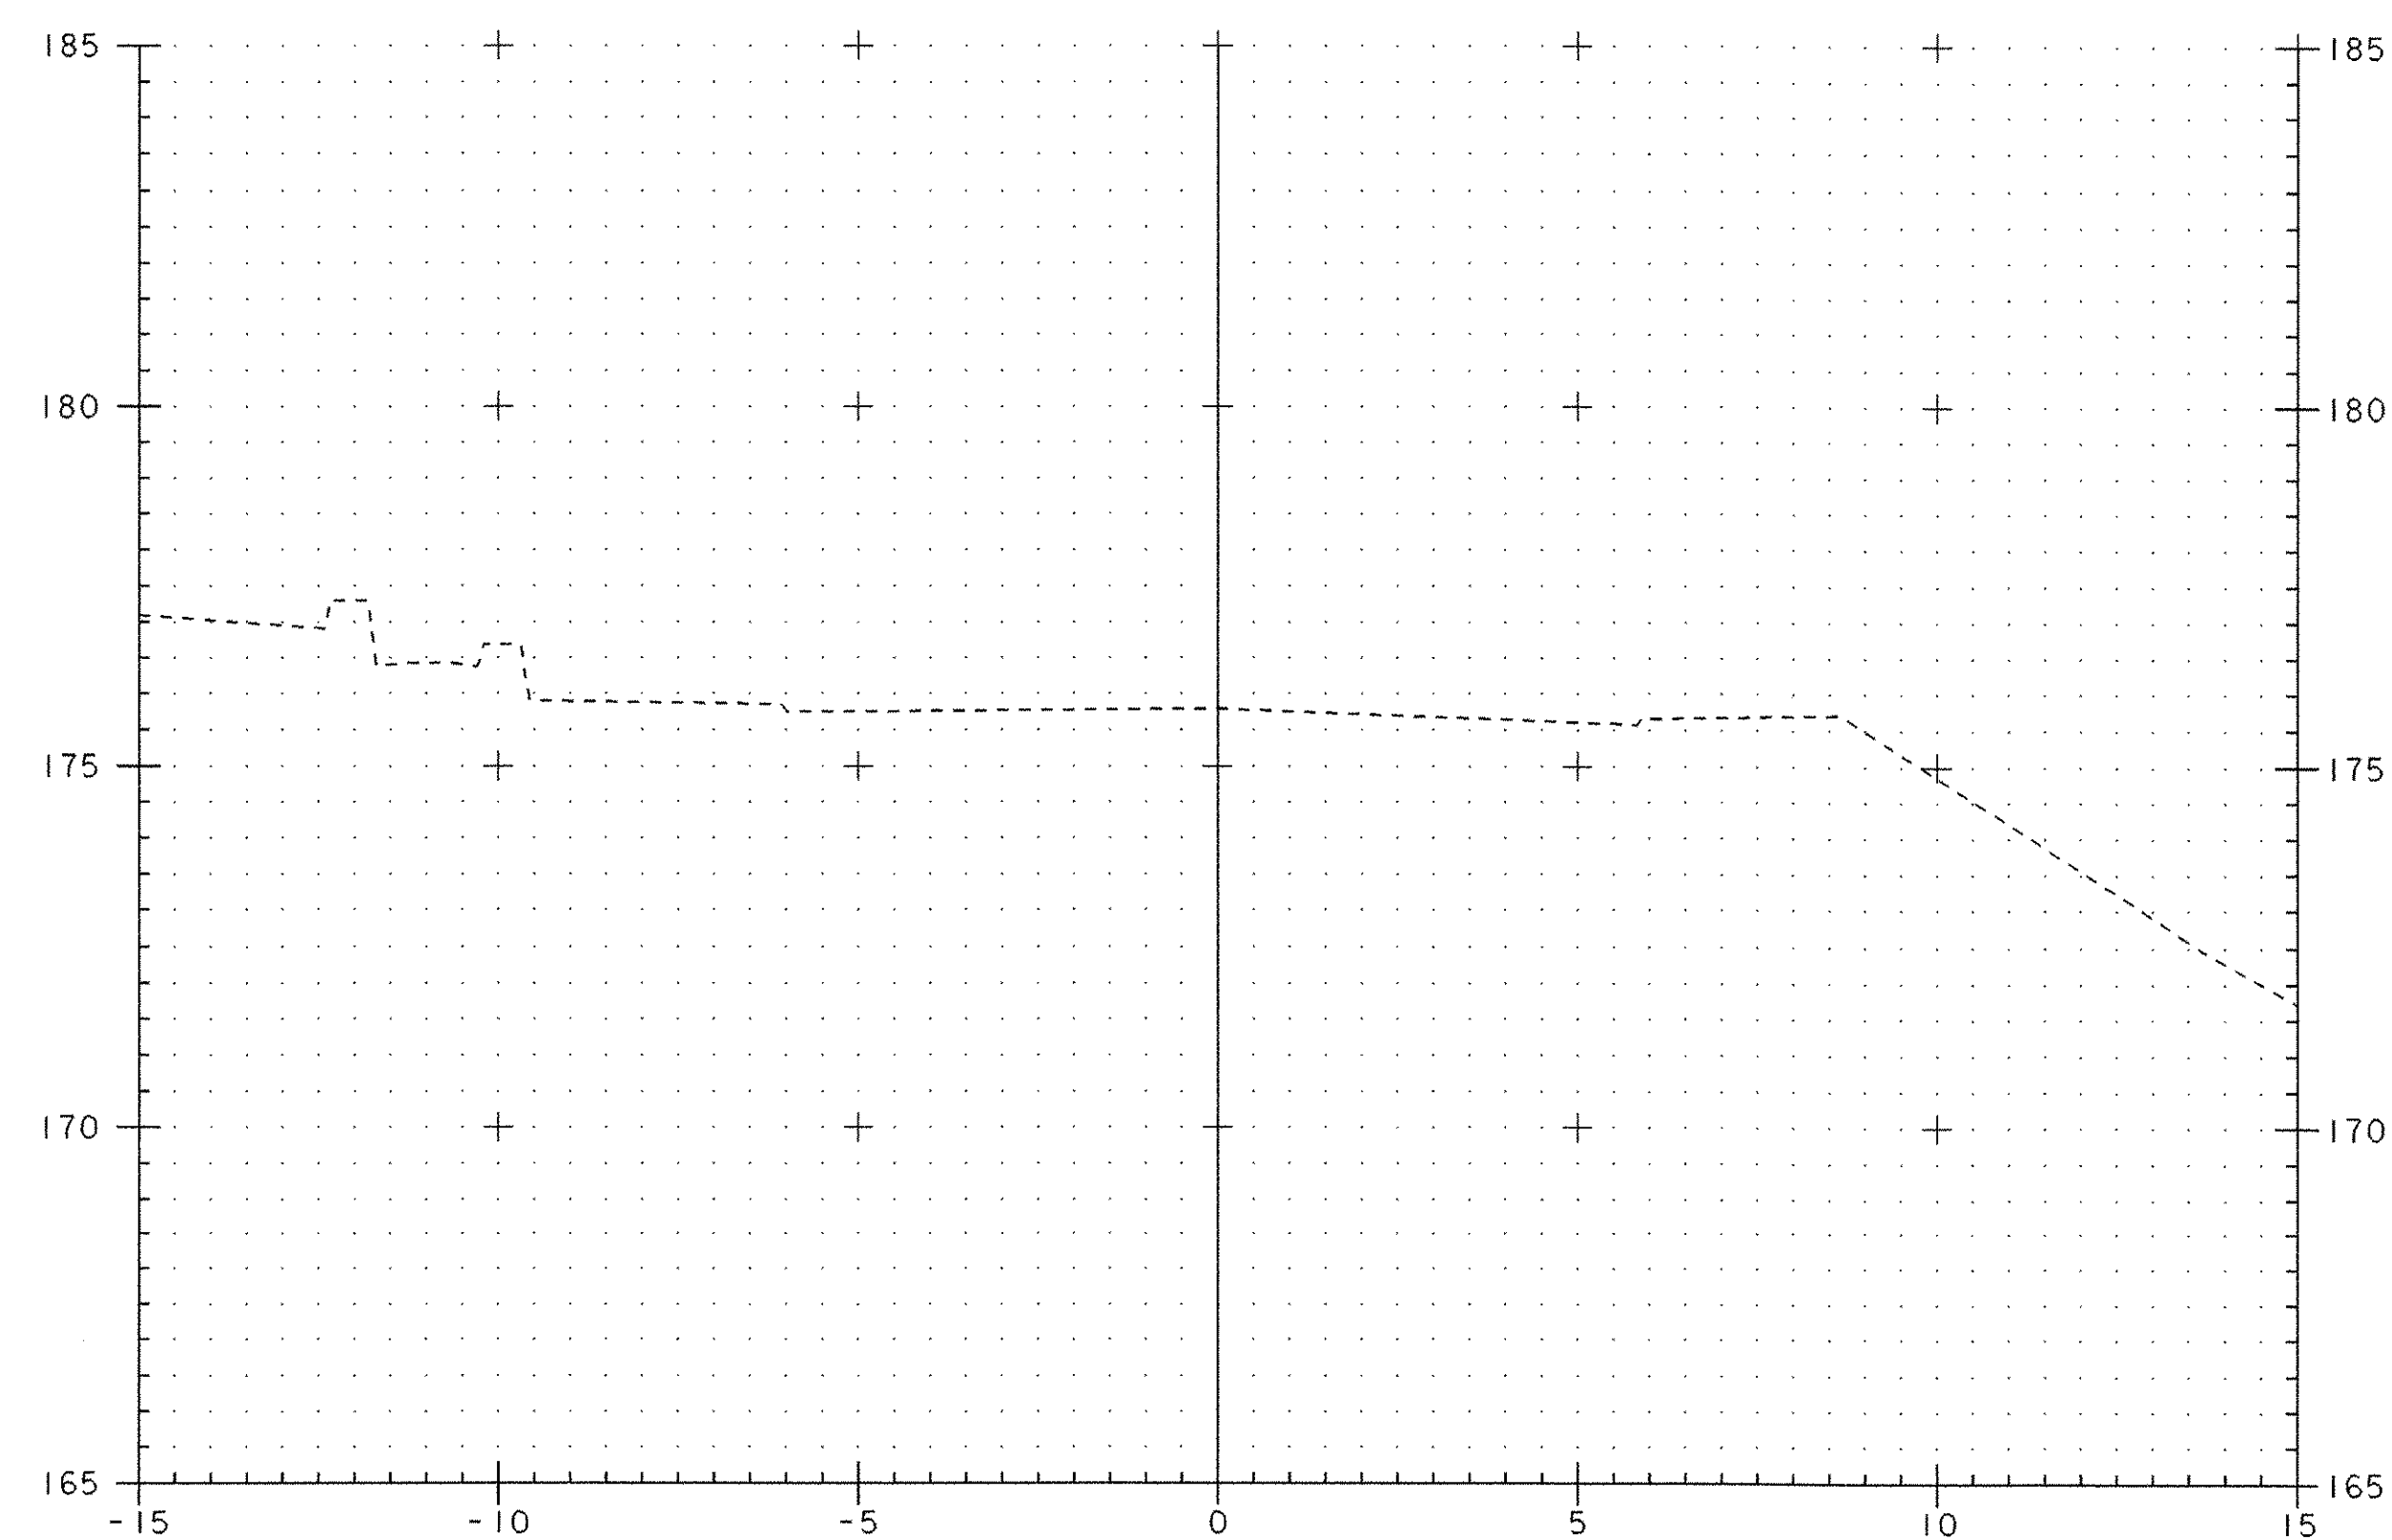


3+240







|                                                        |                                     |
|--------------------------------------------------------|-------------------------------------|
| PROJECT:<br>BETHEL                                     | PROJECT NO. :<br>BRF 0241 (33) - C1 |
| DESIGN FILE NAME: 96j250/structures/s96j250xsec-cl.dgn | IPARM FILE NAME: s1250xdet7.i       |
| TEMPORARY DETOUR CROSS SECTIONS                        | PLOT DATE: 09-JUL-2003              |
| STA 3+240 & 3+187.600                                  | SHEET: 38 OF 47                     |



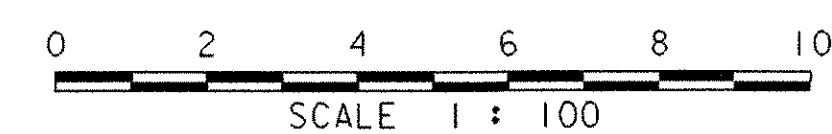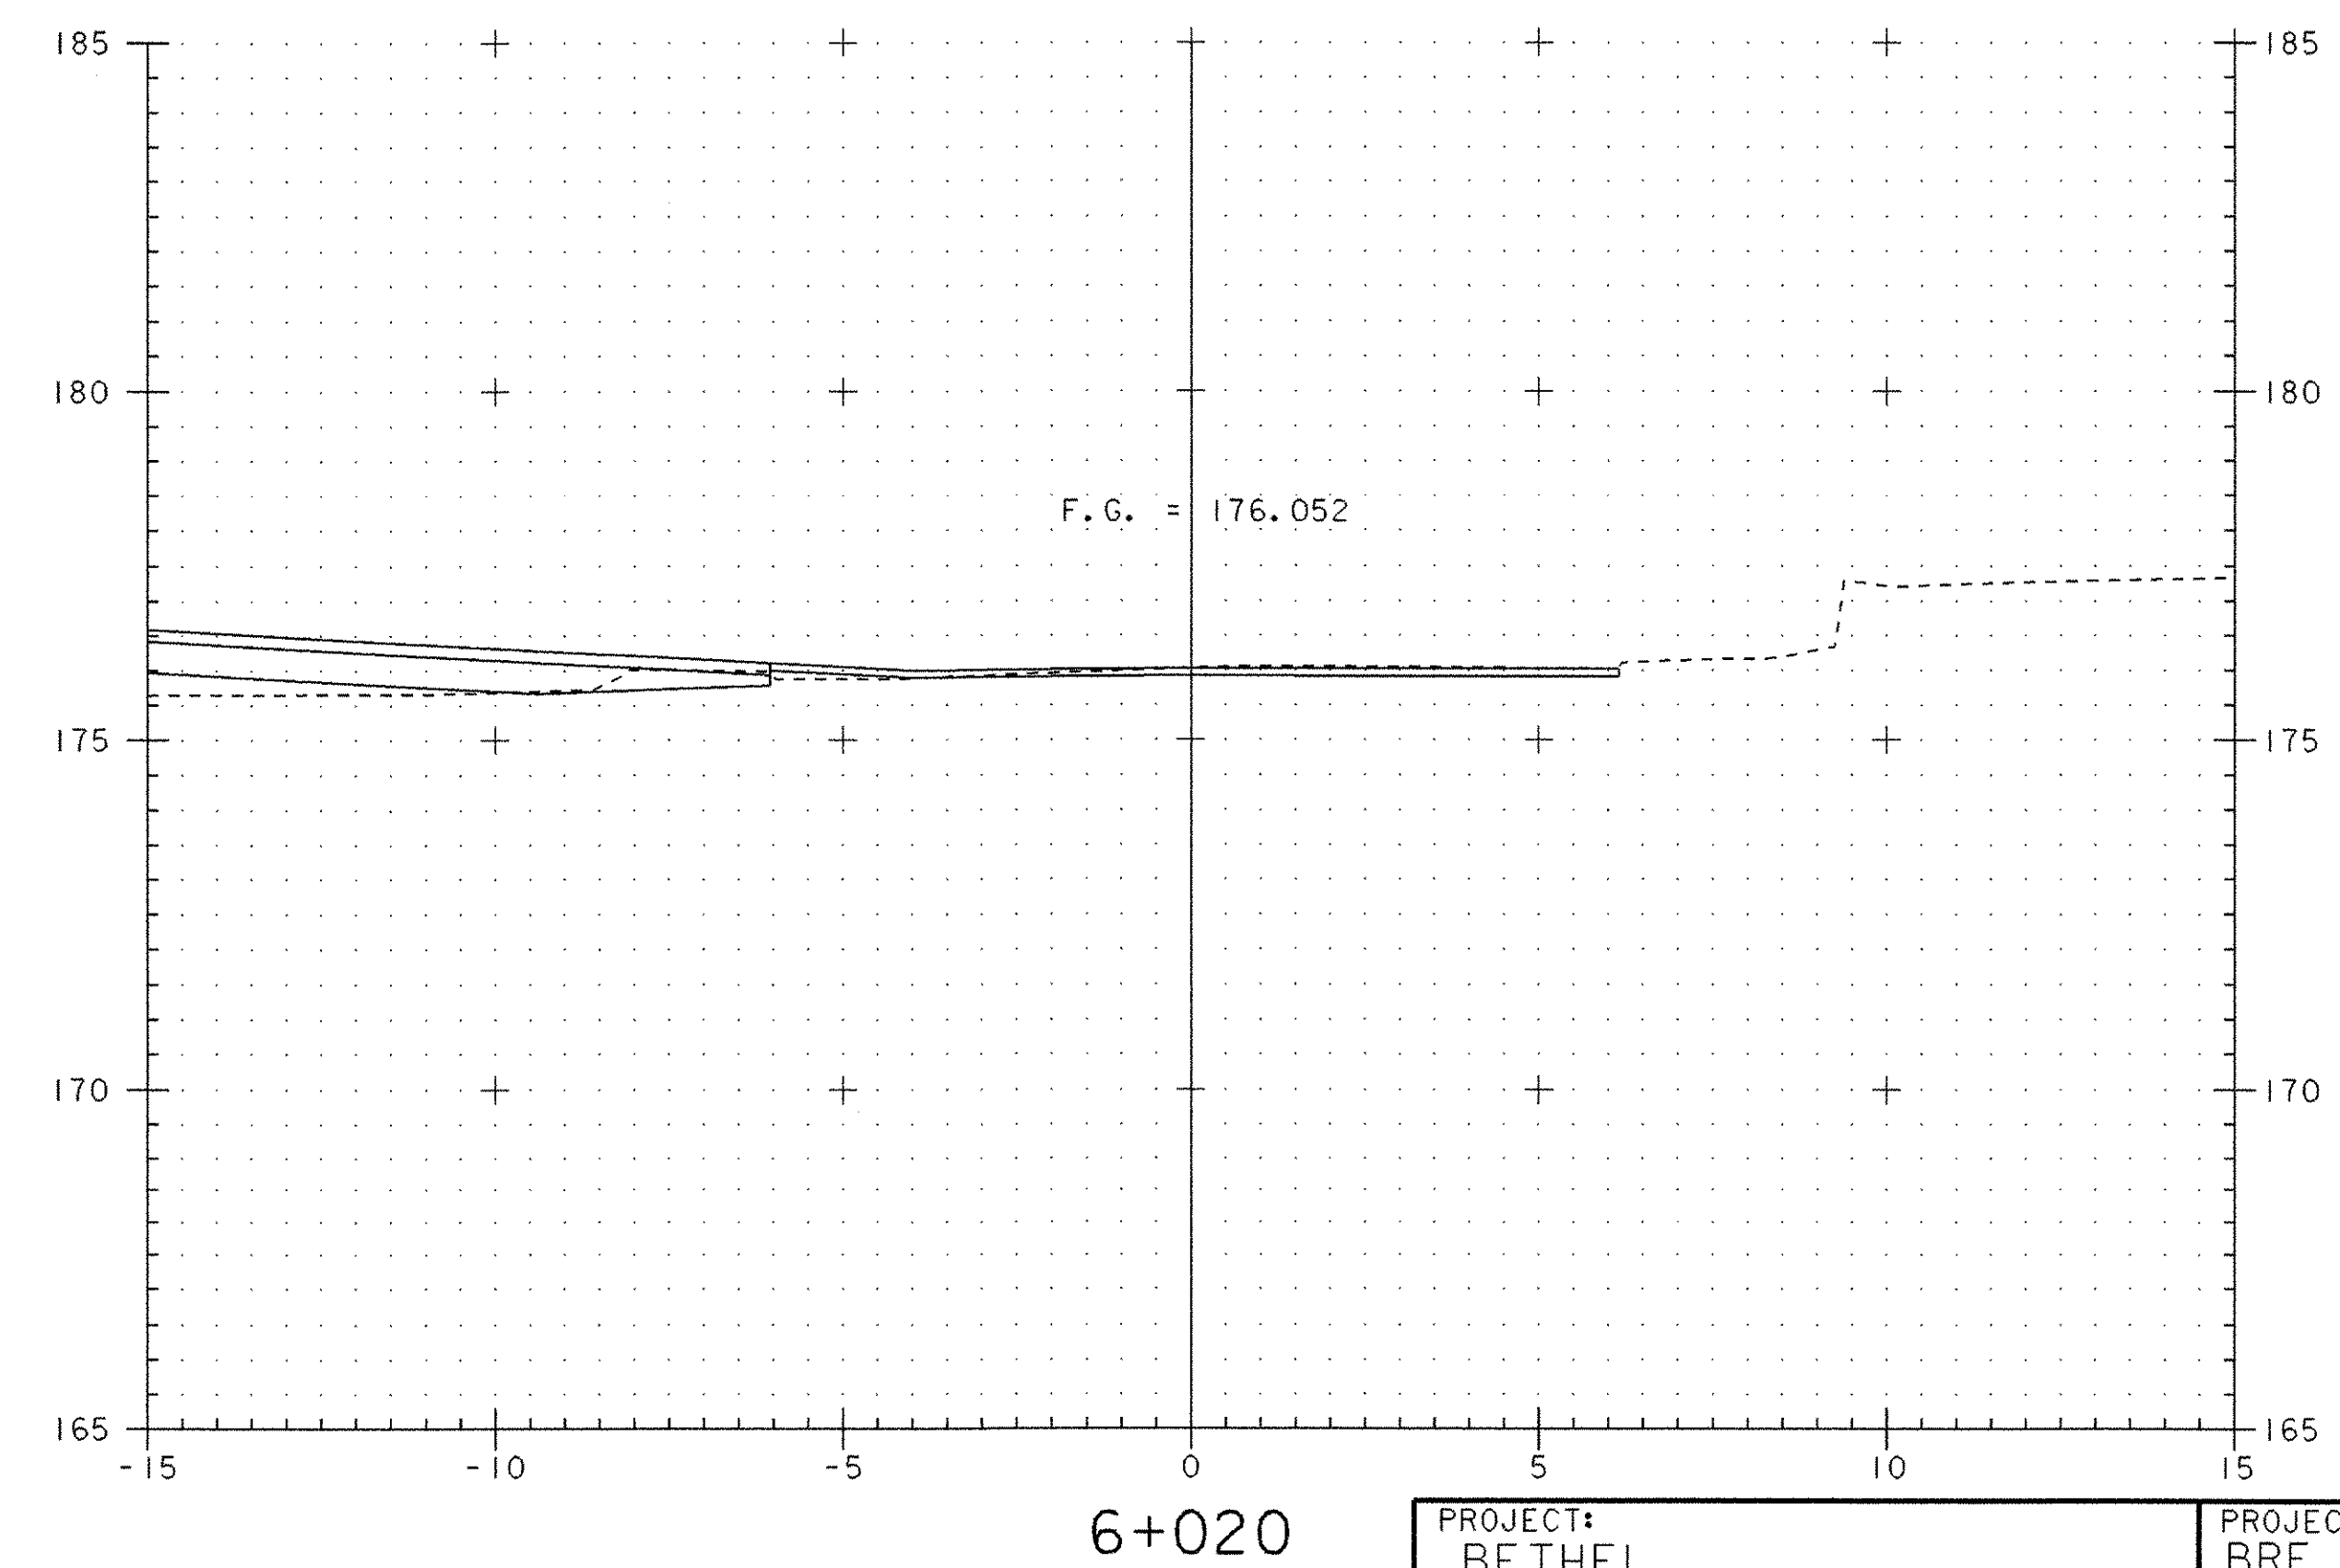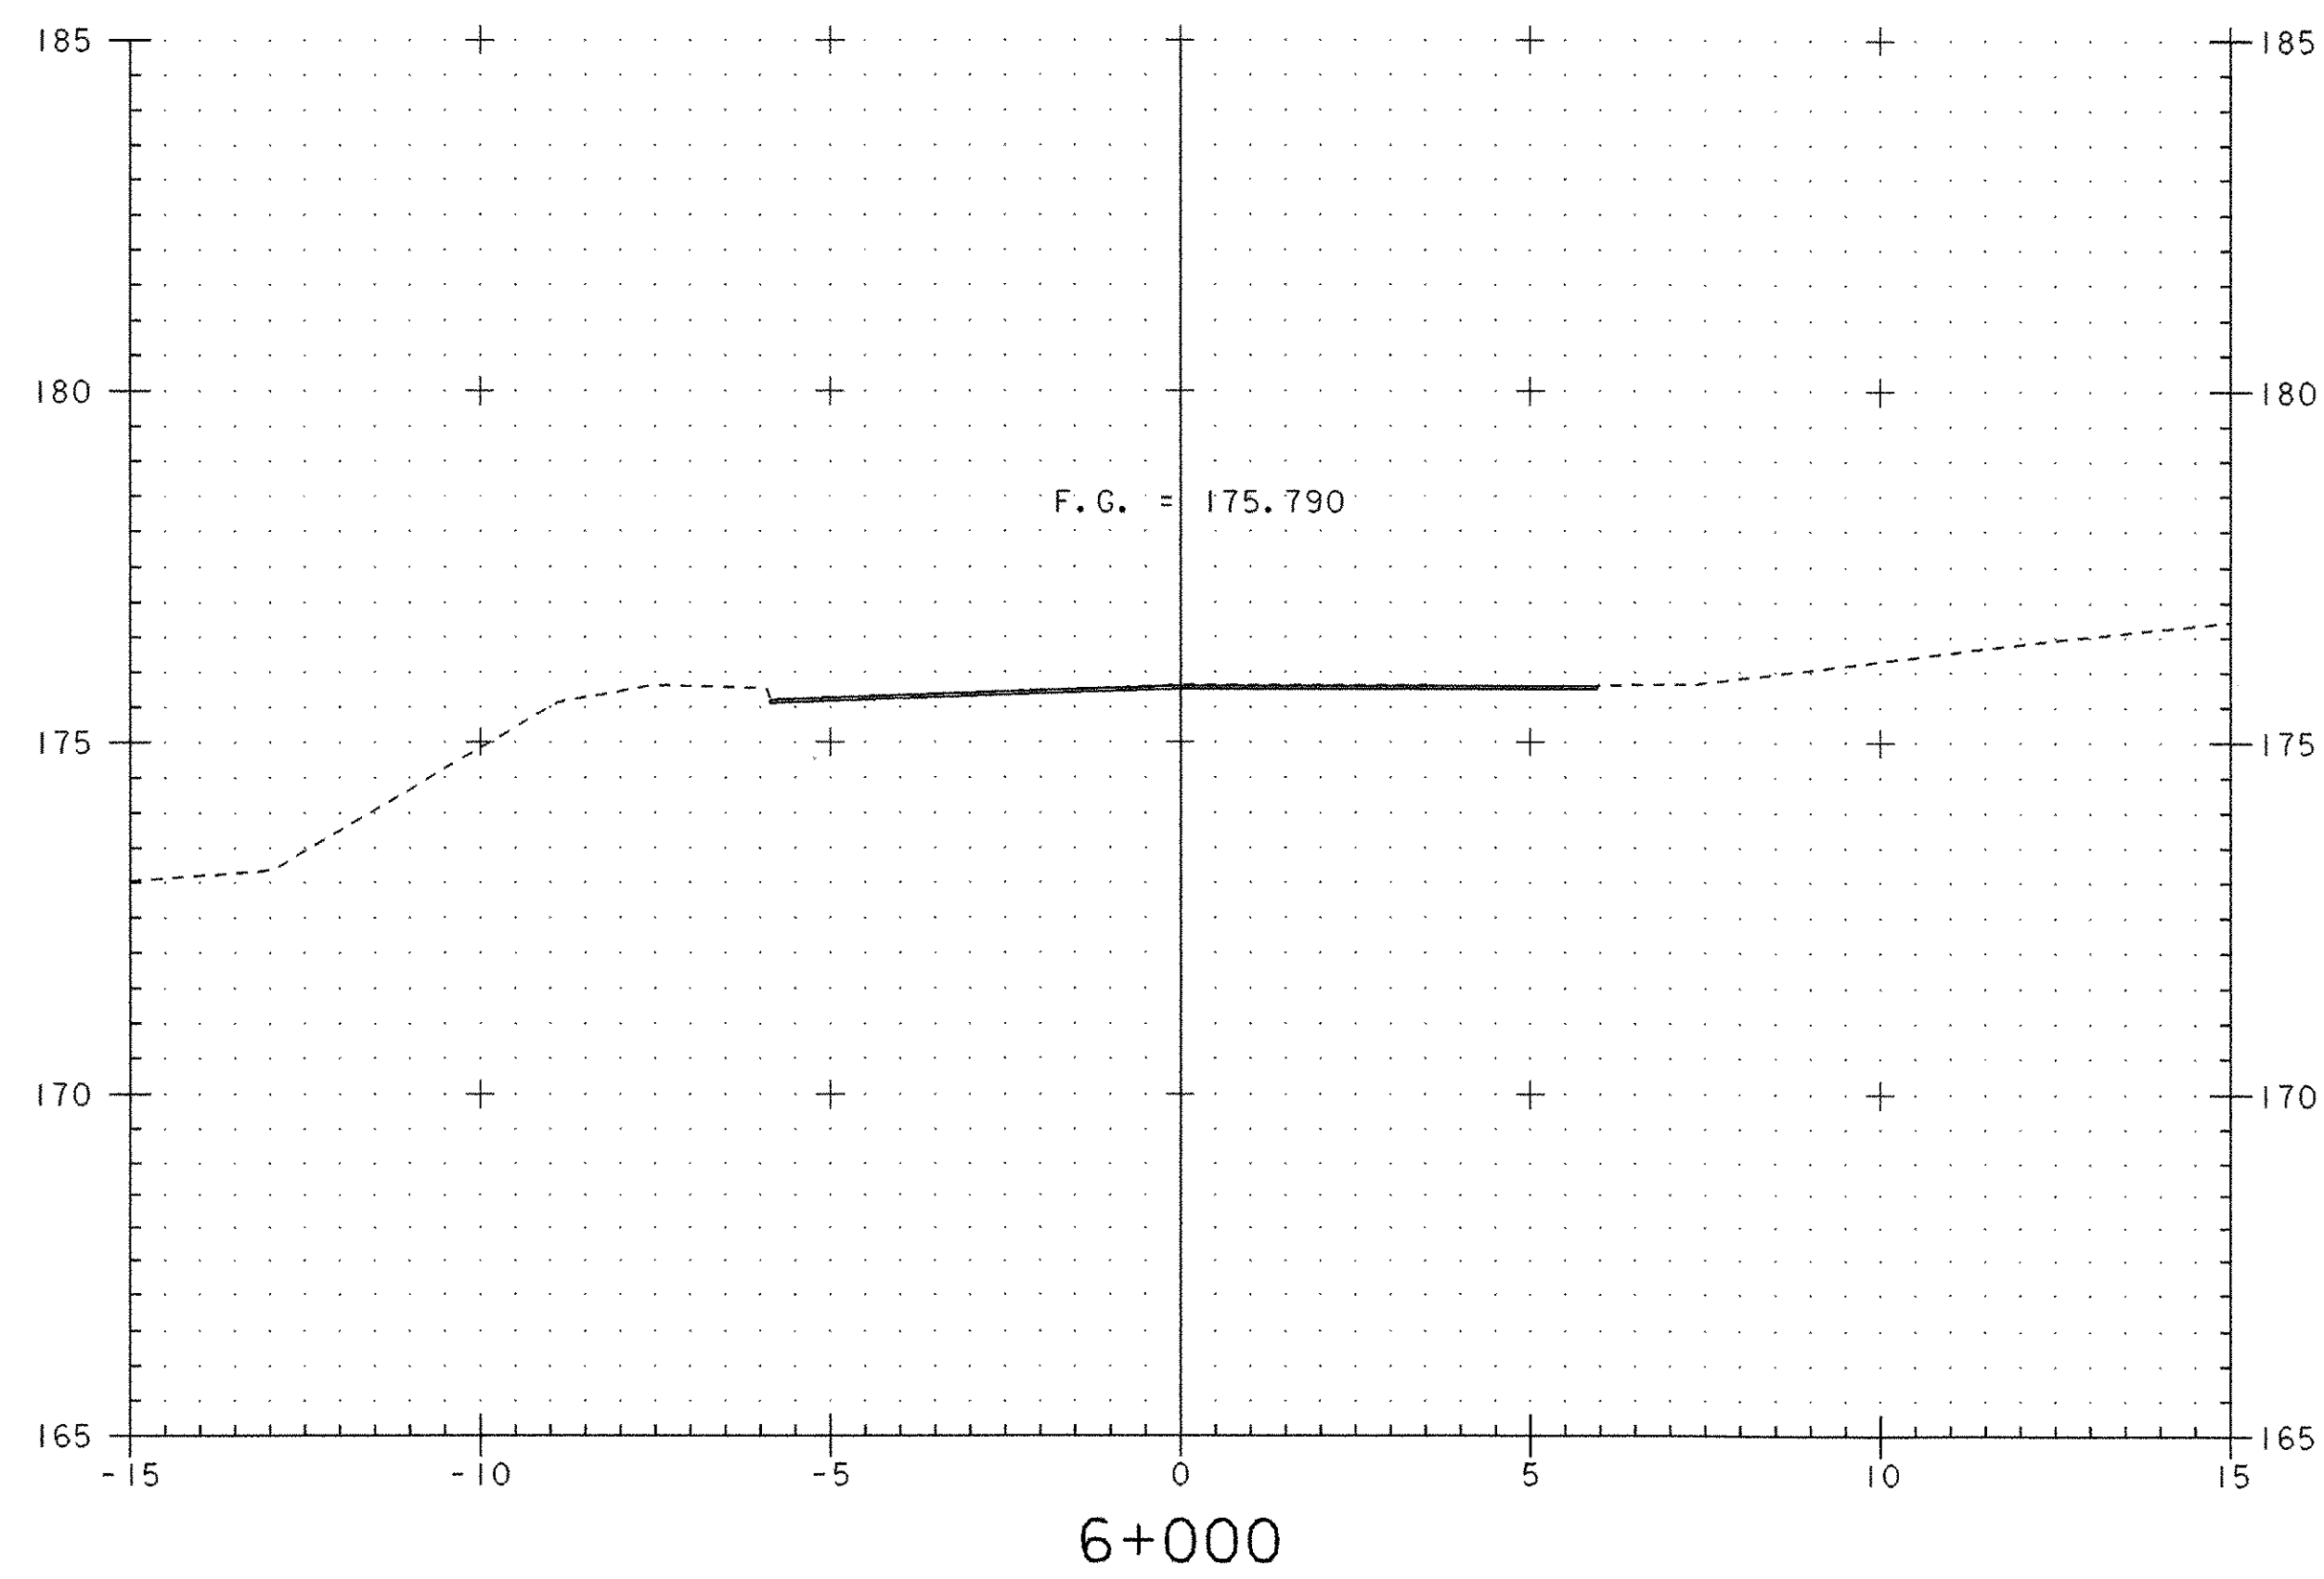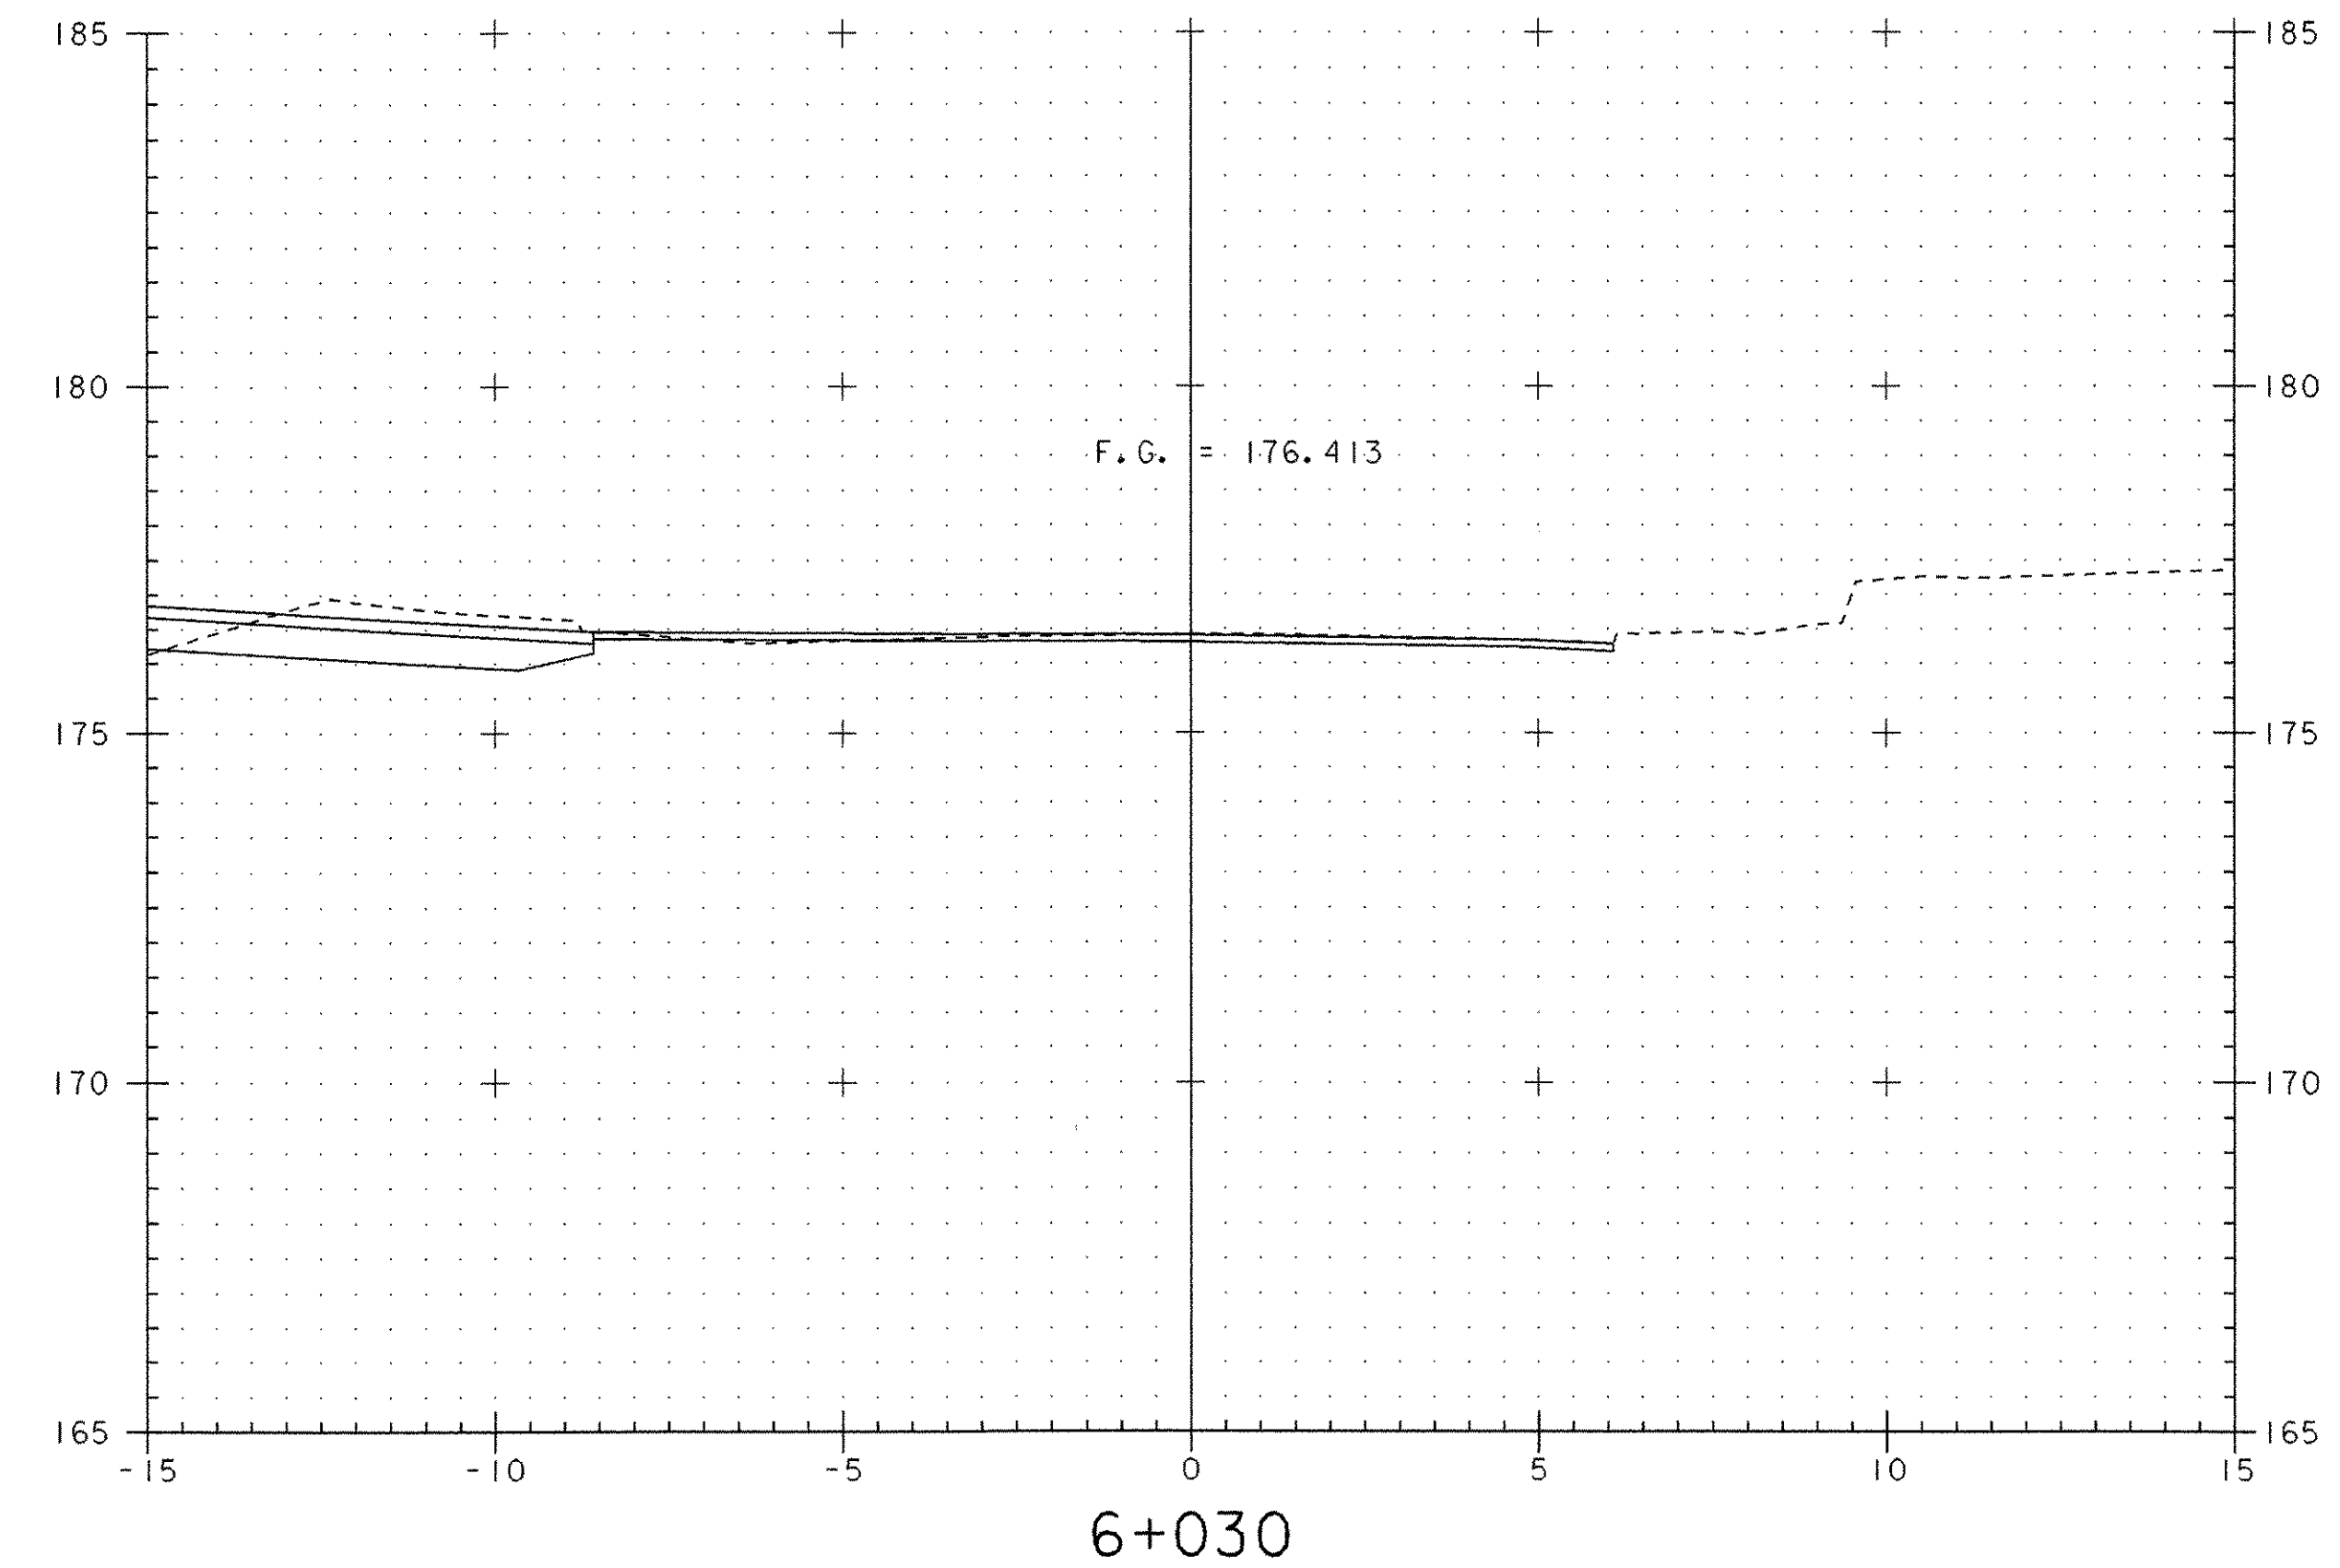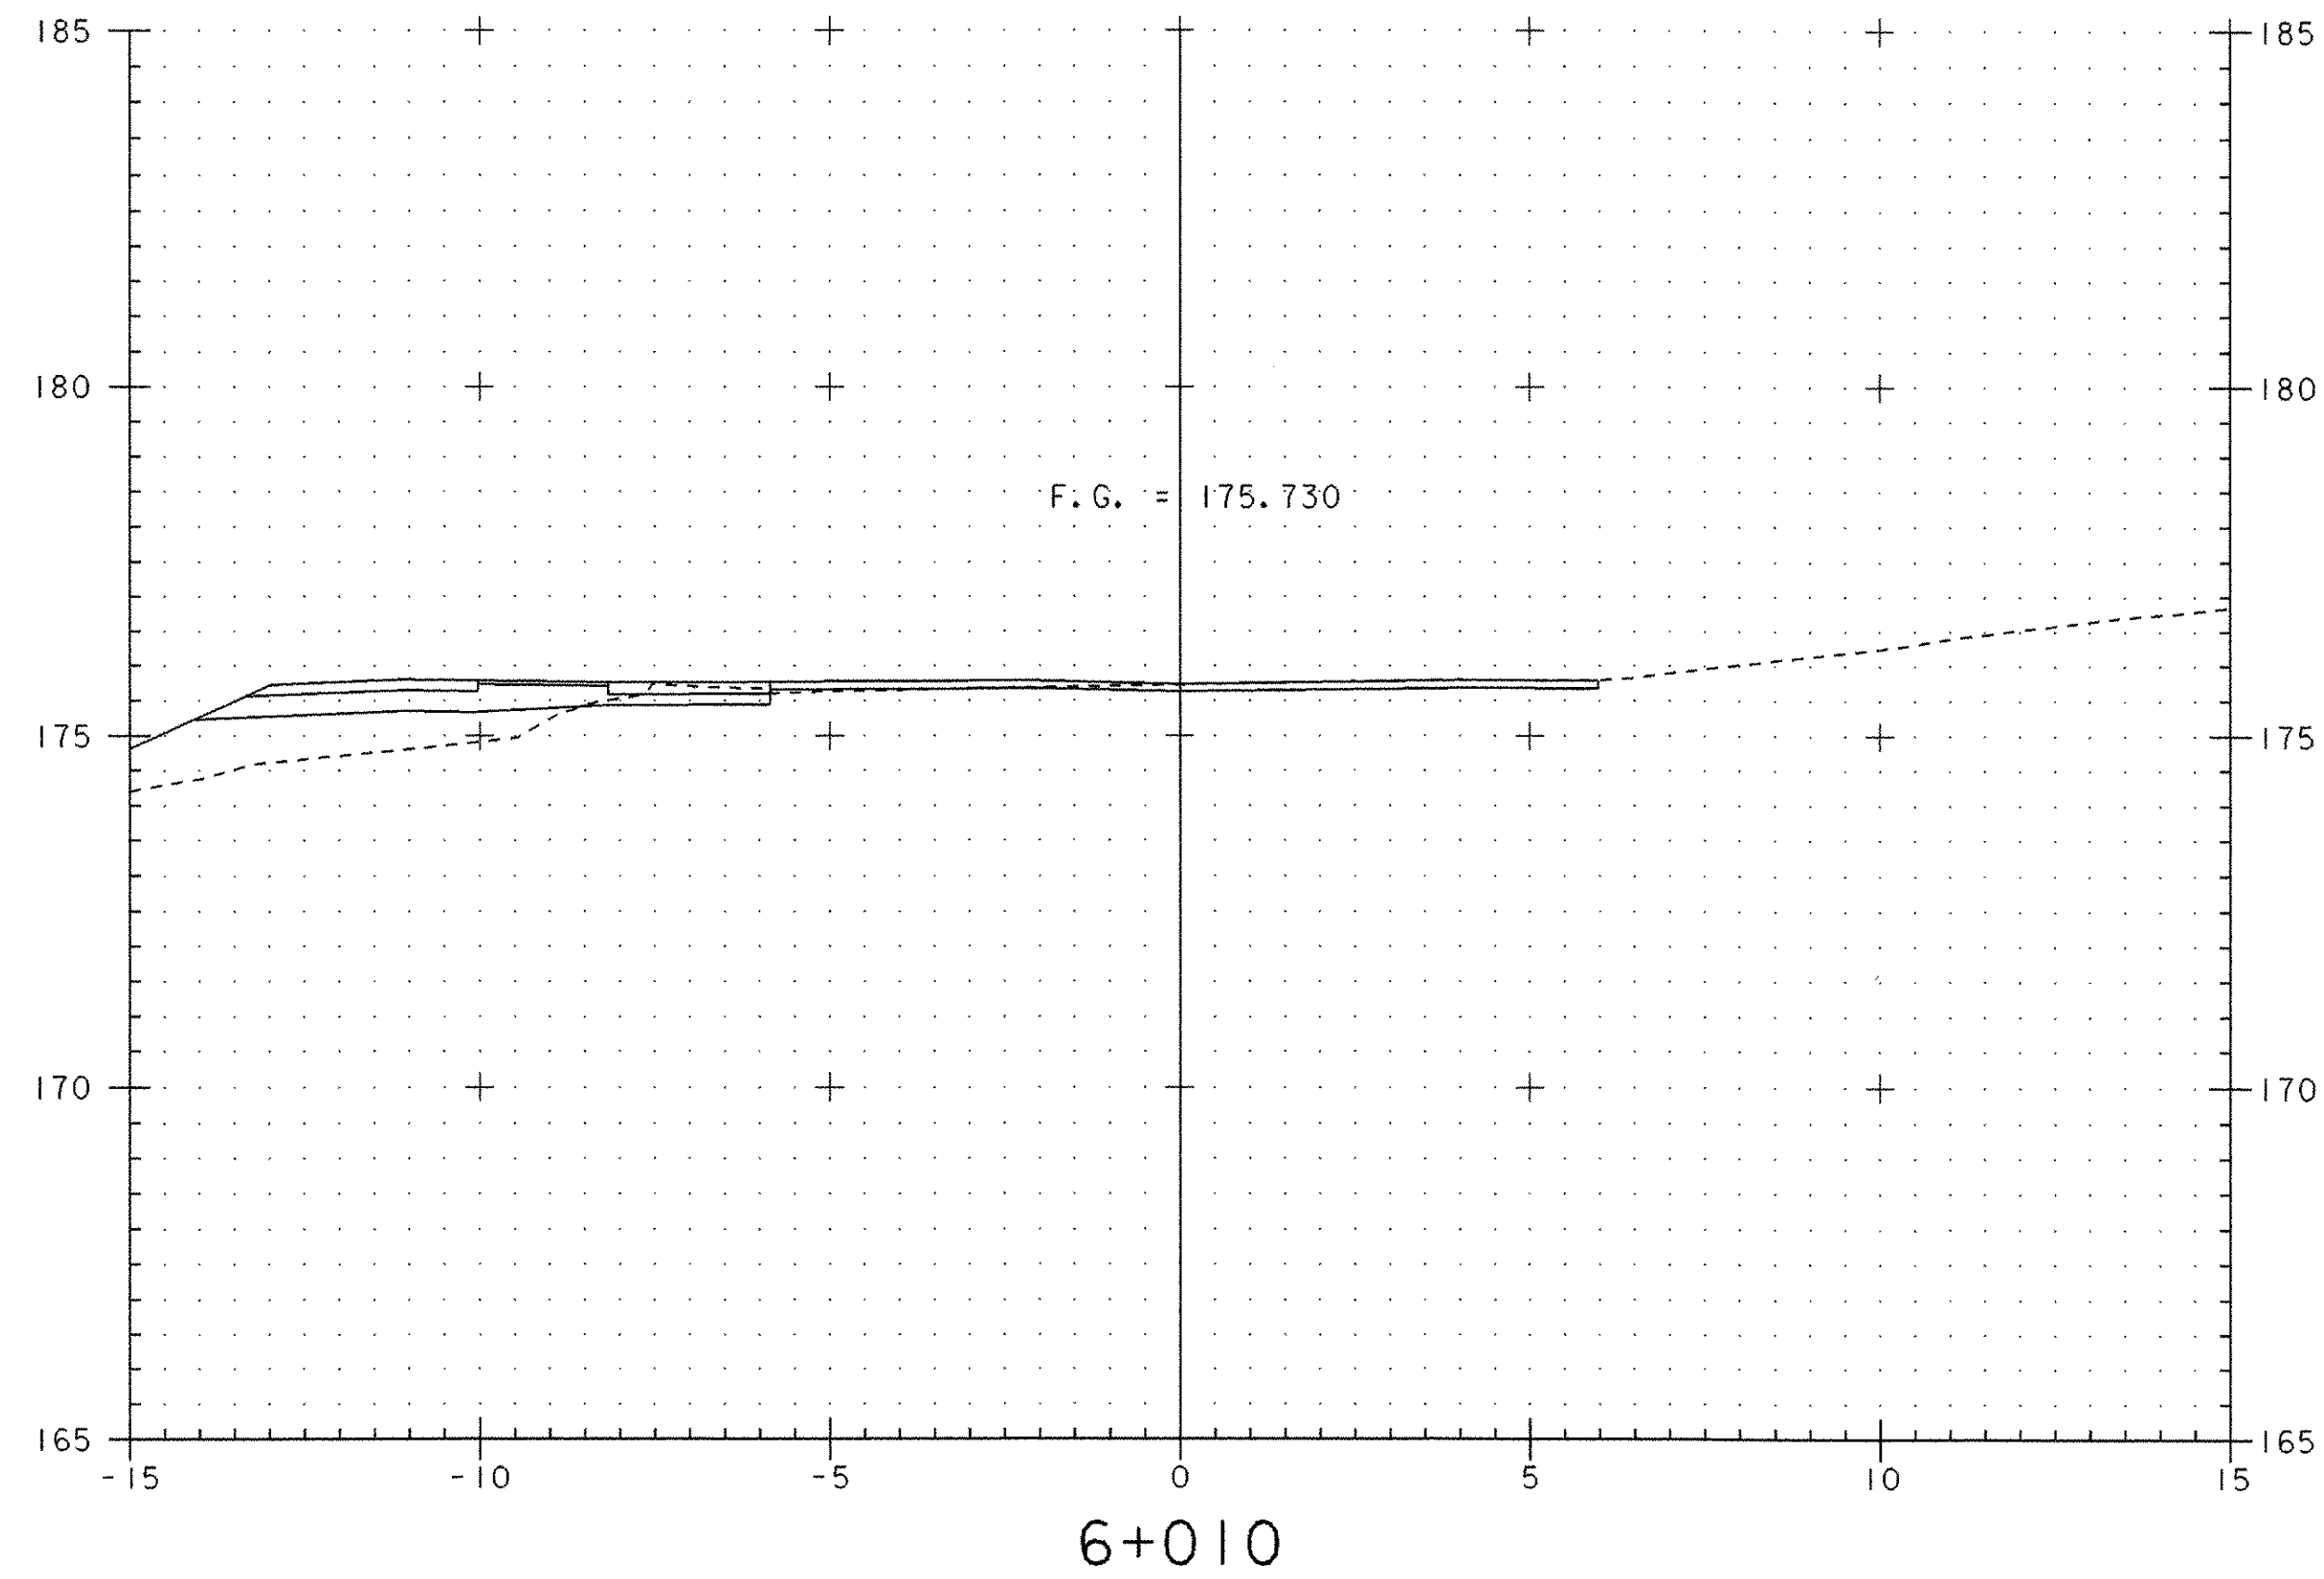






|                          |                                       |                  |                    |
|--------------------------|---------------------------------------|------------------|--------------------|
| PROJECT:                 | BETHEL                                | PROJECT NO. :    | BRF 0241 (33) - C1 |
| DESIGN FILE NAME:        | s96j250/structures/s96j250xsec-cl.dgn | IPARM FILE NAME: | s96j250xth51.i     |
| TH5 Cross Sections       |                                       | PLOT DATE:       | 09-JUL-2003        |
| STA 6+000 THRU STA 6+030 |                                       | SHEET:           | 39 OF 47           |



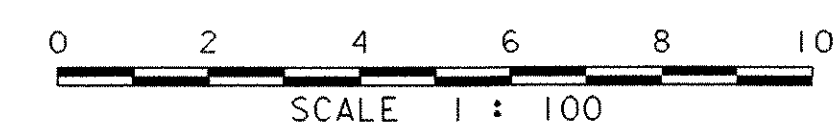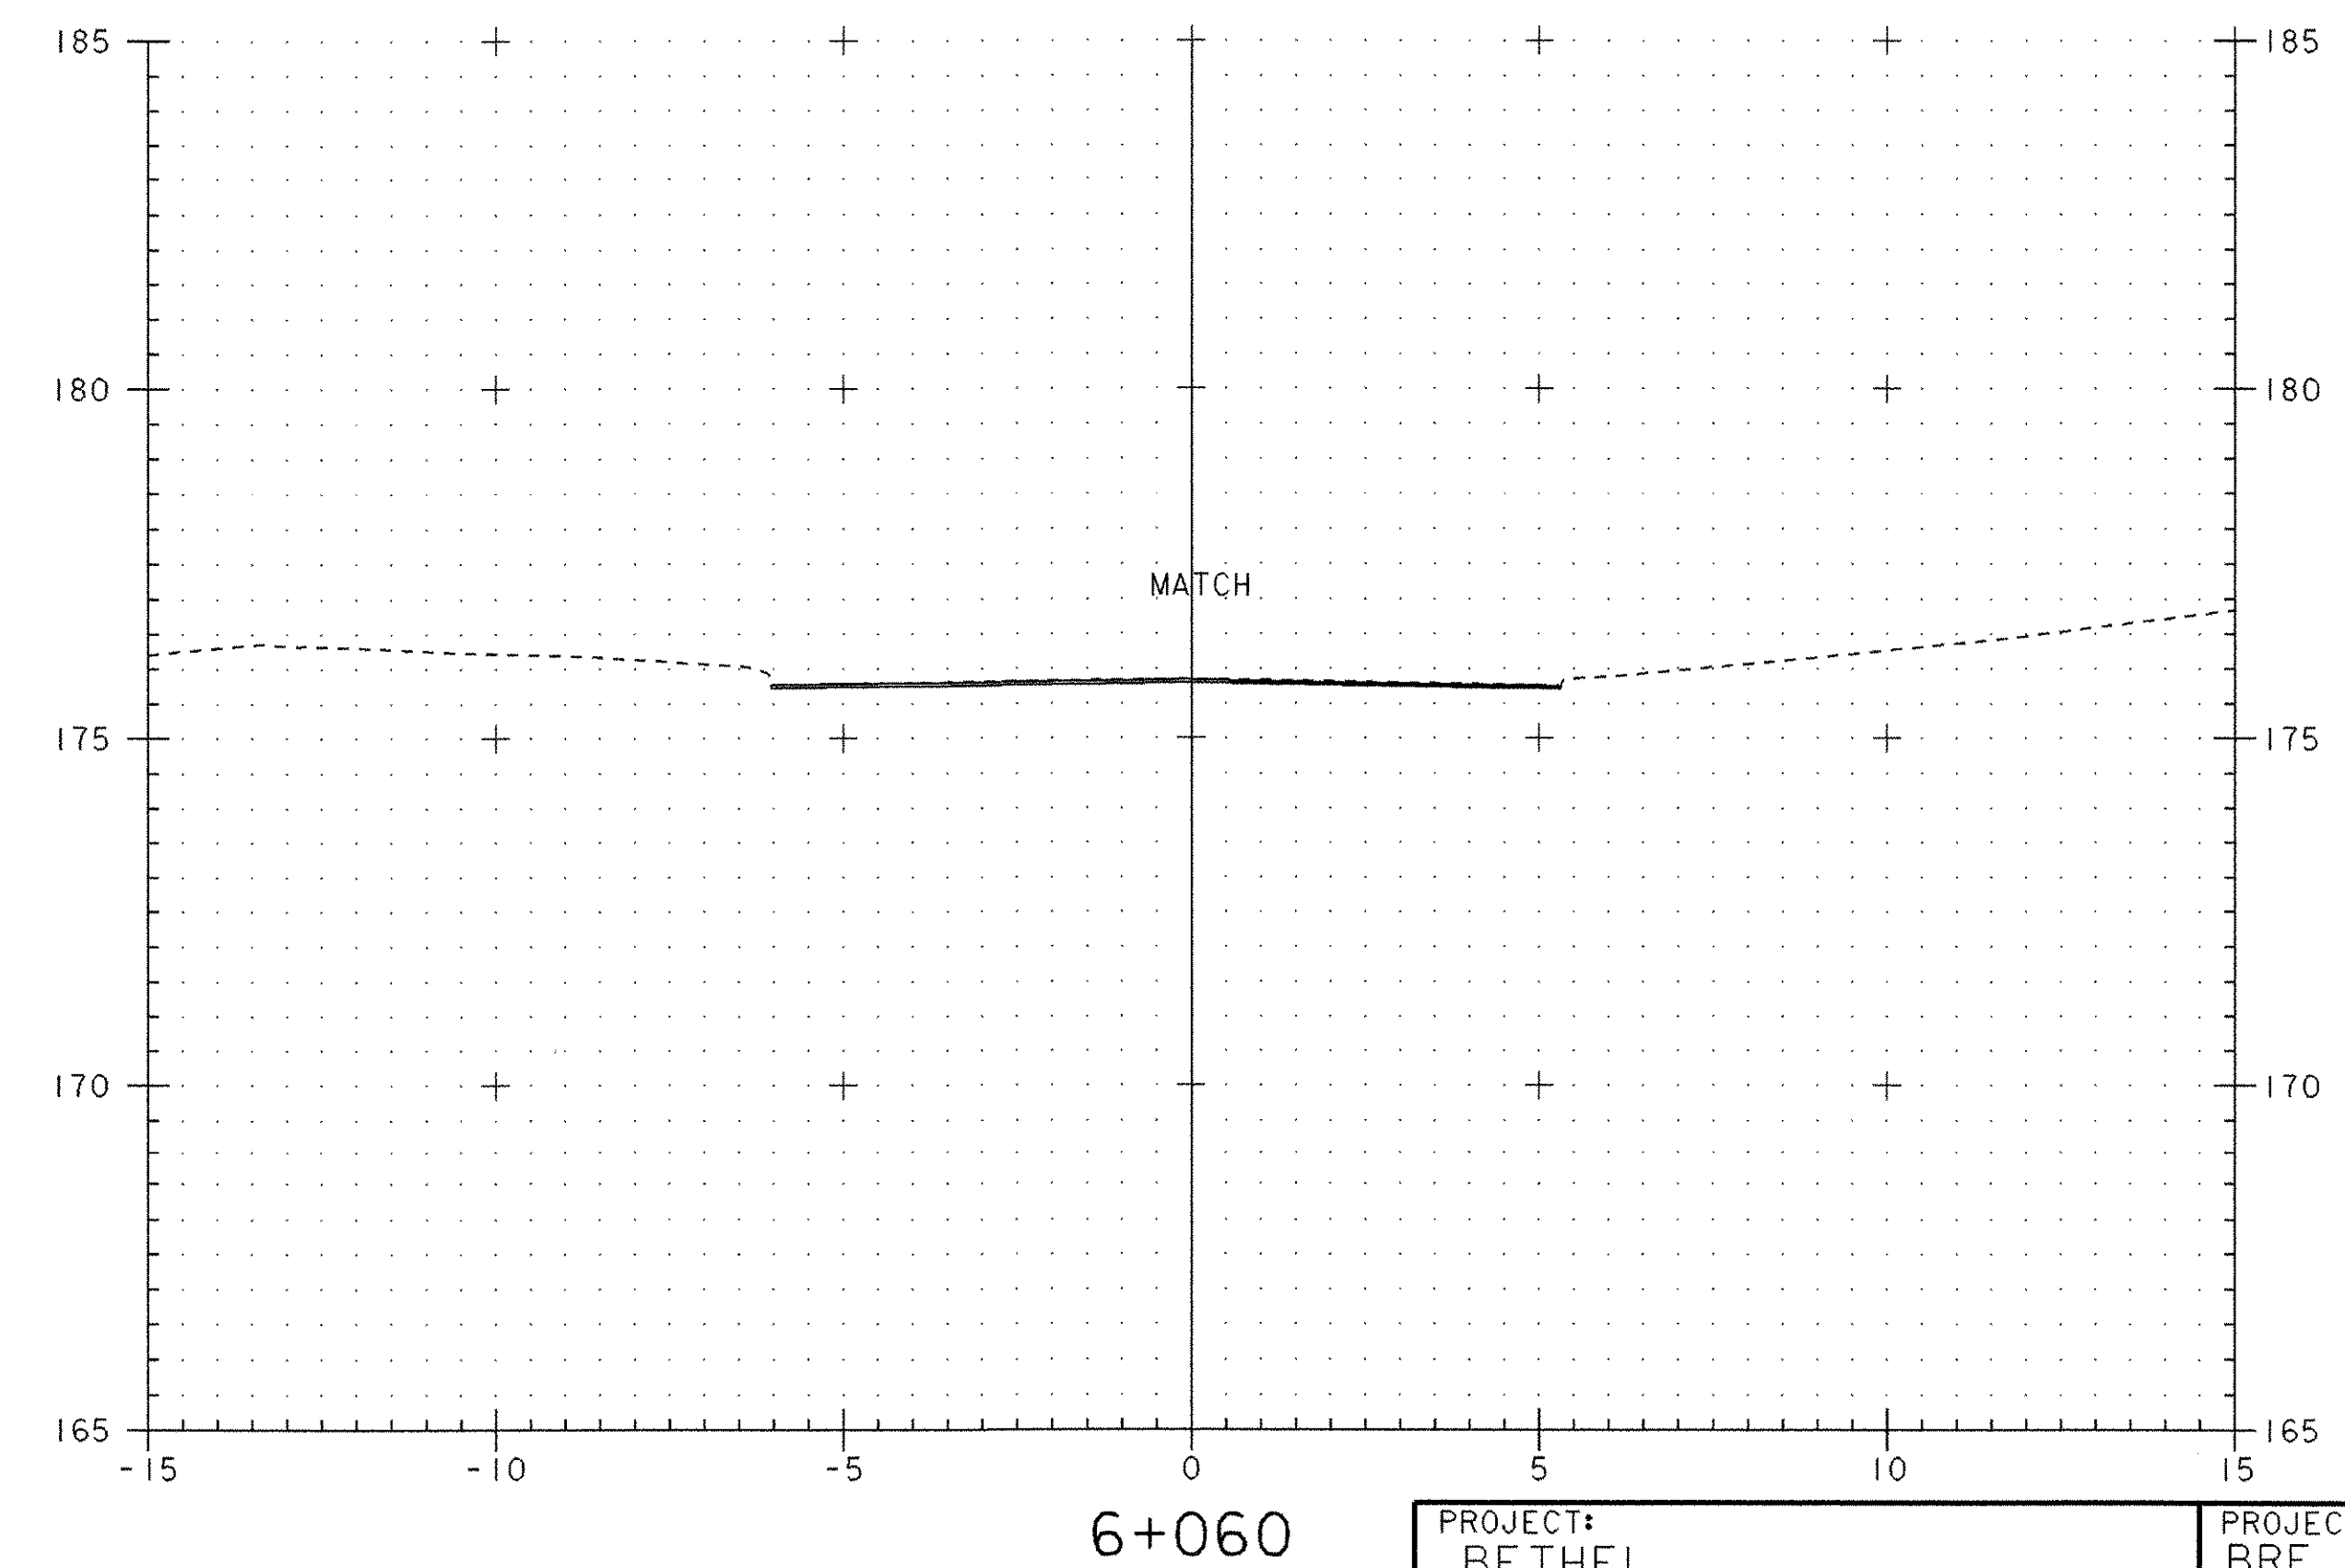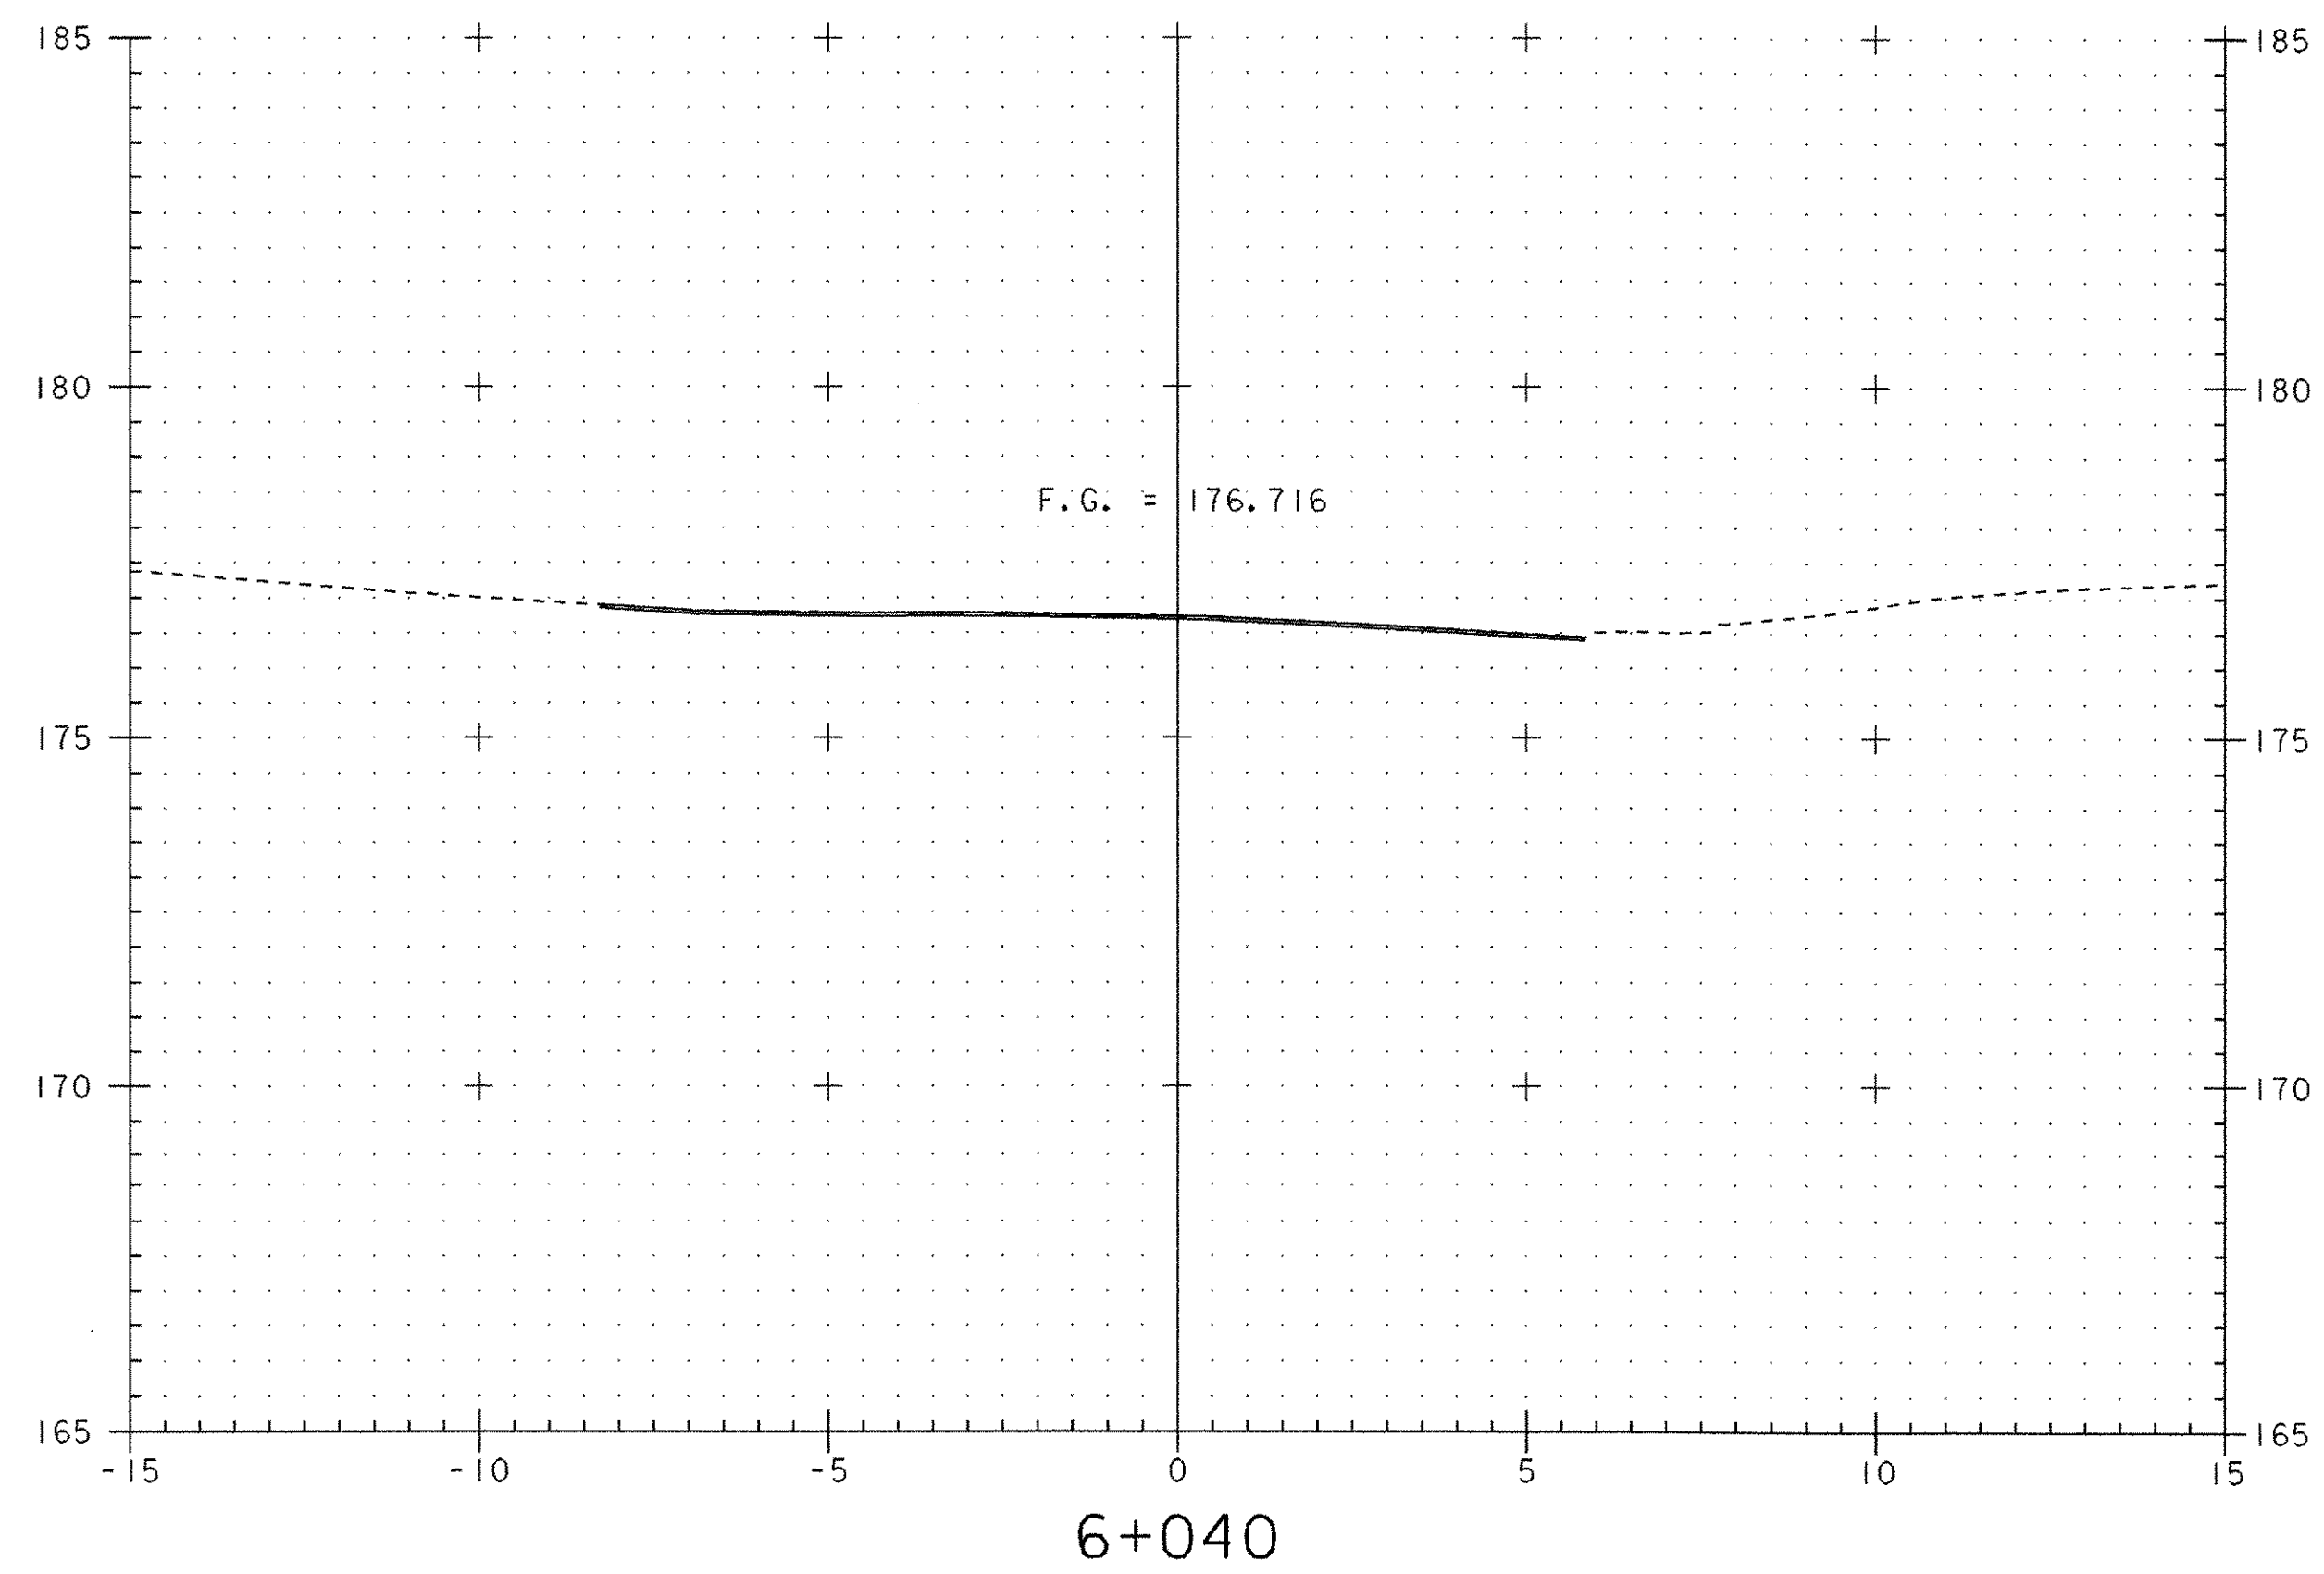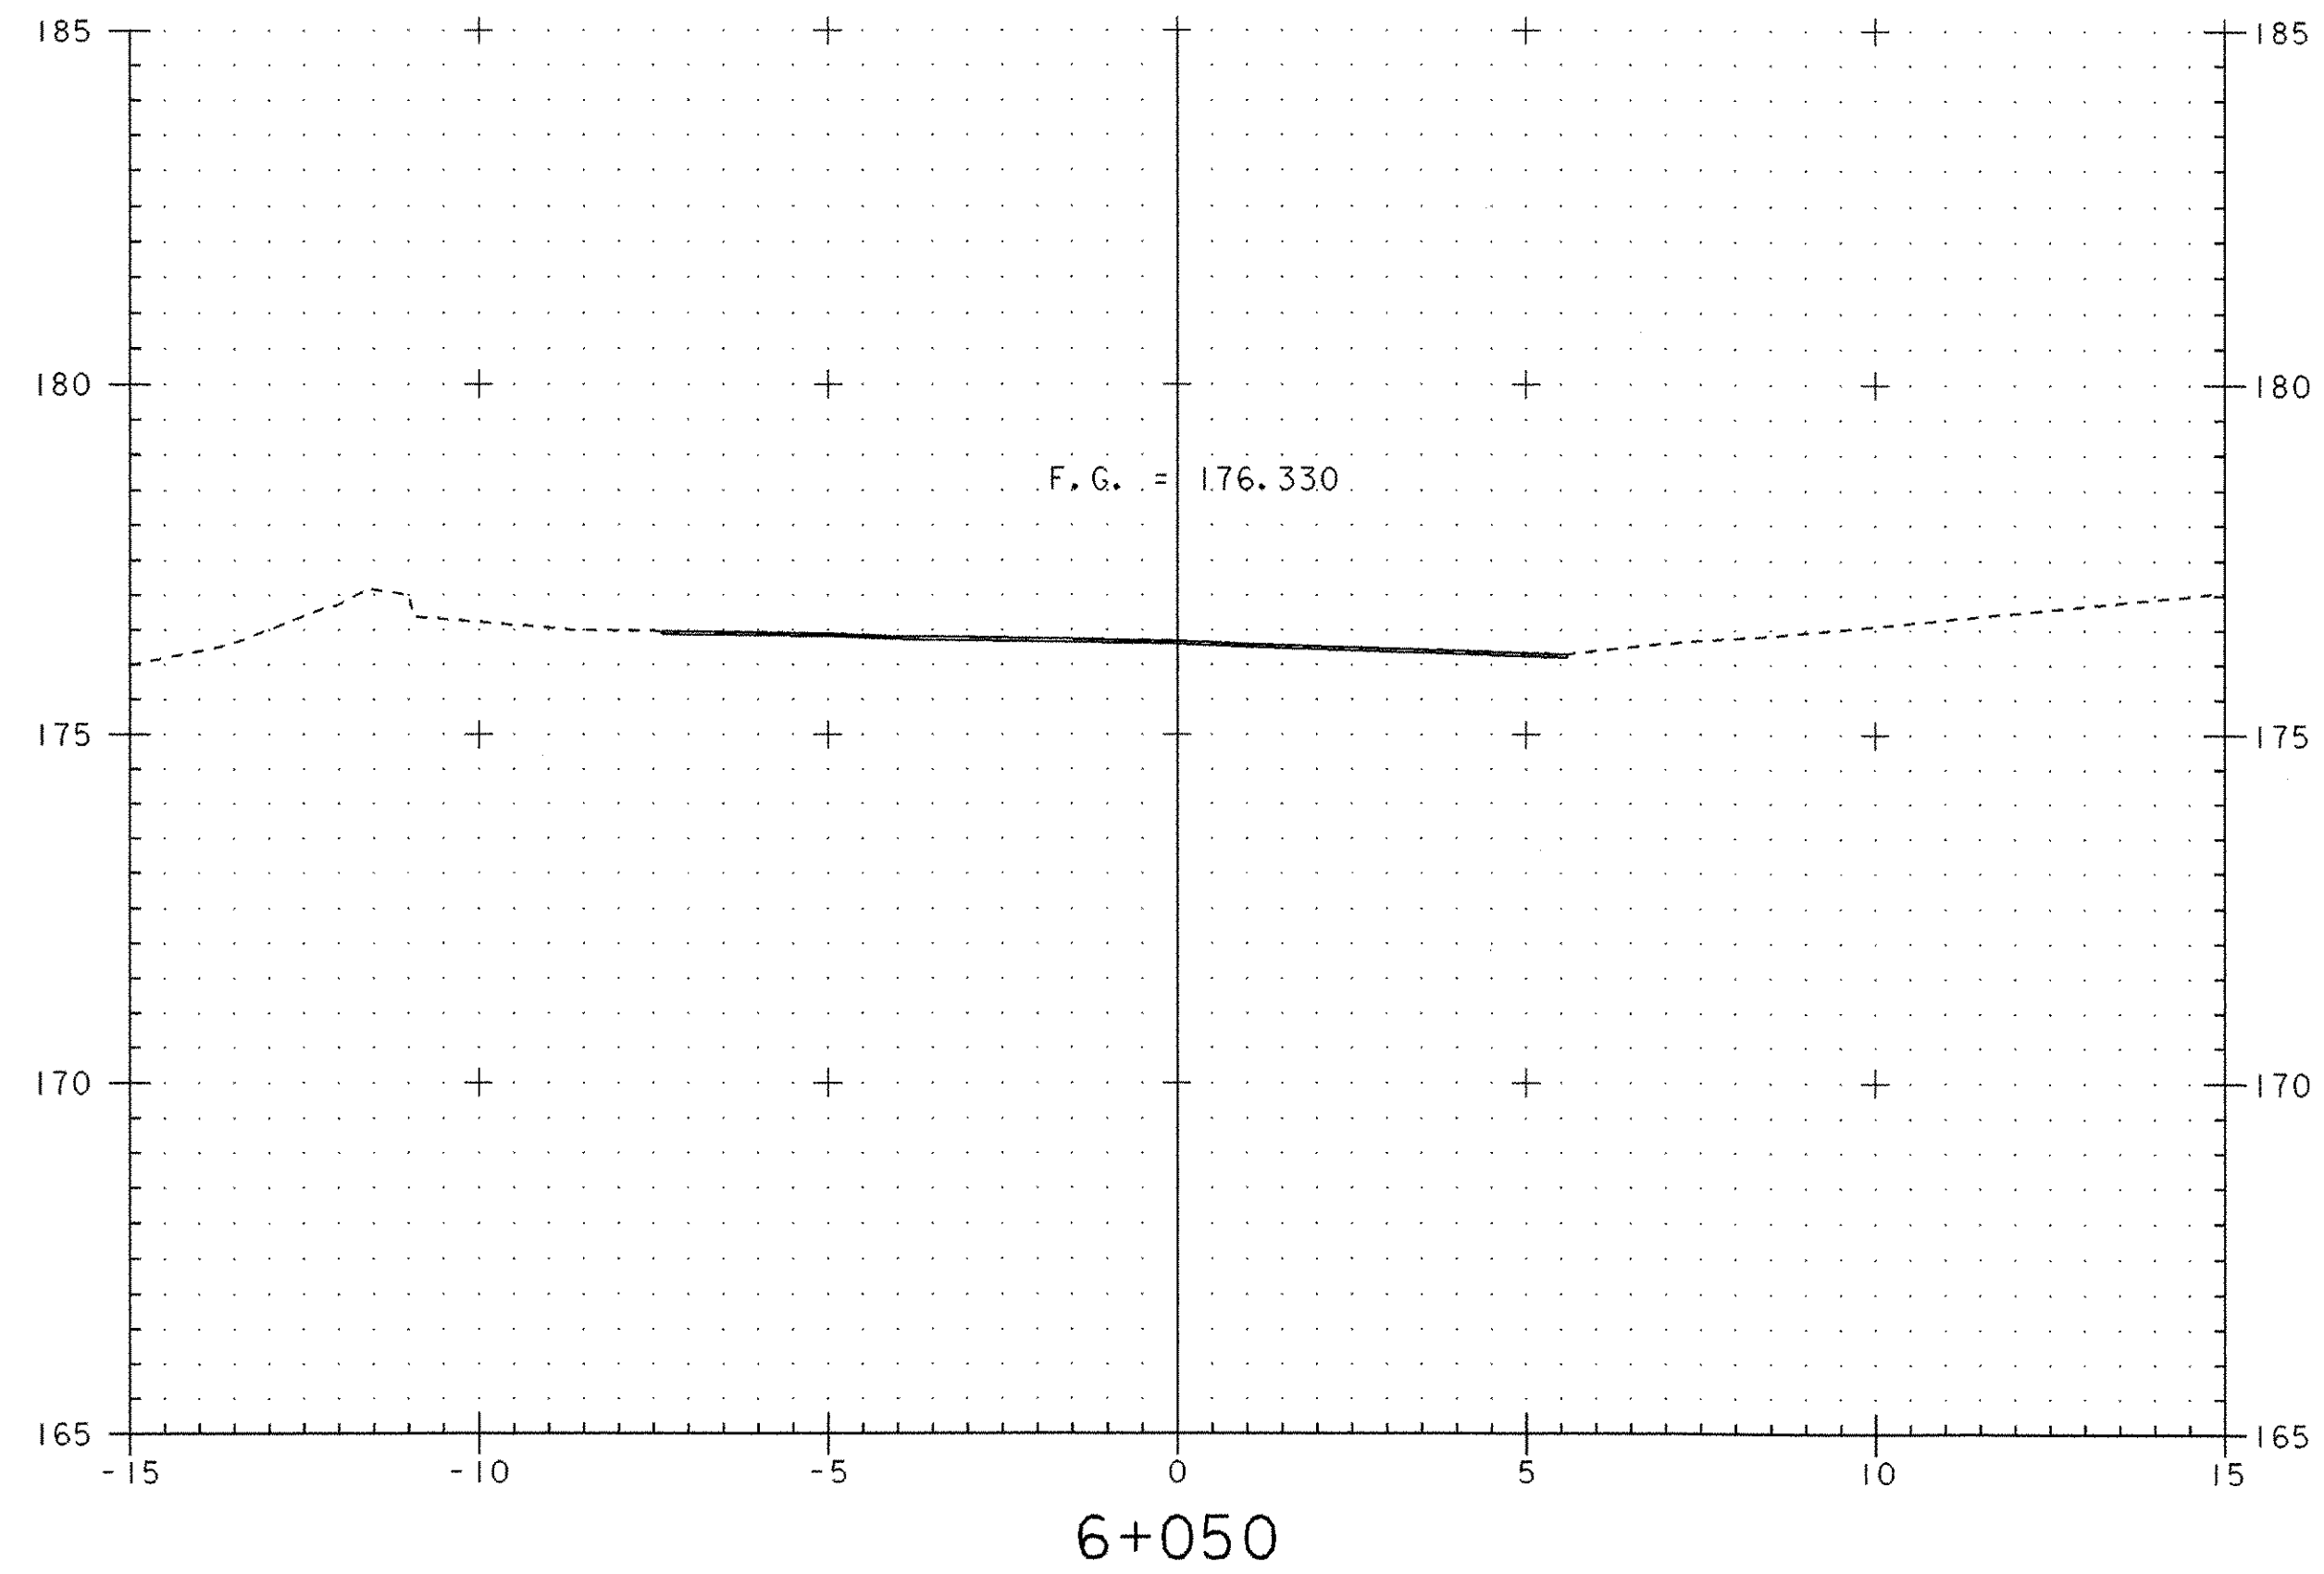





|                                                        |                        |
|--------------------------------------------------------|------------------------|
| PROJECT:                                               | PROJECT NO. :          |
| BETHEL                                                 | BRF 0241 (33) - C1     |
| DESIGN FILE NAME: 96j250/structures/s96j250xsec-cl.dgn |                        |
| IPARM FILE NAME: s96j250xth52.i                        | PLOT DATE: 09-JUL-2003 |
| TH5 Cross Sections                                     |                        |
| STA 6+040 THRU STA 6+060                               | SHEET: 40 OF 47        |



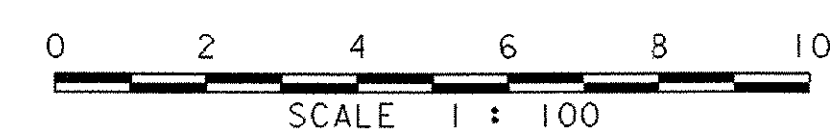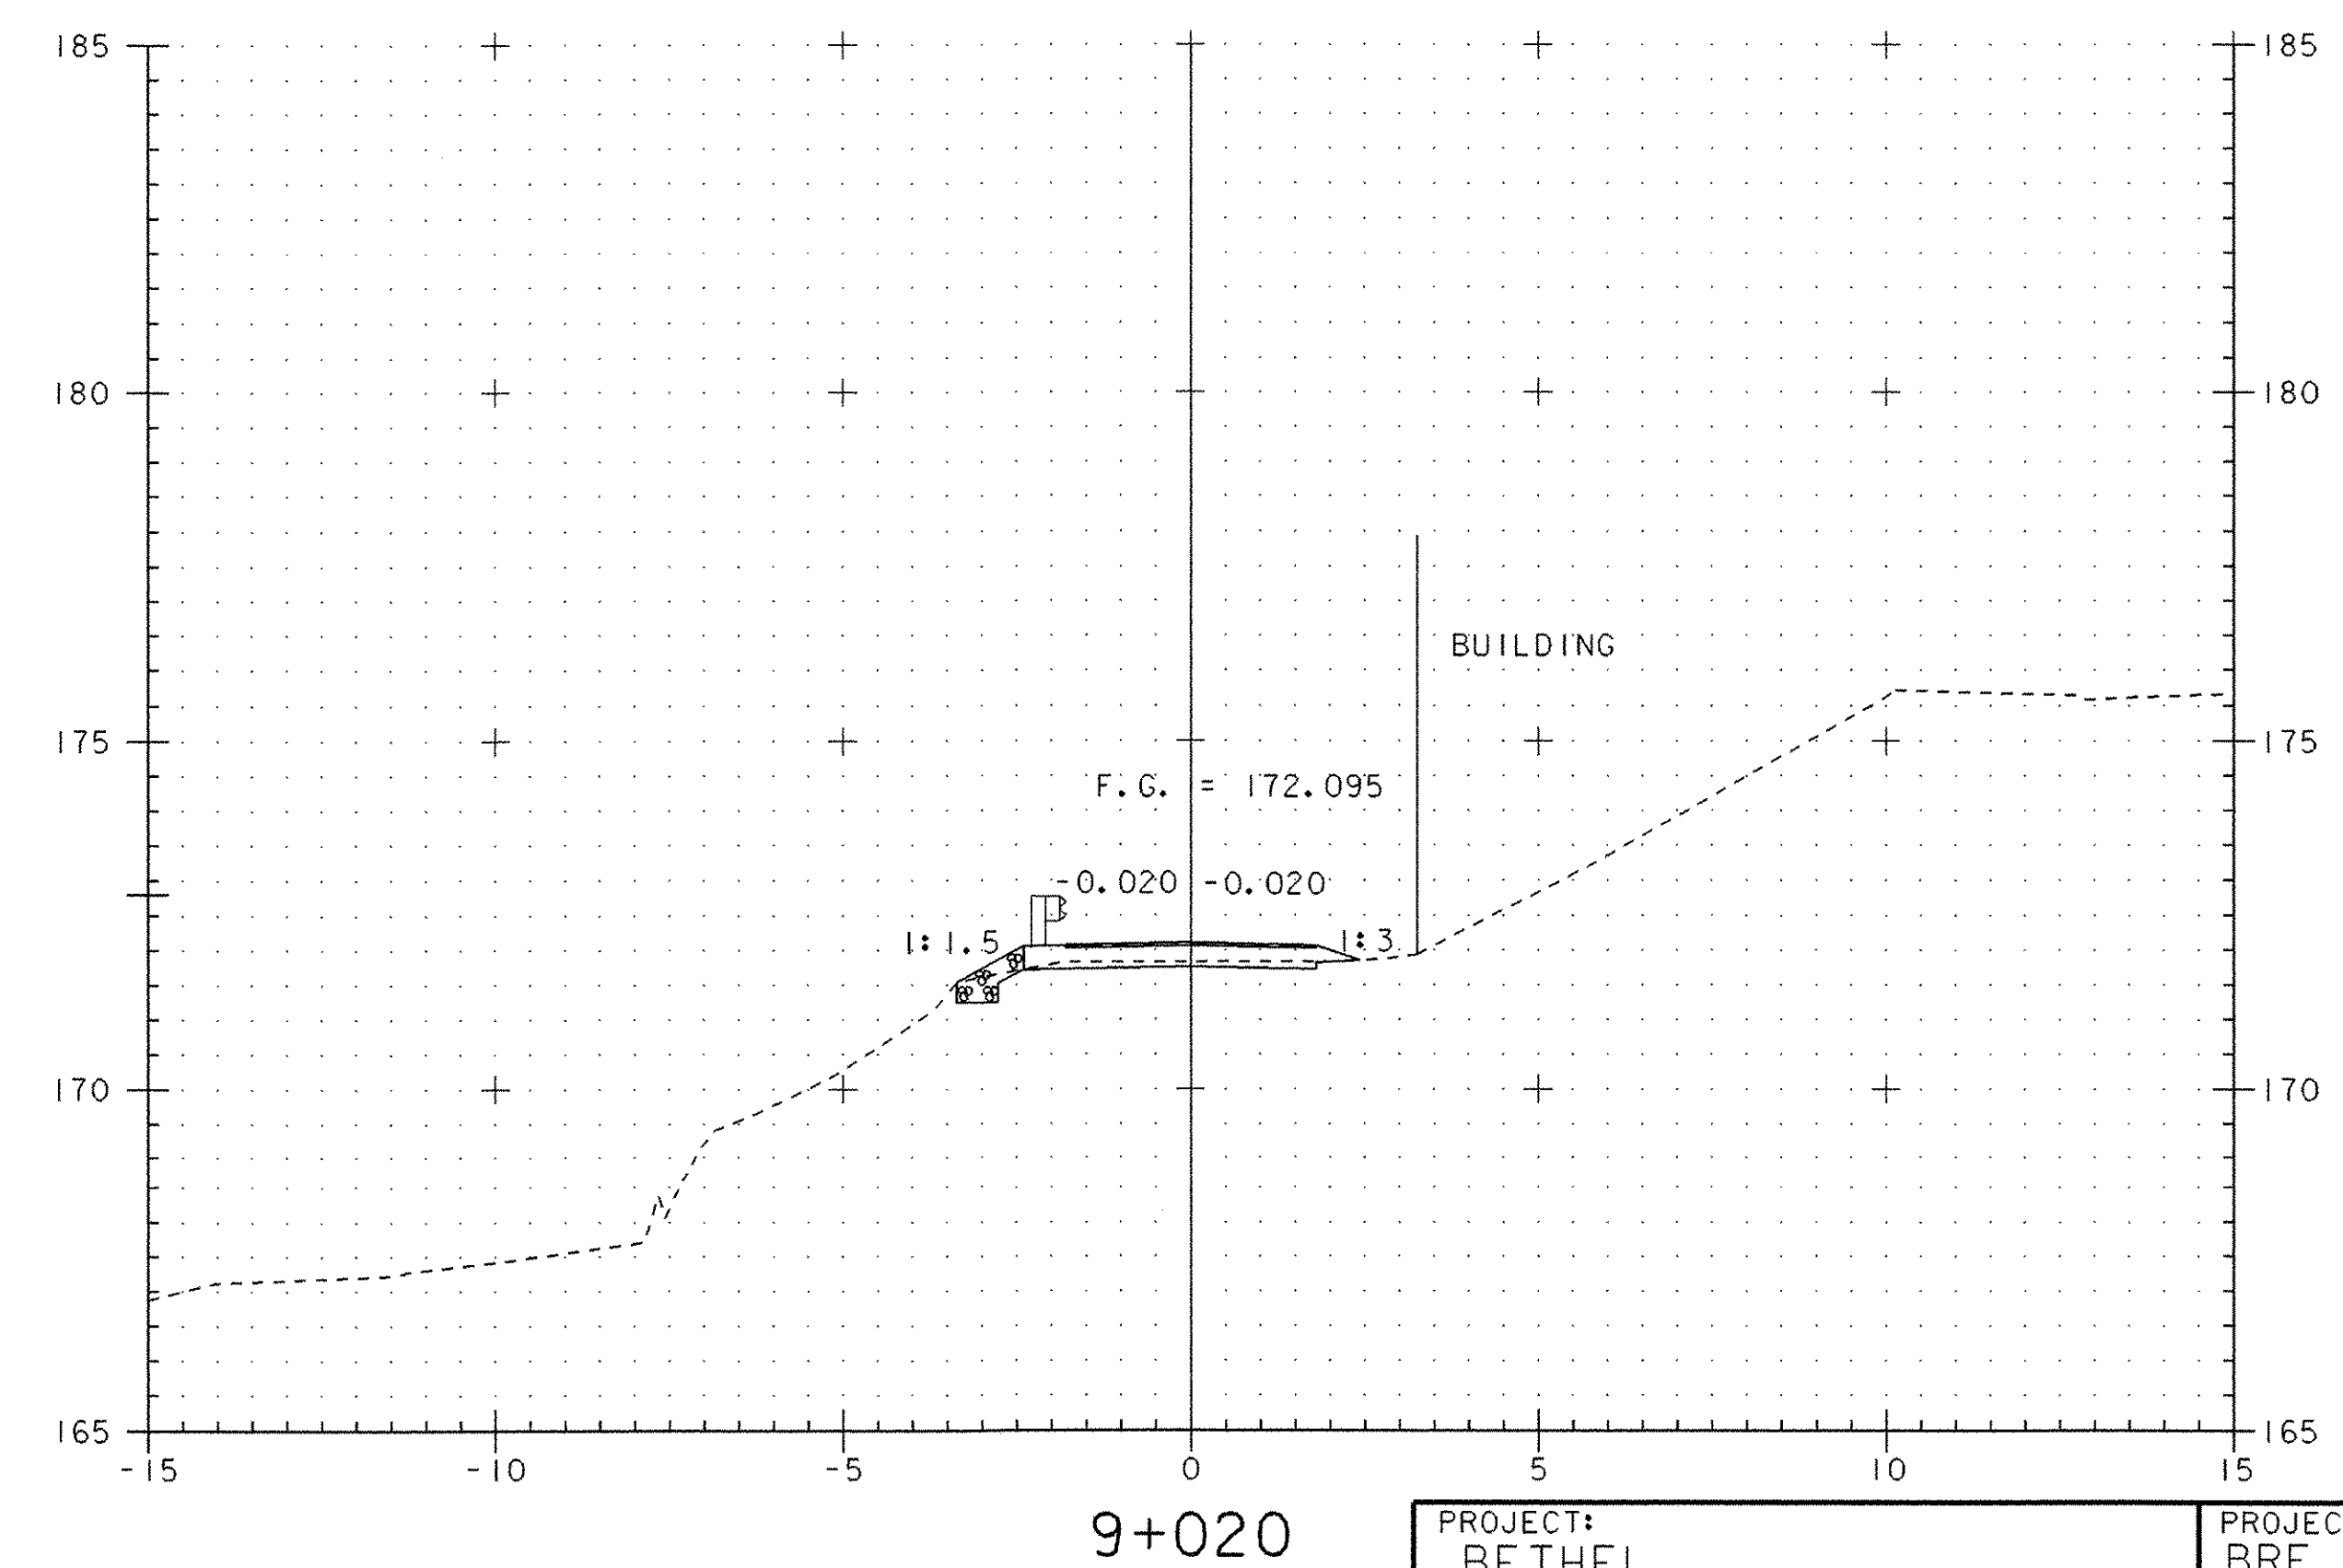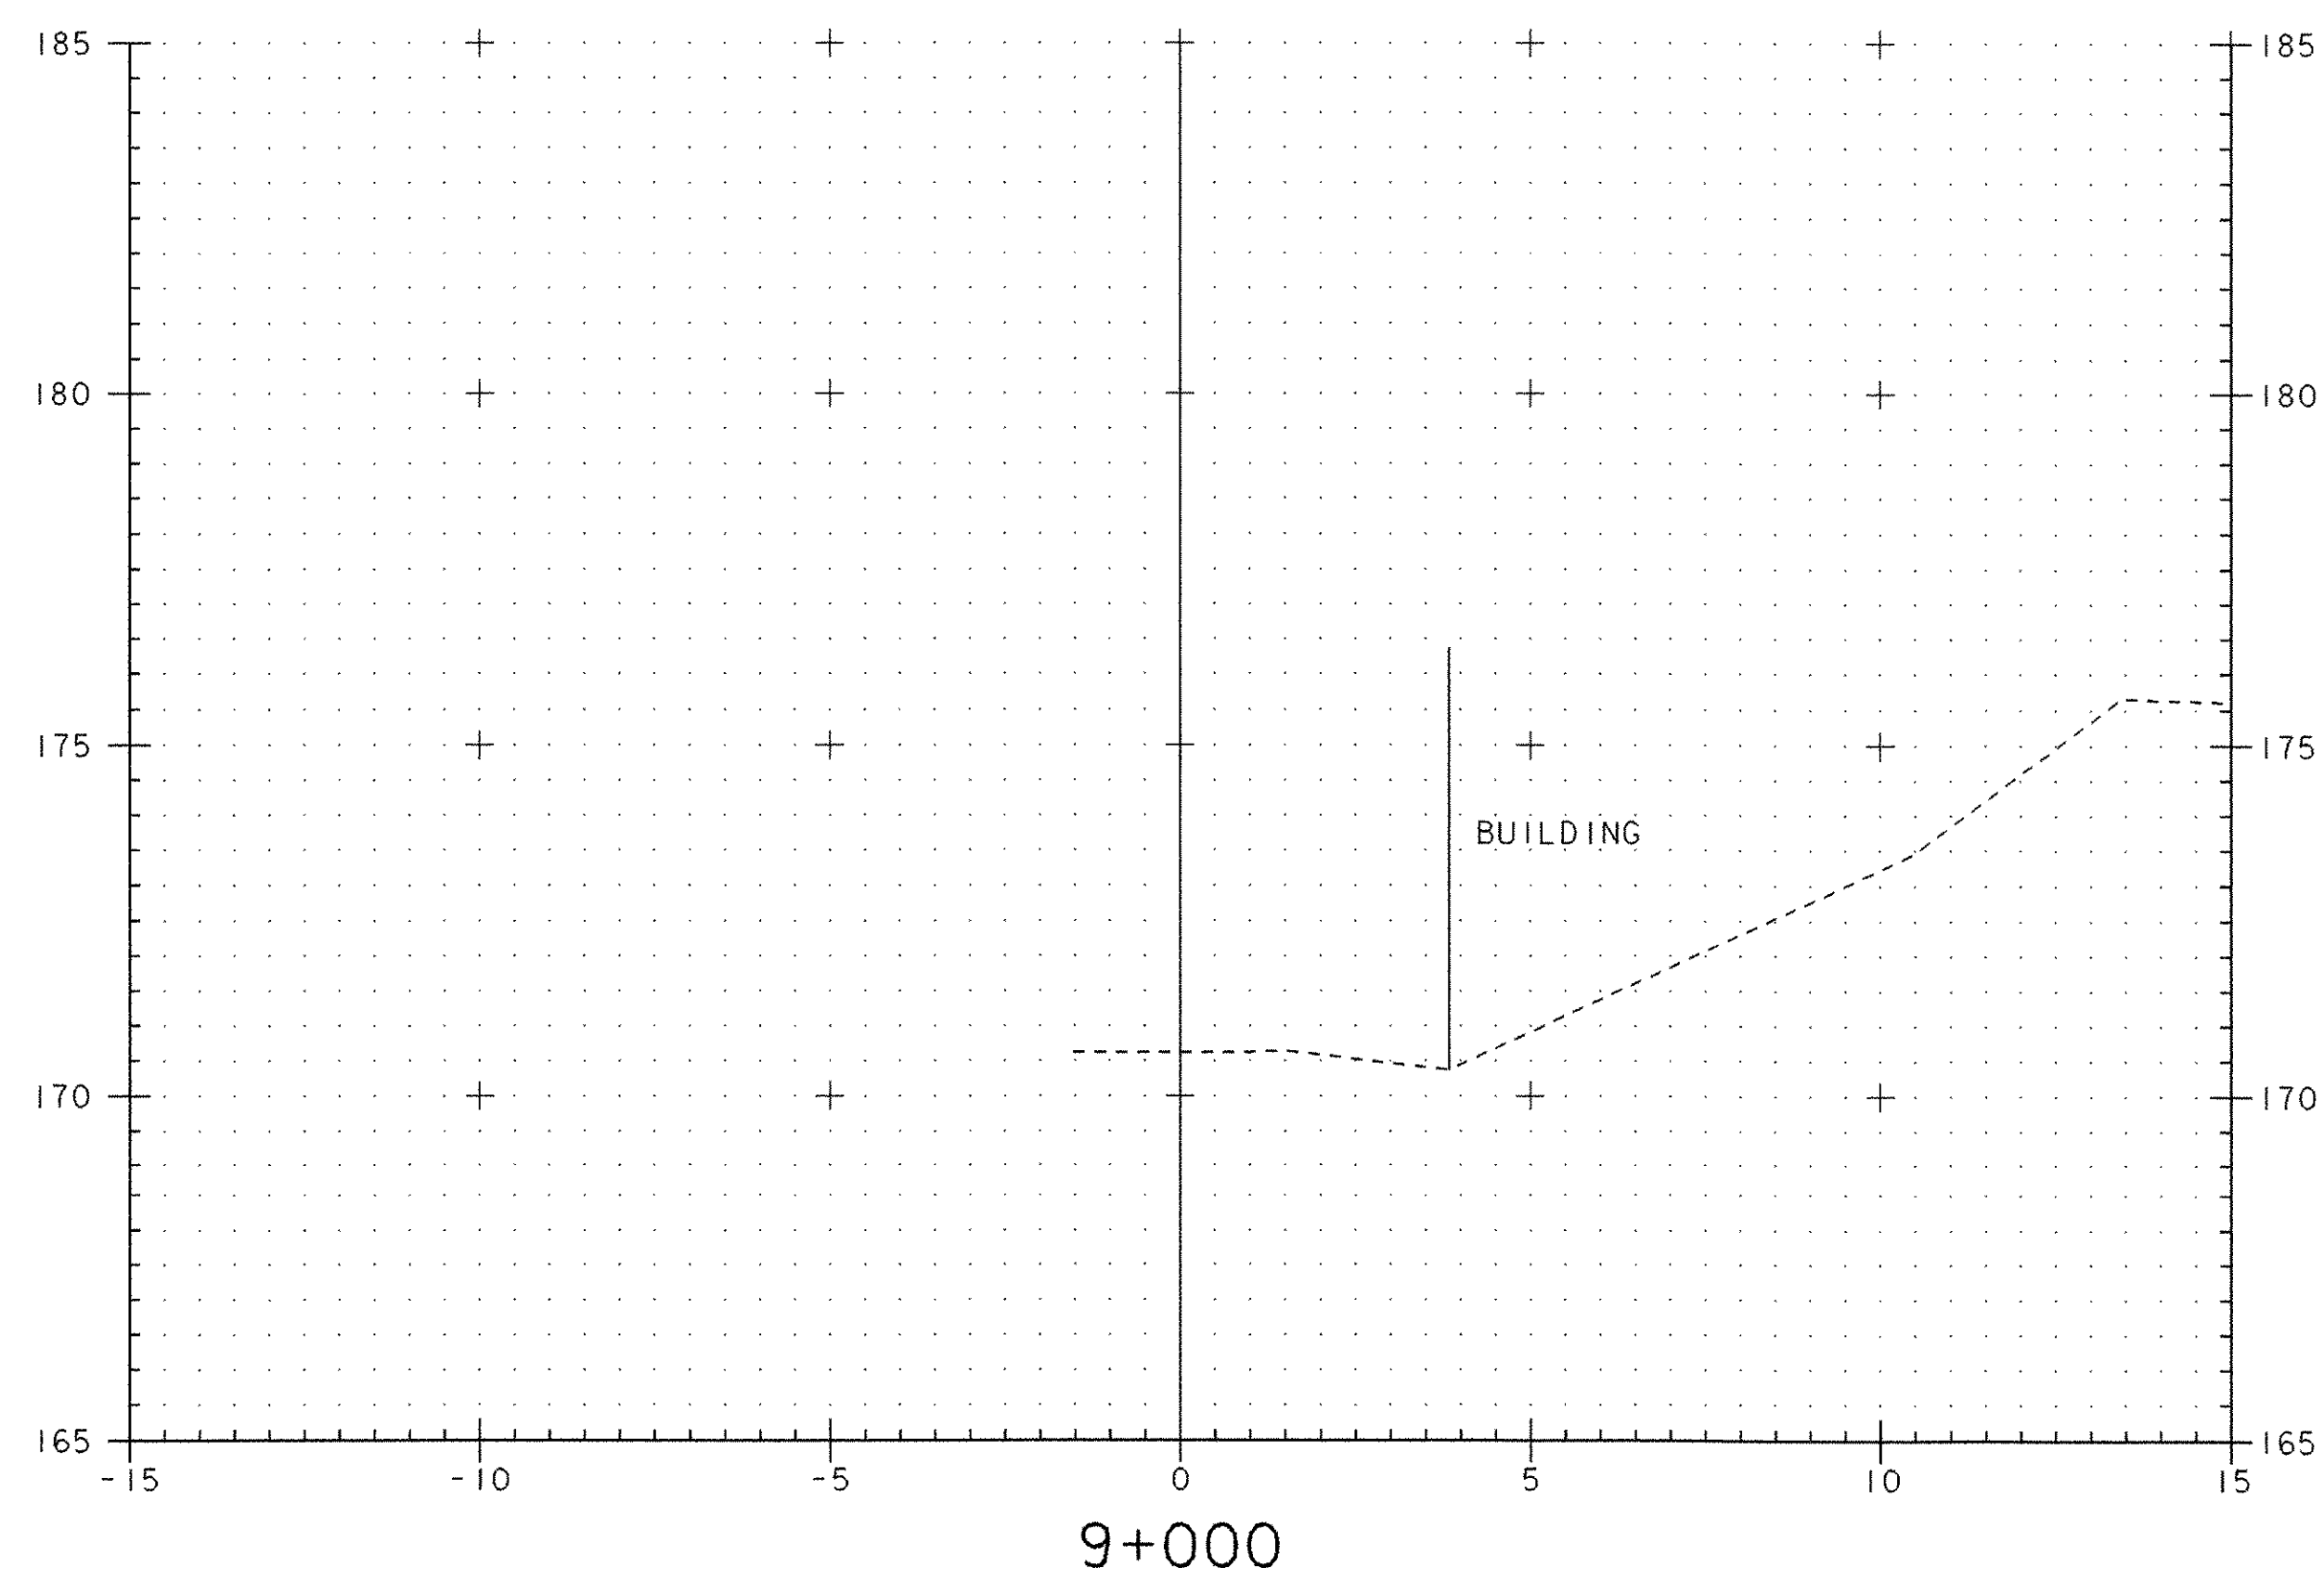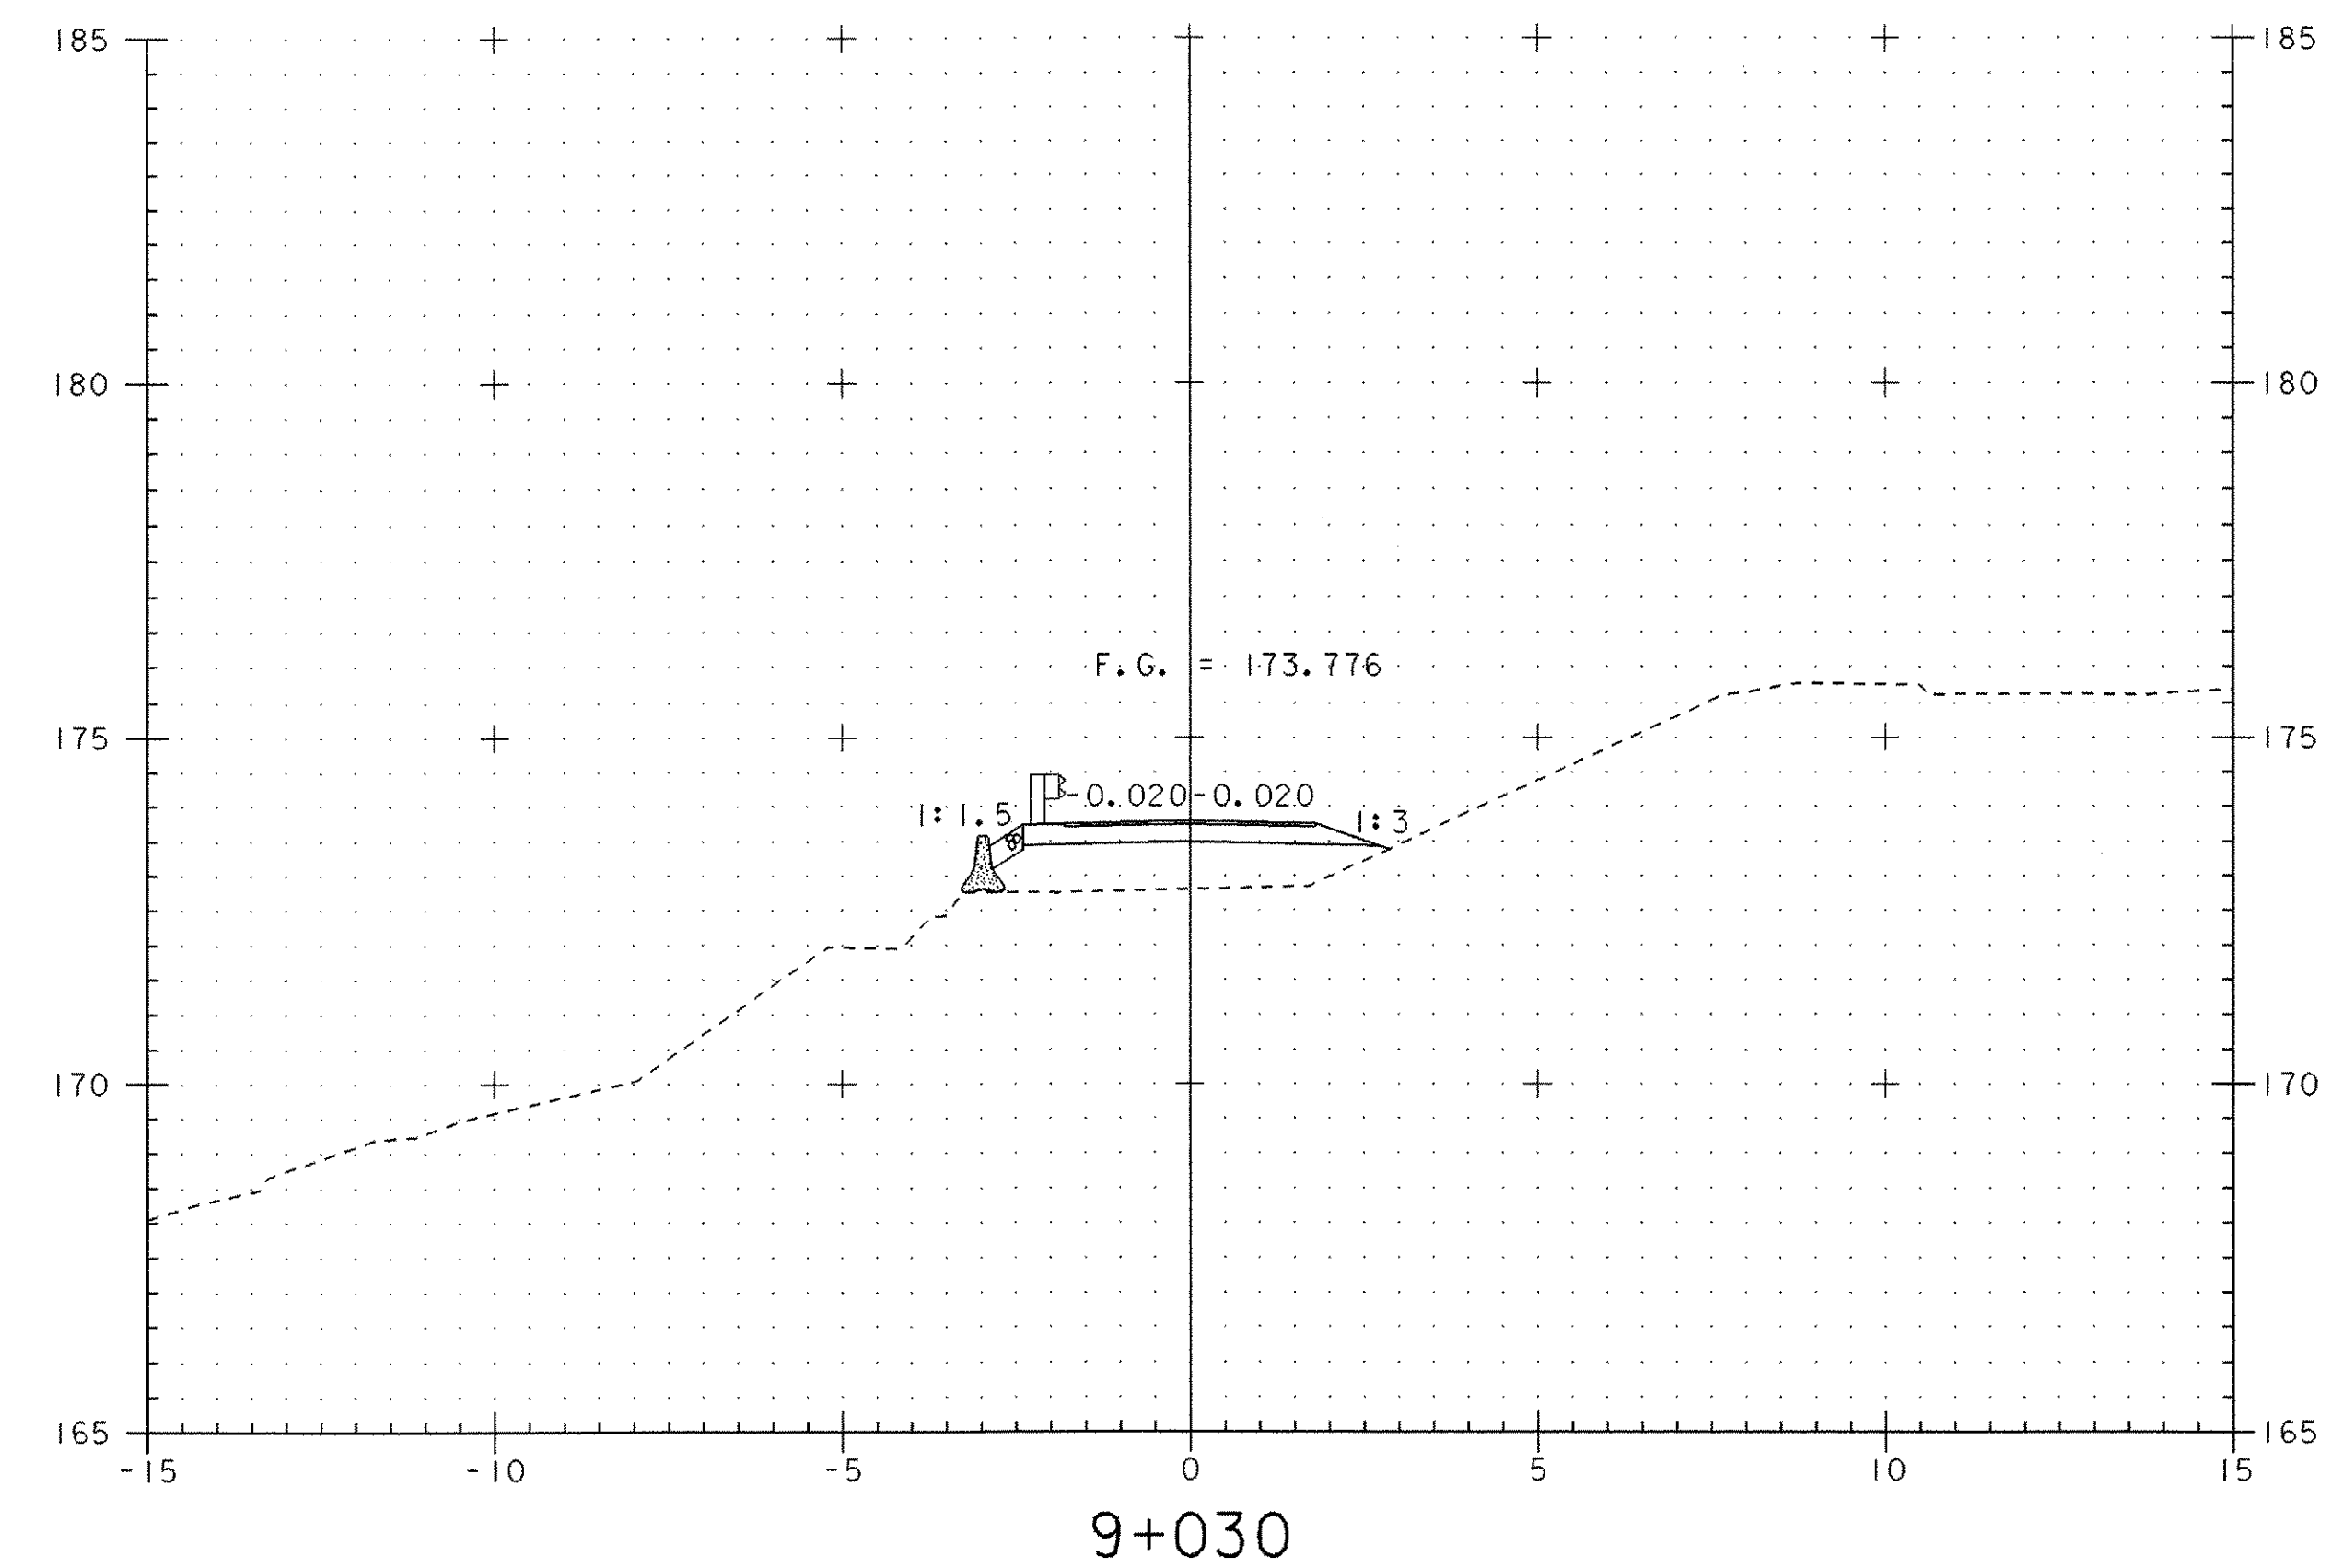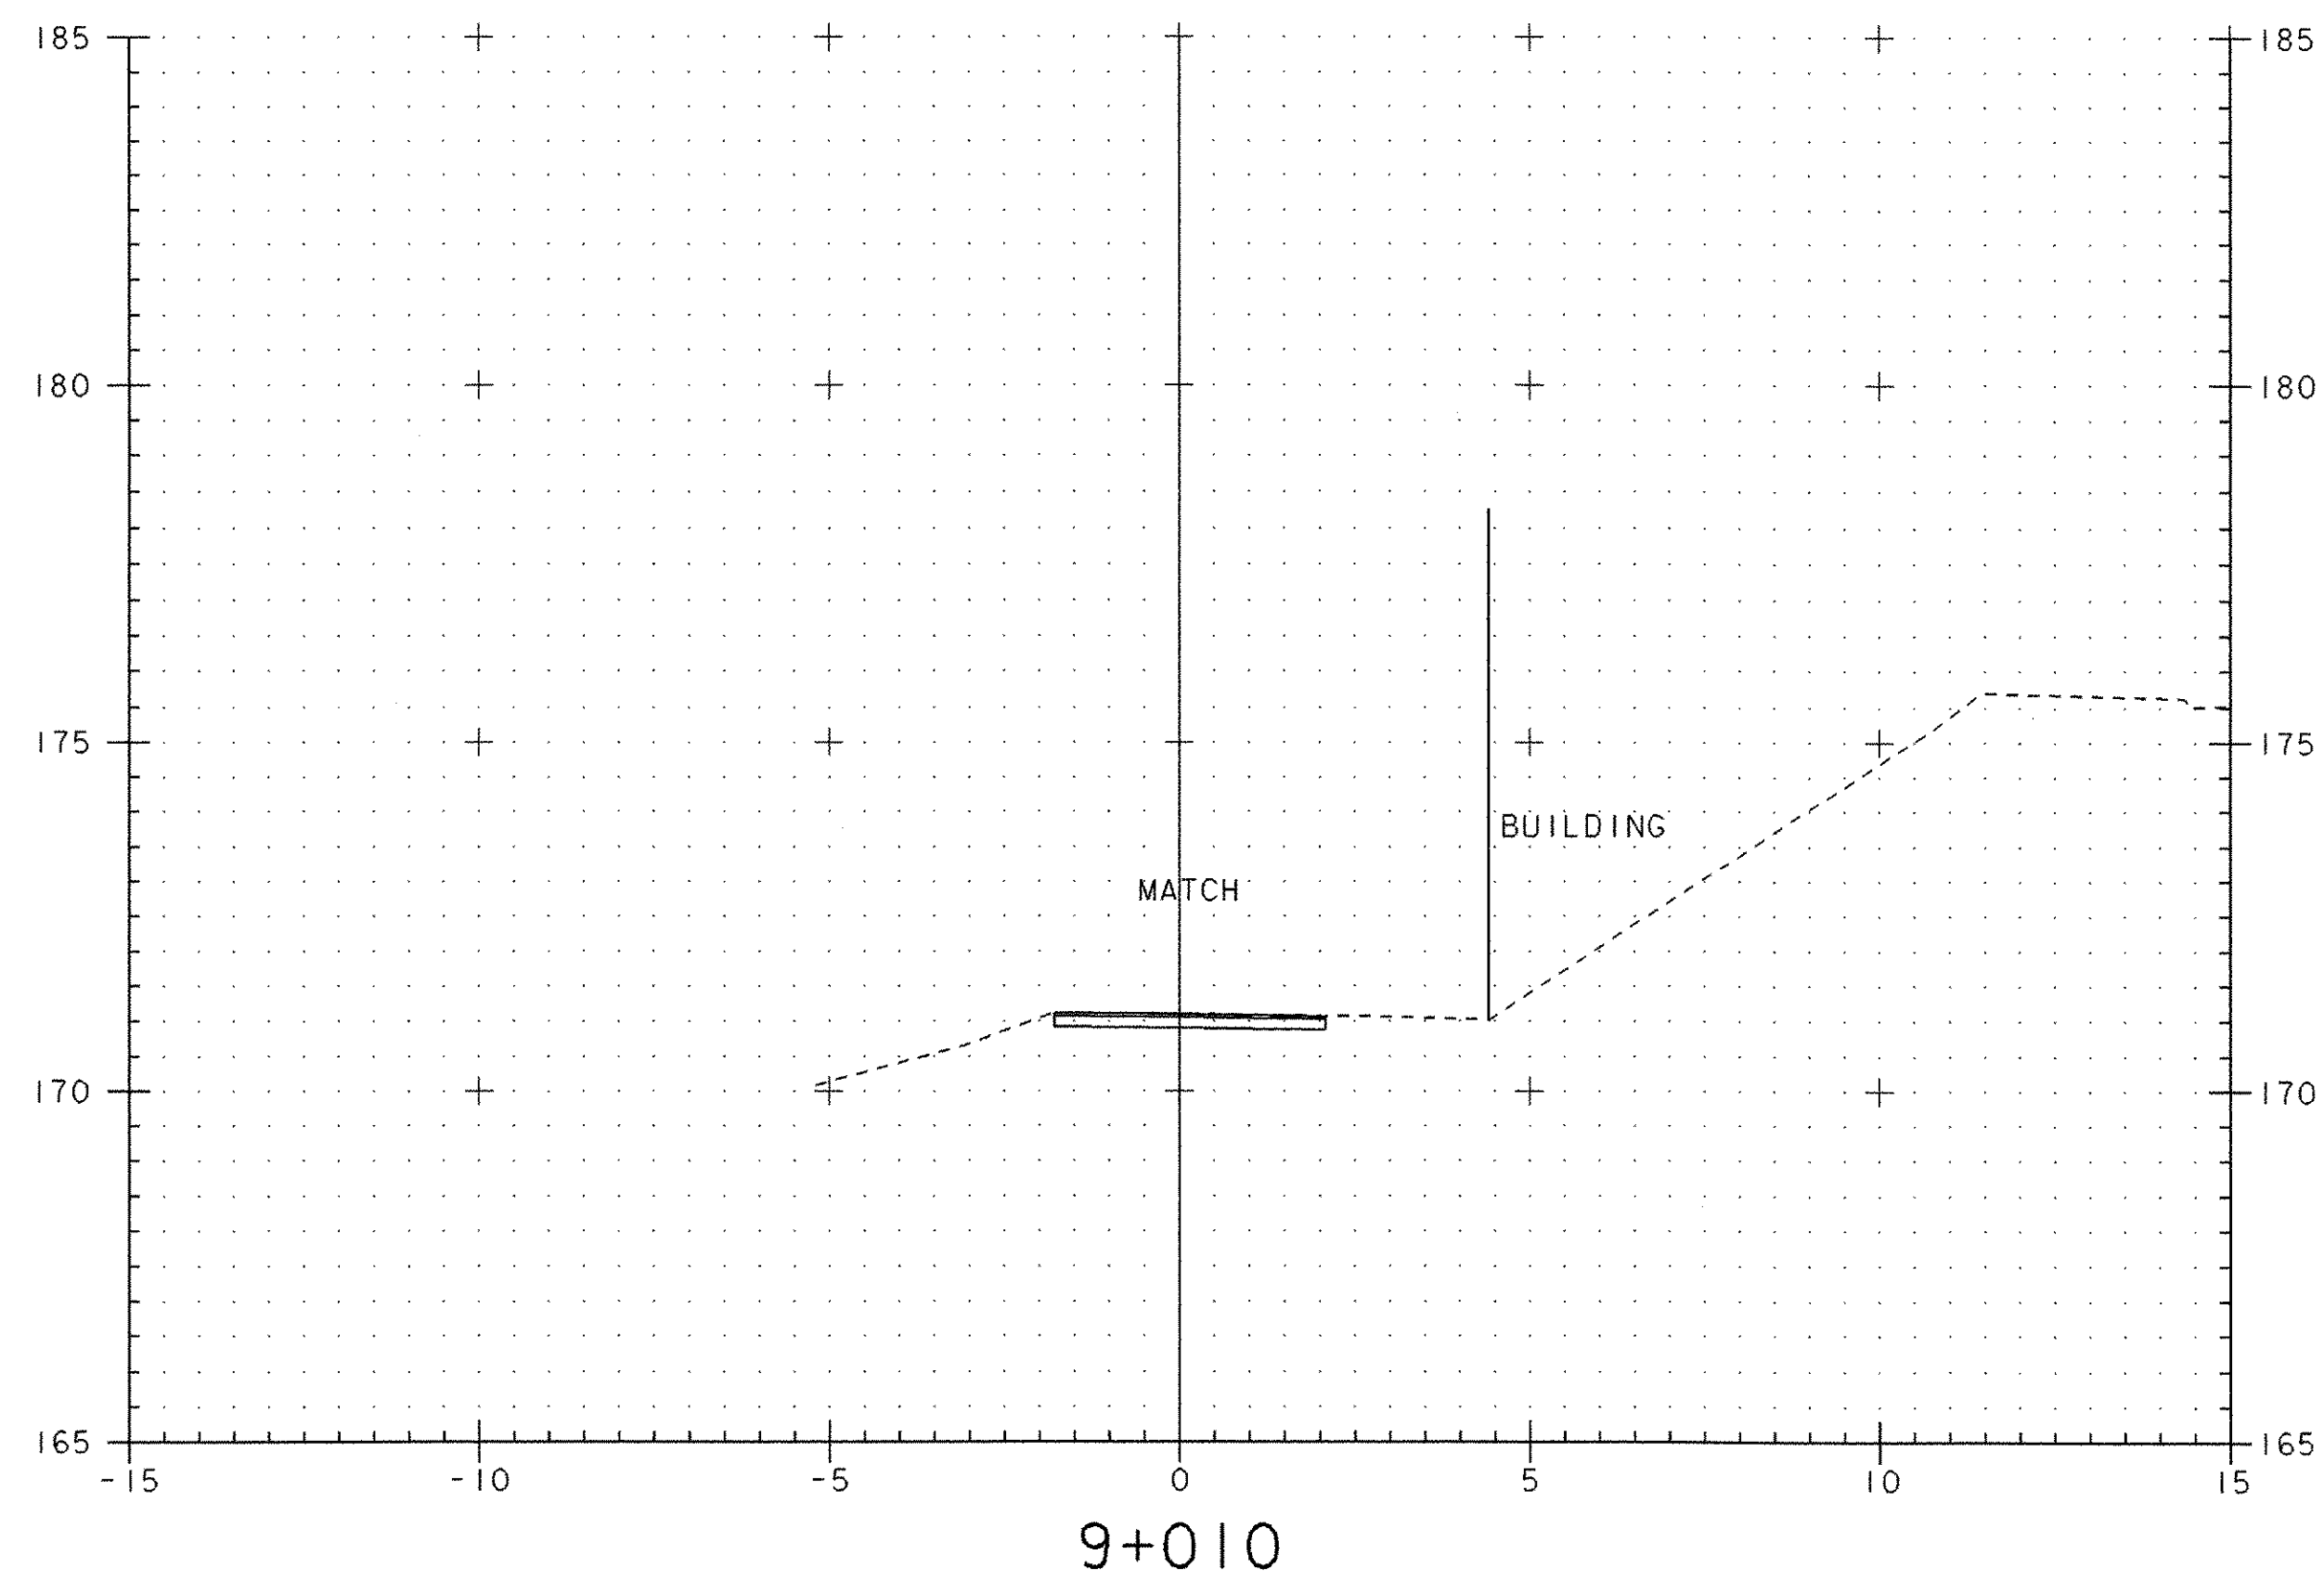




|                                   |                                      |                        |                    |
|-----------------------------------|--------------------------------------|------------------------|--------------------|
| PROJECT:                          | BETHEL                               | PROJECT NO. :          | BRF 0241 (33) - C1 |
| DESIGN FILE NAME:                 | 96j250/structures/s96j250xsec-cl.dgn | IPARM FILE NAME:       | s96j250xbml.i      |
| BETHEL MILLS DRIVE CROSS SECTIONS |                                      | PLOT DATE: 09-JUL-2003 |                    |
| STA 9+000 THRU STA 9+030          |                                      | SHEET: 41 OF 47        |                    |



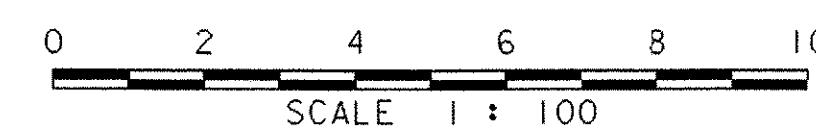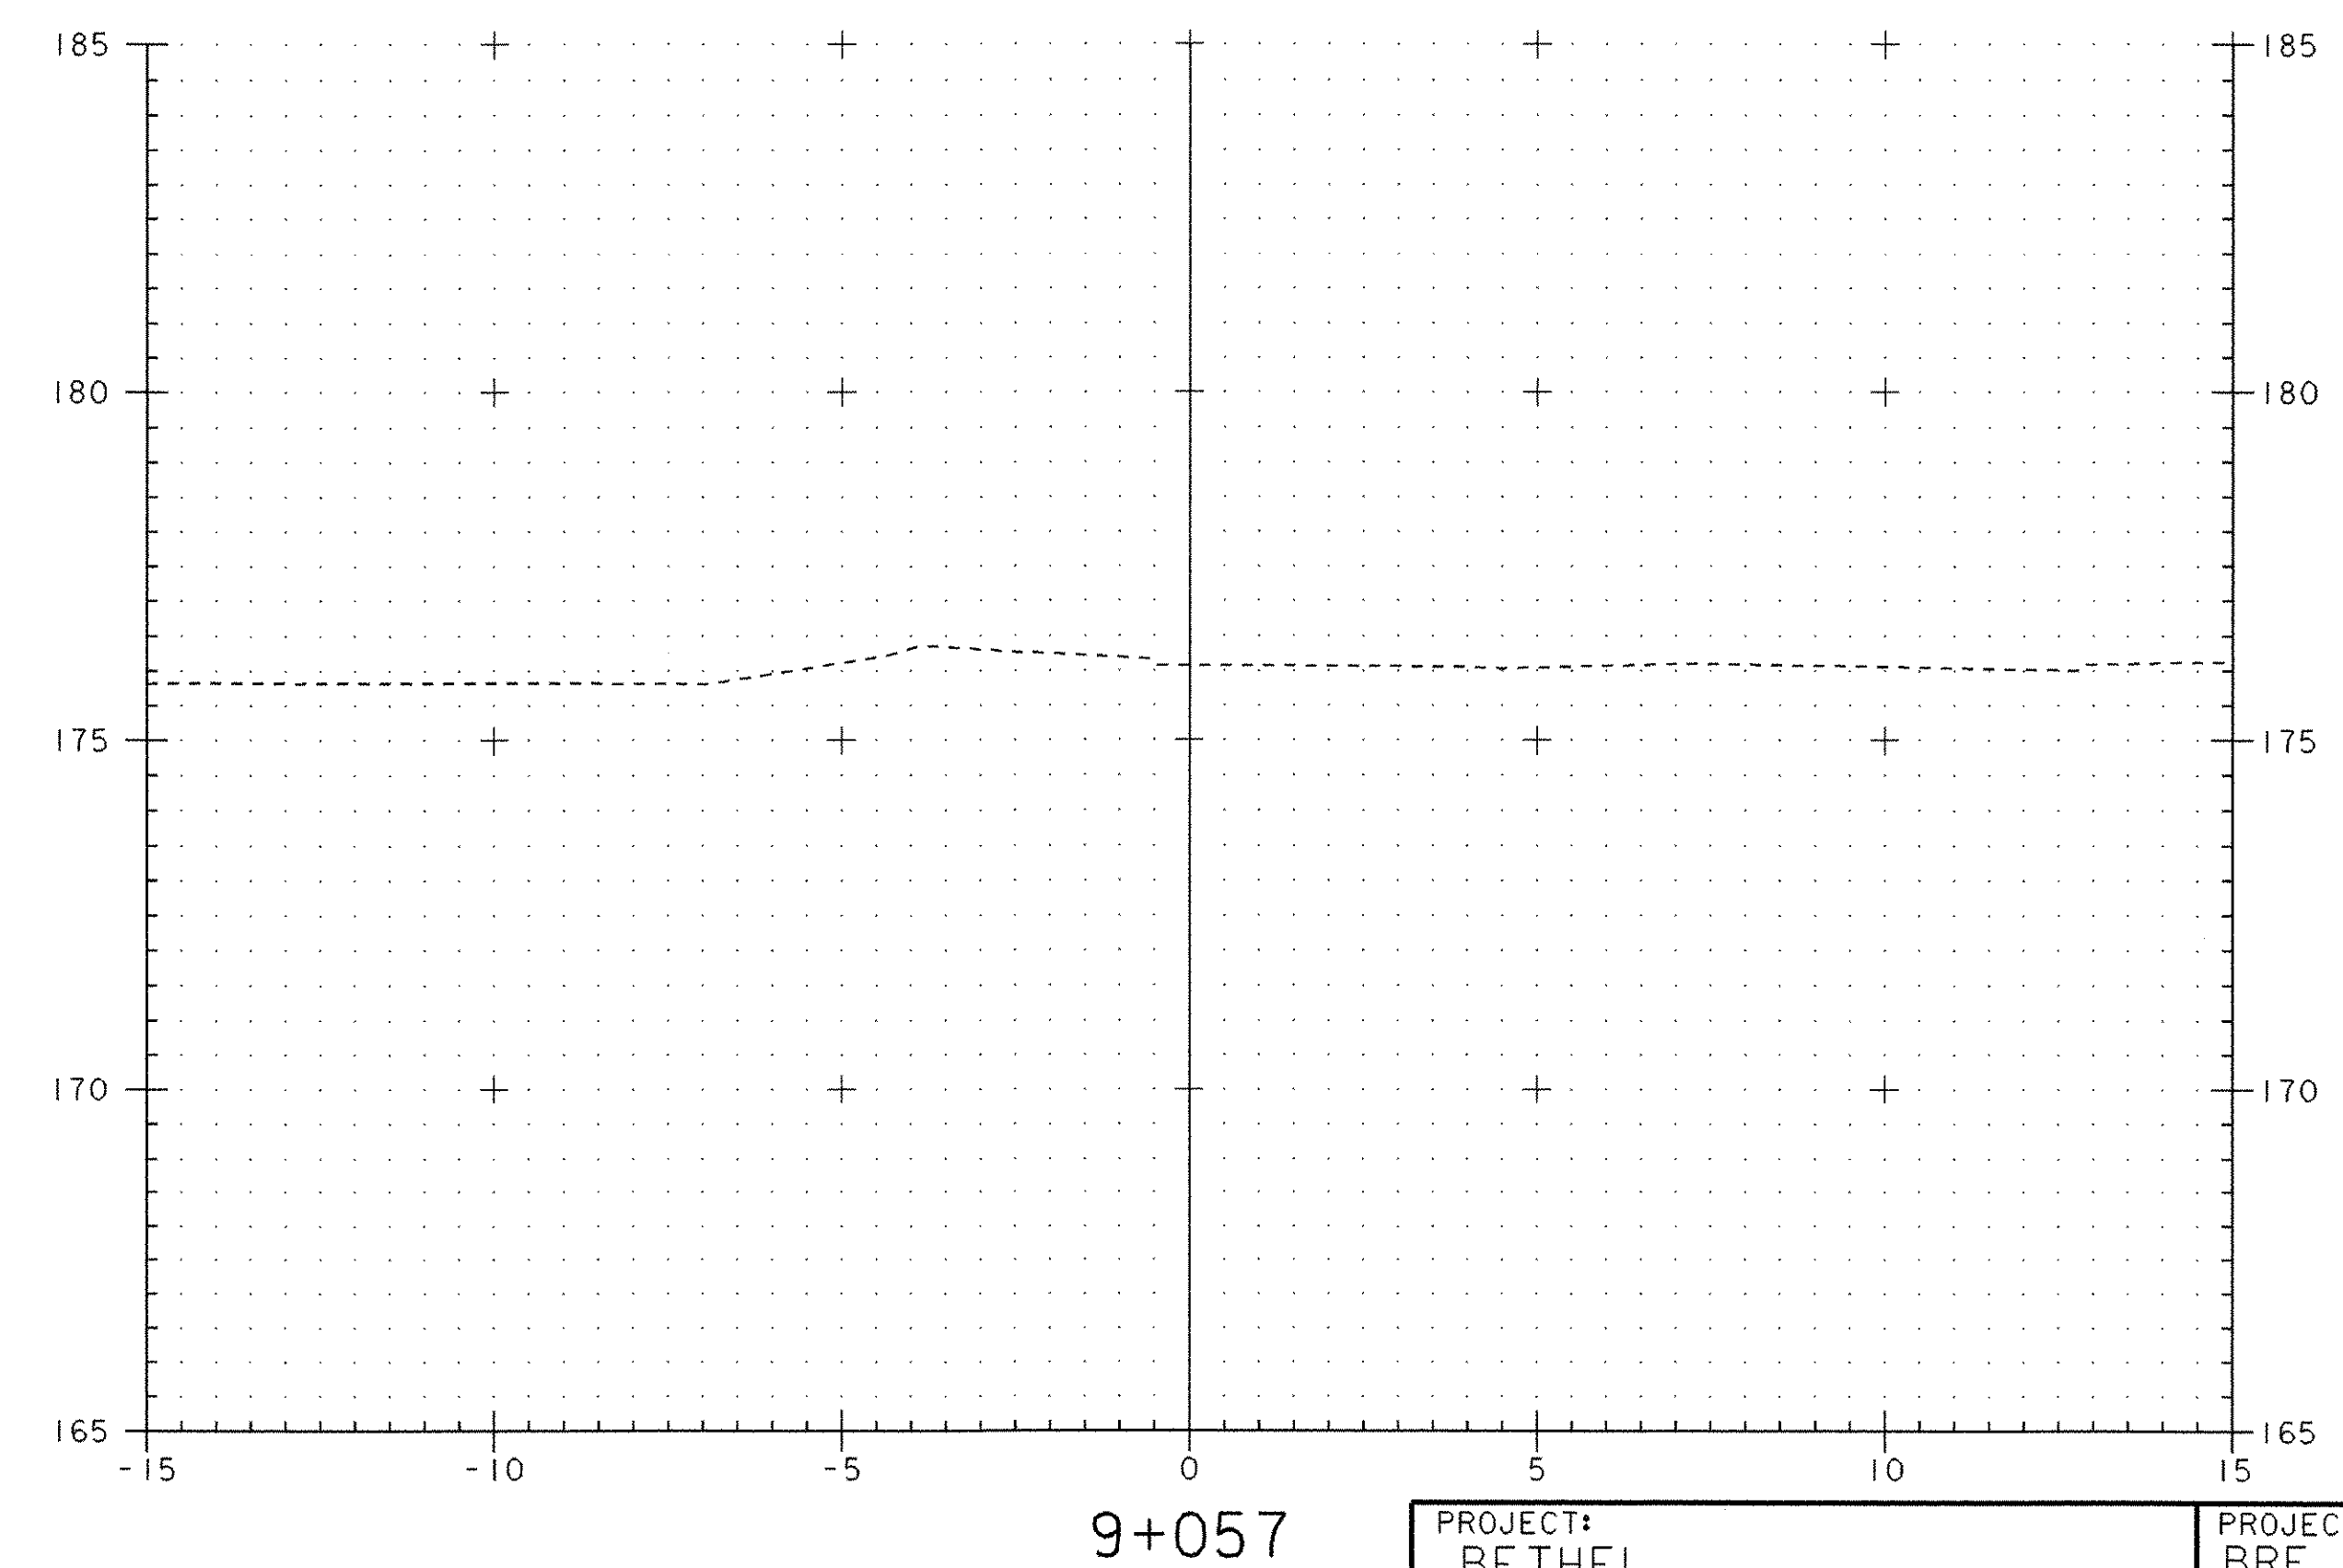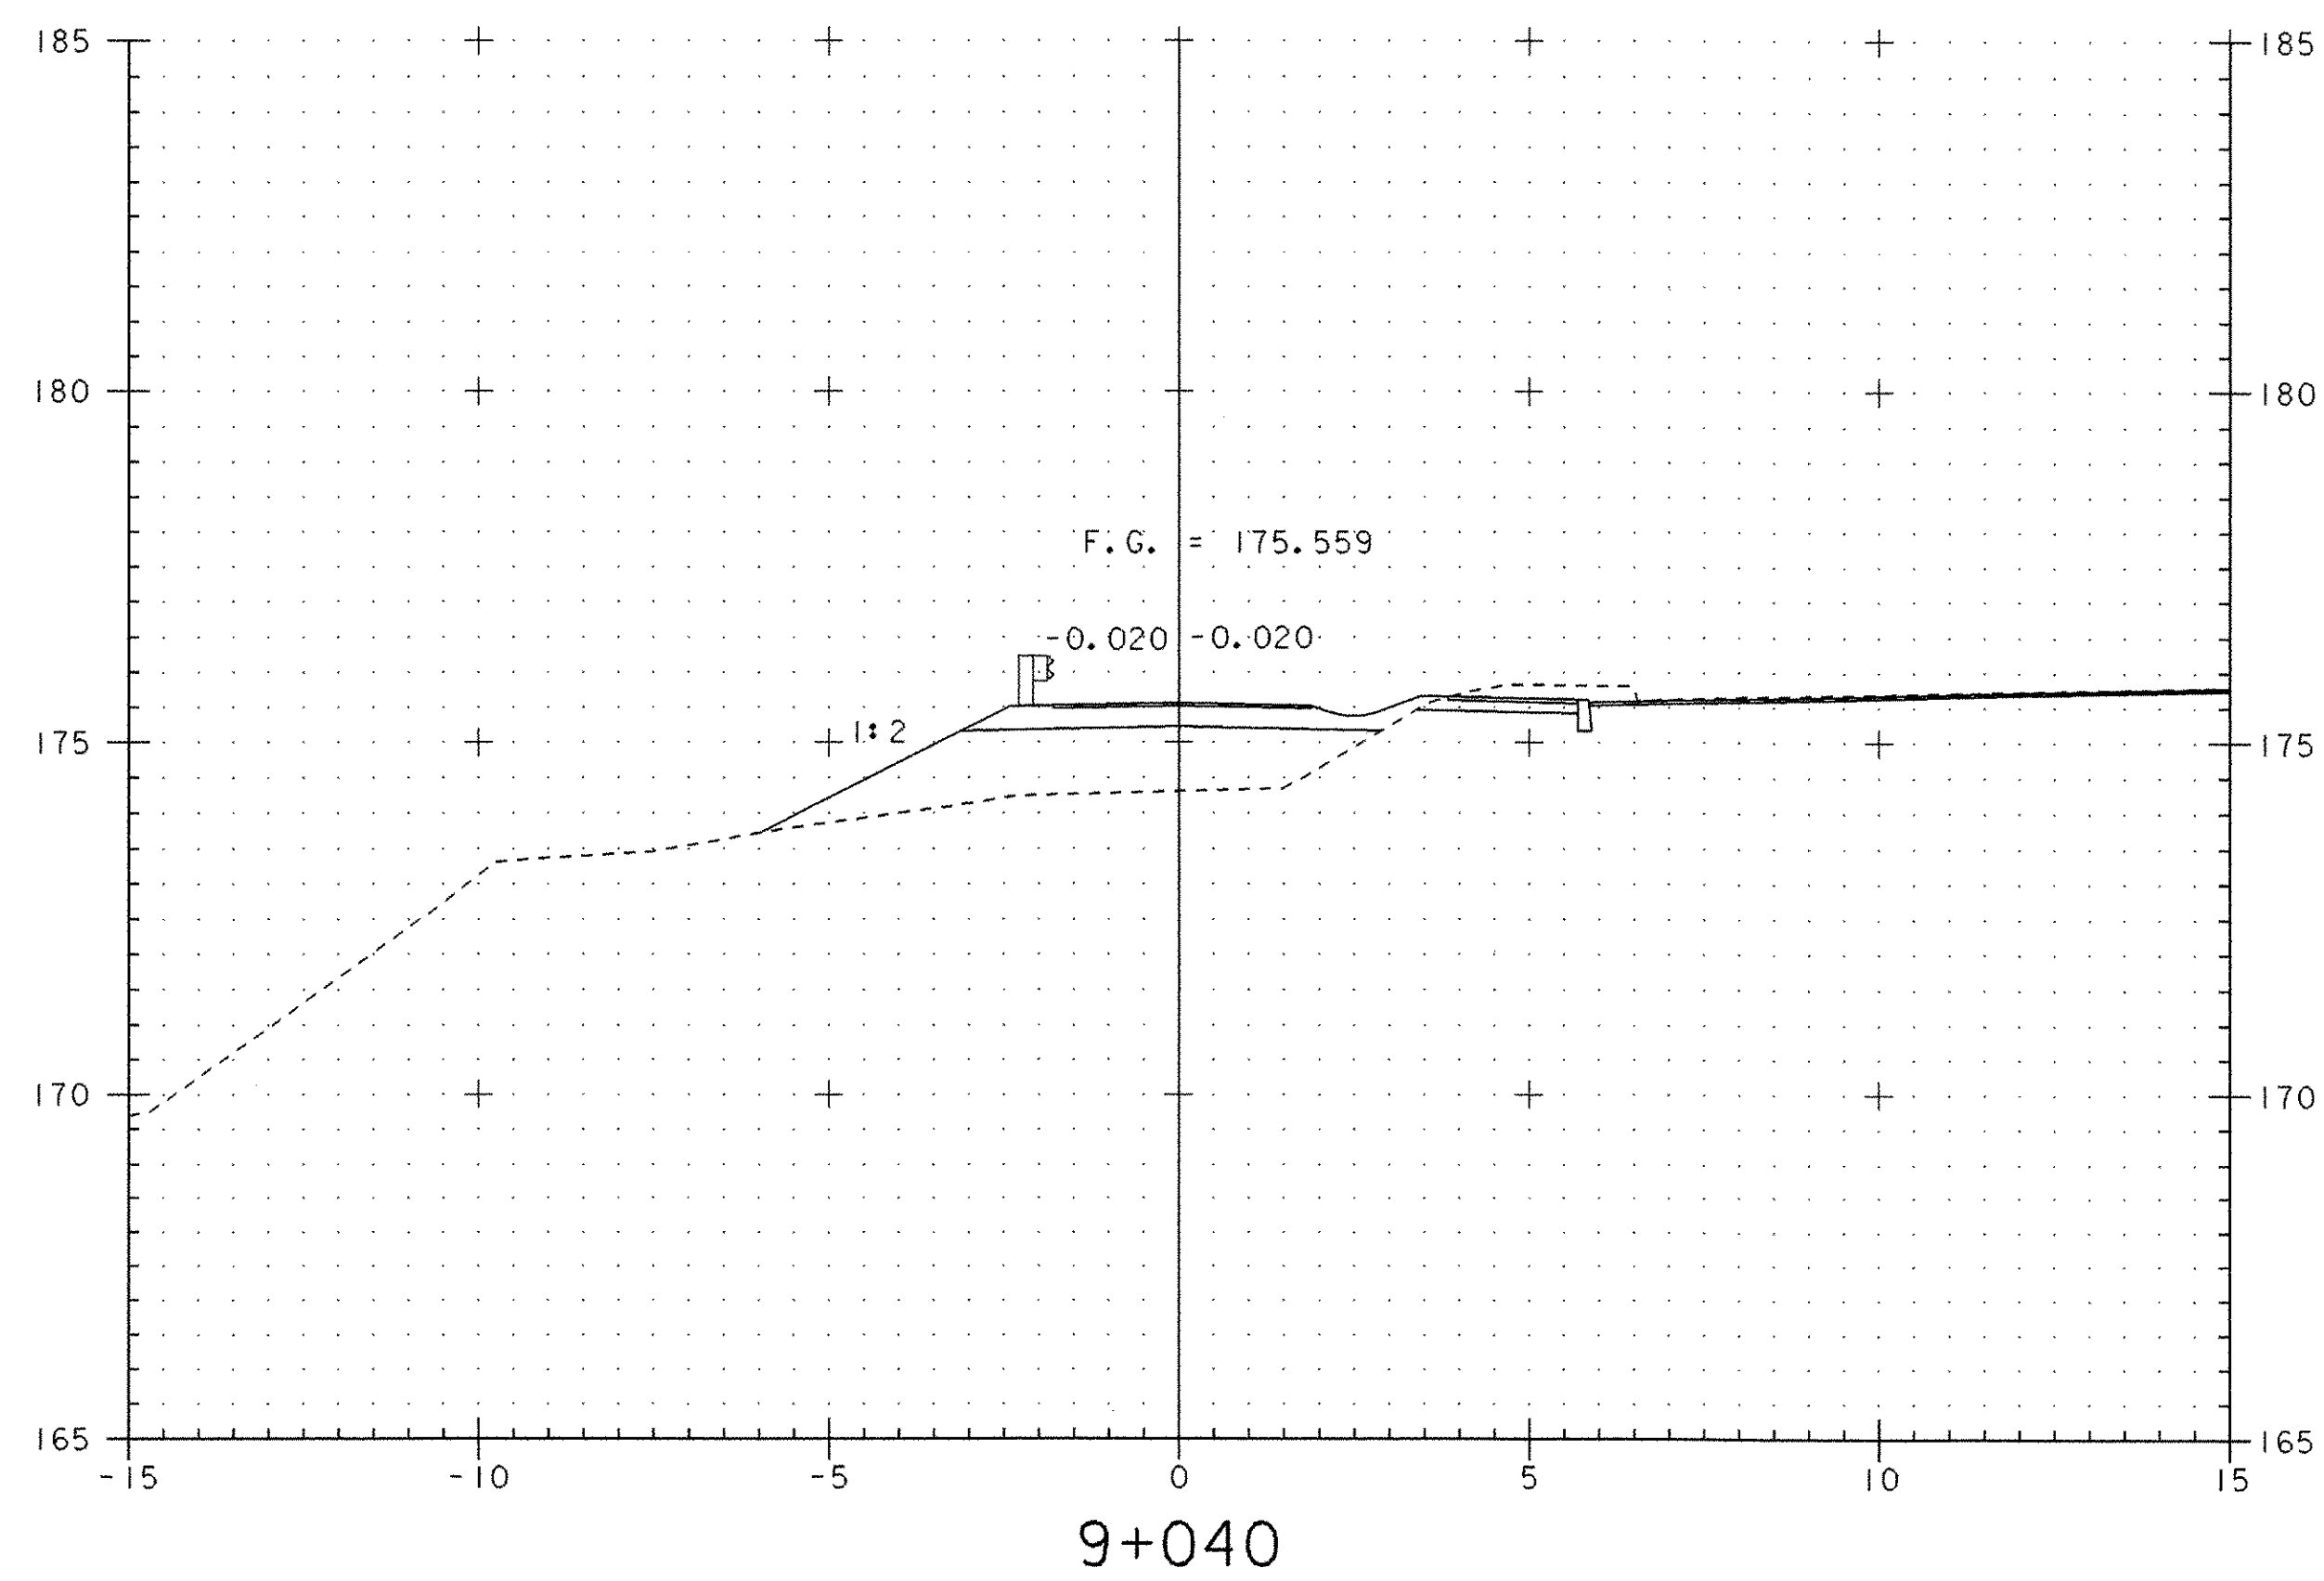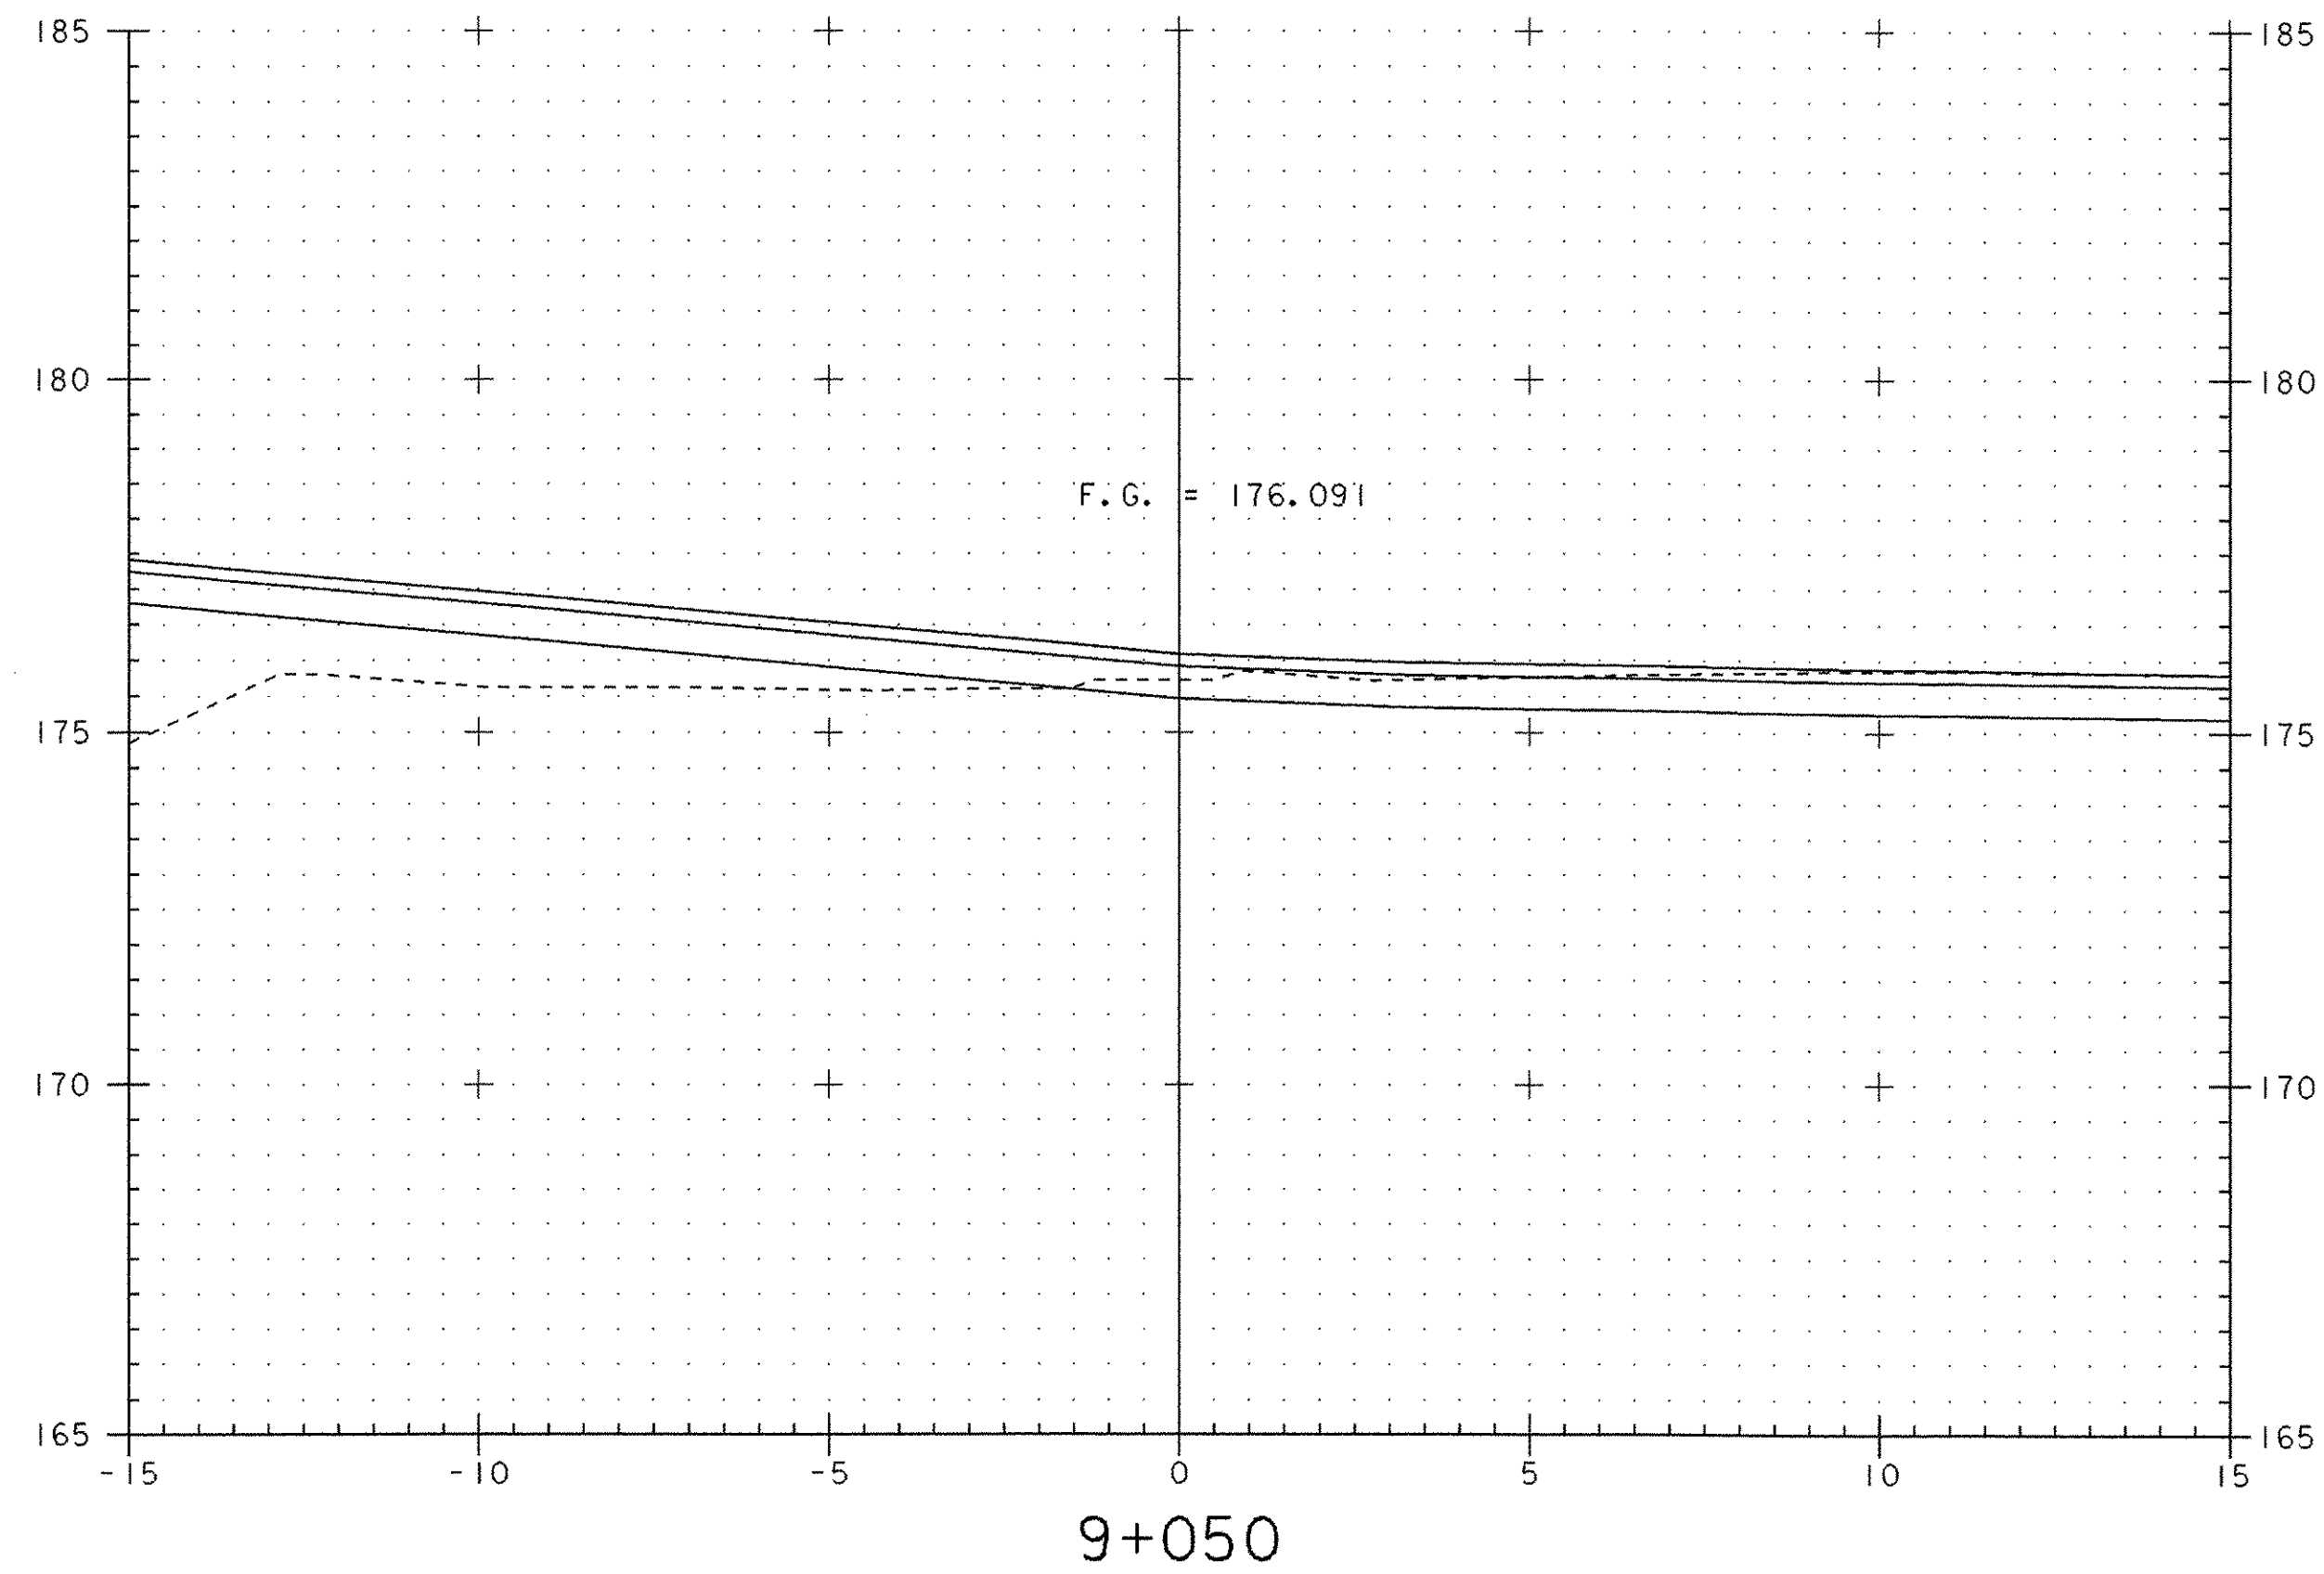




|                                                        |                        |
|--------------------------------------------------------|------------------------|
| PROJECT:                                               | PROJECT NO. :          |
| BETHEL                                                 | BRF 0241 (33) - C1     |
| DESIGN FILE NAME: 96j250/structures/s96j250xsec-cl.dgn |                        |
| IPARM FILE NAME: s96j250xbm2.i                         | PLOT DATE: 09-JUL-2003 |
| BETHEL MILLS DRIVE CROSS SECTIONS                      |                        |
| STA 9+040 THRU STA 9+057                               | SHEET: 42 OF 47        |



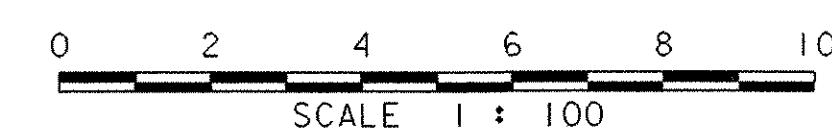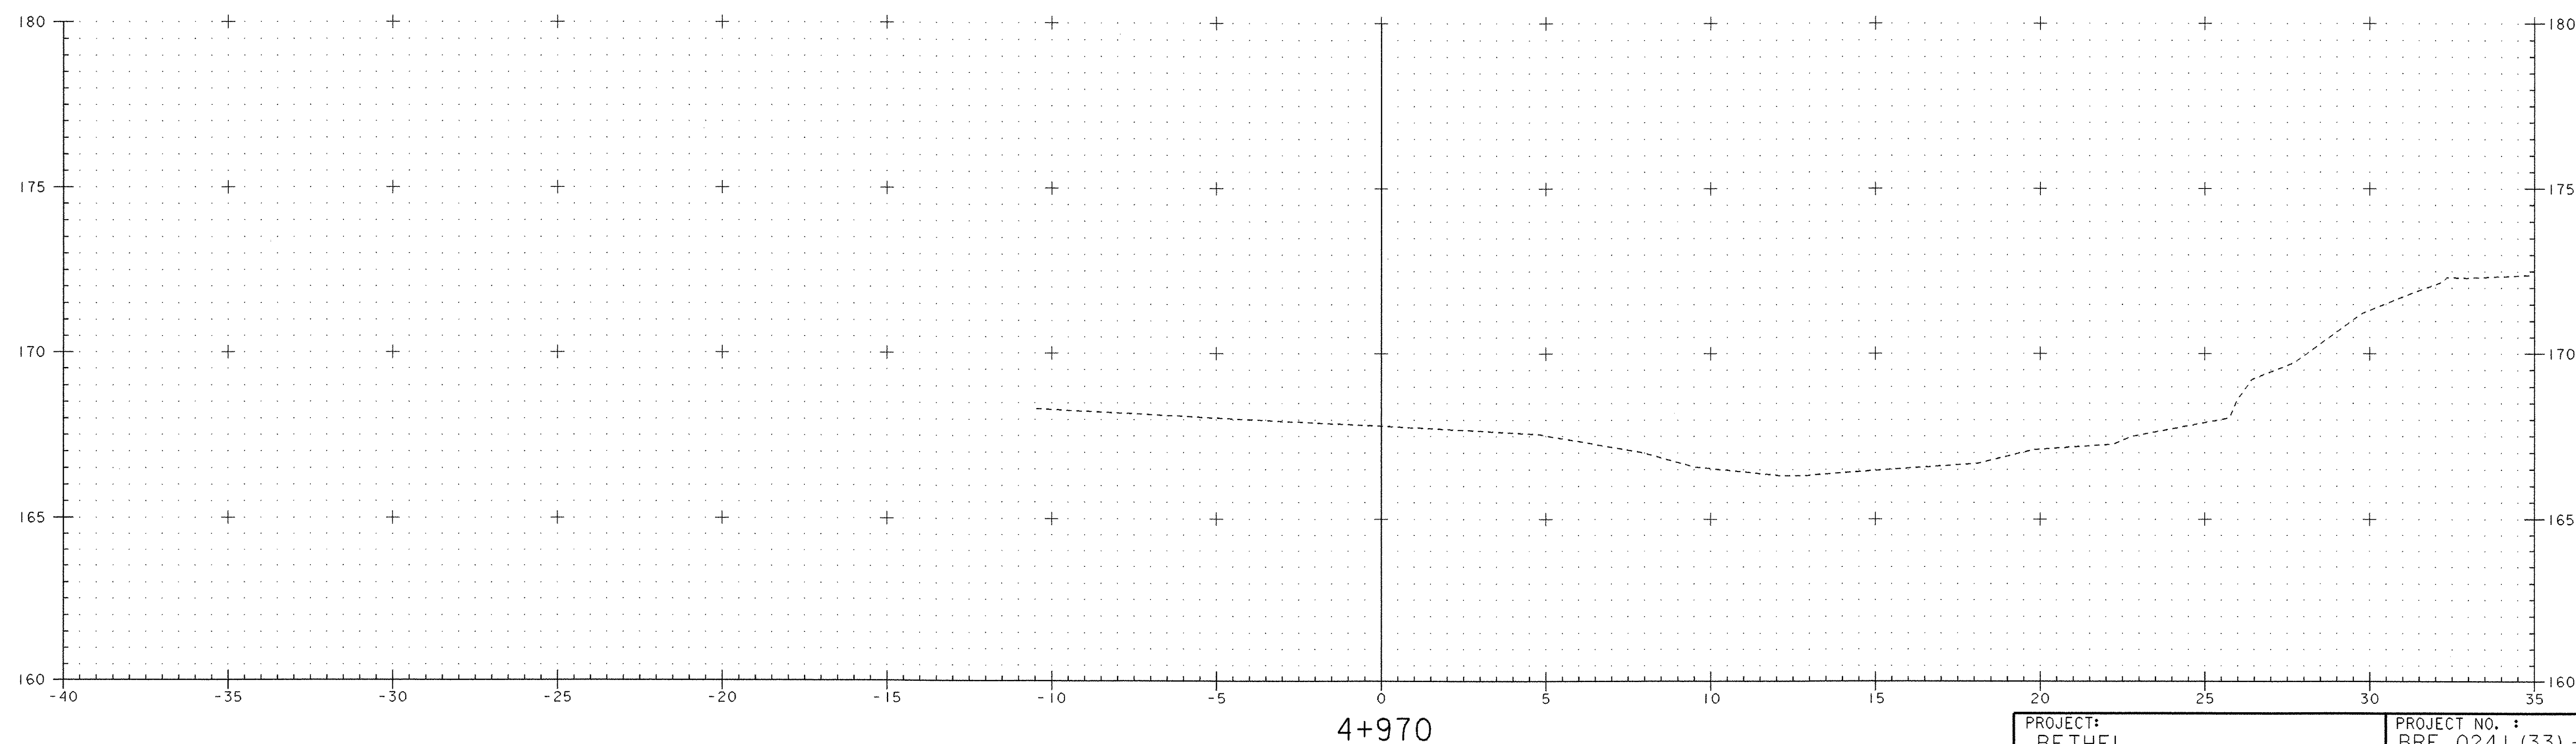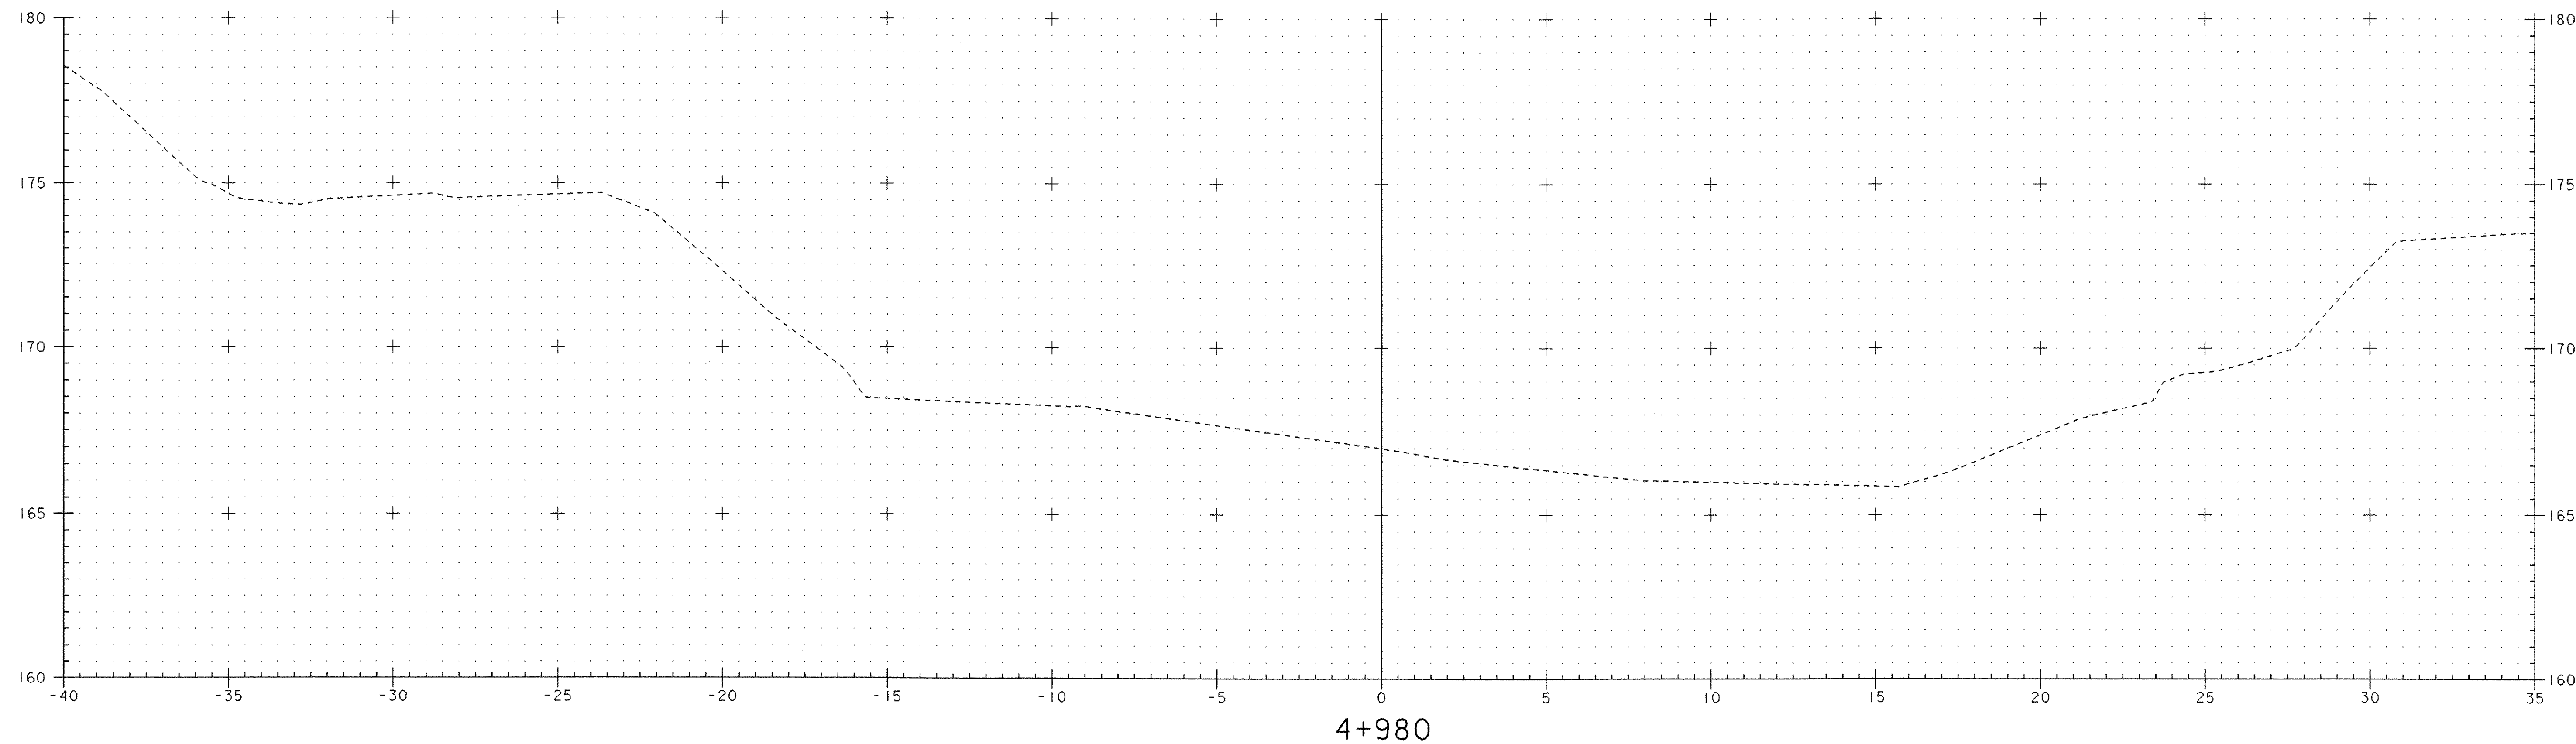



|                                                        |                                     |
|--------------------------------------------------------|-------------------------------------|
| PROJECT:<br>BETHEL                                     | PROJECT NO. :<br>BRF 0241 (33) - C1 |
| DESIGN FILE NAME: 96j250/structures/s96j250xsec-cl.dgn | PLOT DATE: 09-JUL-2003              |
| IPARM FILE NAME: s96j260chl.i                          |                                     |
| CHANNEL CROSS SECTIONS                                 |                                     |
| STA 4+970 AND STA 4+980                                | SHEET: 43 OF 47                     |



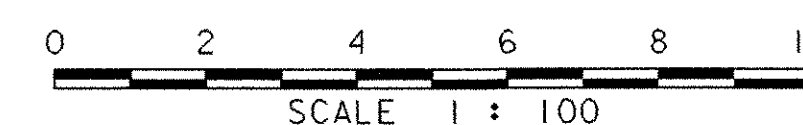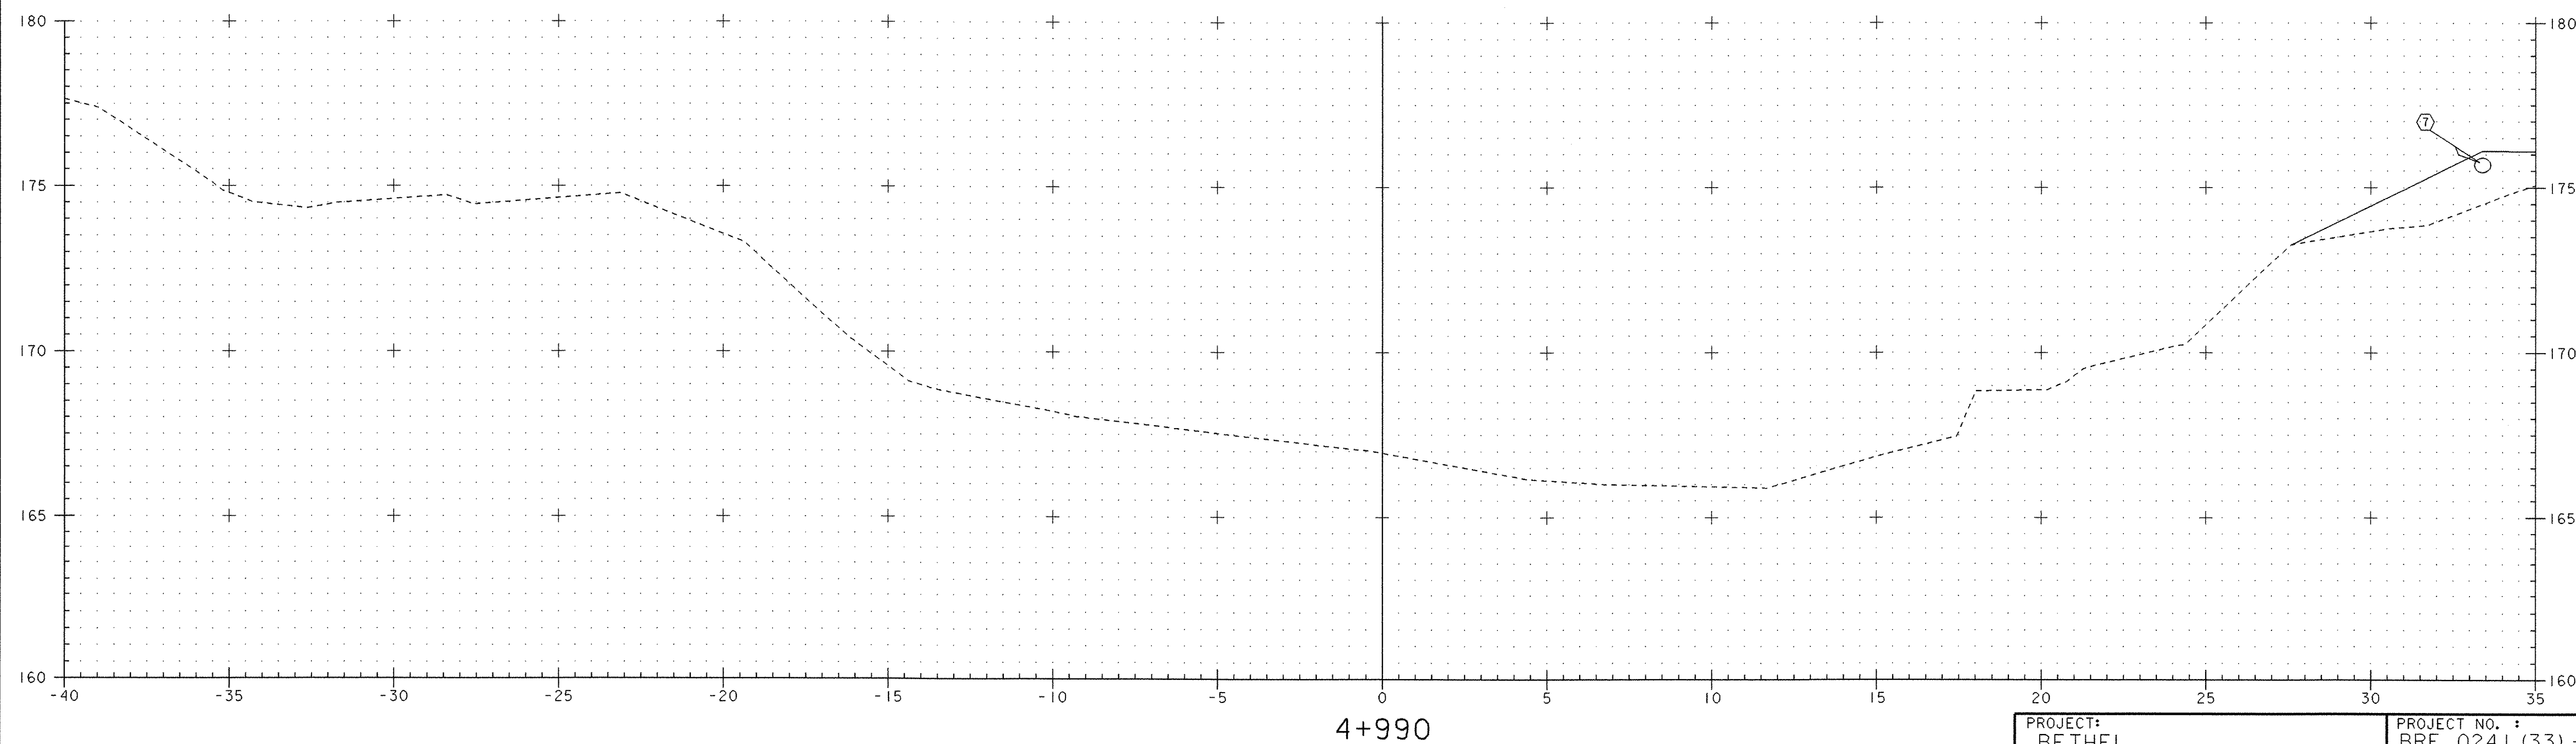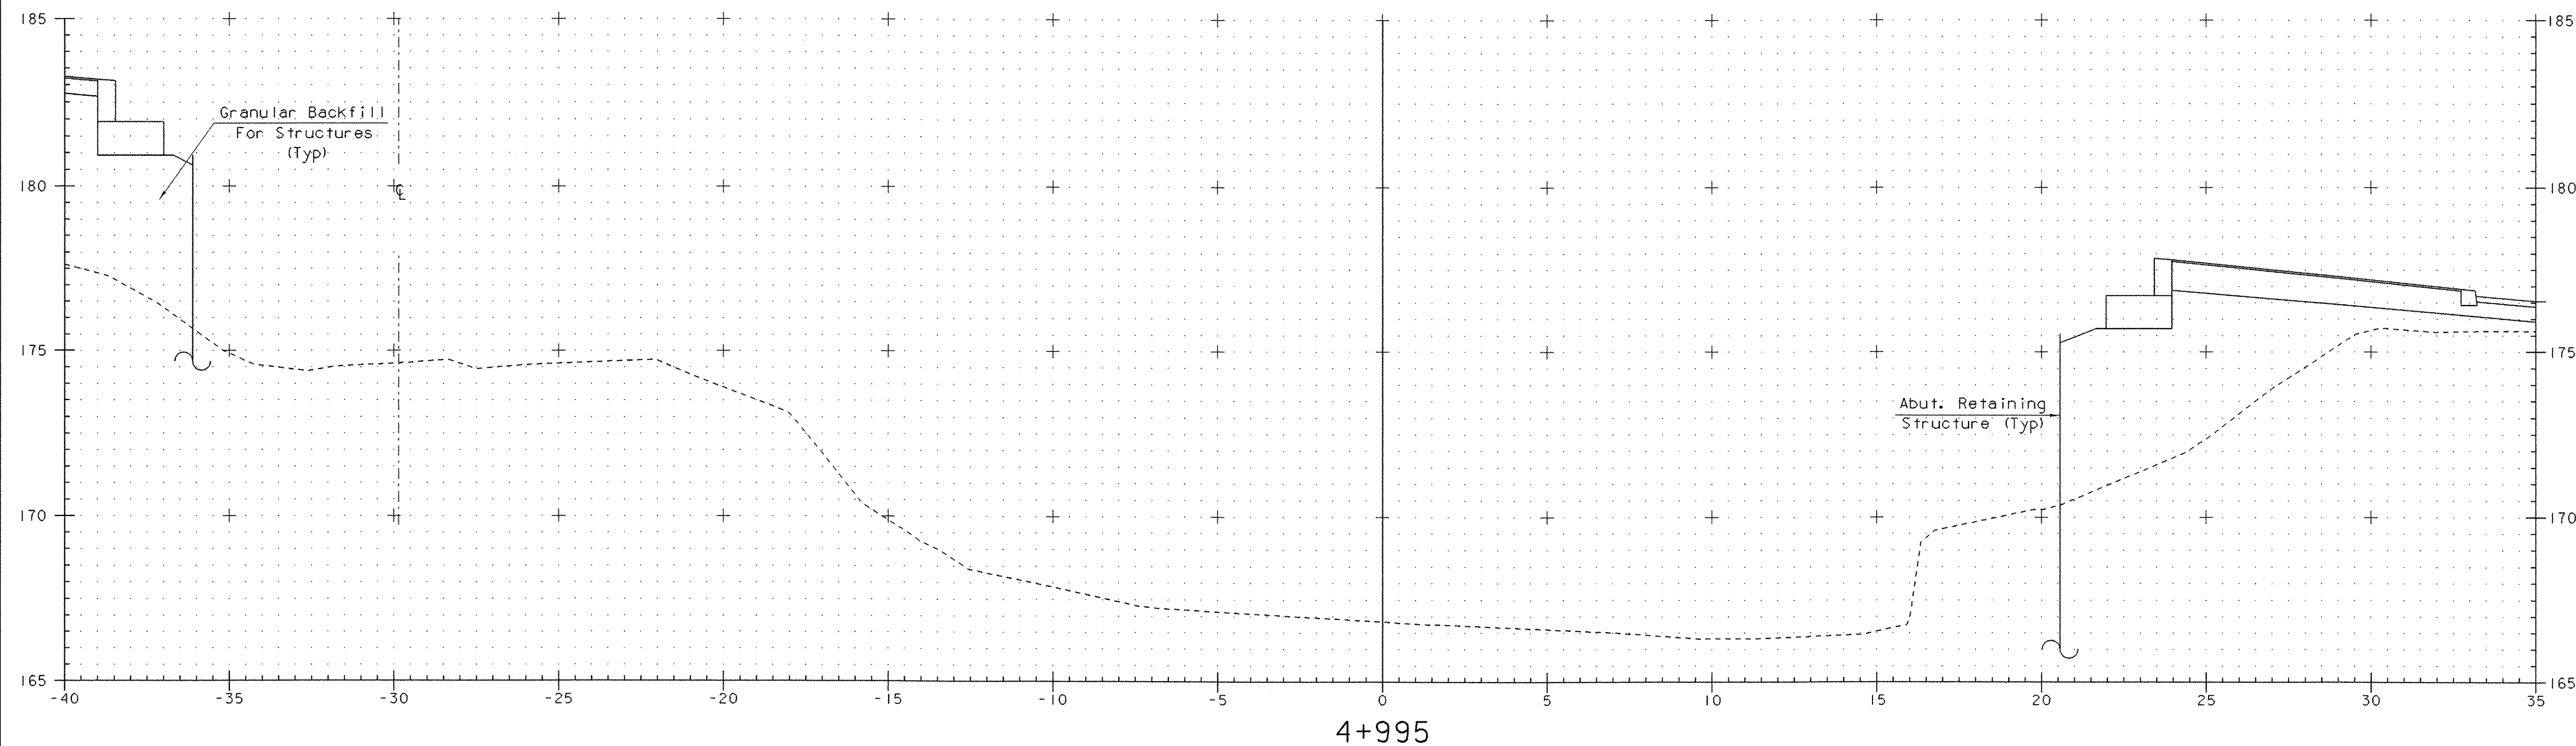




|                         |                                      |               |                    |
|-------------------------|--------------------------------------|---------------|--------------------|
| PROJECT:                | BETHEL                               | PROJECT NO. : | BRF 0241 (33) - C1 |
| DESIGN FILE NAME:       | 96j250/structures/s96j250xsec-cl.dgn |               |                    |
| IPARM FILE NAME:        | s96j250ch2.i                         | PLOT DATE:    | 09-JUL-2003        |
| CHANNEL CROSS SECTIONS  |                                      |               |                    |
| STA 4+990 AND STA 4+995 |                                      |               |                    |



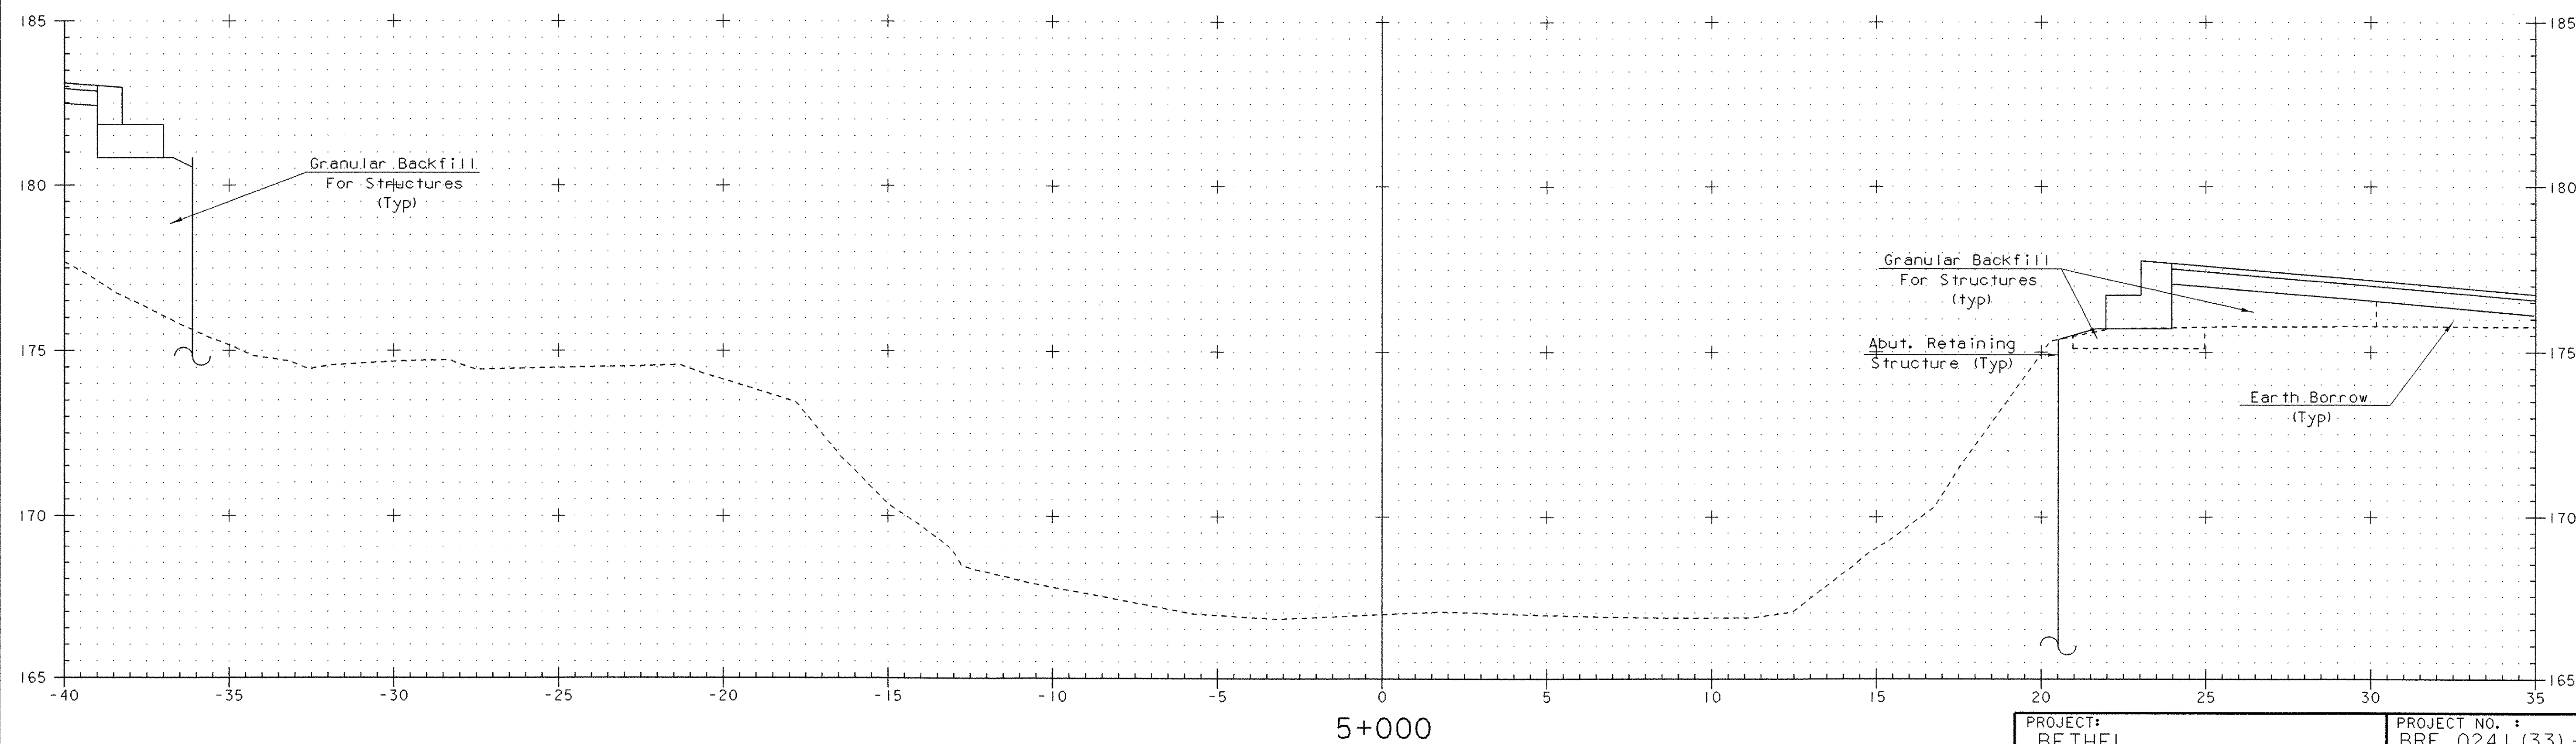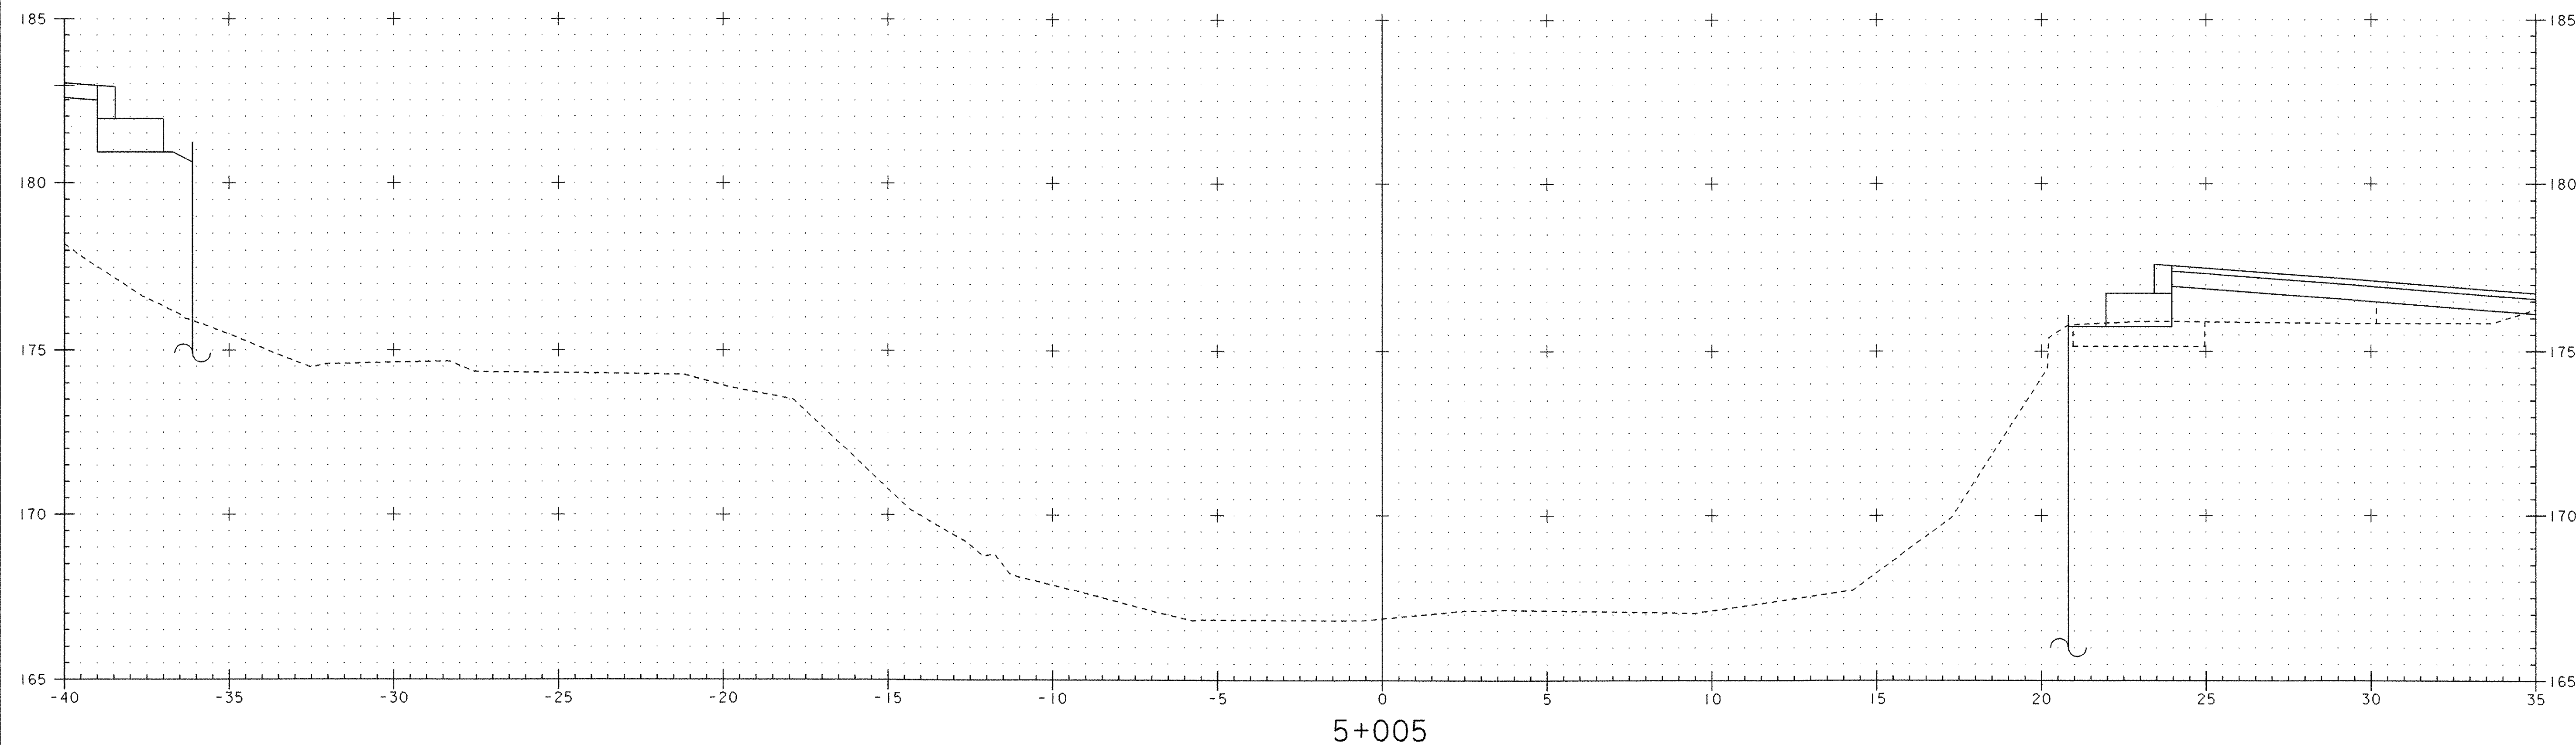



|                         |                                      |               |                    |
|-------------------------|--------------------------------------|---------------|--------------------|
| PROJECT:                | BETHEL                               | PROJECT NO. : | BRF 0241 (33) - C1 |
| DESIGN FILE NAME:       | 96j250/structures/s96j250xsec-cl.dgn |               |                    |
| IPARM FILE NAME:        | s96j250ch3.i                         | PLOT DATE:    | 09-JUL-2003        |
| CHANNEL CROSS SECTIONS  |                                      |               |                    |
| STA 5+000 AND STA 5+005 |                                      | SHEET:        | 45 OF 47           |



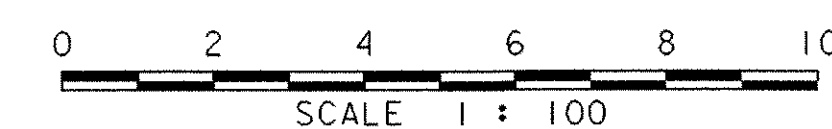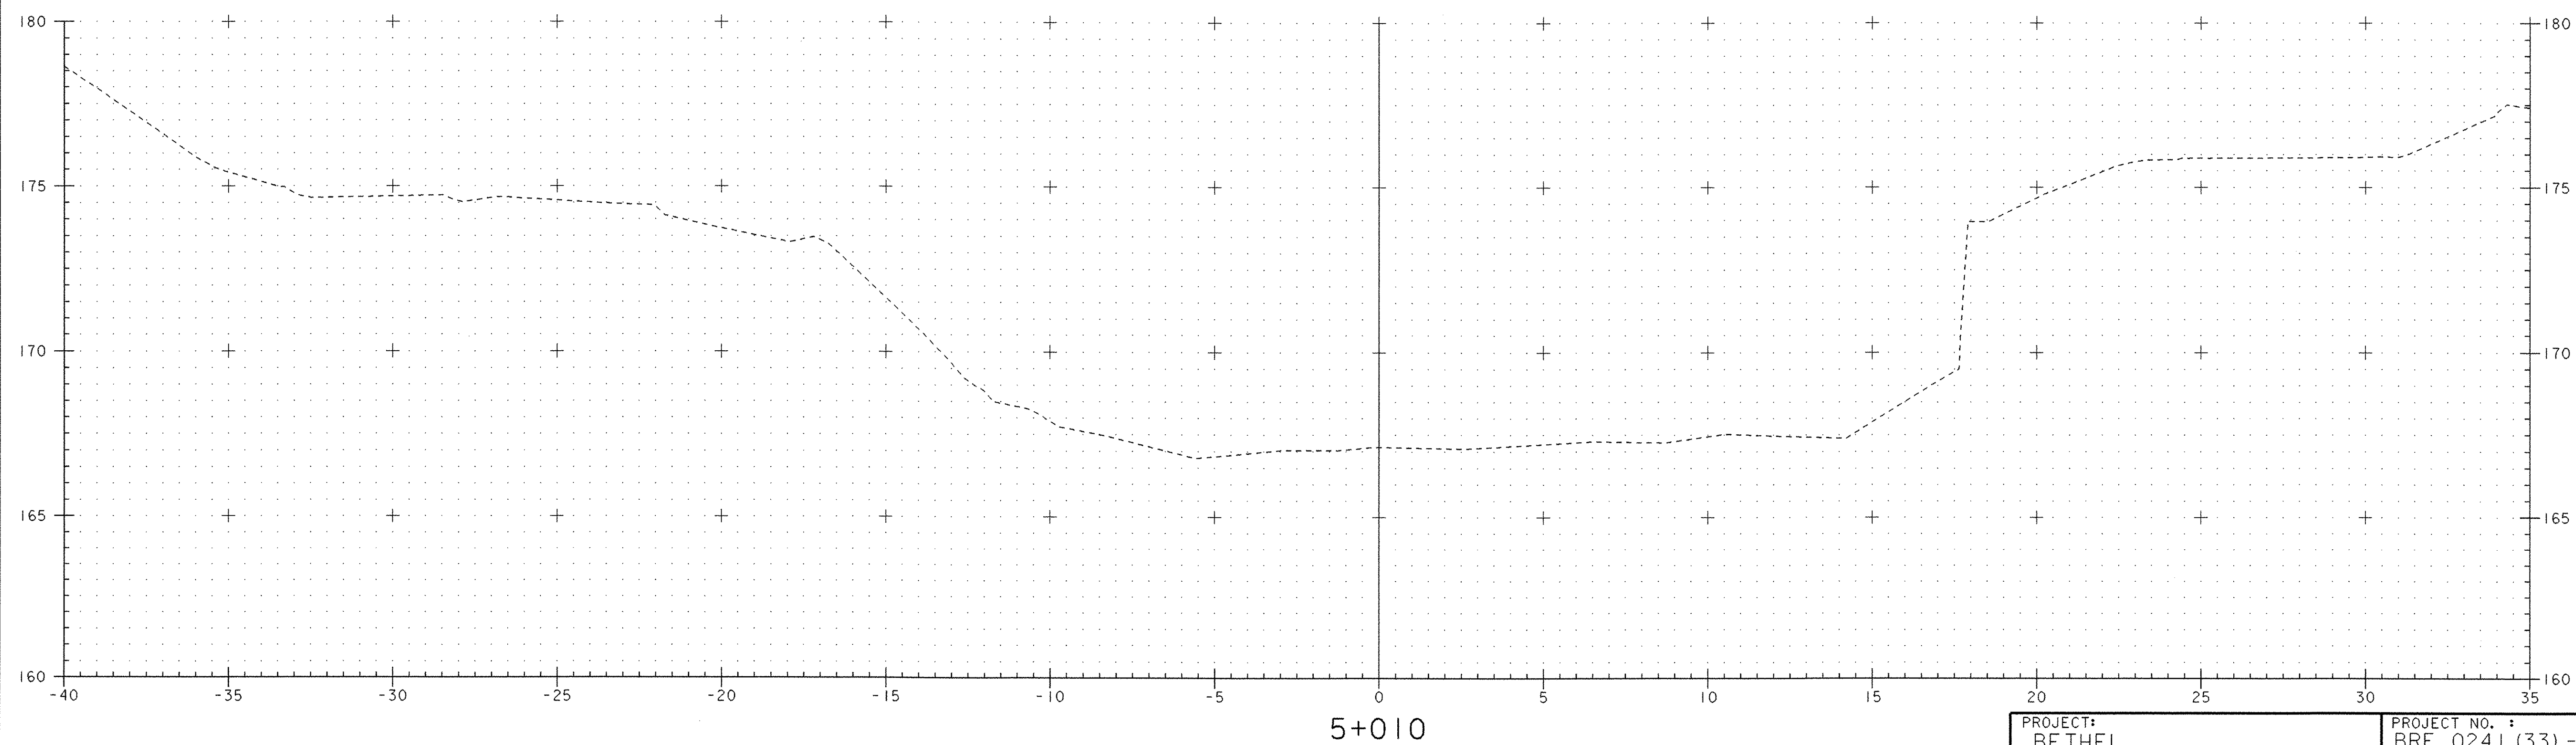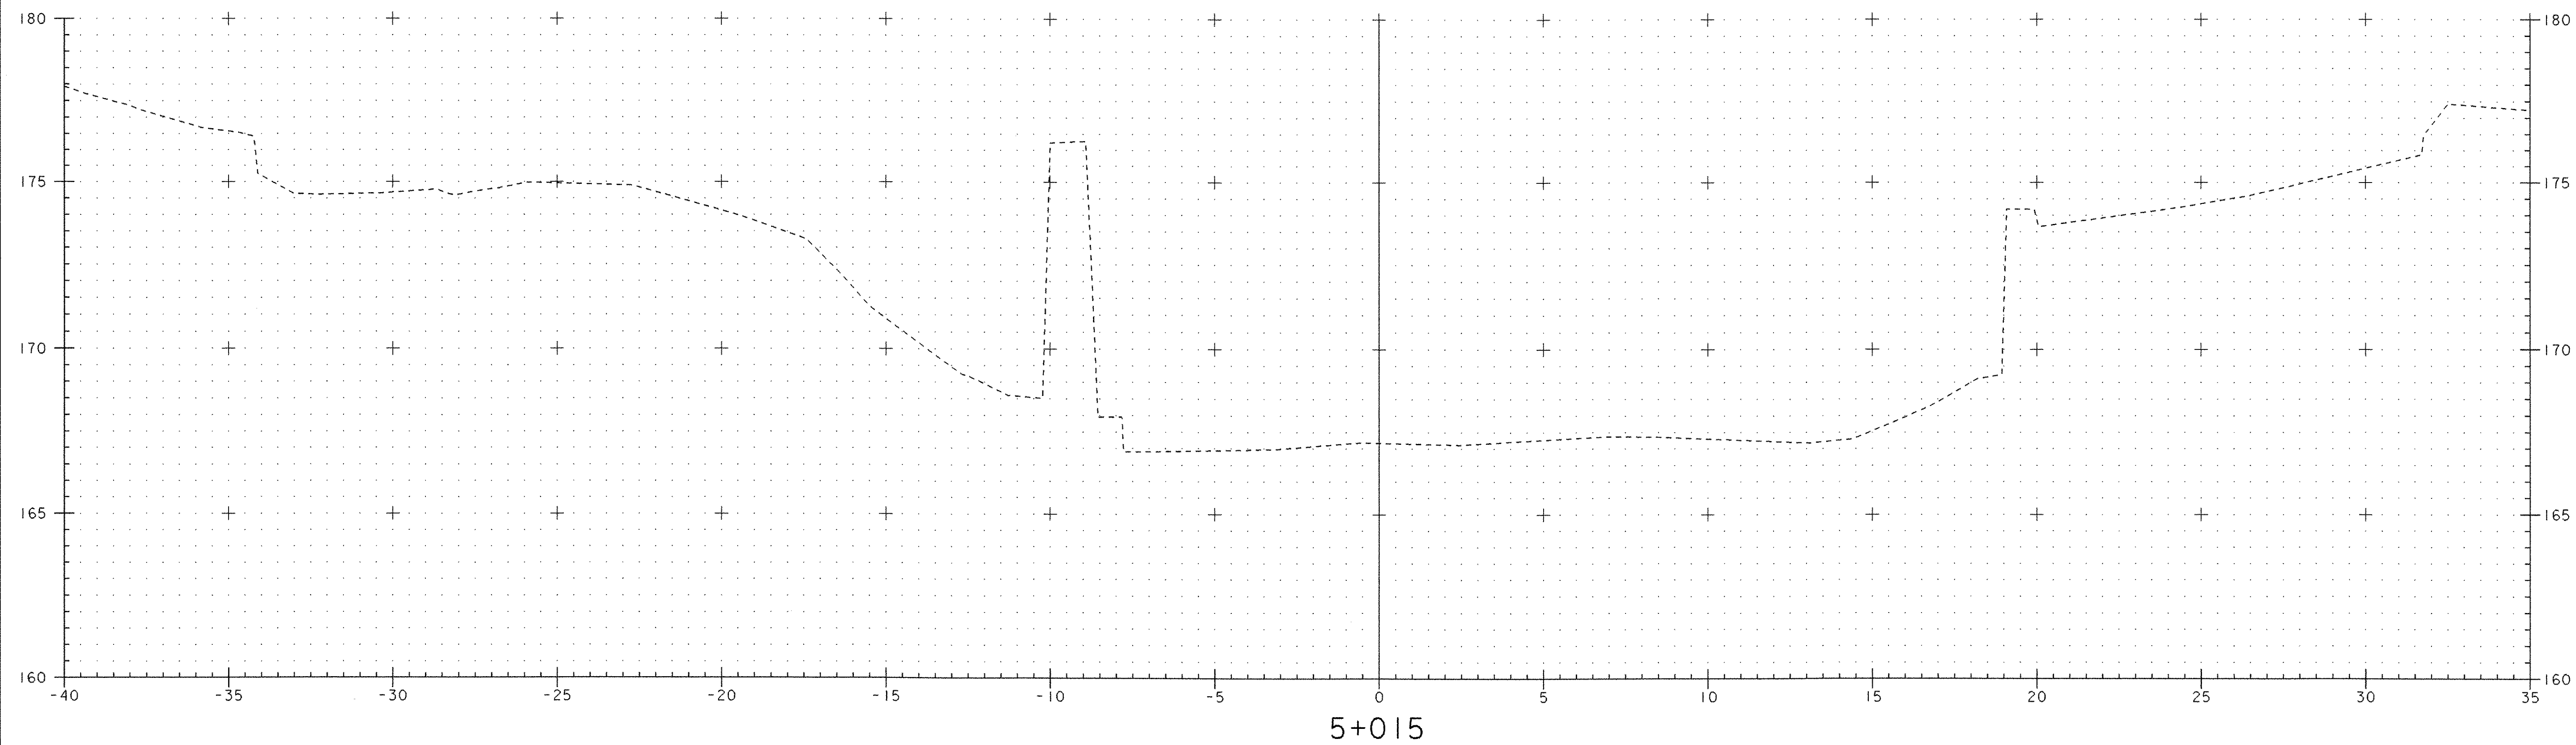

|                                                        |                                     |
|--------------------------------------------------------|-------------------------------------|
| PROJECT:<br>BETHEL                                     | PROJECT NO. :<br>BRF 0241 (33) - C1 |
| DESIGN FILE NAME: 96j250/structures/s96j250xsec-cl.dgn | PLOT DATE: 09-JUL-2003              |
| IPARM FILE NAME: s96j250ch4.i                          |                                     |
| CHANNEL CROSS SECTIONS                                 |                                     |
| STA 5+010 AND STA 5+015                                | SHEET: 46 OF 47                     |



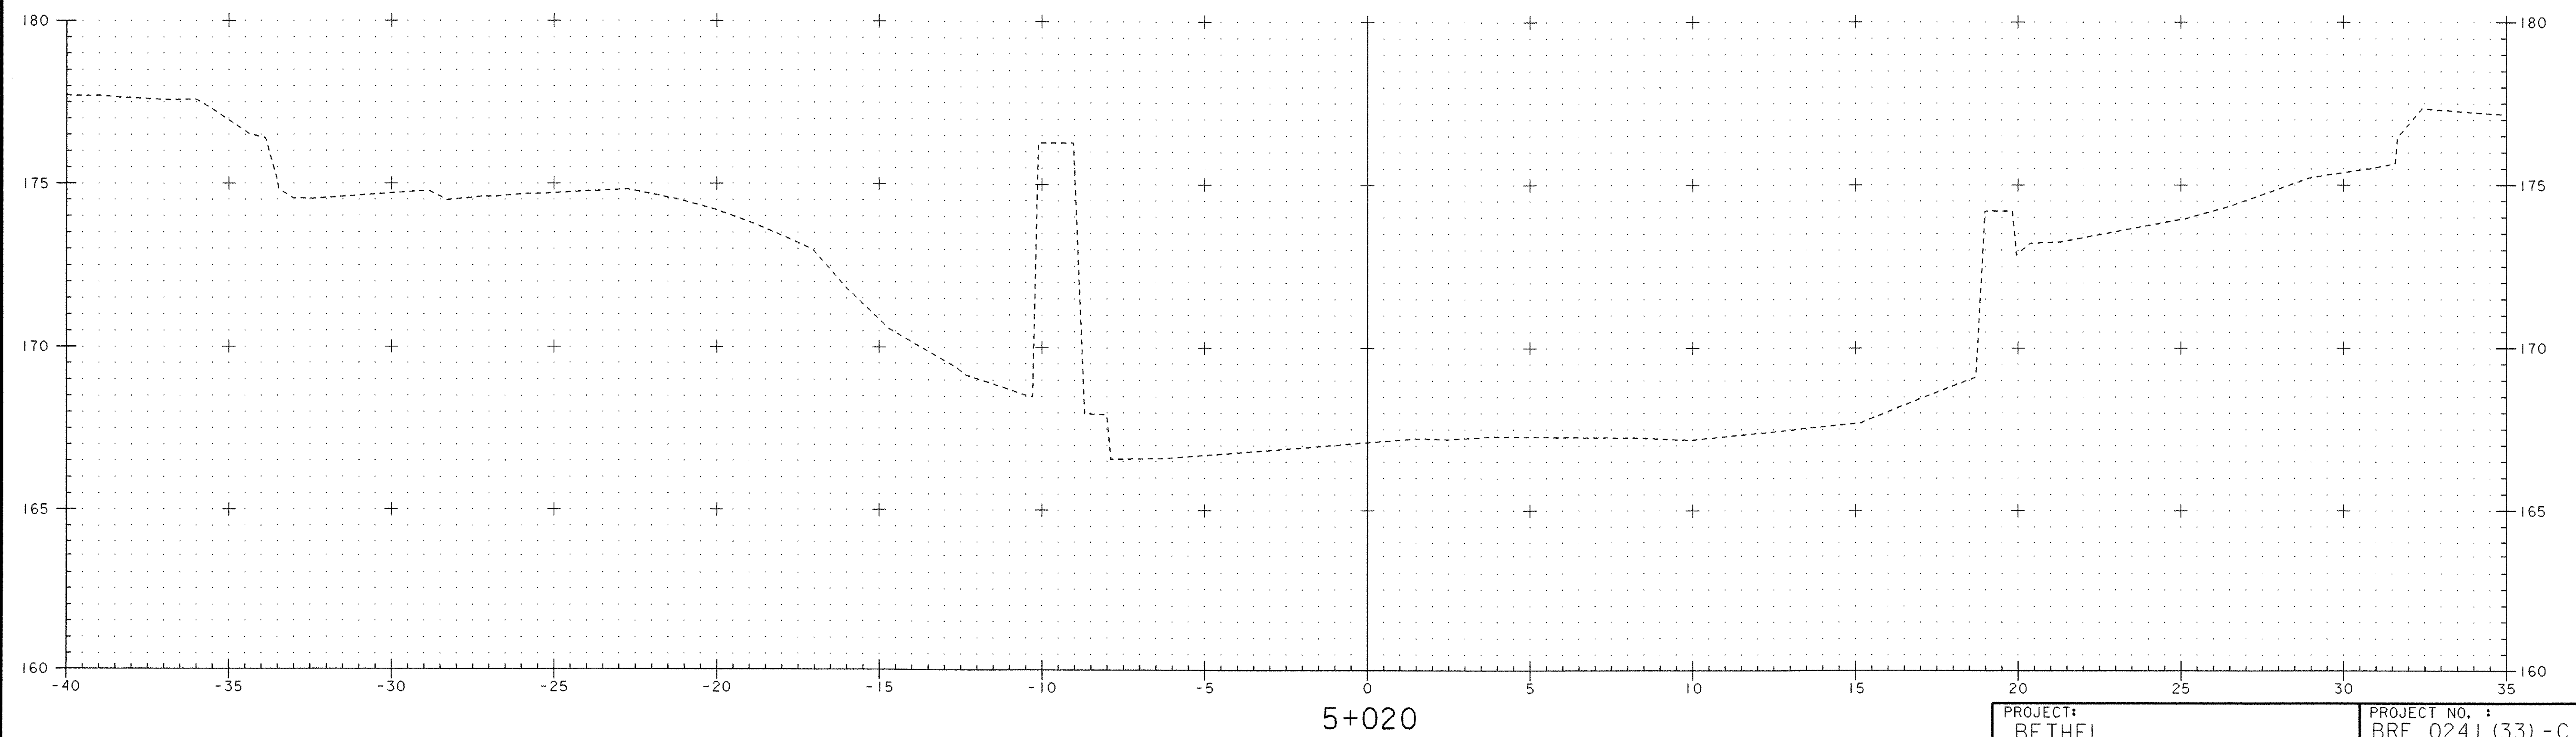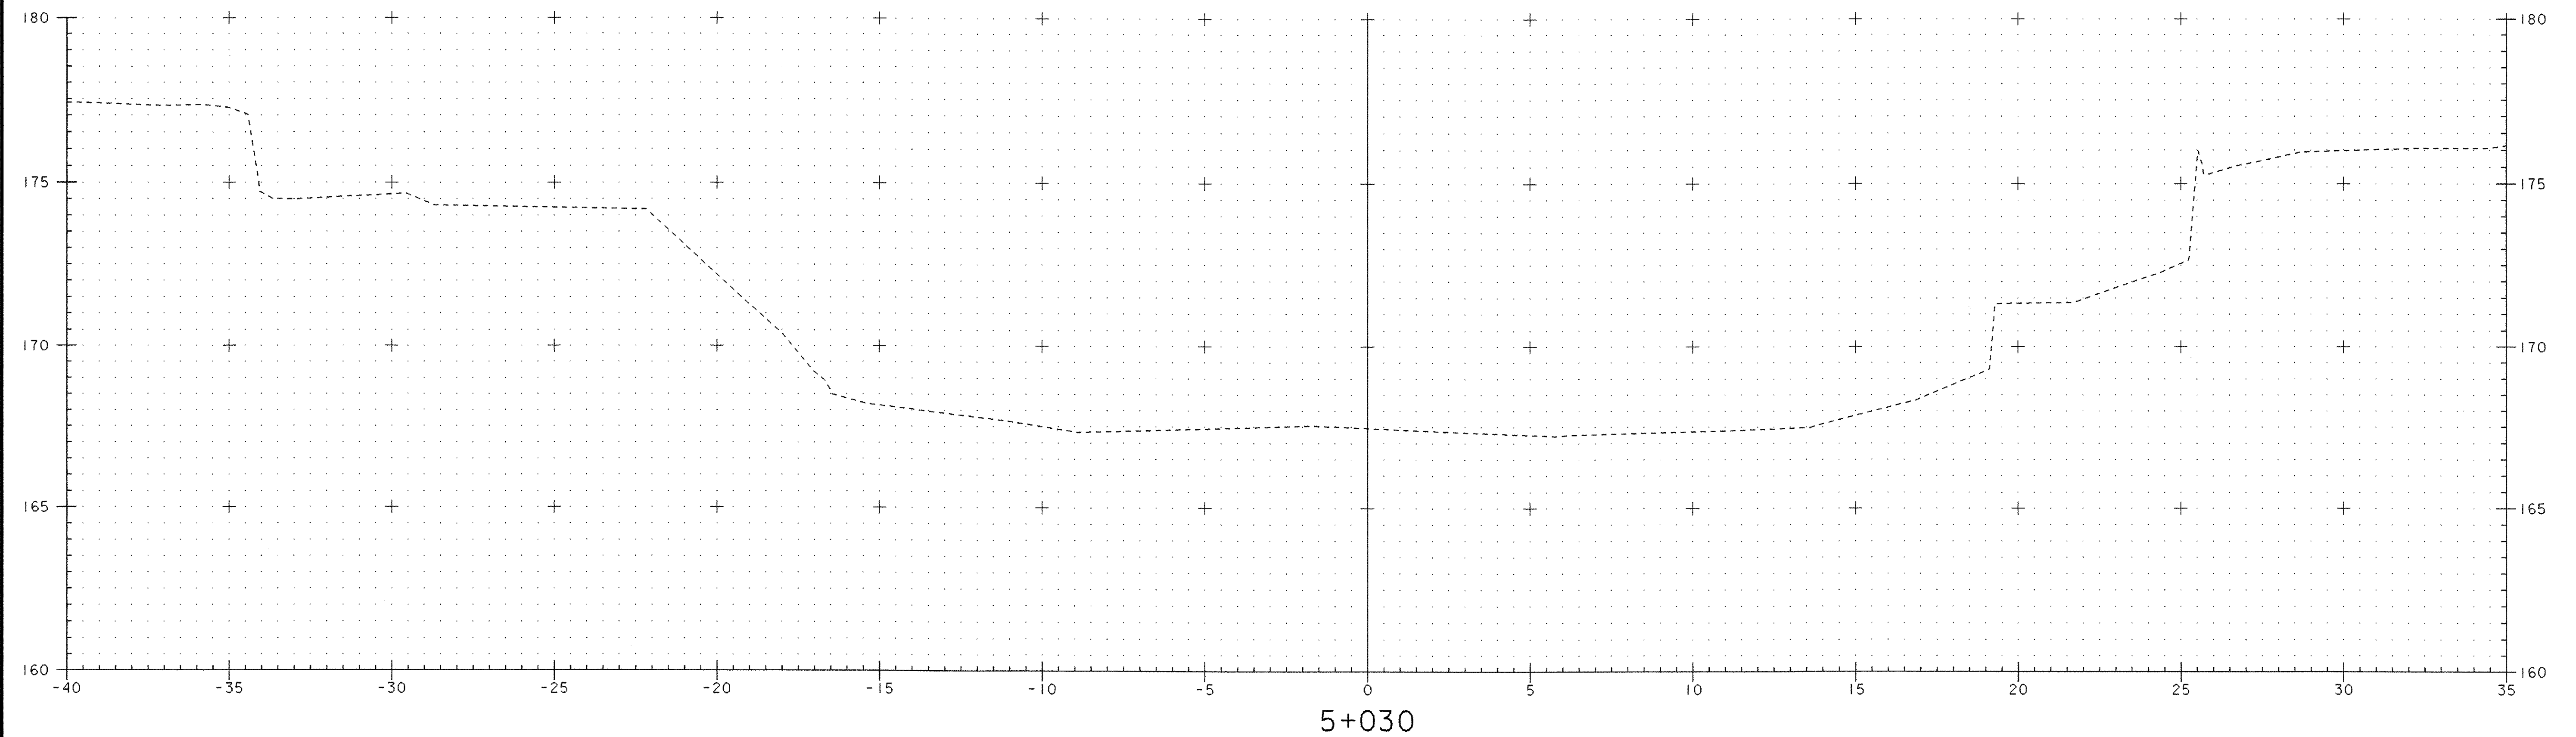

0 2 4 6 8 10  
SCALE 1 : 100

|                                                        |                                     |
|--------------------------------------------------------|-------------------------------------|
| PROJECT:<br>BETHEL                                     | PROJECT NO. :<br>BRF 0241 (33) - C1 |
| DESIGN FILE NAME: 96j250/structures/s96j250xsec-cl.dgn | PLOT DATE: 09-JUL-2003              |
| IPARM FILE NAME: s96j250ch5.i                          |                                     |
| CHANNEL CROSS SECTIONS                                 |                                     |
| STA 5+020 AND STA 5+030                                | SHEET: 47 OF 47                     |