
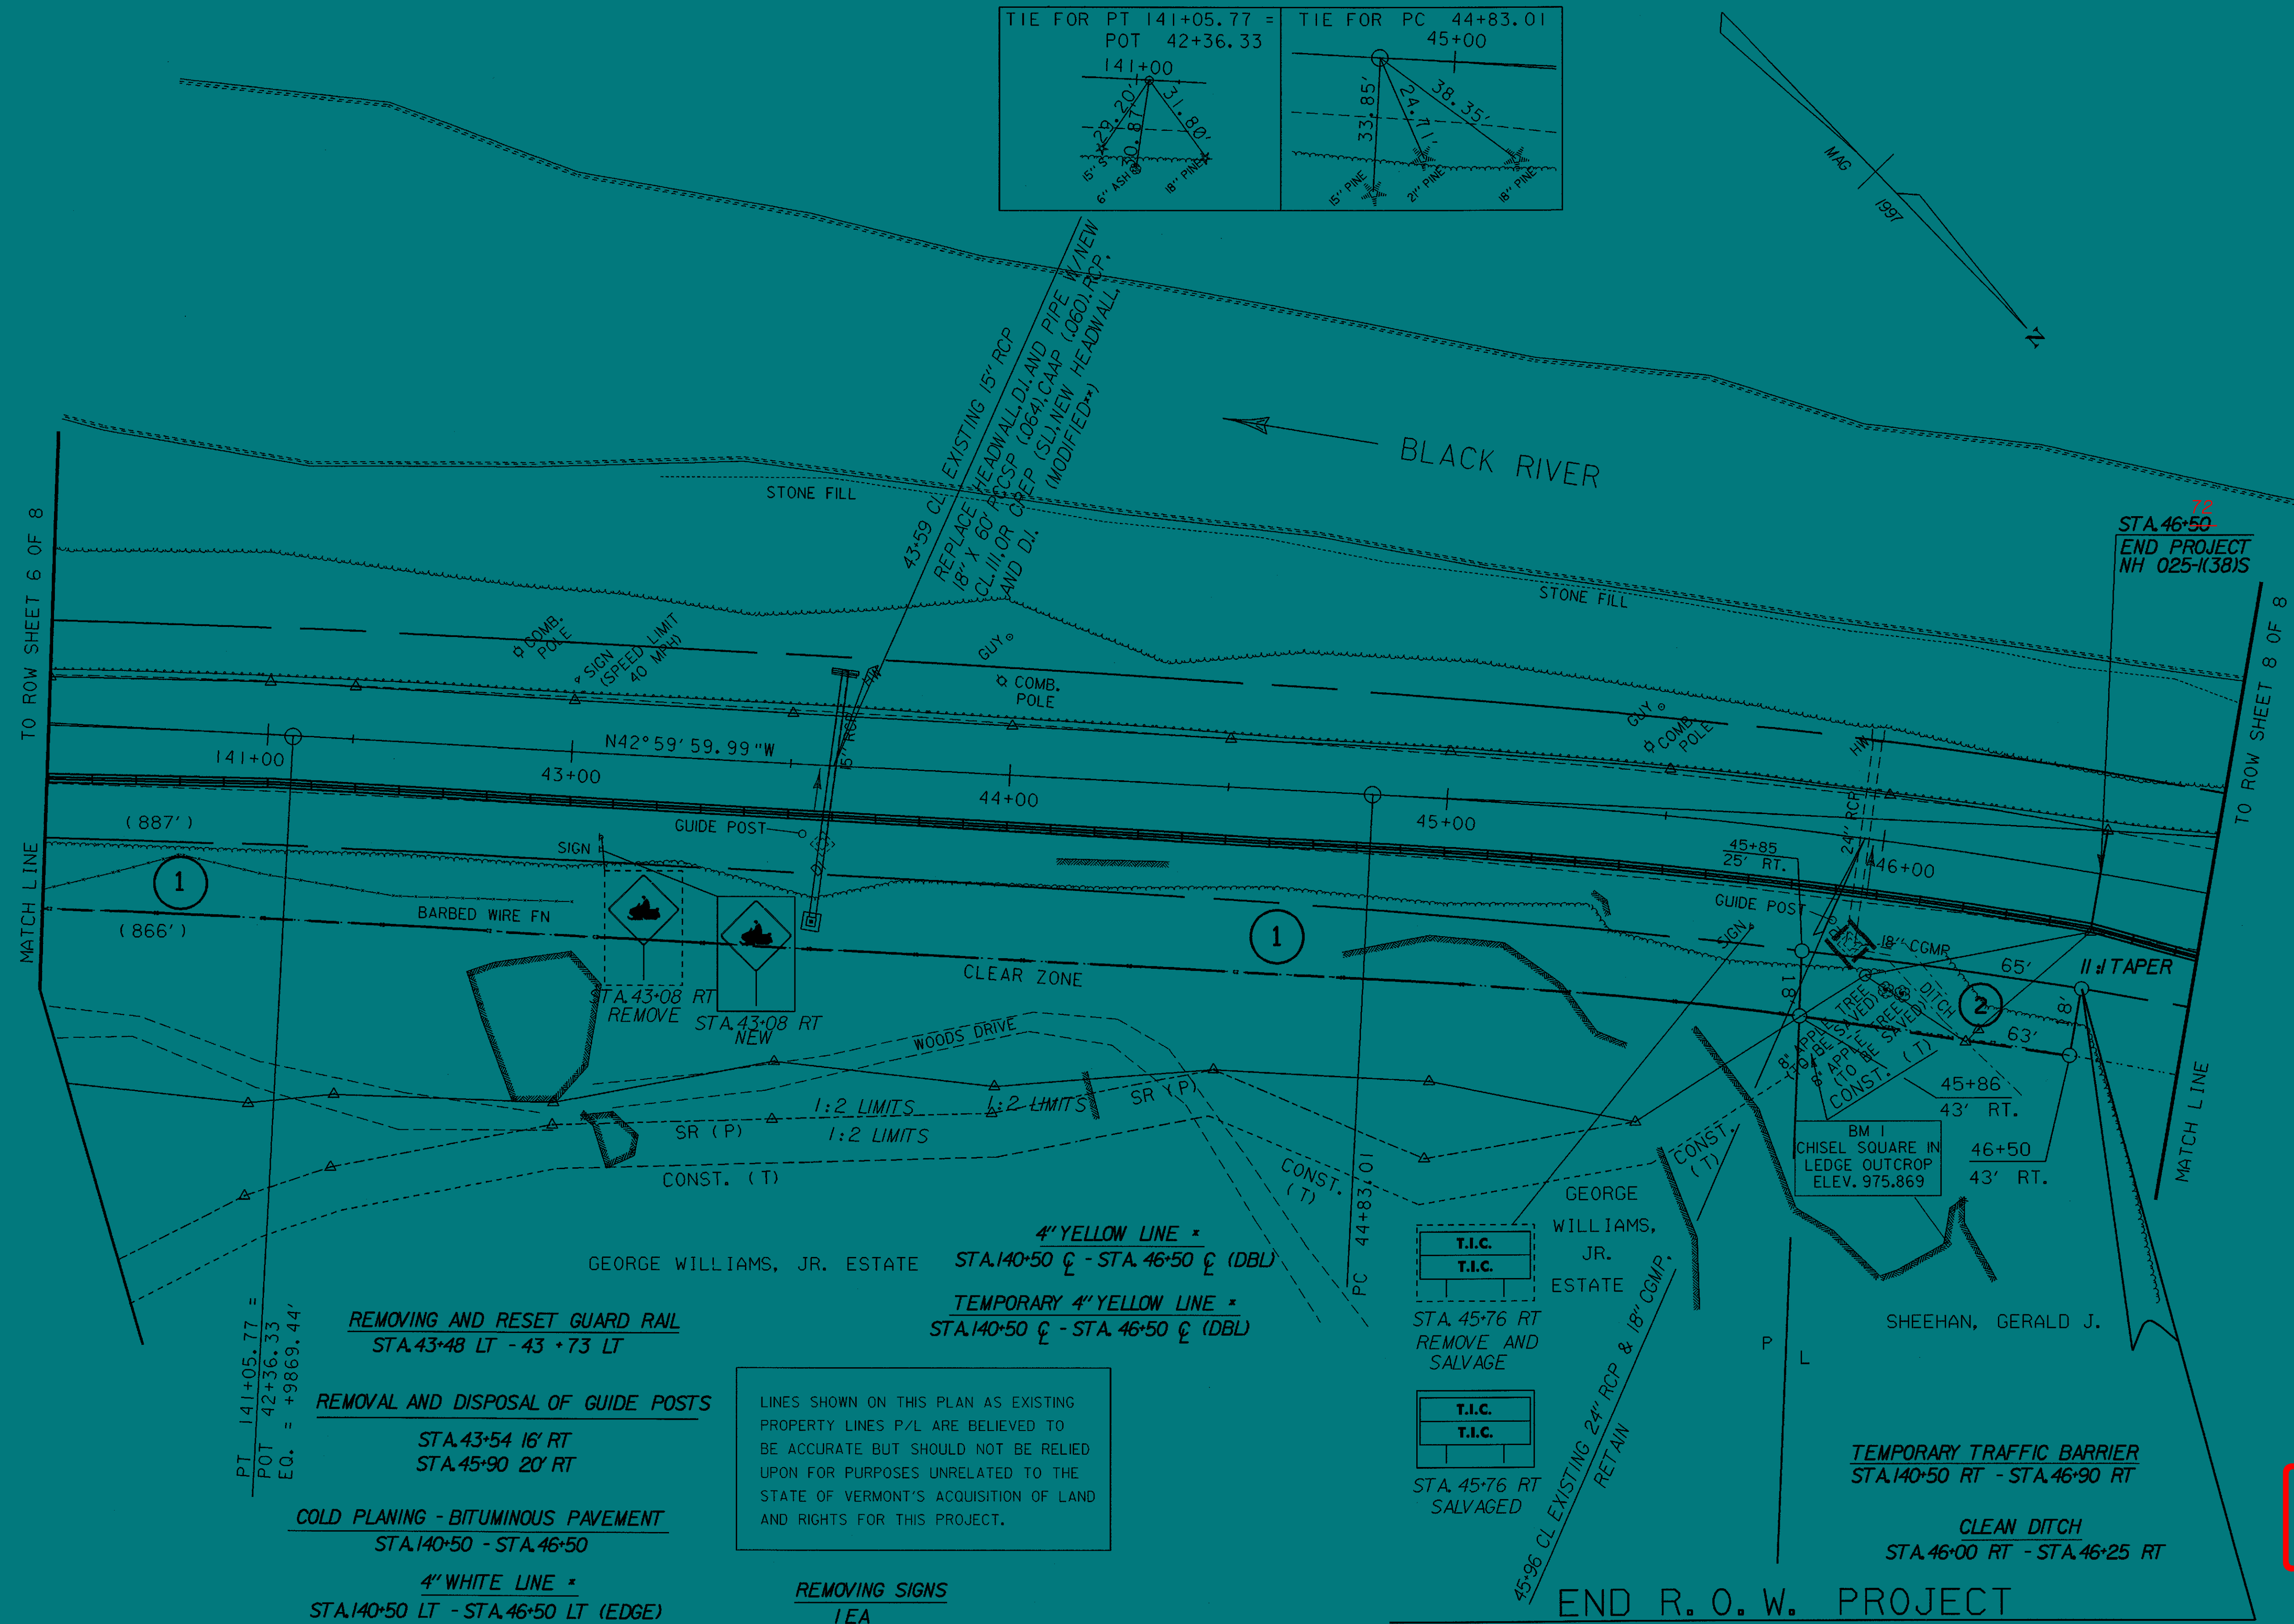


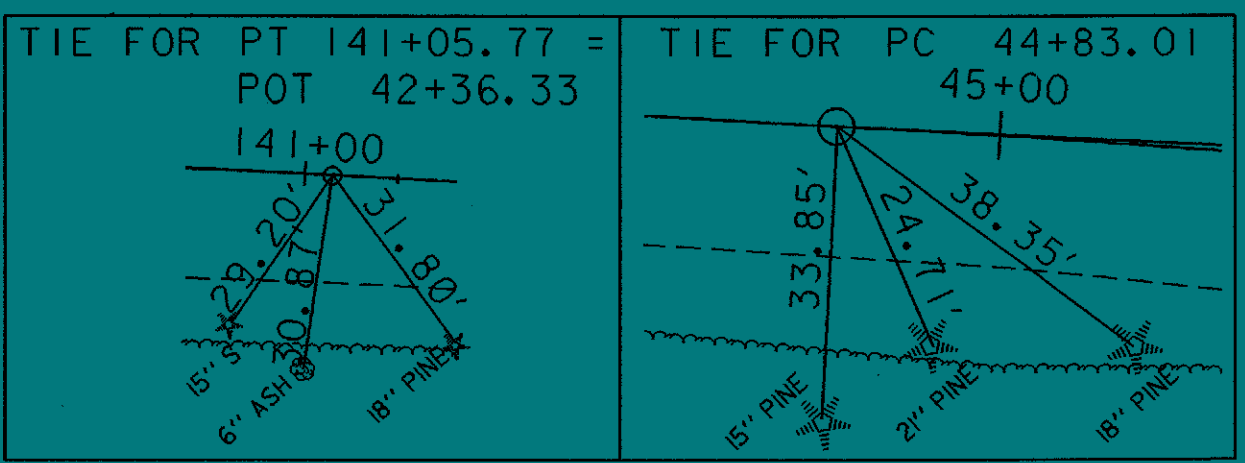

PT 141+05.77 =
POT 42+36.33
EQ. = +9869.44'

REMOVING AND RESET GUARD RAIL
STA.43+48 LT - 43+73 LT

REMOVAL AND DISPOSAL OF GUIDE POSTS
STA.43+54 16' RT
STA.45+90 20' RT

COLD PLANING - BITUMINOUS PAVEMENT
STA.140+50 - STA.46+50

4" WHITE LINE *
STA.140+50 LT - STA.46+50 LT (EDGE)
STA.140+50 RT - STA.46+50 RT (EDGE)

TEMPORARY 4" WHITE LINE *
STA.140+50 LT - STA.46+50 LT (EDGE)
STA.140+50 RT - STA.46+50 RT (EDGE)

* SEE PAVEMENT MARKING TYPICAL ON SHEET 3
NOTE: ACTUAL SIGNS SHOWN ARE NOT DRAWN TO SCALE.

LINES SHOWN ON THIS PLAN AS EXISTING
PROPERTY LINES P/L ARE BELIEVED TO
BE ACCURATE BUT SHOULD NOT BE RELIED
UPON FOR PURPOSES UNRELATED TO THE
STATE OF VERMONT'S ACQUISITION OF LAND
AND RIGHTS FOR THIS PROJECT.

REMOVING SIGNS
IEA

REMOVAL OF EXISTING FENCE
STA.140+50 RT - STA.43+00 RT

EROSION CONTROL
HAY BALES AT D.I. FOR INLET PROTECTION

4" YELLOW LINE *
STA.140+50 C - STA.46+50 C (DBL)

TEMPORARY 4" YELLOW LINE *
STA.140+50 C - STA.46+50 C (DBL)

T.I.C.
T.I.C.
STA. 45+76 RT
REMOVE AND
SALVAGE

TEMPORARY TRAFFIC BARRIER
STA.140+50 RT - STA.46+90 RT

CLEAN DITCH
STA.46+00 RT - STA.46+25 RT

END R.O.W. PROJECT
NH 025-1(38)S STA. 46+50 25' RT.



PROJECT: LUDLOW	PROJECT NO.: NH 025-1(38)S
DESIGN FILE NAME: /97b076/rightofway/rb076zzz.dgn	PLOT DATE: 07-APR-2000
IPARM FILE NAME: rb076l3r.l	SURVEY DATE: 9/15/97
SURVEYED BY: ORVIS	DRAWN BY: SADB
SQUAD LEADER: DELLA SANTA	
R.O.W. SHEET 7 OF 8 SHEETS	SHEET 10 OF 31

DATUM
VERTICAL NAVD 1929
HORIZONTAL ASSUMED