


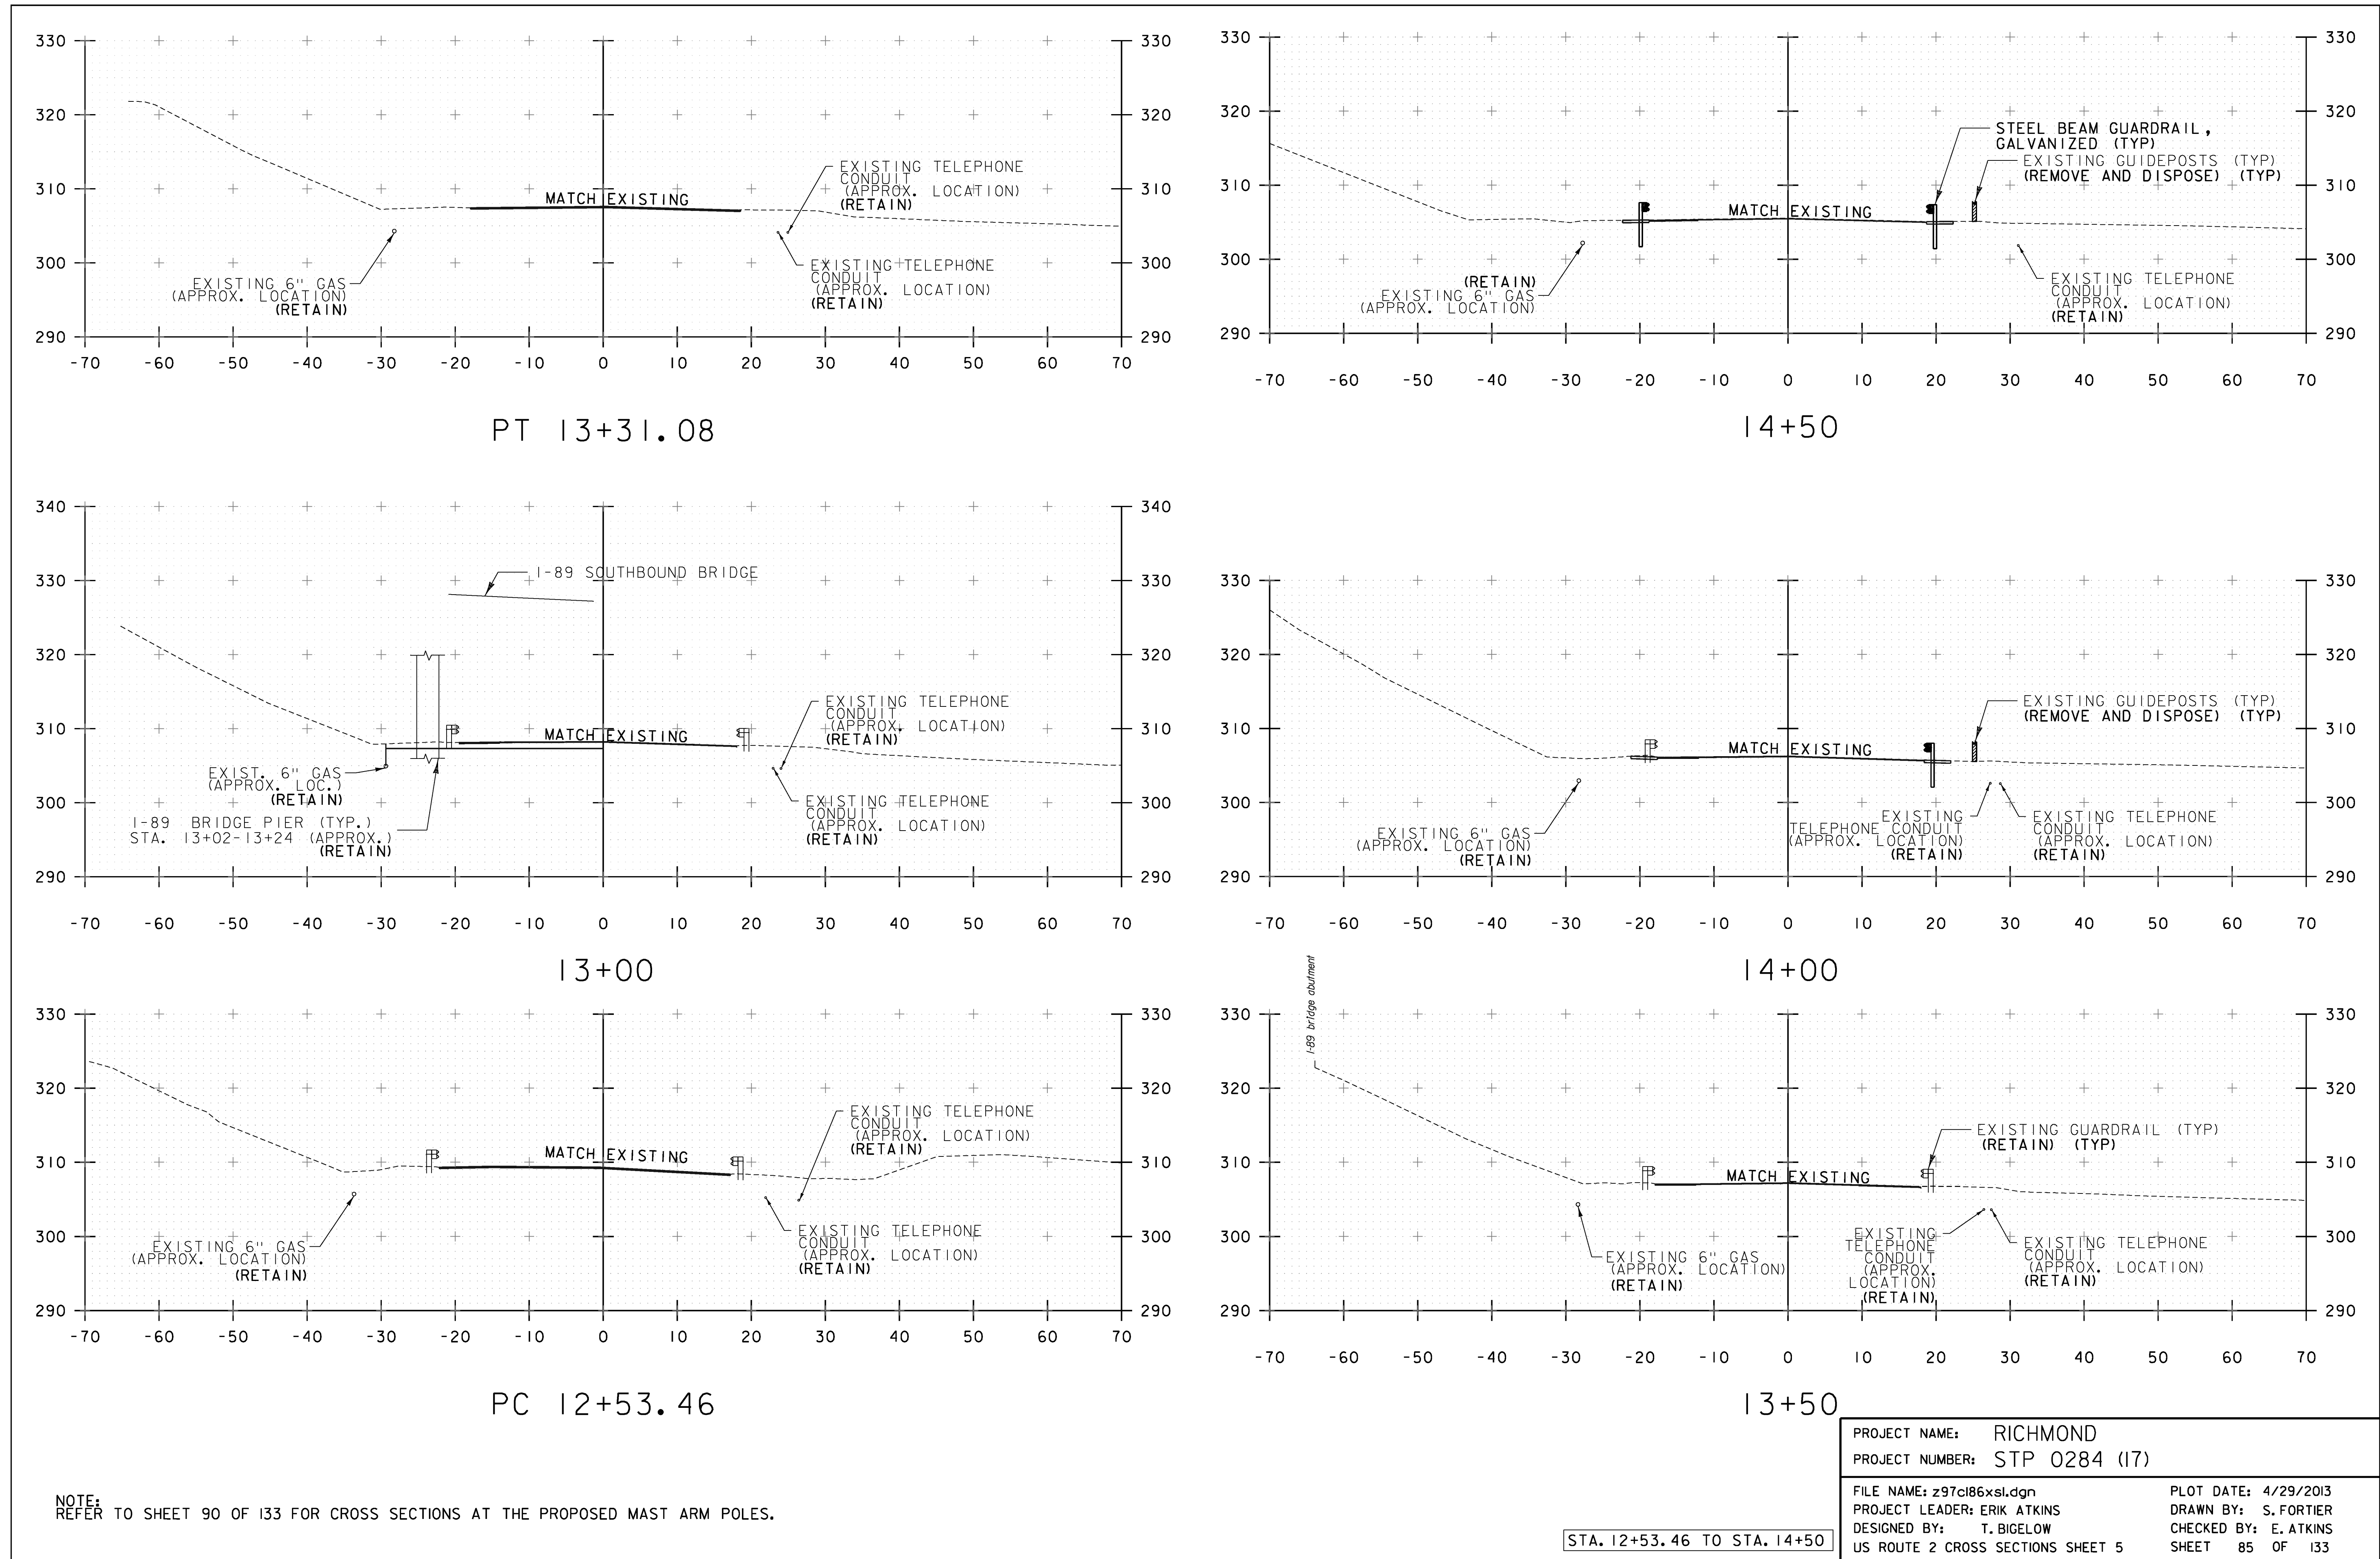

PROJECT NAME: RICHMOND	
PROJECT NUMBER: STP 0284 (I7)	
FILE NAME: z97ci86xsl.dgn	PLOT DATE: 4/29/2013
PROJECT LEADER: ERIK ATKINS	DRAWN BY: S. FORTIER
DESIGNED BY: T. BIGELOW	CHECKED BY: E. ATKINS
US ROUTE 2 CROSS SECTIONS SHEET 5	SHEET 85 OF 133