


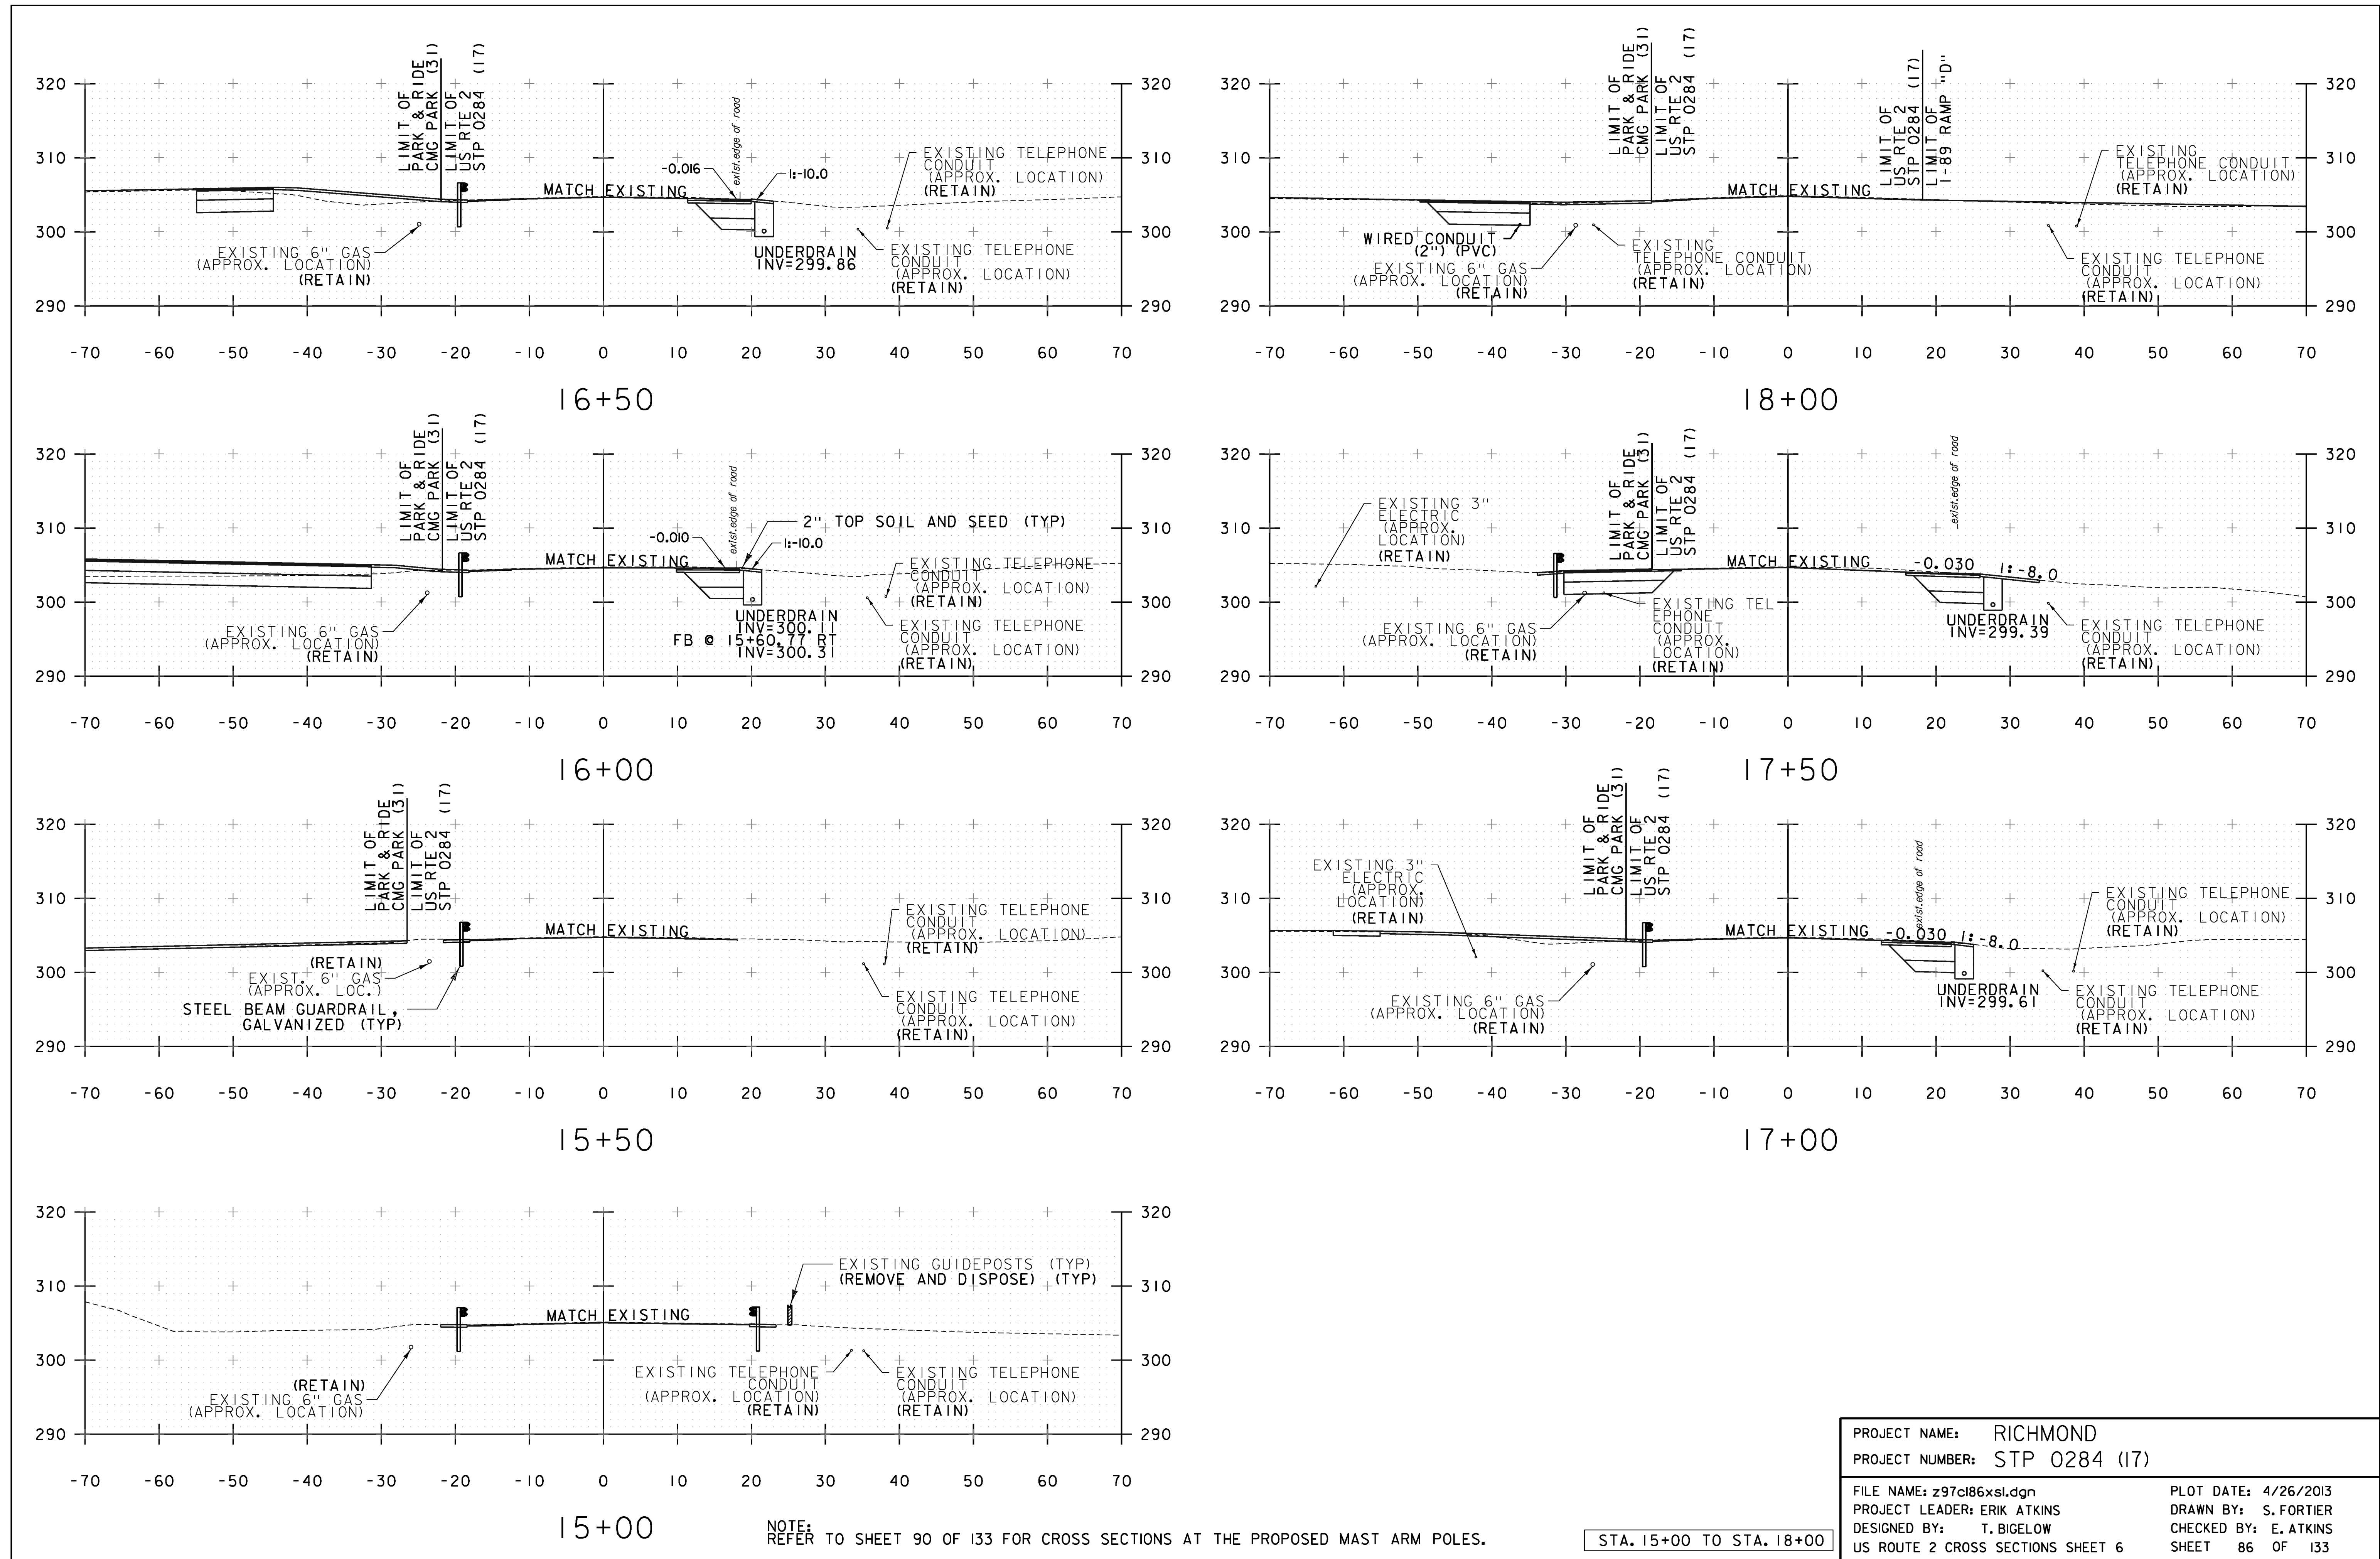

PROJECT NAME: RICHMOND	
PROJECT NUMBER: STP 0284 (17)	
FILE NAME: z97ci86xsl.dgn	PLOT DATE: 4/26/2013
PROJECT LEADER: ERIK ATKINS	DRAWN BY: S.FORTIER
DESIGNED BY: T. BIGELOW	CHECKED BY: E. ATKINS
US ROUTE 2 CROSS SECTIONS SHEET 6	SHEET 86 OF 133

NOTE:
REFER TO SHEET 90 OF 133 FOR CROSS SECTIONS AT THE PROPOSED MAST ARM POLES.

STA. 15+00 TO STA. 18+00