




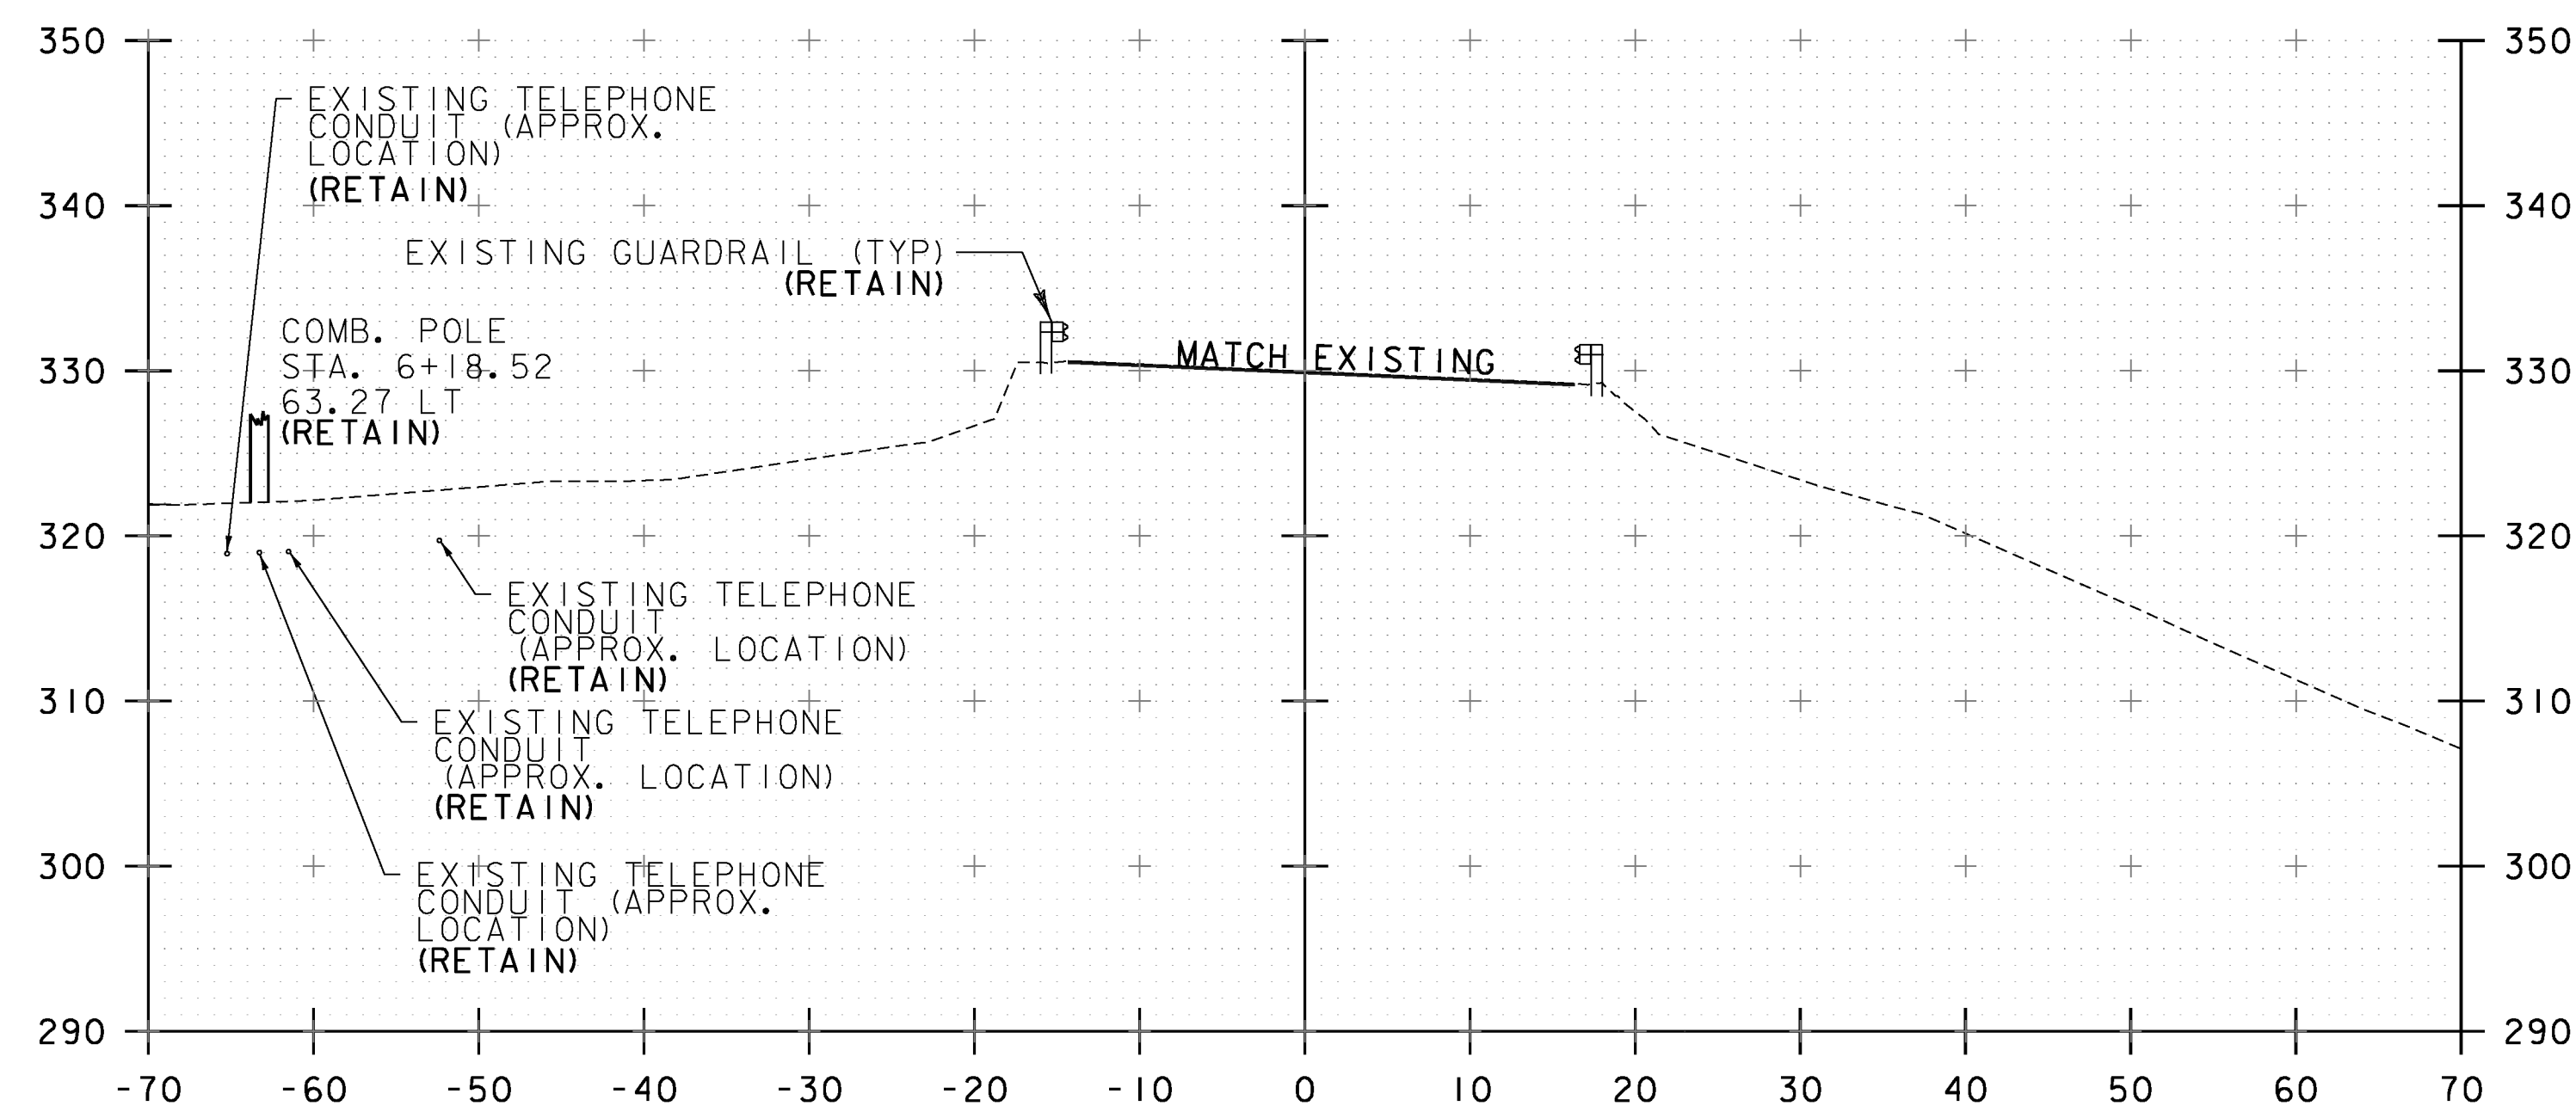


STA. 6+00 SKEWED 22°07' 37"
BEGIN PROJECT
MATCH EXISTING BCP

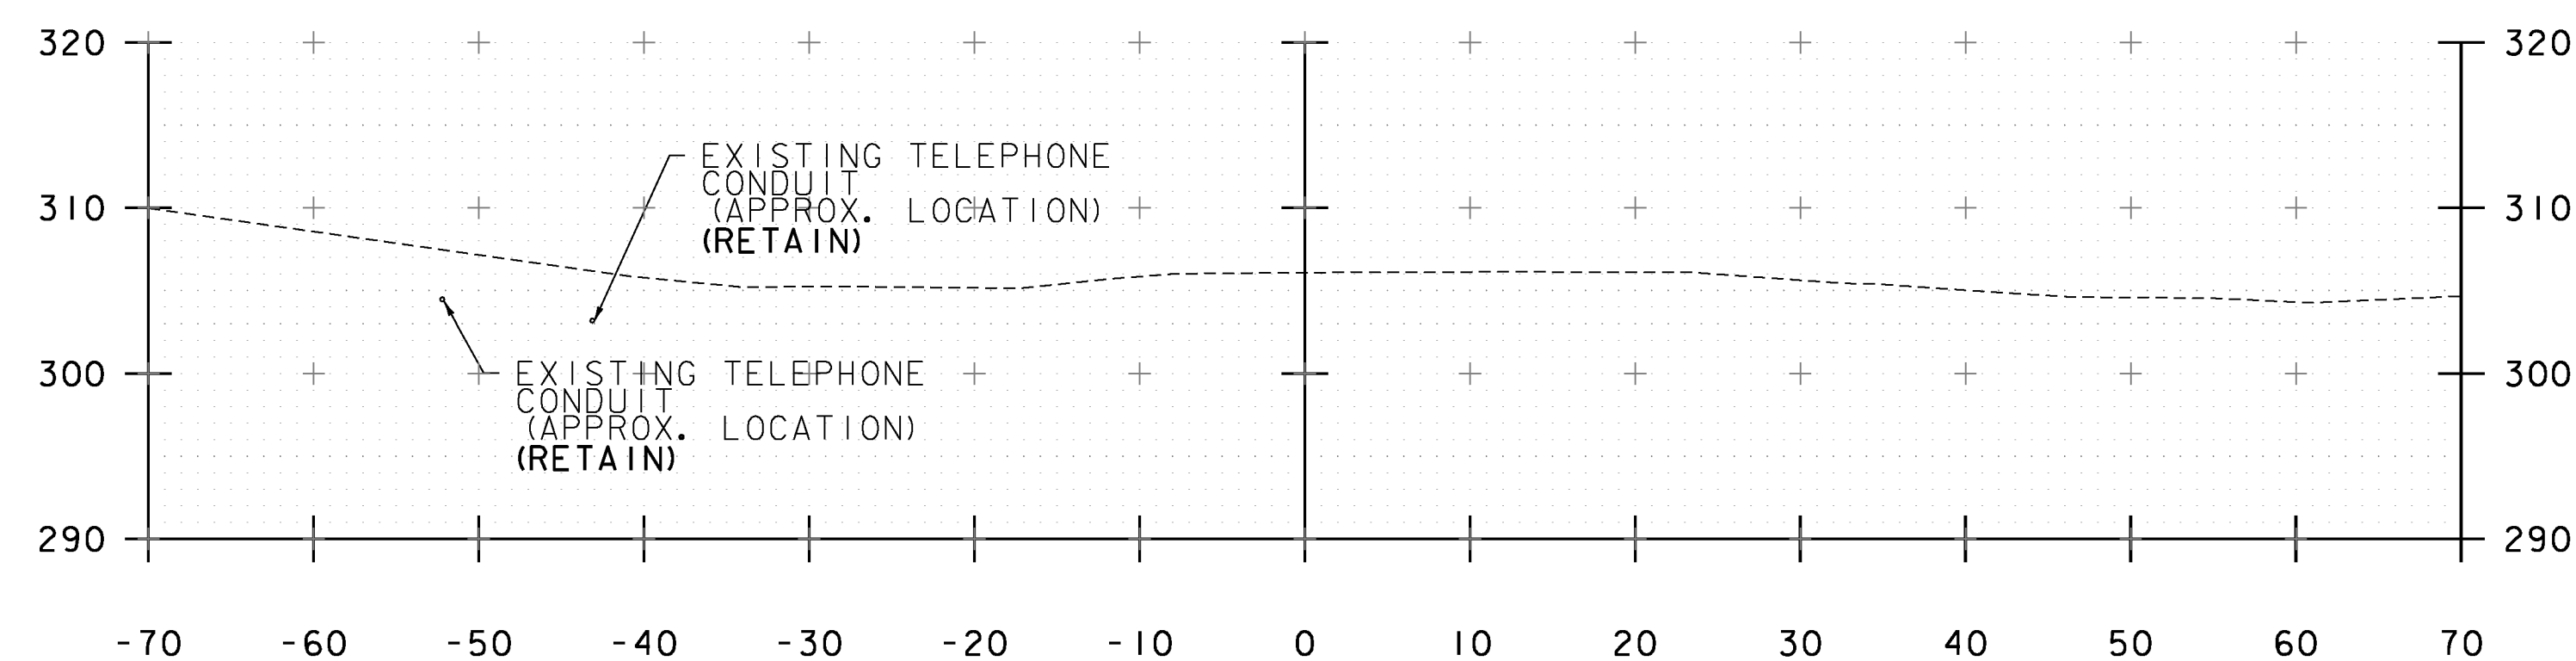

5+50

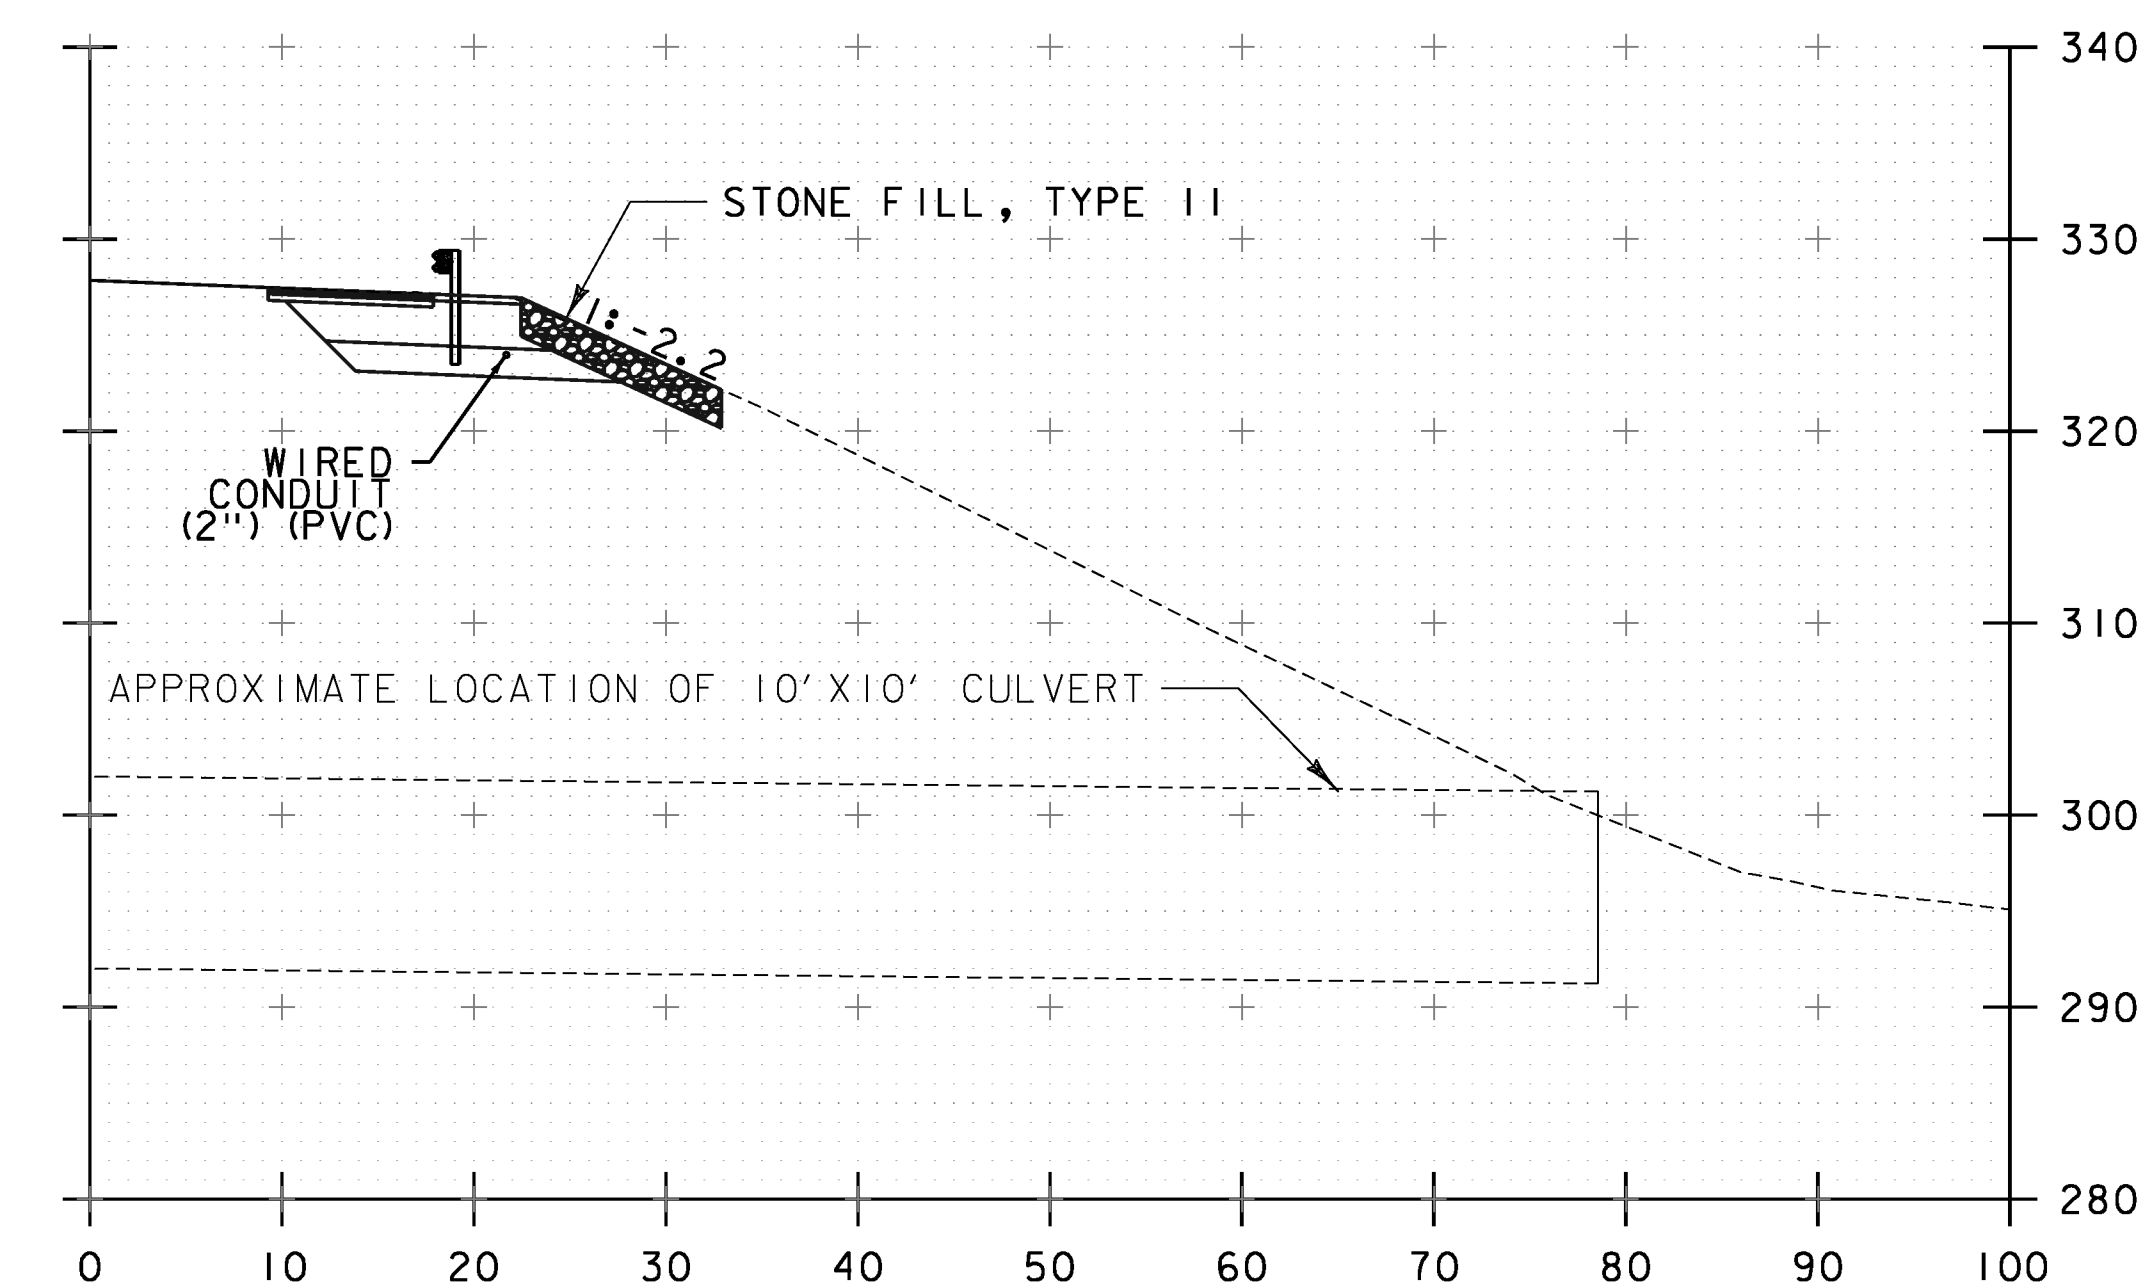

STA. 6+75.02 SKEWED 11°17' 15"

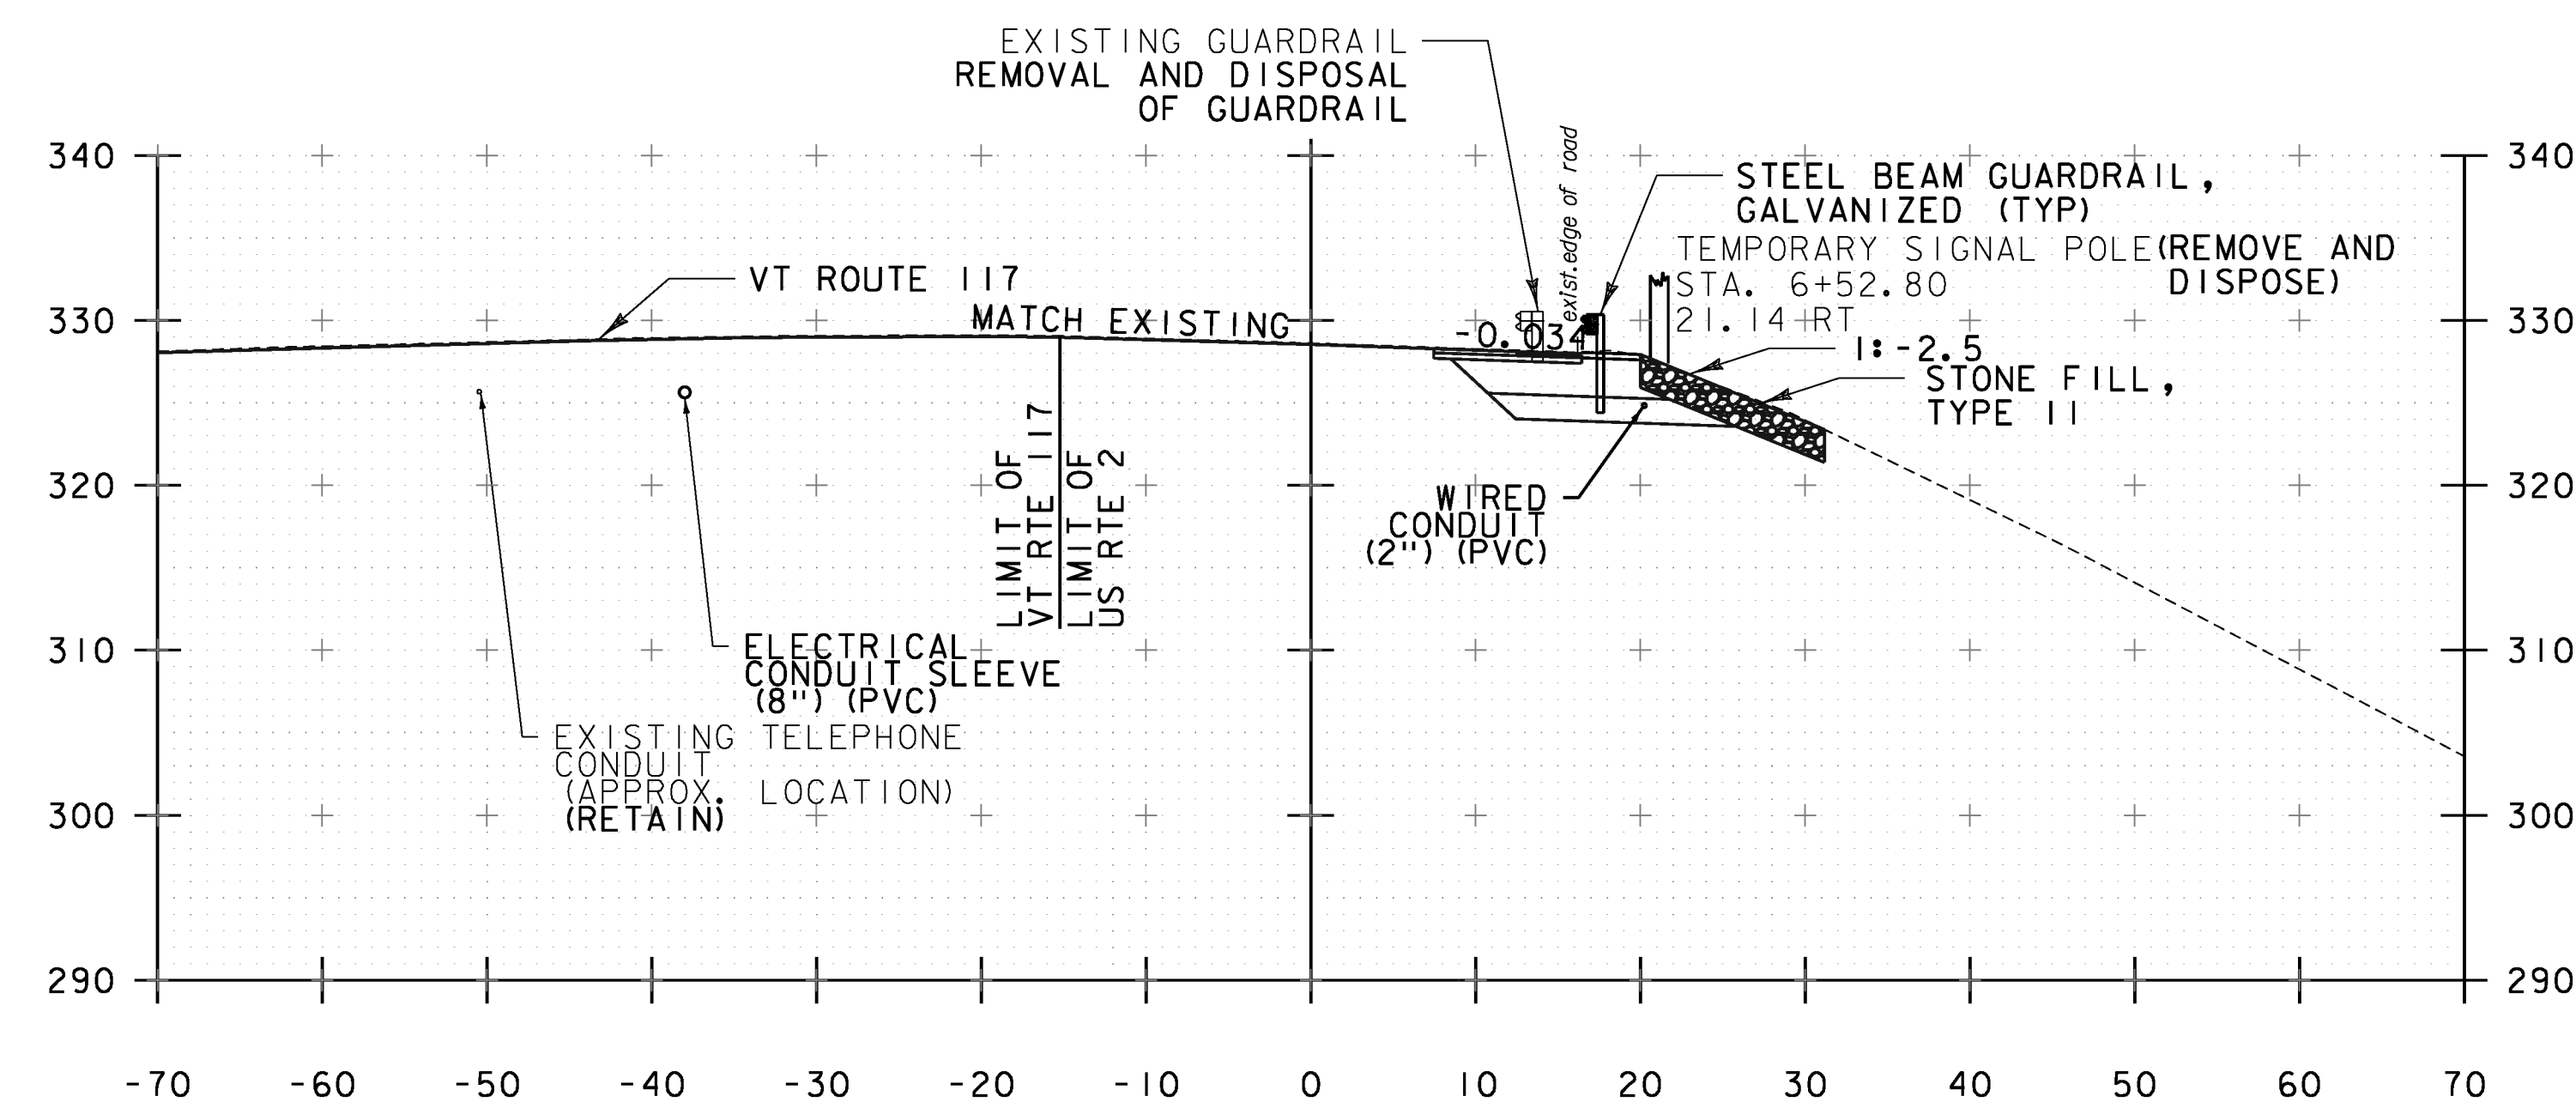

6+50

PROJECT NAME: RICHMOND
PROJECT NUMBER: STP 0284 (17)

FILE NAME: z97ci86xsl.dgn PLOT DATE: 4/26/2013
PROJECT LEADER: ERIK ATKINS DRAWN BY: S. FORTIER
DESIGNED BY: T. BIGELOW CHECKED BY: E. ATKINS
US ROUTE 2 CROSS SECTIONS SHEET 1 SHEET 81 OF 133

STA. 5+50 TO STA. 6+75.02

NOTE:
REFER TO SHEET 90 OF 133 FOR CROSS SECTIONS AT THE PROPOSED MAST ARM POLES.