


STEEL BEAM GUARDRAIL, GALVANIZED
 US RTE 2 10+00.0 RT - US RTE 2 10+87.1 RT
 US RTE 2 13+83.0 RT - US RTE 2 15+00.0 RT
 US RTE 2 14+08.8 LT - US RTE 2 15+00.0 LT

REPLACE GUARDRAIL BEAM UNIT
US RTE 2 II+03.6 LT - US RTE 2 I3+23.5 LT

REMOVAL AND DISPOSAL OF GUARDRAIL
US RTE 2 I0+00.0 RT - US RTE 2 I0+95.1RT
US RTE 2 I3+83.0 RT - US RTE 2 I3+95.5 RT
US RTE 2 I3+93.8 LT - US RTE 2 I4+34.5 LT

REMOVAL AND DISPOSAL OF GUIDE POST
US RTE 2 I3+98.5 - US RTE 2 I5+00.0 RT

EXISTING DRAINAGE
 US RTE 2 14+40.4 LT - US RTE 2 14+76.3 LT
 EXISTING PIPE - RETAIN
 EXISTING DRAINAGE 14+40.4 LT - RETAIN

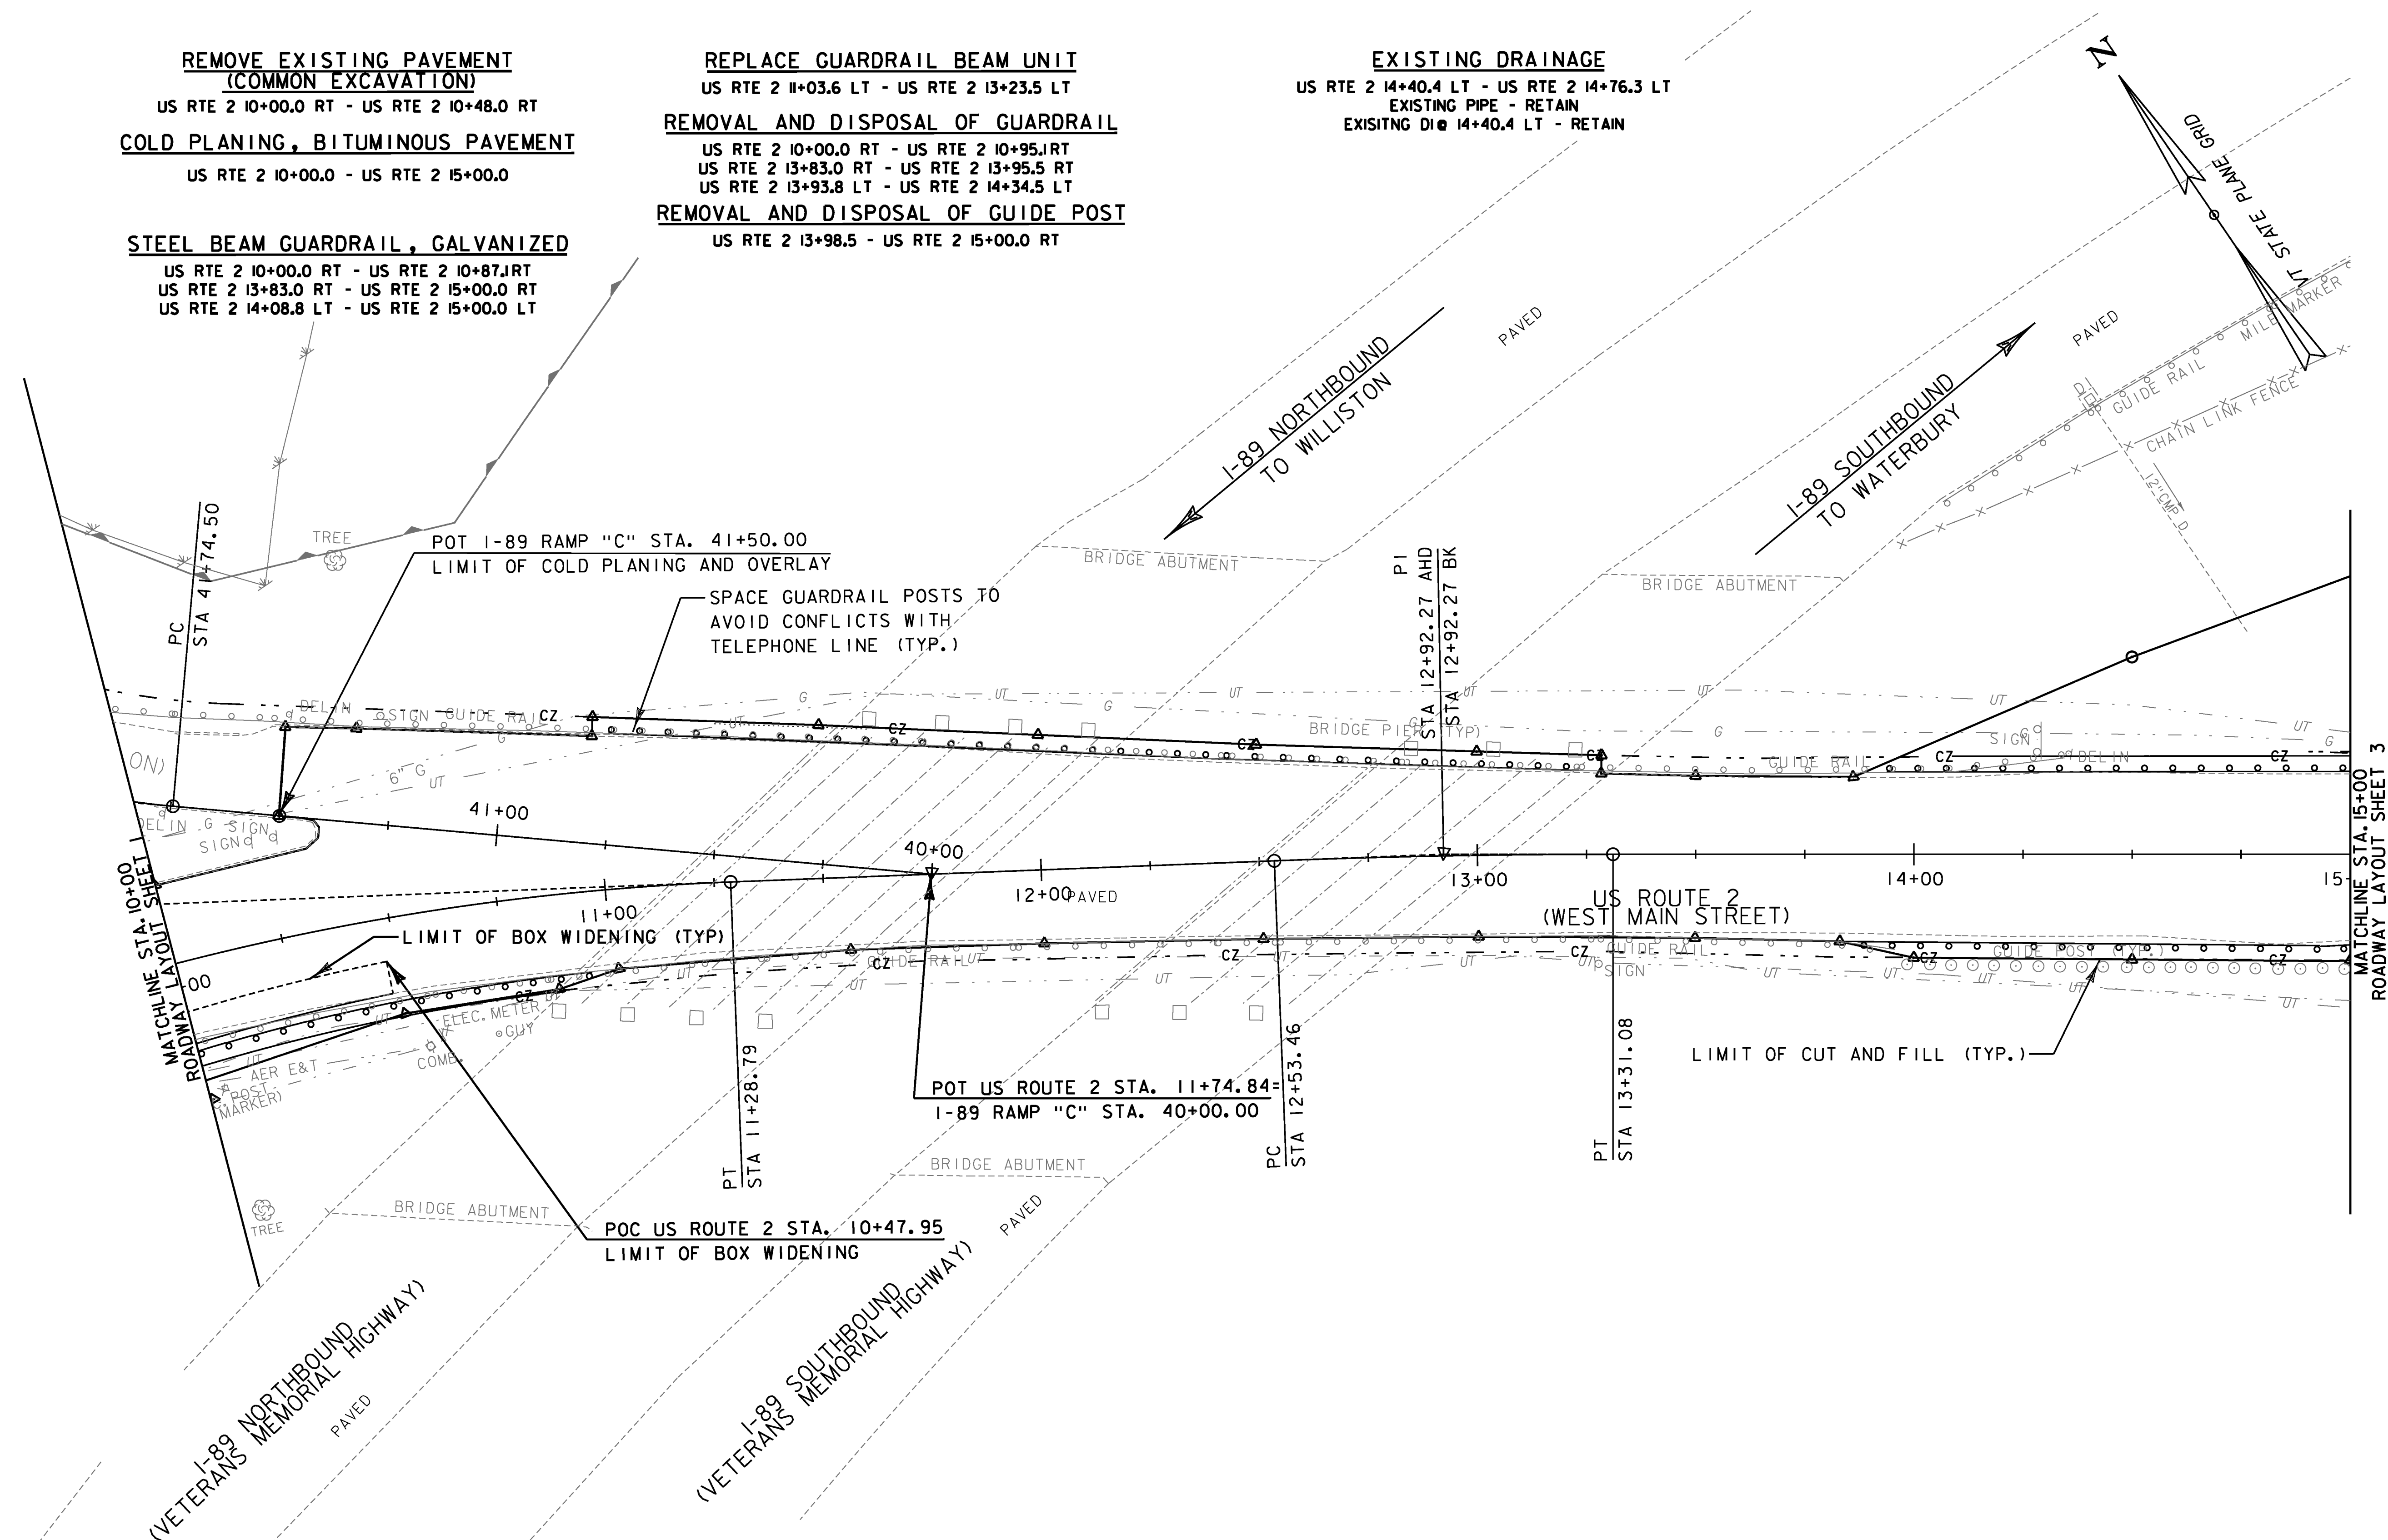

PROJECT NAME:	RICHMOND
PROJECT NUMBER:	STP 0284 (17)

FILE NAME: z97c186bdr.dgn	PLOT DATE: 4/26/2013
PROJECT LEADER: ERIK ATKINS	DRAWN BY: N. BOSAN
DESIGNED BY: T. BIGELOW	CHECKED BY: E. ATKINS
ROADWAY LAYOUT SHEET 2	SHEET 50 OF 133