


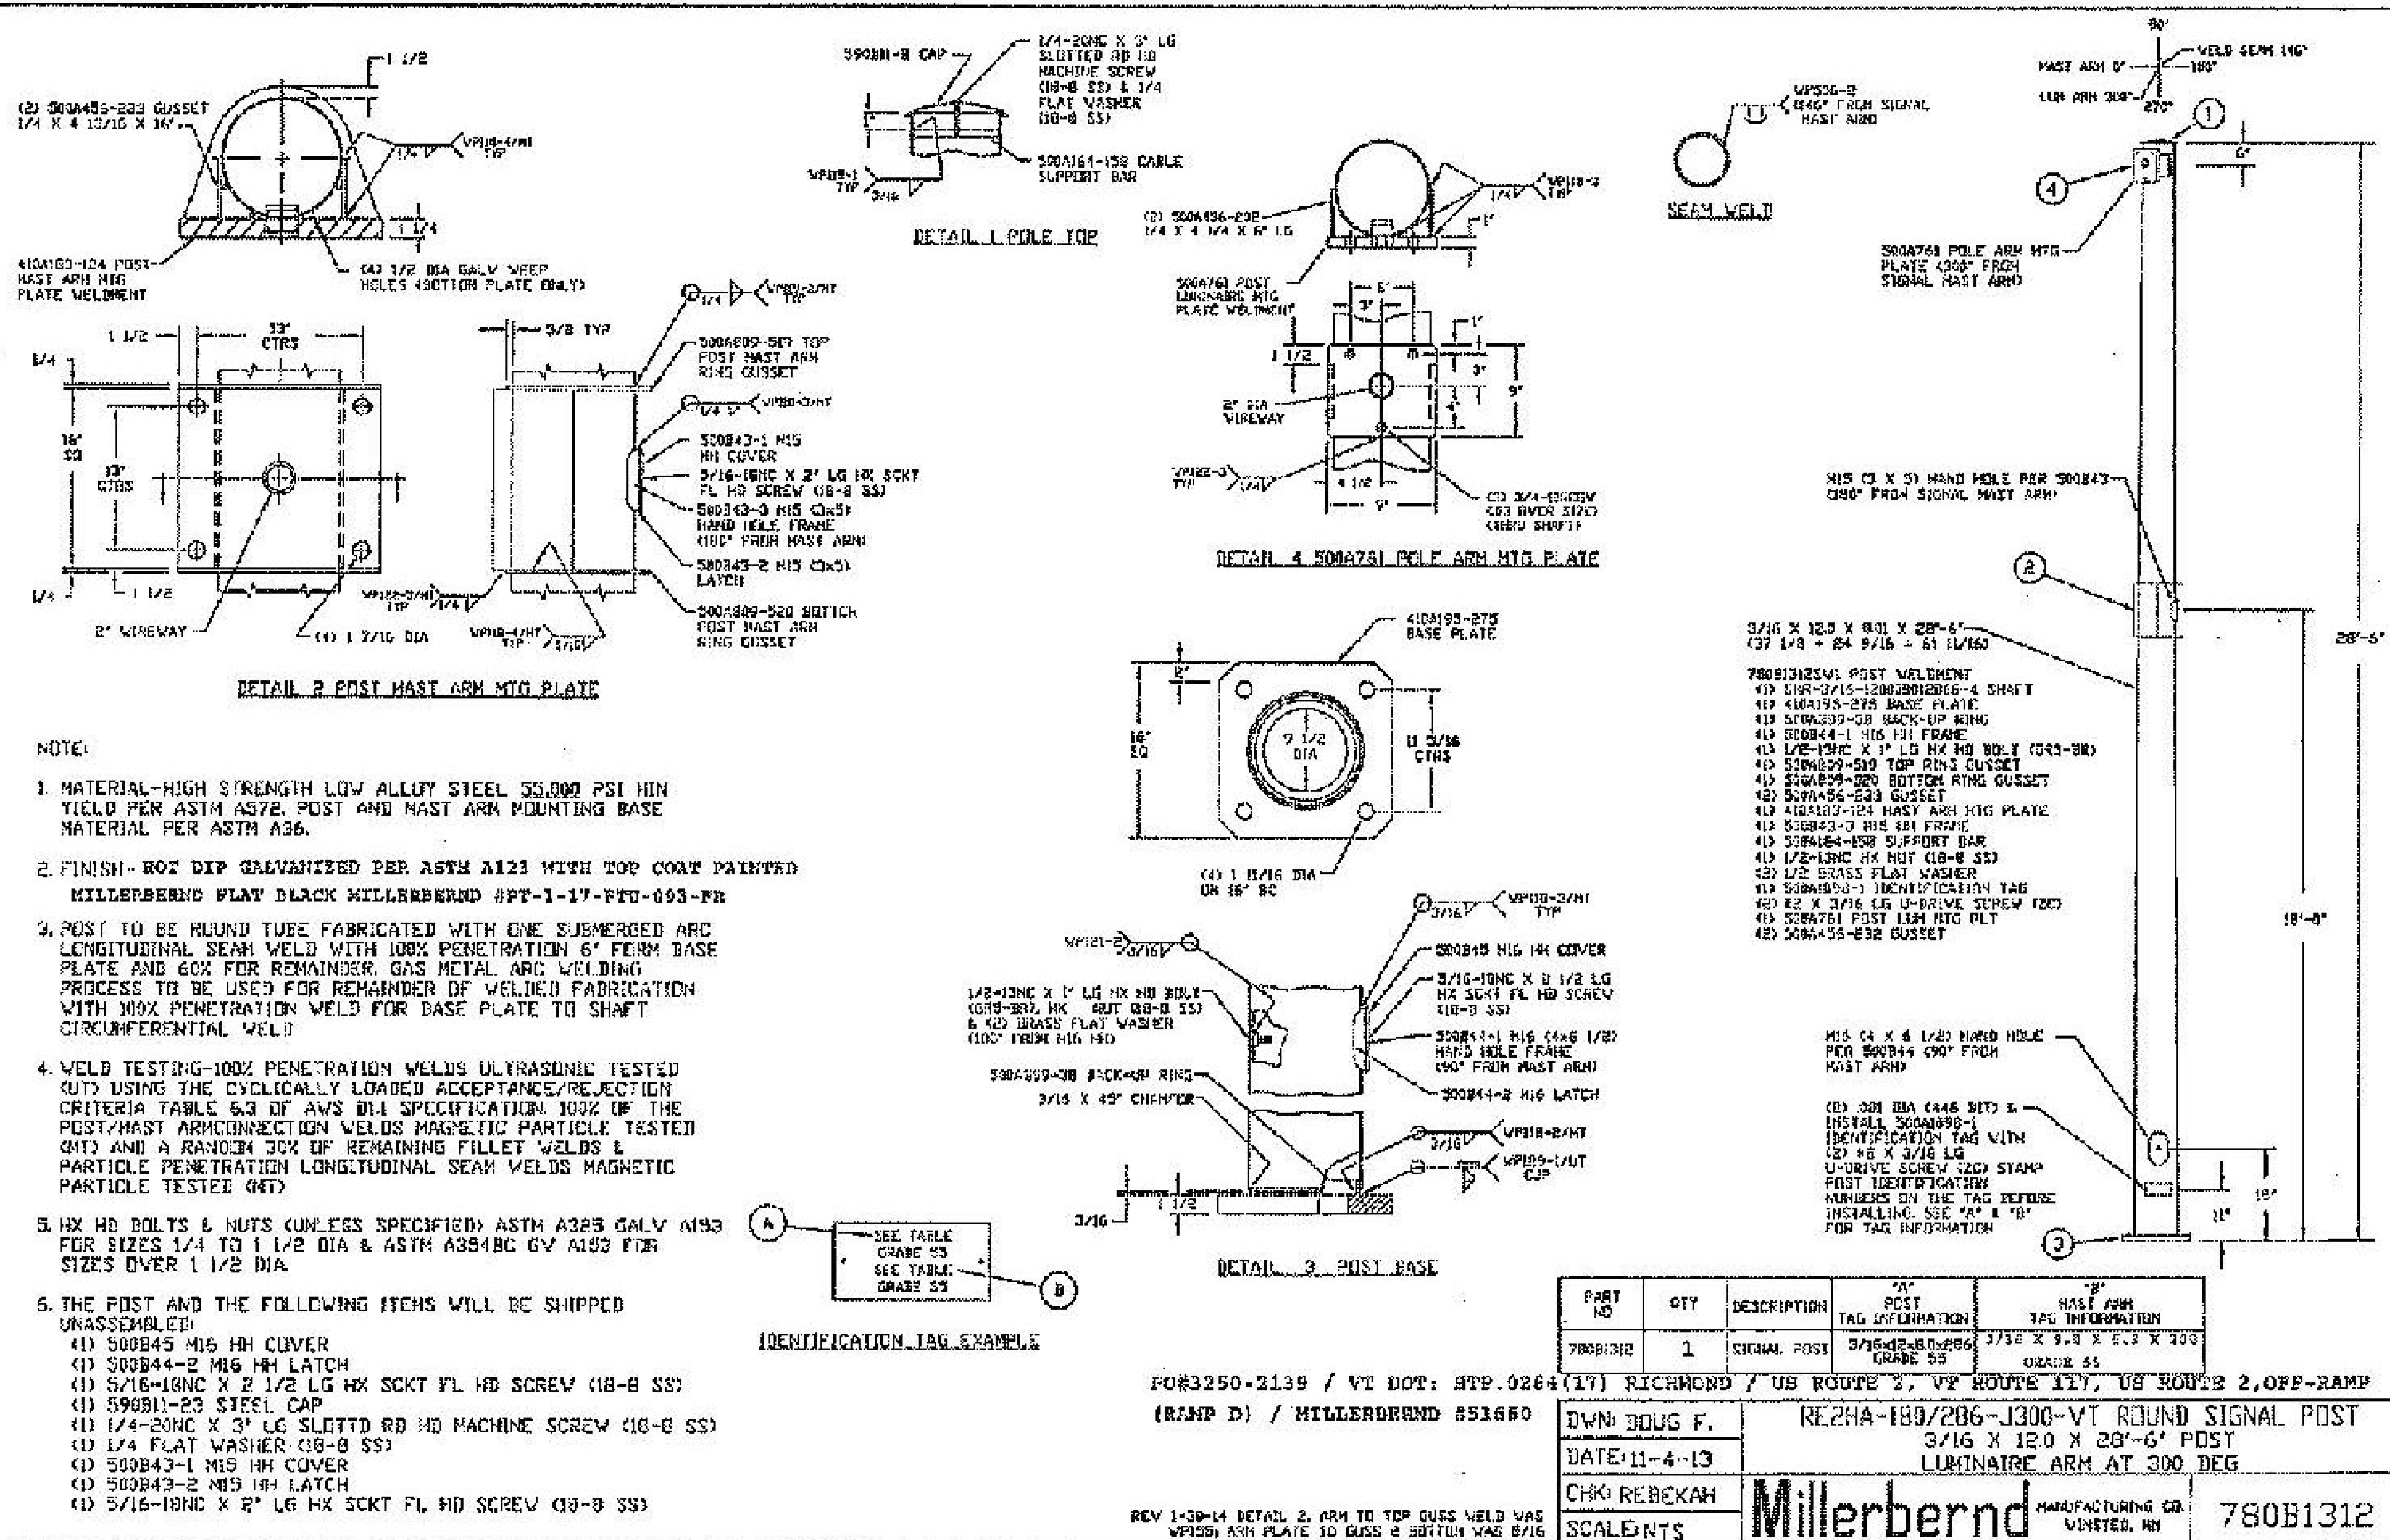

PART NO	QTY	DESCRIPTION	POST TAG INFORMATION	MAST ARM TAG INFORMATION
780B1312	1	SIGNAL POST	3/16 X 120 X 28'-6" POST GRADE 55	3/16 X 9'-3 X 4'-3 X 203 GRADE 55
* (17) RICHMOND / US ROUTE 2, VT ROUTE 127, US ROUTE 2, OFF-RAMP				
DWN BOUS F.		RE2HA-189/286-J300-VT ROUND SIGNAL POST		
DATE: 11-4-13		3/16 X 120 X 28'-6" POST LUMINAIRE ARM AT 300 DEG		
CHK: REBEKAH		Millerbernd		MANUFACTURING CO. VINETON, NH
SCALE: NTS				
				780B1312