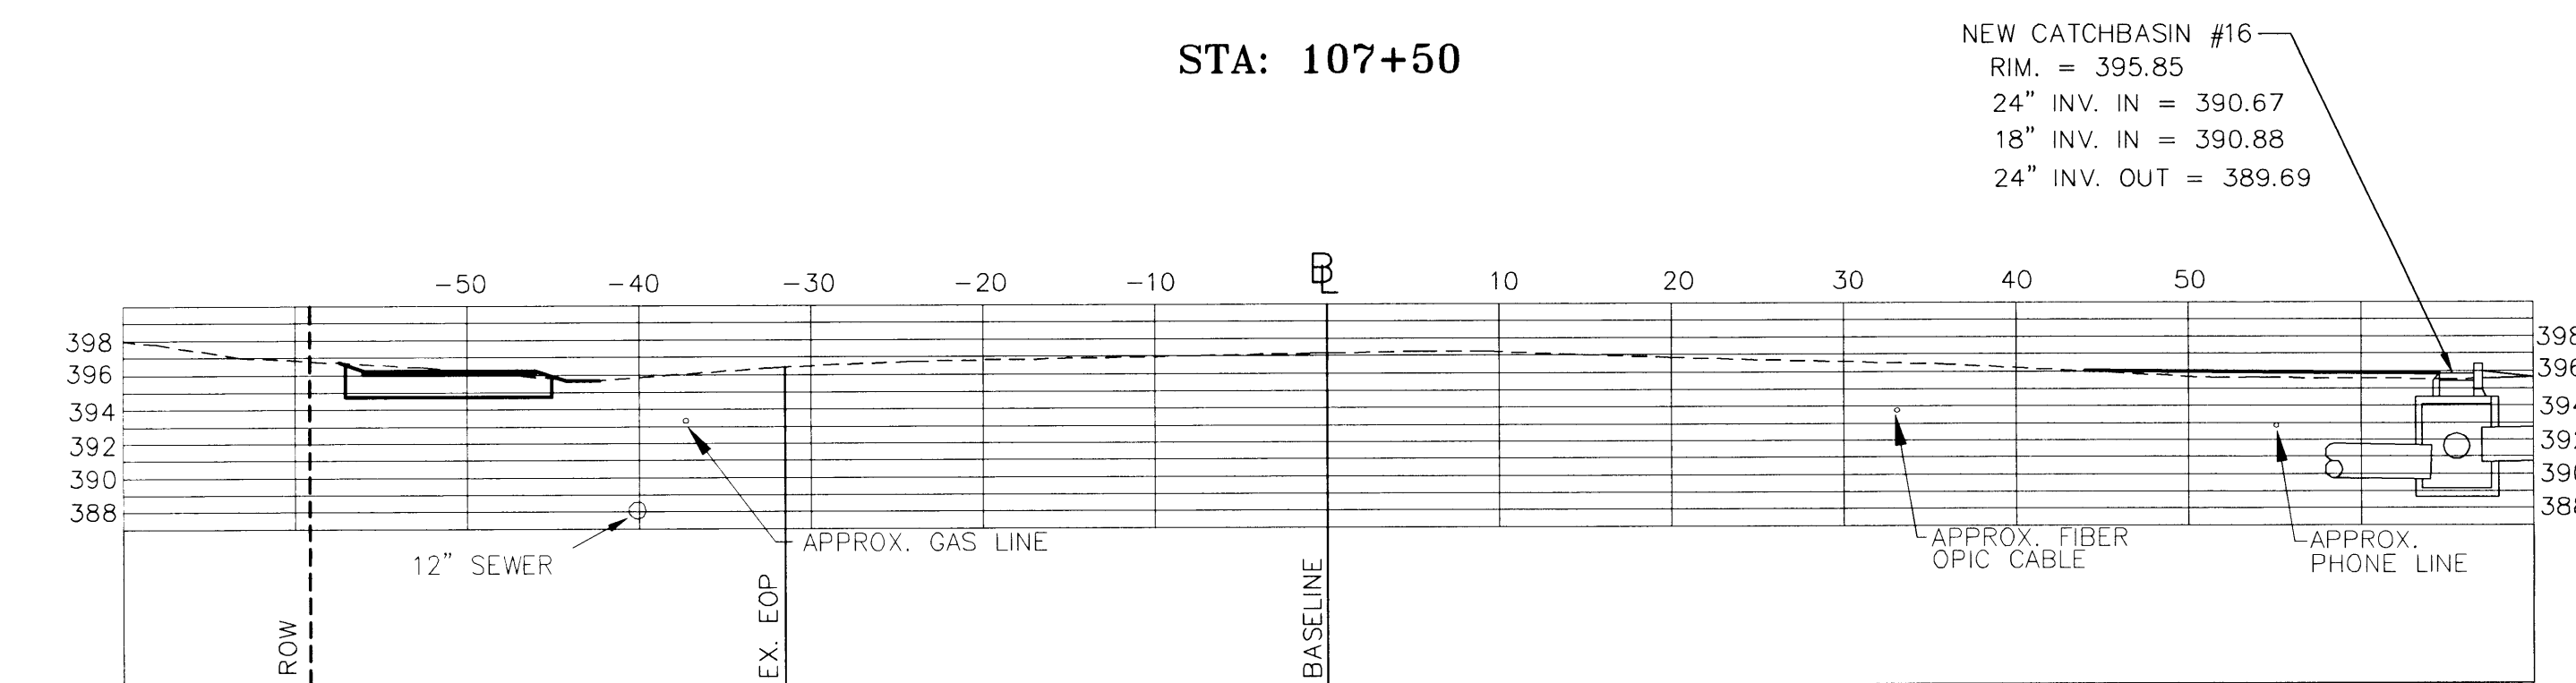
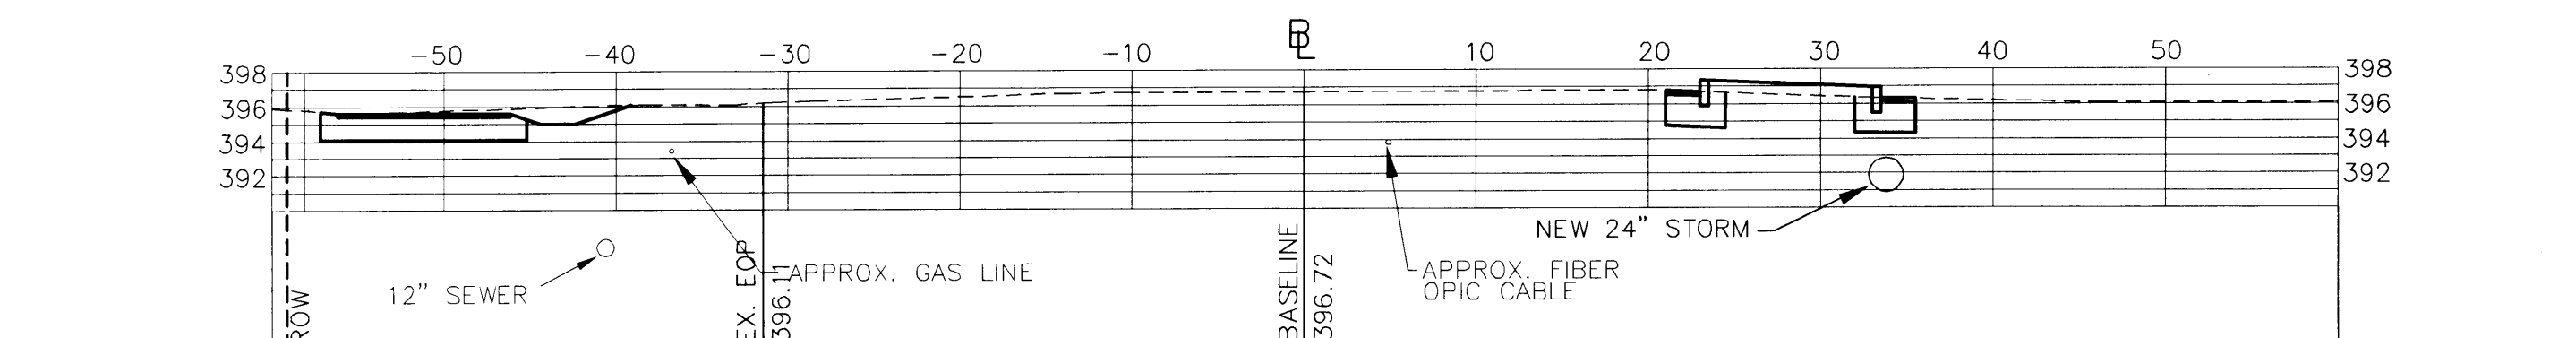
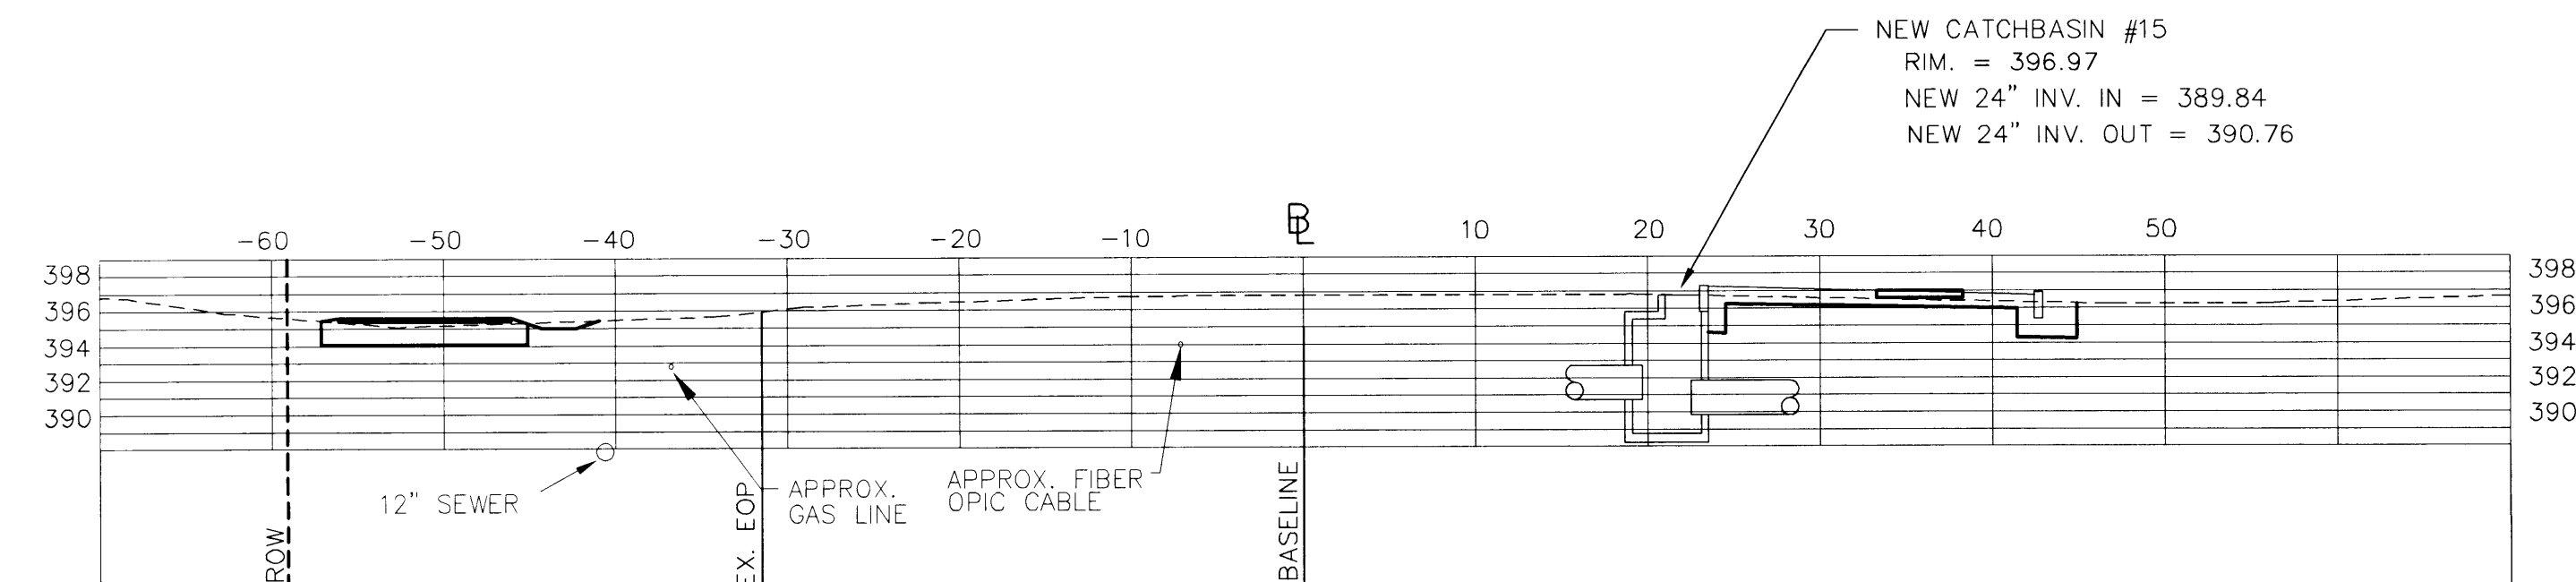
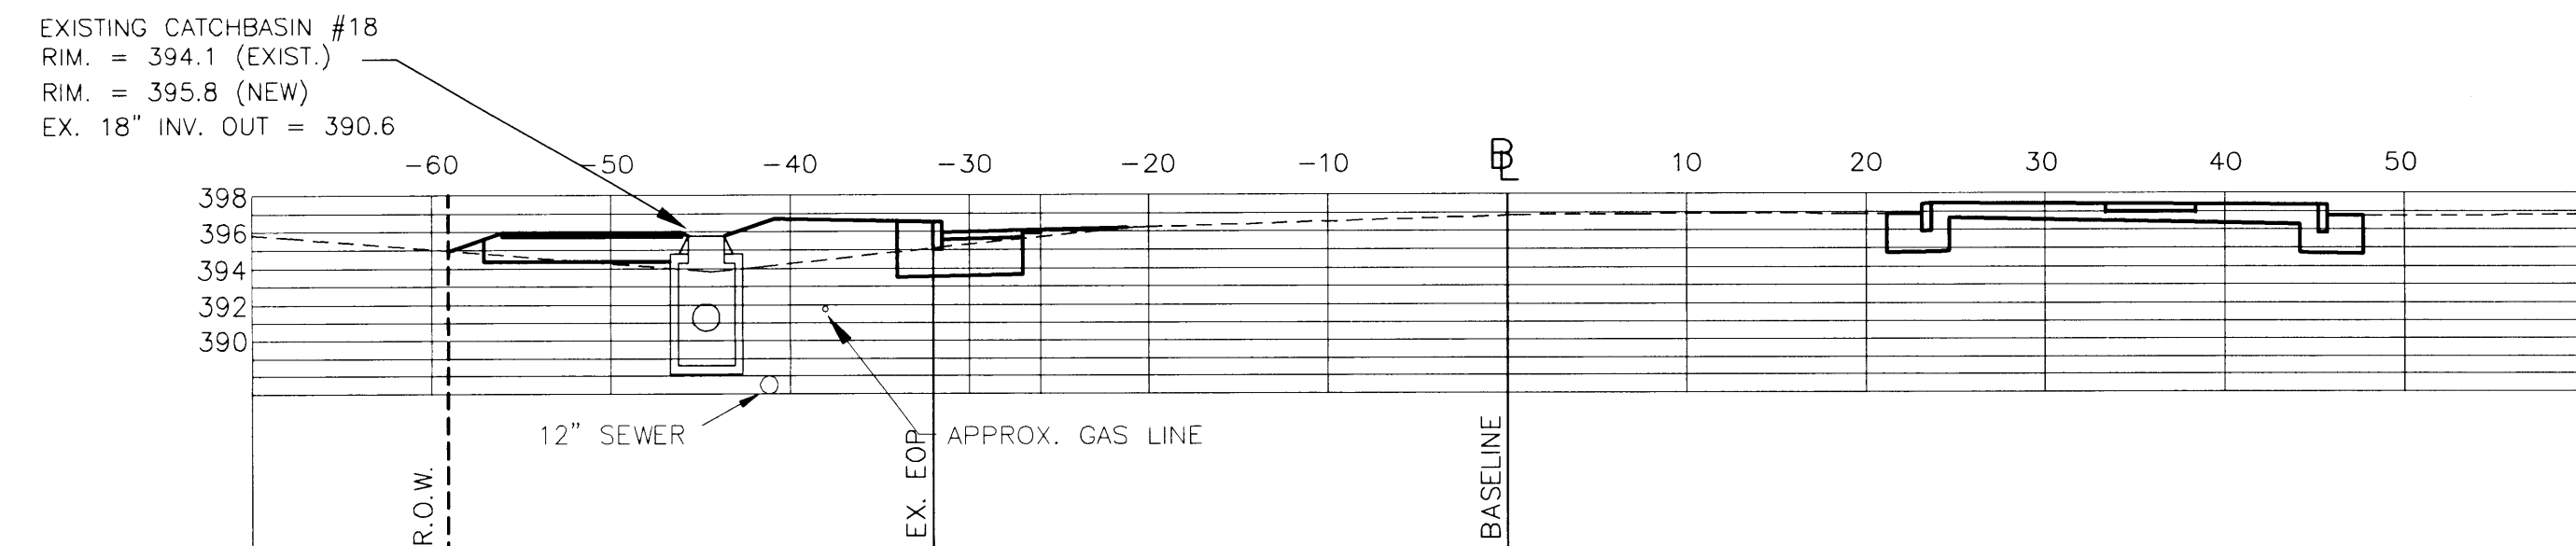
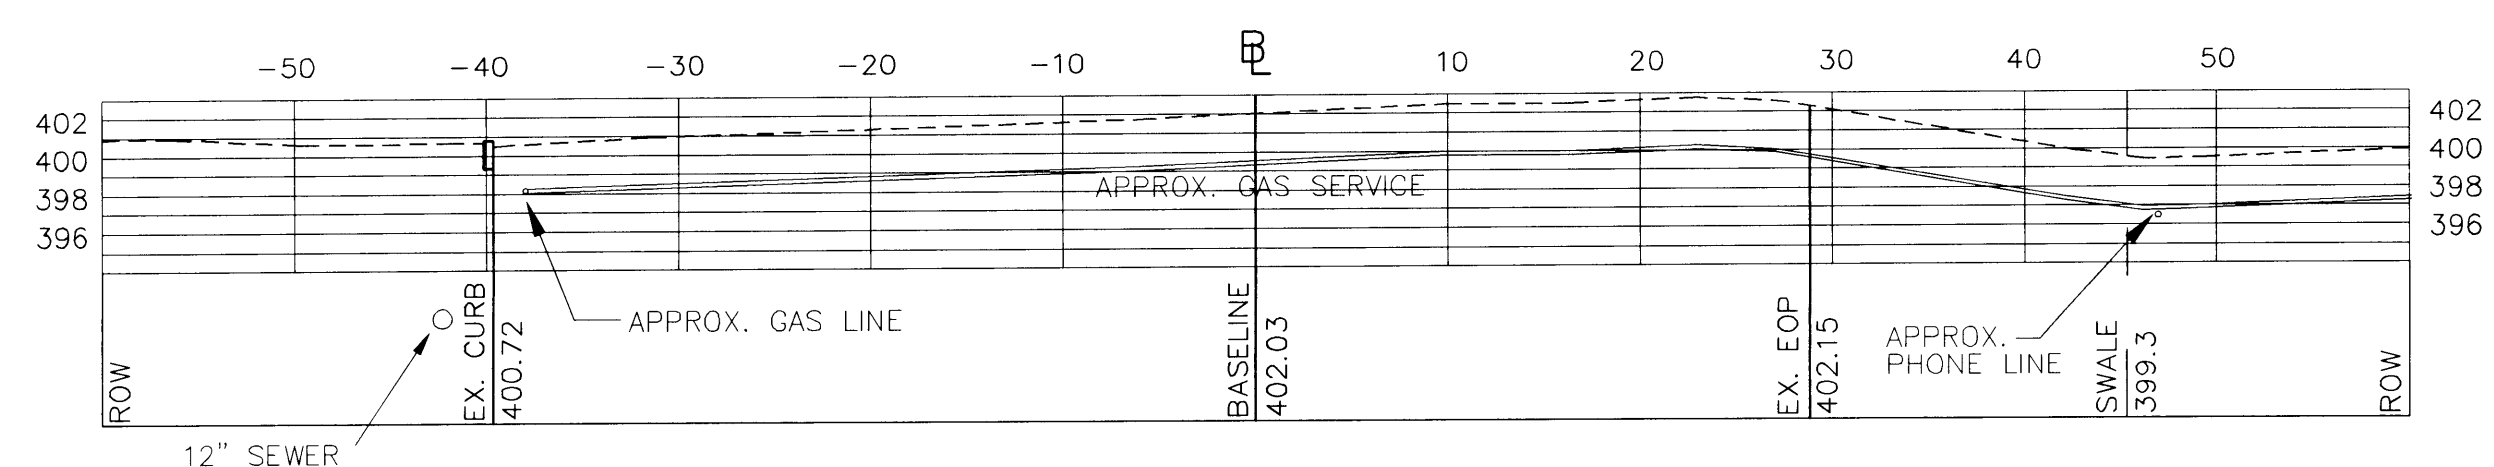
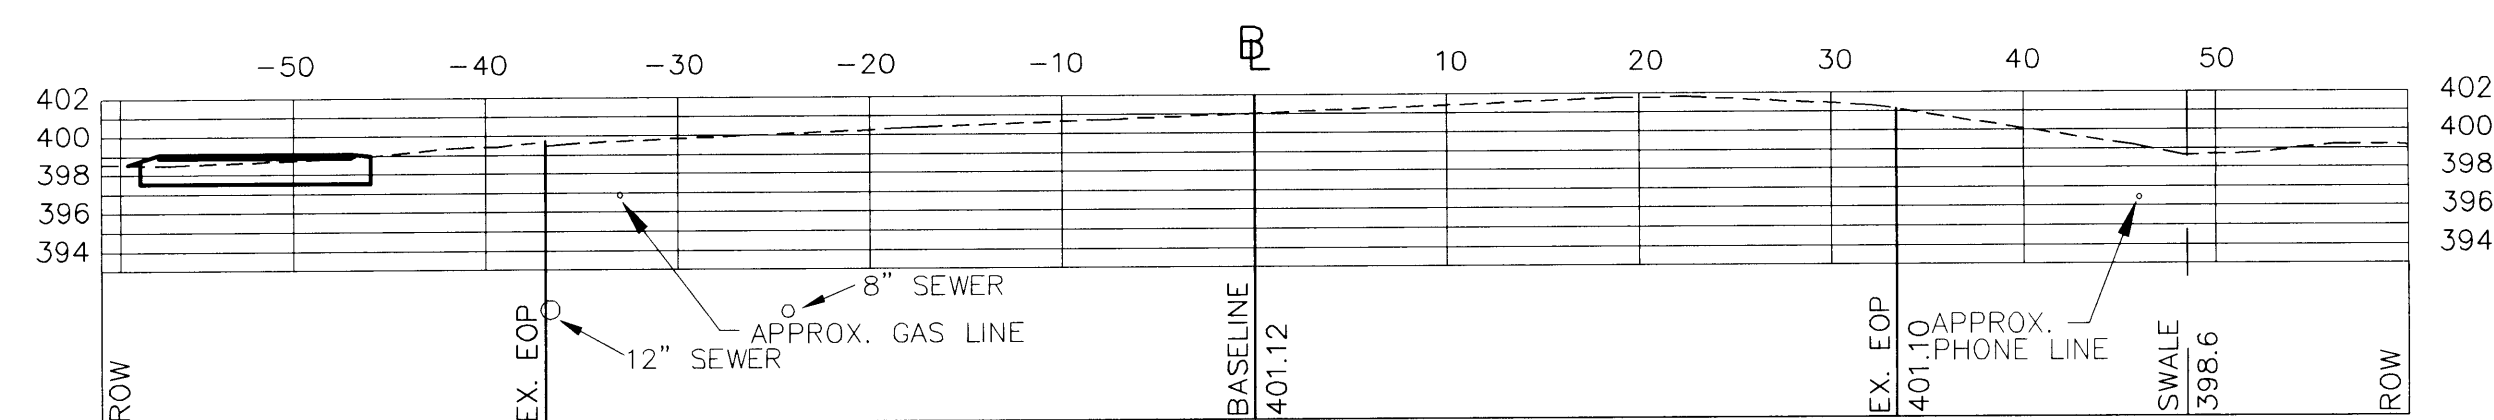
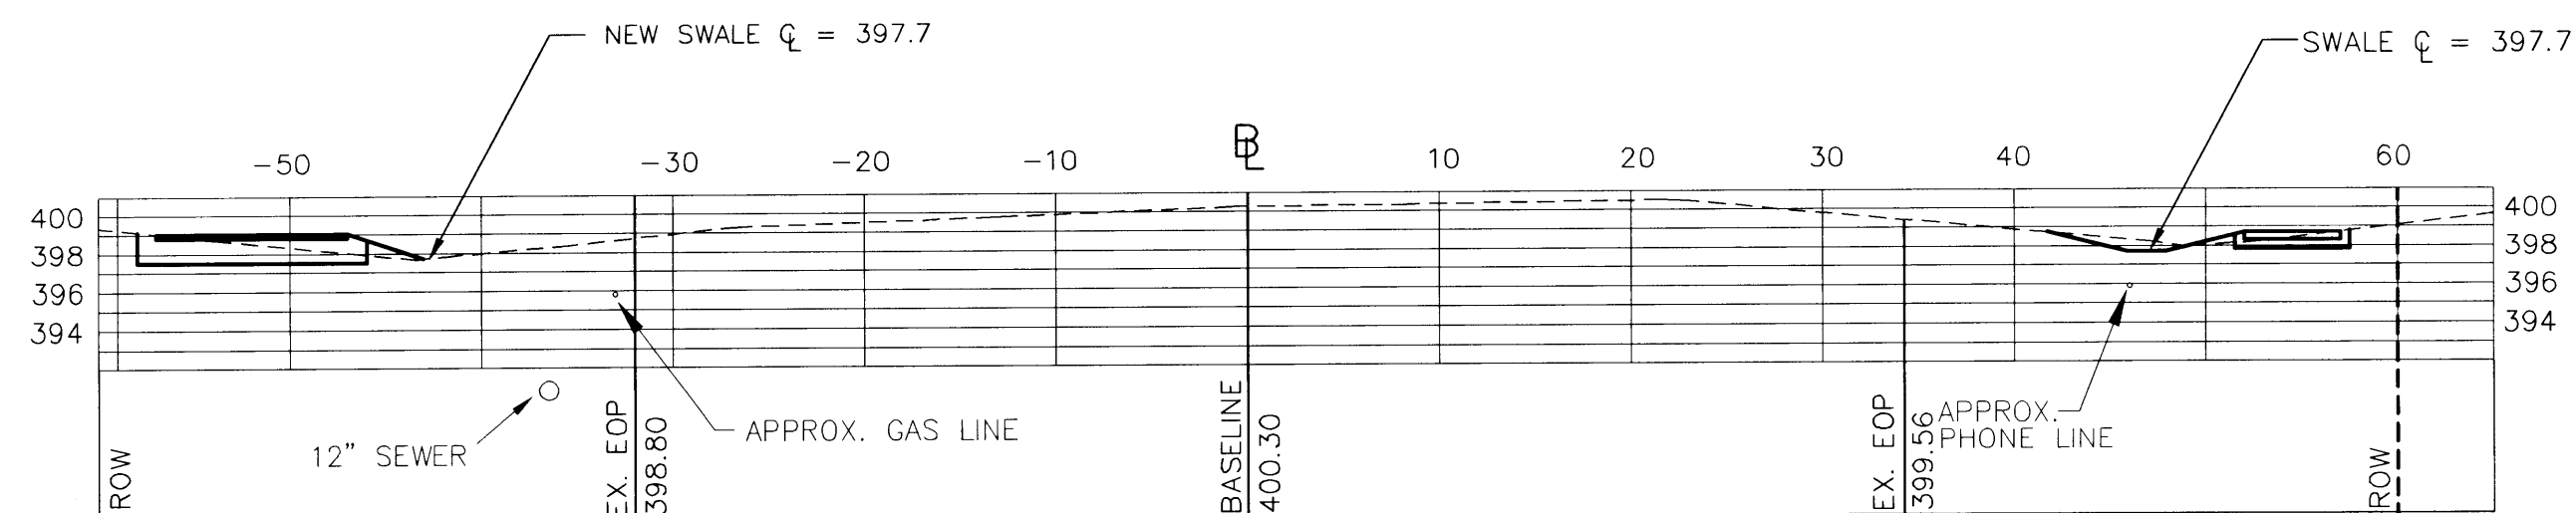
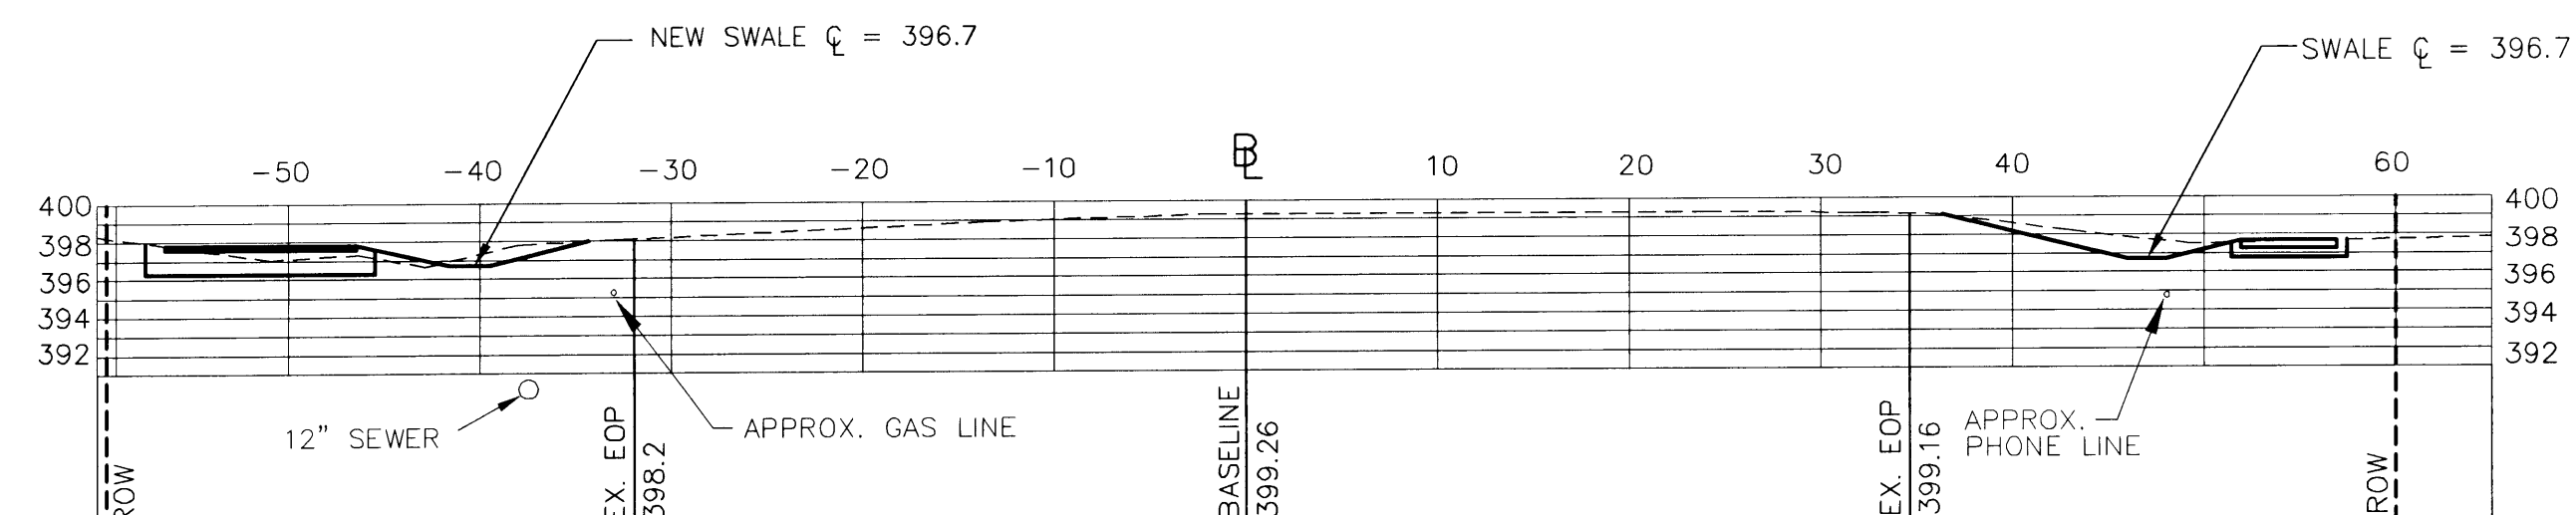
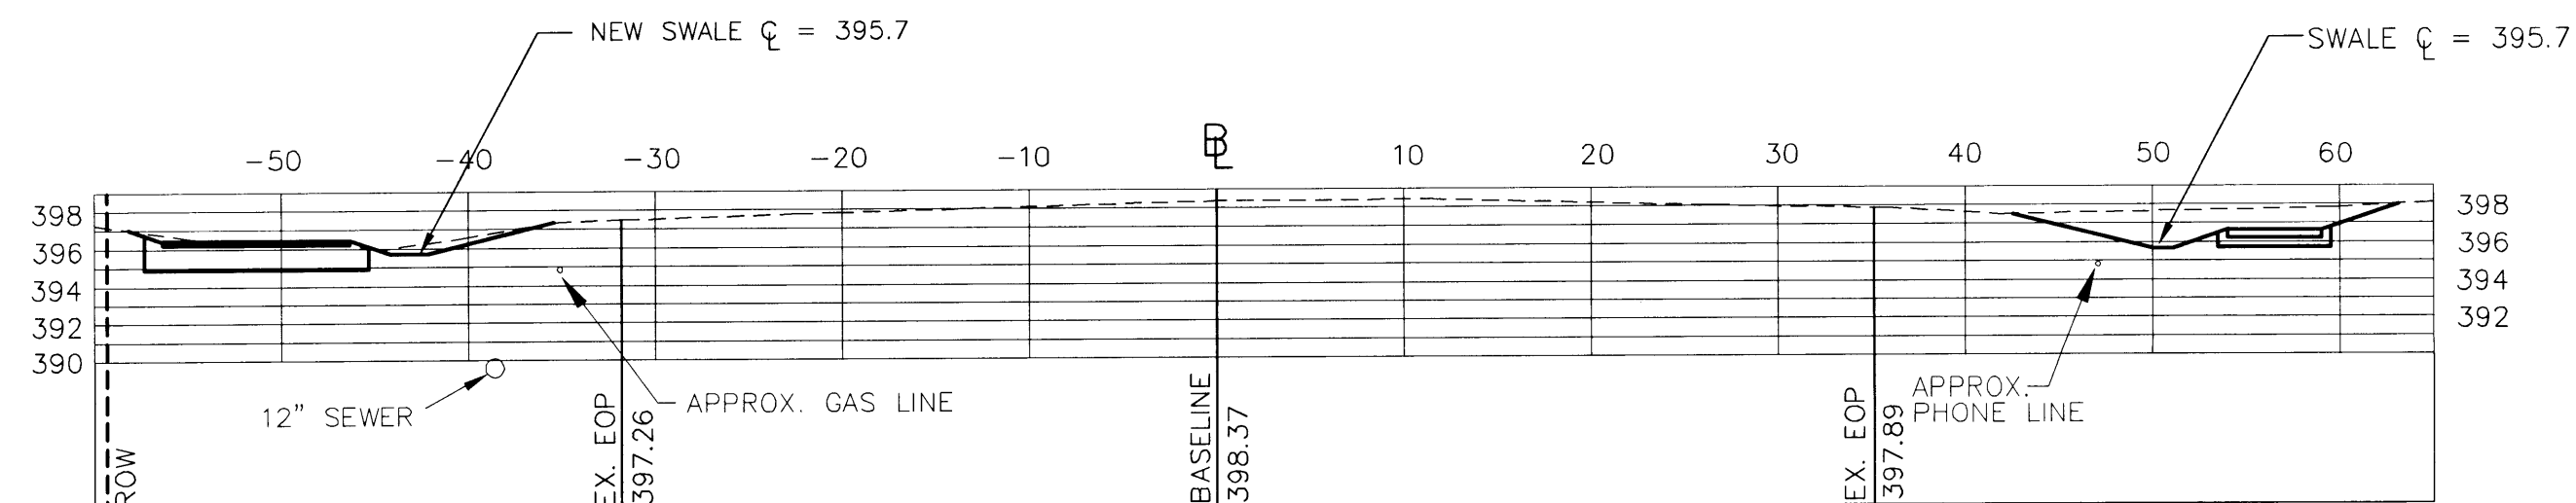
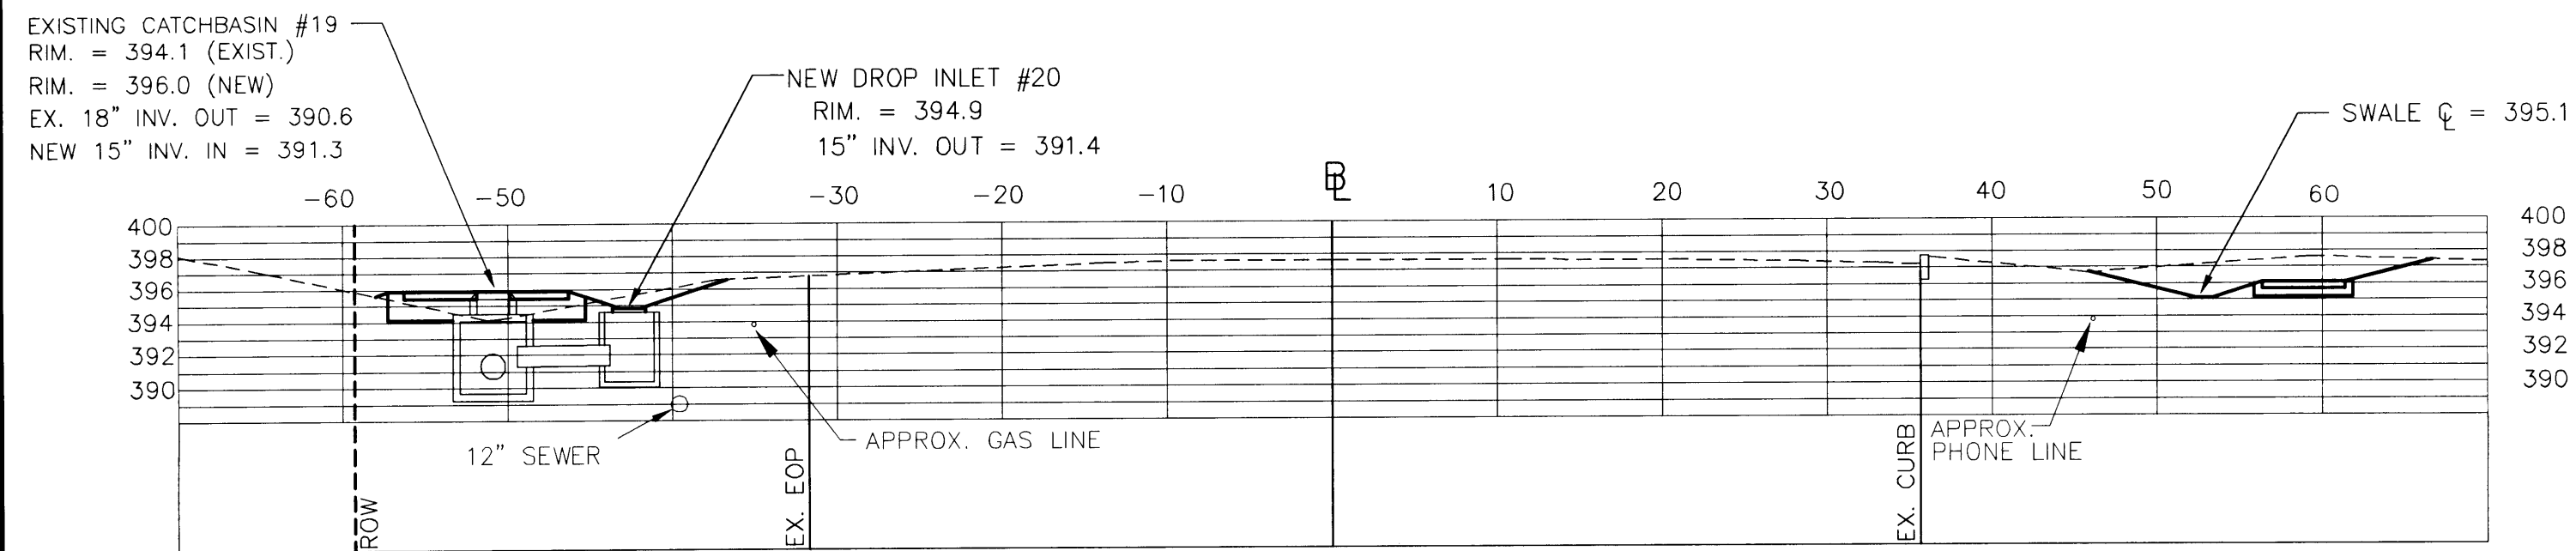


STA: 107+00

CONTRACT PLANS

VERMONT AGENCY OF
TRANSPORTATION

WILLISTON NHG 5500 (10)S
"TAFT CORNERS"
(US ROUTE 2 & VT ROUTE 2A)

WILLISTON

VERMONT

CROSS SECTIONS
(VT ROUTE 2A SOUTH)

LAMOUREUX & DICKINSON
Consulting Engineers Inc.

14 Morse Drive
Essex Junction, VT 05452
(802) 878-4450

Engineers-Planners-Surveyors

design

RJD/JLC

drawn

checked

RJD

scale

1"=10'

sht. no.

19

RECORD DRAWINGS

THIS RECORD DRAWING HAS BEEN PREPARED BY GRIFFIN INTERNATIONAL, INC. BASED ON BASE PLAN DESIGN DRAWINGS PROVIDED BY LAMOUREUX & DICKINSON, INC.. CHANGES MADE TO THE DESIGN PLANS ARE INDICATED. THE INFORMATION PROVIDED REGARDING ANY DEVIATION FROM THE DESIGN PLANS ARE BASED ON RESIDENT ENGINEER NOTES AND MEASUREMENT OF ABOVEGROUND FEATURES.