




STA: 115+00

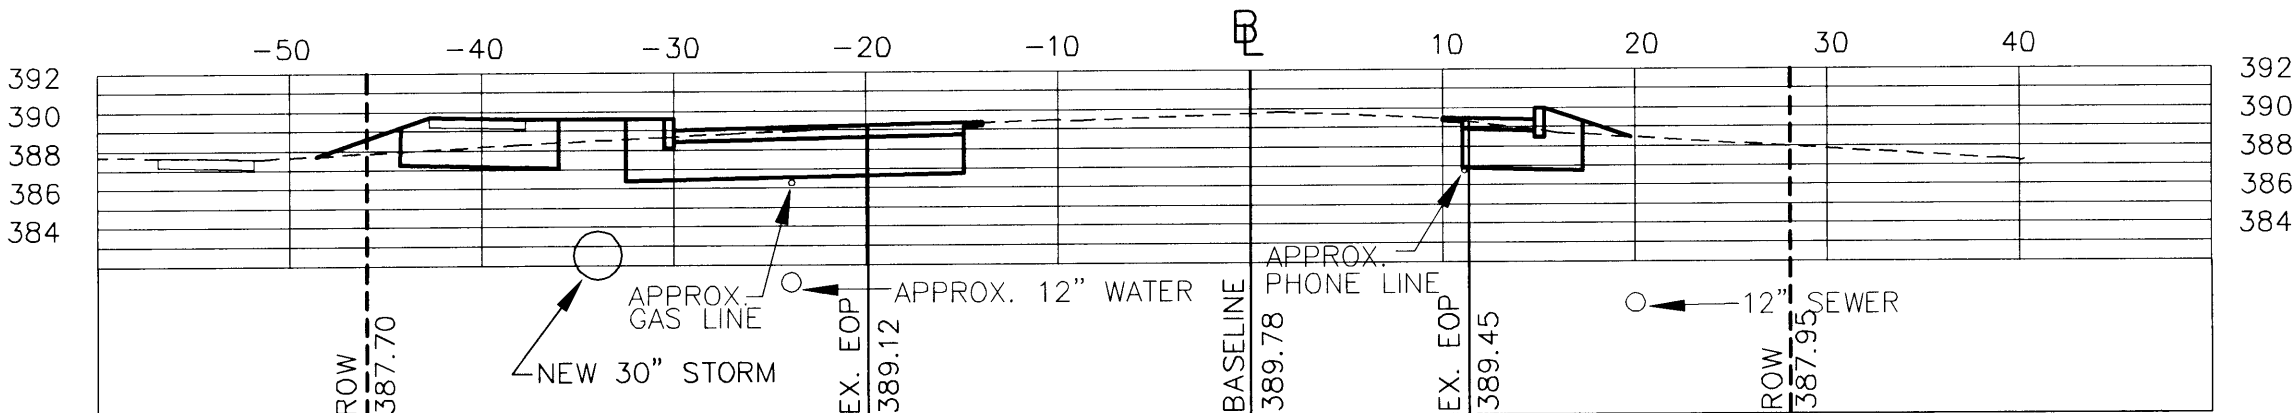


STA: 114+50

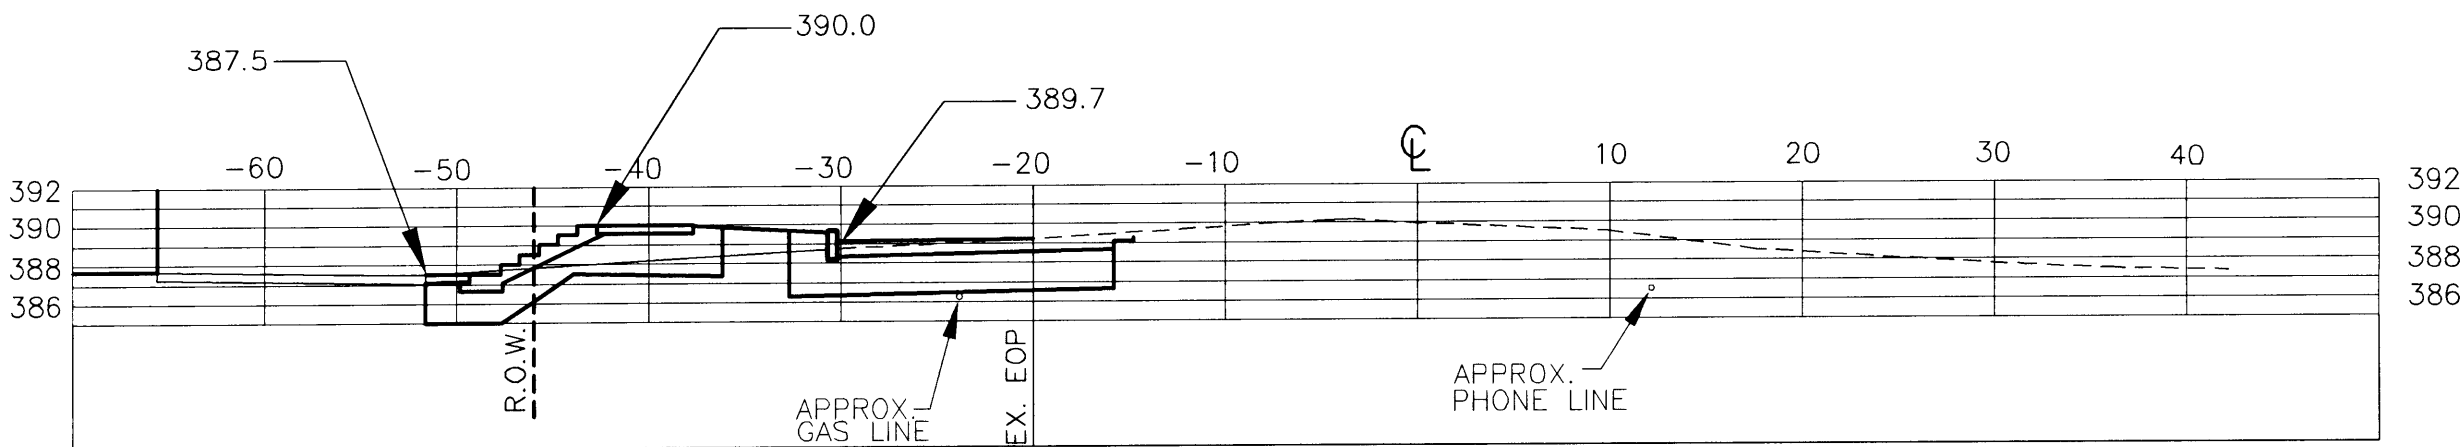


STA: 114+43

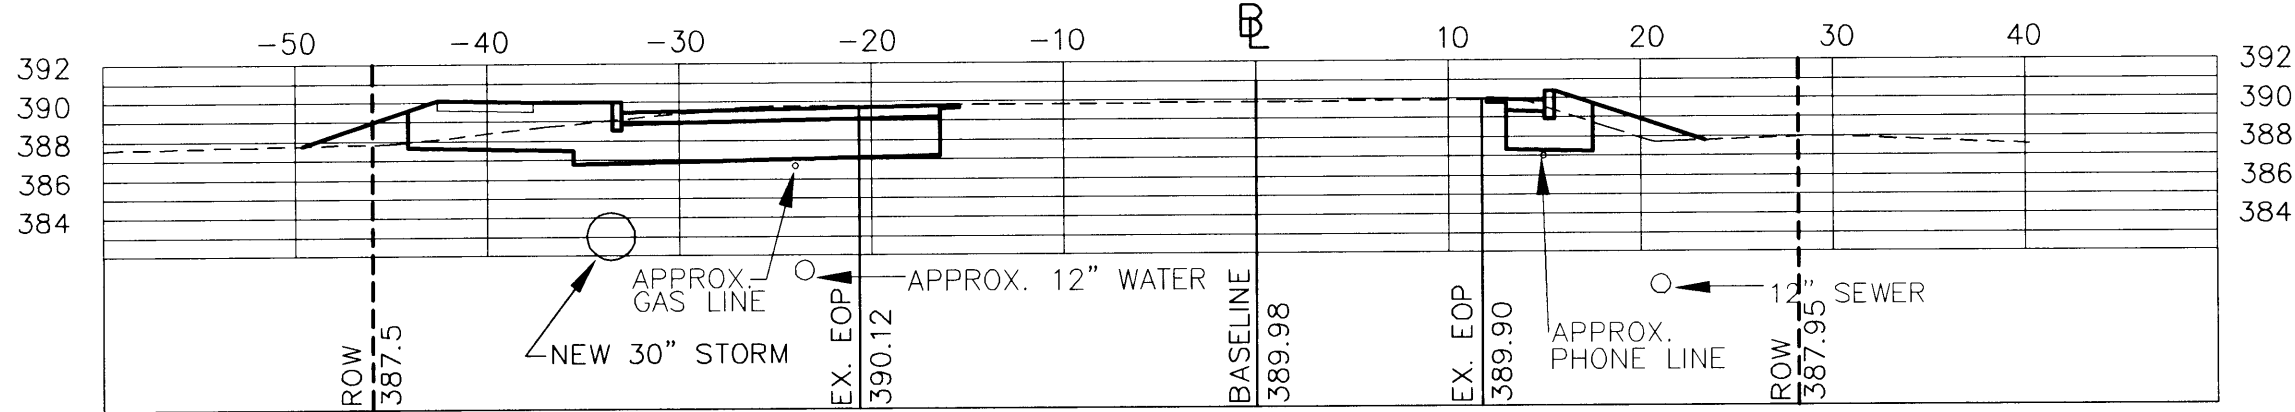


STA: 114+00

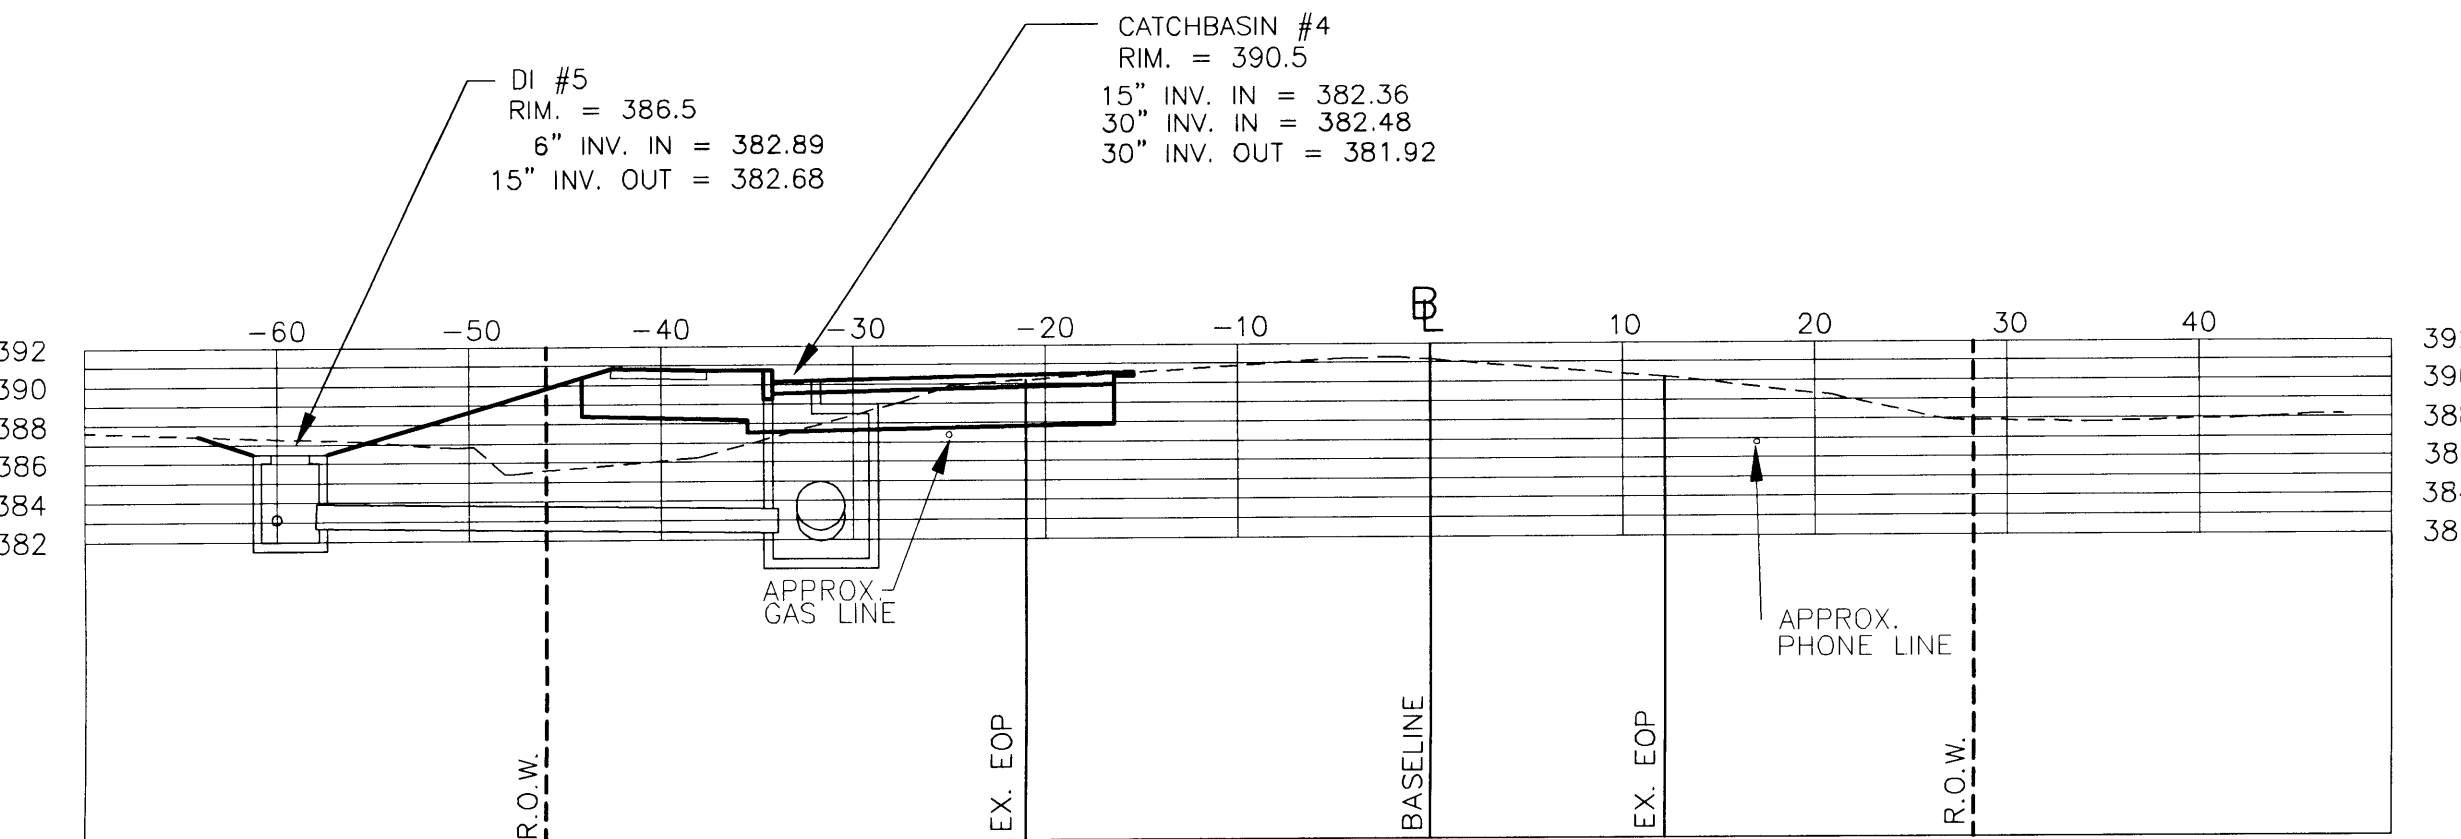


STA: 113+73

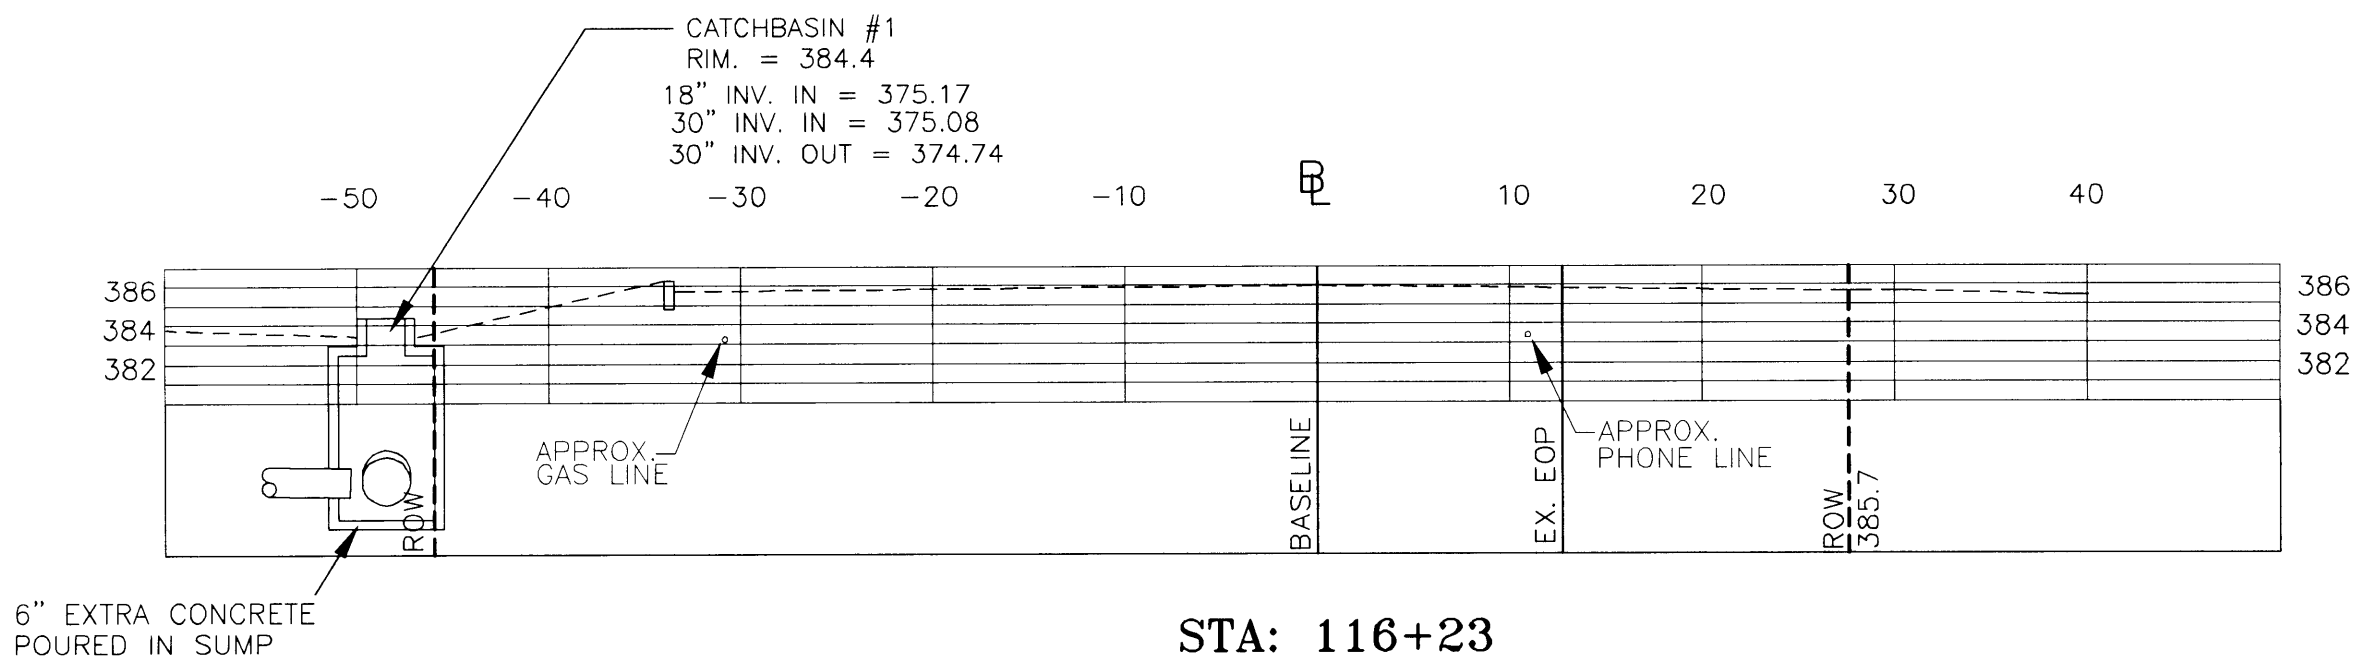


STA: 116+23

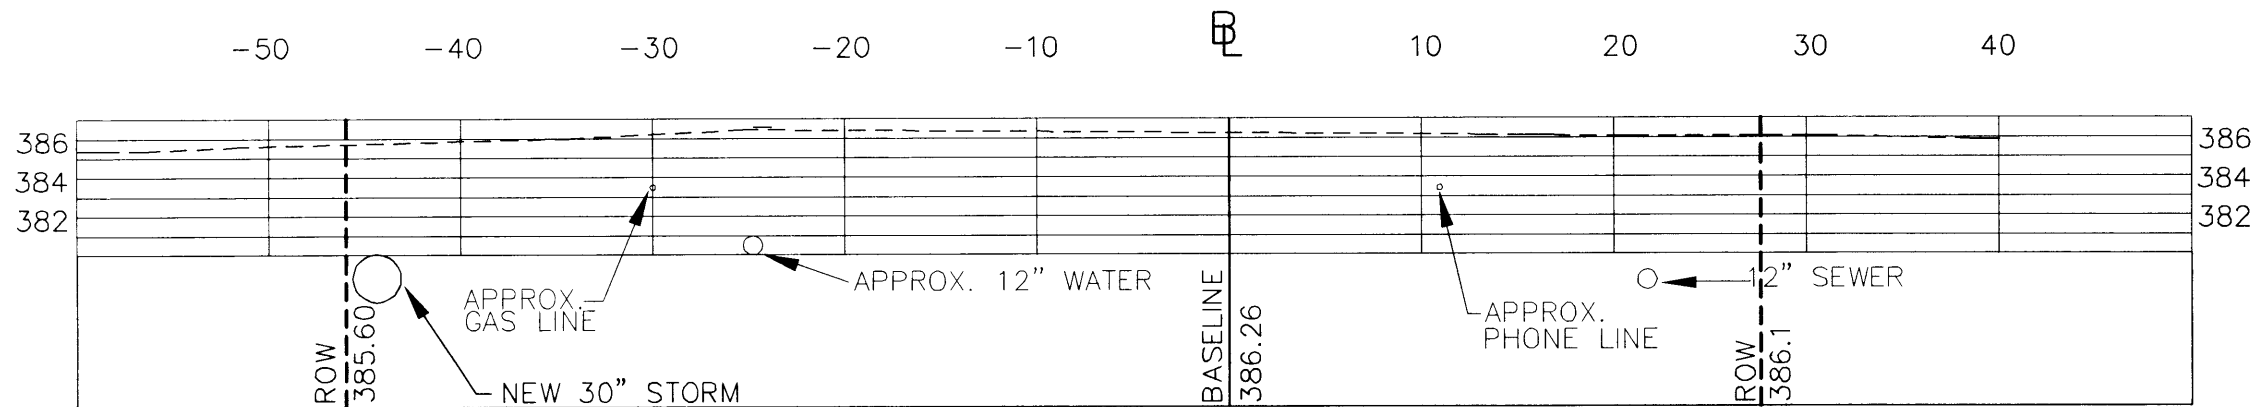

STA: 116+00

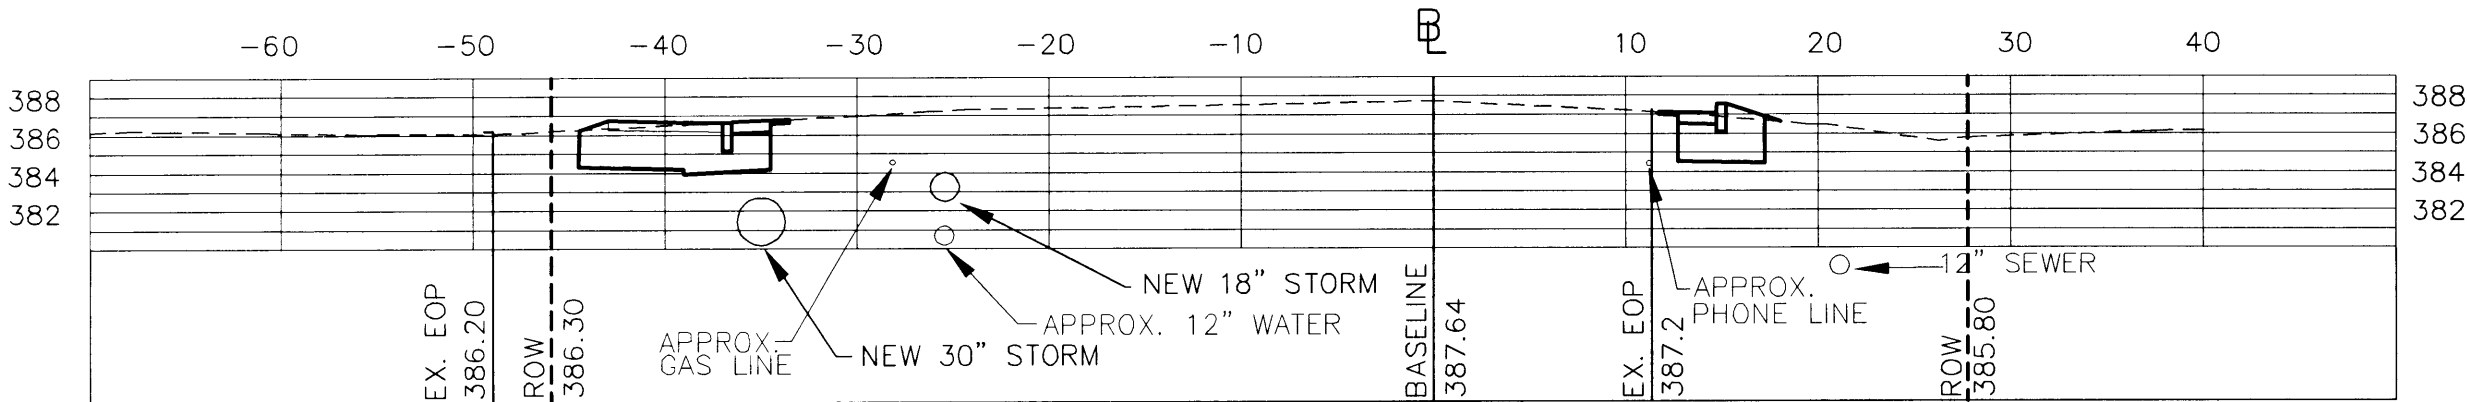

STA: 115+50

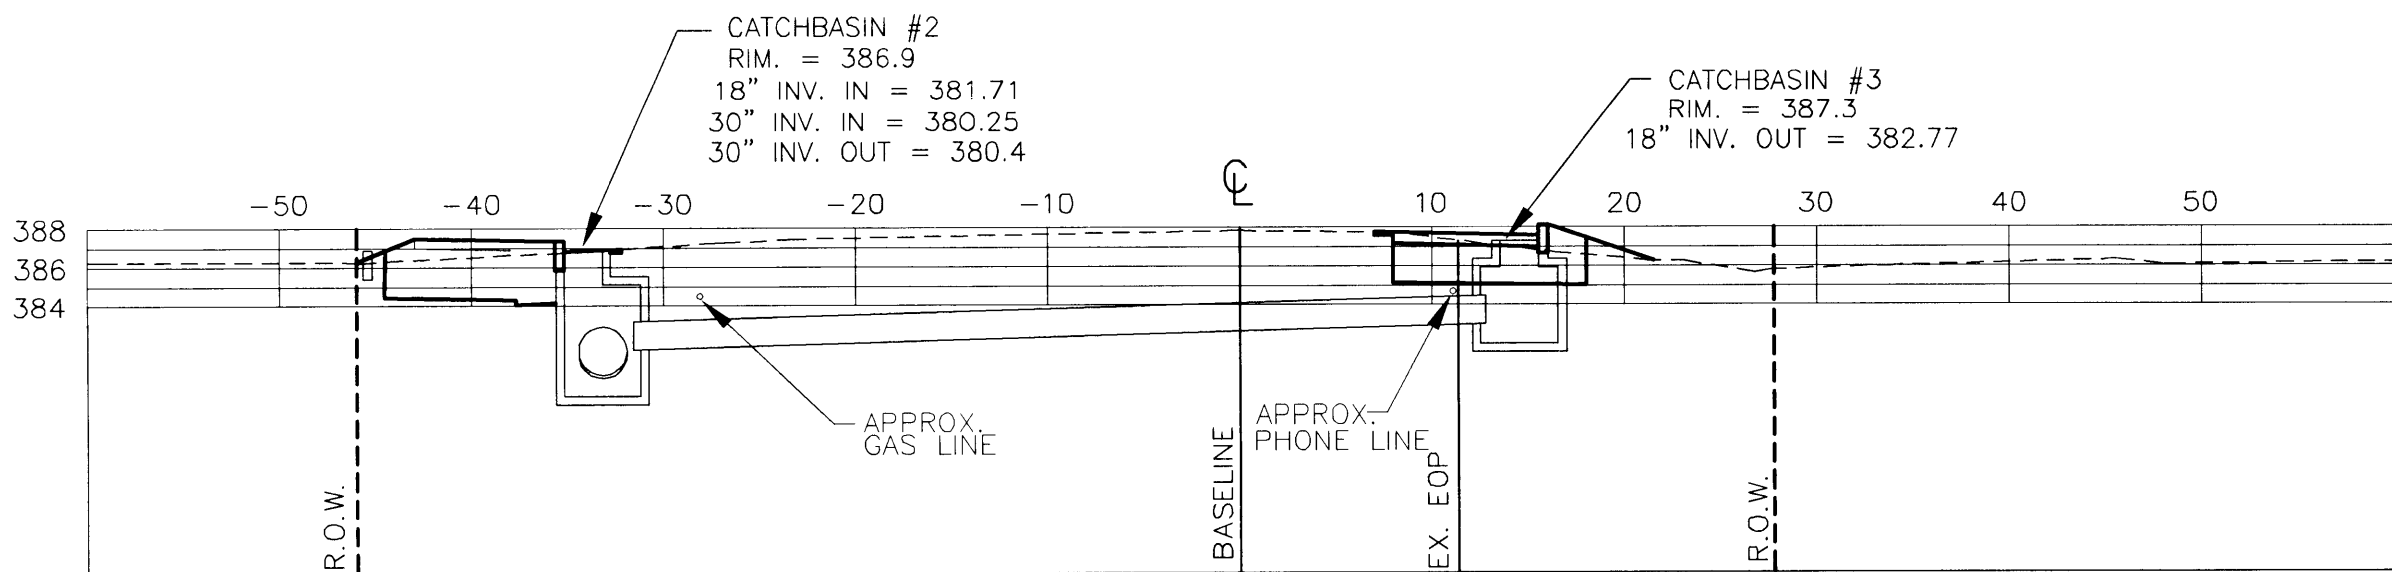

STA: 115+47

RECORD DRAWINGS
THIS RECORD DRAWING HAS BEEN PREPARED BY GRIFFIN INTERNATIONAL, INC. BASED ON BASE PLAN DESIGN DRAWINGS PROVIDED BY LAMOUREUX & DICKINSON, INC. CHANGES MADE TO THE DESIGN PLANS ARE INDICATED. THE INFORMATION PROVIDED REGARDING ANY DEVIATION FROM THE DESIGN PLANS ARE BASED ON RESIDENT ENGINEER NOTES AND MEASUREMENT OF ABOVEGROUND FEATURES.

CONTRACT PLANS

VERMONT AGENCY OF
TRANSPORTATION

WILLISTON NHG 5500 (10)S
"TAFT CORNERS"
(US ROUTE 2 & VT ROUTE 2A)

WILLISTONVERMONT

CROSS SECTIONS
(VT ROUTE 2A NORTH)

LAMOUREUX & DICKINSON
Consulting Engineers Inc.
14 Morse Drive
Essex Junction, VT 05452
(802) 878-4450
Engineers-Planners-Surveyors

design
RJD/JLC
drawn
JLC
checked
RJD
scale
1"=10'
sht. no.
22