



DURABLE 4" WHITE LINE
99+85 - 103+00 LT.
REMOVING SIGNS
4 - AS SHOWN

NOTE:
NEW PAVEMENT MARKINGS SHOWN BASED UPON REVISED
PROJECT LIMIT OF STA. 102+50.

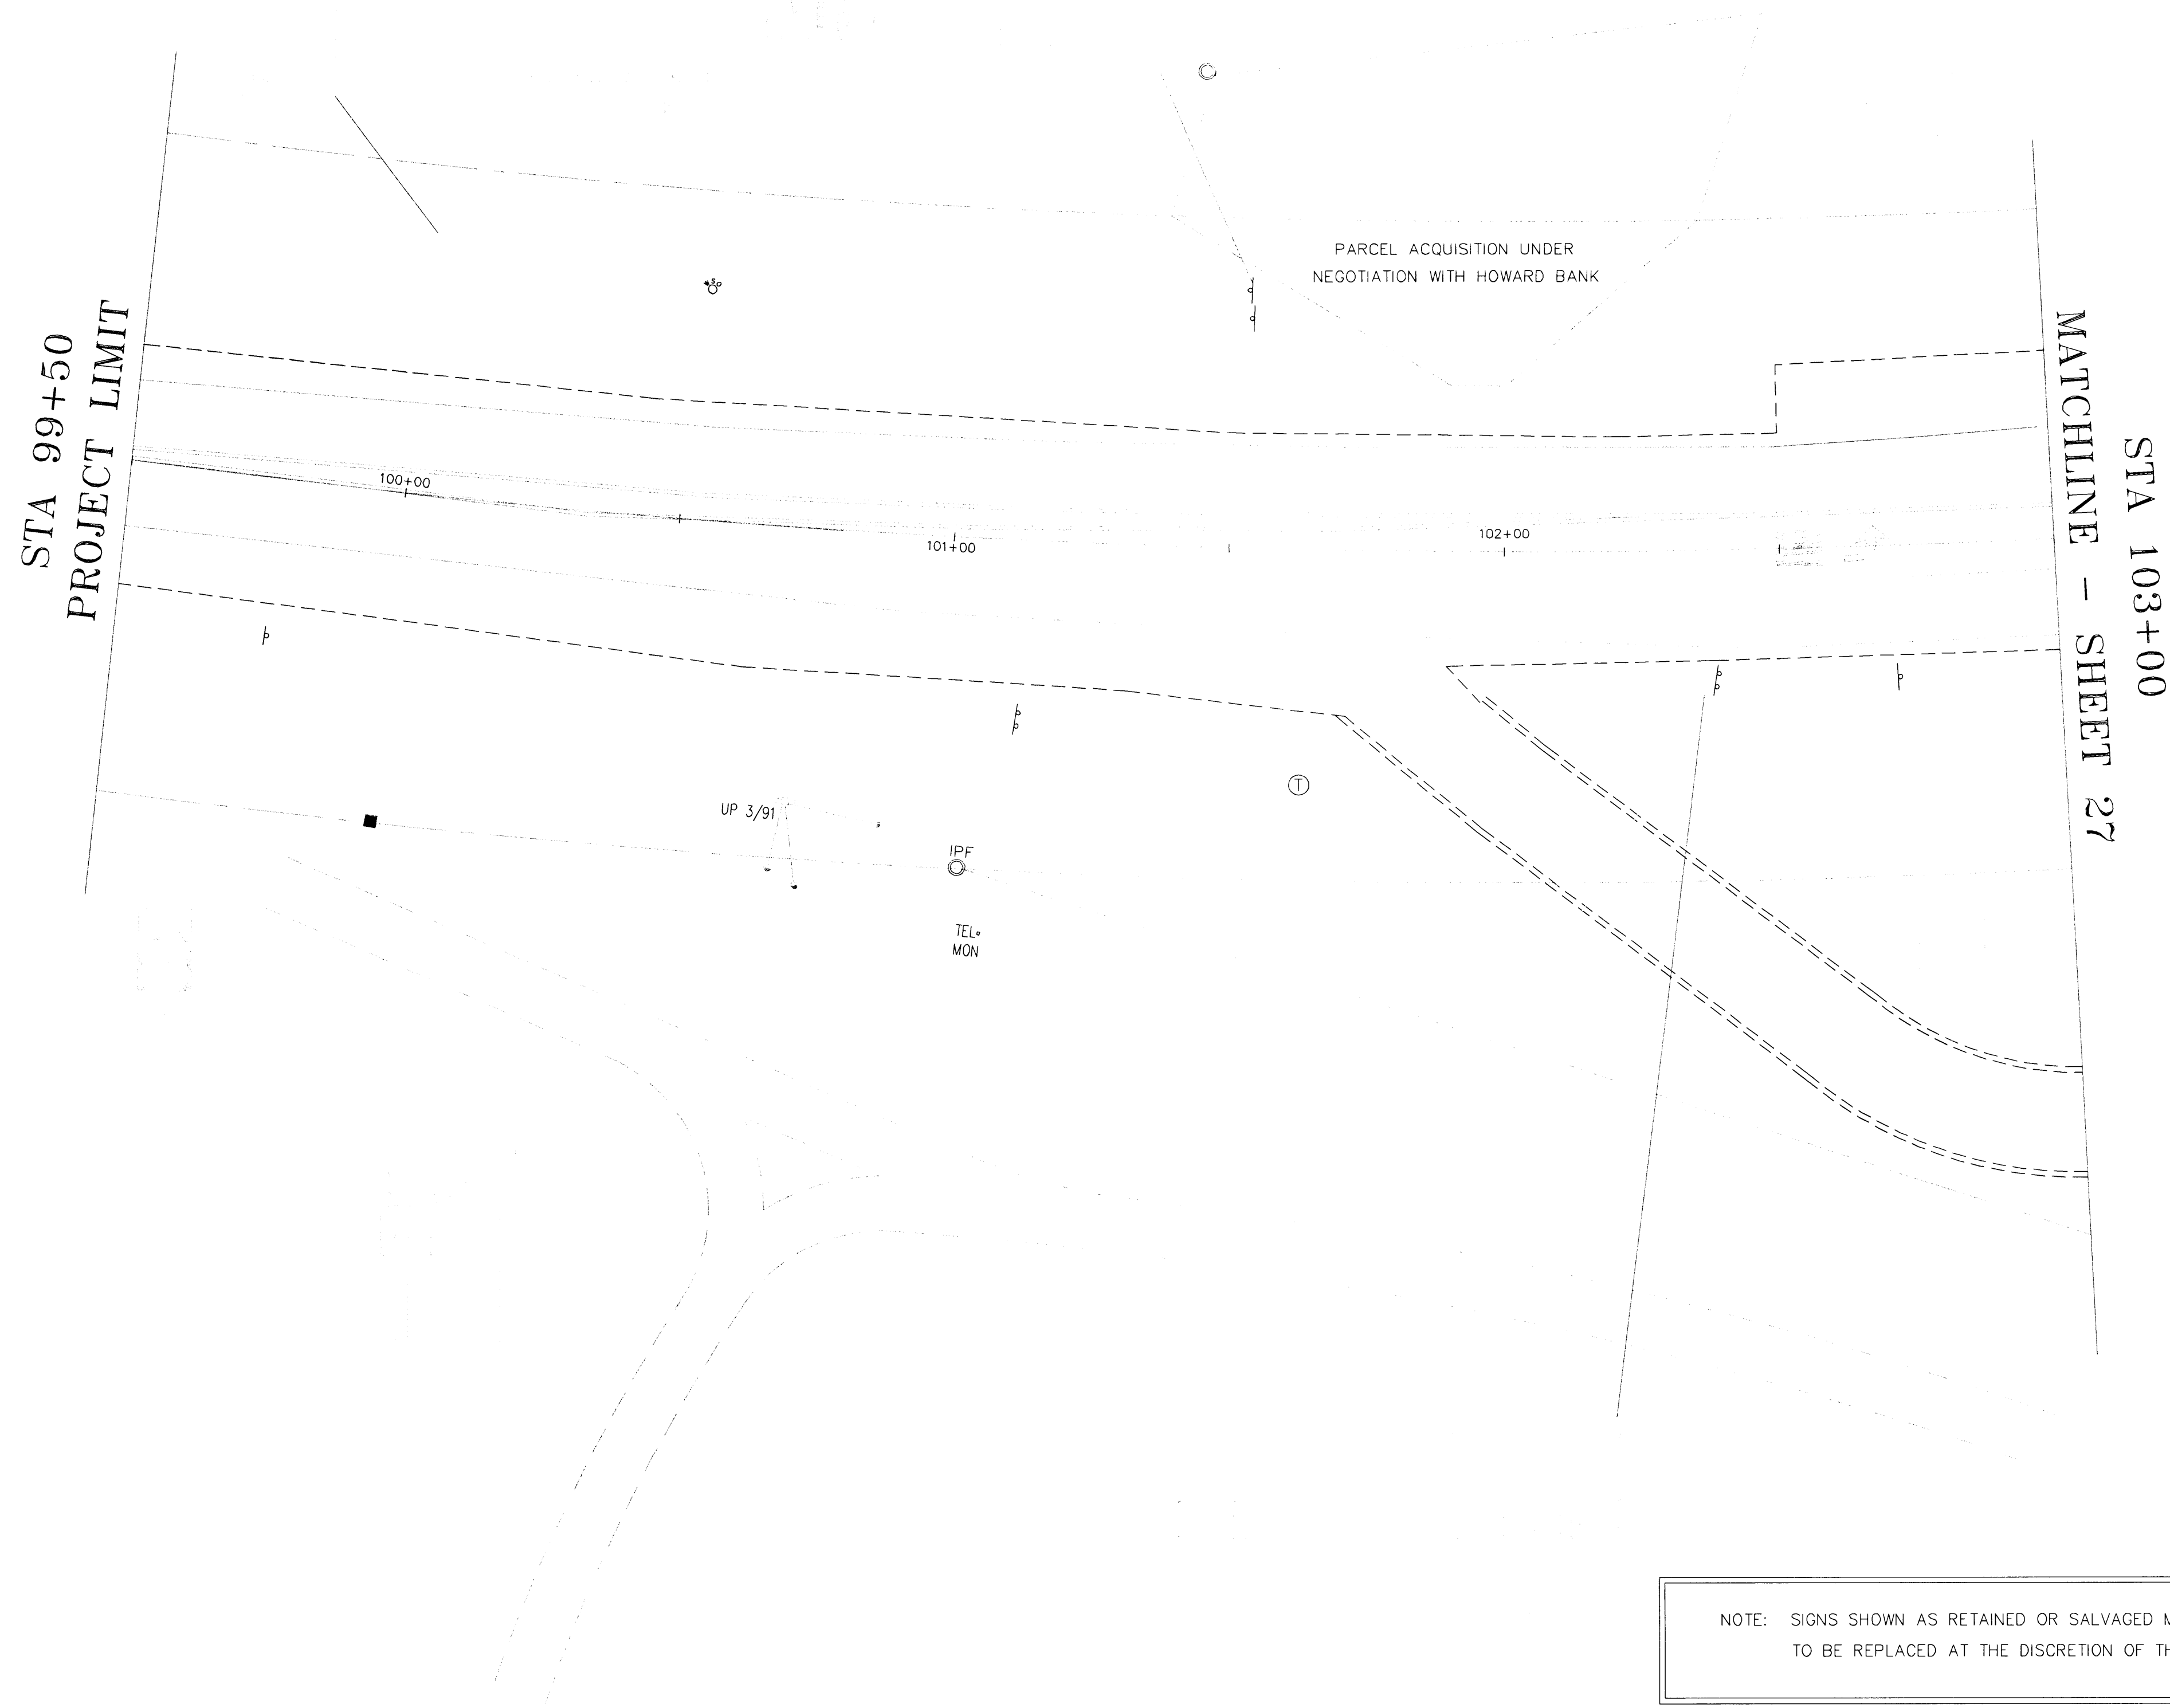

NOTE: SIGNS SHOWN AS RETAINED OR SALVAGED MAY NEED
TO BE REPLACED AT THE DISCRETION OF THE ENGINEER.

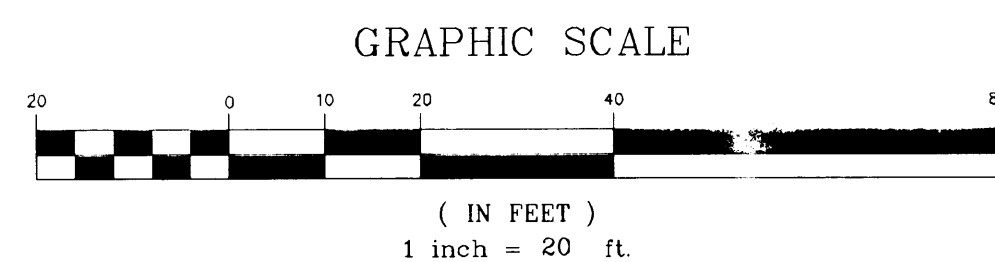

RECORD DRAWINGS

THIS RECORD DRAWING HAS BEEN PREPARED BY GRIFFIN
INTERNATIONAL, INC. BASED ON BASE PLAN DESIGN
DRAWINGS PROVIDED BY LAMOUREUX & DICKINSON, INC..
CHANGES MADE TO THE DESIGN PLANS ARE INDICATED. THE
INFORMATION PROVIDED REGARDING ANY DEVIATION FROM
THE DESIGN PLANS ARE BASED ON RESIDENT ENGINEER
NOTES AND MEASUREMENT OF ABOVEGROUND FEATURES.

CONTRACT PLANS

VERMONT AGENCY OF
TRANSPORTATION

WILLISTON NHG 5500 (10)S
"TAFT CORNERS"
(US ROUTE 2 & VT ROUTE 2A)

WILLISTON

VERMONT

PAVEMENT MARKING &
SIGN LAYOUT SHEET

LAMOUREUX & DICKINSON
Consulting Engineers Inc.
14 Morse Drive
Essex Junction, VT 05452
(802) 878-4450
Engineers-Planners-Surveyors

design
RJD/JLC
drawn
DVE/JLC
checked
RJD
scale
1"=20'
shet. no.

26