
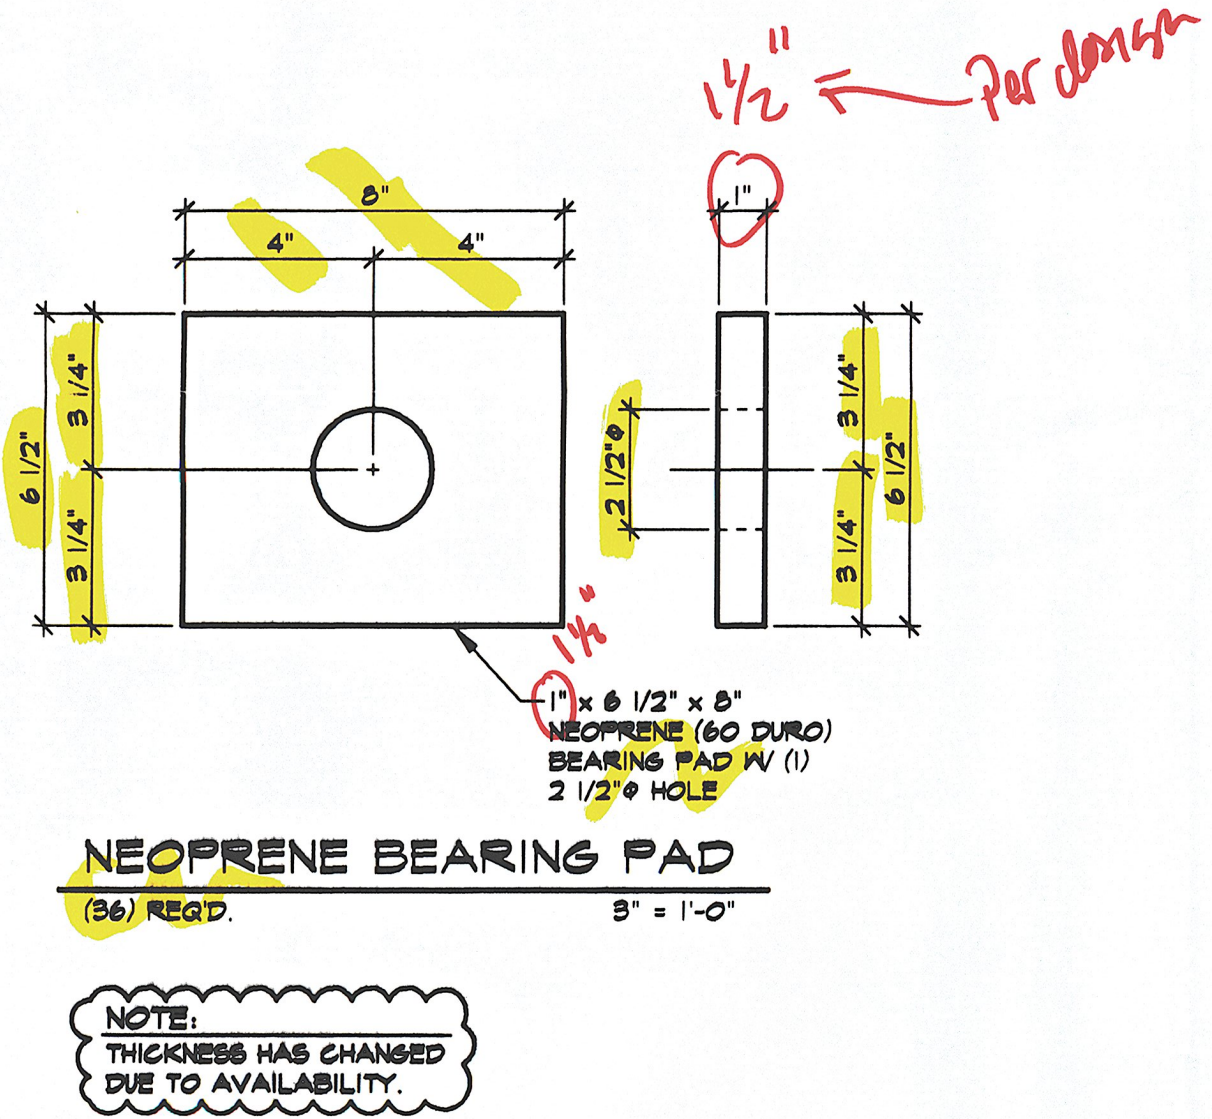


BENT BARS, TIES, & STIRRUPS																		
ITEM	MARK	QTY.	SIZE	LENGTH	TYPE	A	B	C	D	E	F/R	G	H	J	K	O	GRADE	REMARKS
1	401E	364	4	6'-11"	S10		1'-8 1/2"	5'-8"	1'-8 1/2"								60	EPOXY COATED
2	402E	364	4	6'-2"	S10		1'-4"	5'-8"	1'-4"								60	EPOXY COATED
3	403E	364	4	6'-2 3/4"	L4	1'-4"	6"	5 5/8"	1'-11 1/2"	5 5/8"	6"	1'-4"	4"		4"	5'-8"	60	EPOXY COATED
4	404E	18	4	6'-5 5/8"	L4	1'-4"	6"	5 5/8"	2'-2 5/8"	5 5/8"	6"	1'-4"	4"		4"	5'-10 1/8"	60	EPOXY COATED
5																		
6	501E	108	5	7'-1 5/8"	S10		1'-8 1/2"	5'-10 1/8"	1'-8 1/2"								60	EPOXY COATED
7	502E	108	5	6'-4 5/8"	S10		1'-4"	5'-10 1/8"	1'-4"								60	EPOXY COATED
8																		
9																		
MISCELLANEOUS MATERIAL						
ITEM	MARK	QTY.	DESCRIPTION		REMARKS	
1						
2						
3						
4		162	3/4" NON-FERROUS VOID DRAIN			
5		36	DOUBLE 1/2" STRAND LIFT LOOPS			
6						
7						
8						
9						
10						
11						
12						
13		4	1/2" POLYSTRAND x 44'-0"		FOR TRANS. TENSIONING	
14	EM-2	8	3/4"x5"x5" W/ 2" HOLE		GALV.	
15						
16						
17						
18						
19						
20	MK-PS	32	RICHMOND ANGLE HANGER 45° WFR-WFA INSERT			
21		36	1" x 6 1/2" x 8" NEOPRENE (60 DURO) BEARING PAD			
22						
23		18	10" x 16'-5 1/2" VOIDS			
24		18	10" x 16'-10 4/16" VOIDS			
25		18	10" x 17'-3 11/16" VOIDS			
26		27	10" x 18'-3 15/16" VOIDS			
27						

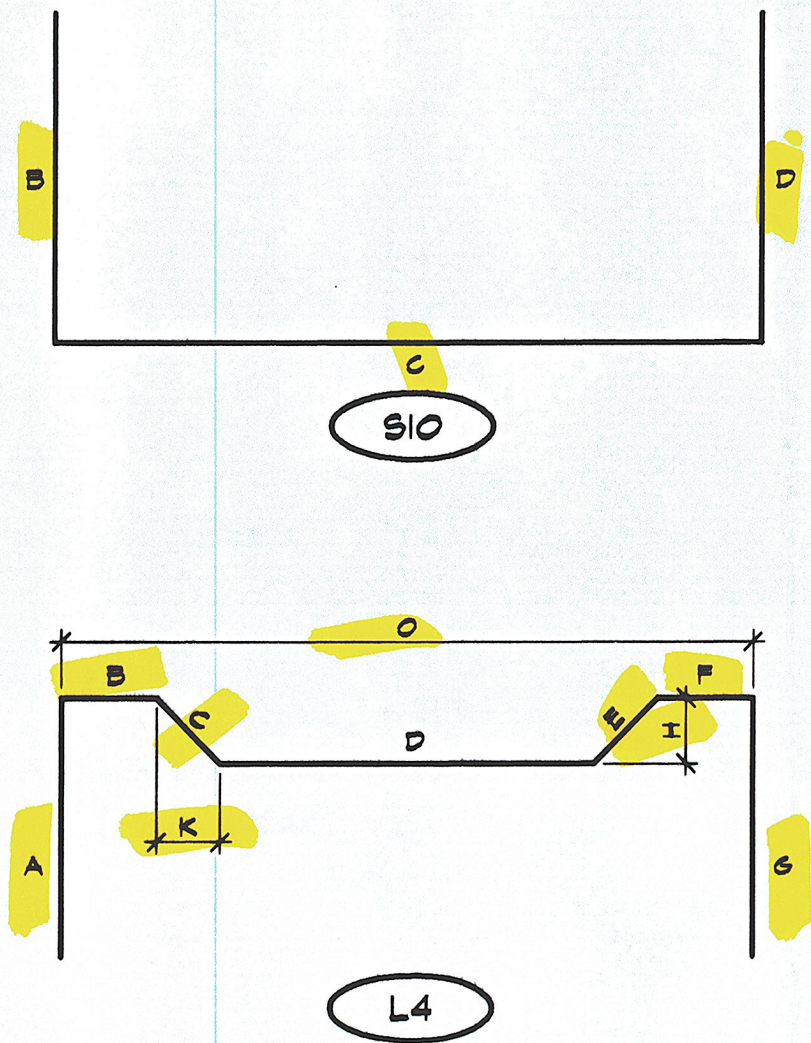

RECEIVED
CK'D BY GSR OK'D BY _____
SEP 15 1997
RESUBMIT _____ APPROVED AS NOTED
BY GSR DATE 9/23/97

NO.	DATE	REVISION	STATE OF VERMONT AGENCY OF TRANSPORTATION	DRAWN: <u>B.M. LOPEZ</u> DESIGNED: _____ CHECKED: _____ APPROVED: _____	J.P. CARRARA & SONS INC. Precast & Prestress Manufacturer RTE. 116, MIDDLEBURY, VERMONT 05753 Phone: (802) 388-8381 Fax: (802) 388-9010 Double-Tees Hollow-Core Plank Flat Panels	WINCO, INC. P.O. BOX 339 SWANTON, VT 05488	Project Name: TOWN OF MONTGOMERY BRIDGE #15 VT 118 OVER THE TROUT RIVER MATERIALS LIST	SCALE: NOTED DATE: 9-5-97	JOB #: 23050-97 SHEET #: MI
-----	------	----------	--	--	--	--	--	------------------------------------	--------------------------------------