
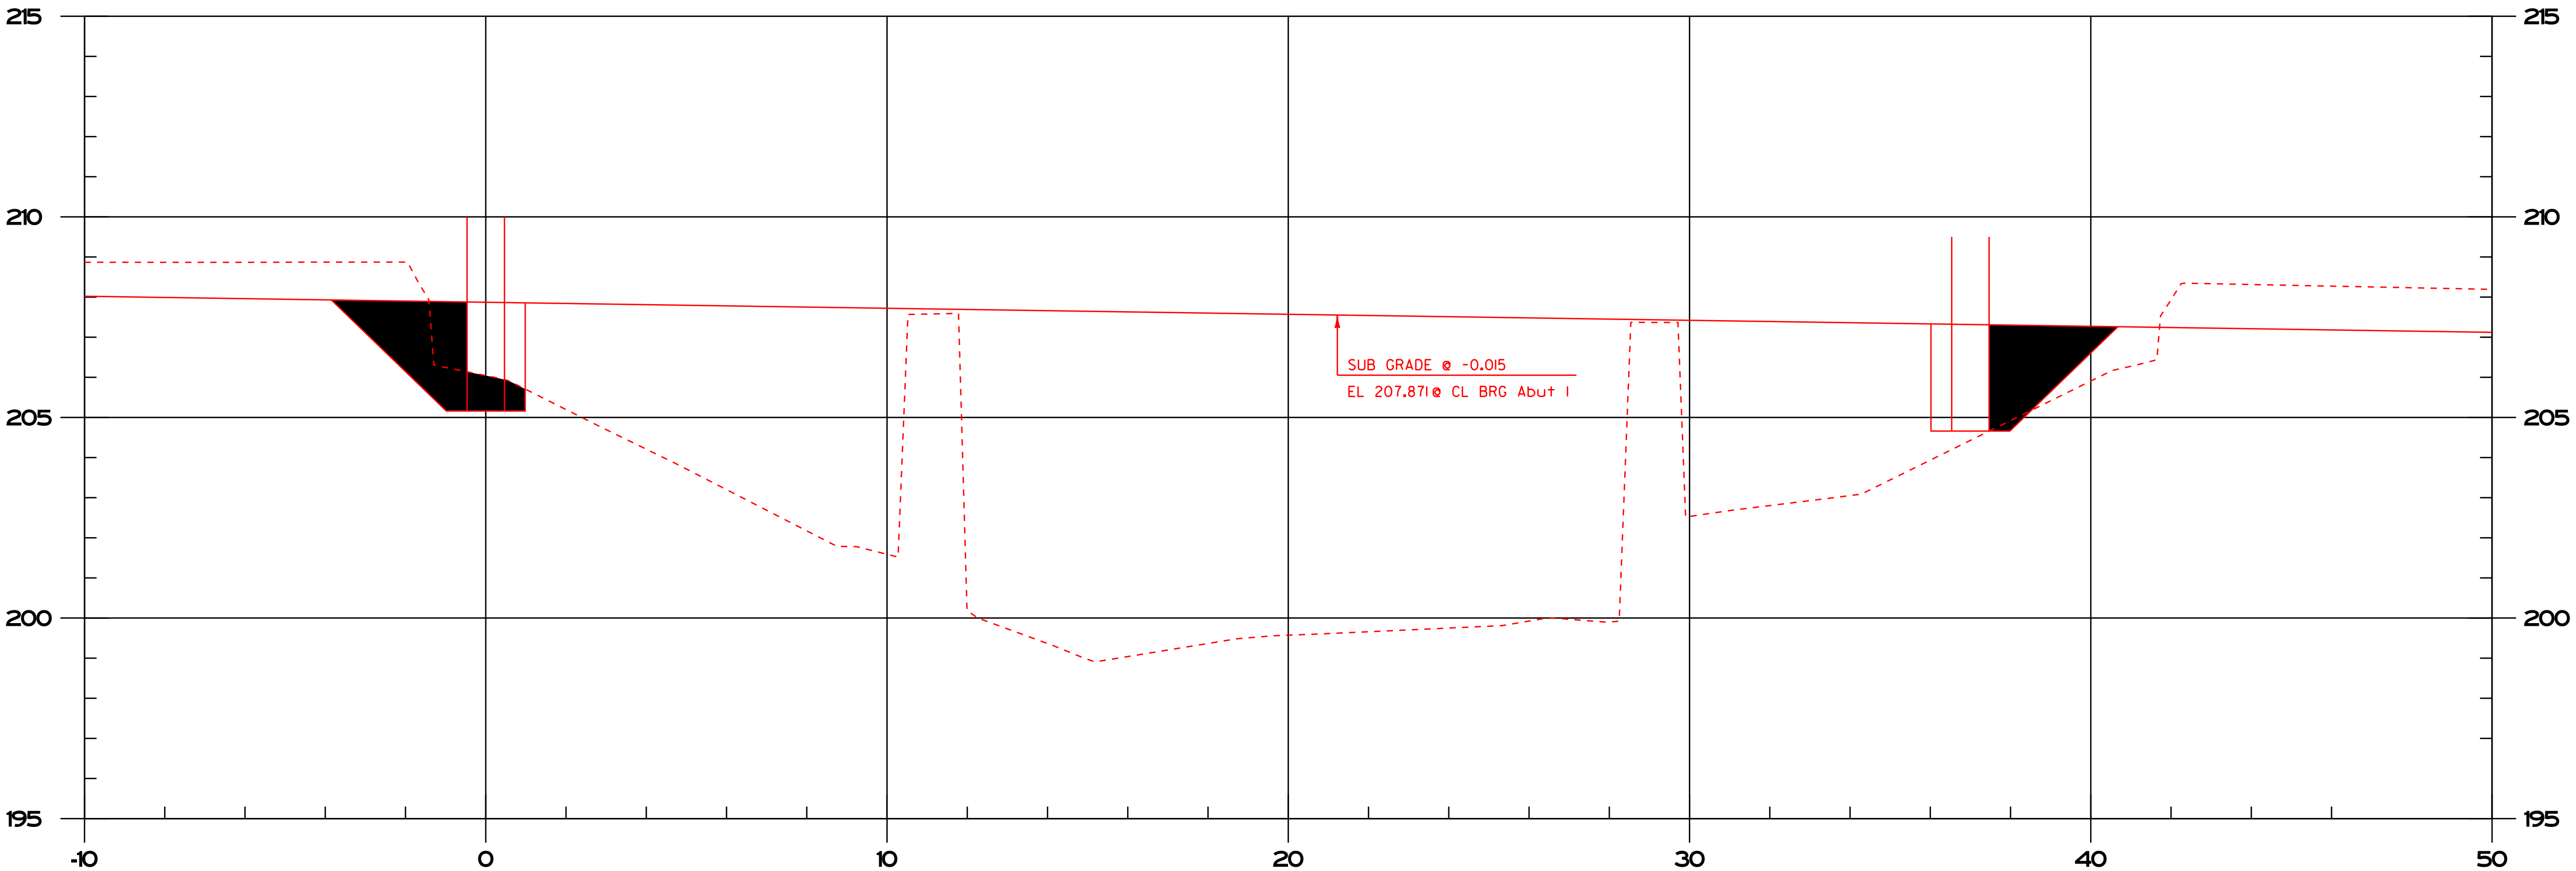


FINISH PRODUCTS DRAWN ON ALTERNATE CHANNEL SECTIONS ARE DRAWN
ACCORDING TO REVISED GRADES (SEE WO #2 DATED 6-8-09) FOR USE IN
DETERMINING STRUCTURE EXCAVATION AND GRANULAR BACKFILL QUANTITIES
CJJ 12-3-09

RIGHT
GRAN. BKFL. FOR STR. (SM) = 5.211
STRUCTURE EXC. (SM) = 5.158
CJJ 12-3-09
CJJ 12-3-09

FAR RIGHT
GRAN. BKFL. FOR STR. (SM) = 4.827
STRUCTURE EXC. (SM) = 0.724
CJJ 12-3-09
CJJ 12-3-09

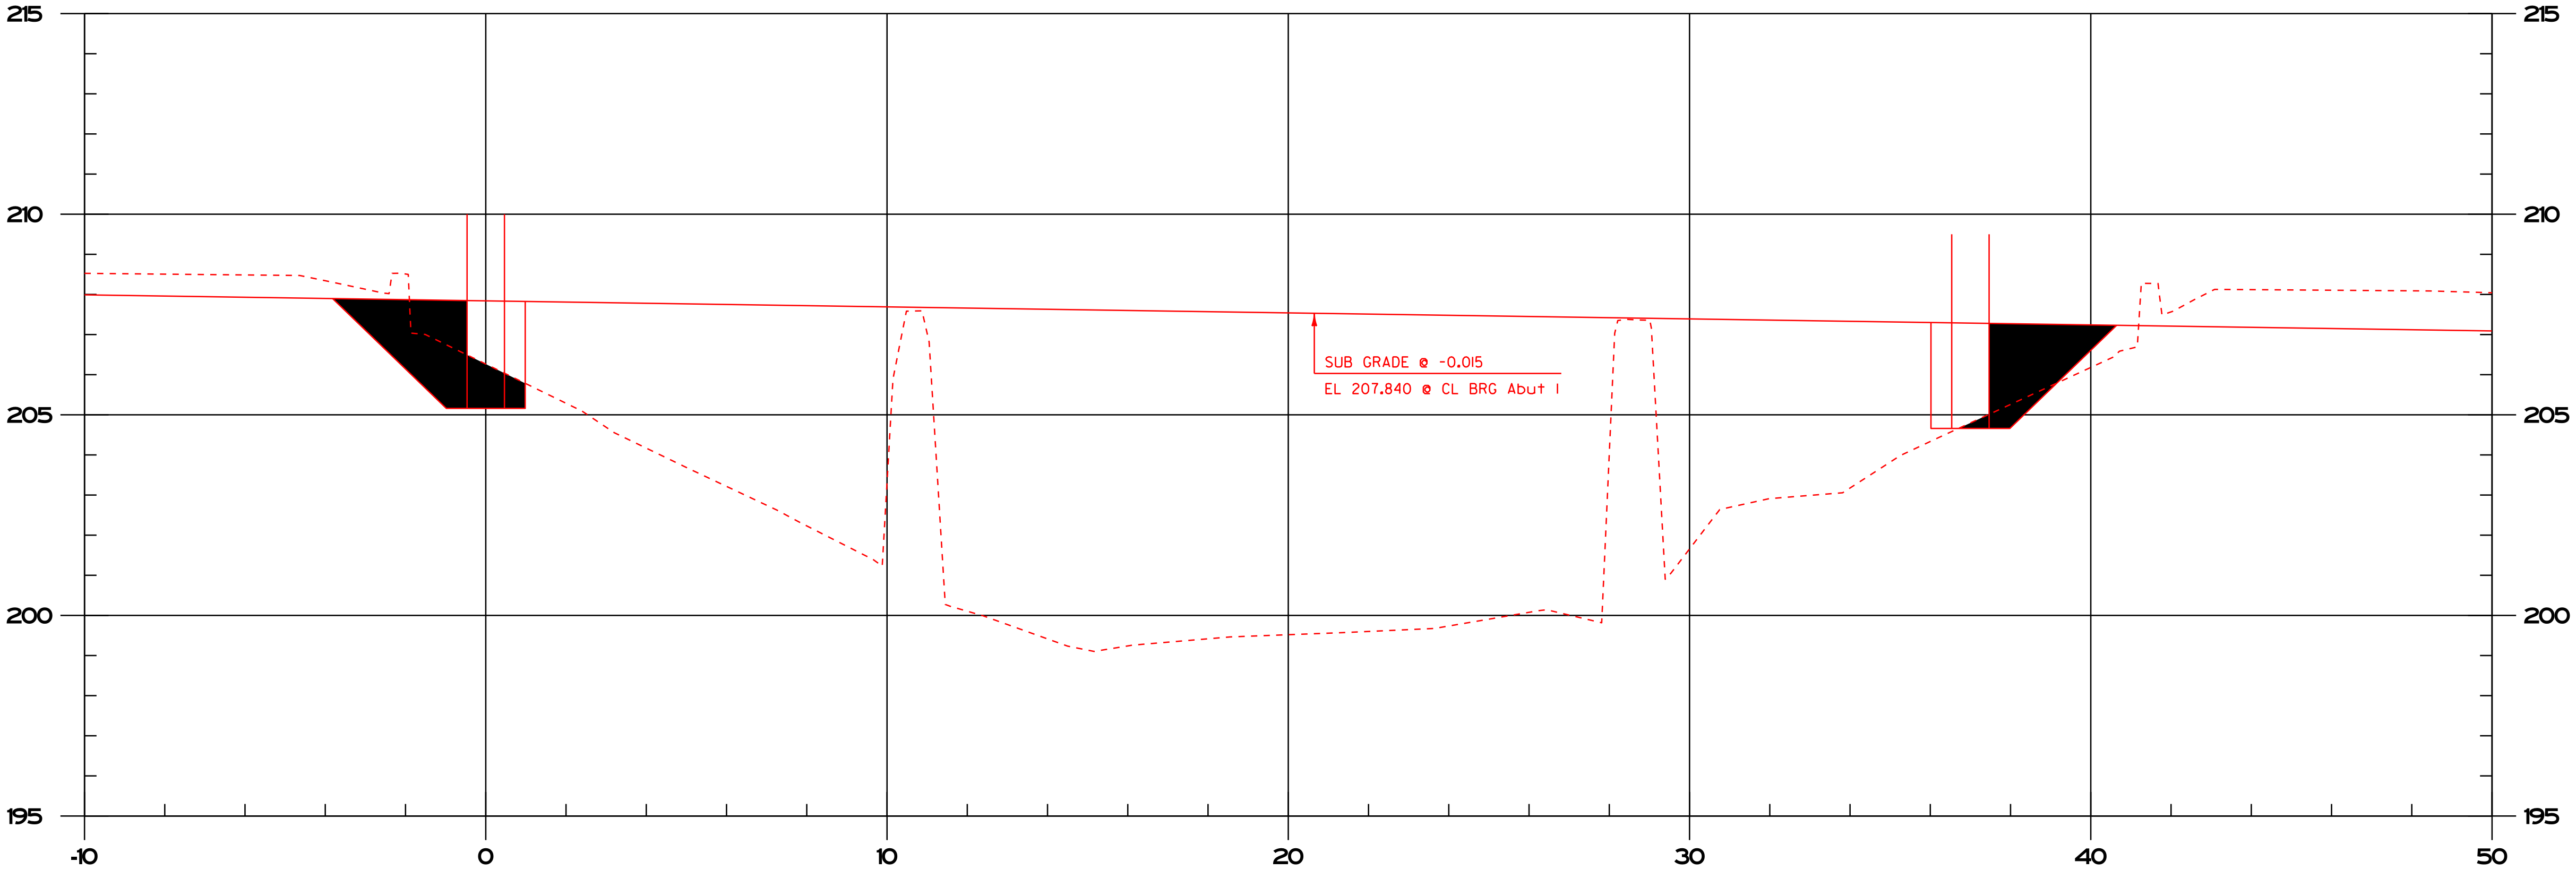

RIGHT
GRAN. BKFL. FOR STR. (SM) = 5.316
STRUCTURE EXC. (SM) = 5.016
CJJ 12-3-09
CJJ 12-3-09

FAR RIGHT
GRAN. BKFL. FOR STR. (SM) = 4.926
STRUCTURE EXC. (SM) = 0.133
CJJ 12-3-09
CJJ 12-3-09

PROJECT:	PROJECT NO.:
EAST MONIPELIER	BRE_028-3(36)
DESIGN FILE NAME: z98b254/stc/sb254xs.dgn	PLOT DATE: 21-MAY-2012 16:00
IPARM FILE NAME: sb254x15.i	DRAWN BY: B.PELLEII
DESIGNED BY: J.LACROIX	CHECKED BY: J.LACROIX
SQUAD LEADER: K.HIGGINS	SHEET: \$S*\$ OF \$T*\$
CHANNEL CROSS SECTIONS #4	



7-31-09 js