


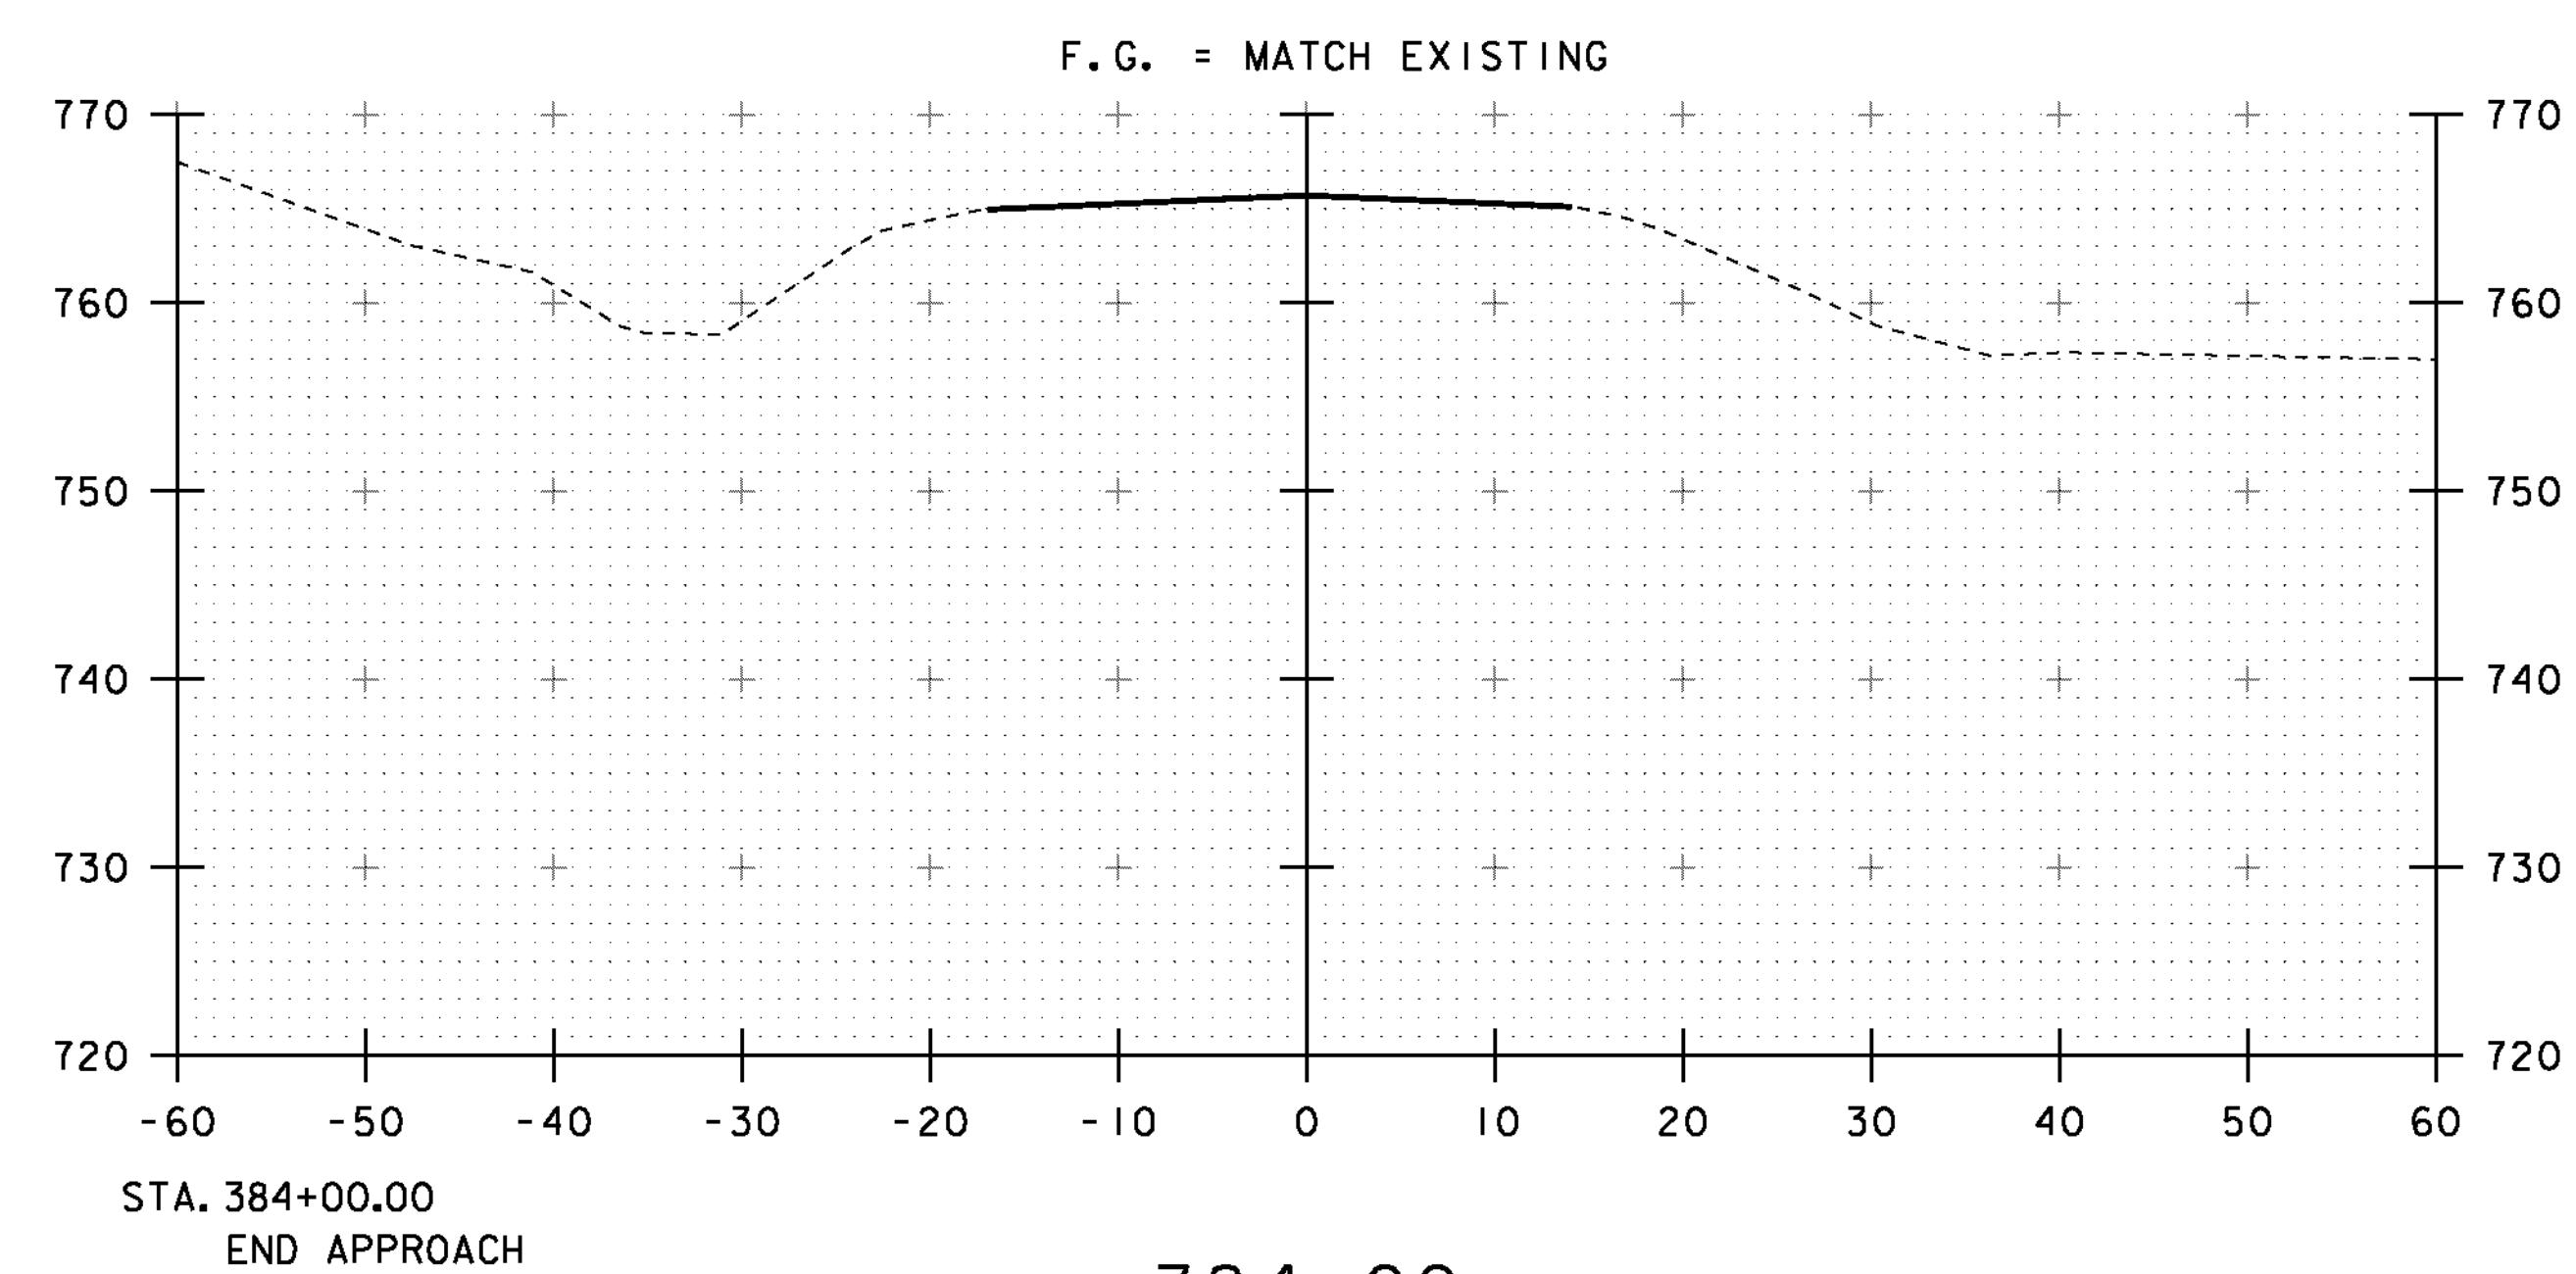

10 0 10
SCALE: 1" = 10'-0"

STA. 384+00

PROJECT NAME: ST. JOHNSBURY
PROJECT NUMBER: BR 028-4(25)S

FILE NAME: s98b320xsl.dgn
PROJECT LEADER: C. CARLSON
DESIGNED BY: H. SALLS
ROADWAY CROSS SECTIONS 10

PLOT DATE: 28-AUG-2012
DRAWN BY: C. MOONEY
CHECKED BY: C. CARLSON
SHEET 40 OF 62