




ABUTMENT NO. 1 SHOWN
ABUTMENT NO. 2 SIM/OPP HAND
SCALE: $\frac{3}{8}" = 1'-0"$

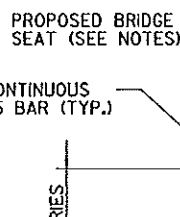

SCALE: I' = I'-0

- ## NOTES

Town Of	BERKSHIRE	Bridge No.	30
		Loc. Sta.	

Highway No.	VT 118	Surv. Sta.
VT 118 OVER MISSISSQUINN RIVER		

ABUTMENT SEAT MODIFICATION DETAILS

Designed By	S. Kiefer	Drawn By	S. Kiefer
Checked By	Date	Bridge Design Supervisor	

PROJECT	PROJECT NO.
BERKSHIRE	DUE 0883/016

LOG. Info.	ZC304802.DG4
------------	--------------