



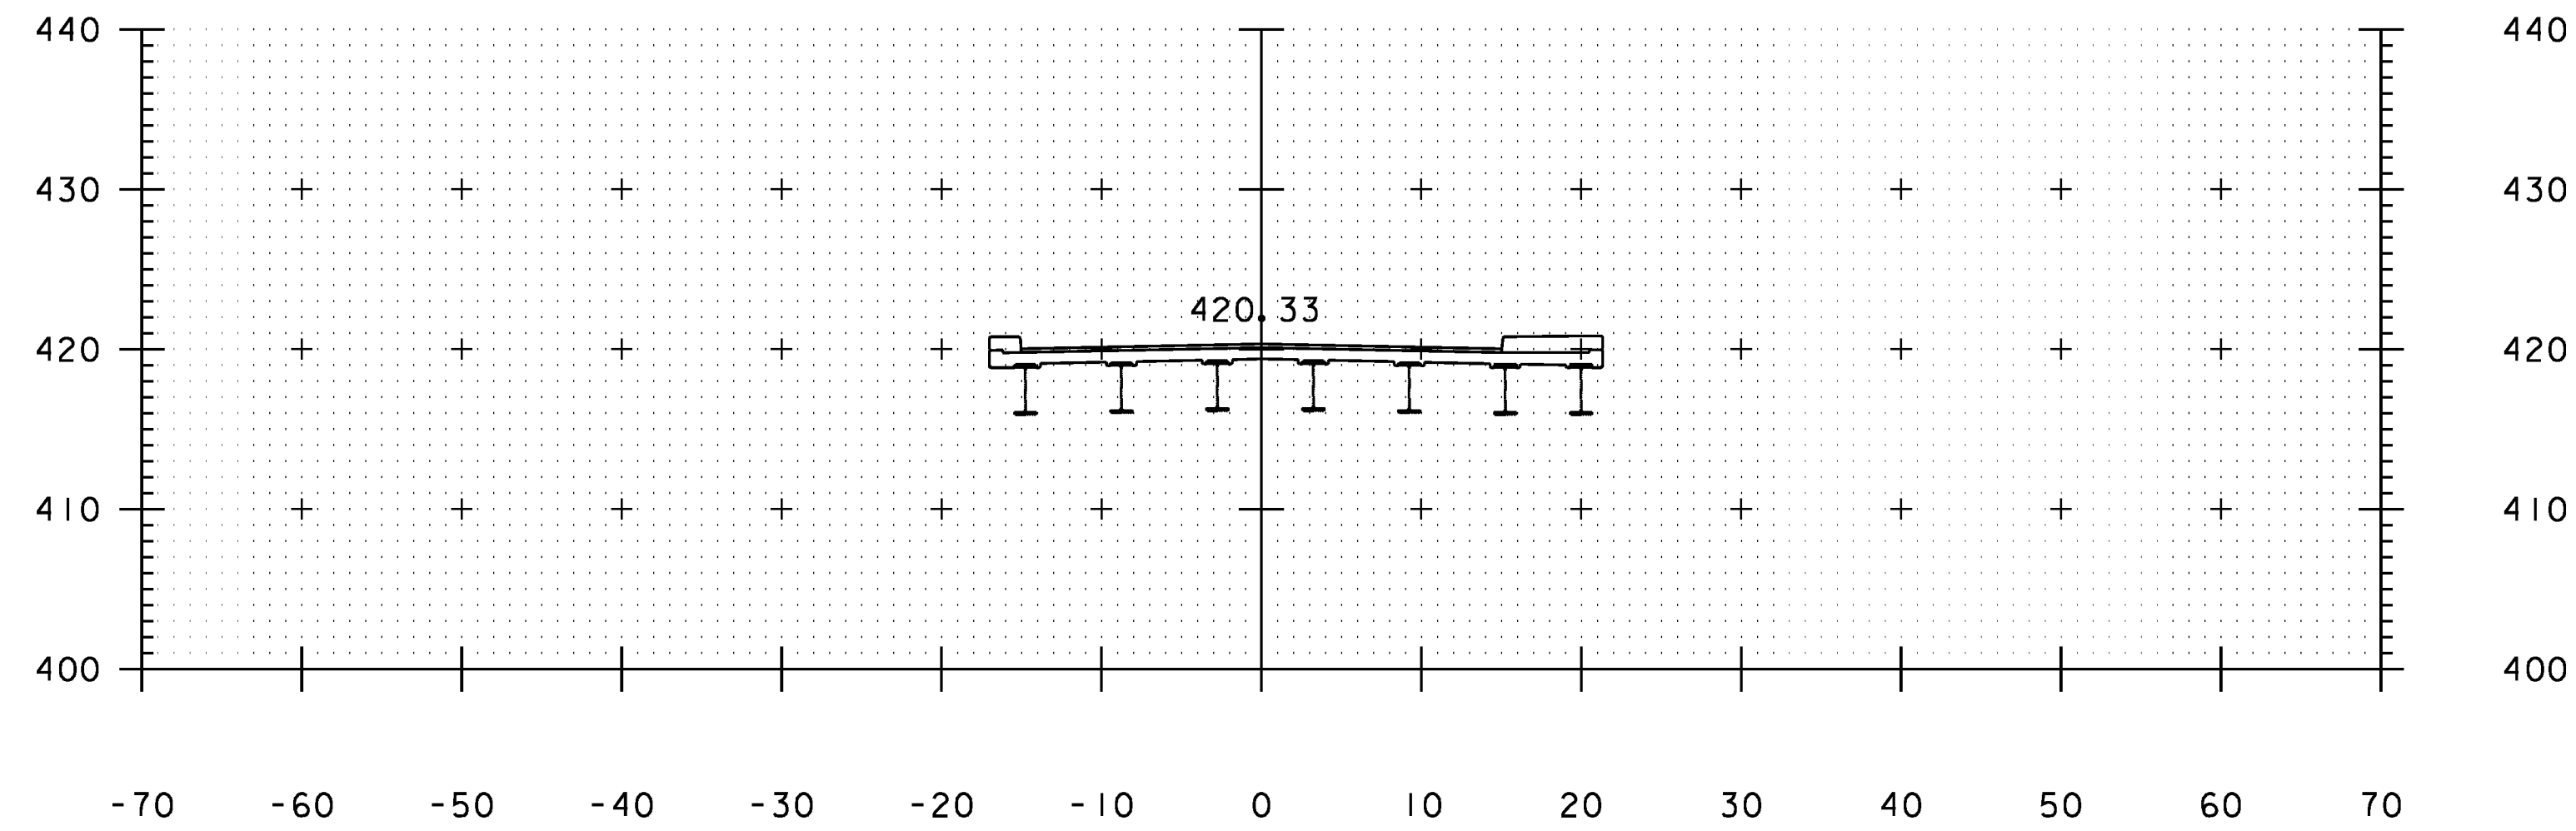

2+00.00

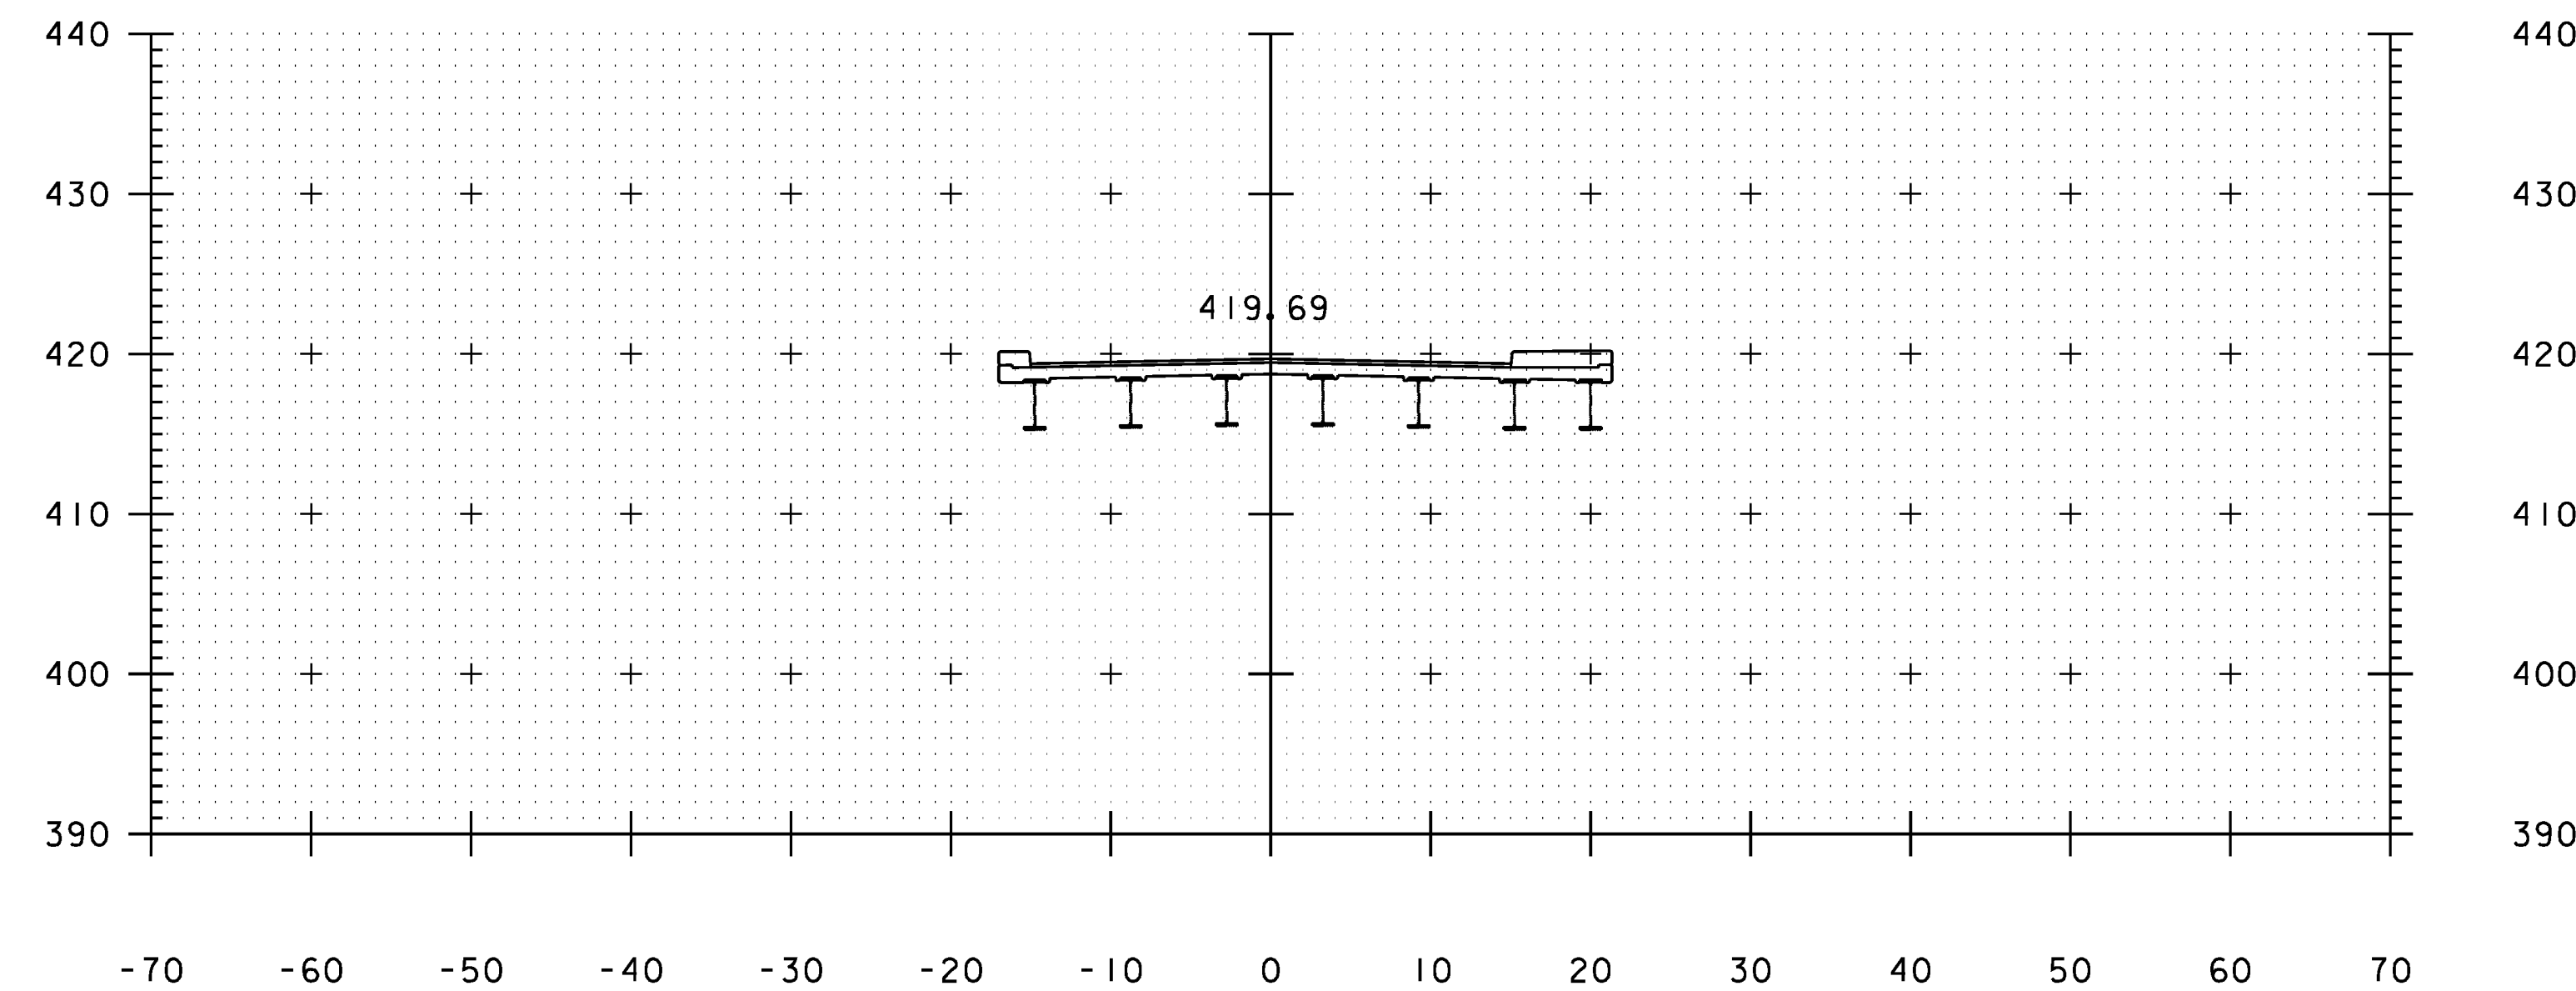

1+50.00

STATE OF VERMONT AGENCY OF TRANSPORTATION			
Town Of <i>BERKSHIRE</i>		Bridge No.	<i>30</i>
Highway No. <i>VT 118</i>		Log Sta.	
		Surv. Sta.	
<i>VT 118 OVER MISSISSQUOI RIVER</i>			
<i>CROSS SECTION 2</i>			
Designed By <i>D. Bryant</i>	Drawn By <i>J. Davis</i>		
Checked By <i>J. Andrews</i>	Date <i>4/2/09</i>	Bridge Design Supervisor	Date
PROJECT <i>BERKSHIRE</i>		PROJECT NO. <i>BHF 0283(9)S</i>	
I.G.C. Info.		<i>ZC304XSLDGN</i>	
Bridge Sheet No.		Sheet <i>33</i> of <i>41</i>	