



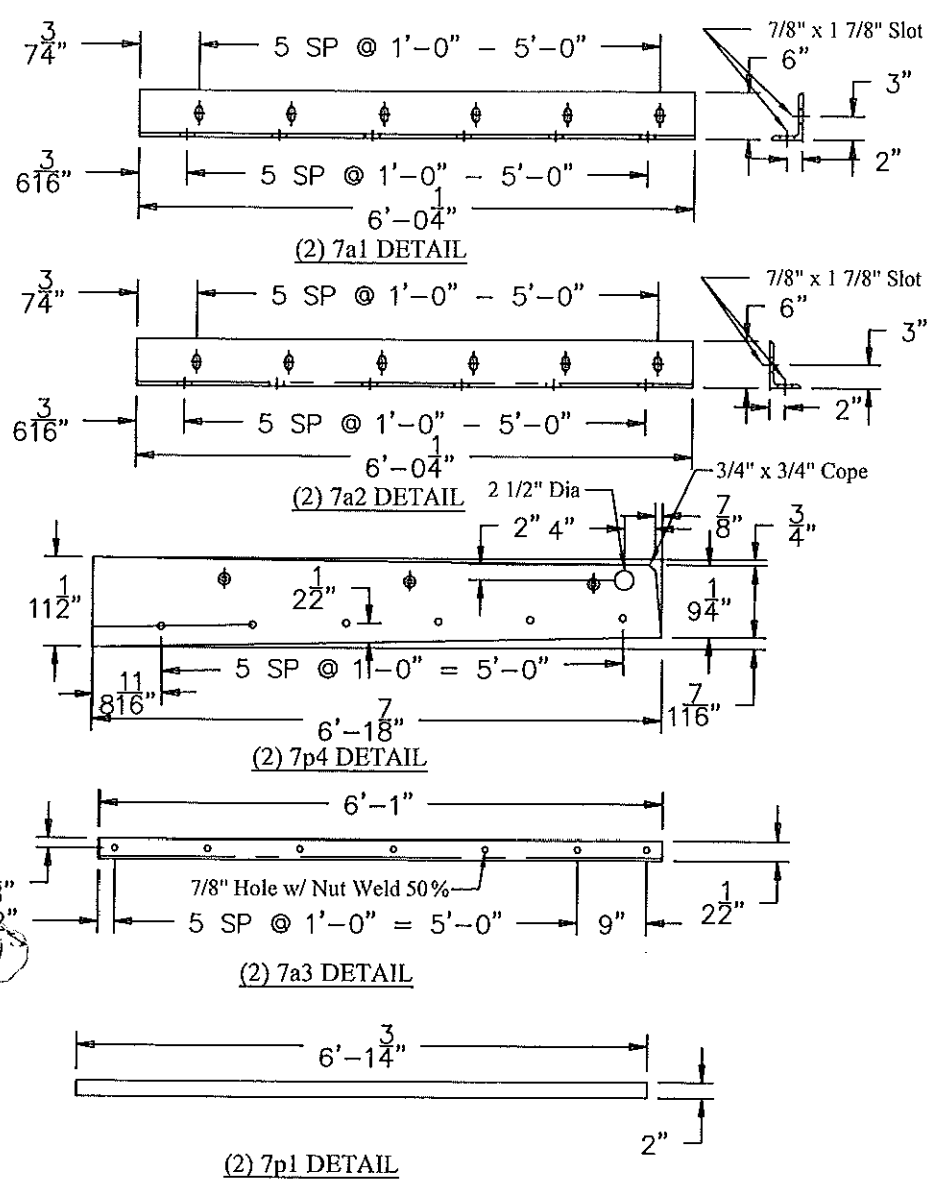

BILL OF MATERIALS				
QTY	MARK	SHAPE	LENGTH	REMARKS
1	7C1	SIDEWALK STR		Abnt 1
1	7C2	SIDEWALK STR		Abnt 2
2	7a1	L 6 x 4 x 1/2	6'-0" 1/4"	
2	7a2	L 6" x 4" x 1/2"	6'-0" 1/4"	
2	7a3	L 2 1/2 x 2 1/2 x 1/2	6'-1"	
2	7p1	Plate 5/8 x 2"	6'-1 3/4"	
1	7p2	Plate 1/2 x 7"	6'-1 3/4"	
1	7p3	Plate 1/2 x 6 1/2"	6'-1 3/4"	
2	7p4	Plate 1/2 x 11 1/2"	6'-1 7/8"	
1	7p5	Plate 1/2 x 11 1/2"	6'-1 7/8"	
1	7p6	Plate 1/2 x 6 1/2"	1'-9 7/8"	
1	7p7	Plate 1/2 x 5 1/2"	0'-9 1/2"	
1	7p8	Plate 1/2 x 5 1/2"	1'-9 7/8"	
2	7p9	Plate 5/8 x 2"	1'-8"	
2	7p10	Plate 5/8 x 2"	11'-0" 1/2"	
2	8p1	Plate 1/2 x 20"	6'-3"	
2	8p2	Plate 1/2 x 20"	11'-0" 1/2"	
2	8p3	Plate 1/2 x 10 1/8"	1'-8"	
2	8p4	Plate 1/2 x 11 5/8"	6'-1 7/8"	
28	7a1	3/4" x 7" Welded Stud		Str
14		Bolt 3/4" x 1 1/2" Lg w/ Nut & Washer		
14		Flat CS Nut, Cap Screw 3/4" x 1 1/2" Lg w/ Nut		Coat

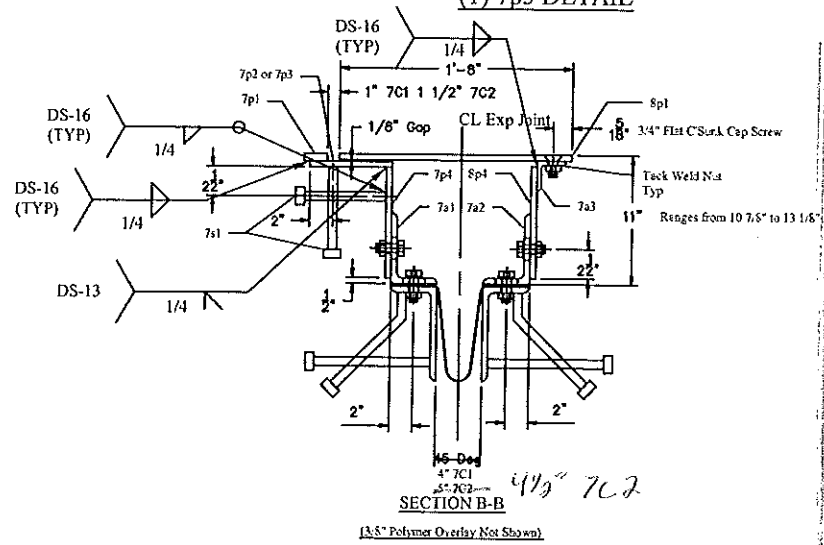

30 Description Taken

X Make Correction as Noted

Submit Specified Item

Revise and Resubmit as Noted

Rejected

Checking to fit general compliance with the design concept of the project and general compliance with the information given in the contract documents only. Any deviation shown is not an approval and is subject to the requirements of the plans and specifications. Any action shown on a specific item shall not indicate the checking of an assembly of which the item is a component. Contractor to ensure responsibility for dimensions shown shall be confirmed and coordinated at the job site, fabrication processes, techniques of construction, quality procedures, and consideration of its work with that of all other trades and the satisfactory coordination of its work.

Reviewed By: Shanta Keller Date: 5/10/10

DRAWING CODES		DATE: 01/11/2013	
<u>CURB LAYOUT & DETAILS</u>			
PROJECT	RESCUE BAY 6083 RD 2		
LOCATION	VIRMONT ROUTE 118 BRIDGE NO. 30		
ENGINEER	VERMONT AGENCY OF TRANSPORTATION		
CUSTOMER	S. D. IRELAND CONCRETE CONSTRUCTION CORPORATION		
MERRIMACK SHEET METAL		DRAWN BY:	RL
119 HALL STREET CONCORD NH 03301		CHECKED BY:	JD
		ADD NO.	#3201
		DWG:	F7