
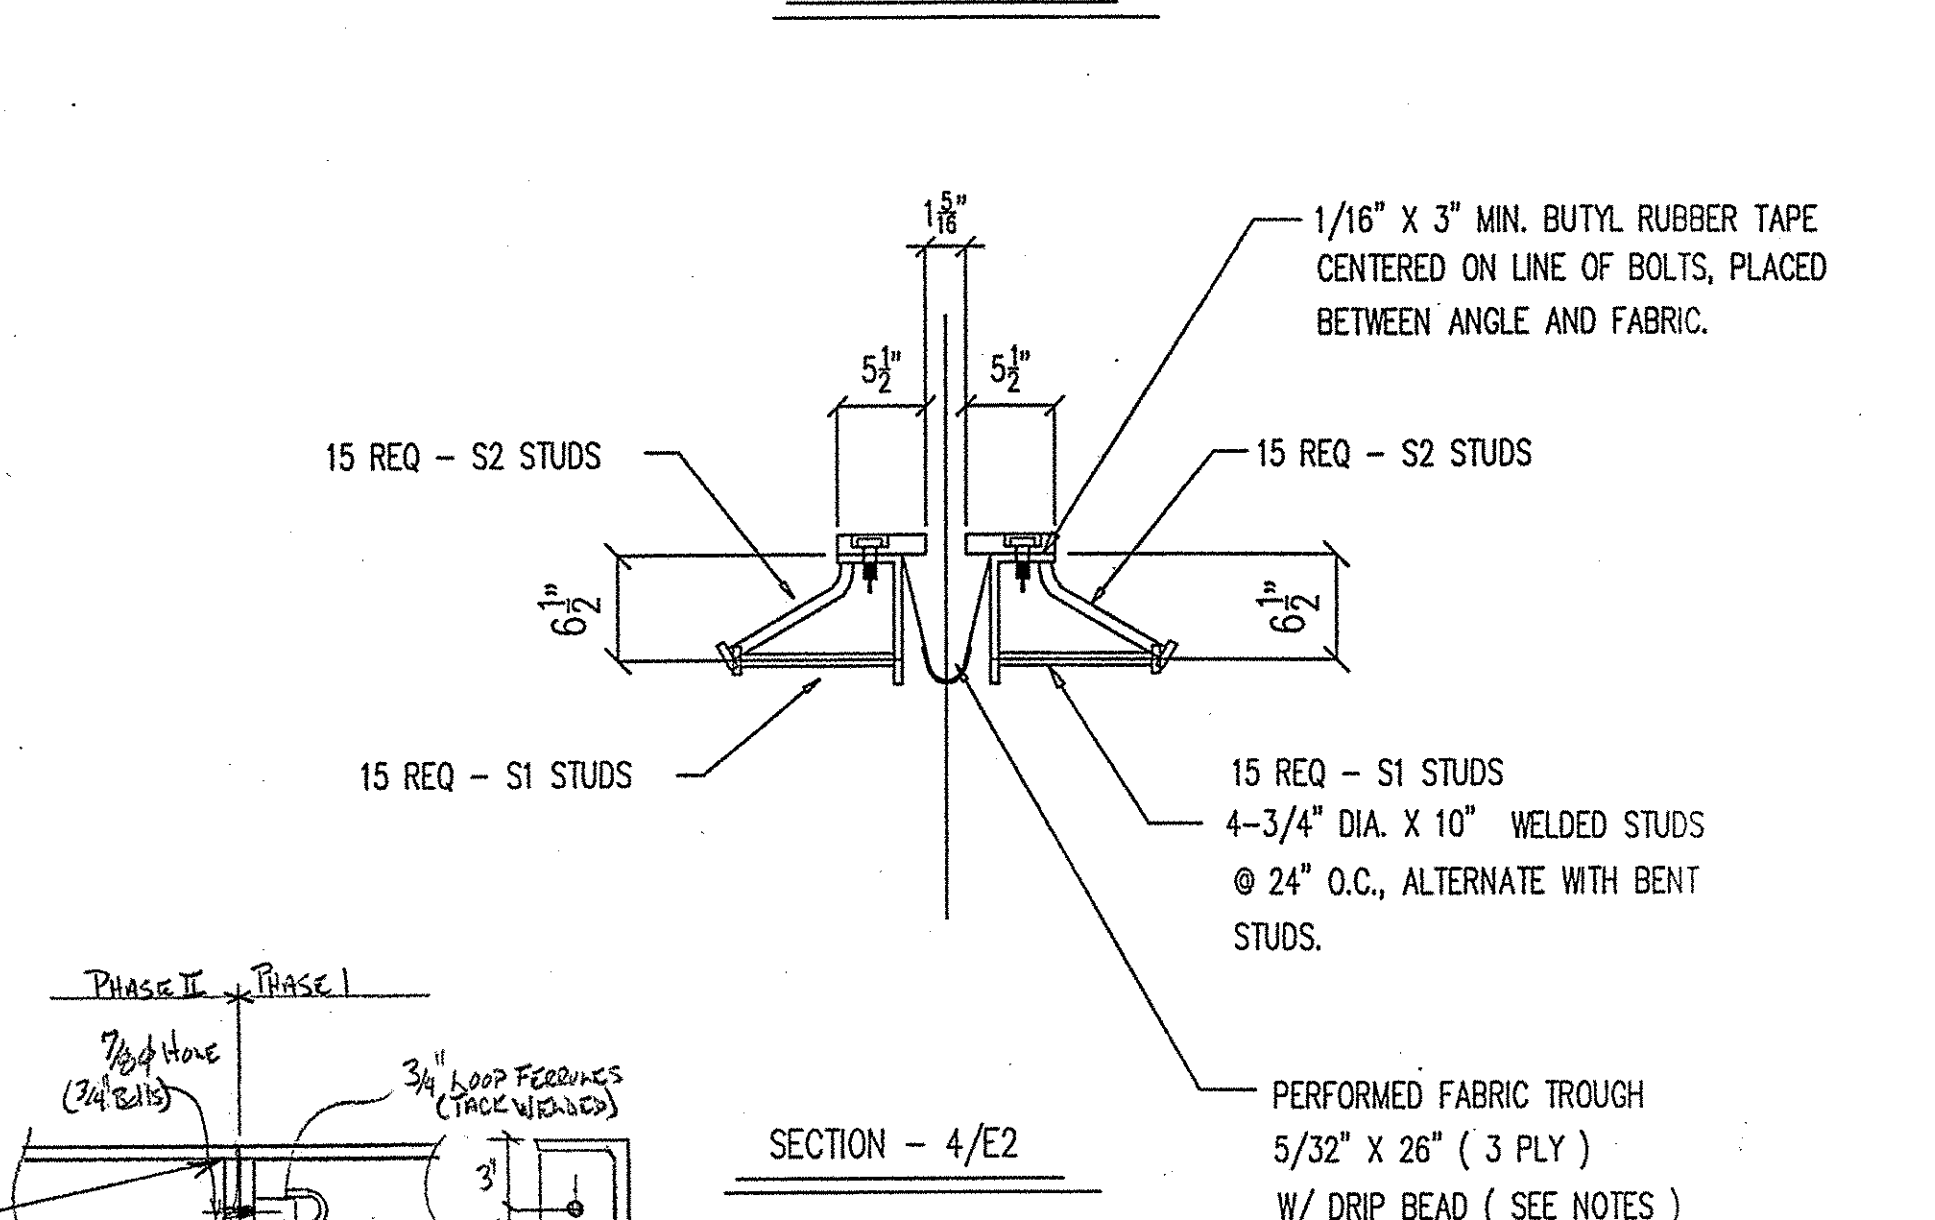
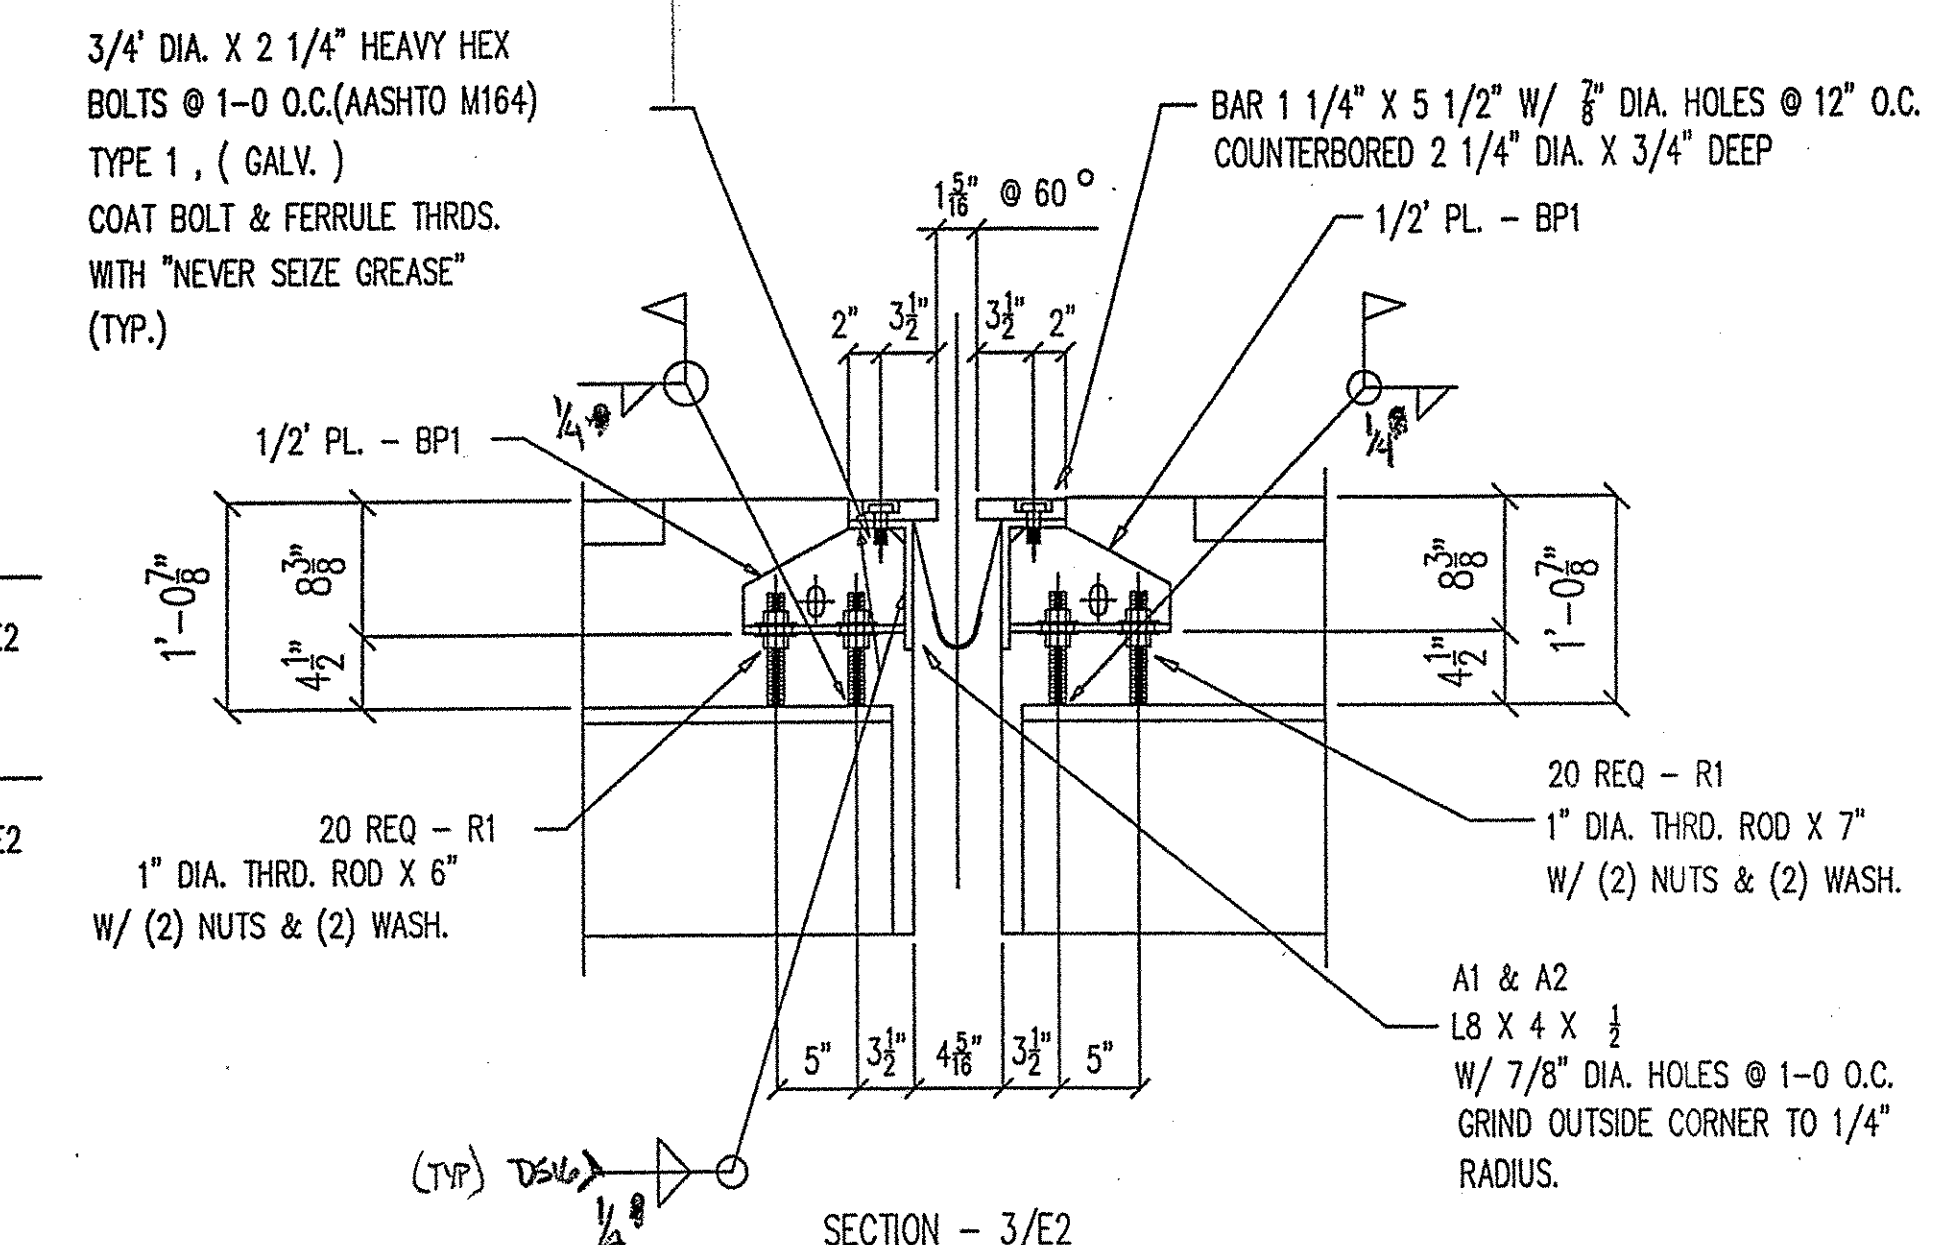


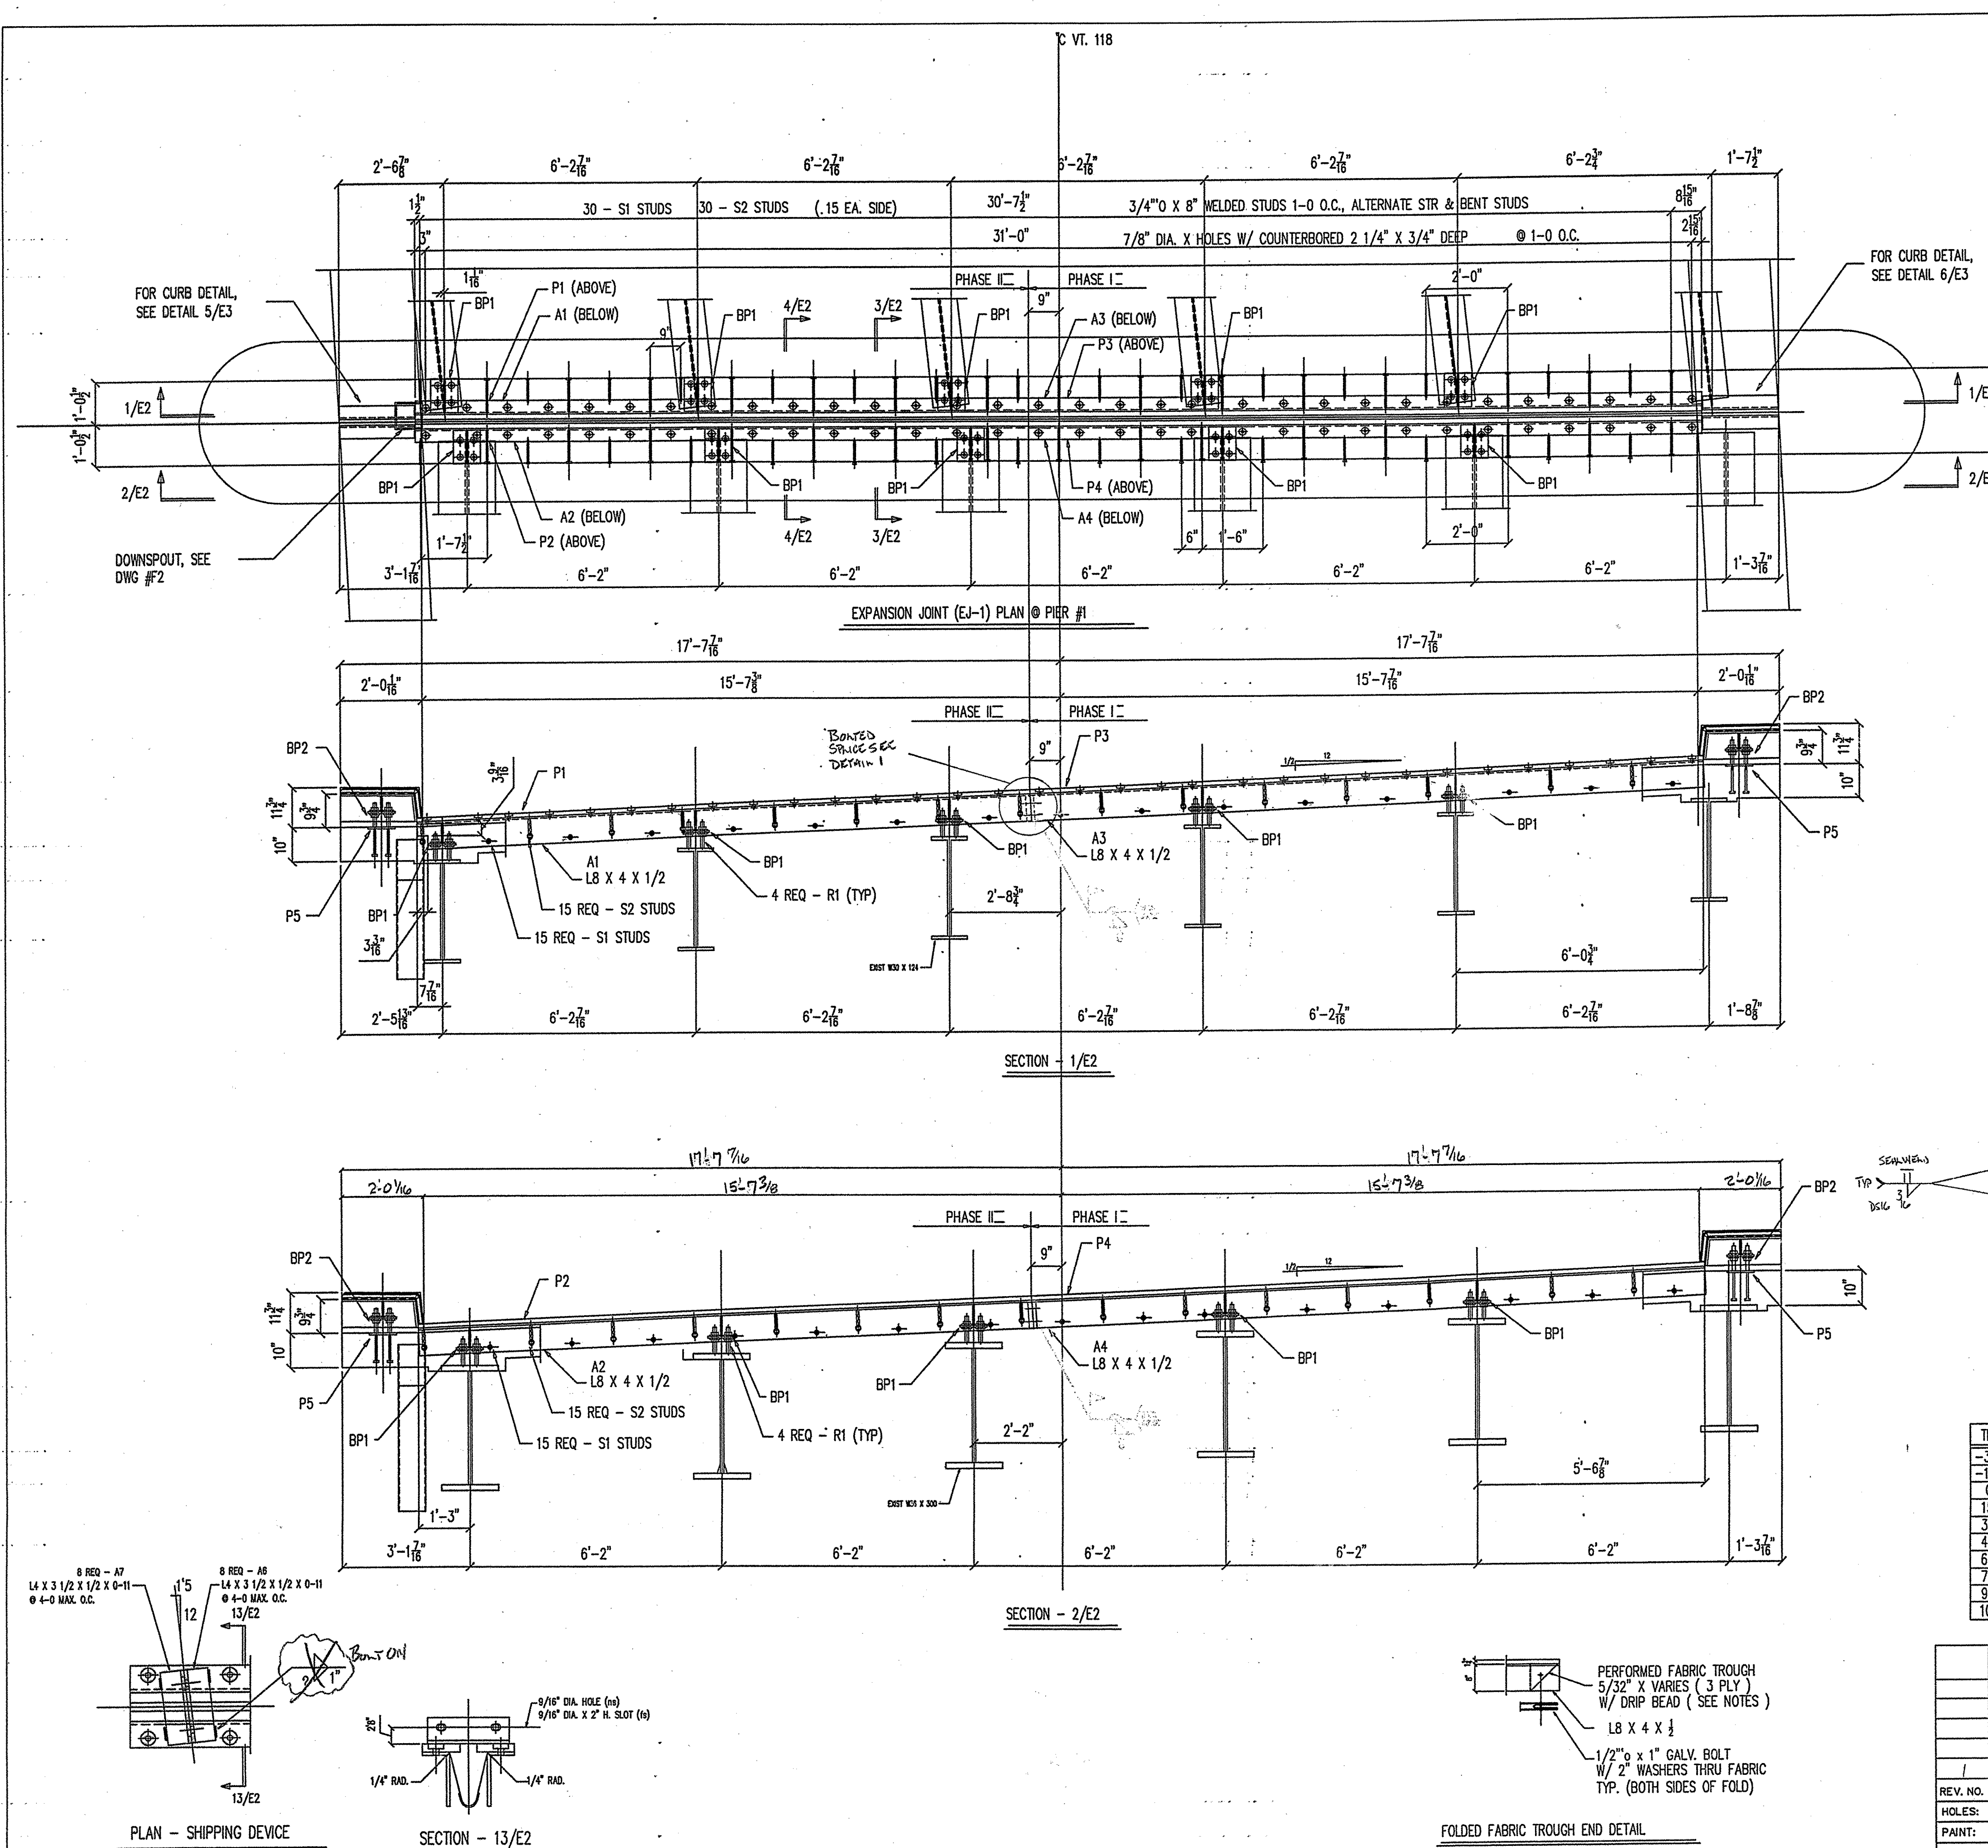

TEMP	"A" DIST.	"B" DIST.	"C" DIST.
-30°F	2 9/16	5 9/16	3 1/16
-15°F	2 3/8	5 3/8	2 7/8
0°F	2 1/8	5 1/8	2 5/8
15°F	1 15/16	4 15/16	2 7/16
30°F	1 11/16	4 11/16	2 3/16
45°F	1 1/2	4 1/2	2
60°F	1 5/16	4 5/16	1 13/16
75°F	1 1/16	4 1/16	1 9/16
90°F	7/8	3 7/8	1 3/8
105°F	5/8	3 5/8	1 1/8

EXPANSION JOINT (EJ-1) PLAN @ PIER #1

DATE SUB. PROJECT MONTGOMERY VT. BRIDGE

DATE APP. LOCATION VT. ROUTE 118, BRIDGE #21

DATE DIST. ARCHITECT MONTGOMERY, VT.

ENGINEER STATE OF VERMONT, AGENCY OF TRANSPORTATION

CUSTOMER A.L. ST. ONGE CONST.

MERRIMACK SHEET METAL

119 HALL ST.

CONCORD, N.H., 03301

TEL. (603) 224-7766

FAX. (603) 224-7925

DR BY KJM

REV BY

JOB NO. 0770

DWG NO. E2