


LIST OF
CONSTRUCTION SIGNS

TOWN HIGHWAY	RWA	RW500	EW	RWN	SRWA	SRW500
CAMBRIDGE						
BEGIN PROJECT			2		4	4
TH#23	1		1			
QUINN ROAD - TH#14	1		1			
MARSH ROAD - TH#15	1		1			
WATERVILLE						
HOGBACK ROAD - TH#4	1		1			
PLOT ROAD - TH#1	1		1			
OAKES ROAD - TH#18	1		1			
CHURCH STREET - TH#20	1		1			
TH#27	1		1			
FOX HILL - TH#28	1		1			
BEALS HILL - TH#12	1		1			
LAPLAND ROAD - TH#4	1		1			
BURT ROAD - TH#13	1		1			
MONTGOMERY ROAD - TH#14	1		1			
CODDING HOLLOW ROAD - TH#3	1		1			
WOODARD ROAD - TH#26	1		1			
MAXFIELD ROAD - TH#9	1		1			
SMITHVILLE ROAD - TH#7	1		1			
BELVIDERE						
BACK ROAD - TH#3	1		1			
LARAWAY MOUNTAIN ROAD - TH#7	1		1			
MORGAN BRIDGE ROAD - TH#2	1		1			
BACK ROAD - TH#3	1		1			
END PROJECT	2	2	1	1		
TOTALS	23	2	24	1	4	4

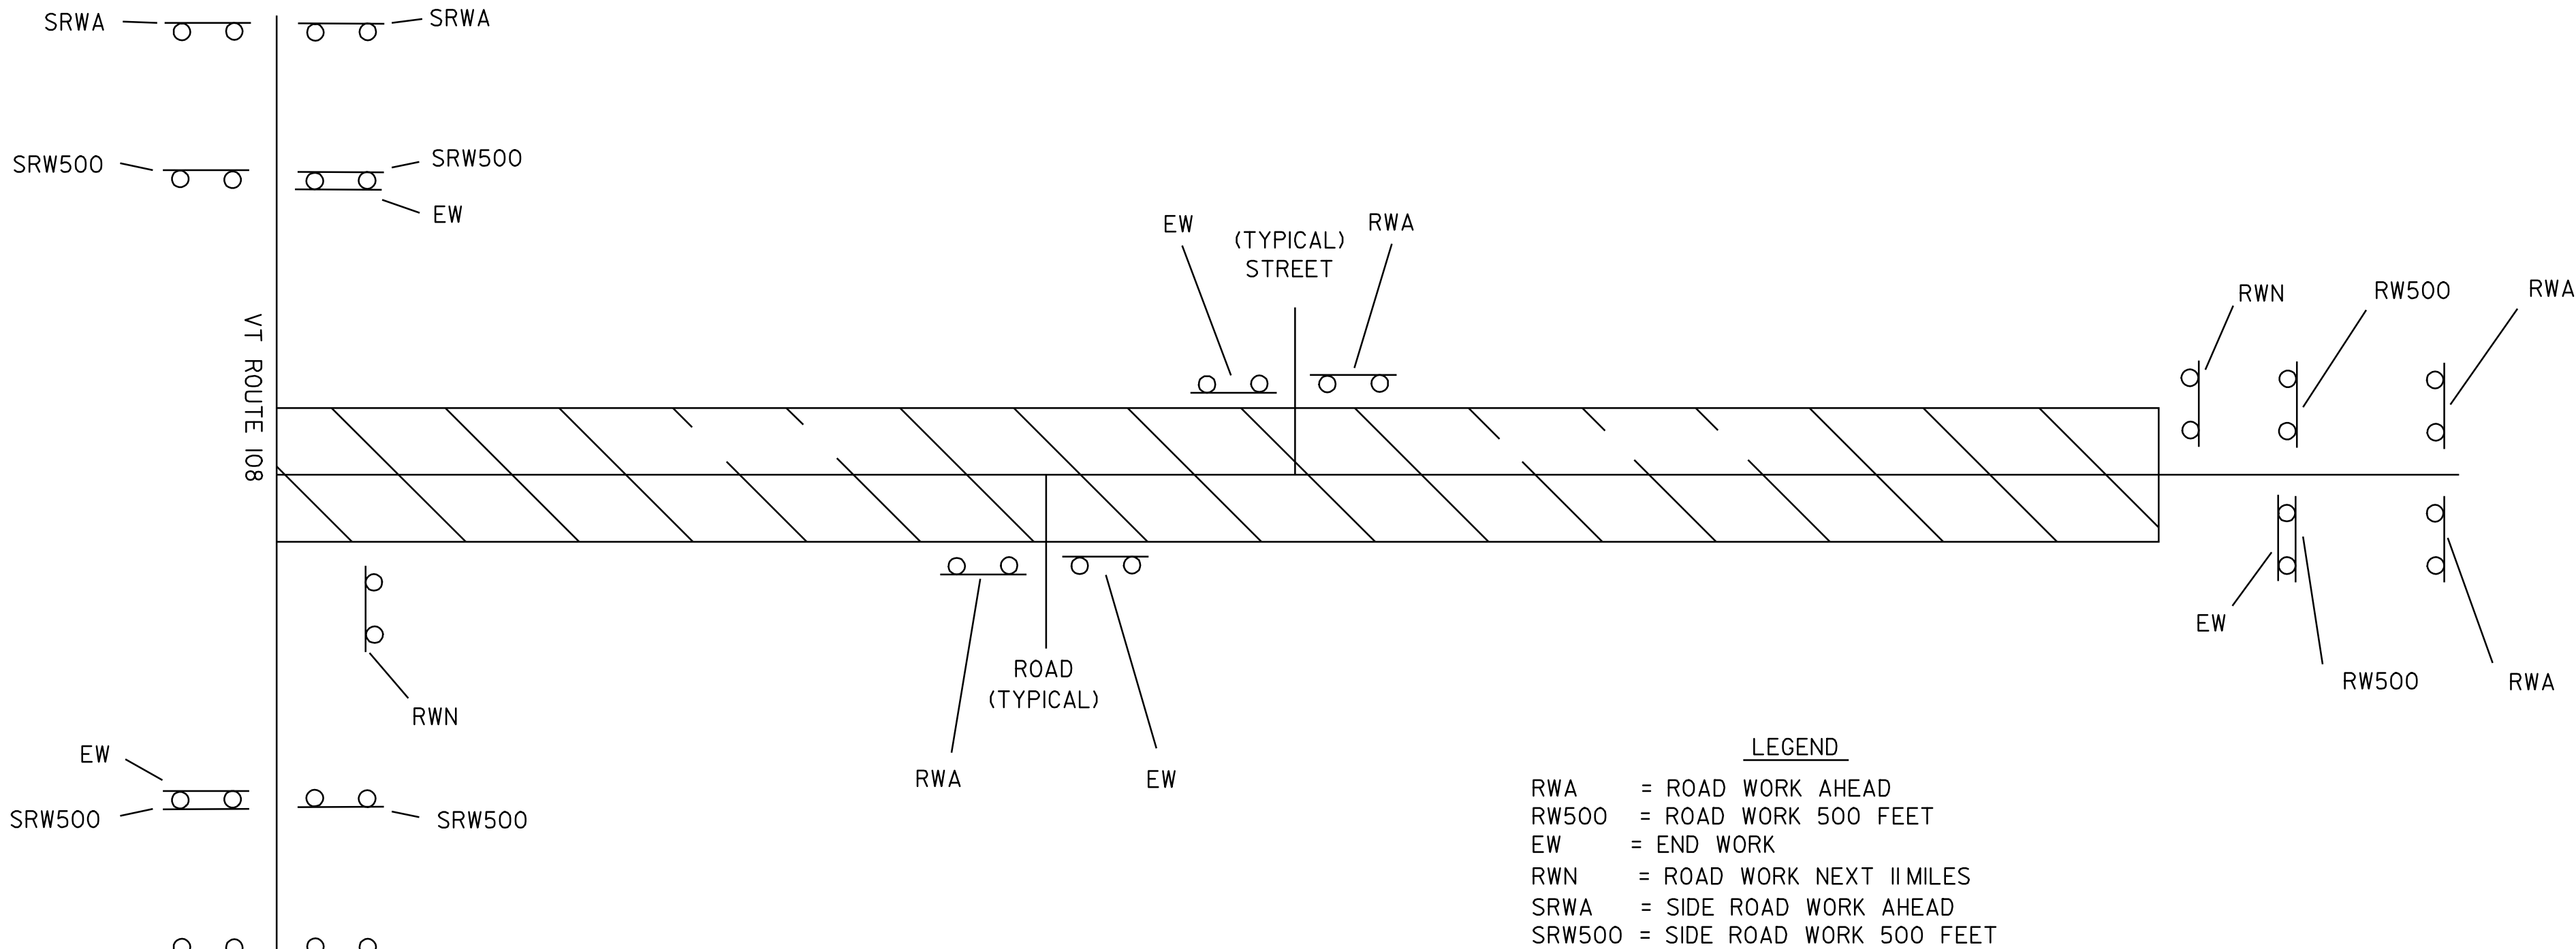


CONSTRUCTION APPROACH SIGNING

SEE STD. E-100 FOR SIGN PLACEMENT

RESIDENT ENGINEER, AT HIS OR HER DISCRETION, SHALL ELIMINATE CONSTRUCTION APPROACH SIGNING AT DEAD END LOCATIONS.

NOTE:

THE CONTRACTOR SHALL INCLUDE A CONSTRUCTION SIGN PACKAGE FOR EXPECTED LANE CLOSURES AND WORK ZONE SPEED REDUCTIONS IN COMPLIANCE WITH STANDARD E-103. PAYMENT FOR PROVIDING THIS PACKAGE SHALL BE INCIDENTAL TO ITEM 641.10, TRAFFIC CONTROL.

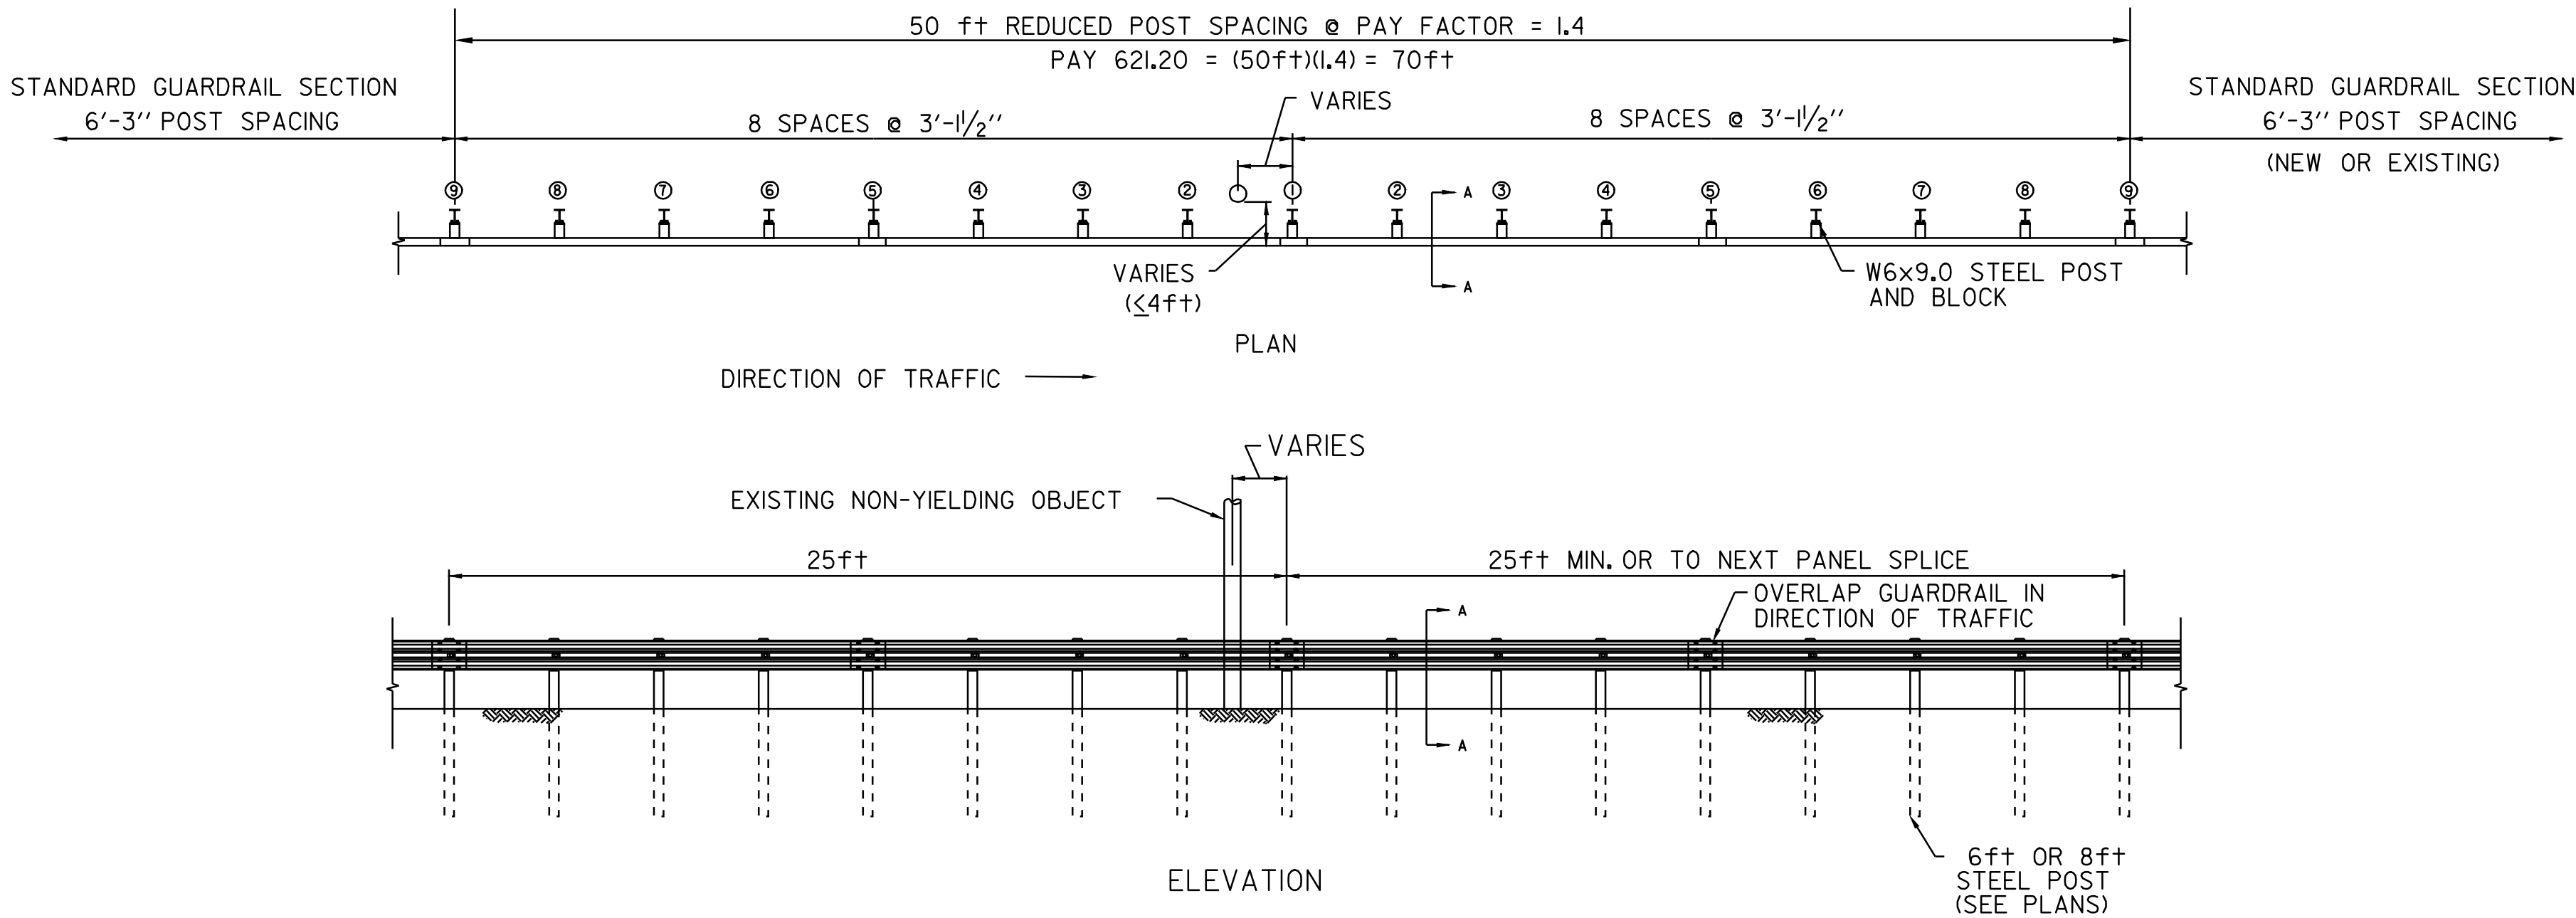


NON-YIELDING OBJECT APPROACH DETAIL

WATERVILLE

STA 35+15 LT
~~STA 36+22 LT~~
STA 37+42 LT
STA 92+11 RT

CONSTRUCTION APPROACH
SIGNING &
NON-YIELDING OBJECT
APPROACH DETAILS

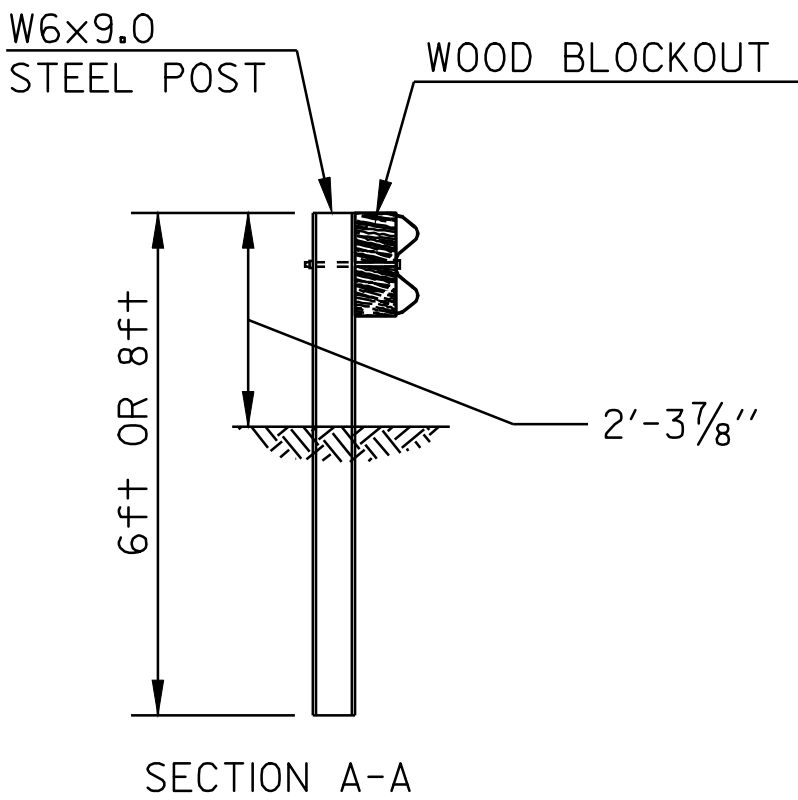

DATUM
VERTICAL N/A
HORIZONTAL N/A

DESIGNED BY BCE/PJM DATE 8-05
DRAWN BY C.E.A., INC. DATE 8-05
DESIGN FILE NO. p99ci90.dgn
PRF FILE p99ci90cas.1 DATE 12-DEC-2008 09
PROJ. NAME **CAMBRIDGE - BELVIDERE**
PROJ. NO. **STP 2219(1)S**
SHEET **37** OF **37** SHEETS