
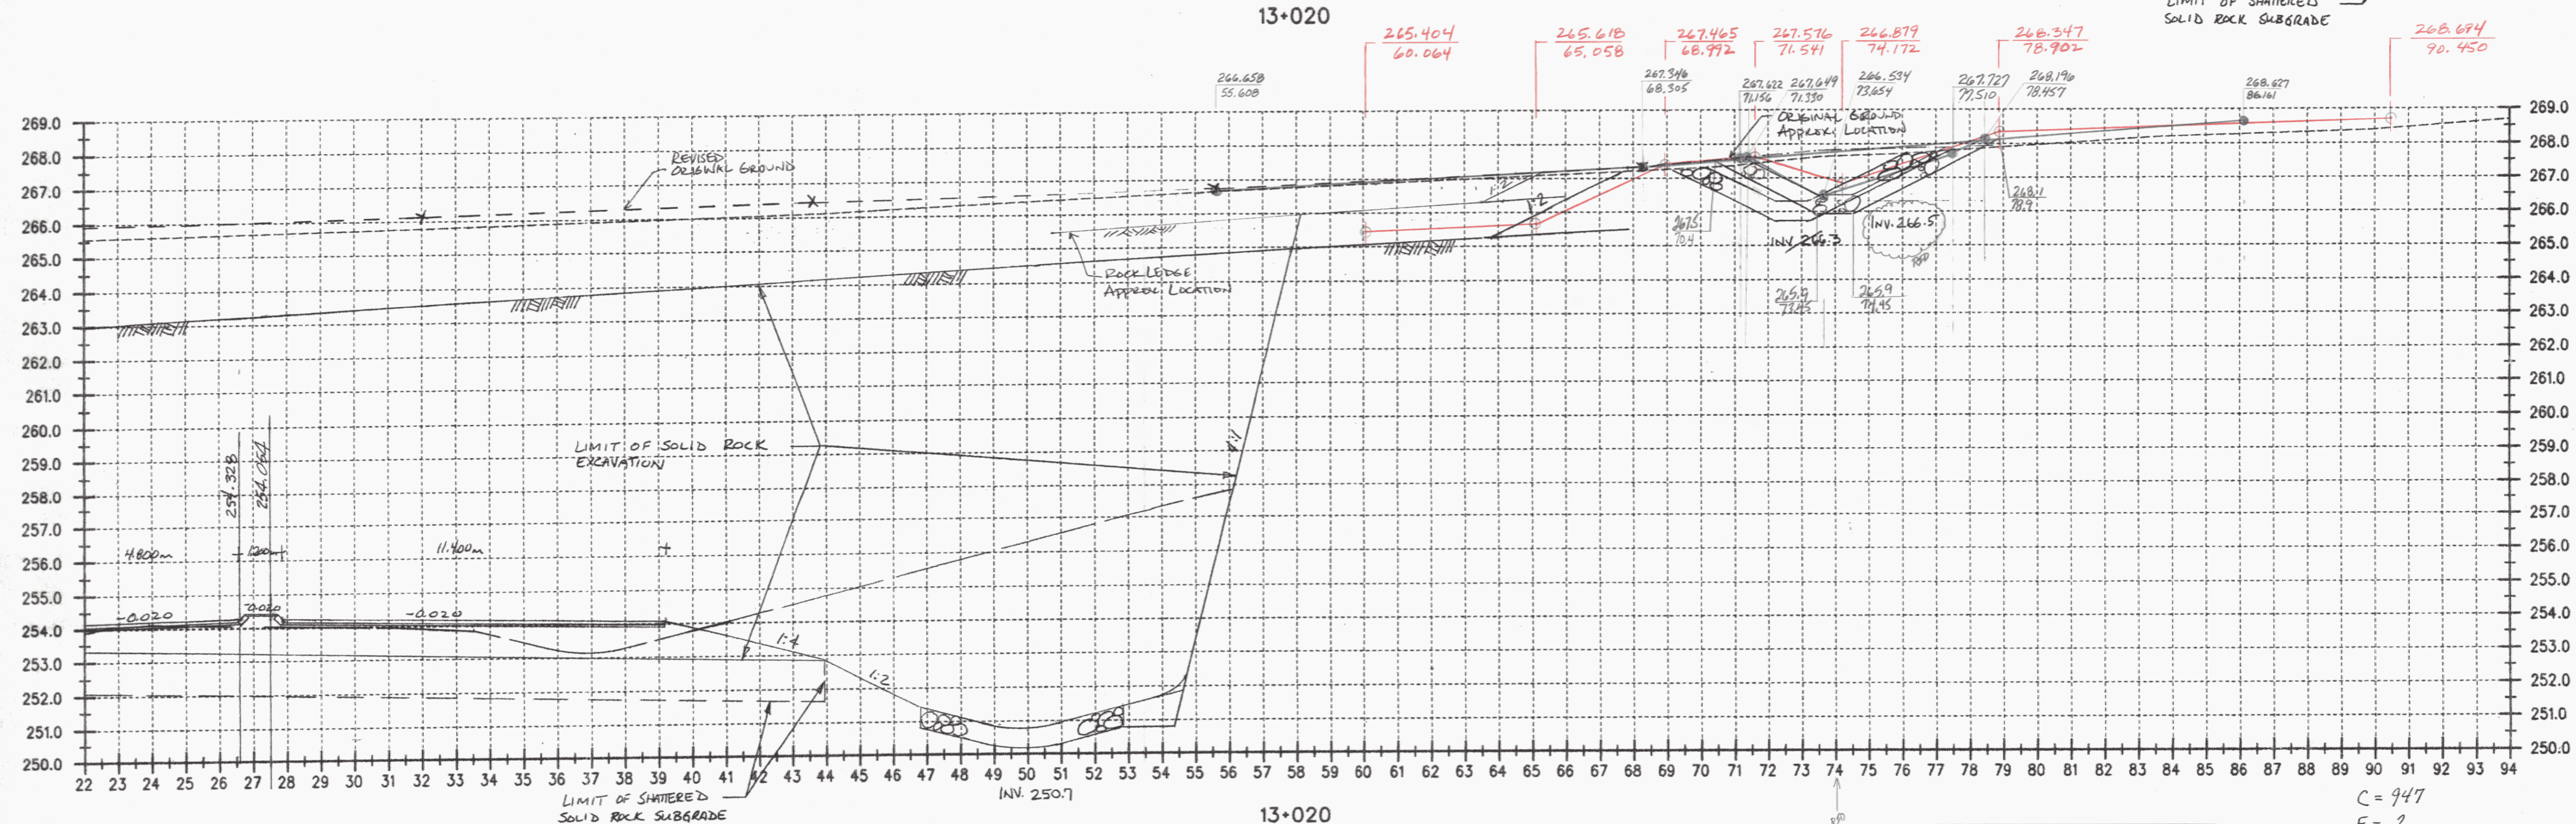


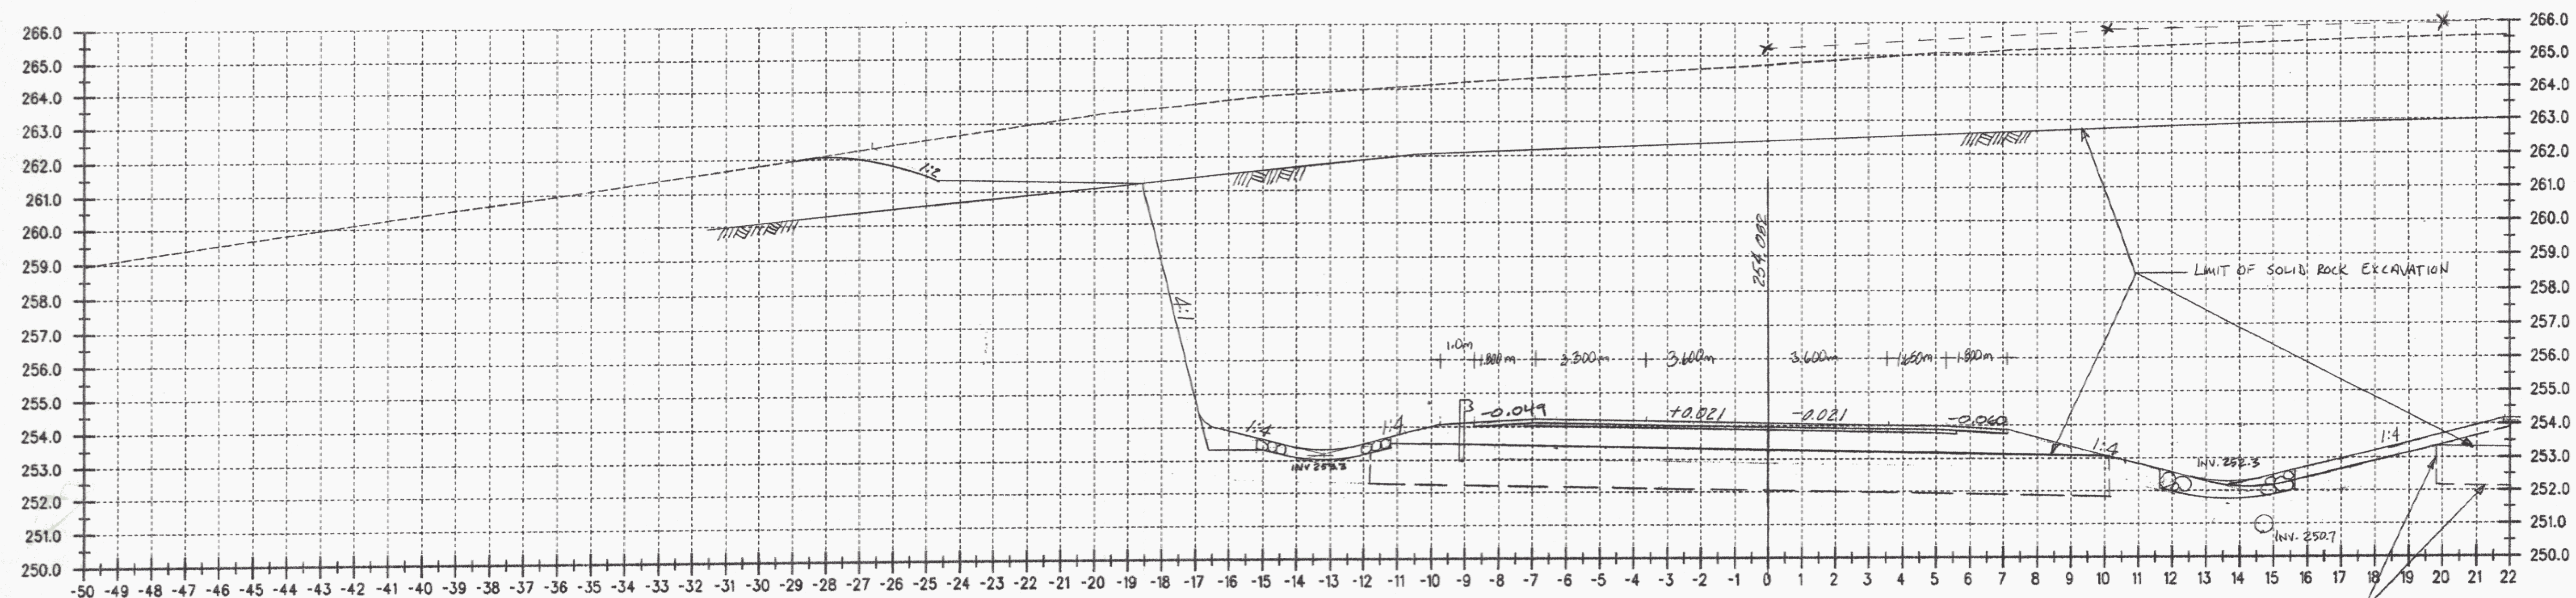

13+020


13+020

FG. Rmt 11/10/05 *[Signature]* 11/1/05

C = 947
F = 2
R = 750

DATUM	
VERTICAL	NAVD 1988
HORIZONTAL	N/A

ALL DIMENSIONS IN MILLIMETERS EXCEPT AS INDICATED

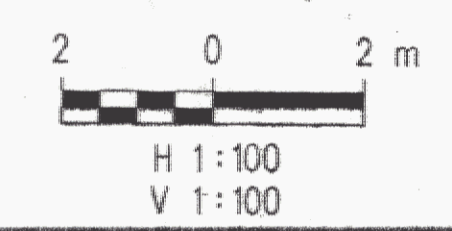

SURVEYED BY C.H.A. & V.S.E. DATE	
DRAWN BY J.S.L.	DATE
SQUAD LEADER T.P.K.	REV. 08/02
DESIGN FILE NO. N/A	
PARM FILE	DATE PLOTTED
PROJ. NAME BENNINGTON - HOOSICK	
D.P.I. 0146(1) C/3	
PROJ. NO. P.I.N. 1306.60.201	
SHEET 337 OF 473 SHEETS	

RFD