

646.402 DURABLE 4 INCH WHITE LINE, THERMOPLASTIC
(ALL LINES WILL INCLUDE C/L BREAKS FOR TOWN HIGHWAYS)
HISTORIC VT. ROUTE 7A:
STA. 187+65.00 - STA. 188+50.00 PARKING SPACES RT
STA. 188+90.00 - STA. 189+55.00 SOLID LANE LINE LT
STA. 189+15.00 - STA. 189+95.00 PARKING SPACES RT
STA. 189+50.00 - STA. 189+69.00 NO PARKING ZONE HATCHING
STA. 189+55.00 - STA. 190+80.00 DOTTED LANE LINE LT
STA. 189+95.00 - STA. 190+84.00 PARKING SPACES RT

646.602 TEMPORARY 4 INCH WHITE LINE, PAINT
(ALL LINES WILL INCLUDE C/L BREAKS FOR TOWN HIGHWAYS)

HISTORIC VT. ROUTE 7A:
STA. 187+65.00 - STA. 188+50.00 PARKING SPACES RT
STA. 188+90.00 - STA. 189+55.00 SOLID LANE LINE LT
STA. 189+15.00 - STA. 189+95.00 PARKING SPACES RT
STA. 189+50.00 - STA. 189+69.00 NO PARKING ZONE HATCHING
STA. 189+55.00 - STA. 190+80.00 DOTTED LANE LINE LT
STA. 189+95.00 - STA. 190+84.00 PARKING SPACES RT

646.412 DURABLE 4 INCH YELLOW LINE, THERMOPLASTIC
(ALL LINES WILL INCLUDE C/L BREAKS FOR TOWN HIGHWAYS)
HISTORIC VT. ROUTE 7A:
STA. 184+00.00 - STA. 188+50.00 DOUBLE SOLID MEDIAN LT/RT
STA. 188+70.72 DOUBLE SOLID RT, TH-4
STA. 188+95.00 - STA. 189+50.00 MEDIAN EDGE LINE RT
STA. 189+50.00 - STA. 190+80.00 DOUBLE SOLID MEDIAN RT
STA. 190+80.00 - STA. 191+00.00 DOUBLE SOLID C/L

646.612 TEMPORARY 4 INCH YELLOW LINE, PAINT
(ALL LINES WILL INCLUDE EDGE LINE BREAKS AND RADIUS FOR TOWN HIGHWAYS)

HISTORIC VT. ROUTE 7A:
STA. 184+00.00 - STA. 188+50.00 DOUBLE SOLID MEDIAN LT/RT
STA. 188+70.72 DOUBLE SOLID RT, TH-4
STA. 188+95.00 - STA. 189+50.00 MEDIAN EDGE LINE RT
STA. 189+50.00 - STA. 190+80.00 DOUBLE SOLID MEDIAN RT
STA. 190+80.00 - STA. 191+00.00 DOUBLE SOLID C/L

646.481 DURABLE 24 INCH STOP BAR, TYPE ITAPE

HISTORIC VT. ROUTE 7A:
STA. 188+70.72 RT, TH-4

646.682 TEMPORARY 24 INCH STOP BAR, PAINT

HISTORIC VT. ROUTE 7A:
STA. 188+70.72 RT, TH-4

646.491 DURABLE LETTER OR SYMBOL, TYPE ITAPE
HISTORIC VT. ROUTE 7A:
STA. 188+36.00 RT, HANDICAP SYMBOL (1EA)
STA. 188+70.72 RT, TH-4, "S,T,O,P" (4 EA)
STA. 189+51.00 C/L, ARROW (1EA)

646.692 TEMPORARY LETTER OR SYMBOL, PAINT

HISTORIC VT. ROUTE 7A:
STA. 188+36.00 RT, HANDICAP SYMBOL (2 EA)
STA. 188+70.72 RT, TH-4, "S,T,O,P" (8 EA)
STA. 189+51.00 C/L, ARROW (2 EA)

646.501 DURABLE CROSSWALK MARKING, TYPE ITAPE

HISTORIC VT. ROUTE 7A:
STA. 188+55.00 LT/RT
STA. 188+70.72 RT, TH-4
STA. 190+88.00 LT/RT

646.452 DURABLE 8 INCH YELLOW LINE, THERMOPLASTIC
HISTORIC VT. ROUTE 7A:
STA. 184+00.00 - STA. 188+50.00 HATCHED MEDIAN LT/RT
STA. 189+55.00 - STA. 190+80.00 HATCHED MEDIAN LT/RT

646.702 TEMPORARY CROSSWALK MARKING, PAINT


HISTORIC VT. ROUTE 7A:
STA. 188+55.00 LT/RT
STA. 188+70.72 RT, TH-4
STA. 190+88.00 LT/RT

675.50 REMOVING SIGNS

AS SHOWN - 3

675.60 ERECTING SALVAGED SIGNS

AS SHOWN - 2

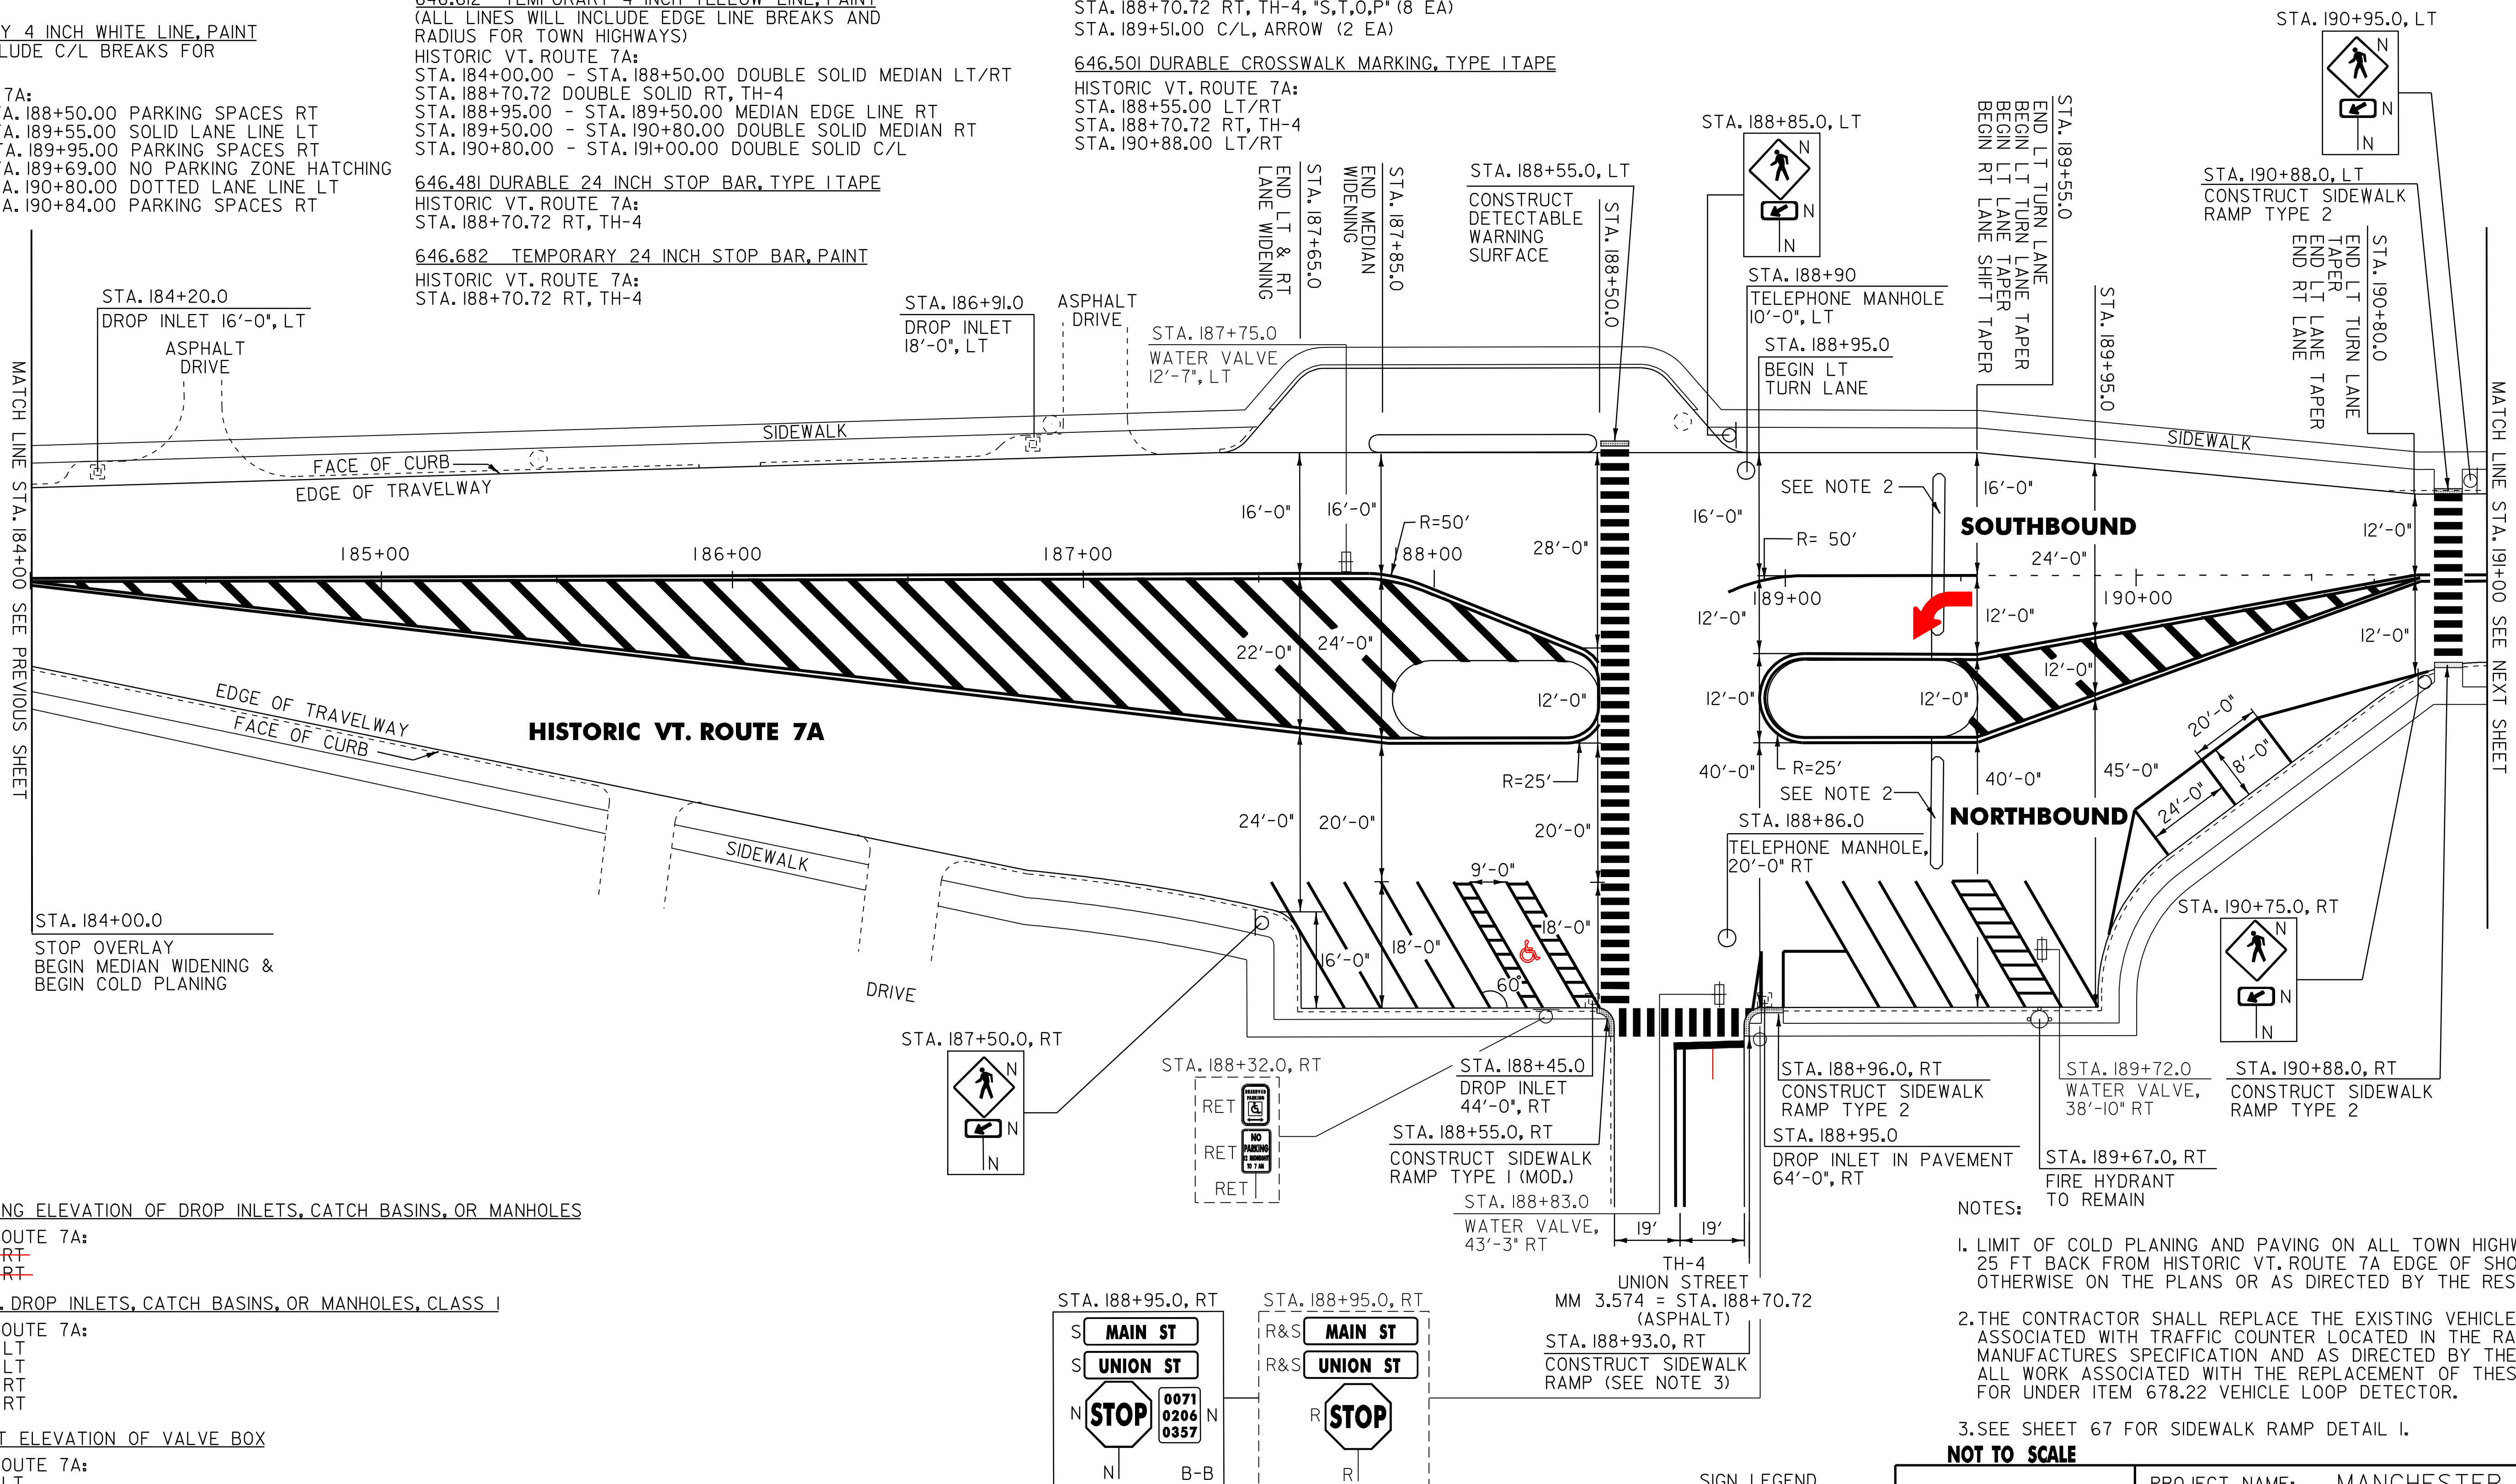

604.40 CHANGING ELEVATION OF DROP INLETS, CATCH BASINS, OR MANHOLES

HISTORIC VT. ROUTE 7A:
~~STA. 188+86.0 RT~~
~~STA. 188+90.0 RT~~

604.412 REHAB. DROP INLETS, CATCH BASINS, OR MANHOLES, CLASS I


HISTORIC VT. ROUTE 7A:
STA. 184+20.0 LT
STA. 186+91.0 LT
STA. 188+45.0 RT
STA. 188+95.0 RT

629.20 ADJUST ELEVATION OF VALVE BOX

HISTORIC VT. ROUTE 7A:
STA. 187+75.0 LT
STA. 188+83.0 RT
STA. 189+72.0 RT

678.22 VEHICLE LOOP DETECTOR

HISTORIC VT. ROUTE 7A:
STA. 187+35.0 LT/RT (100.0 LF)

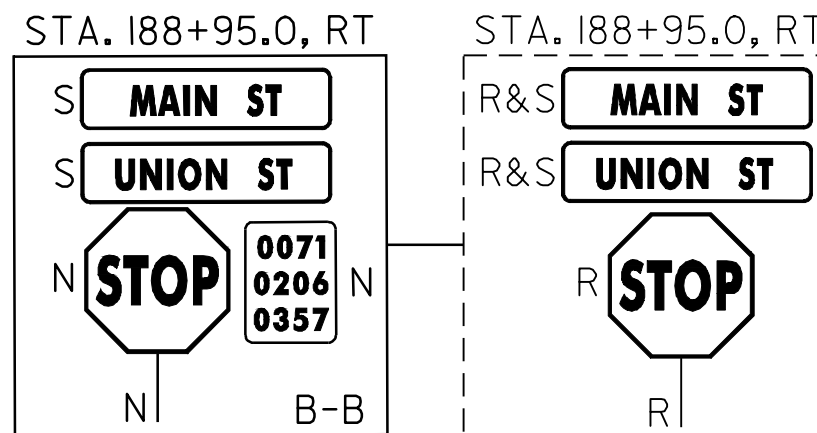

SIGN LEGEND
R = REMOVE
S = SALVAGE
N = NEW
RET = RETAIN
B-B = BACK TO BACK
EXISTING = -----
NEW = -----

NOTES:

1. LIMIT OF COLD PLANING AND PAVING ON ALL TOWN HIGHWAYS SHALL BE MEASURED 25 FT BACK FROM HISTORIC VT. ROUTE 7A EDGE OF SHOULDER UNLESS DENOTED OTHERWISE ON THE PLANS OR AS DIRECTED BY THE RESIDENT ENGINEER.

2. THE CONTRACTOR SHALL REPLACE THE EXISTING VEHICLE DETECTOR LOOPS ASSOCIATED WITH TRAFFIC COUNTER LOCATED IN THE RAISED MEDIAN PER THE MANUFACTURES SPECIFICATION AND AS DIRECTED BY THE RESIDENT ENGINEER. ALL WORK ASSOCIATED WITH THE REPLACEMENT OF THESE LOOPS SHALL BE PAID FOR UNDER ITEM 678.22 VEHICLE LOOP DETECTOR.

3. SEE SHEET 67 FOR SIDEWALK RAMP DETAIL I.

NOT TO SCALE

PROJECT
LAYOUT
SHEET #9

PROJECT NAME: MANCHESTER
PROJECT NUMBER: STP 2203(I)S

FILE NAME: p99cl58.dgn
PROJECT LEADER: D.E.G.
DESIGNED BY: M.J.M.
IPARM FILE: p99cl58109.i

PLOT DATE: 09-MAY-2008
DRAWN BY: C.A.K.
CHECKED BY: D.W.E.
SHEET 23 OF 68