

646.412 DURABLE 4 INCH YELLOW LINE, THERMOPLASTIC
(ALL LINES WILL INCLUDE C/L BREAKS FOR TOWN HIGHWAYS)
HISTORIC VT. ROUTE 7A:
STA. 227+00.00 - STA. 234+00.00 DOUBLE SOLID C/L
STA. 232+16.16 DOUBLE SOLID LT, WAYS LANE
STA. 232+16.16 DOUBLE SOLID LT, WAYS LANE

646.481 DURABLE 24 INCH STOP BAR, TYPE ITAPE
HISTORIC VT. ROUTE 7A:
STA. 232+16.16 LT, WAYS LANE
STA. 232+16.16 LT, WAYS LANE

646.491 DURABLE LETTER OR SYMBOL, TYPE ITAPE
HISTORIC VT. ROUTE 7A:
STA. 232+16.16 LT, WAYS LANE, "S,T,O,P" (4 EA)
STA. 232+16.16 LT, WAYS LANE, YIELD LINE (4 EA)
STA. 232+16.16 LT, WAYS LANE, "S,T,O,P" (4 EA)


646.612 TEMPORARY 4 INCH YELLOW LINE, PAINT
(ALL LINES WILL INCLUDE EDGE LINE BREAKS AND RADIUS FOR TOWN HIGHWAYS)
HISTORIC VT. ROUTE 7A:
STA. 231+00.00 - STA. 234+00.00 DOUBLE SOLID C/L
STA. 232+16.16 DOUBLE SOLID LT, WAYS LANE
STA. 232+16.16 DOUBLE SOLID LT, WAYS LANE

646.682 TEMPORARY 24 INCH STOP BAR, PAINT
HISTORIC VT. ROUTE 7A:
STA. 232+16.16 LT, WAYS LANE
STA. 232+16.16 LT, WAYS LANE

646.692 TEMPORARY LETTER OR SYMBOL, PAINT
HISTORIC VT. ROUTE 7A:
STA. 232+16.16 LT, WAYS LANE, "S,T,O,P" (8 EA)
STA. 232+16.16 LT, WAYS LANE, YIELD LINE (8 EA)
STA. 232+16.16 LT, WAYS LANE, "S,T,O,P" (8 EA)

646.501 DURABLE CROSSWALK MARKING, TYPE ITAPE
HISTORIC VT. ROUTE 7A:
STA. 230+57.76 RT, LONG VIEW DRIVE
STA. 231+31.00 LT/RT

675.50 REMOVING SIGNS
AS SHOWN - 8
675.60 ERECTING SALVAGED SIGNS
AS SHOWN - 4

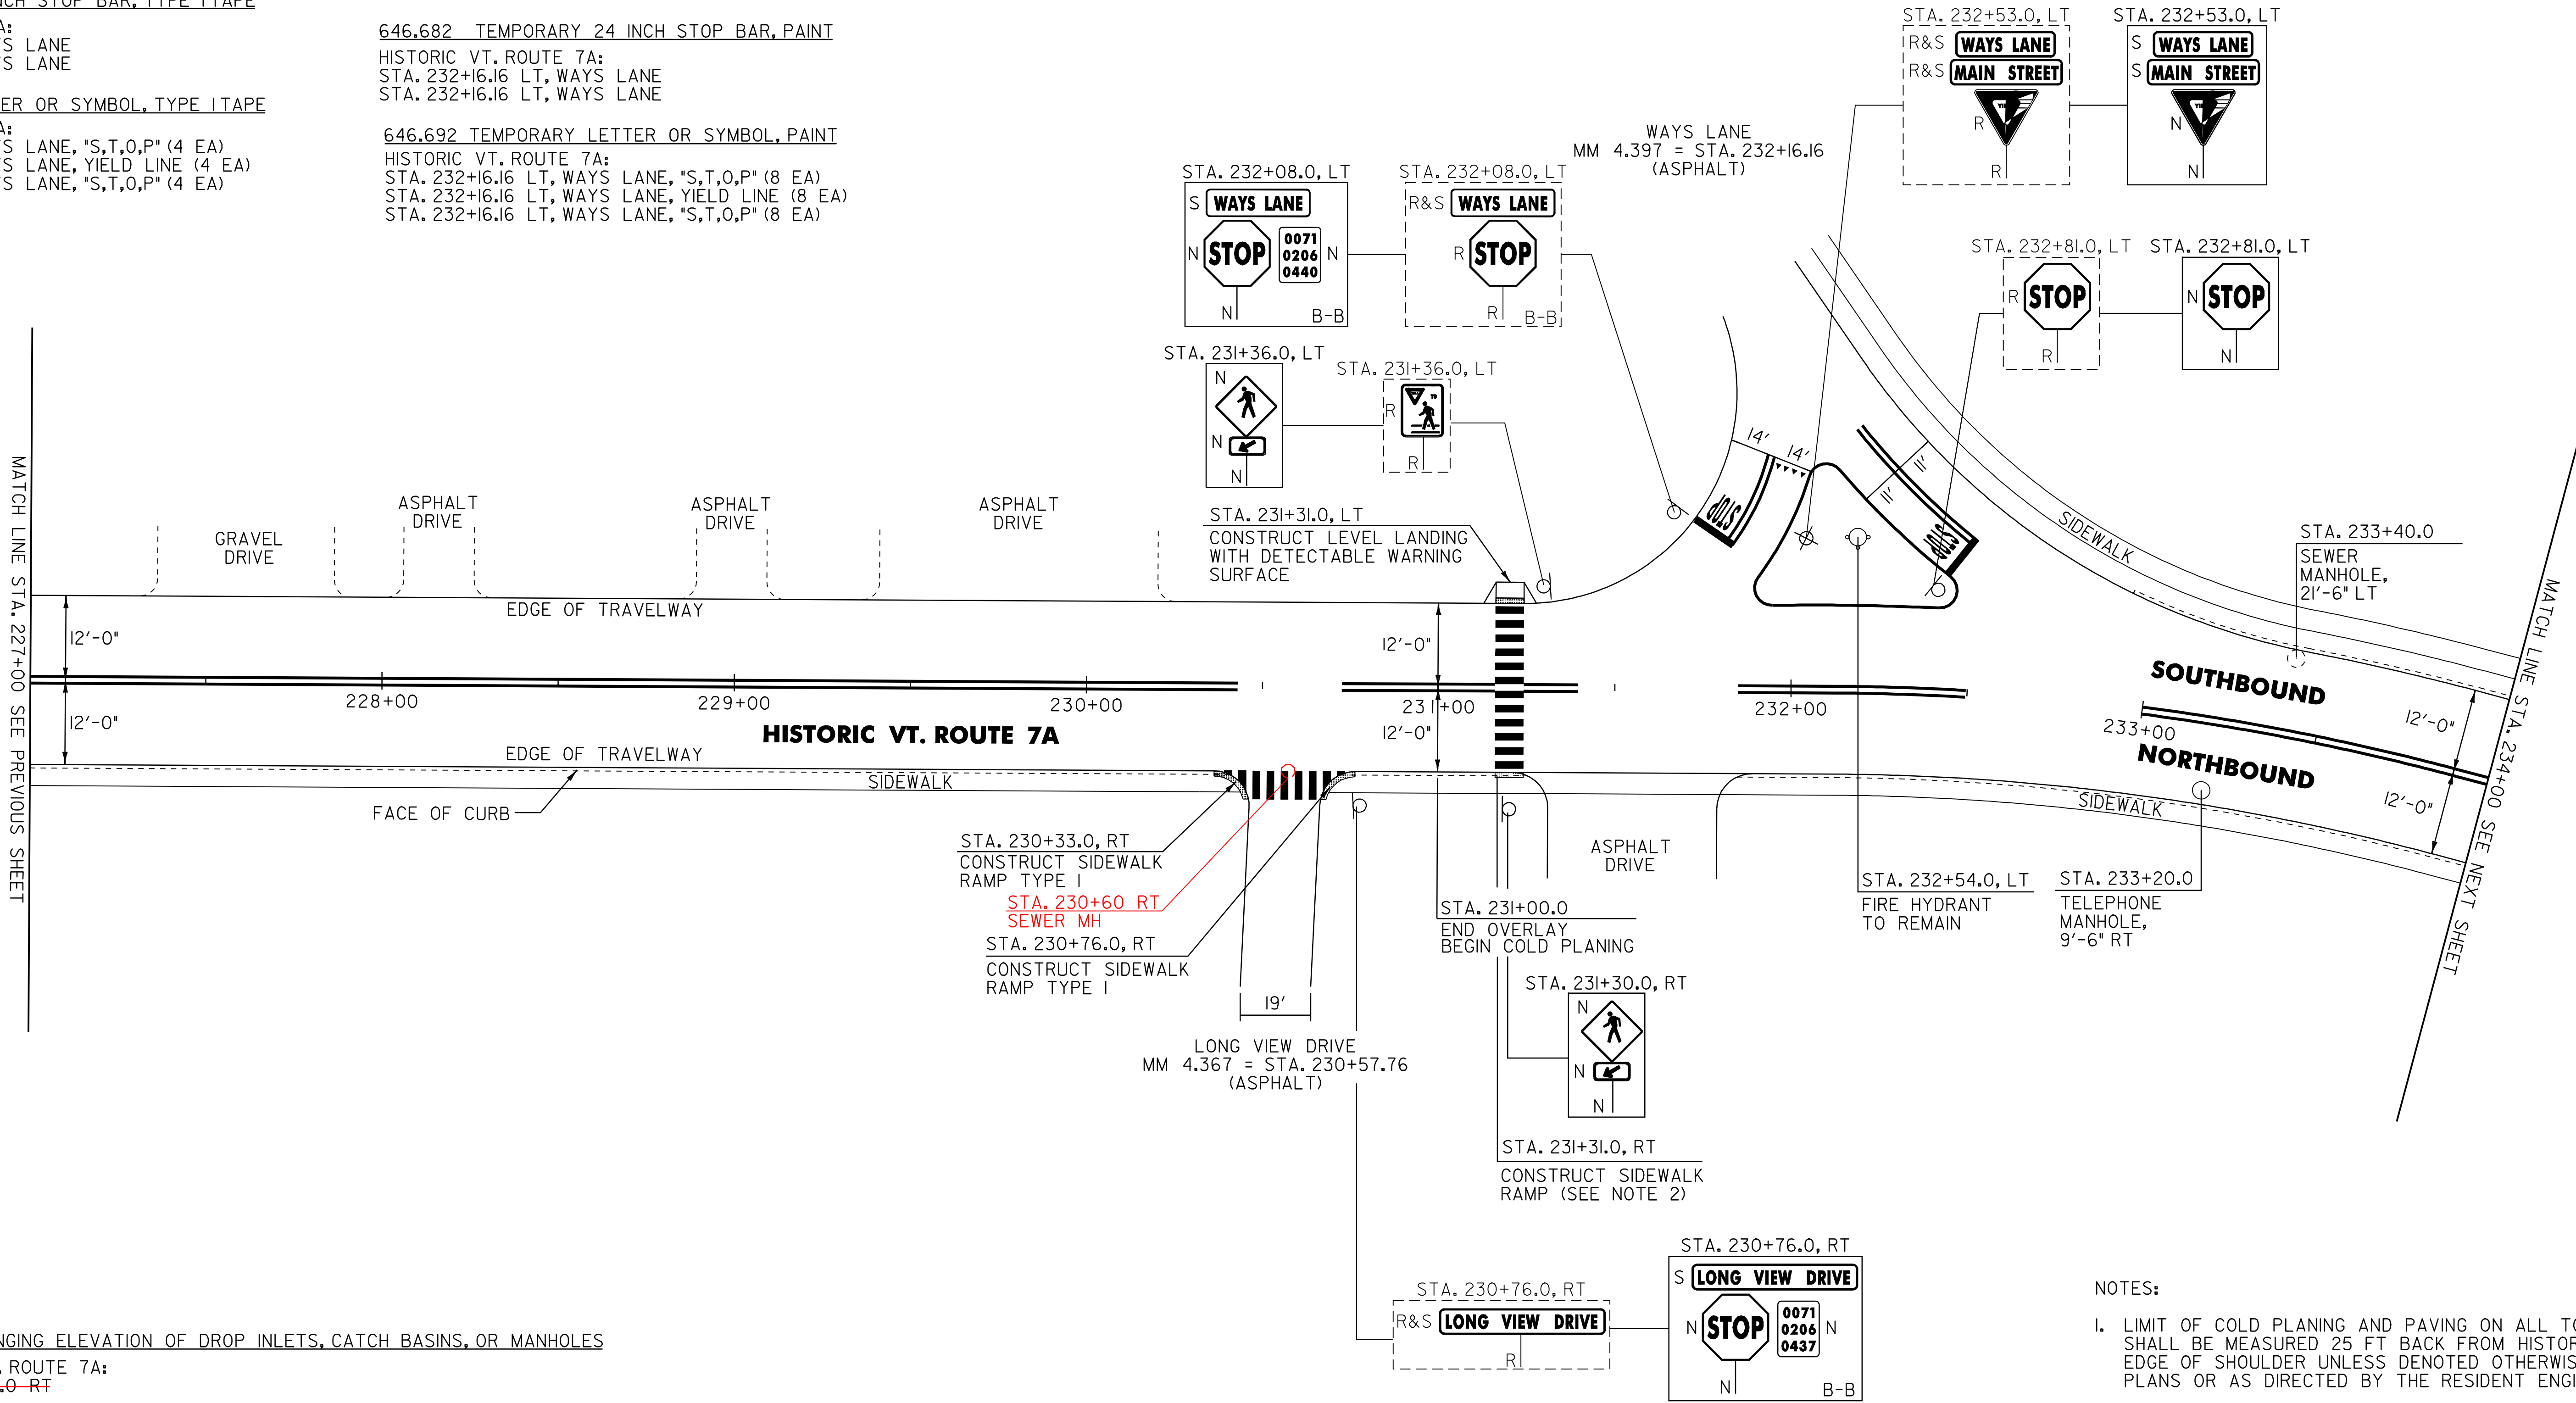

604.40 CHANGING ELEVATION OF DROP INLETS, CATCH BASINS, OR MANHOLES
HISTORIC VT. ROUTE 7A:
~~STA. 233+20.0 RT~~

604.42 CHANGING ELEVATION OF SEWER MANHOLES
HISTORIC VT. ROUTE 7A:
~~STA. 233+40.0 LT~~
~~230+60.0 RT~~
900.680 SPECIAL PROVISION, (BITUMINOUS CONCRETE PAVEMENT SURFACE PREPARATION) (PG 64-28)
HISTORIC VT. ROUTE 7A:
STA. 227+00 - 231+00 LT/RT

SIGN LEGEND
R = REMOVE
S = SALVAGE
N = NEW
RET = RETAIN
B-B = BACK TO BACK
EXISTING = -----
NEW = _____

- NOTES:
- LIMIT OF COLD PLANING AND PAVING ON ALL TOWN HIGHWAYS SHALL BE MEASURED 25 FT BACK FROM HISTORIC VT. ROUTE 7A EDGE OF SHOULDER UNLESS DENOTED OTHERWISE ON THE PLANS OR AS DIRECTED BY THE RESIDENT ENGINEER.
 - SEE SHEET 67 FOR SIDEWALK RAMP DETAIL 2.

NOT TO SCALE	
PROJECT LAYOUT SHEET #15	
PROJECT NAME: MANCHESTER PROJECT NUMBER: STP 2203(I)S	FILE NAME: p99c158.dgn PROJECT LEADER: D.E.G. DESIGNED BY: M.J.M. IPARM FILE: p99c158115.1
PLOT DATE: 09-MAY-2008 DRAWN BY: C.A.K. CHECKED BY: D.W.E. SHEET 29 OF 68	