

TEMPORARY 4" WHITE LINE, PAINT
DURABLE 4" WHITE LINE, THERMOPLASTIC
STA H 29+00 TO H 34+50 SOLID LT & RT

REMOVAL & DISPOSAL OF GUARDRAIL
33+98.5 - 34+36 LT

TEMPORARY 4" YELLOW LINE, PAINT
DURABLE 4" YELLOW LINE, THERMOPLASTIC
STA H 29+00 TO H 34+50 SOLID LT & RT

TEMPORARY LETTER OR SYMBOL, PAINT
DURABLE LETTER OR SYMBOL, THERMOPLASTIC
STA H 30+80 RT - "STOP"
STA H 31+20 RT - "AHEAD"

STEEL BEAM GUARDRAIL, GALV.
STA 34+23.5 - 34+36 LT

MANUFACTURED TERMINAL SECTION, FLARED
33+86 LT


SHOULDER BERM REMOVAL
STA H 29+55 TO H 34+50 RT
STA H 34+06 TO H 34+50 LT

~~STONE FILL, TYPE I~~
~~STA H 29+53 RT~~
~~STA H 32+30 RT~~

STONE FILL, TYPE II
STA H 32+70 TO H 33+04 RT (25' WIDE)

REMOVING SIGNS
AS SHOWN - 1

ERECTING SALVAGED SIGNS
AS SHOWN - 1

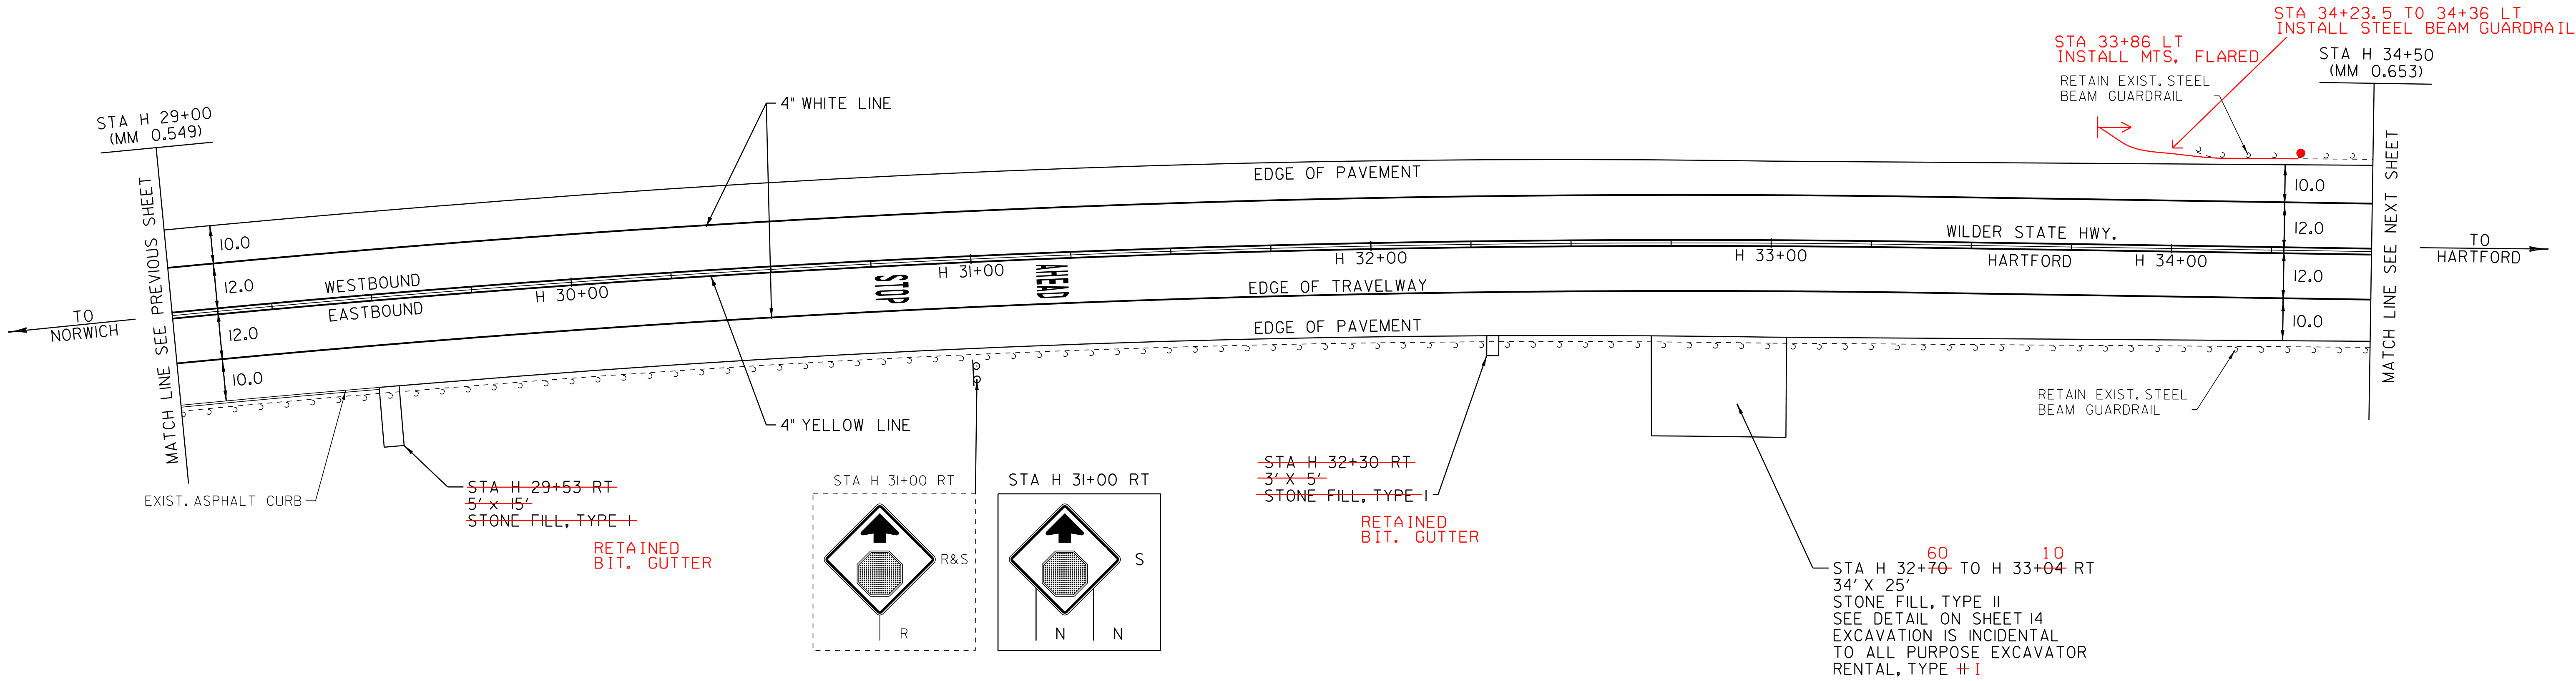

LEGEND

- R = REMOVE EXISTING
- S = SALVAGE
- R&S = REMOVE AND SALVAGE
- N = NEW
- RET = RETAIN
- B-B = BACK TO BACK
- EXISTING GUARDRAIL
- PROPOSED GUARDRAIL
- TYPE I DELINEATOR, WHITE

PAVING
LAYOUT
SHEET 7

PROJECT NAME: HARTFORD-NORWICH
PROJECT NUMBER: STP 2206(1)S

FILE NAME: /pave/99ci64/pcl64
PROJECT LEADER: PTS
DESIGNED BY: NLL
IPARM FILE NAME: pcl64la07.i

PLOT DATE: 14-FEB-2012 15:50
DRAWN BY: MRS
CHECKED BY: NLL
SHEET 31 OF 137

NOT TO SCALE