


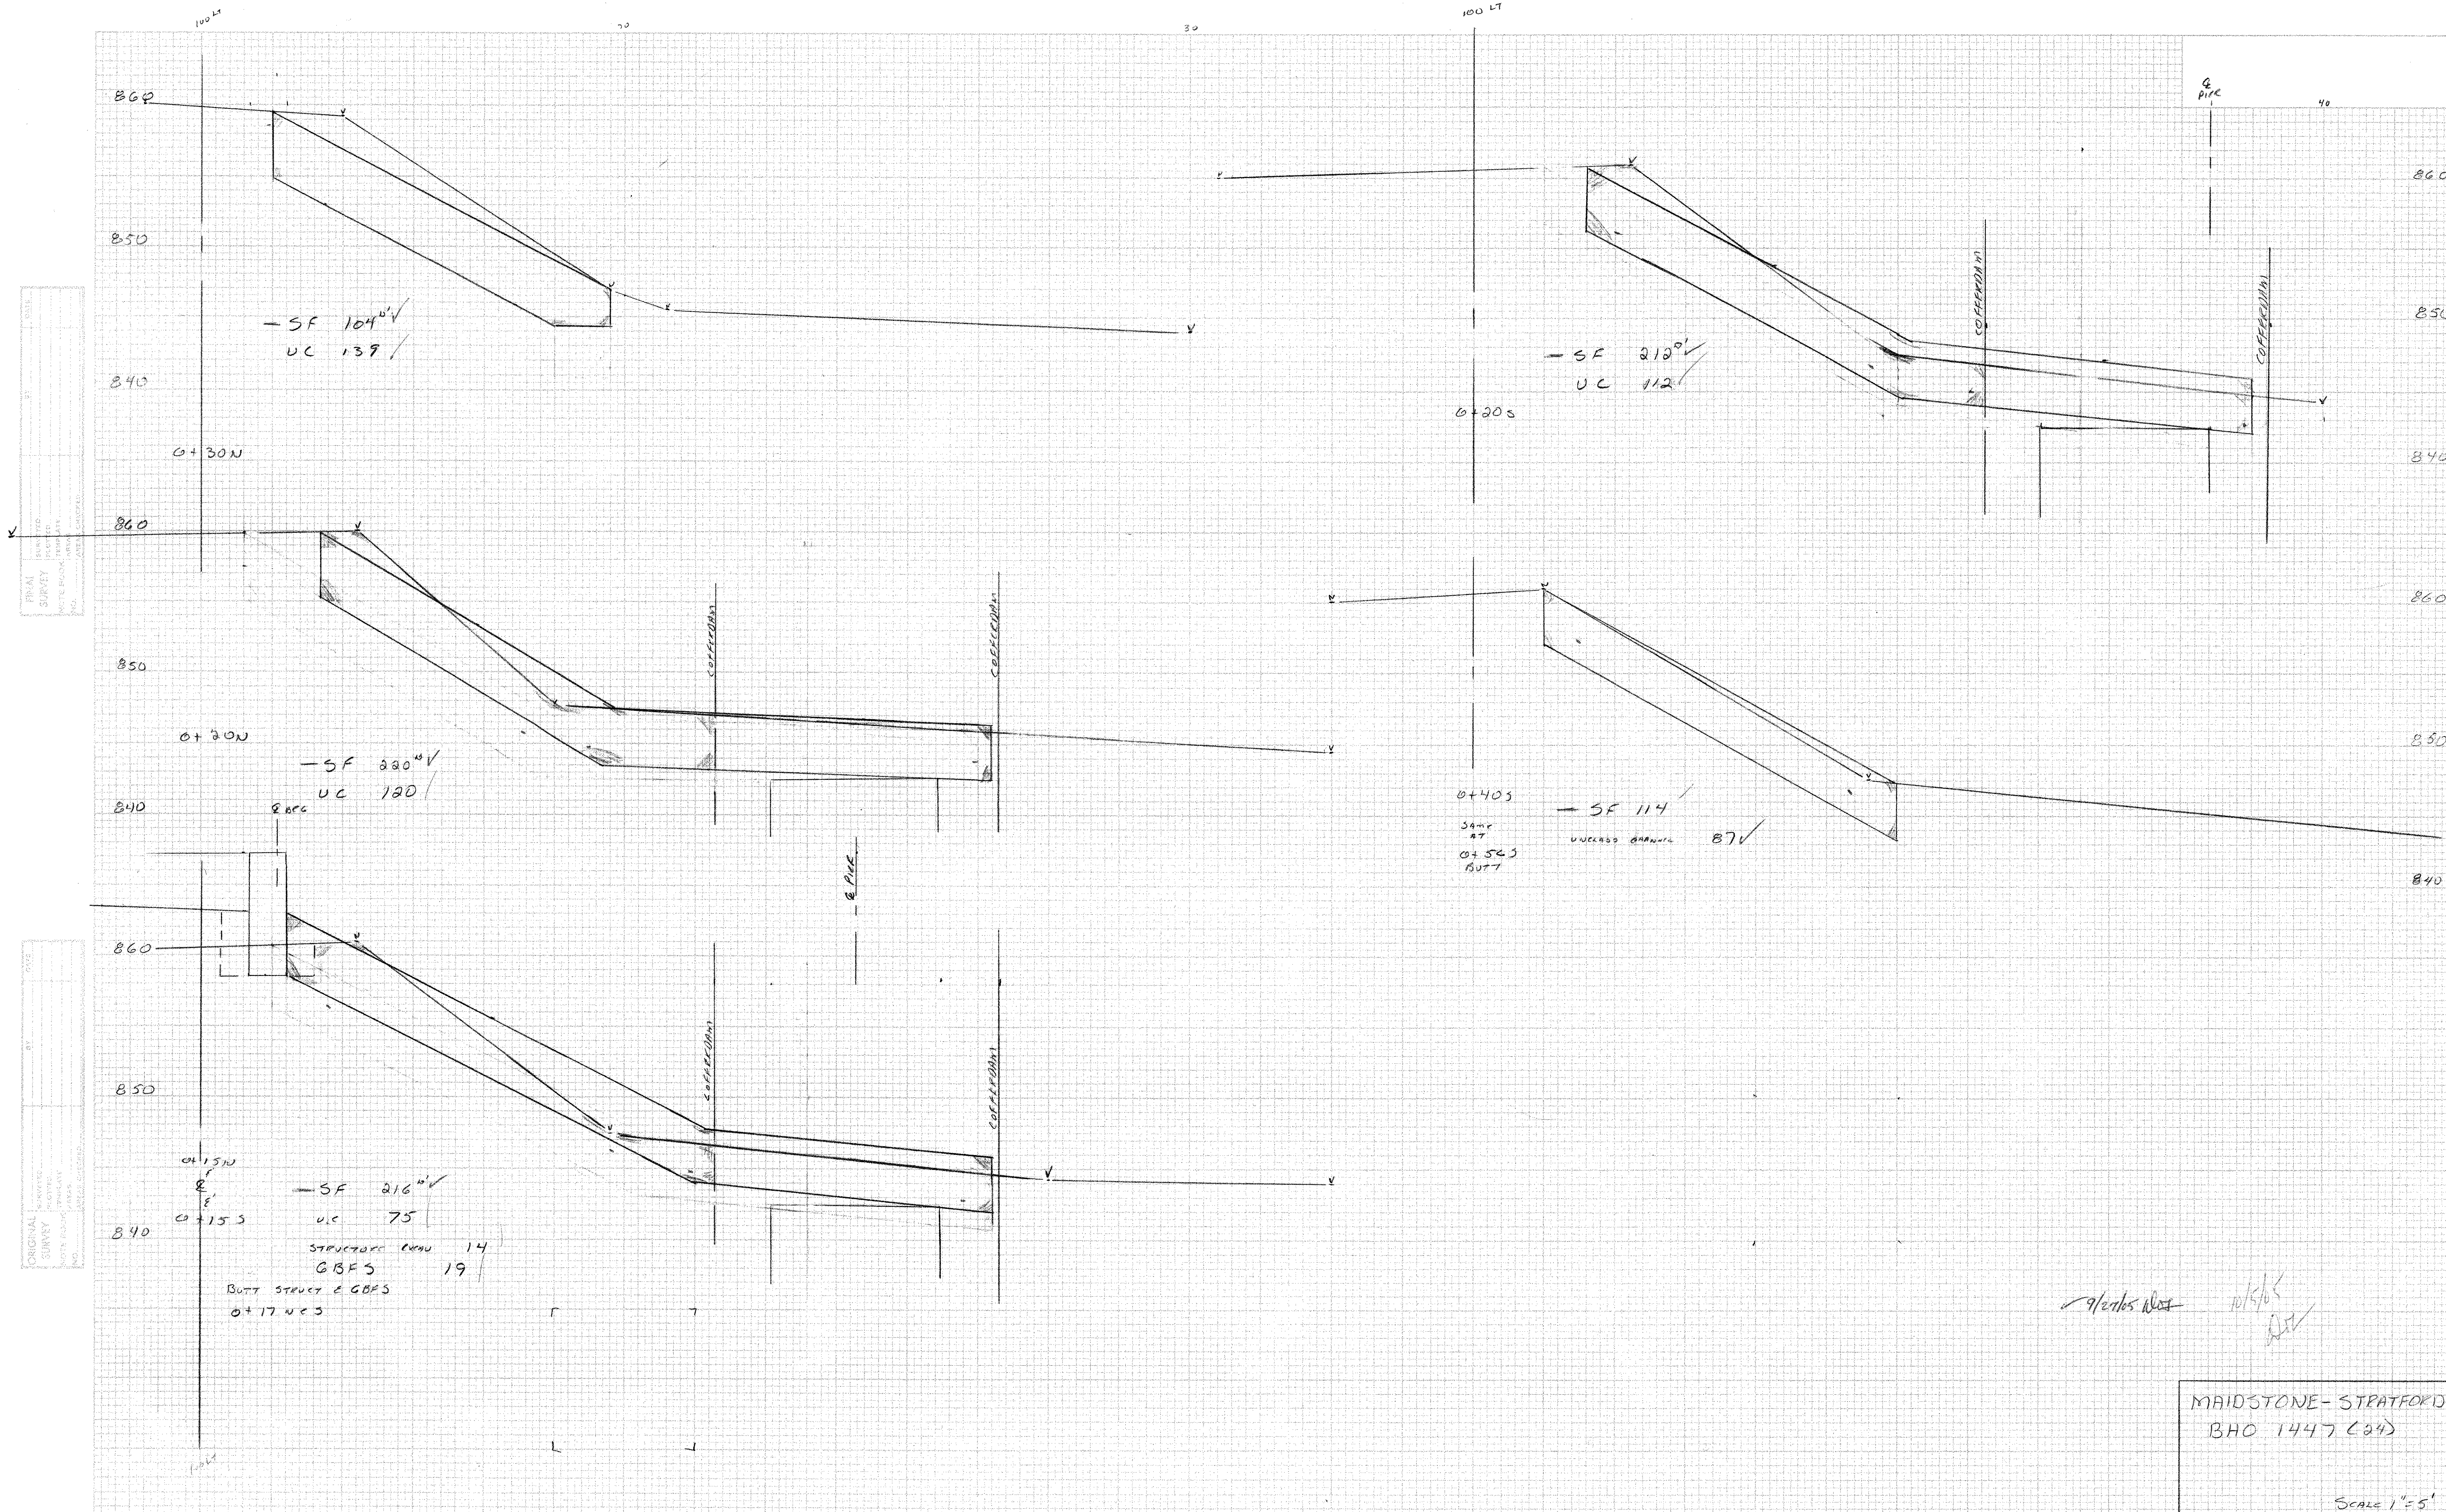

ORIGINAL SURVEY
 DATE: 10/15/65
 BY: [Signature]
 PROJECT: MAIDSTONE-STRATFORD
 SHEET: 1447 (24)

ORIGINAL SURVEY
 DATE: 10/15/65
 BY: [Signature]
 PROJECT: MAIDSTONE-STRATFORD
 SHEET: 1447 (24)

9/21/65 [Signature]
 10/15/65 [Signature]

MAIDSTONE-STRATFORD
 BHO 1447 (24)

SCALE 1"=5'