


STATE OF VERMONT
AGENCY OF TRANSPORTATION


PROPOSED IMPROVEMENT
TOWN OF FERRISBURGH
COUNTY OF ADDISON
COMMUTER PARK-AND-RIDE LOT

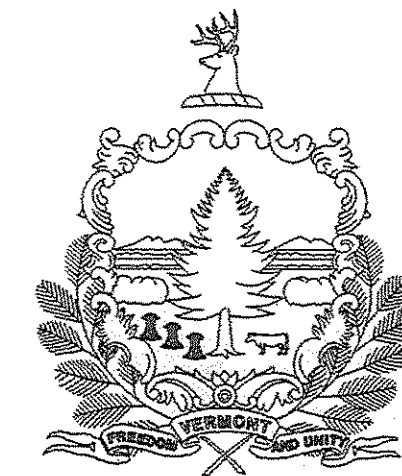

RECORD PLANS


CONTRACTOR: J.A. McDONALD - LYNDON, CTR., VT.
RESIDENT ENGINEER: DALE NORTON
CONSTRUCTION BEGAN: AUGUST 4, 2008
CONSTRUCTION COMPLETE: OCTOBER 7, 2008
RECORD PLANS BY: DALE NORTON, N. GARBACIK
I HEREBY CERTIFY THAT ALL THE CONSTRUCTION REQUIRED BY THIS SET OF DRAWINGS HAS BEEN ACCOMPLISHED AS INDICATED HEREIN.
BY Dale R. Norton RESIDENT ENGINEER
DATE 07 Oct 2009

NOTE: Any further information concerning final quantities, amounts or other details relative to this project may be found at Central Files in the electronic archives.

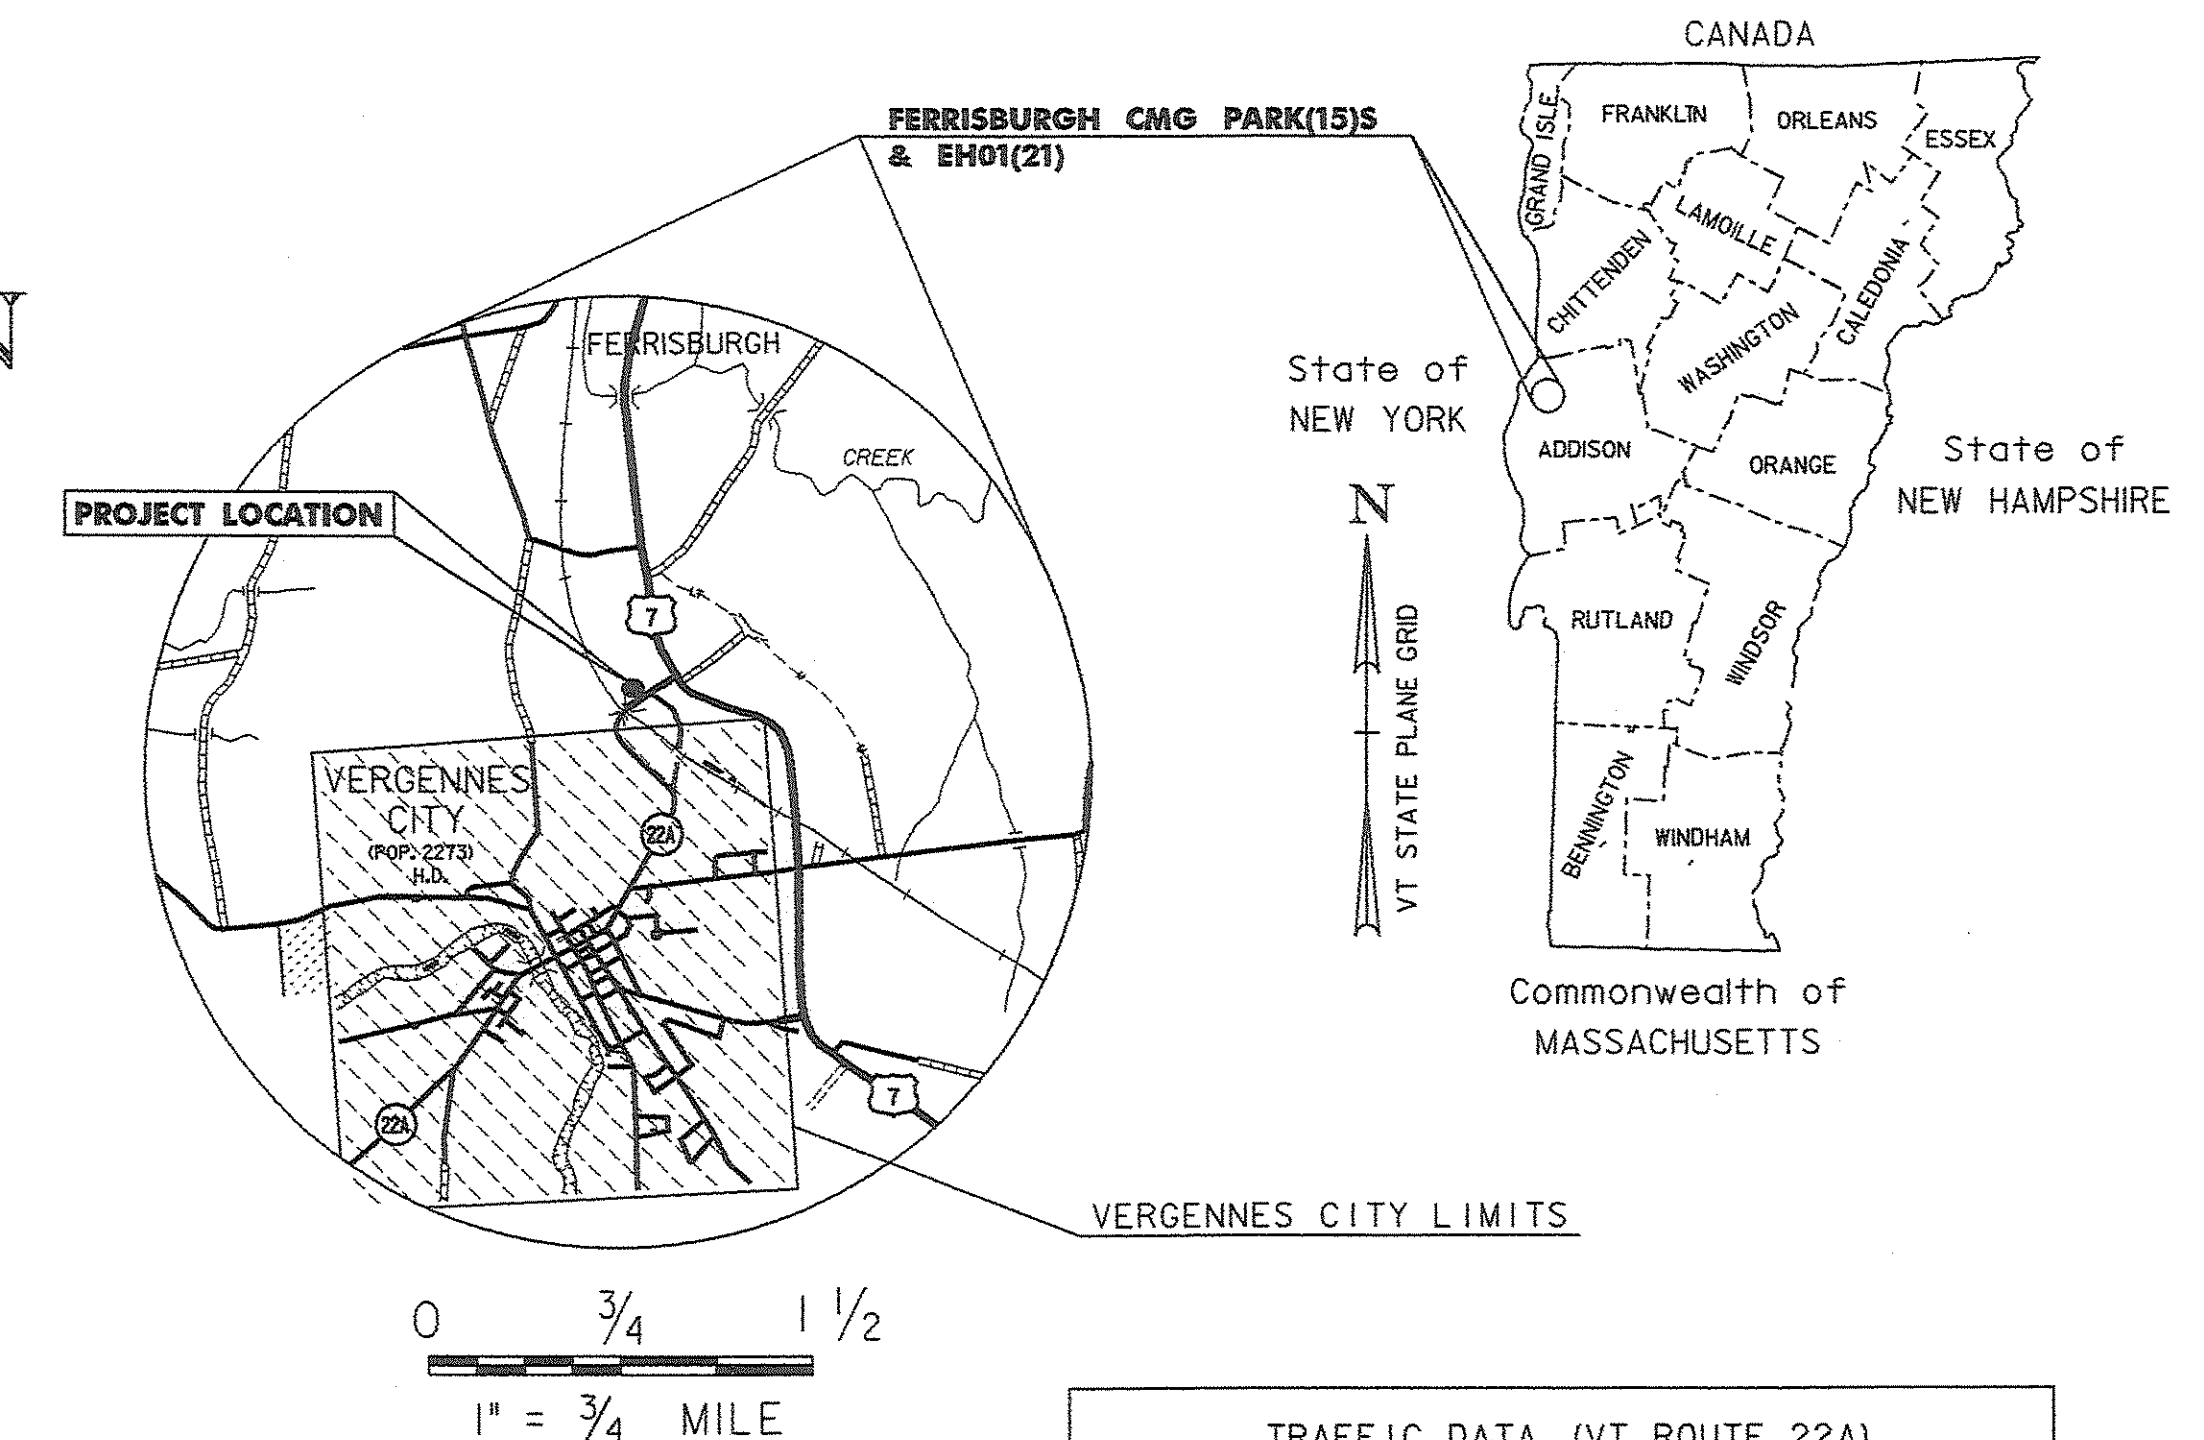

FUTURE RELOCATION
OF RAILROAD STATION
(C. 1855)

THIS PROJECT IS LOCATED ON VT ROUTE 22A IN THE TOWN OF FERRISBURGH, APPROXIMATELY 950' SOUTHWEST OF THE U.S. ROUTE 7 AND VT ROUTE 22A INTERSECTION, ON THE NORTHERLY SIDE OF VT ROUTE 22A. WORK TO BE PERFORMED UNDER THIS PROJECT INCLUDES THE CONSTRUCTION OF A NEW PARK-AND-RIDE LOT, INSTALLATION OF ELECTRIC & WATER SERVICE FOR THE FUTURE RELOCATION OF THE HISTORIC VERGENNES RAILROAD STATION, AND REMOVAL OF OLD U.S. ROUTE 7 ASPHALT PAVEMENT.

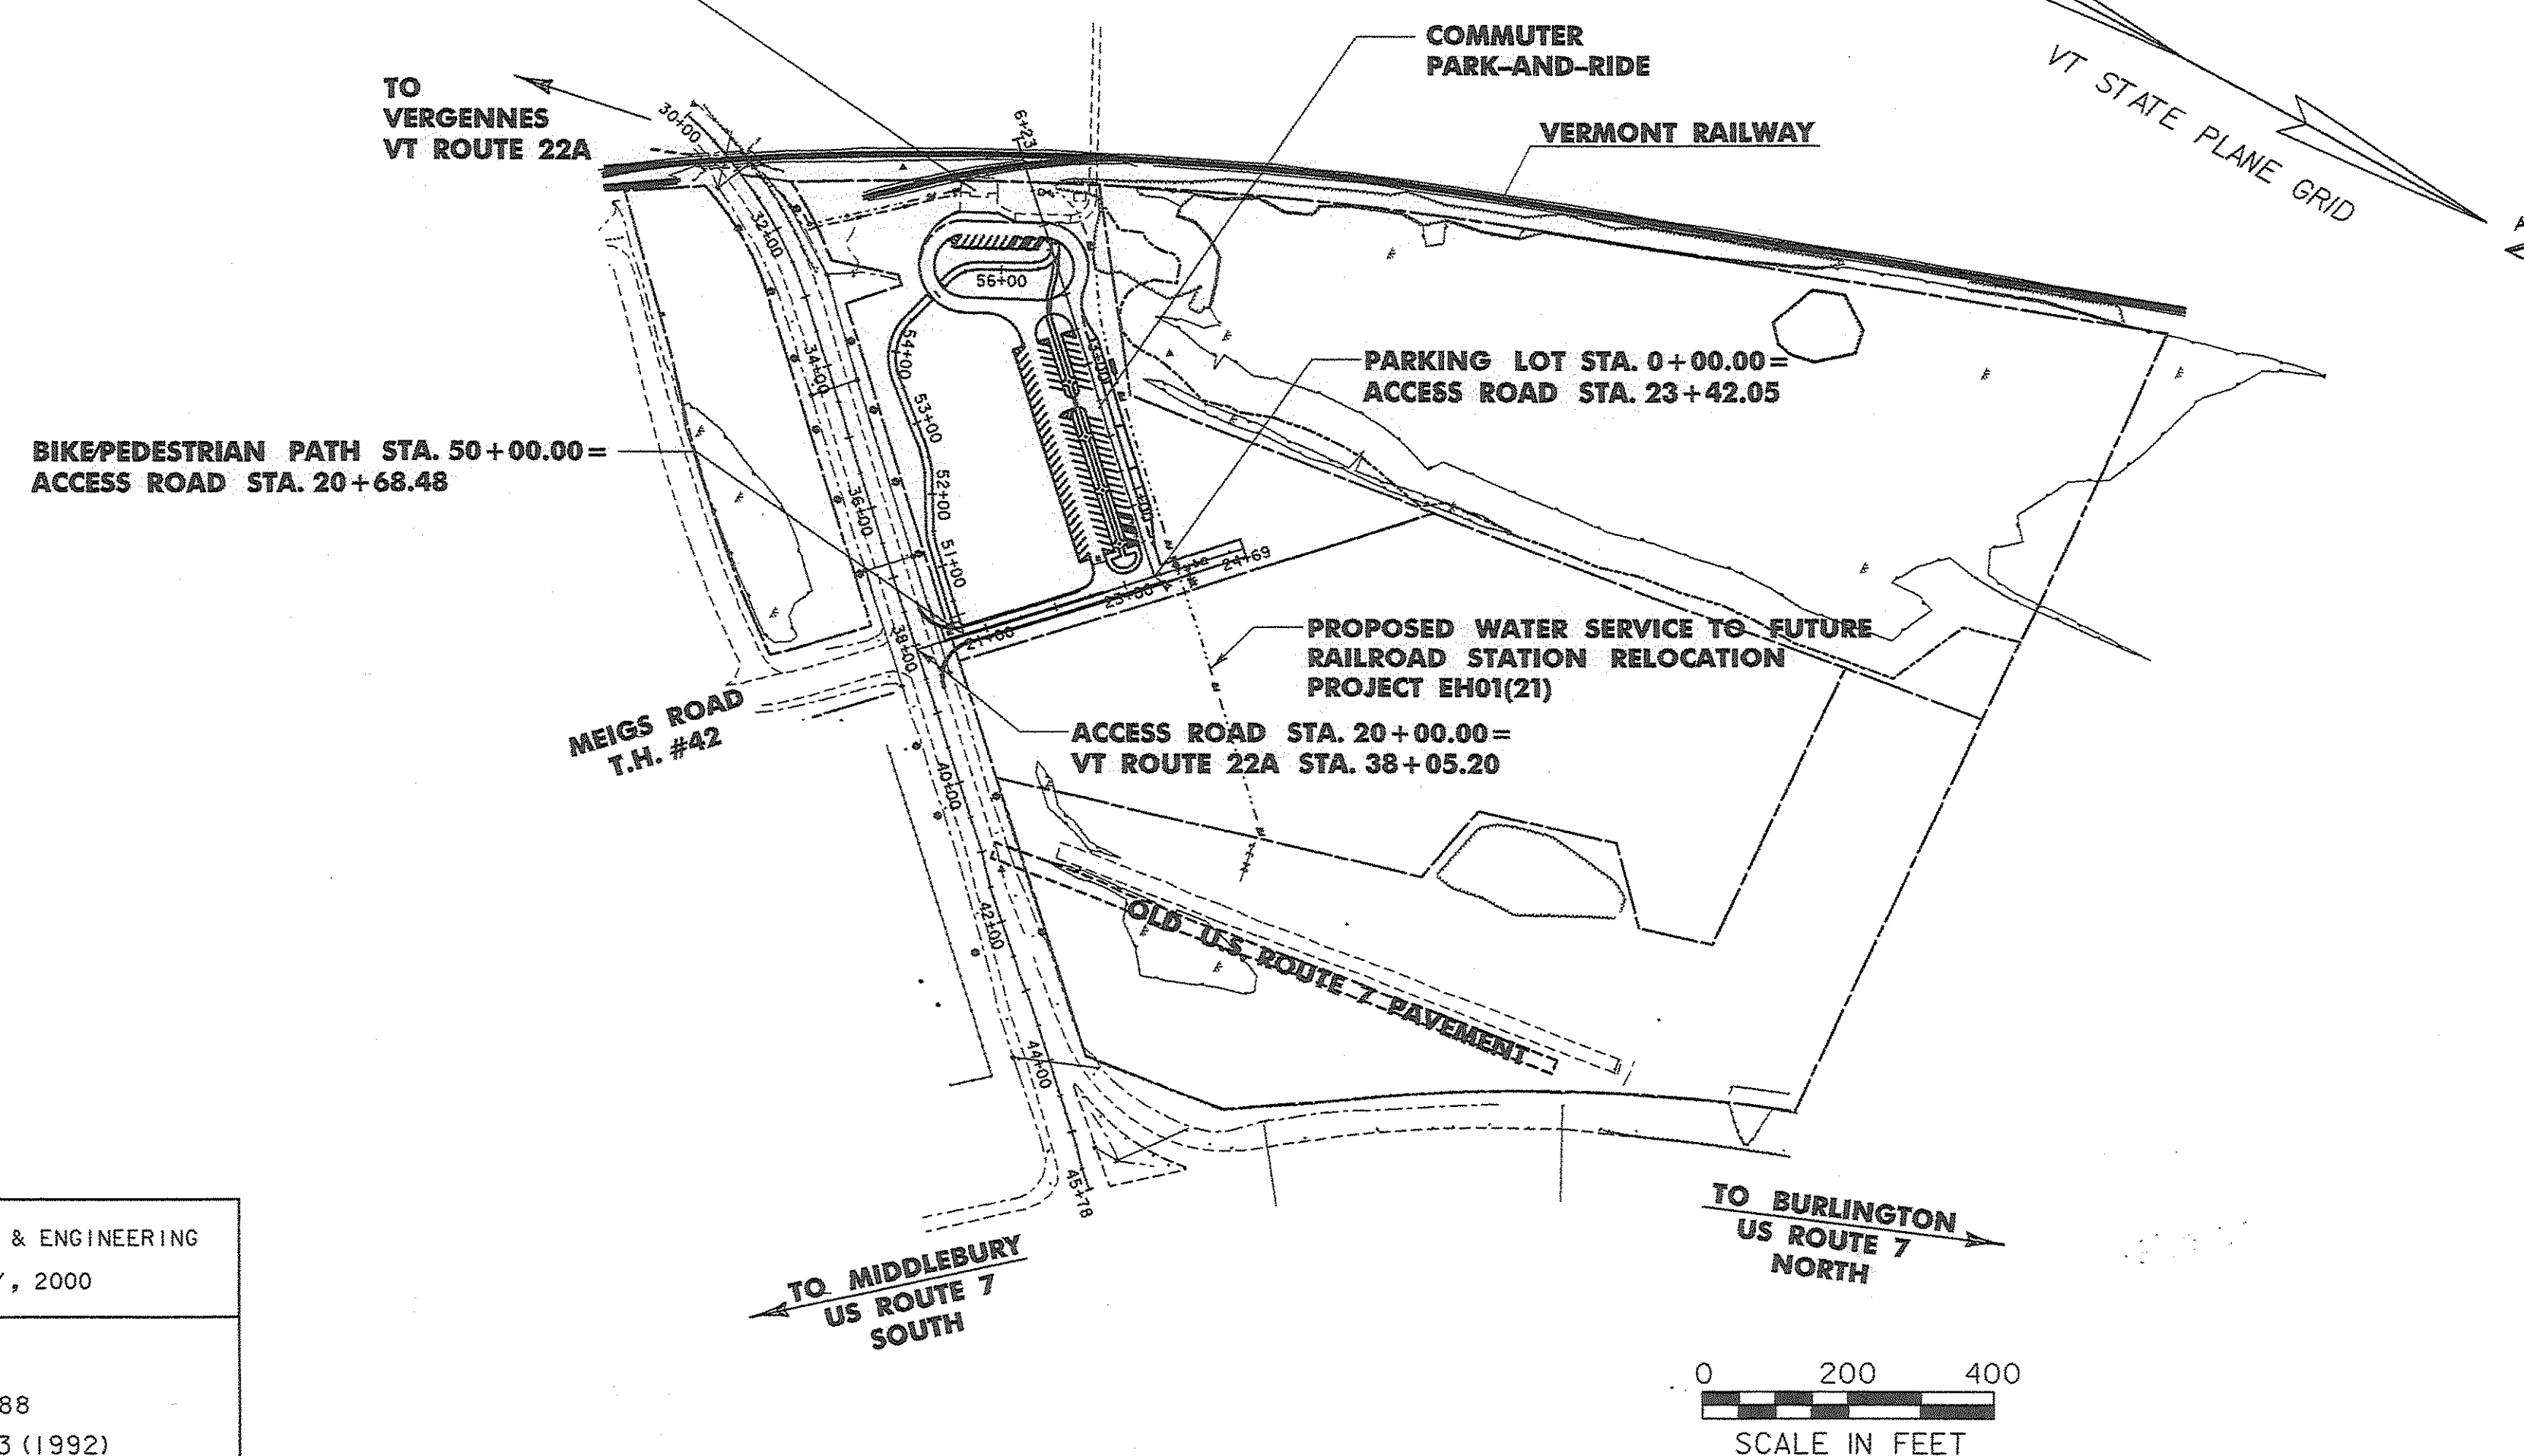

TRAFFIC DATA (VT ROUTE 22A)		
	2002	2022
ADT	6800	9000
DHV	870	1100
ADTT	670	810
%T	6	6
%D	55	55
ESALS (2002-2022) = 6,988,000		
ESALS (2002-2042) = 17,572,000		
DESIGN SPEED (VT ROUTE 22A) = 30 MPH		
POSTED SPEED (VT ROUTE 22A) = 30 MPH		

CONVENTIONAL SYMBOLS

COUNTY LINE	
TOWN LINE	
LIMITS OF ACCESS	
POINT OF ACCESS	
FENCE LINE	
STONE WALL	
TRAVELED WAY	
GUARD RAIL	
RAILROAD	
SURVEY LINE	
CULVERT	
POWER POLE	
TELEPHONE POLE	
TREES	
CONTROL OF ACCESS	
PROPERTY LINE	
R.O.W. TAKING LINE	
SLOPE RIGHTS	
TOP OF CUT	
TOE OF SLOPE	

SURVEYED BY : VT SURVEY & ENGINEERING
SURVEYED DATE : MAY, 2000

DATUM
VERTICAL NAVD88
HORIZONTAL NAD83 (1992)

THESE PLANS ARE SUBJECT TO SUCH ENGINEERING CHANGES AS MAY BE REQUIRED BY THE FEDERAL HIGHWAY ADMINISTRATION OR THE DIRECTOR OF PROGRAM DEVELOPMENT.

CONSTRUCTION IS TO BE CARRIED ON IN ACCORDANCE WITH THESE PLANS AND THE STANDARD SPECIFICATIONS FOR CONSTRUCTION DATED 2001, AS APPROVED BY THE FEDERAL HIGHWAY ADMINISTRATION ON JANUARY 4, 2001 FOR USE ON THIS PROJECT, INCLUDING ALL SUBSEQUENT REVISIONS AND SUCH REVISED SPECIFICATIONS AND SPECIAL PROVISIONS AS ARE INCORPORATED IN THESE PLANS.

DEPARTMENT OF TRANSPORTATION
FEDERAL HIGHWAY ADMINISTRATOR

APPROVED _____ DATE _____


DIRECTOR OF PROGRAM DEVELOPMENT

APPROVED David C. Davis DATE 4/20/06

PROJECT MANAGER : WAYNE L. DAVIS

PROJECT NAME : FERRISBURGH/VERGS-FERRISBURGH
PROJECT NUMBER : CMG PARK (15) S
STP EH01 (21)

SHEET 1 OF 65 SHEETS

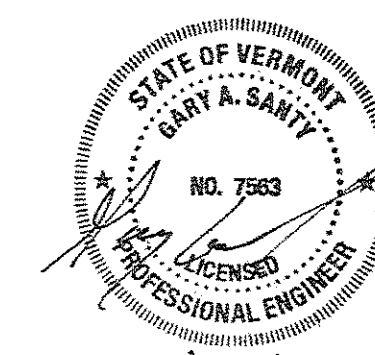

4/19/2006

DH Dufresne-Henry