



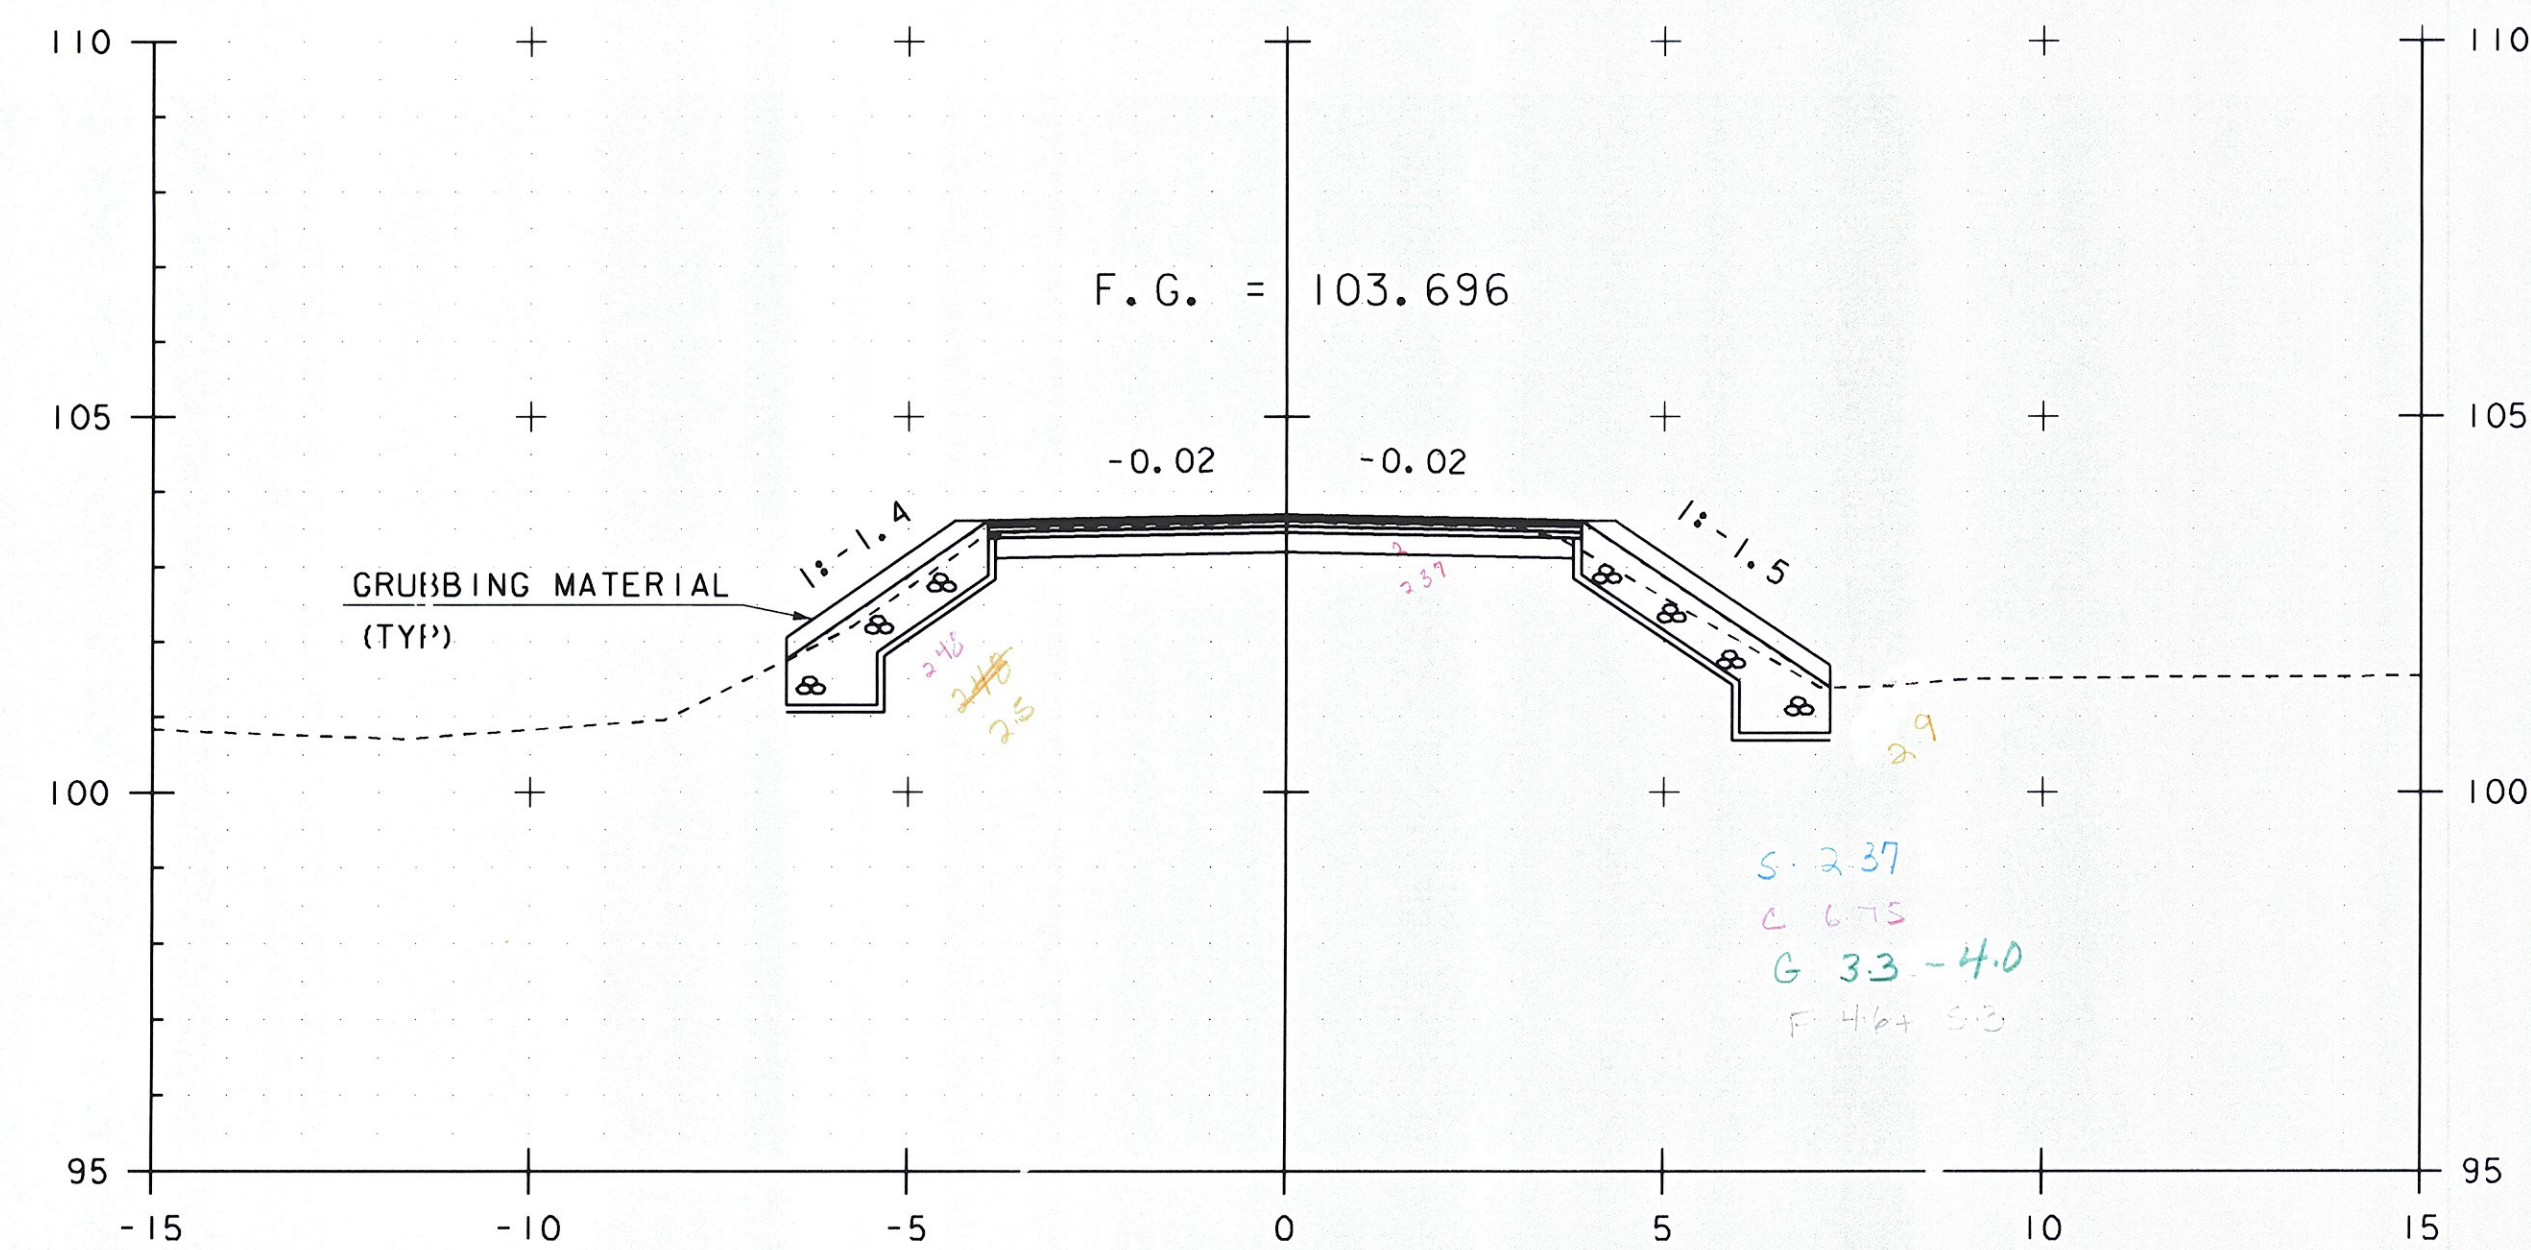


1+160.00

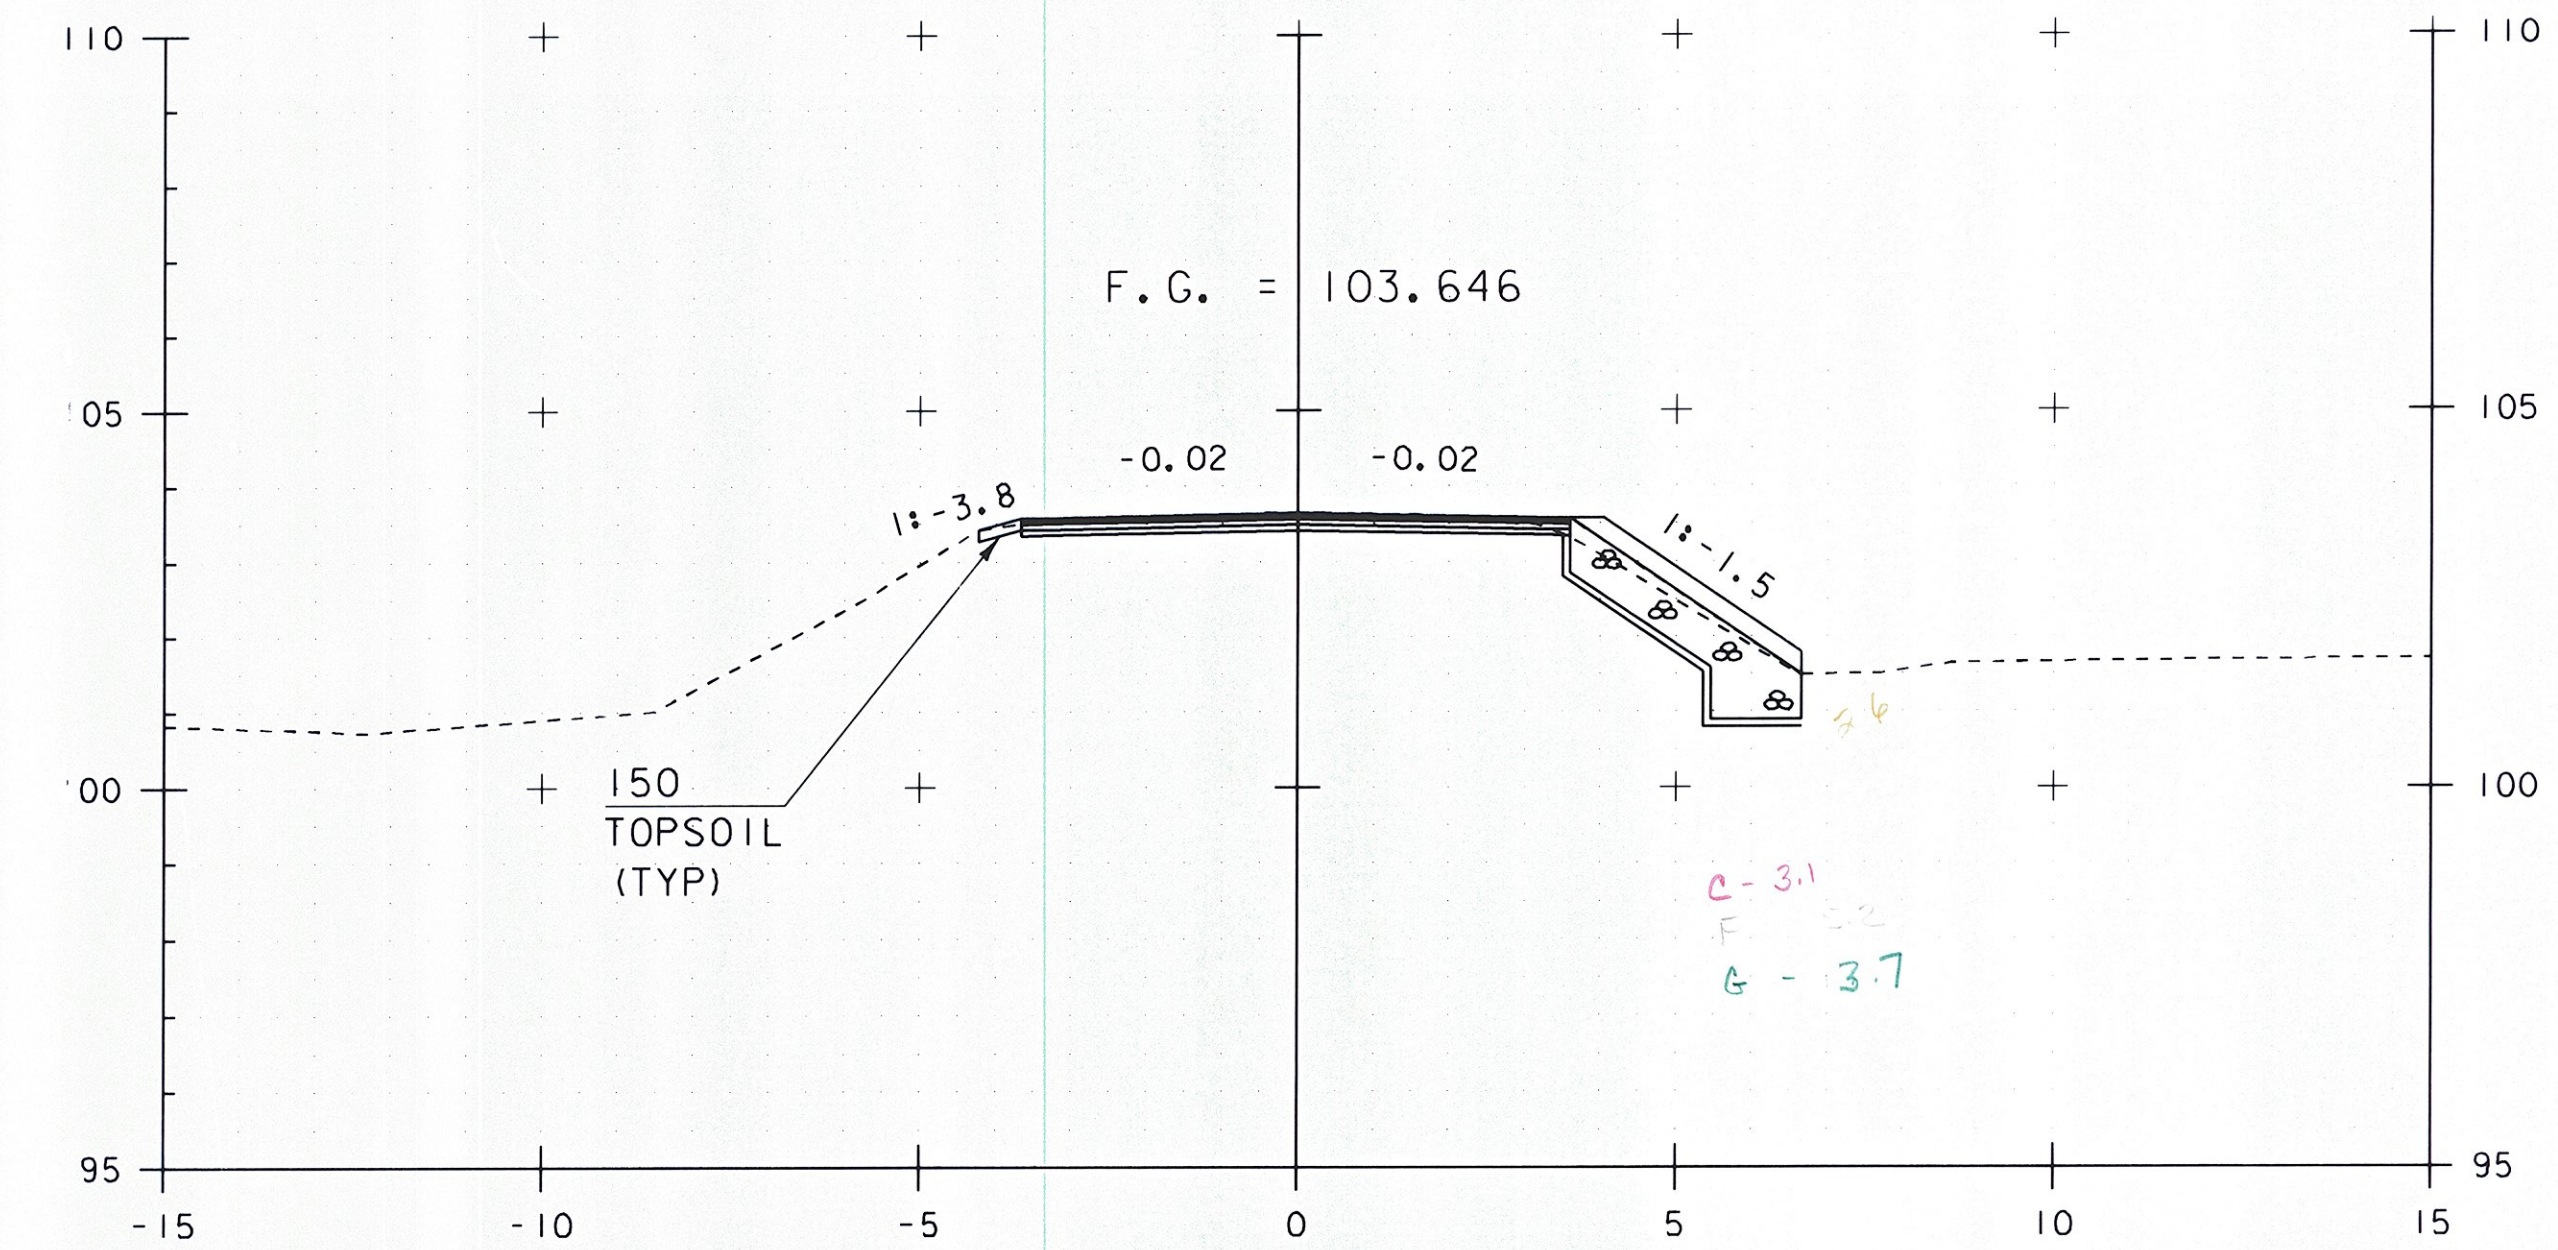


STA. 1+170.000
END STONE FILL, TYPE II (LT)
GEOTEXTILE UNDER STONE FILL
GRUBBING MATERIAL


1+170.00

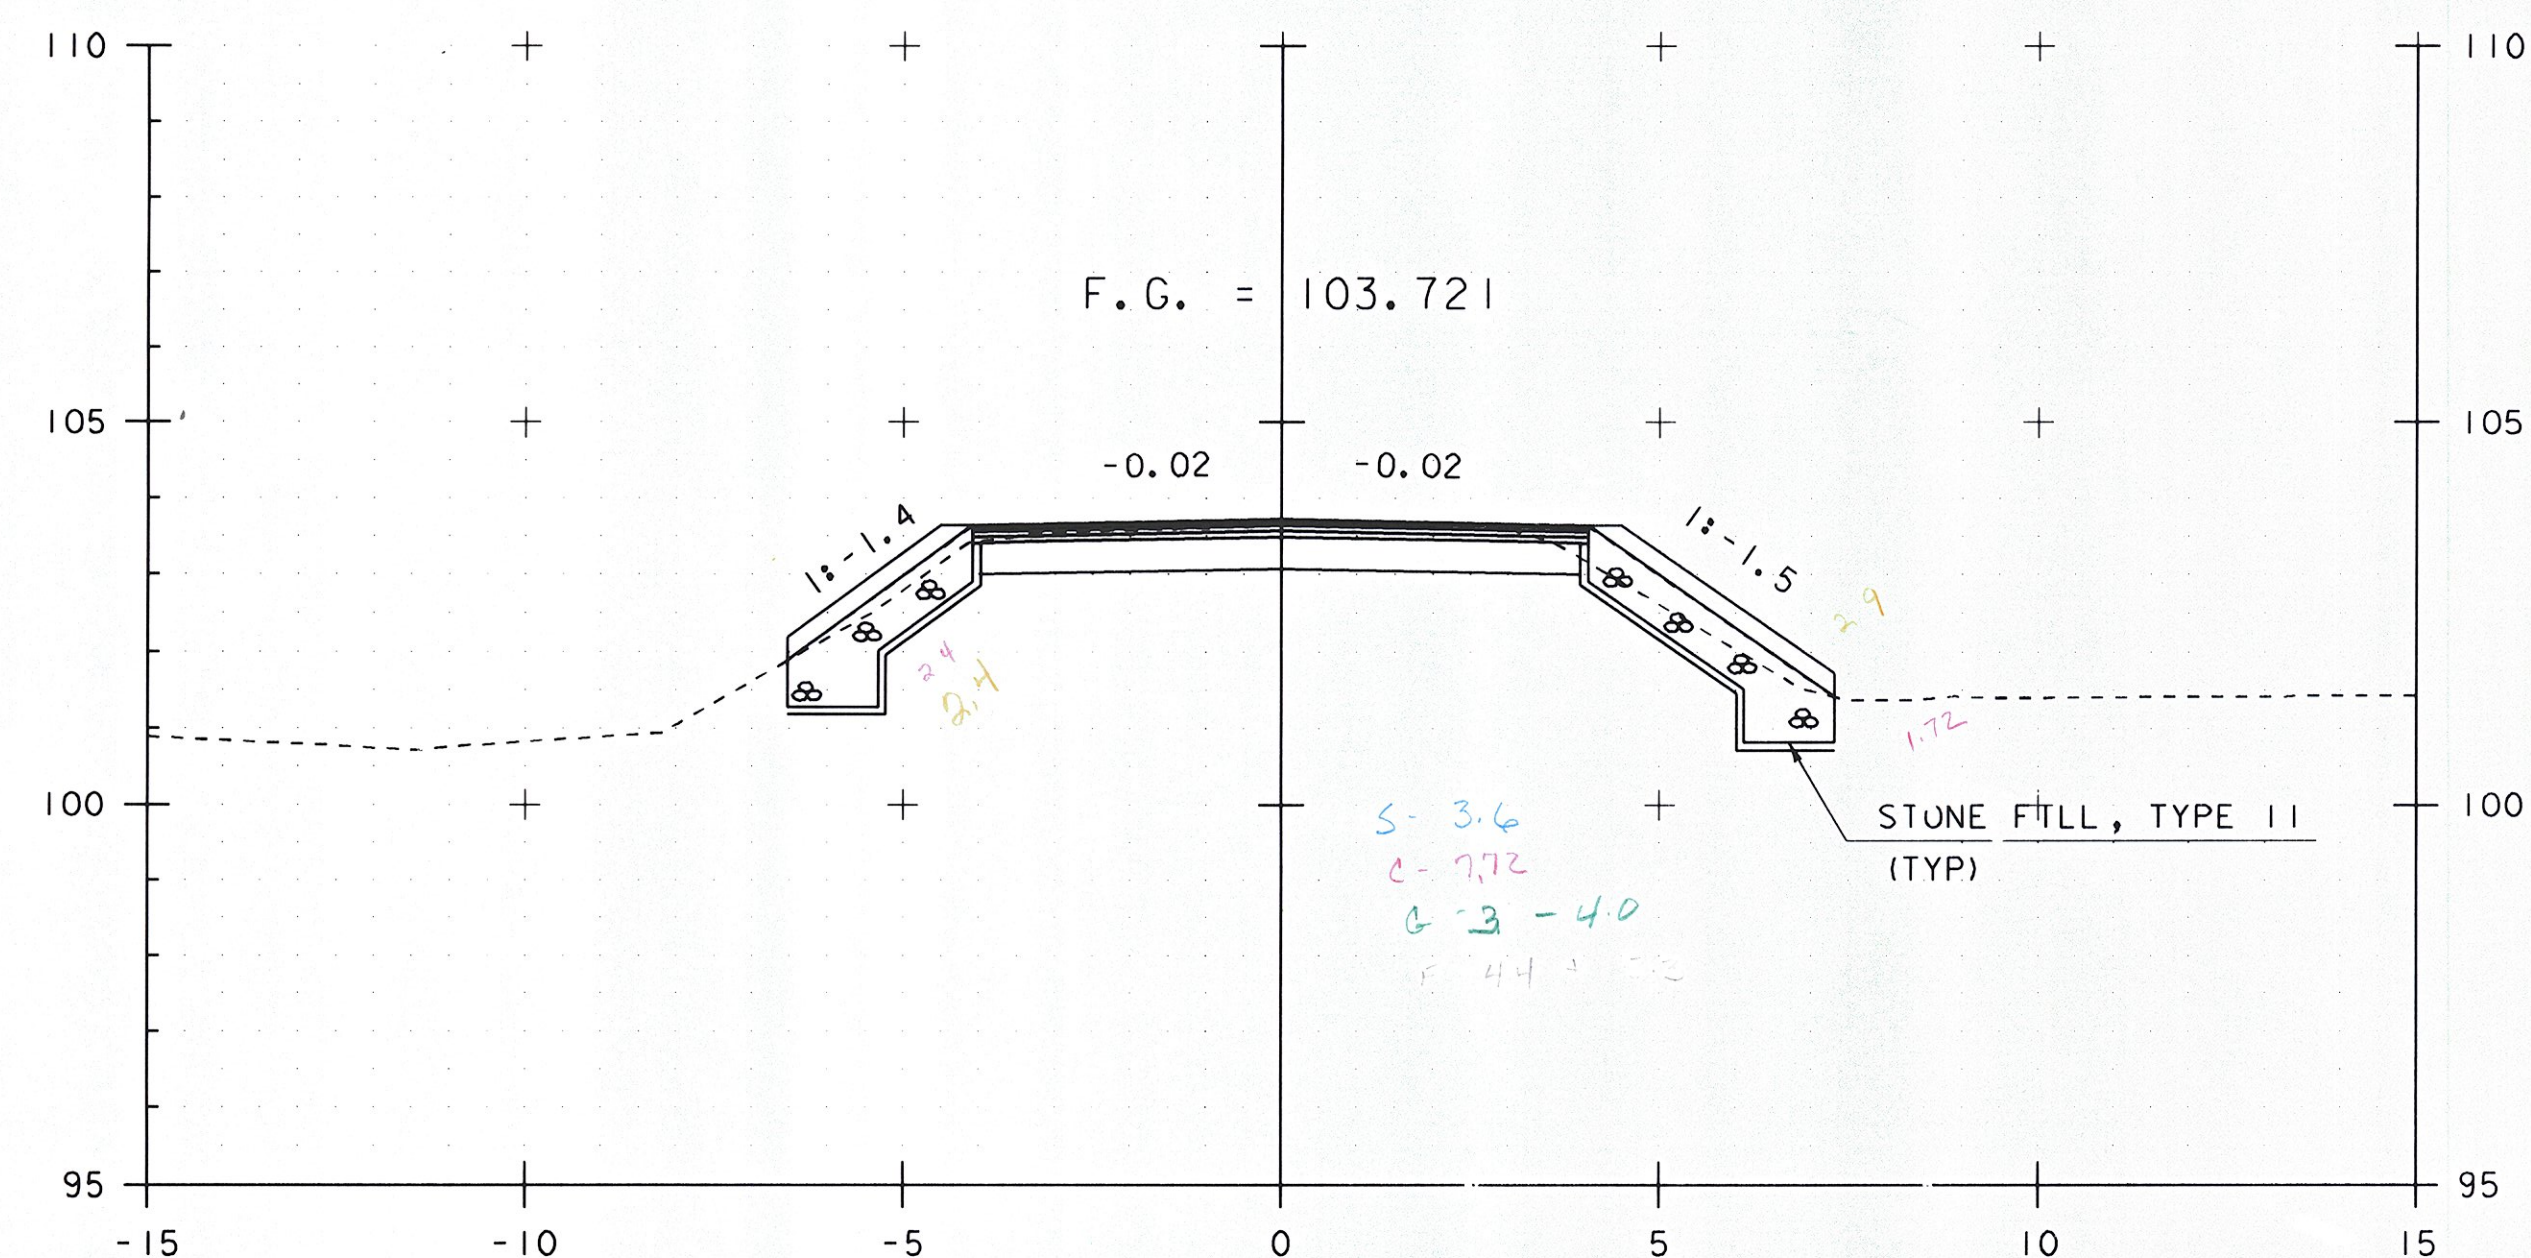

1+155.00

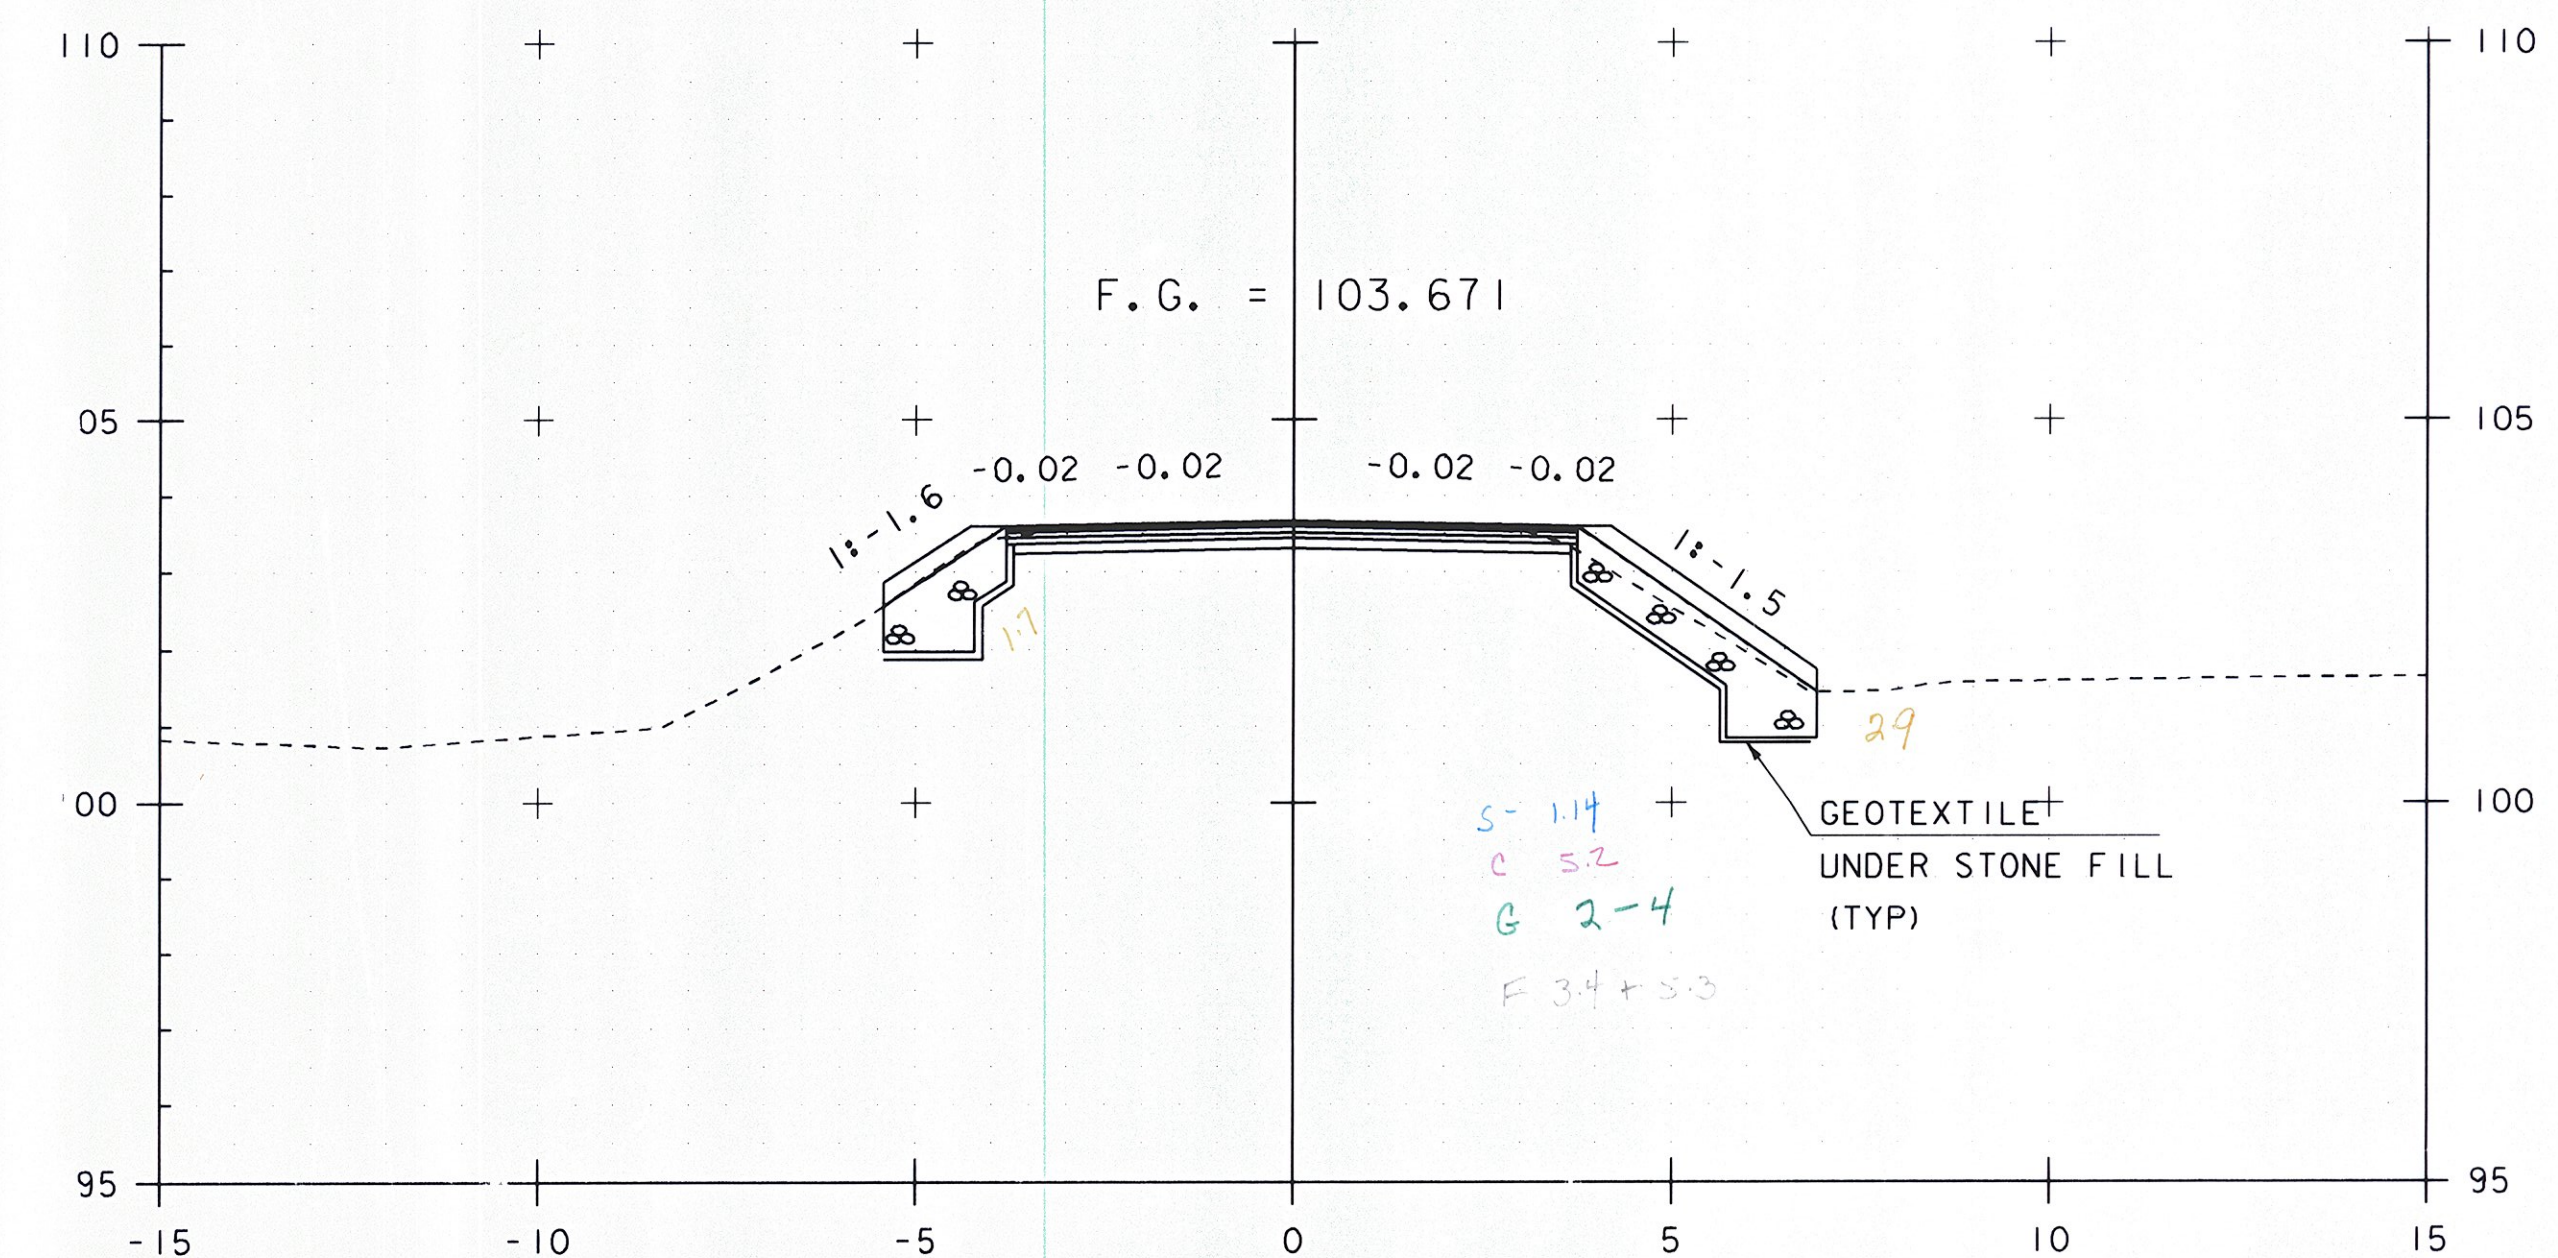

1+165.00

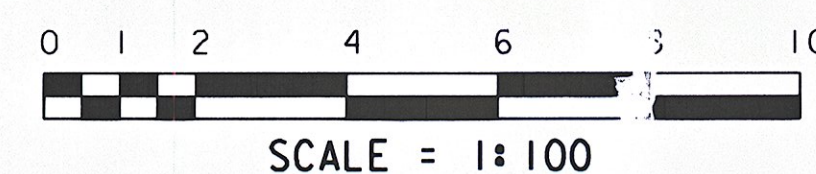

STA. 1+155 TO STA. 1+170

PROJECT NAME: HINESBURG	
PROJECT NUMBER: STP 0199(2)	
FILE NAME: 01J282/str/s01J282xsl.dgn	PLOT DATE: 02-MAR-2011
PROJECT LEADER: C. CARLSON	DRAWN BY: C. MOONEY
DESIGNED BY: W. LAMMER	CHECKED BY: C. CARLSON
MAINLINE SECTIONS SHEET 8	SHEET 42 OF 56