


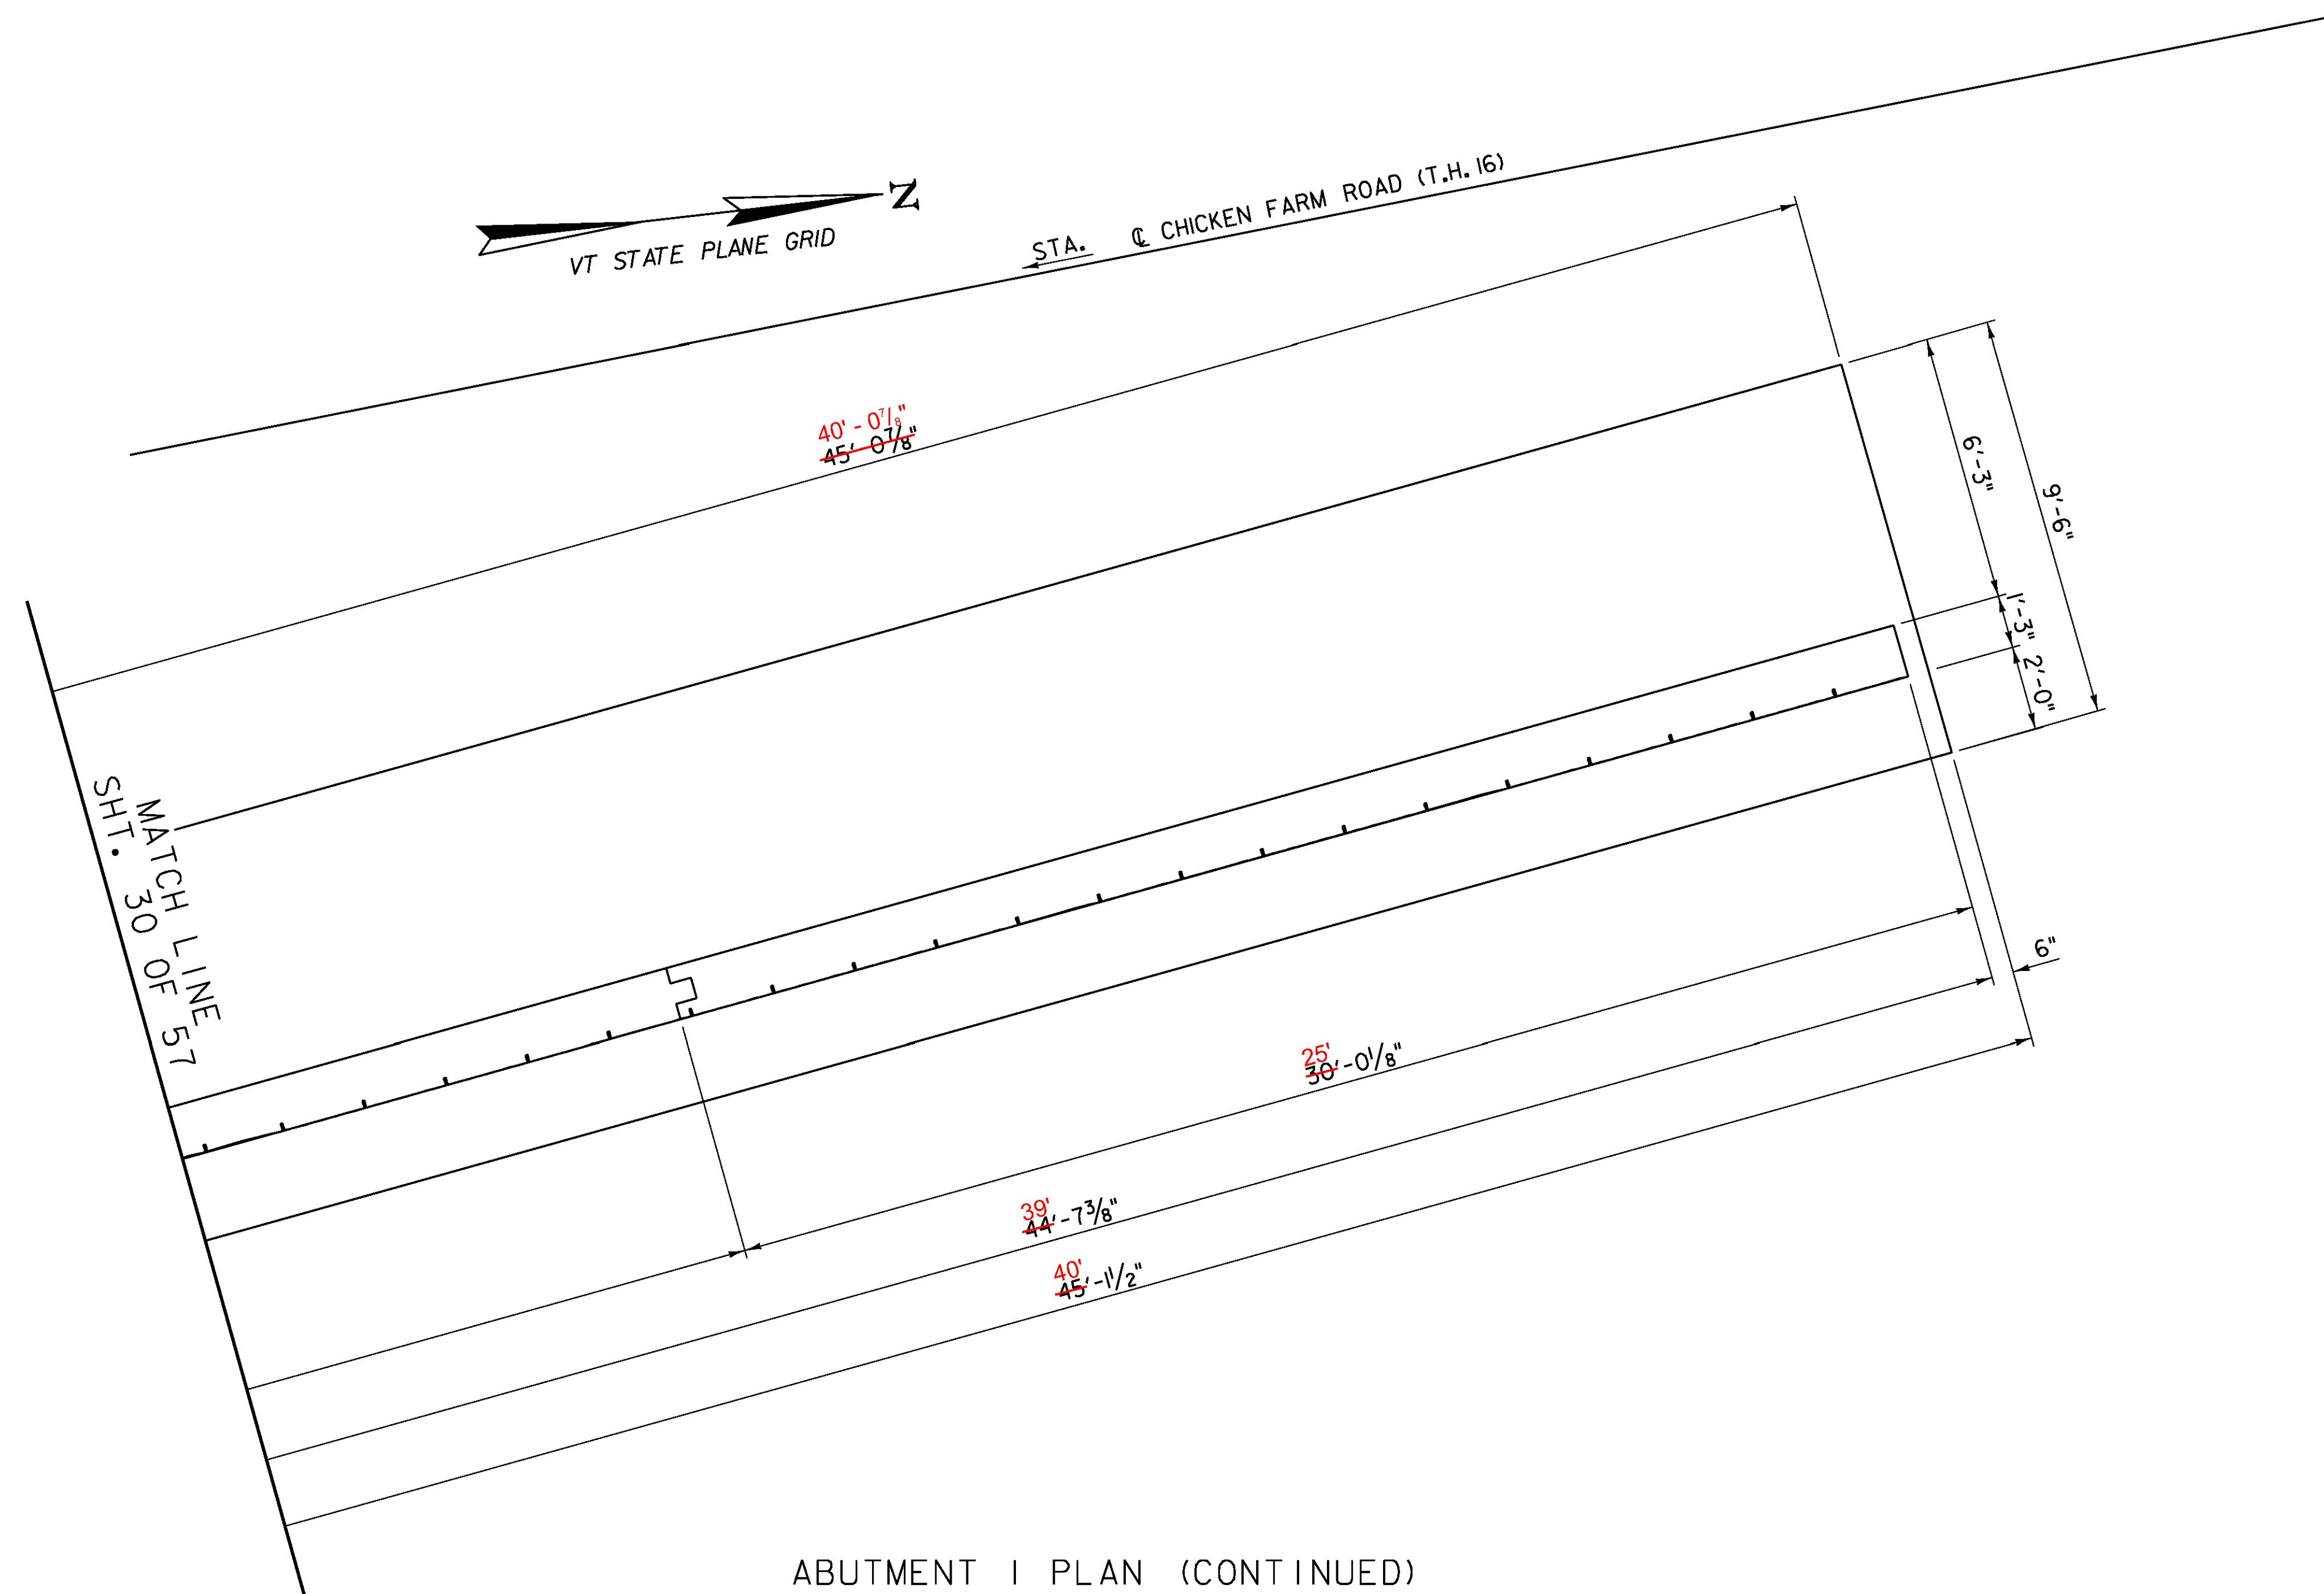

ABUTMENT 1 PLAN (CONTINUED)
SCALE $\frac{3}{8}$ " = 1' - 0"



PROJECT NAME: CORINTH	
PROJECT NUMBER: BRO 1447(29)	
FILE NAME: ...drawing\z01j292.abuts.dgn	PLOT DATE: 8/4/2014
PROJECT LEADER: G. BOGUE	DRAWN BY: L. BUXTON
DESIGNED BY: J. HUNGERFORD	CHECKED BY: G. BOGUE
ABUTMENT 1 MASONRY 2	SHEET 31 OF 57

8/4/2014 12:35:58 PM V:\953\active\95310795\transportation\drawing\z01j292.abuts.dgn