



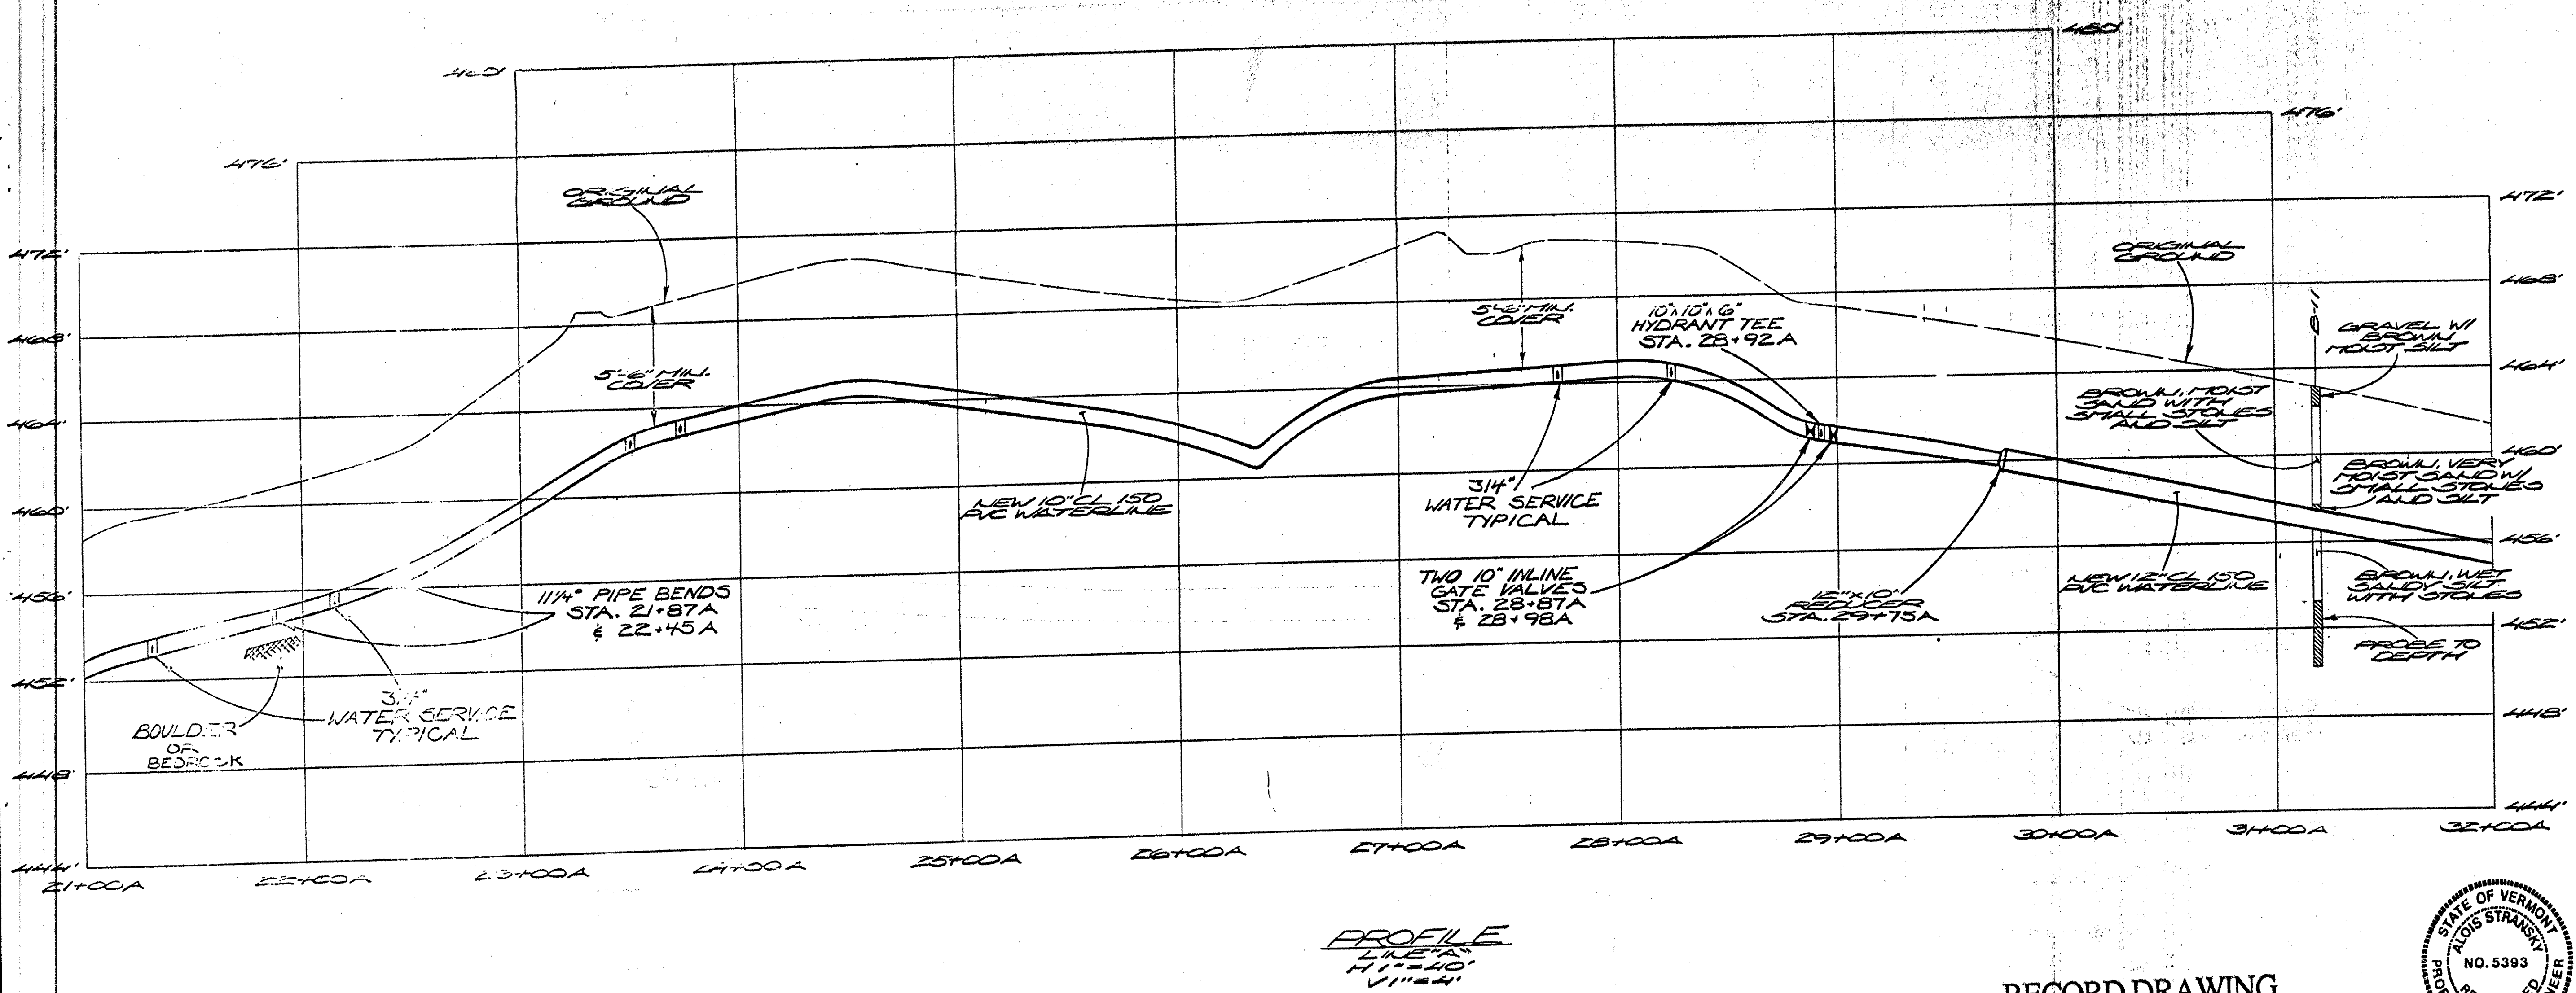

RECORD DRAWING
FEBRUARY 1990

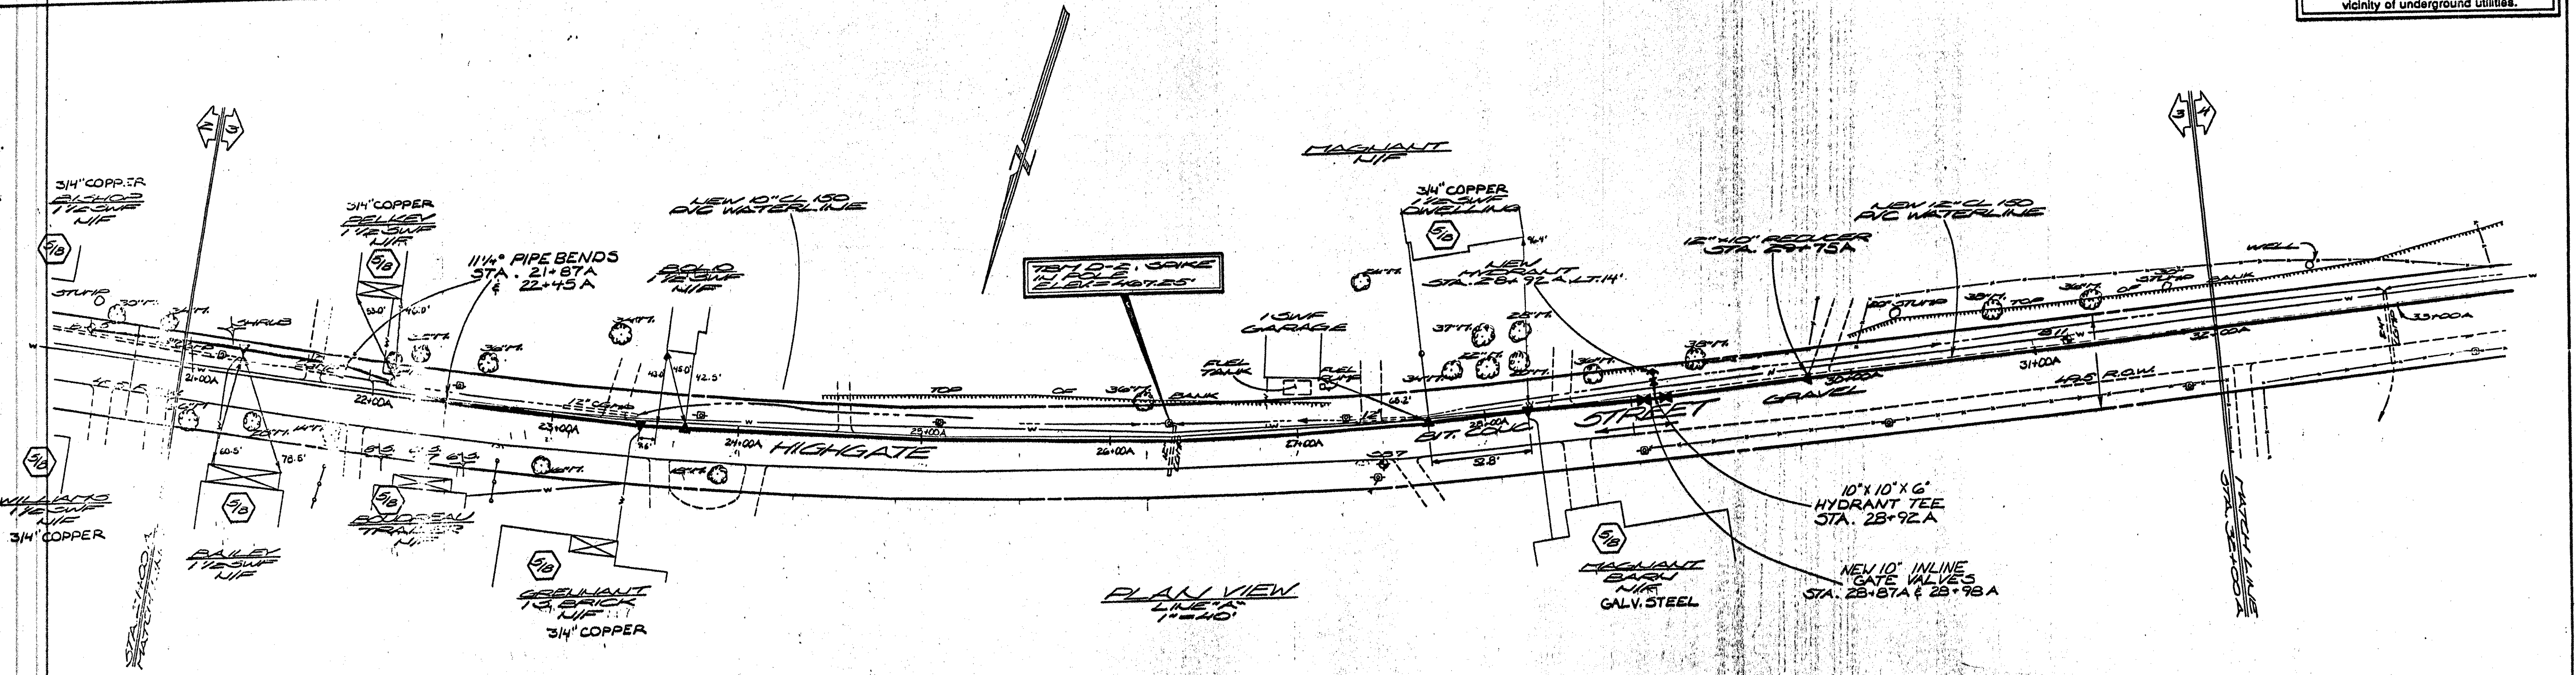

212070	RECORD DRAWING	TCR
DATE 11/6/88	REVISION ADD GATE VALVES STA. 28+92A & 28+98A	BY AS
FRANKLIN FIRE DISTRICT No. 1 FRANKLIN, VERMONT		
PLAN and PROFILE 21 + 00A to 32 + 00A		
SURVEY MRM	Donald L. Hamlin CONSULTING ENGINEERS, INC. Essex Junction, Vermont	SCALE SHOWN
DESIGN AS		DATE 5/24/88
DRAWN JRD		DRW. NO. 3 of 20
CHECKED AS/MCW		60 OF 60