

FED. ROAD REG. NO.	STATE	CONTRACT NO.	SHEET NO.	TOTAL SHEETS
1	N.Y.		24	43

COUNTY ROAD 18 OVER POULTNEY RIVER
WASHINGTON COUNTY, NY / RUTLAND COUNTY, VT
TOWN OF HAMPTON, NY / POULTNEY, VT
CAPITAL PROJECT IDENTIFICATION NO. 1753.76

AS BUILT: NO REVISIONS 9/2003

CONCRETE TABLE (m³)		
POUR	ITEM	ITEM
	555.0104 M	555.0105 M
1	46.4	—
2	—	69.8
3	—	16.1
4	—	16.1
5	—	4.0
TOTAL	46.4	106.0

NOTE:
POUR * DOES NOT NECESSARILY INDICATE
CONSTRUCTION SEQUENCE.

NOTES:
FOR DESIGN PURPOSES, THE MAXIMUM FOOTING PRESSURE
DOES NOT EXCEED 1.0 MPa.
REINFORCEMENT NOT SHOWN
FOR SECTION A-A SEE DWG. NO. ST-10.
FOR SECTION B-B SEE DWG. NO. ST-10.
FOR WEST ABUTMENT REINFORCEMENT PLANS AND WINGWALL
REINFORCEMENT ELEVATION SEE DWG. NO. ST-9.
FOR WATERSTOP DETAIL, SEE DWG. NO. ST-14.
FOR CHAMFER DETAIL, SEE DWG. NO. ST-14.

ALL DIMENSIONS ARE IN MM UNLESS OTHERWISE NOTED
AS BUILT REVISIONS





Signature 9/2003
SIGNATURE DATE

COUNTY ROAD 18 OVER POULTNEY RIVER

WEST ABUTMENT
PLAN AND ELEVATION

WASHINGTON COUNTY
DEPARTMENT OF PUBLIC WORKS

FILENAME	REGION	DATE	DRAWING NO.
175376AA.11A	ONE	3/2002	ST-8

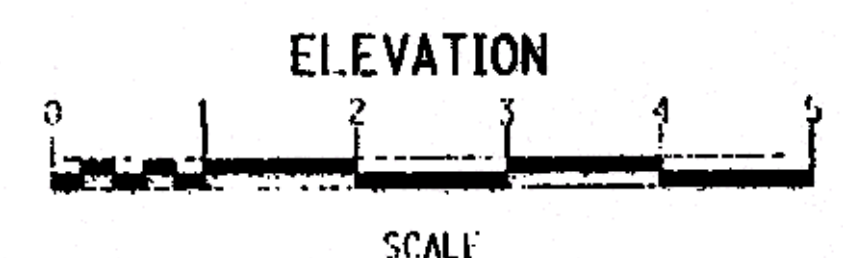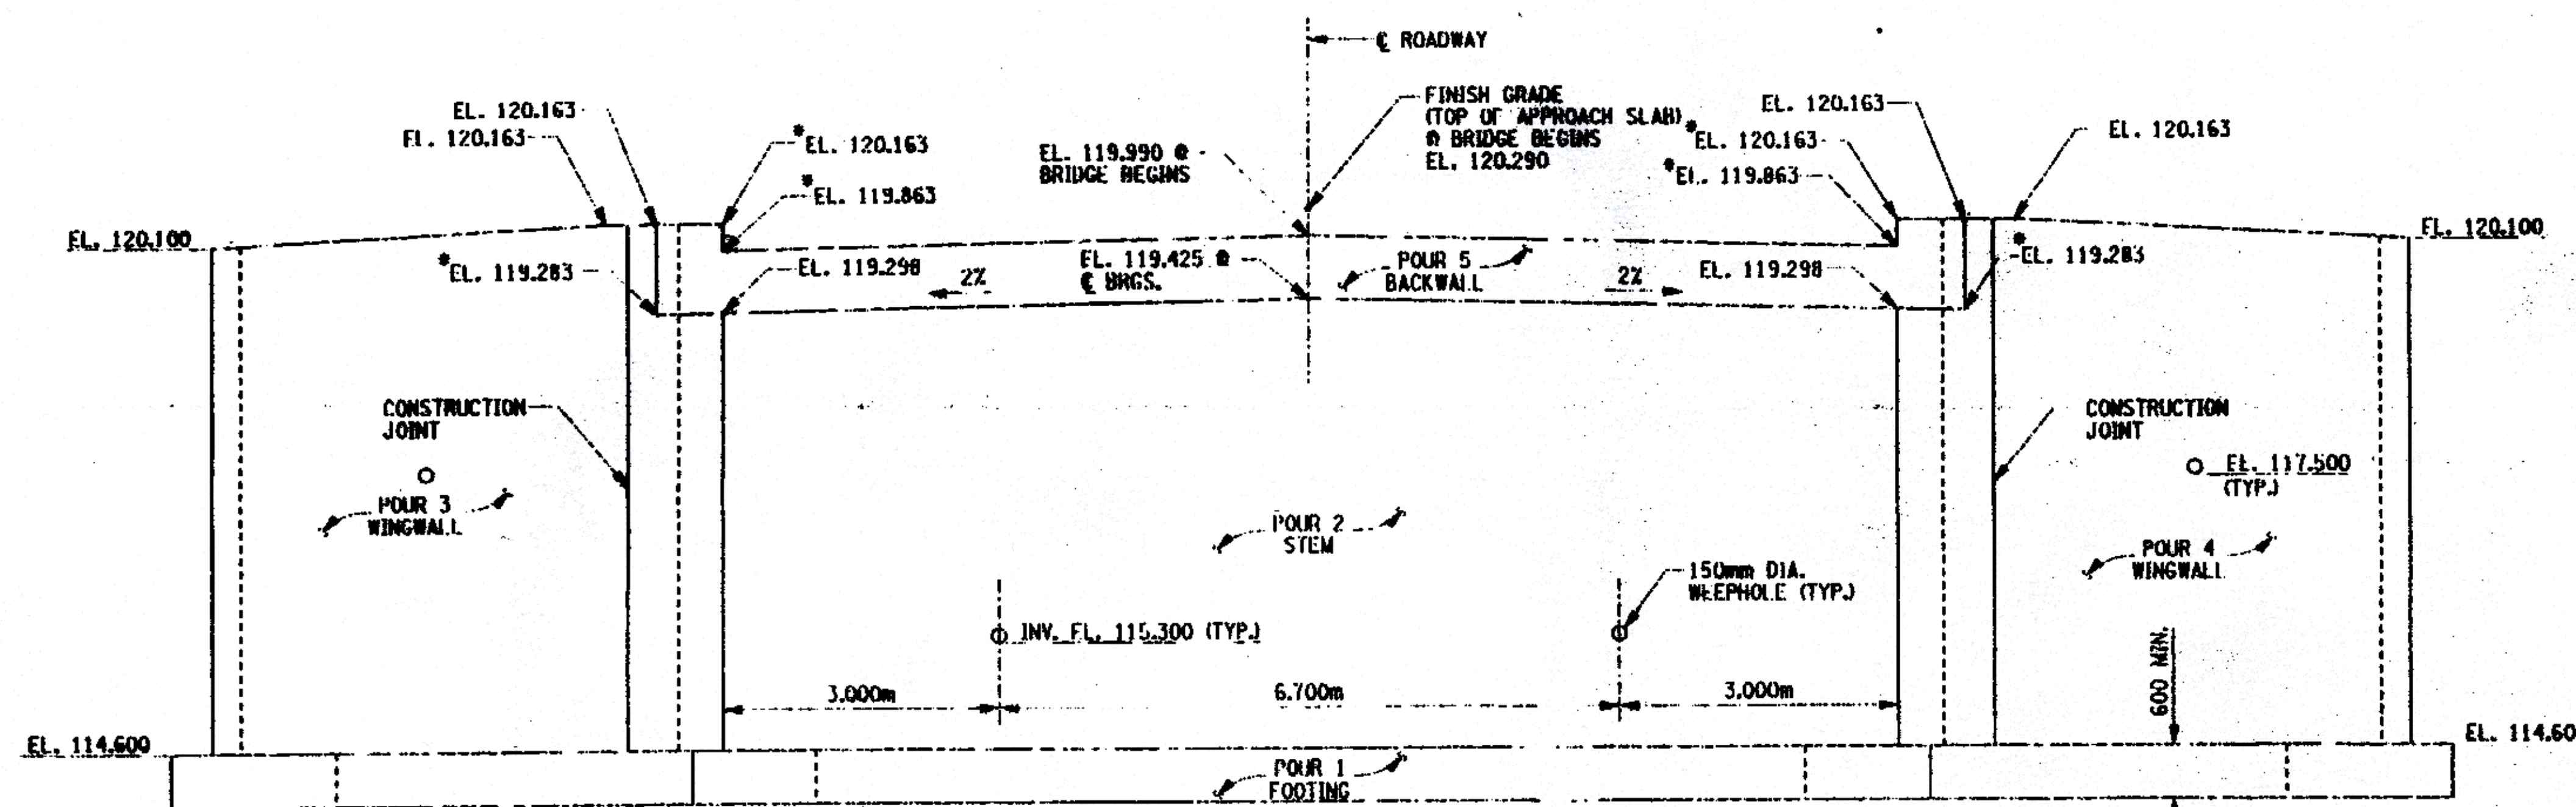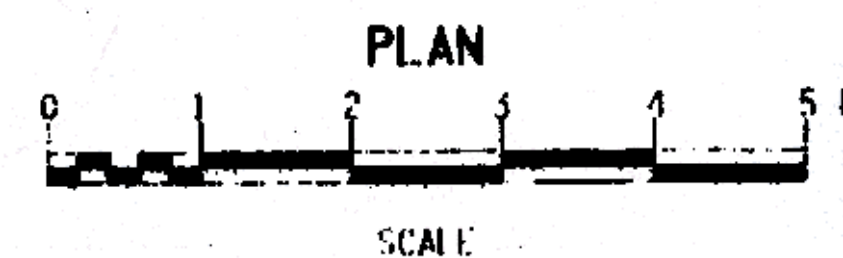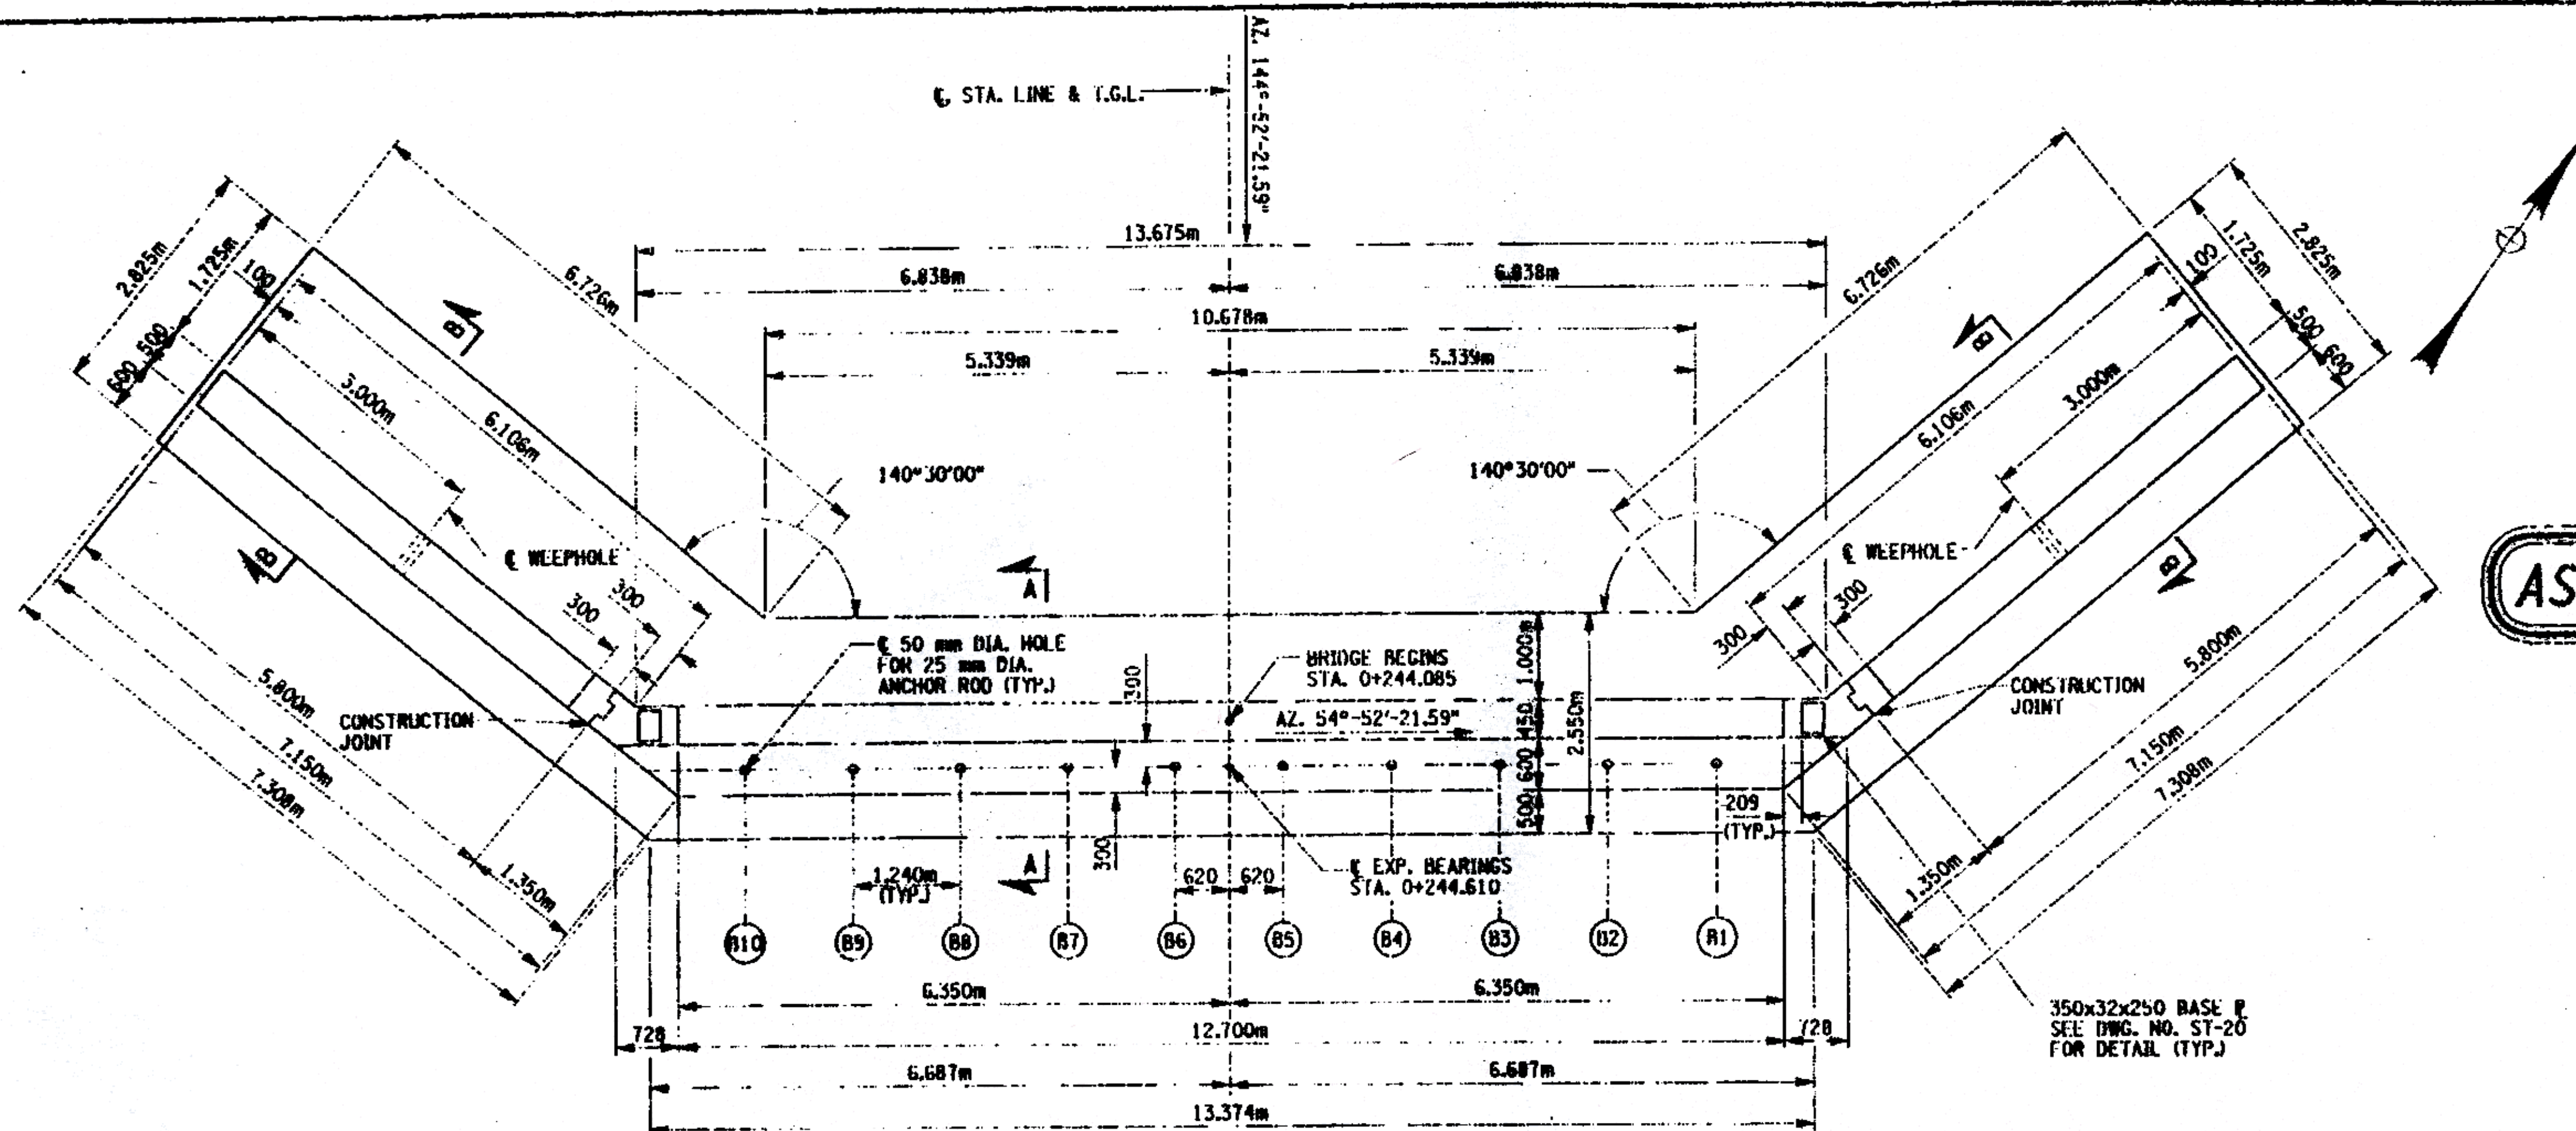

* INDICATES ELEVATIONS TAKEN AT FRONT
FACE OF BACKWALL.