



STATE OF NEW YORK
DEPARTMENT OF TRANSPORTATION
OFFICE OF ENGINEERING

P.I.N. 1753.76

COUNTY ROAD 18 OVER POULTNEY RIVER
TOWN OF HAMPTON, NY / POULTNEY, VT
WASHINGTON COUNTY, NY / RUTLAND COUNTY, VT

STANDARD SHEETS

M203-1, M203-2, M606-3, M607-2, M619-4, M619-5, M645-50,
M645-51, M645-52, M645-55, M645-56, M685-1

ALL WORK CONTEMPLATED UNDER THIS CONTRACT IS TO BE COVERED BY AND IN CONFORMITY WITH THE STANDARD SPECIFICATIONS (METRIC UNITS) OF JANUARY 2, 1995, AS AMENDED BY ADDENDA NOS. 1 AND 2 WITH CURRENT REVISIONS AND MODIFICATIONS, EXCEPT AS MODIFIED ON THESE PLANS AND IN THE ITEMIZED PROPOSAL.

3

CONTRACTOR'S NAME BONSARD EXCAVATING CORP.
AWARD DATE 7-22-02
COMPLETION DATE 6-13-03
FINAL ACCEPTANCE DATE 7-11-03
ENGINEER IN CHARGE L. LAWRENCE STEVENS
Earth Tech
FINAL COST TOTAL \$ 620,043.31

FISCAL SHARE

COST(S)

PREPARED FOR:




WASHINGTON COUNTY
DEPARTMENT OF PUBLIC WORKS

RECOMMENDED BY:

WILLY F. GRIMMKE, P.E.
SUPERINTENDENT OF PUBLIC WORKS

DATE: _____

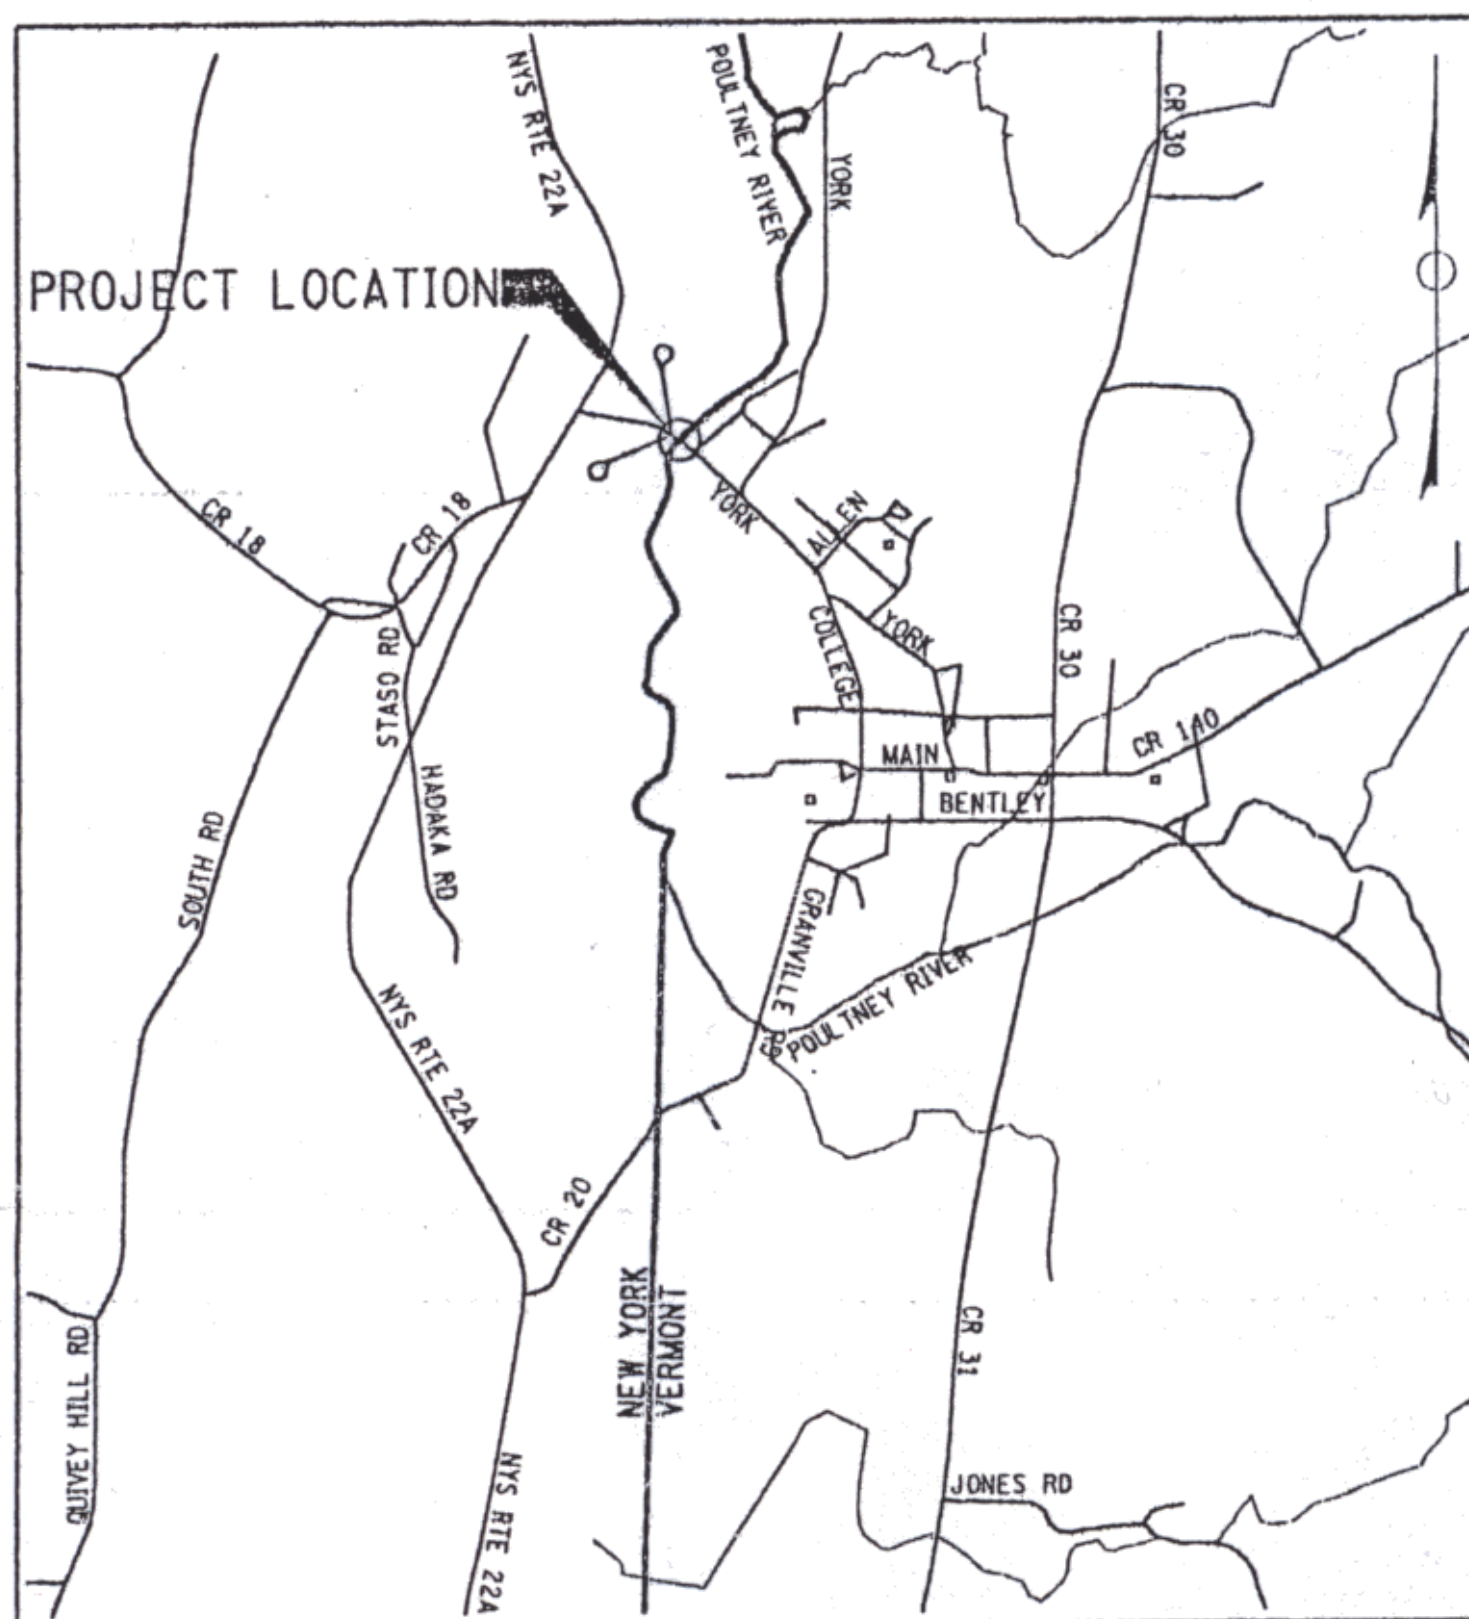

PROJECT LOCATION

PREPARED BY

EARTH  TECH

A **tyco** INTERNATIONAL LTD. COMPANY

40 BRITISH AMERICAN BOULEVARD
LATHAM, NEW YORK 12110




THOMAS J. CASCINO, P.E. NO. 072511

COUNTY ROAD 18 OVER POULTNEY RIVER			
TOWNS OF HAMPTON, NY/POULTNEY, VT			
WASHINGTON CTY, NY/RUTLAND CTY, VT			
BIN 3306390			
FED. ROAD REG. NO.	STATE	SHEET NO.	TOTAL SHEETS
1	N.Y.	1	43
FEDERAL AID PROJECT NO.			
CAPITAL PROJECT IDENTIFICATION NO. 1753.76			
INDEX ON SHEET NO.		2	

FED. ROAD REF. NO.	STATE	CONTRACT NO.	SHEET NO.	TOTAL SHEETS
1	N.Y.		3	43

COUNTY ROAD 18 OVER POULNEY RIVER
WASHINGTON COUNTY, NY / RUTLAND COUNTY, VT
TOWN OF HAMPTON, NY / POULTNEY, VT
CAPITAL PROJECT IDENTIFICATION NO. 1753.76

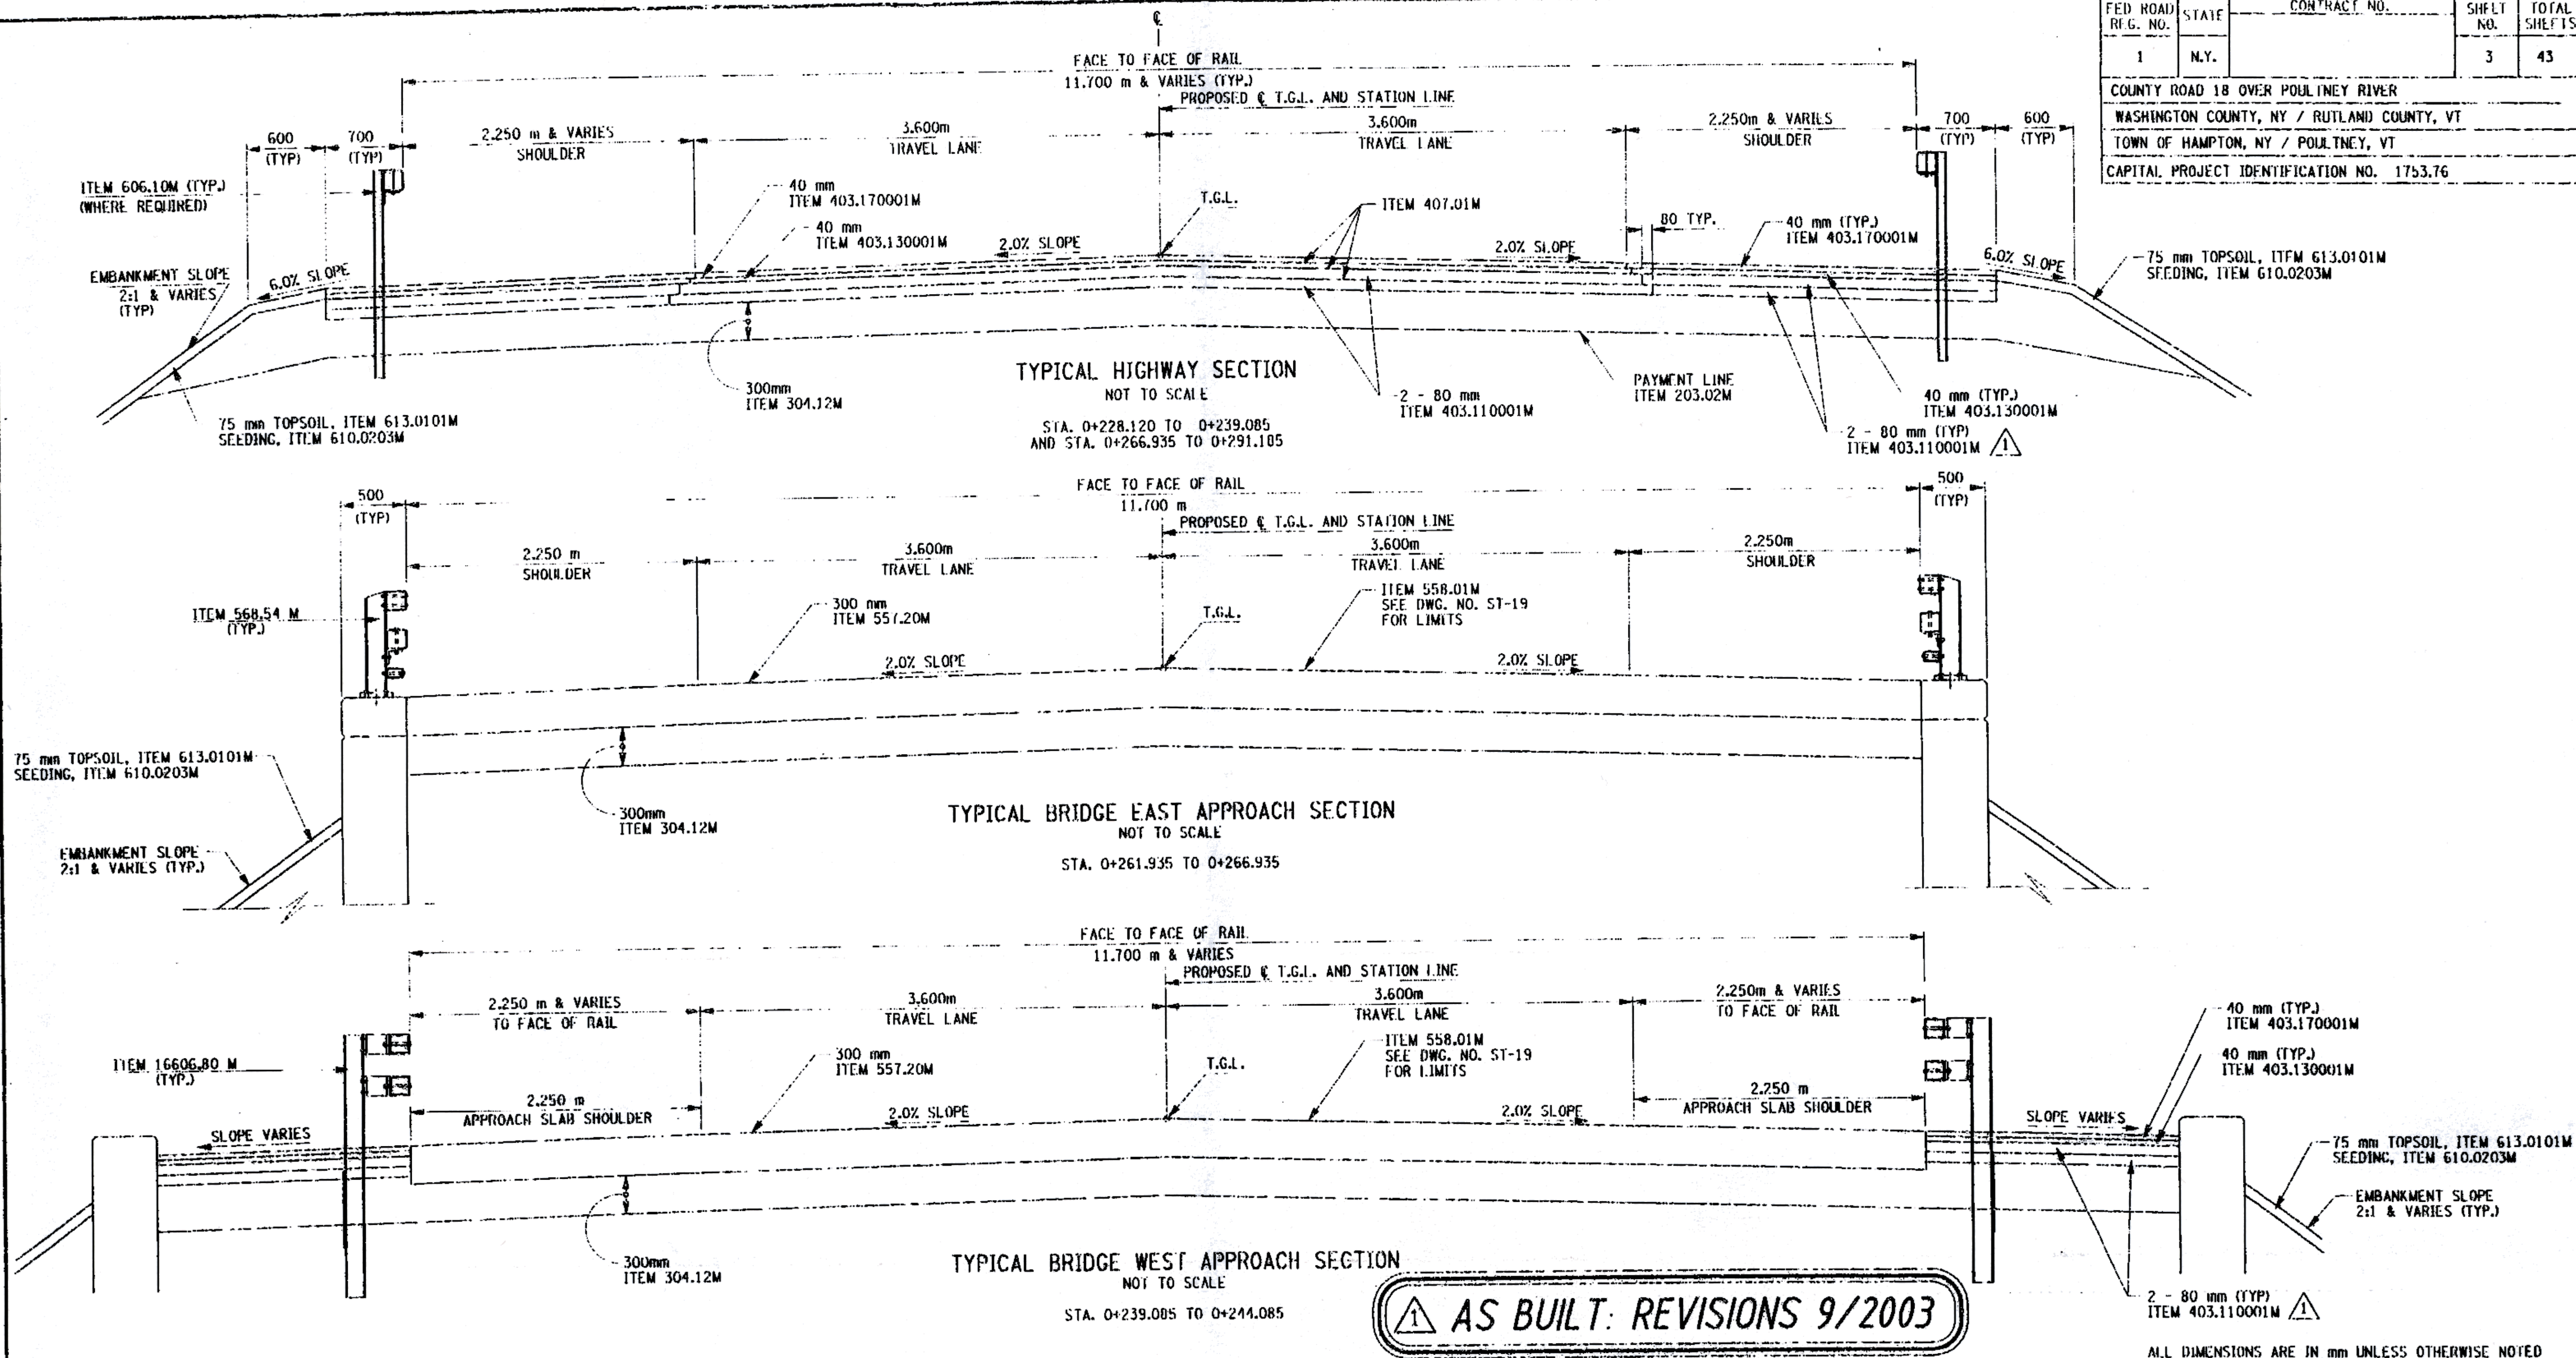

AS BUILT: REVISIONS 9/2003

ALL DIMENSIONS ARE IN mm UNLESS OTHERWISE NOTED

ITEM	DESCRIPTION	UNIT	ITEM	DESCRIPTION	UNIT	NOTES:
203.02M	UNCLASSIFIED EXCAVATION AND DISPOSAL	CM				1. THE TYPICAL HIGHWAY SECTION DETAILS SHALL BE USED TO RECONSTRUCT THE INTERSECTION AREA ON THE WEST SIDE OF THE BRIDGE AS DETAILED ON DWG. NO. MPT-3. THIS AREA SHALL NOT BE RECONSTRUCTED UNTIL THE NEW BRIDGE AND APPROACHES ARE COMPLETED, AND THE TEMPORARY CONCRETE BARRIERS ARE REMOVED. THE WORK AREA SHALL BE STAGED TO PROVIDE FOR TRAFFIC MOVEMENTS WITHIN THE INTERSECTION, AND NO DROP-OFFS WILL BE ALLOWED DURING NON-WORK HOURS. THE CONTRACTOR SHALL SUBMIT A WORK SEQUENCE PRIOR TO COMMENCING WORK IN THIS AREA.
304.12M	SUBBASE COURSE, TYPE 2	CM				2. TACK COAT (ITEM 407.01 M) SHALL BE APPLIED BETWEEN ASPHALT CONCRETE COURSES AT A RATE OF 0.14 L/m ² .
403.110001M	ASPHALT CONCRETE - TYPE 1 BASE COURSE	MT				3. TACK COAT (ITEM 407.01 M) SHALL BE APPLIED TO ALL SAWCUT AND EXISTING SURFACES PRIOR TO PAVING.
403.130001M	ASPHALT CONCRETE - TYPE 3 BINDER COURSE	MT				4. ANY DAMAGE TO EXISTING PAVEMENT OUTSIDE THE PROPOSED WORK LIMITS SHALL BE REPAIRED (A.O.B.E.) BY THE CONTRACTOR AT NO ADDITIONAL COST TO THE COUNTY.
403.170001M	ASPHALT CONCRETE - TYPE 6F TOP COURSE (FRICTION)	MT				5. THE BOTTOM PAYMENT LIMIT FOR ITEM 203.02M UNDER THE PAVEMENT SHALL BE TO THE BOTTOM OF PROPOSED SUBBASE COURSE OR BOTTOM OF THE EXISTING PAVEMENT, WHICHEVER IS LOWER.
407.01M	TACK COAT	L				
557.20M	STRUCTURAL APPROACH SLAB WITH INTEGRAL WEARING SURFACE	SM				
558.01M	TRANSVERSE SAWCUT GROOVING OF STRUCTURAL SLAB SURFACE	SM				
606.10M	BOX BEAM GUIDE RAILING	M				
16606.80M	TRANSITION - BRIDGE RAILING OR CONCRETE BARRIER TO BOX BEAM GUIDE RAILING	M				
610.0203M	ESTABLISHING TURF	SM				
613.0101M	TOPSOIL	CM				

AS BUILT REVISIONS			
		9/2003	
SIGNATURE		DATE	
COUNTY ROAD 18 OVER POULNEY RIVER			
TYPICAL SECTIONS			
WASHINGTON COUNTY			
DEPARTMENT OF PUBLIC WORKS			
FILENAME 175376AA.C1C	REGION ONE	DATE 3/2002	DRAWING NO. TS-1

FILE NAME = \\wv\142007\ACD\AsBuilt\175376e.glc
DATE/TIME = 11/24/2003 8:43:33 AM
USER = JWC

DESIGN SUPERVISOR JWC JOB MANAGER JWC CHECKED BY LK ESTIMATED BY EKT DRAFTED BY RUN CHECKED BY EKT

FILE NAME = J:\work\112007\CA00\as-built\175376a.gis
DATE/TIME = 11/04/2003 8:06:22 AM
USER = RJN

CHECKED BY EXT

DRAFTED BY RJN

ESTIMATED BY EXT


CHECKED BY LAK

DESIGNED BY EXT


JOB MANAGER IJC

DESIGN SUPERVISOR IJC

FED ROAD REC. NO.	STAFF	CONTRACT NO.	SHEET NO.	TOTAL SHEETS
1	N.Y.		12	43
COUNTY ROAD 18 OVER POULTNEY RIVER				
WASHINGTON COUNTY, NY / RUTLAND COUNTY, VT				
TOWN OF HAMPTON, NY / POULTNEY, VT				
CAPITAL PROJECT IDENTIFICATION NO. 1753.76				

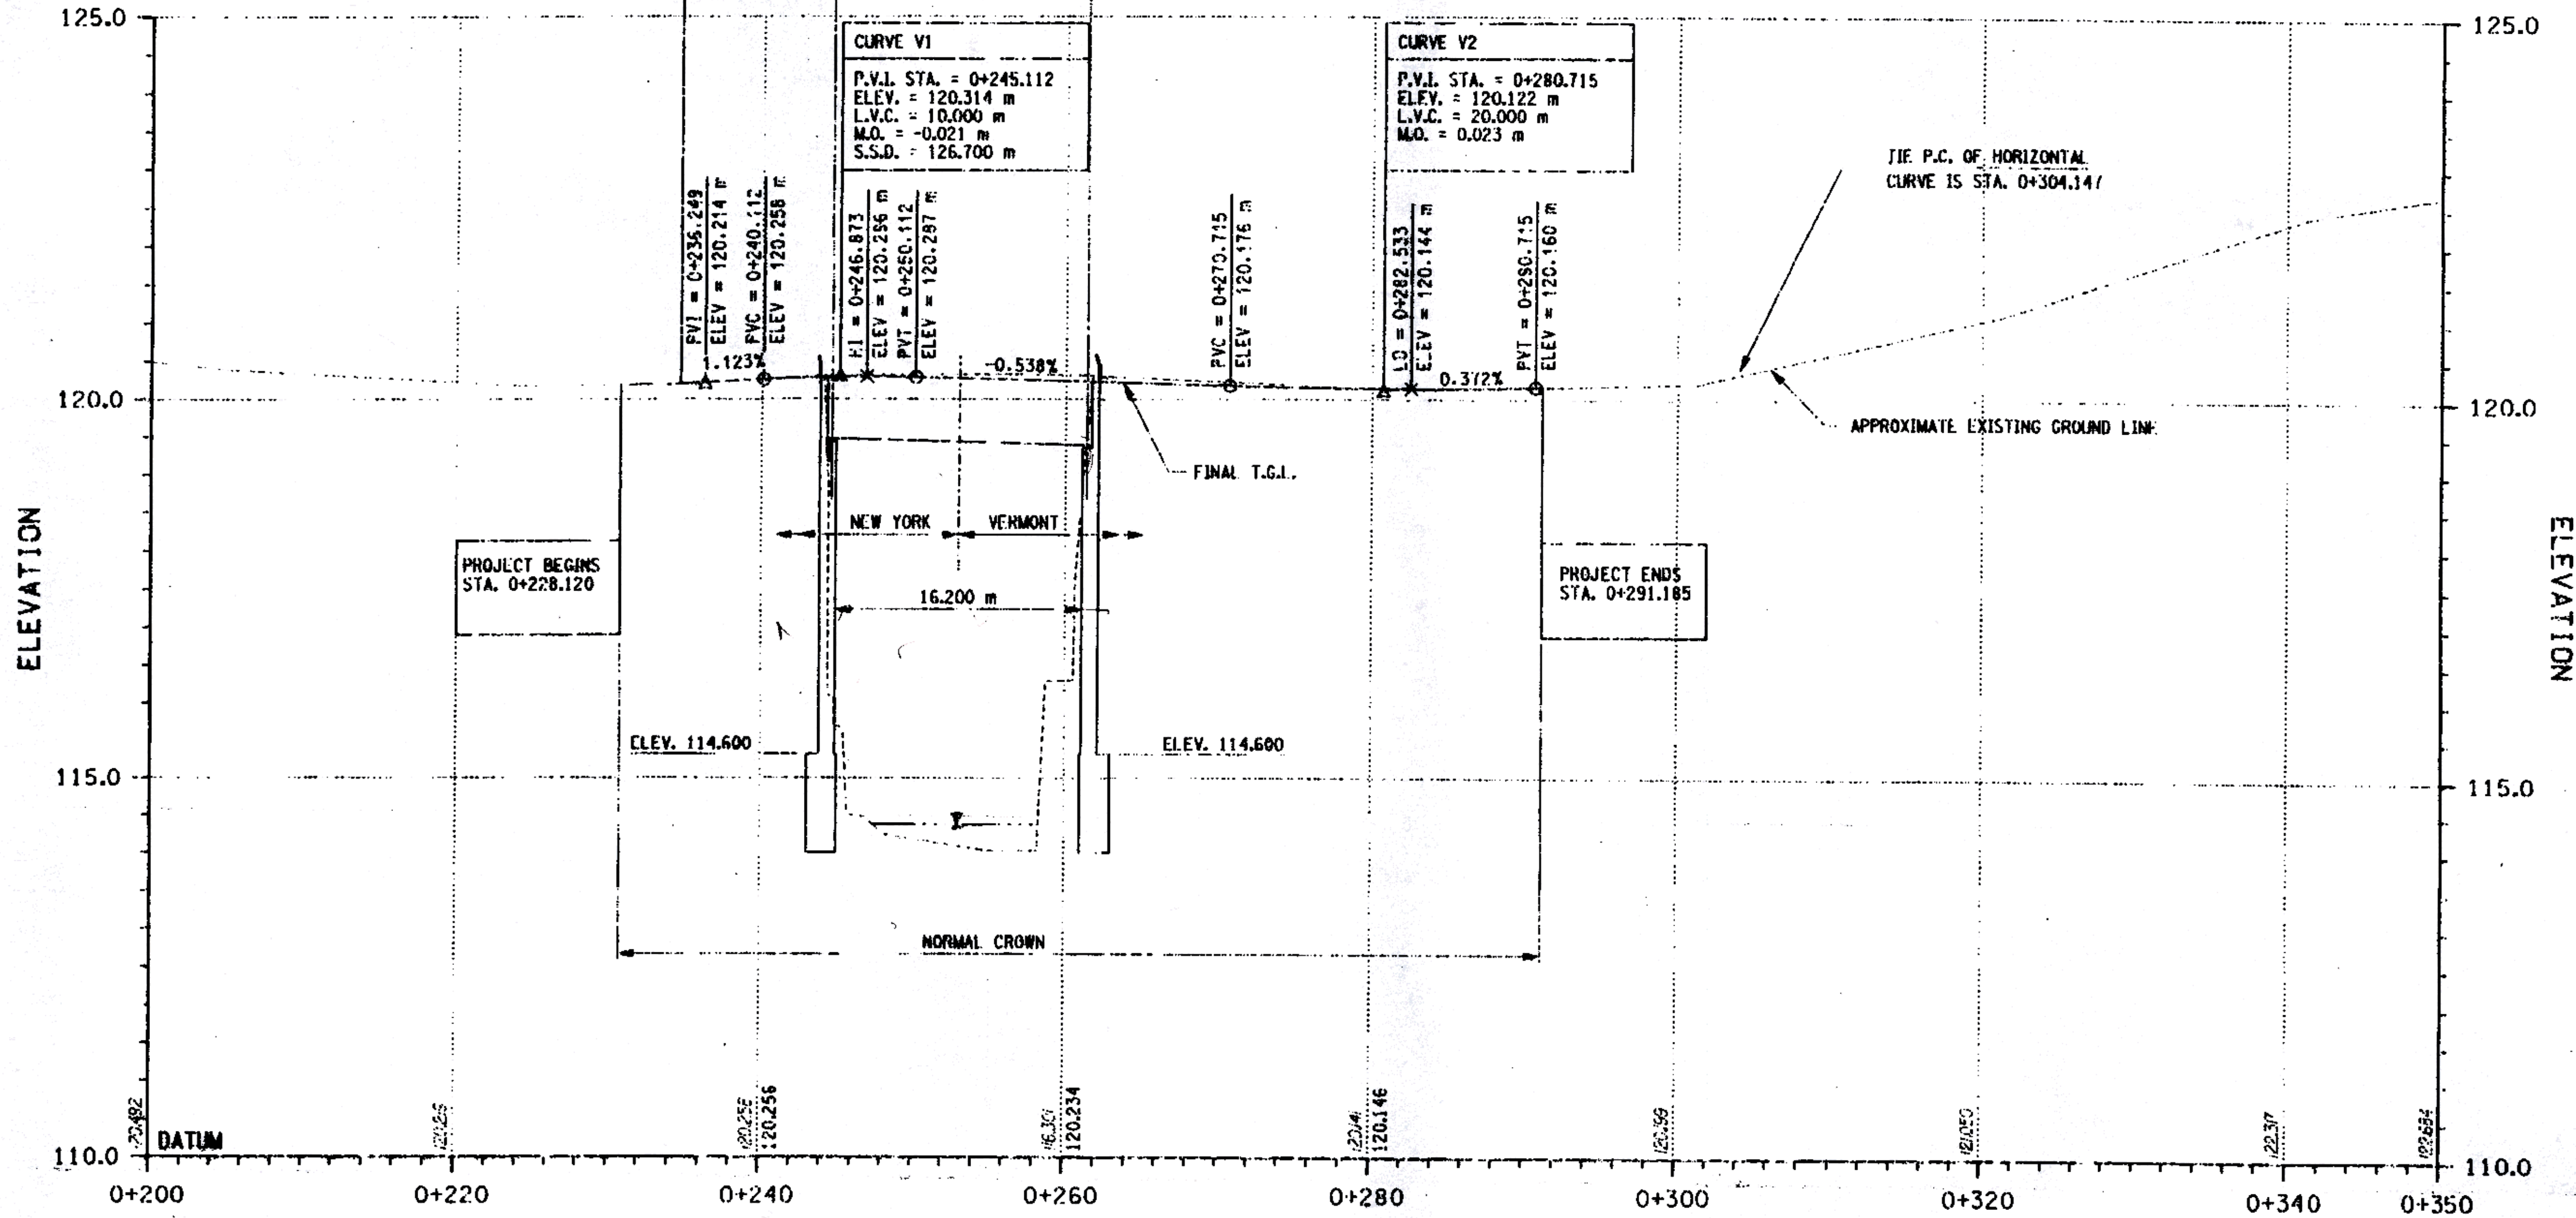

PROFILE

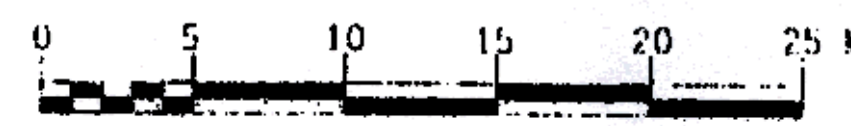

HORIZONTAL SCALE



VERTICAL SCALE

AS BUILT: NO REVISIONS 9/2003

ALL DIMENSIONS ARE IN mm UNLESS OTHERWISE NOTED

AS BUILT REVISIONS

Anthony E. Thomas 9/2003
SIGNATURE DATE

COUNTY ROAD 18 OVER POULTNEY RIVER


PROFILE

WASHINGTON COUNTY
DEPARTMENT OF PUBLIC WORKS

FILENAME	REGION	DATE	DRAWING NO.
175376A.G18	ONE	3/2003	CR-2


FILE NAME = I:\work\142007\CADD\AsBuilt\175376aa.gla
DATE/TIME = 3/04/2003 09:59:06 AM
USER = RUN

DESIGN SUPERVISOR TJC
DESIGNED BY TJC
CHECKED BY LAK
ESTIMATED BY EXT
DRAFTED BY RUN
CHECKED BY EXT

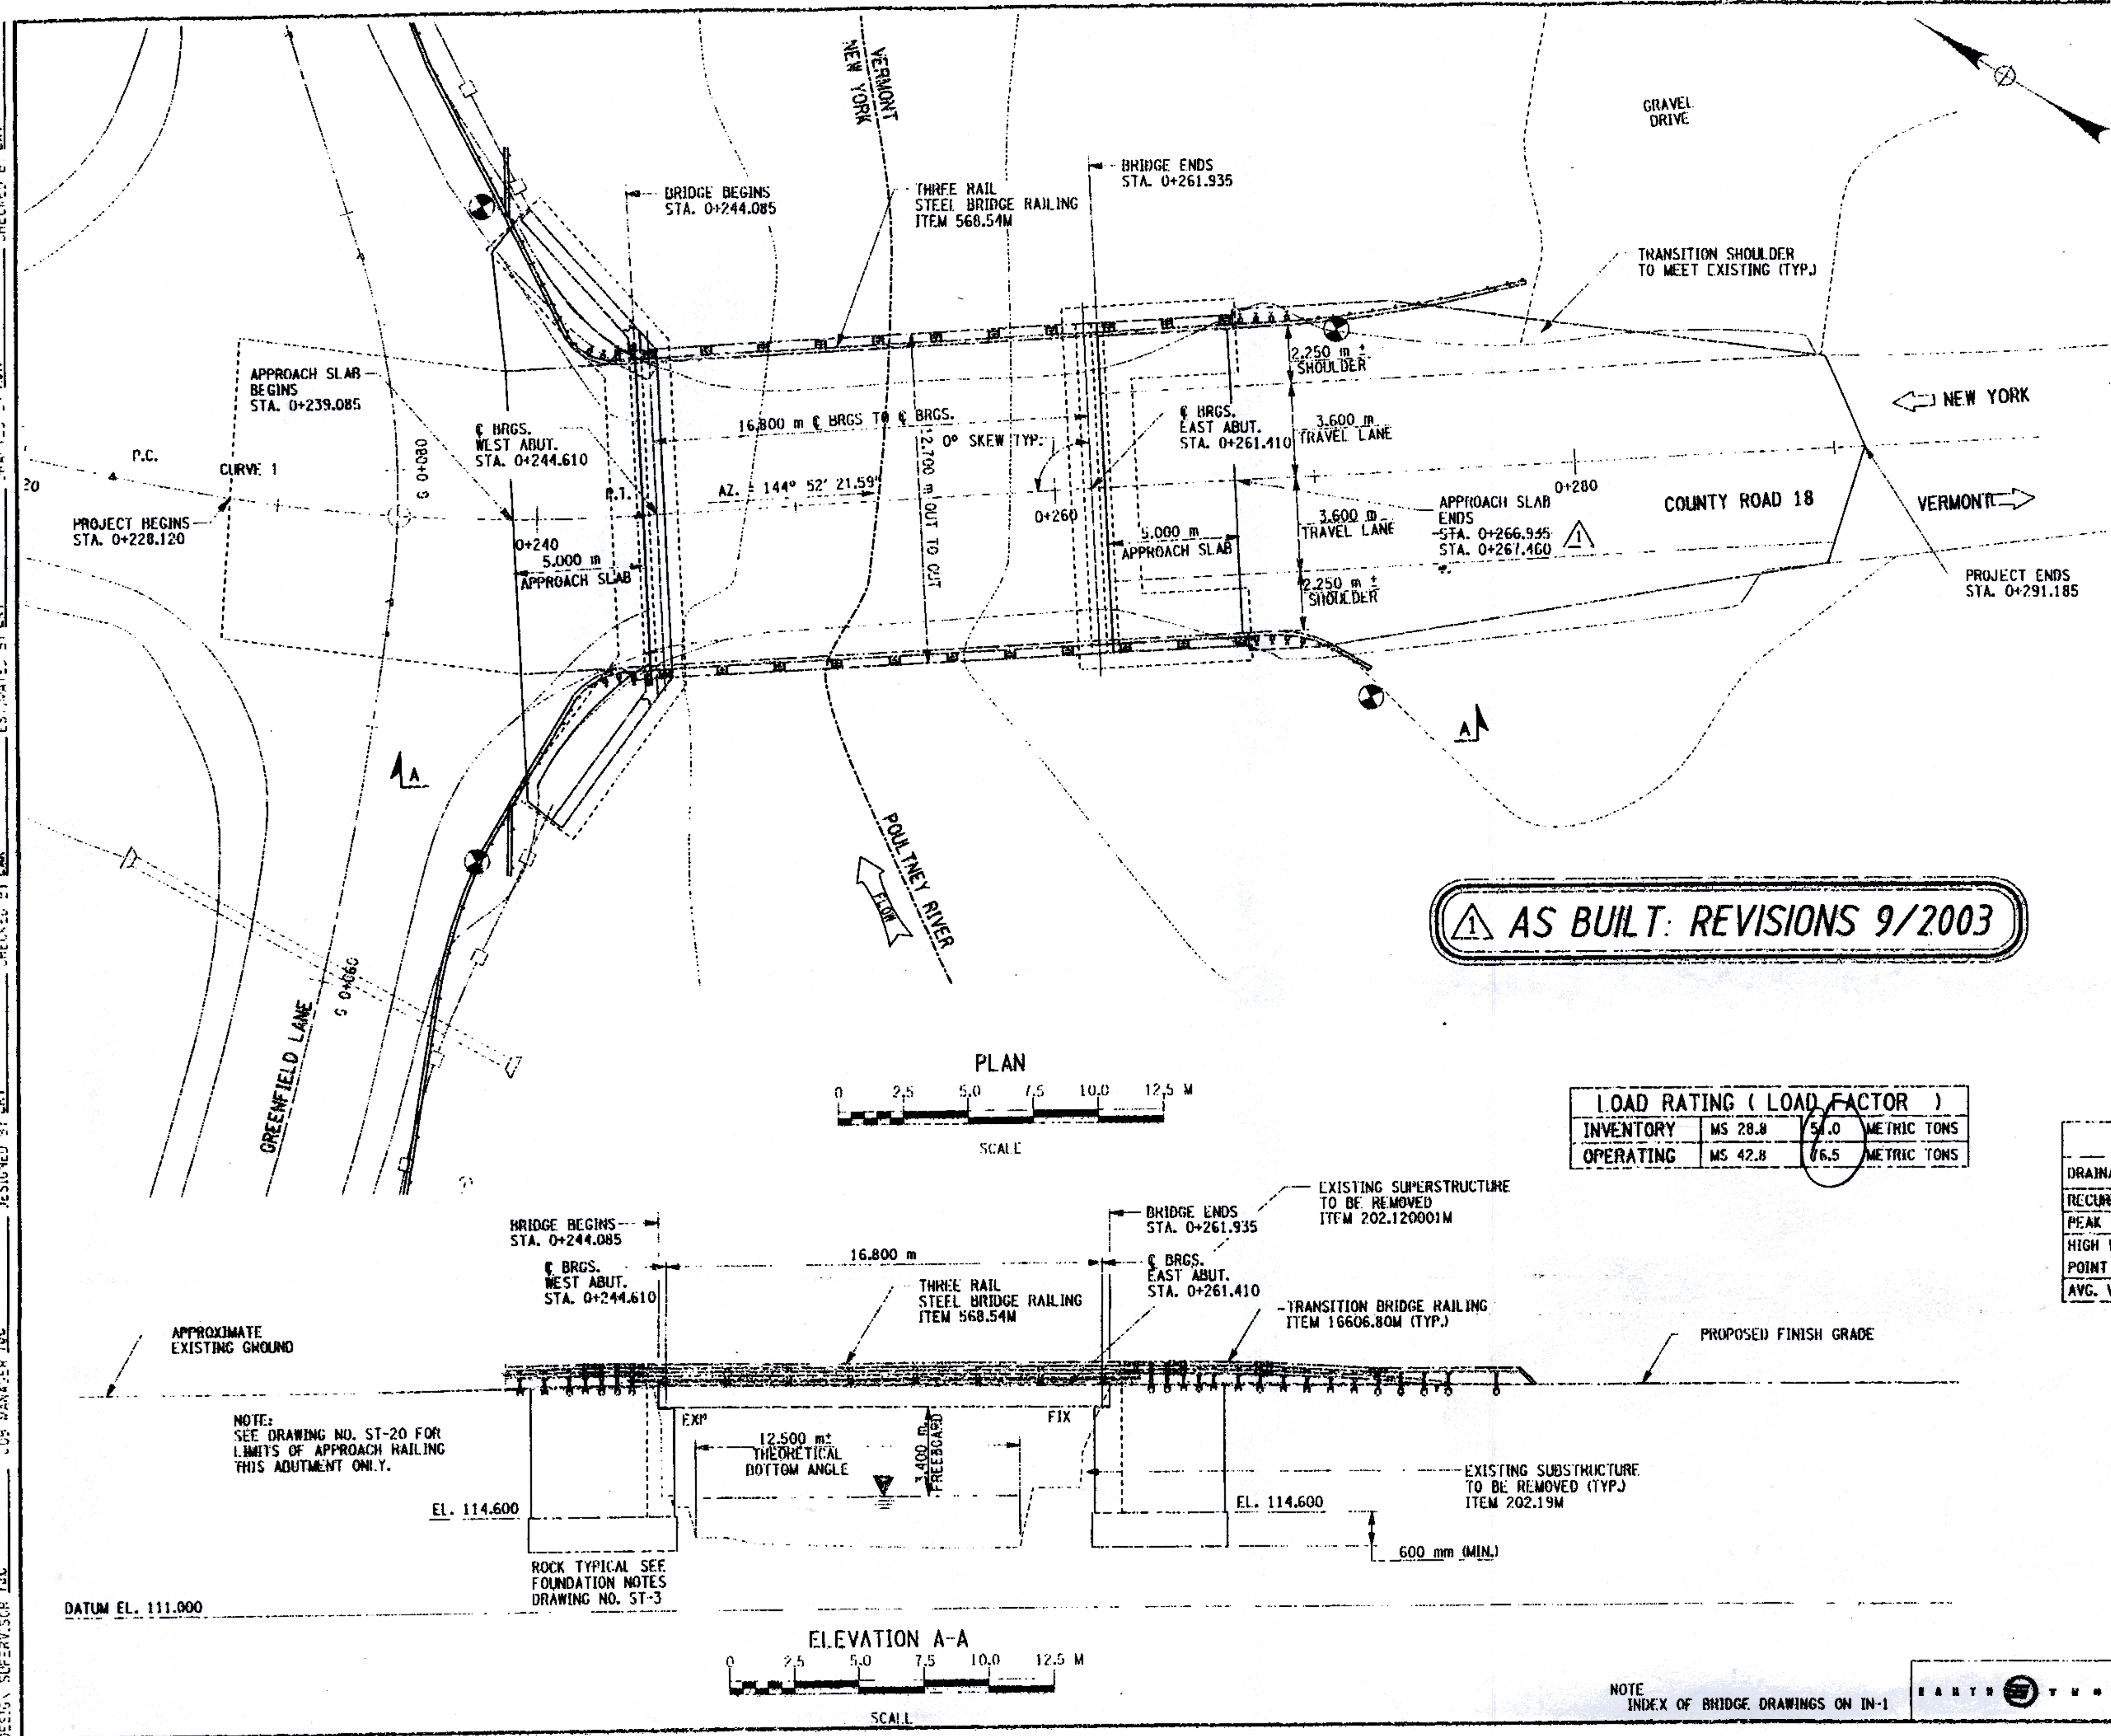

FED ROAD RLG. NO.	STATE	CONTRACT NO.	SHEET NO.	TOTAL SHEETS
1	N.Y.		17	43

COUNTY ROAD 18 OVER POULTNEY RIVER
WASHINGTON COUNTY, NY / RUTLAND COUNTY, VT
TOWN OF HAMPTON, NY / POULTNEY, VT
CAPITAL PROJECT IDENTIFICATION NO. 1753.76

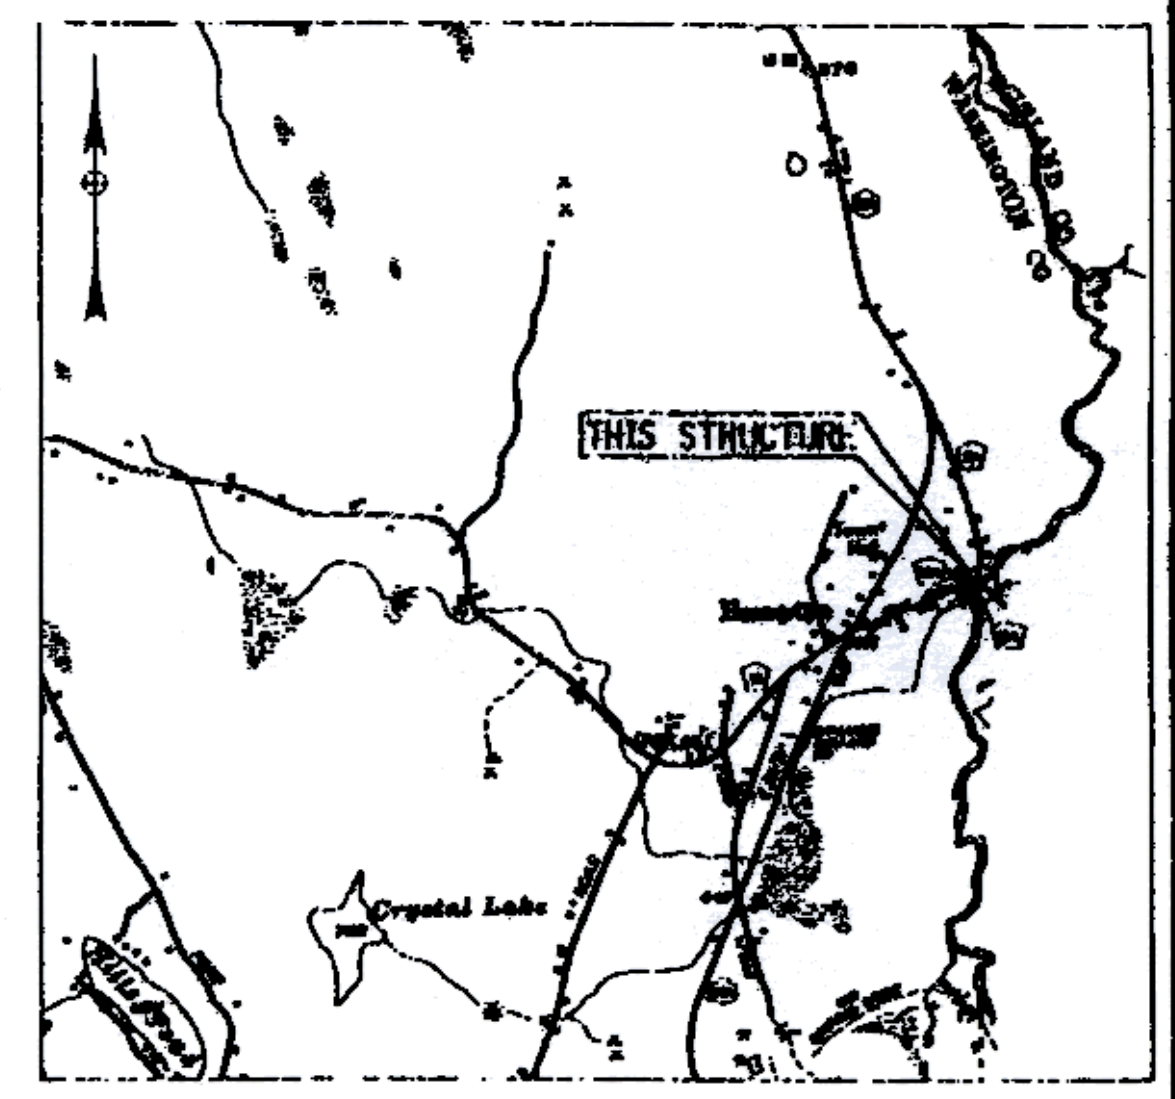

LOCATION MAP
THORN HILL QUADRANGLE
SCALE: 1:24000

ELECTRICAL SAFETY NOTE:
HIGH VOLTAGE ELECTRICAL LINES ARE IN PROXIMITY TO THIS BRIDGE. REFER TO ELECTRICAL SAFETY NOTE CONTAINED IN THE CONTRACT PROPOSAL FOR SPECIAL CONTRACTOR SAFETY REQUIREMENTS. SEE DRAWING NO. GP-1 FOR LOCATIONS.

AS BUILT: REVISIONS 9/2003

HORIZONTAL CURVE DATA		
	CURVE 1	CURVE 2
PC STATION	0+223.489	0+304.147
RADIUS	75,000 m	500,000 m
LENGTH OF CURVE	20.416 m	12.248 m

LOAD RATING (LOAD FACTOR)		
INVENTORY	MS 28.8	54.0 METRIC TONS
OPERATING	MS 42.8	86.5 METRIC TONS

HYDRAULIC DATA			
DRAINAGE AREA	124.96 km ²	BASIC FLOOD	DESIGN FLOOD
RECURRENCE INTERVAL (YEARS)	100	100	50
PEAK DISCHARGE (m ³ /s)	107.6	87.8	
HIGH WATER ELEVATION AT POINT OF MAX. BACKWATER	EXISTING	116.12	115.89
	PROPOSED	116.12	115.89
AVG. VELOCITY THRU STRUCTURE @ DESIGN FLOOD = 3.95 m/s			

BIN 3-30639-0
ALL DIMENSIONS ARE IN MM UNLESS OTHERWISE NOTED
AS BUILT REVISIONS

Lawrence E. Attanasio 9/2003
SIGNATURE DATE




COUNTY ROAD 18 OVER POULTNEY RIVER
PLAN AND ELEVATION

WASHINGTON COUNTY
DEPARTMENT OF PUBLIC WORKS

FILENAME 175376AA.GIA	REGION ONE	DATE 3/2002	DRAWING NO. ST-1
--------------------------	---------------	----------------	---------------------

NOTE
INDEX OF BRIDGE DRAWINGS ON IN-1

FED ROAD REG. NO.	STATE	CONTRACT NO.	SHEET NO.	TOTAL SHEETS
1	N.Y.		18	43
COUNTY ROAD 18 OVER POULTNEY RIVER				
WASHINGTON COUNTY, NY / RUTLAND COUNTY, VT				
TOWN OF HAMPTON, NY / POULTNEY, VT				
CAPITAL PROJECT IDENTIFICATION NO. 175376				

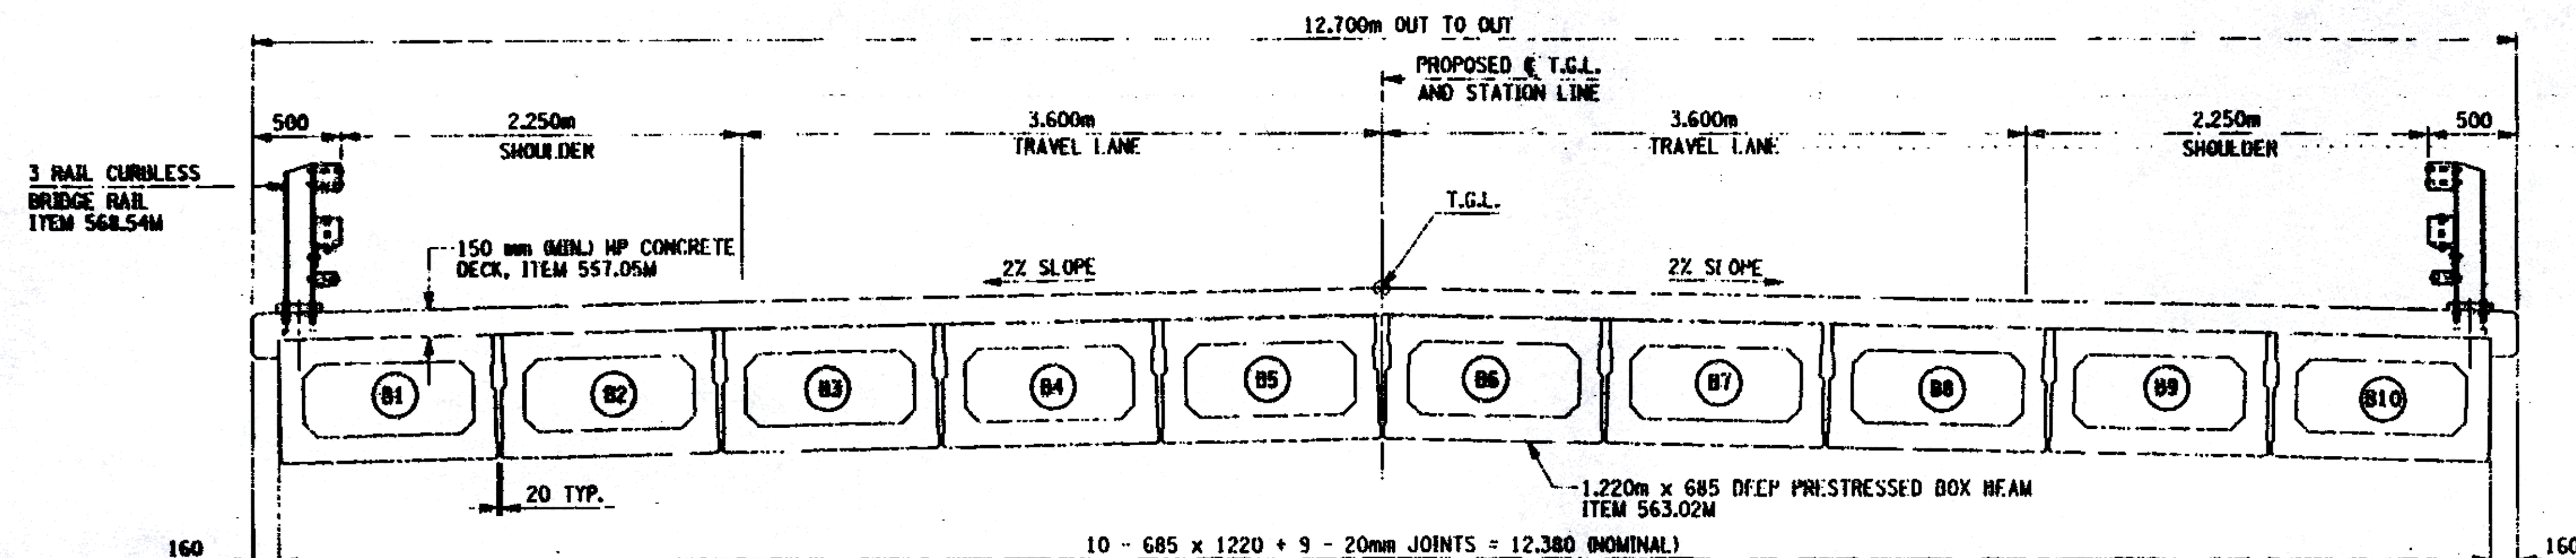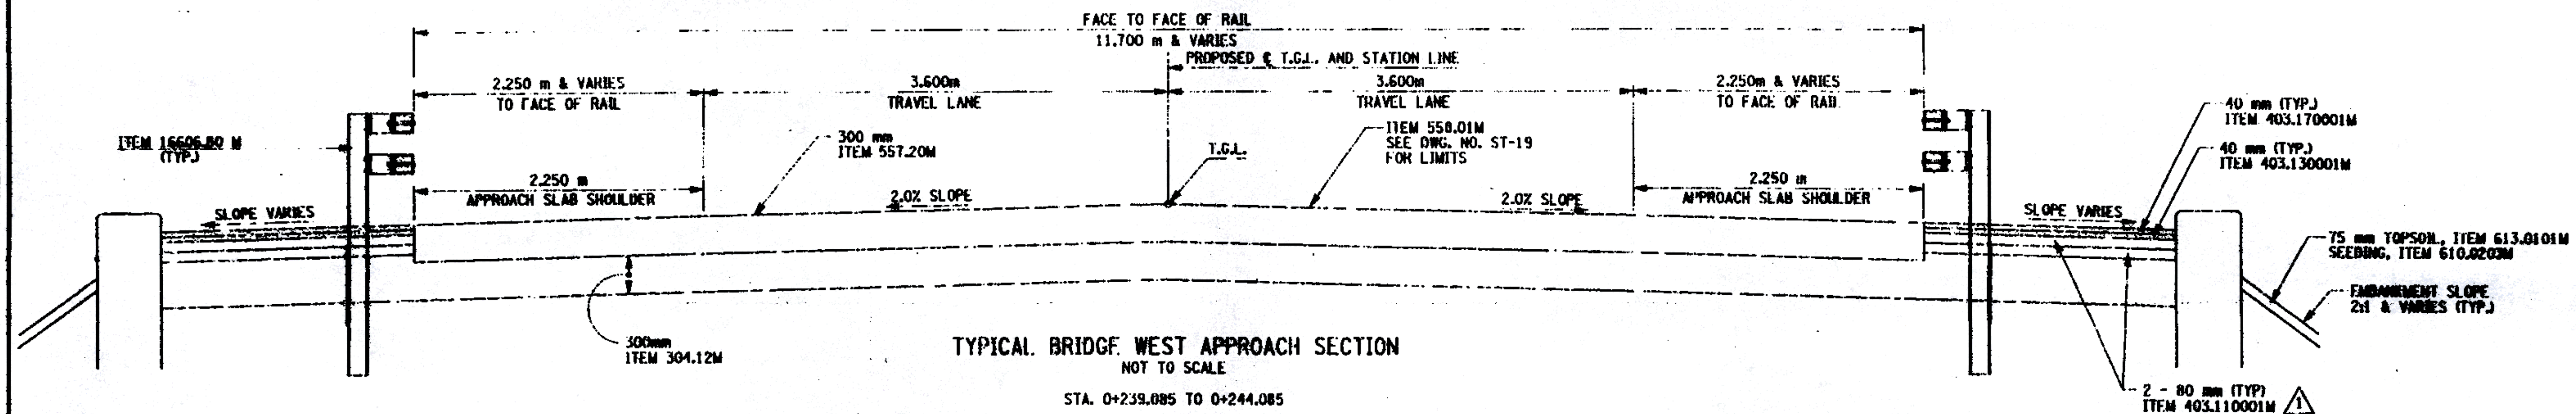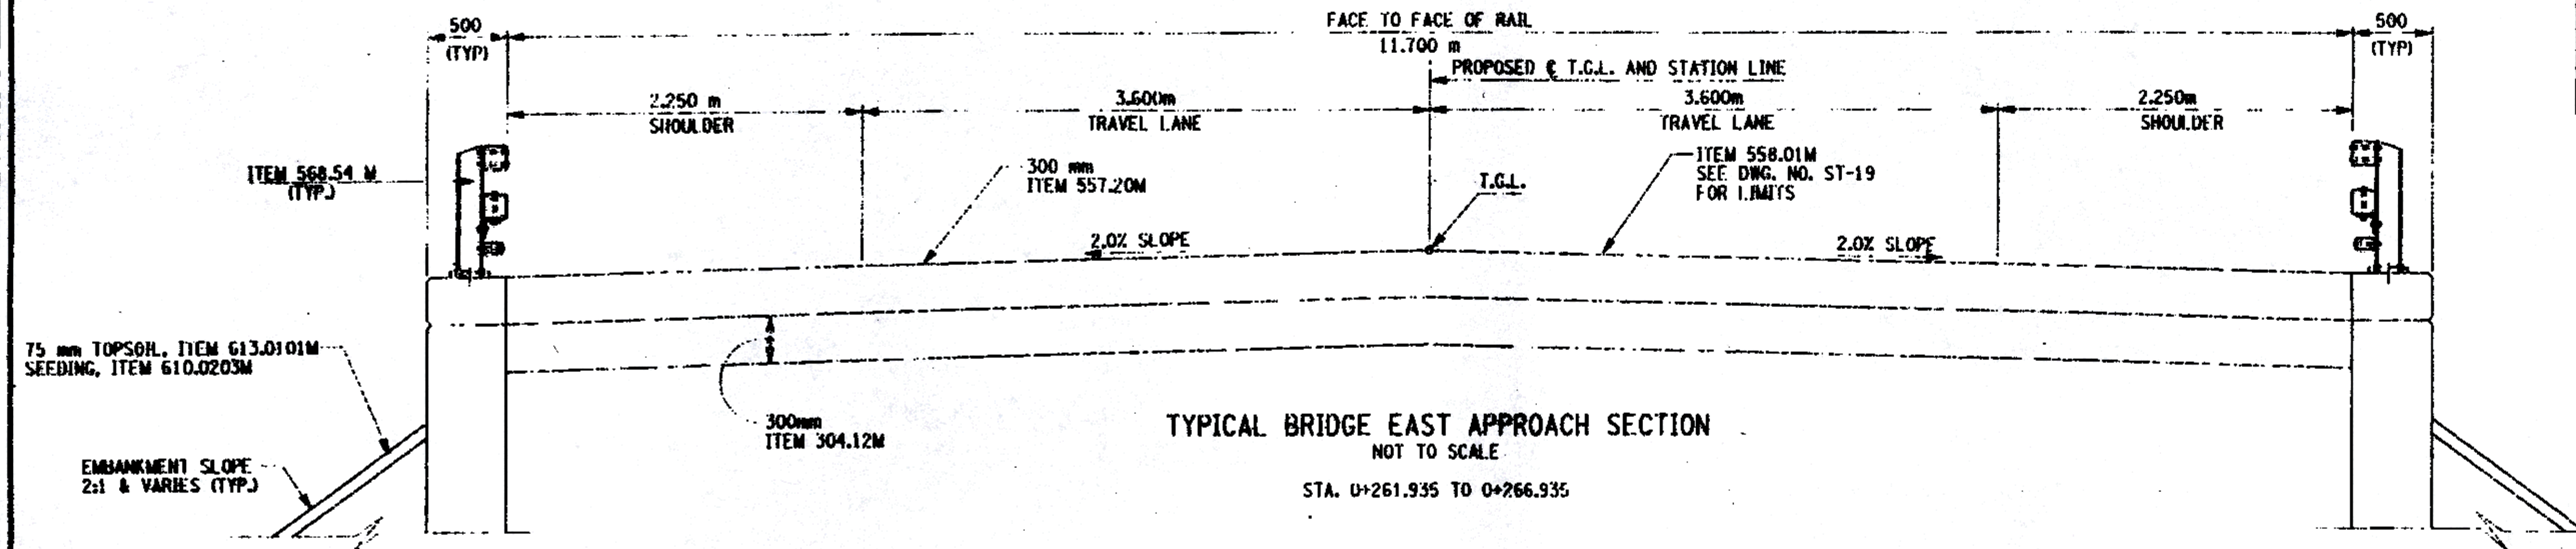

⚠ AS BUILT: REVISIONS 9/2003

ALL DIMENSIONS ARE IN mm UNLESS OTHERWISE NOTED
AS BUILT REVISIONS

Signature: E. Stevens 9/2003
SIGNATURE DATE

COUNTY ROAD 18 OVER POULINEY RIVER
TYPICAL BRIDGE SECTIONS

WASHINGTON COUNTY
DEPARTMENT OF PUBLIC WORKS

		DEPARTMENT OF PUBLIC WORKS	
FILENAME 175376AA.G1E	REGION ON:	DATE 3/2002	DRAWING NO. ST-2

NOTES:
1. FOR ADDITIONAL DETAILS SEE DWG NO. TS-1.

TYPICAL BRIDGE SECTION
NOT TO SCALE
STA. 0+244.085 TO 0+261.935

```
FILE NAME = I:\work\42087\CADD\AsBuilts\175376A.AGE
DATE/TIME = 11/30/2003  3:59:36 AM
USER = BGN
```

CHECKED BY SKY

03:3426
NITE

ESTIMATED SV EKT

✓ CHECKED 5-1-67

~~TX3~~ DESIGNED BY EXT

371 HEDYATM 601

GA SUPERVISOR TJC

GENERAL NOTES

DESIGN SPECIFICATIONS: NEW YORK STATE DEPARTMENT OF TRANSPORTATION STANDARD SPECIFICATIONS FOR HIGHWAY BRIDGES WITH ALL PROVISIONS IN EFFECT AS OF 04/2002. (FOR DESIGN PURPOSES, COMPRESSIVE STRENGTH OF CONCRETE FOR SUBSTRUCTURES AND DECK SLABS AT 28 DAYS: $f'_c = 21$ MPa)

LIVE LOAD: MS23

CONSTRUCTION AND MATERIALS SPECIFICATIONS: STANDARD SPECIFICATIONS, CONSTRUCTION AND MATERIALS, NEW YORK STATE DEPARTMENT OF TRANSPORTATION, OFFICE OF ENGINEERING, DATED JANUARY 2, 1995 WITH CURRENT ADDITIONS AND MODIFICATIONS.

ALL SHOP DRAWINGS SUBMITTED FOR THIS PROJECT SHALL BE IN SI UNITS.

THE COST OF WATER USED FOR COMPACTION OF SELECT FILL ITEMS SHALL BE INCLUDED IN THE UNIT PRICE BID FOR ITEM 203.21M - SELECT STRUCTURAL FILL.

THE COST OF ALL JOINT MATERIAL SHALL BE INCLUDED IN THE UNIT PRICES BID FOR THE VARIOUS ITEMS OF THE CONTRACT, UNLESS OTHERWISE SPECIFIED ON THE PLANS.

THE LOAD RATINGS ARE IN ACCORDANCE WITH THE AASHTO "MANUAL FOR CONDITION EVALUATION OF BRIDGES - 1994" WITH ALL INTERIM PROVISIONS IN EFFECT.

THIS BRIDGE SHALL BE MAINTAINED IN ACCORDANCE WITH THE GUIDELINES CONTAINED IN THE CURRENT EDITION OF THE AASHTO MANUAL FOR BRIDGE MAINTENANCE.

HIGH VOLTAGE ELECTRICAL LINES ARE IN PROXIMITY TO THIS BRIDGE. REFER TO THE ELECTRICAL SAFETY NOTE CONTAINED IN THE CONTRACT PROPOSAL FOR SPECIAL CONTRACTOR SAFETY REQUIREMENTS.

THE CONTRACTOR SHALL BE RESPONSIBLE FOR THE COST OF TESTING ALL MATERIALS. TESTING OF MATERIALS SHALL BE PERFORMED BY AN INDEPENDENT TESTING LABORATORY APPROVED BY THE ENGINEER. TESTING SHALL CONFORM TO THE APPLICABLE ASTM AND NYSDOT STANDARDS. THE TESTING LABORATORY SHALL SUBMIT A WRITTEN REPORT DESCRIBING THE TESTS PERFORMED, THE RESULTS OF SUCH TESTS, AND A STATEMENT OF COMPLIANCE OR NON-COMPLIANCE OF THE SPECIFICATION TO THE CONTRACTOR AND THE ENGINEER. MATERIAL TESTING SHALL BE IN ACCORDANCE WITH THE TECHNICAL PROVISION SECTION OF THE SPECIFICATIONS AND CONTRACT DOCUMENTS.

IF THE STRUCTURE HAS A BRIDGE IDENTIFICATION NUMBER (B.I.N.) PLATE ATTACHED, IT SHALL BE THE CONTRACTOR'S RESPONSIBILITY TO PROTECT IT DURING CONSTRUCTION OR REMOVE AND REMOUNT IT AFTER CONSTRUCTION IS COMPLETED.

STREAM PROTECTION NOTES

THE POULTNEY RIVER IS CLASSIFIED AS A CLASS C(I) WATERBODY AT THIS LOCATION

DURING THE COURSE OF CONSTRUCTION, THE CONTRACTOR SHALL CONDUCT OPERATIONS IN SUCH A MANNER AS TO PREVENT ANY DAMAGE TO ANY STREAM FROM POLLUTION BY DEBRIS, SEDIMENTATION OR OTHER FOREIGN MATERIAL, OR FROM THE MANIPULATION OF EQUIPMENT AND/OR MATERIALS IN OR NEAR SUCH STREAMS. NO WATER SHALL BE RETURNED DIRECTLY TO THE STREAM WHICH HAS BEEN USED FOR WASH PURPOSES OR OTHER SIMILAR OPERATIONS WHICH CAUSE THE WATER TO BE CONTAMINATED WITH SAND, SILT, CEMENT, OIL, OR OTHER IMPURITIES. IF THE CONTRACTOR USES THE WATER FROM ANY STREAM, THEY SHALL CONSTRUCT AN INTAKE OR TEMPORARY DAM AS REQUIRED TO PROTECT AND MAINTAIN WATER RIGHTS AND SUSTAIN FISH LIFE DOWNSTREAM.

SHOULD FIELD CONDITIONS REQUIRE A CHANGE FROM THE TYPE OF COFFERDAM SYSTEM CALLED FOR ON THE PLANS, THE ENGINEER-IN-CHARGE SHALL CONTACT THE CONSULTANT FOR COORDINATION WITH APPROPRIATE AGENCIES TO APPROVE THE CHANGE.

DEWATERING OF THE COFFERDAM SHALL BE ACCOMPLISHED BY PUMPING THE WATER TO AN APPROVED UPLAND VEGETATED AREA OUTSIDE OF THE STREAMBED AS APPROVED BY THE E.I.C. TEMPORARY SOIL EROSION AND WATER POLLUTION CONTROL, SUCH AS HAY BALES OR APPROVED EQUIVALENT, MAY BE REQUIRED AS DETERMINED BY THE ENGINEER-IN-CHARGE. NO SETTLEMENT BASIN SHALL BE CONSTRUCTED.

ORDINARY HIGH WATER IS ESTIMATED TO BE 115.30 m. THIS IS DEFINED AS THE WATER SURFACE ELEVATION FOR THE MEAN ANNUAL FLOOD, WHICH IS THE FLOOD THAT HAS A RECURRENCE INTERVAL OF 2.33 YEARS.

ORDINARY WATER IS ESTIMATED TO BE 115.00 m. THIS IS DEFINED AS THE HIGHEST SURFACE WATER ELEVATION LIKELY TO BE ENCOUNTERED DURING ONE CONSTRUCTION SEASON (OTHER THAN MAJOR FLOODS). IT IS ALWAYS LESS THAN THE ORDINARY HIGH WATER ELEVATION AND IT IS USUALLY AN OBSERVED ELEVATION RATHER THAN A COMPUTED ONE.

LOW WATER IS ESTIMATED TO BE 114.30 m. THIS WATER ELEVATION IS THE NORMAL LOW WATER ELEVATION PREVALENT DURING ONE CONSTRUCTION SEASON FOR MORE THAN 25% OF THE TIME. IT IS AN OBSERVED ELEVATION RATHER THAN A COMPUTED ONE.

FOUNDATION NOTES

SPREAD FOOTINGS FOR ABUTMENTS, WINGWALLS, AND U-WALLS ARE DESIGNED TO BEAR ON ROCK AND TO EXERT A MAXIMUM BEARING PRESSURE OF 1.0 MPa.

SPREAD FOOTINGS FOR ABUTMENTS, WINGWALLS, AND U-WALLS ARE DESIGNED USING A COEFFICIENT OF SLIDING FRICTION OF 0.60 BETWEEN THE FOOTING CONCRETE AND ROCK.

REMOVE ALL SOFT, WEATHERED ROCK AT THE PROPOSED BOTTOM OF FOOTING ELEVATION.

IF THE ROCK SURFACE IS WITHIN 0.600m OF THE PROPOSED BOTTOM OF FOOTING ELEVATION:

- REMOVE HIGH ROCK TO BOTTOM OF FOOTING ELEVATION, AND/OR
- BACKFILL LOW AREAS TO BOTTOM OF FOOTING ELEVATION WITH CLASS A CONCRETE

IF THE ROCK SURFACE IS MORE THAN 0.600m FROM THE PROPOSED BOTTOM OF FOOTING ELEVATION, NOTIFY THE ENGINEER.

AT EACH SUBSTRUCTURE, THE ENGINEER WILL BE REQUIRED TO INSPECT THE ROCK TO VERIFY IT IS COMPETENT TO SUPPORT THE DESIGN BEARING PRESSURE.

SUBSTRUCTURE NOTES

ALL PLACEMENTS OF SELECT STRUCTURE FILL, ITEM 203.21 M, SHALL BE COMPACTED TO 95 PERCENT OF STANDARD PROCTOR MAXIMUM DENSITY.

HIGHWAY EMBANKMENT MATERIAL AND SELECT STRUCTURE FILL, ITEM 203.21 M, SHALL BE PLACED SIMULTANEOUSLY, IN CONTACT, ON BOTH SIDES OF THE VERTICAL PAYMENT LINE.

WHERE A COFFERDAM IS USED, THE COST OF DEWATERING THE ENTIRE EXCAVATION, REGARDLESS OF SOURCE OF WATER, SHALL BE INCLUDED IN THE UNIT PRICE BID FOR THE COFFERDAM ITEM.

TOP OF BACKWALLS SHALL BE STEEL TROWEL FINISHED. SHEET GASKET (TREATED BOTH SIDES), 728-06, SHALL BE PLACED ON THE TOP OF THE BACKWALLS OF EXPANSION ABUTMENTS ONLY. TWO SHEETS SHALL BE USED; PAYMENT SHALL BE INCLUDED IN THE UNIT PRICE BID FOR THE APPROACH SLAB ITEM.

THE FOLLOWING CONCRETE ELEMENTS SHALL BE SEALED ACCORDING TO ITEM 18559.1896 M - PROTECTIVE SEALING OF STRUCTURAL CONCRETE: THE TOTAL AREA OF THE NEW CONCRETE BRIDGE SEATS INCLUDING AREAS UNDER THE BEARINGS, THE FRONT FACE OF THE ABUTMENTS, U-WALLS, AND WINGWALLS, THE VERTICAL FACES OF THE CURTAIN WALLS, AND TOP SURFACES OF THE CURTAIN WALLS, U-WALL, AND WINGWALLS.

REMOVAL NOTES

EXISTING SUBSTRUCTURE SHALL BE REMOVED WITHIN THE LIMITS SHOWN ON THE PLANS UNDER ITEM 202.19 M.

EXISTING SUPERSTRUCTURE SHALL BE REMOVED UNDER ITEM 202.120001 M.

THE CONTRACTOR'S ATTENTION IS DIRECTED TO THE REQUIREMENTS OF SUBSECTION 202-3.01 GENERAL AND SAFETY REQUIREMENTS. A REMOVAL PLAN, SIGNED BY A REGISTERED PROFESSIONAL ENGINEER IN THE STATE OF NEW YORK, SHALL BE SUBMITTED TO THE ENGINEER THIRTY (30) DAYS PRIOR TO BEGINNING THE DEMOLITION.

RECORD PLANS FOR THIS STRUCTURE ARE AVAILABLE AT THE OFFICE OF THE WASHINGTON COUNTY DEPARTMENT OF PUBLIC WORKS.

WHENEVER ITEMS IN THE CONTRACT REQUIRE MATERIALS TO BE REMOVED AND DISPOSED OF, THE COST OF SUPPLYING A DISPOSAL AREA AND TRANSPORTATION TO THAT AREA SHALL BE INCLUDED IN THE UNIT PRICES BID FOR THOSE ITEMS.

DURING REMOVAL OPERATIONS, THE CONTRACTOR SHALL NOT BE ALLOWED TO DROP WASTE CONCRETE, DEBRIS AND OTHER MATERIAL TO THE AREA BELOW THE BRIDGE EXCEPT WHERE THE PLANS SPECIFICALLY PERMIT THE DROPPING OF MATERIAL. PLATFORMS, NETS, SCREENS OR OTHER PROTECTIVE DEVICES SHALL BE USED TO CATCH THE MATERIAL. IF THE ENGINEER DETERMINES THAT ADEQUATE PROTECTIVE DEVICES ARE NOT BEING EMPLOYED, THE WORK SHALL BE SUSPENDED UNTIL ADEQUATE PROTECTION IS PROVIDED.

ALL MATERIAL FALLING ON THE AREA BELOW AND ADJACENT TO THE BRIDGE SHALL BE REMOVED AND DISPOSED OF BY THE CONTRACTOR AT NO COST TO THE OWNER.

THE COST OF FURNISHING, INSTALLING, MAINTAINING, REMOVING AND DISPOSING OF ALL PLATFORMS, NETS, SCREENS OR OTHER PROTECTIVE DEVICES SHALL BE INCLUDED IN THE UNIT PRICES BID FOR THE APPROPRIATE ITEMS OF THE CONTRACT.

SUPERSTRUCTURE (OR SUBSTRUCTURE) REMOVAL NOTES:

LIMITS AND METHODS FOR REMOVAL OF PAINT AT LOCATIONS OF FASTENER REMOVAL OR FLAME CUTTING SHALL BE AS DESCRIBED IN SUBSECTIONS 202-3.05 AND 741-01 OF THE STANDARD SPECIFICATIONS. PAINT WASTE NOT COLLECTED BY VACUUM METHODS SHALL BE COLLECTED USING AN ENVIRONMENTAL GROUND AND/OR WATERWAY PROTECTION SYSTEM THE COST OF PAINT REMOVAL, PAINT COLLECTION/PROTECTION AND DISPOSAL OF PAINT REMOVAL WASTE SHALL BE INCLUDED IN THE LUMP SUM PRICE(S) BID FOR THE SUPERSTRUCTURE REMOVAL ITEM(S) OR THE UNIT PRICE BID FOR THE SUBSTRUCTURE REMOVAL ITEM.

LOOSE AND/OR PELLING PAINT ON STEEL SURFACES MAY BECOME DISLOOSED DURING REMOVAL OPERATIONS OR DURING TRANSPORTATION FROM THE SITE UNLESS APPROPRIATE MEASURES ARE TAKEN. THE CONTRACTOR SHALL FORMULATE AND SUBMIT A METHOD OF REMEDIATING THE CONDITION FOR APPROVAL BY THE ENGINEER. WORKER LEAD PROTECTION IN ACCORDANCE WITH OSHA 1926.62 MUST BE SATISFIED. ALTERNATIVES COULD INCLUDE TRANSPORTING AFFECTED MEMBERS IN CLOSED TRUCKS, WRAPPING AFFECTED MEMBERS PRIOR TO REMOVAL, ENCAPSULATING THE LOOSE PAINT OR REMOVAL OF LOOSE PAINT PRIOR TO DISMANTLING OPERATIONS. THE COST OF REMEDIATING THIS CONDITION SHALL BE INCLUDED IN THE LUMP SUM PRICE(S) BID FOR THE SUPERSTRUCTURE REMOVAL ITEM(S) OR THE UNIT PRICE BID FOR THE SUBSTRUCTURE REMOVAL ITEM(S) BECAUSE OF THE ABOVE-MENTIONED CONDITION, THE CONTRACTOR SHOULD EXAMINE THE CONDITION OF THE STRUCTURE'S PAINT PRIOR TO SUBMITTING A BID.

THE FOLLOWING ITEMS SHALL BE USED TO IMPLEMENT AND MAINTAIN EFFECTIVE HEALTH AND SAFETY CONTROLS COST INCLUDED IN THE LUMP SUM PRICE(S) BID FOR THE SUPERSTRUCTURE REMOVAL ITEM(S):

LEAD HEALTH AND SAFETY PROGRAM
LEAD EXPOSURE CONTROL PLAN
MEDICAL TESTING AND EXPOSURE MONITOR SAMPLE ANALYSIS
DECONTAMINATION FACILITIES

SUPERSTRUCTURE NOTES

TOP SURFACES OF NEW BRIDGE DECKS AND APPROACH SLABS SHALL BE SEALED ACCORDING TO ITEM 18559.1896 M - PROTECTIVE SEALING OF STRUCTURAL CONCRETE ON NEW BRIDGE DECKS AND BRIDGE DECK OVERLAYS.

CONCRETE PLACEMENT AND FINISHING OPERATIONS SHALL BE PERFORMED AS RAPIDLY AS POSSIBLE. THE ENGINEER MAY ORDER THE CONTRACTOR TO STOP PLACEMENT OPERATIONS AT ANY TIME IF, IN THE ENGINEER'S OPINION, CONCRETE PLACED DURING THE PLACEMENT HAS STARTED TO SET, OR IS ABOUT TO SET, AND FURTHER PLACEMENT OF CONCRETE WILL CAUSE DEFLECTION CRACKING.

LONGITUDINAL CONSTRUCTION JOINTS WILL NOT BE PERMITTED.

FINISHING MACHINE(S) SHALL BE OPERATED AS CLOSE TO THE SKEW ANGLE AS PRACTICABLE.

WET BURLAP CURING BLANKETS ARE REQUIRED TO BE PLACED ON THE CONCRETE DECK WITHIN 30 MINUTES OF THE CONCRETE BEING DEPOSITED INTO THE FORMS OR 5 MINUTES AFTER FINISHING, WHICHEVER COMES FIRST. THE PLACEMENT OF THE TUFF DRAG TEXTURE SHALL NOT INTERFERE WITH THESE REQUIREMENTS.

IN THE EVENT THE CONTRACTOR'S DECK PLACEMENT OPERATION IS STOPPED PRIOR TO COMPLETION, WHETHER BY THE CONTRACTOR'S OWN DECISION OR BY ORDER OF THE ENGINEER, THE CONTRACTOR SHALL BE RESPONSIBLE FOR PROVIDING A FINISHED DECK GRADE WHICH MATCHES THE PLANNED PROFILE. ANY SUBSEQUENT REVISIONS TO DECK FORMS MADE NECESSARY BY SUCH ACTION SHALL BE AT THE CONTRACTOR'S EXPENSE.

AS BUILT: NO REVISIONS 9/2003

ALL DIMENSIONS ARE IN mm UNLESS OTHERWISE NOTED
AS BUILT REVISIONS

Signature 9/2003
SIGNATURE DATE

COUNTY ROAD 18 OVER POULTNEY RIVER

GENERAL NOTES

WASHINGTON COUNTY
DEPARTMENT OF PUBLIC WORKS

EARTH SYSTEM

FILE NAME	REGION	DATE	DRAWING NO.
175376AAJ11U	ONE	3/2002	ST-3

AS BUILT: NO REVISIONS 9/2003

FED. ROAD REG. NO.	STATE	CONTRACT NO.	SHEET NO.	TOTAL SHEETS
1	N.Y.		34	43

COUNTY ROAD 18 OVER POULINNEY RIVER
WASHINGTON COUNTY, NY / RUTLAND COUNTY, VT
TOWN OF HAMPTON, NY / POULINNEY, VT
CAPITAL PROJECT IDENTIFICATION NO. 1753.76

NOTES:

PREMOULDED RESILIENT J.T. FILLER SHALL MEET THE REQUIREMENTS OF 705-07 AND BE PAID FOR UNDER BEARING ITEM.

THE ENDS OF BEAM AND ANCHOR DOWEL HOLES SHALL BE MADE VERTICAL ± 6 mm, UNDER D.I.L. AND GRADU. ANCHOR DOWELS TO BE PAID FOR UNDER BEARING ITEM. DOWEL HOLE FILL MATERIAL SHALL BE INCLUDED IN THE UNIT PRICE BID FOR ELASTOMERIC BEARING ITEM AND SHALL MEET MATERIAL REQUIREMENTS AS FOLLOWS:

EXPANSION END MATERIAL OPTION:

N.Y.S. MAT. SPEC. 702-0700 - ASPHALT FILLER
FED. MAT. SPEC. 55-5-00195B - ELASTOMERIC POLYMER TYPE, TWO-COMPONENT COLD APPLIED
FED. MAT. SPEC. 55-5-00200D - ELASTOMERIC POLYMER TYPE, TWO-COMPONENT JET FUEL RESISTANT, COLD APPLIED

FIXED END MATERIAL OPTION:


**N.Y.S. MAT. SPEC. 721-03 - EPOXY POLYSULFIDE GROUT WITH SAND
**N.Y.S. MAT. SPEC. 721-01 - EPOXY RESIN SYSTEM WITH SAND
N.Y.S. MAT. SPEC. 701-05 - CONCRETE GROUTING MATERIAL
N.Y.S. MAT. SPEC. 701-06 - CEMENT BASED GROUT MATERIALS FOR SHEAR KEYS

** - MOISTURE FREE, SAND/AST SAND SHALL BE ADDED IN THE RATIO OF (1) PART EPOXY TO (2) PARTS SAND.


INSTALLATION ALIGNMENT:

THE MAXIMUM VARIATION FROM PERFECT ALIGNMENT UNDER FULL DEAD LOAD SHALL NOT EXCEED 4 mm. THIS VARIATION SHALL BE MEASURED AS THE HORIZONTAL DISTANCE BETWEEN THE CENTERLINE OF THE HIGHEST ELASTOMER SURFACE AND THE CENTERLINE OF THE LOWEST ELASTOMER SURFACE.


CONCRETE SURFACES UNDER THE BEARINGS SHALL CONFORM TO SUBSECTION 565.3.02 "CONCRETE BEARING SURFACE PREPARATION" OF THE NEW YORK STATE STANDARD SPECIFICATIONS, CONSTRUCTION AND MATERIALS.

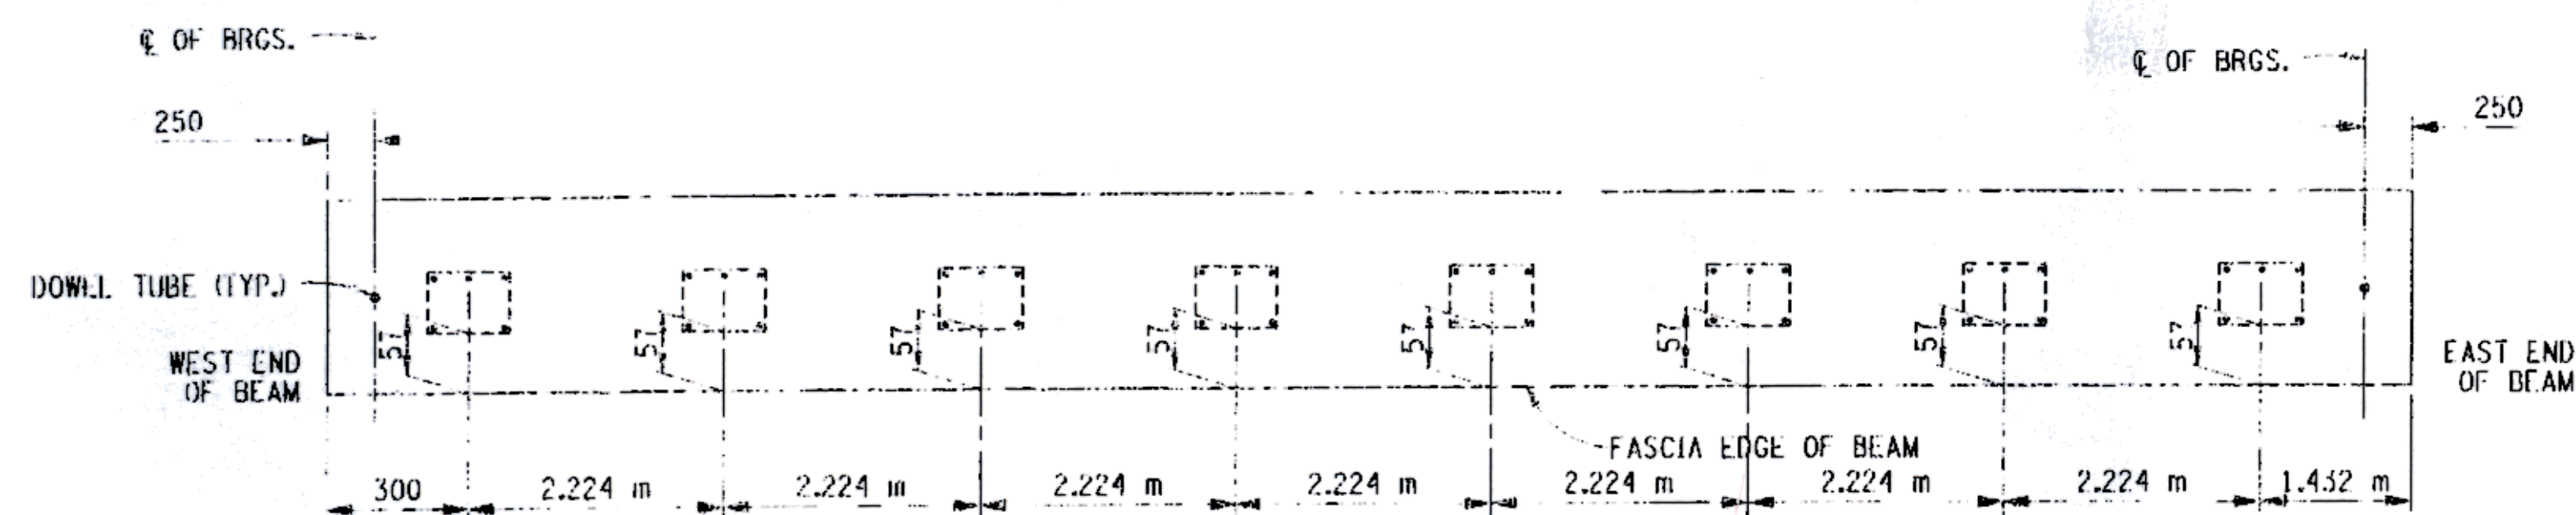


PLAN OF RAILING ANCHORAGE
NOT TO SCALE

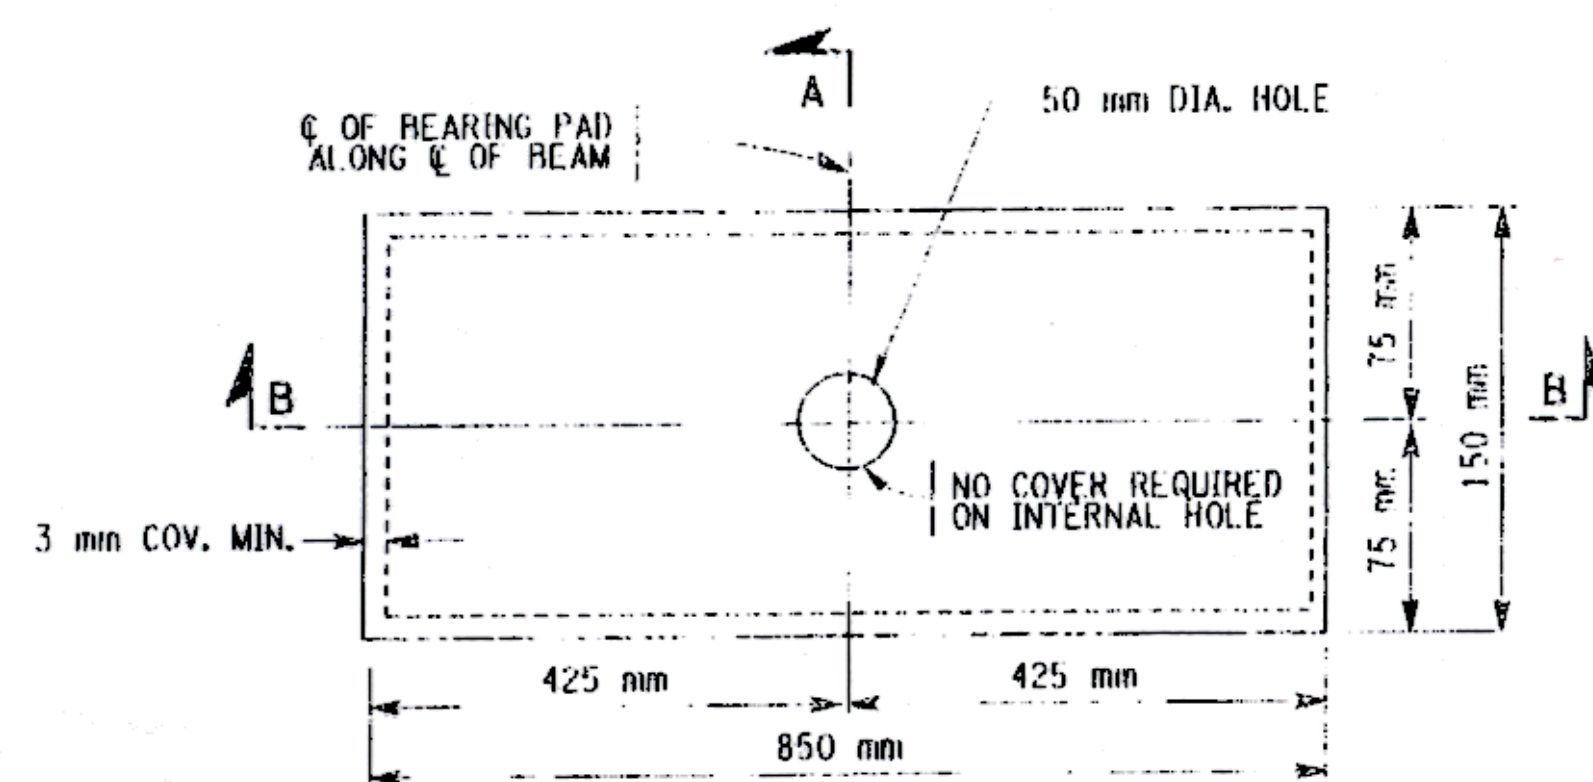


TYPICAL RECTANGULAR
STEEL LAMINATED ELASTOMERIC BEARING (TYPE E.L.)
PLAN
NOT TO SCALE

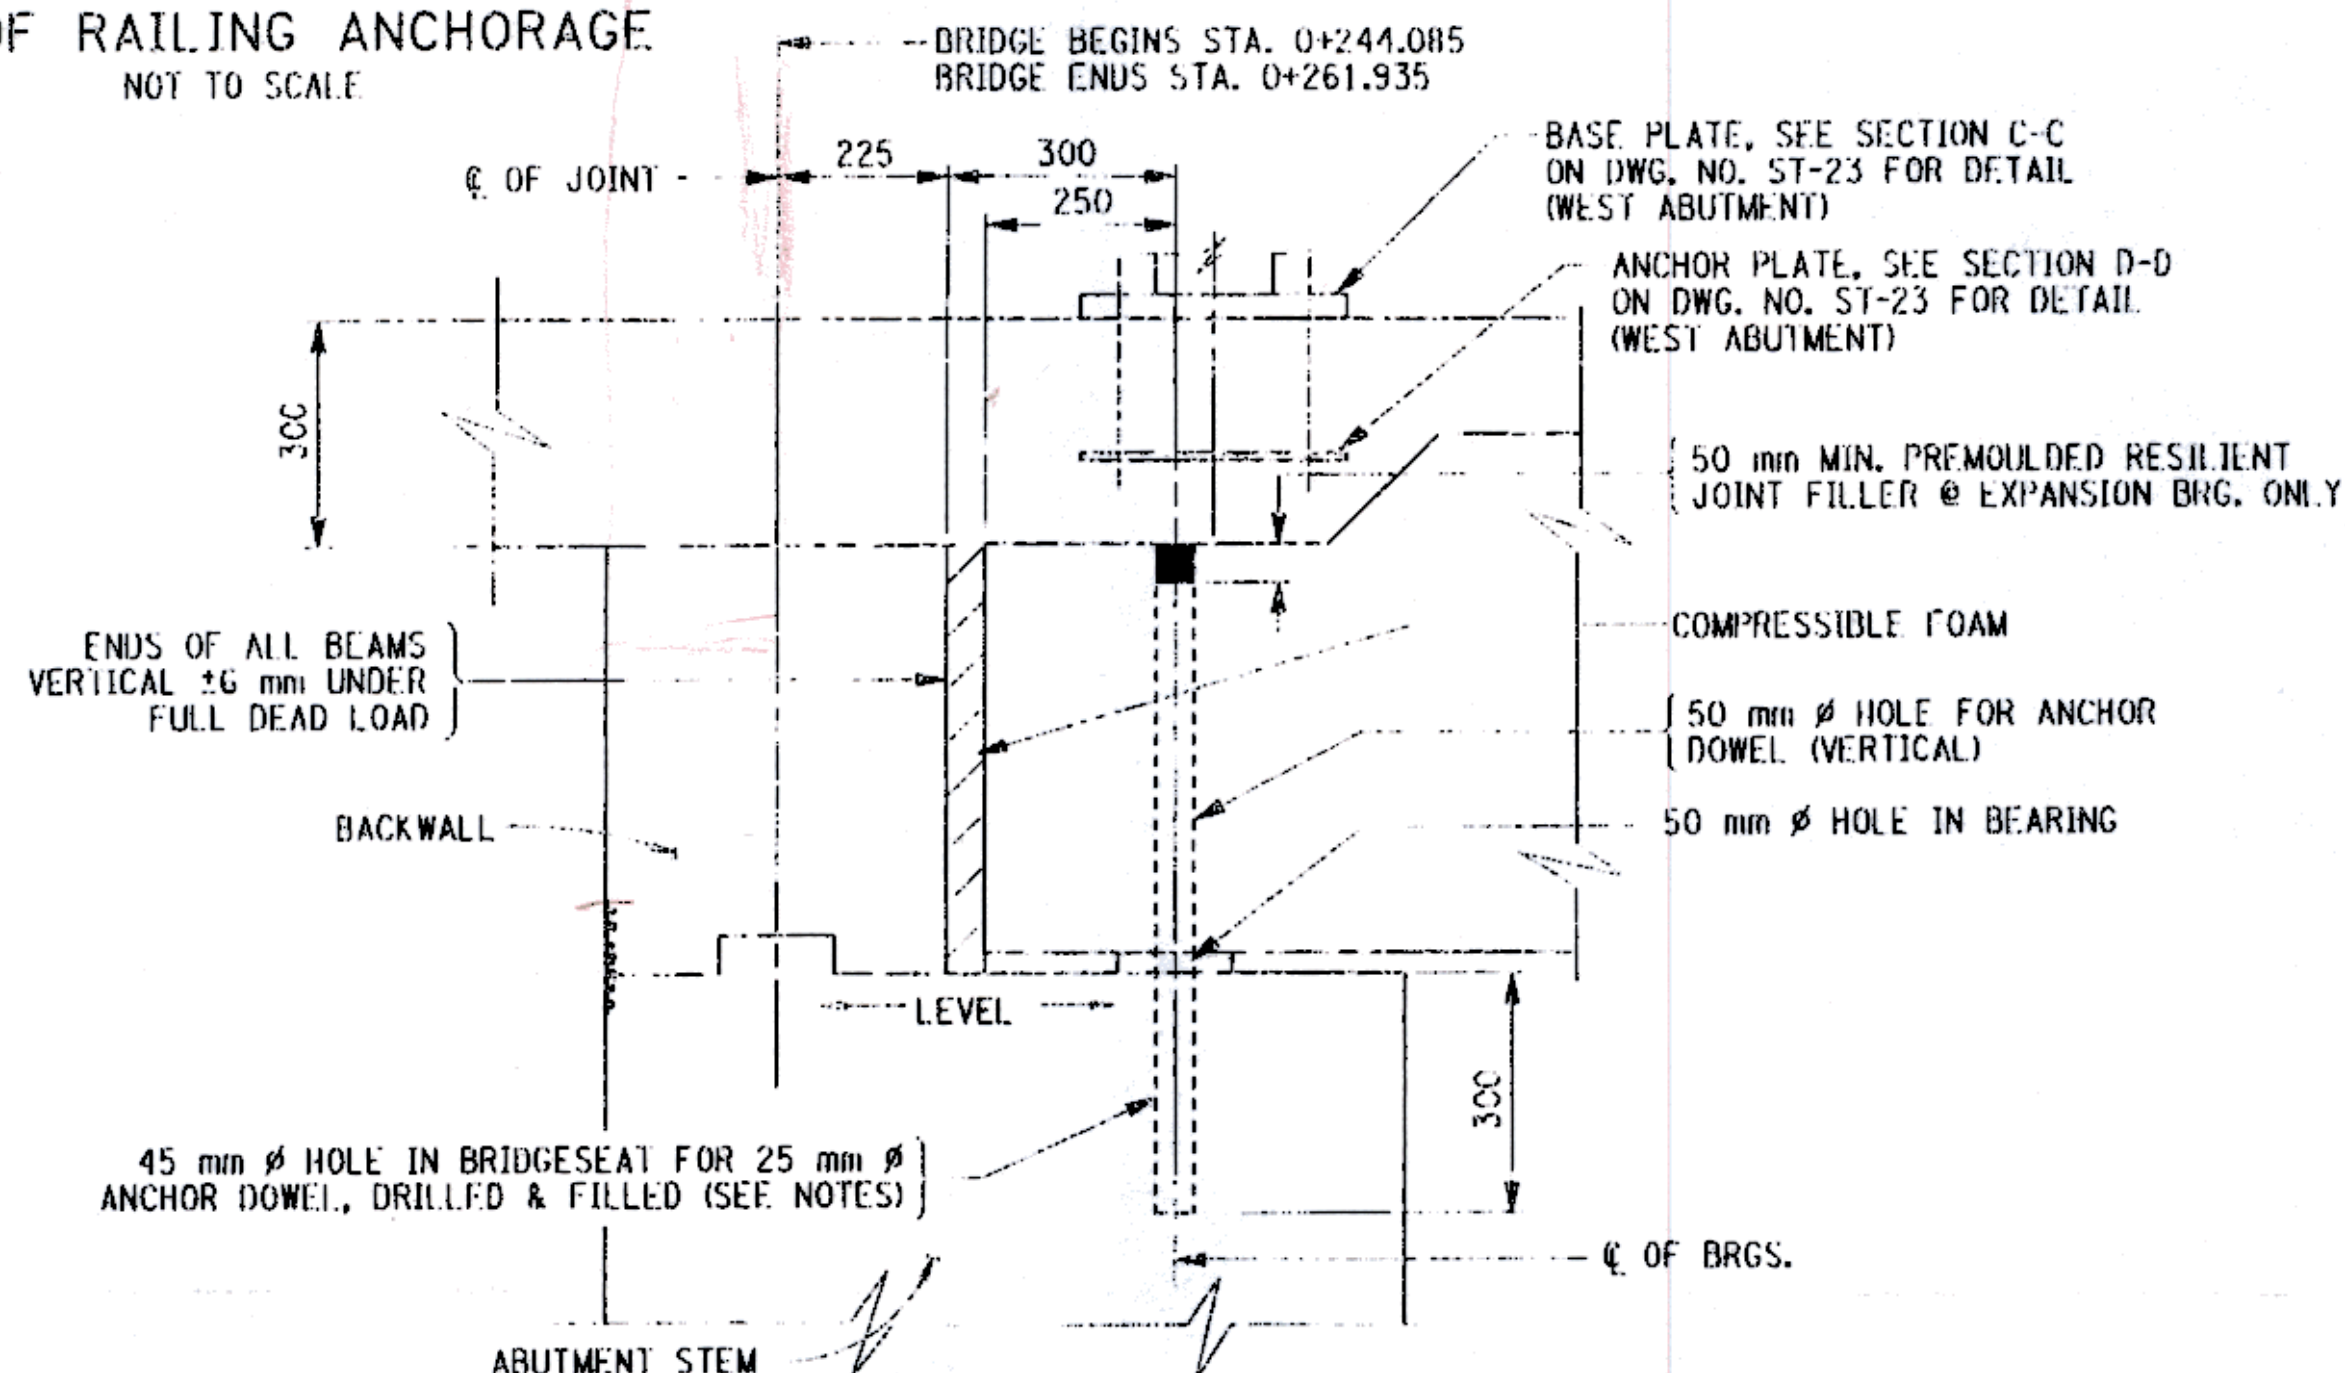


PARTIAL SECTION AT ABUTMENT
NOT TO SCALE

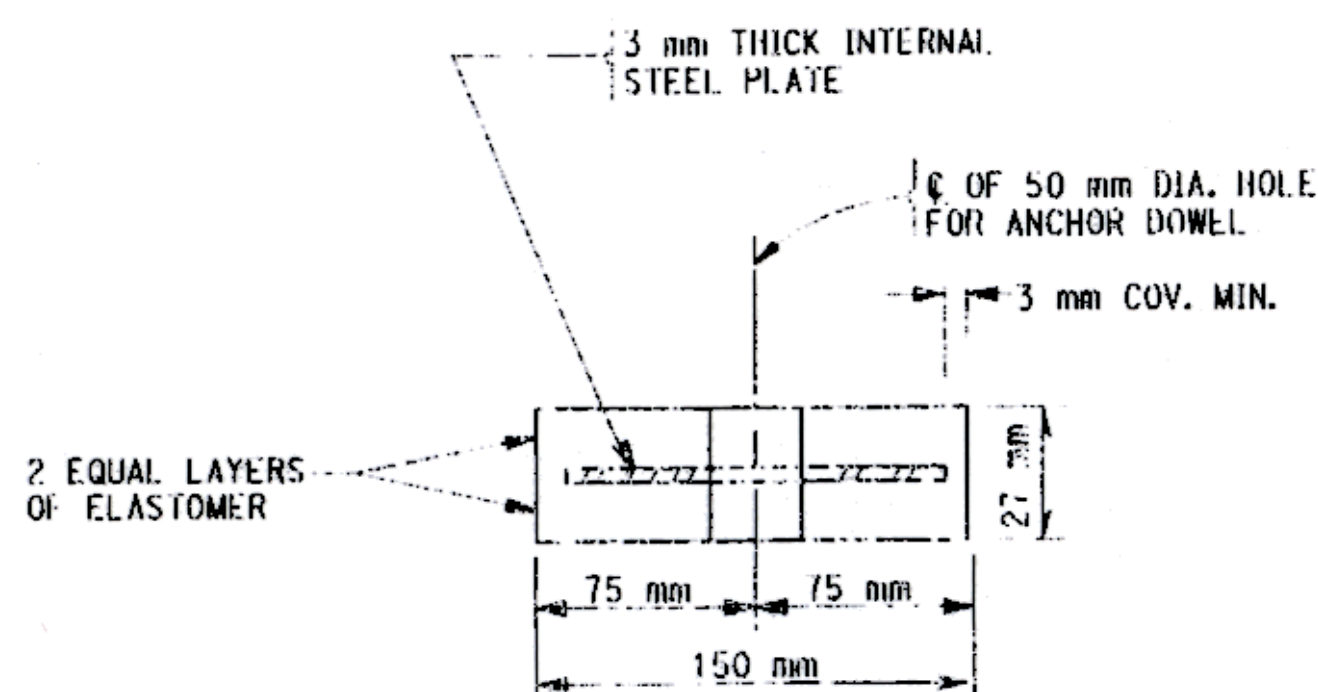

SECTION A-A
NOT TO SCALE

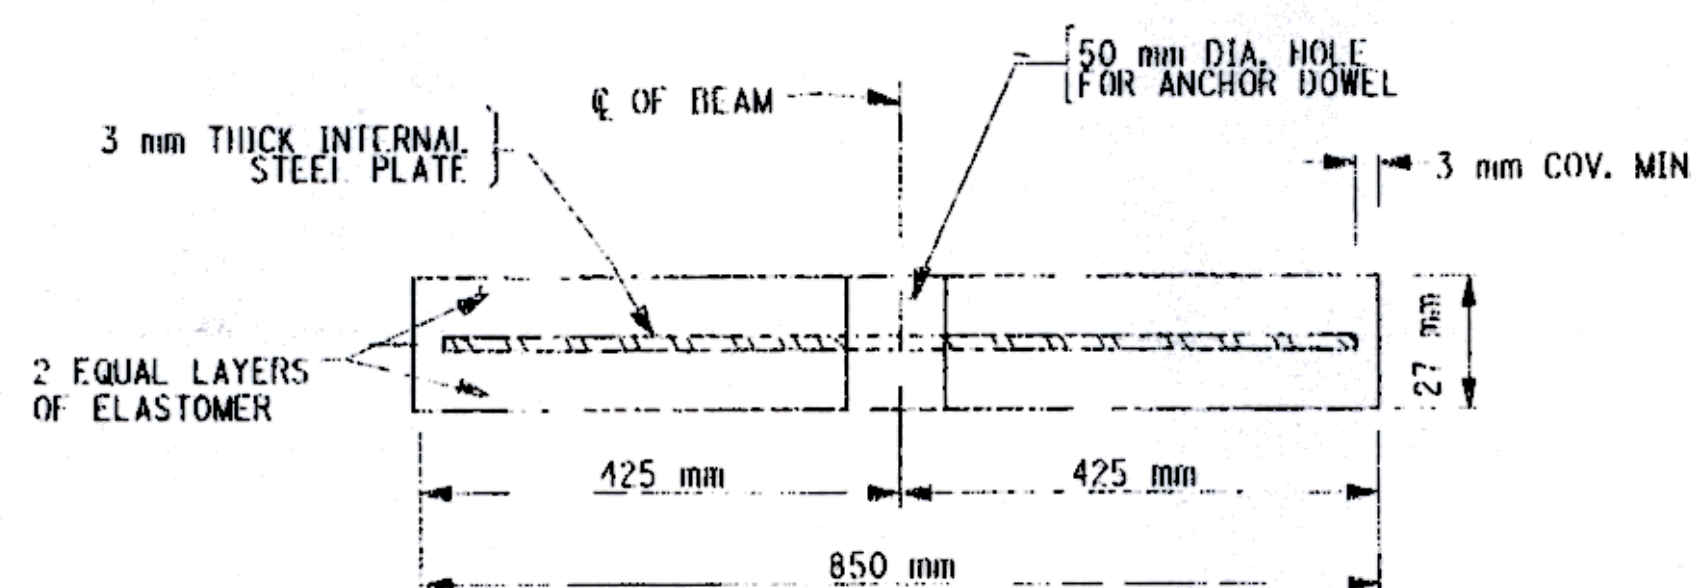

SECTION B-B
NOT TO SCALE

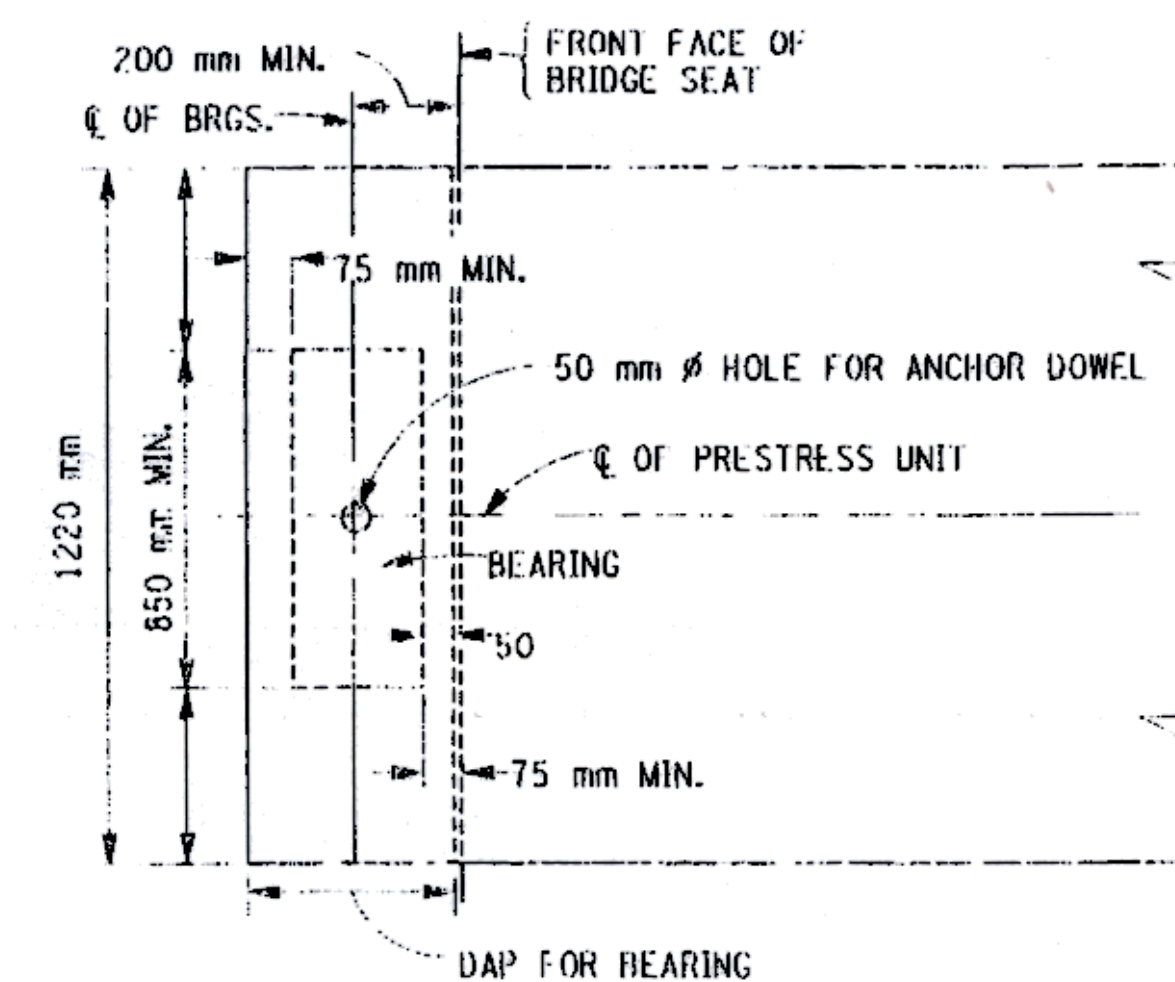

BEARING PLACEMENT DETAILS
NO SKEW
NOT TO SCALE

STEEL LAMINATED ELASTOMERIC BEARING (TYPE E.L.) TABLE

STEEL LAMINATED ELASTOMERIC BEARING (TYPE E.L.) TABLE																
LOCATION	FIX/ EXP.	ITEM NO.	QUANTITY REQUIRED	D.L. + S.D.L. (kN)	L.L. WITHOUT IMPACT (kN)	TOTAL DESIGN REACTION (kN)	SHAPE FACTOR	ELASTOMER LAYERS				h _{FT} (mm)	COMP. AREA (sq. mm)	SHEAR AREA (sq. mm)	BRG. H	ANCHOR DOWEL DIAMETER
								THK/LAYER	N LAYERS	L	W					
WEST ABUTMENT	EXP.	565.1922M	10	154.7	142.2	296.9	4.85	12	2	150	850	24	125,540	125,540	27	25 mm
EAST ABUTMENT	FIX	565.1922M	10	154.7	142.2	296.9	4.85	12	2	150	850	24	125,540	125,540	27	25 mm

ALL DIMENSIONS ARE IN mm UNLESS OTHERWISE NOTED

AS BUILT REVISIONS

Signature 9/2003
SIGNATURE DATE


COUNTY ROAD 18 OVER POULINNEY RIVER

ELASTOMERIC BEARING AND
BOX BEAM ANCHOR DOWEL/MISC. DETAILS

WASHINGTON COUNTY
DEPARTMENT OF PUBLIC WORKS

FILE NAME	REGION	DATE	DRAWING NO.
175376AA.Z1A	ONE	3/2002	ST-18

FED ROAD REG. NO.	STATE	CONTRACT NO.	SHEET NO.	TOTAL SHEETS
1	N.Y.		36	43
COUNTY ROAD 18 OVER POULTNEY RIVER				
WASHINGTON COUNTY, NY / RUTLAND COUNTY, VT				
TOWN OF HAMPTON, NY / POULTNEY, VT				
CAPITAL PROJECT IDENTIFICATION NO. 175376				

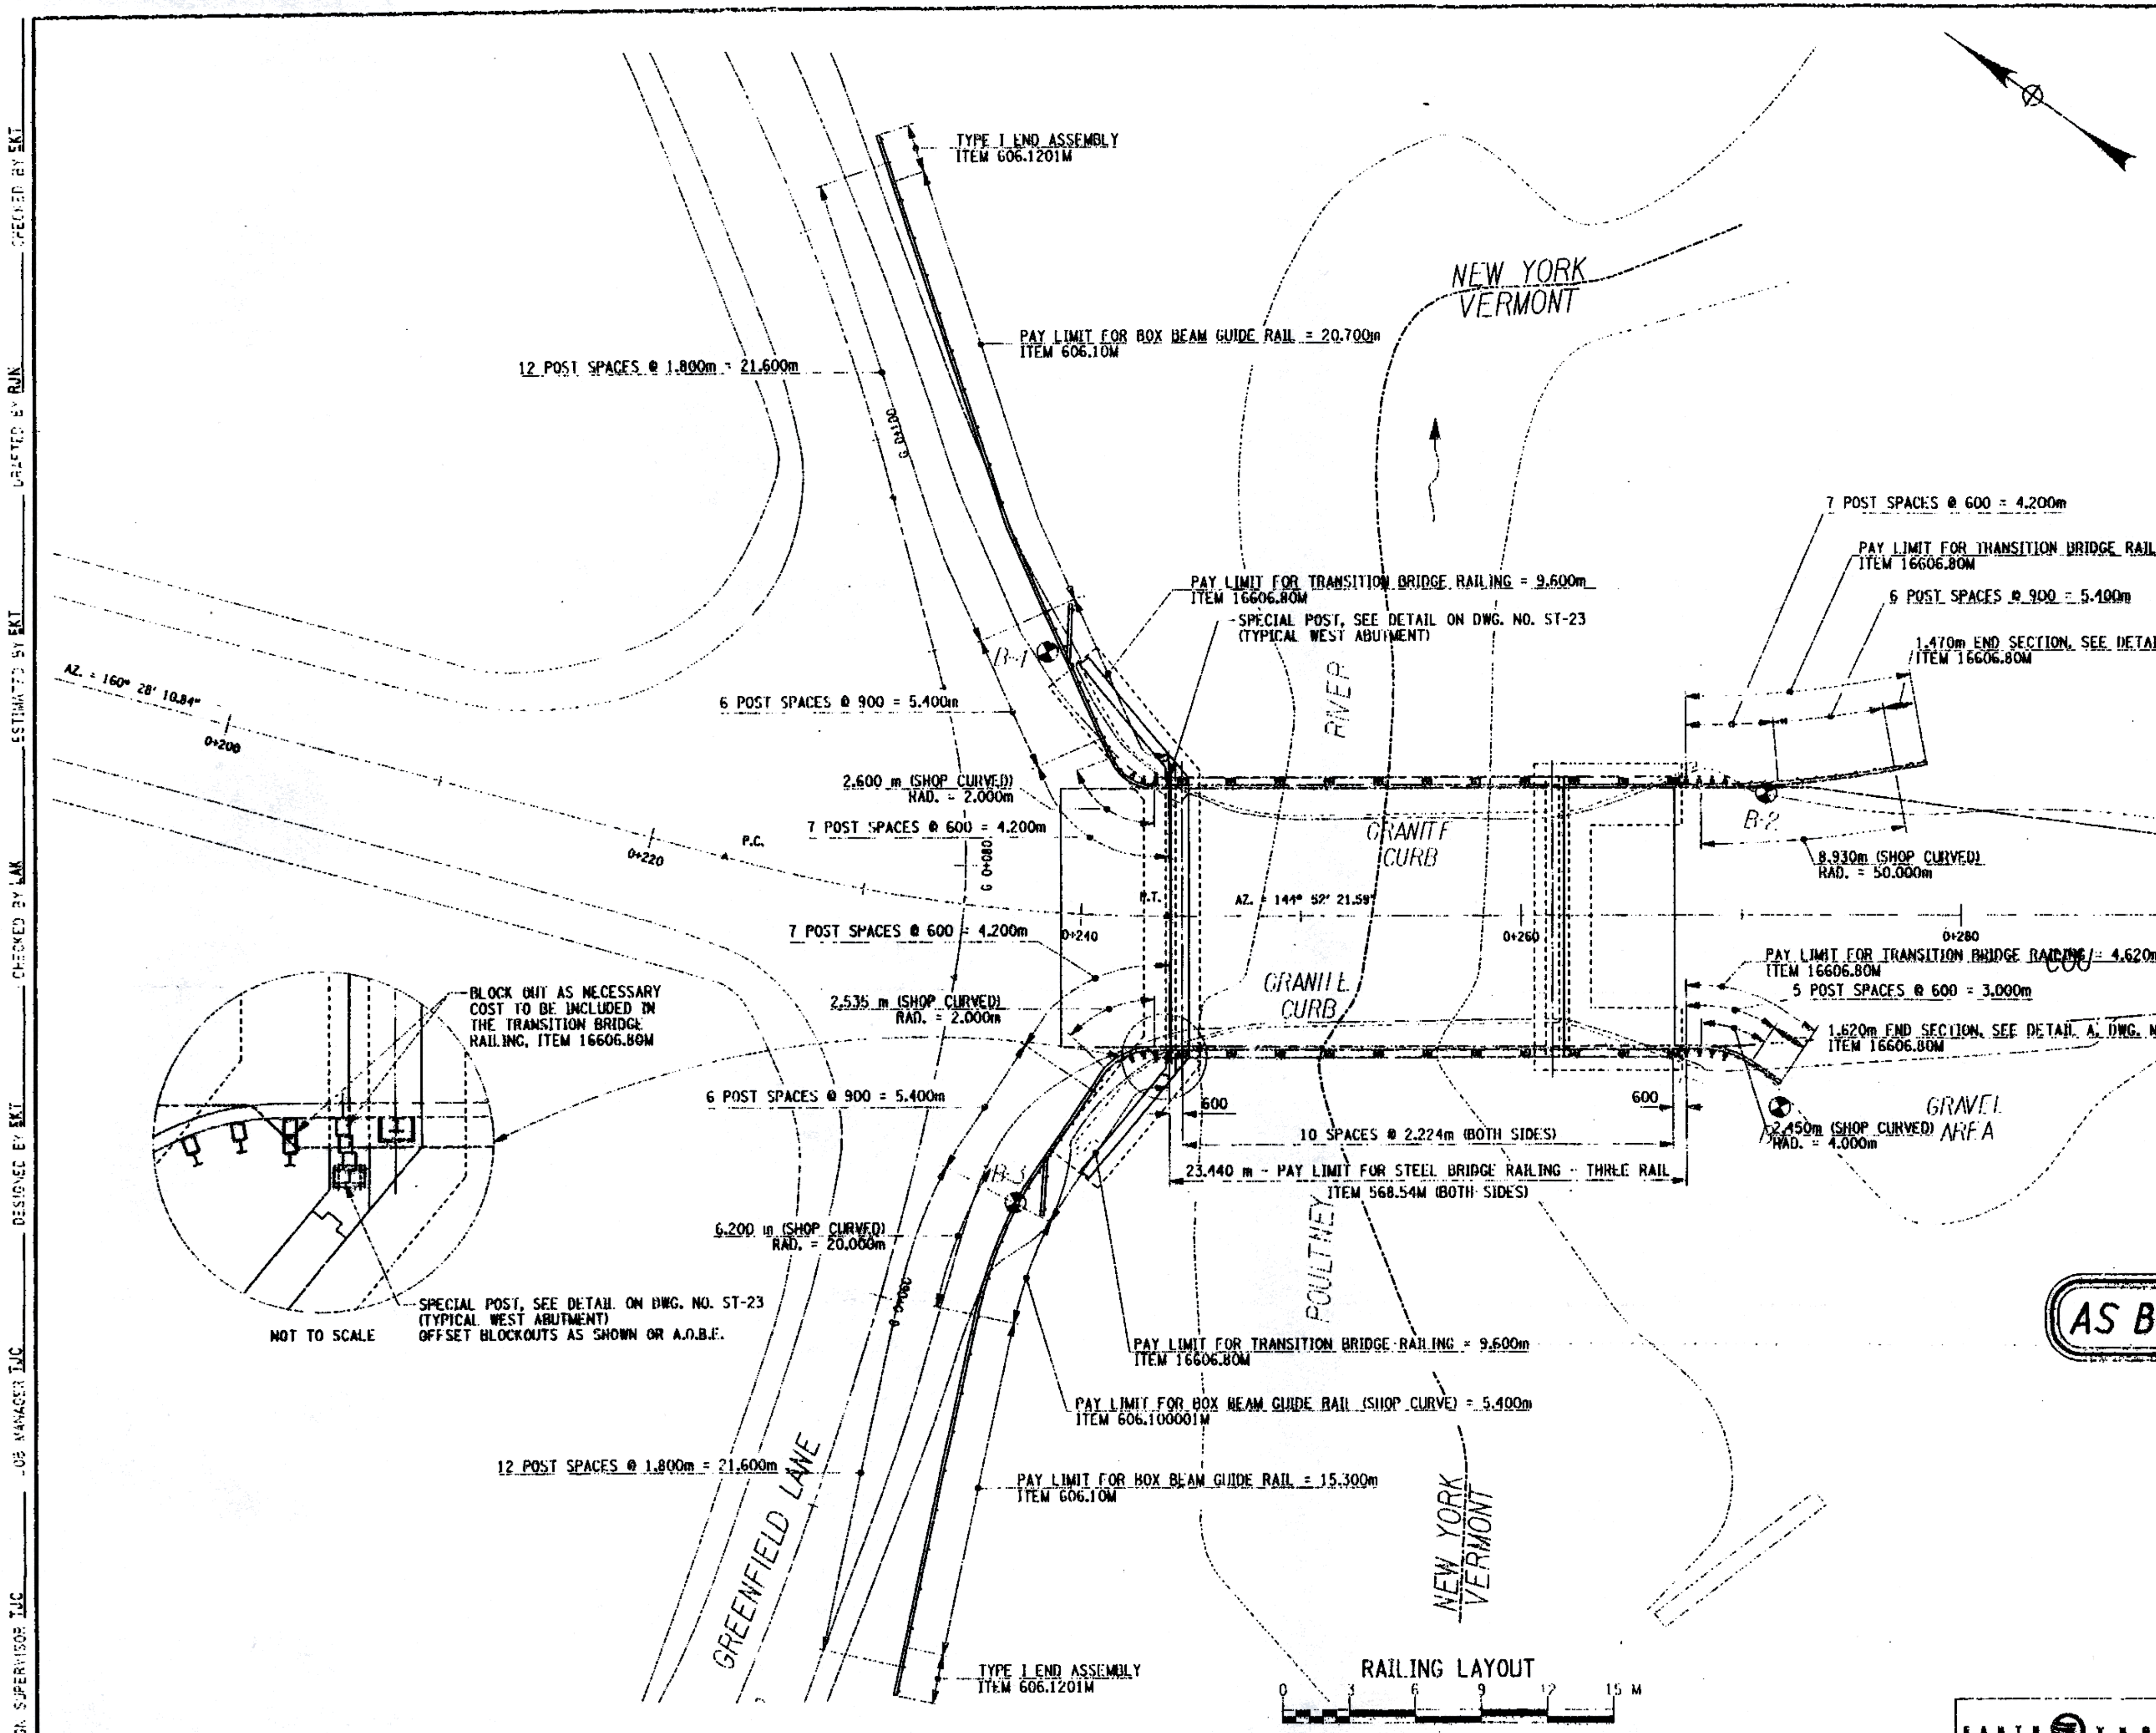

AS BUILT: NO REVISIONS 9/2003

ALL DIMENSIONS ARE IN INCH UNLESS OTHERWISE NOTED
AS BUILT REVISIONS

Lawrence E. Stevens 9/2003
SIGNATURE DATE

COUNTY ROAD 18 OVER POULTNEY RIVER

RAILING LAYOUT

WASHINGTON COUNTY
DEPARTMENT OF PUBLIC WORKS







FILENAME	REGION	DATE	DRAWING NO
175376AA.R1E	ONE	3/2002	ST-20

```
FILE NAME = j:\work\42897\CADD\AsBuilts\175376as-b-1e
DATE/TIME = 11/04/2003 10:11:05 AM
USER = AJN
```

DESIGN SUPERVISOR TUC _____ DESIGNED BY EKT _____
 JOB MANAGER TUC _____ CHECKED BY LAK _____
 _____ ESTIMATED BY EKT _____ CREATED BY RUN _____

FILE NAME: I:\Users\JCB\Documents\175376AA.HSA
DATE/TIME: 11/24/2003 10:02:21 AM
USER: JCB
DESIGN SUPERVISOR: JCB
JCB MANAGER: JCB

DESIGNED BY: JCB
CHECKED BY: JCB
ESTIMATED BY: JCB
CHECKED BY: JCB
DRAFTED BY: JCB
CHECKED BY: JCB

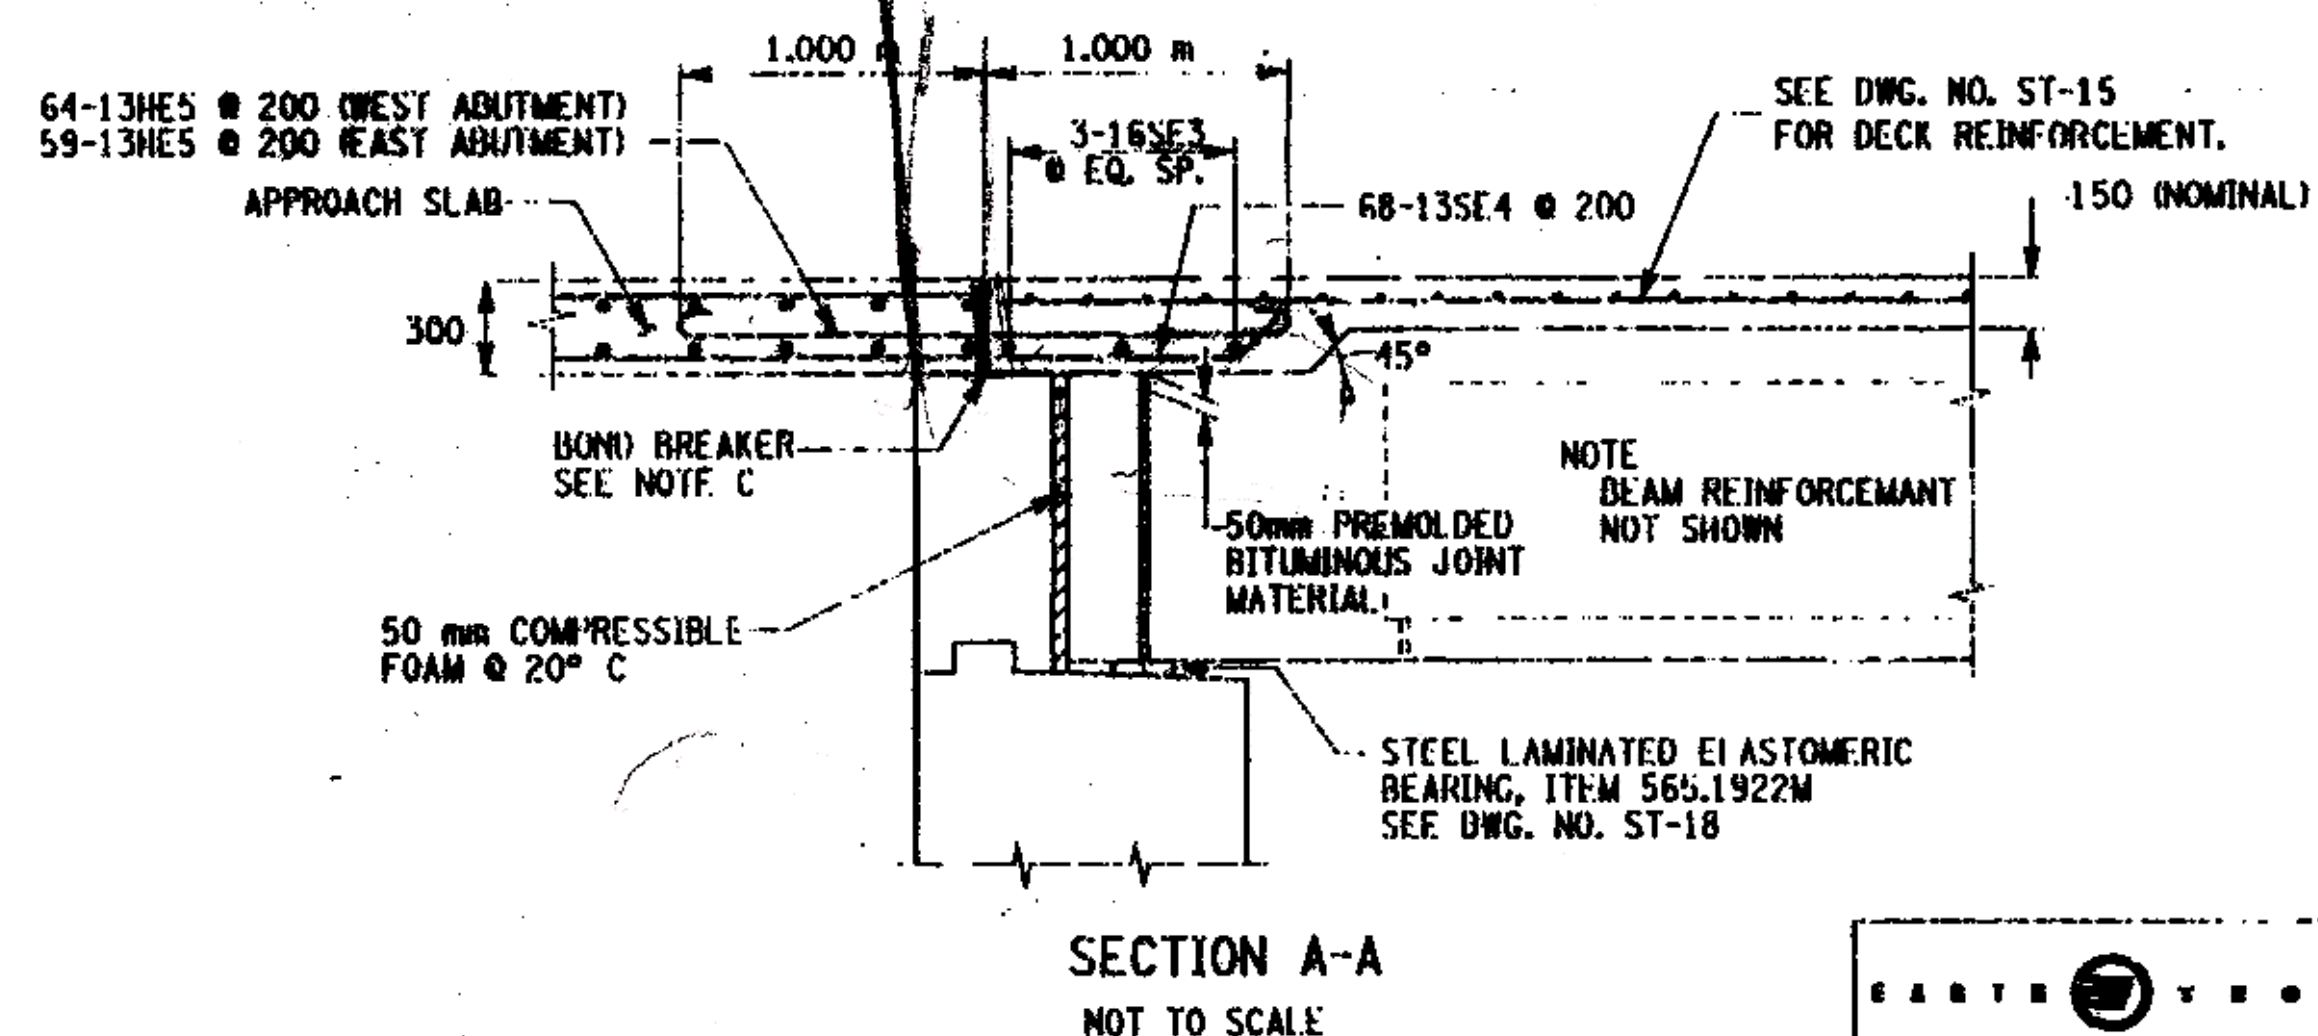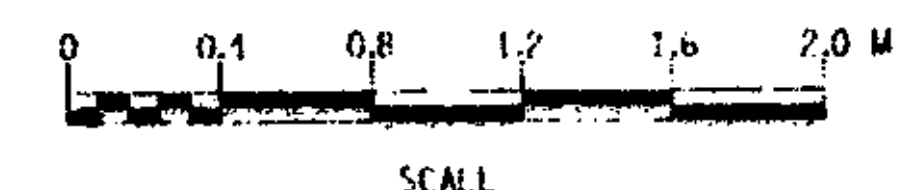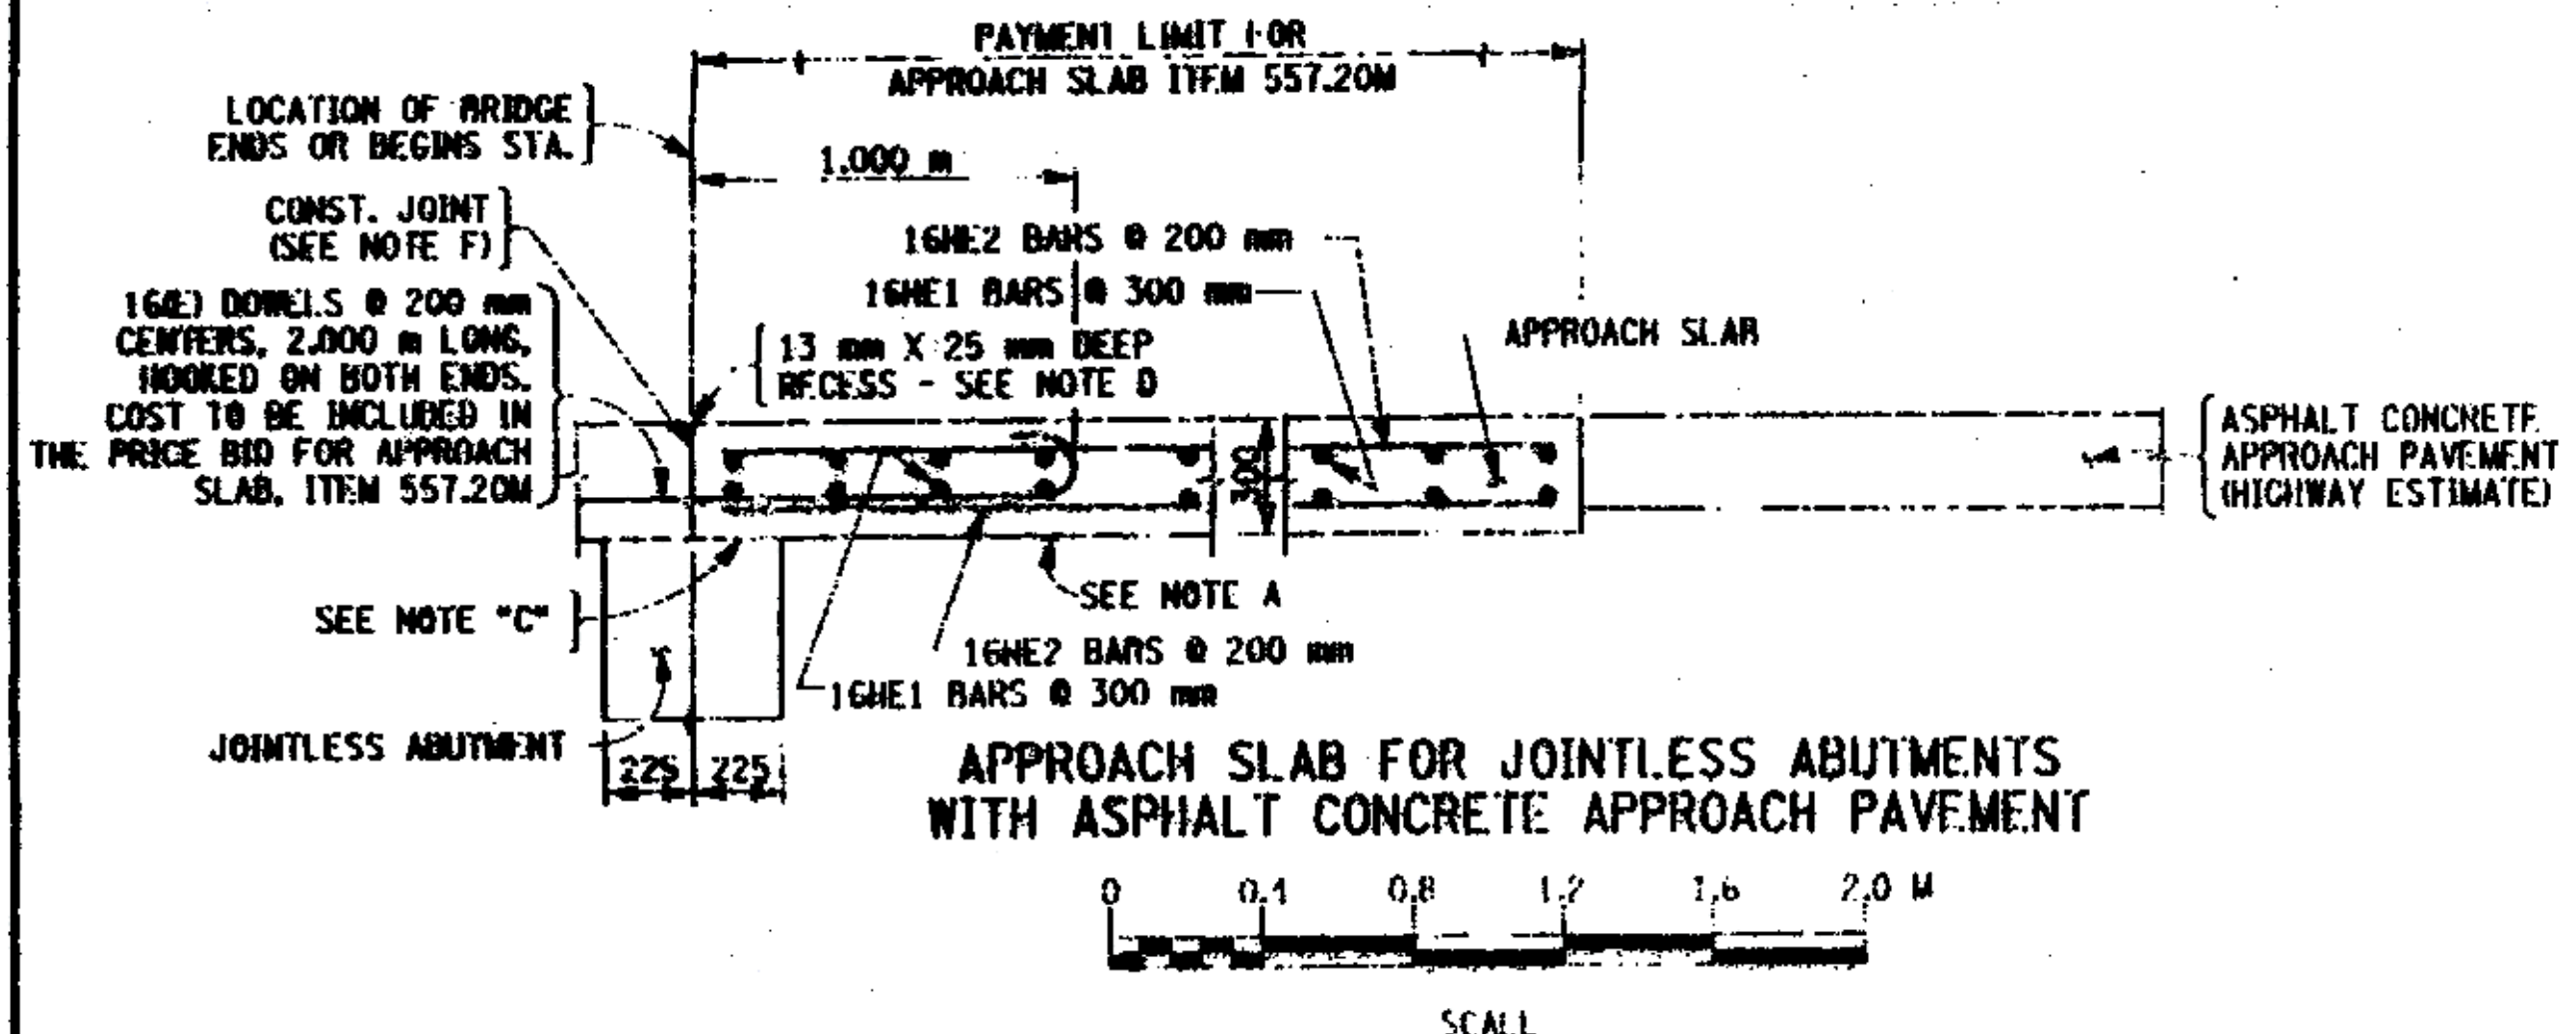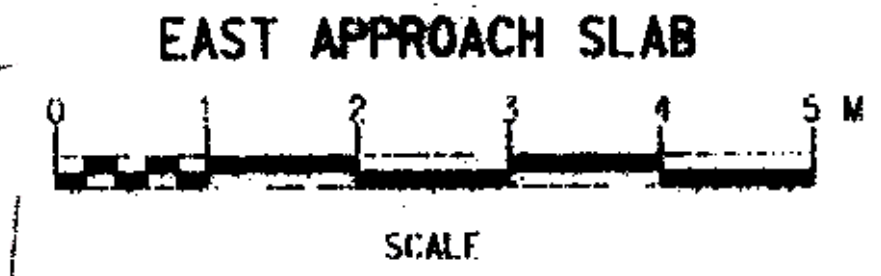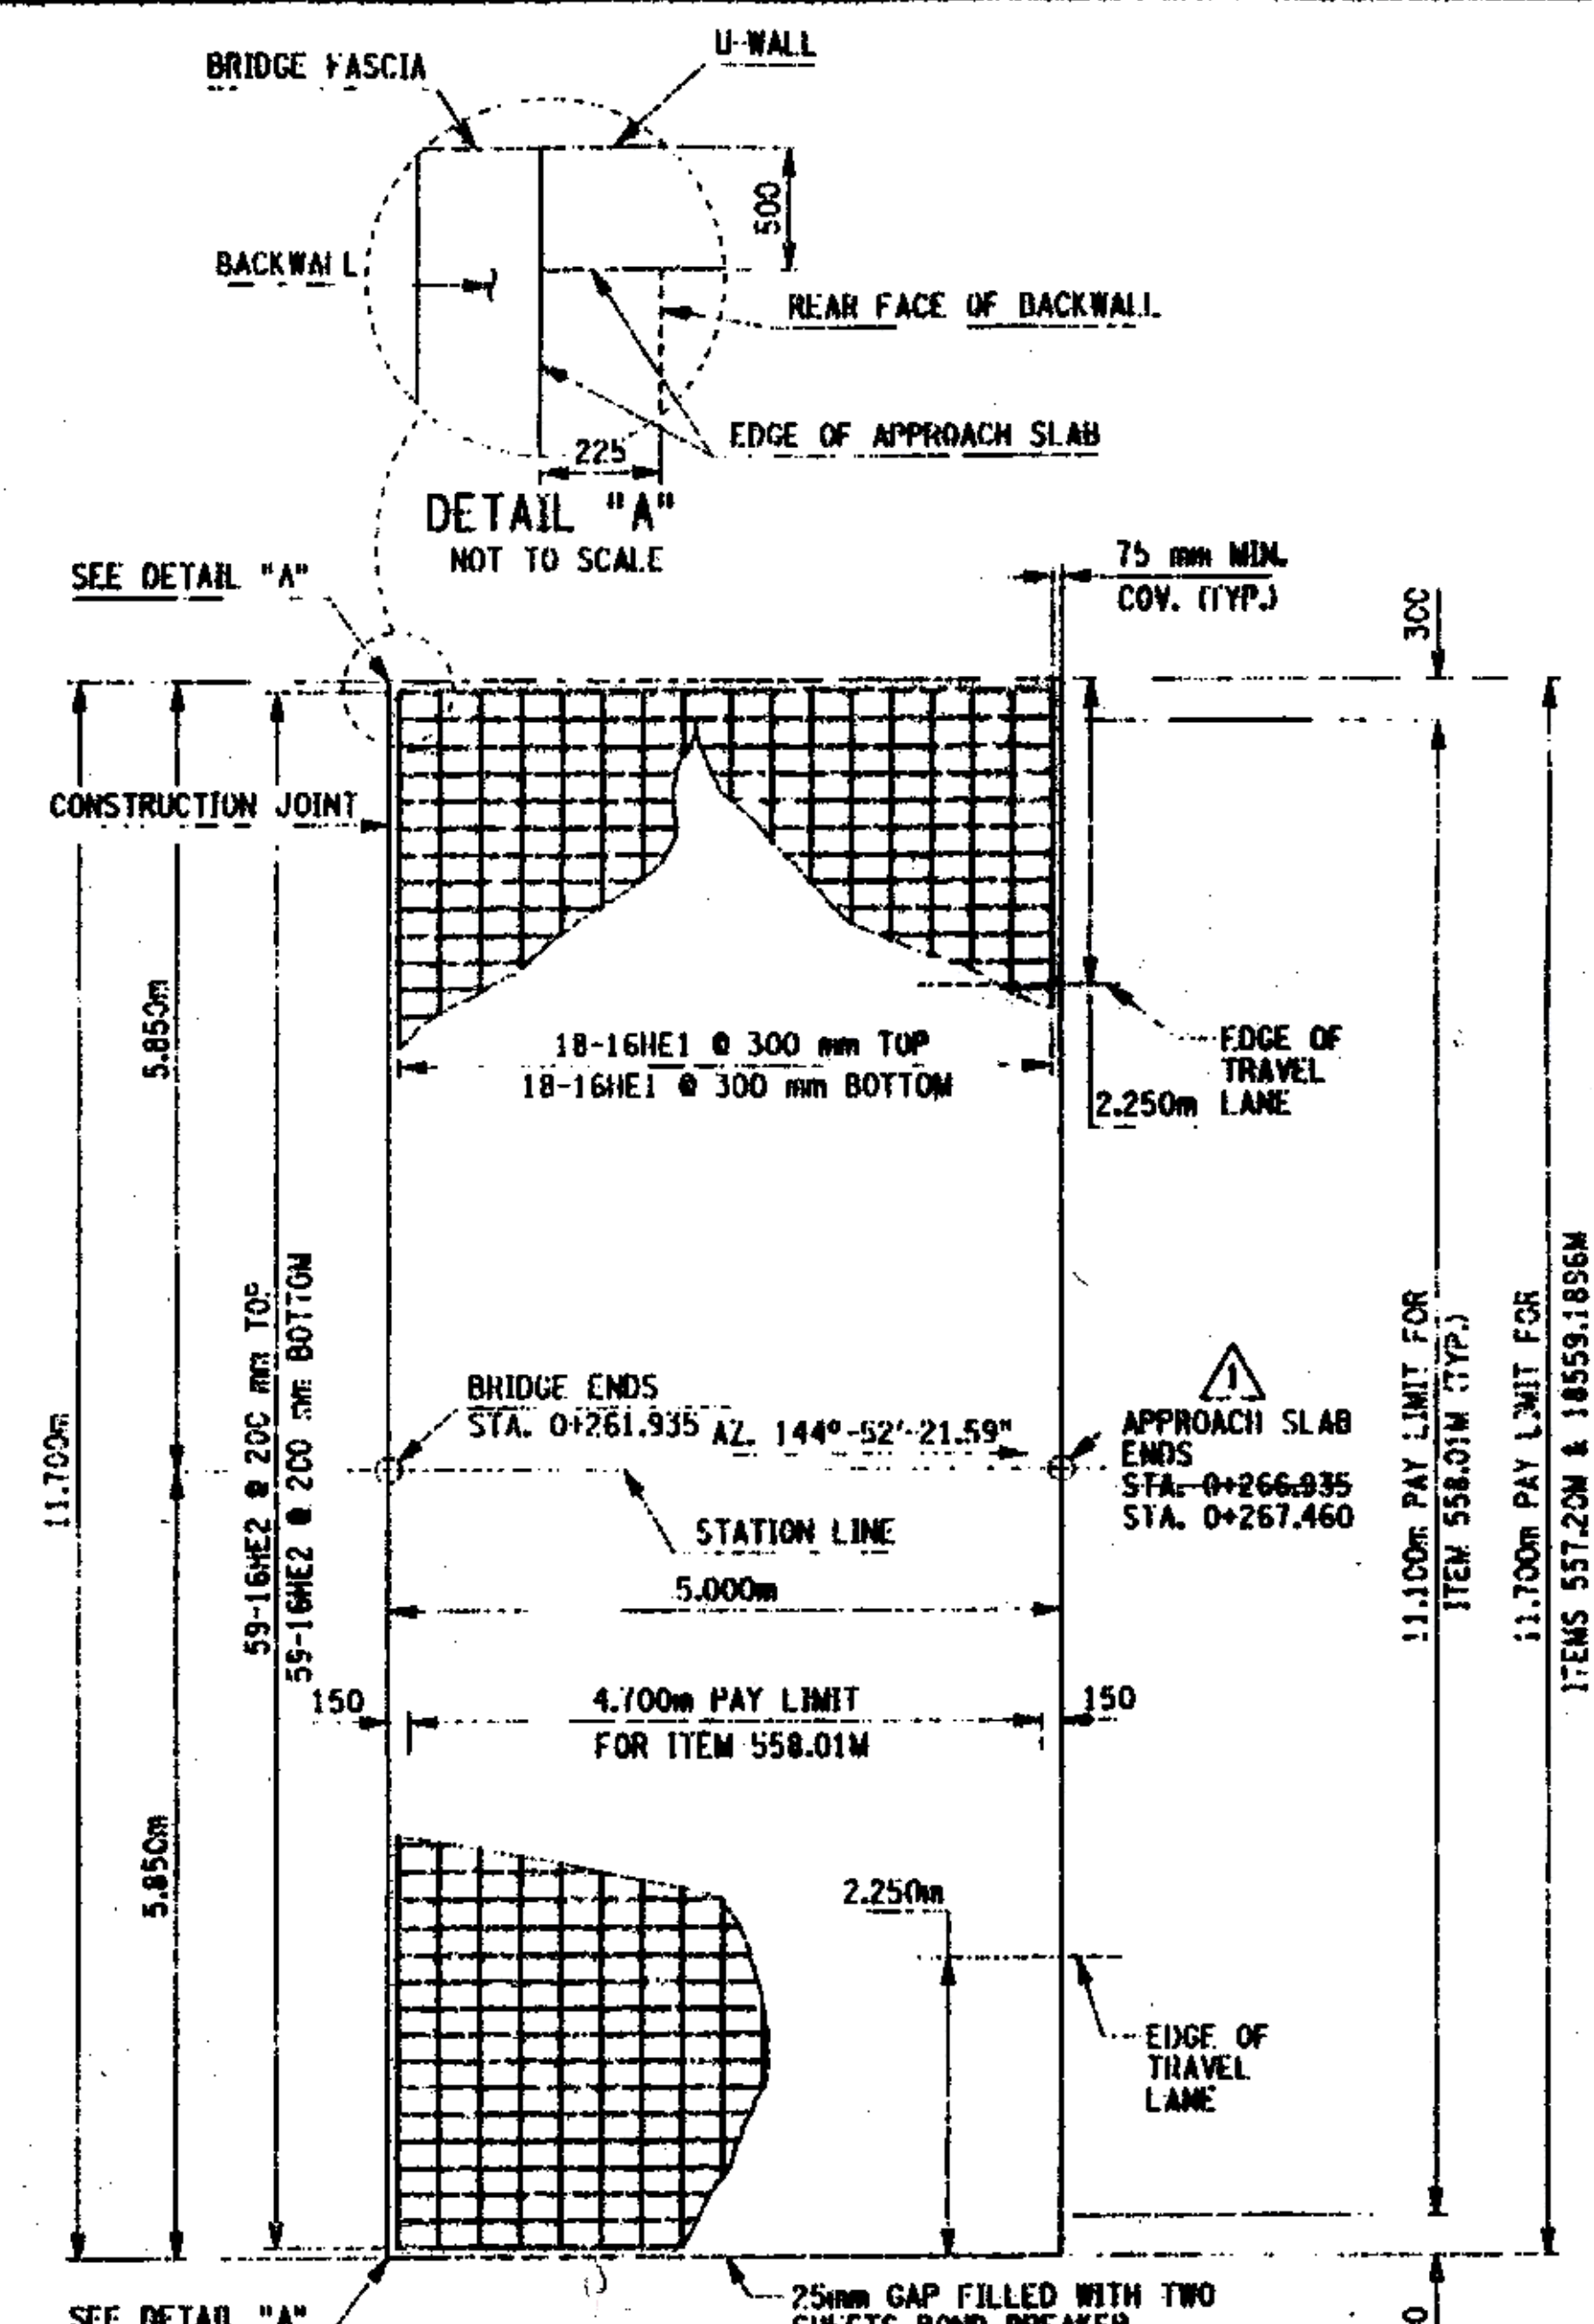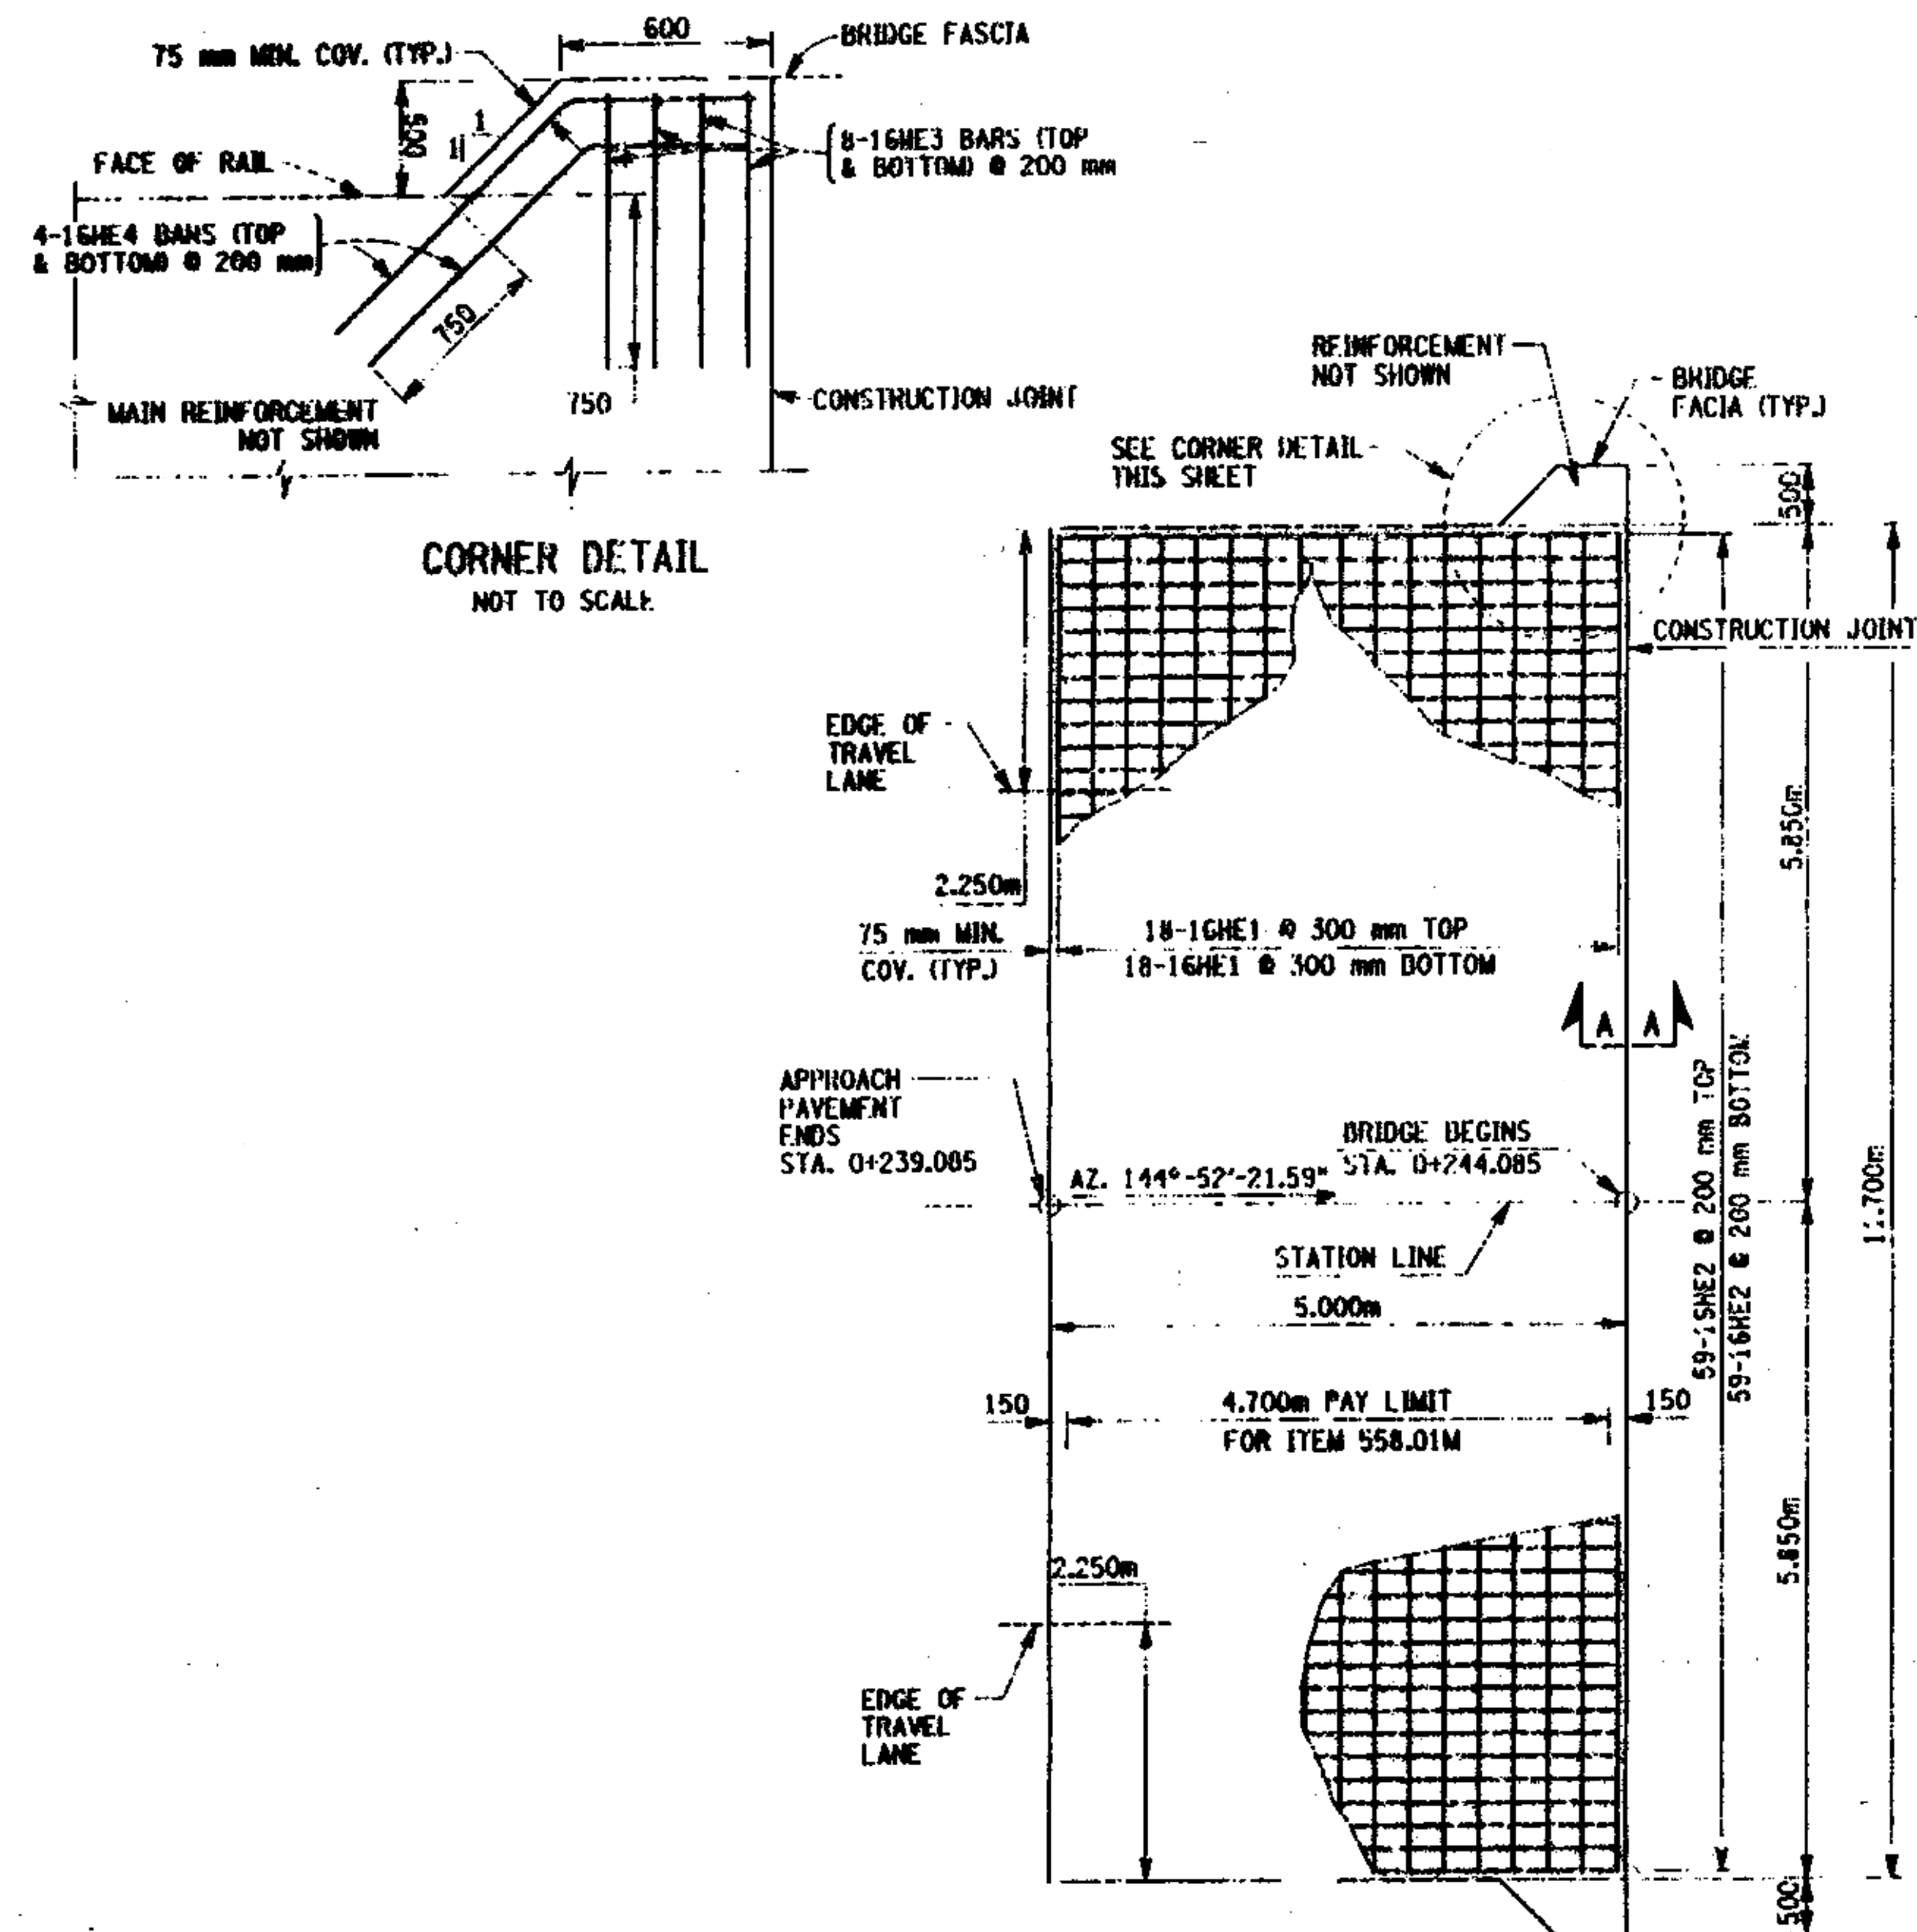

SECTION A-A
NOT TO SCALE

TEO ROAD R.C. NO.	STATE	CONTRACT NO.	SHEET NO.	TOTAL SHEETS
1	N.Y.		35	43

COUNTY ROAD 18 OVER POULTNEY RIVER
WASHINGTON COUNTY, NY / RUTLAND COUNTY, VT
TOWN OF HAMPTON, NY / POULTNEY, VT
CAPITAL PROJECT IDENTIFICATION NO. 1753.76

- NOTES:
- TO PERMIT UNHINDERED LONGITUDINAL MOVEMENT OF SLAB, THE SURFACE OF THE SUBBASE COURSE MUST BE ACCURATELY CONTROLLED TO FOLLOW AND BE PARALLEL TO THE ROADWAY GRADE AND CROSS SLOPE. POLYETHYLENE CURING COVERS (WHITE OPAQUE) IN ACCORDANCE WITH MATERIAL SPECIFICATION SUBSECTION 711-04 SHALL BE PLACED ON THE FINISHED SUBBASE COURSE THE FULL WIDTH OF THE APPROACH SLAB PRIOR TO PLACEMENT OF THE REINFORCEMENT. THE CURING COVERS SHALL BE 0.1 mm THICK, AND LAPS SHALL BE 600 mm MINIMUM.
 - FILL THE RECESS WITH A STRUCTURAL JOINT MATERIAL, LIQUID SEALANT, FROM THE DEPARTMENT'S APPROVED LIST. THE MANUFACTURER'S RECOMMENDATIONS SHALL BE FOLLOWED FOR THOSE SEALANTS THAT REQUIRE A PRIMER. THE CONCRETE SHALL CURE FOR MINIMUM OF 7 DAYS BEFORE JOINT IS SEALED. SEALING SHALL ONLY BE PERFORMED WHEN THE CONCRETE TEMPERATURE IS 5°C OR ABOVE. BOTH JOINT FACES SHALL BE SAND BLASTED TO ROUGHEN THE SURFACE AND TO REMOVE ALL SURFACE MOISTURE AND ANY OTHER MATERIAL THAT MAY INTERFERE WITH BOND.
 - TOP OF BACKWALL SHALL BE STEEL TROWEL FINISHED. SHEET GASKET (TREATED BOTH SIDES) MATERIAL SPECIFICATION 728-06, SHALL BE PLACED ON THE TOP OF BACKWALLS. TWO 1.6 mm THICK SHEETS SHALL BE USED, AND PAYMENT SHALL BE INCLUDED IN THE UNIT PRICE BID FOR THE APPROACH ITEM.
 - FILL THE RECESS WITH A STRUCTURAL JOINT MATERIAL, LIQUID SEALANT, FROM THE DEPARTMENT'S APPROVED LIST. IF THE RECESS IS SAW CUT, WATER BLAST IMMEDIATELY FOLLOWING CUTTING TO REMOVE ANY RESIDUAL SLURRY BEFORE IT DRIES. CLEAN THE VERTICAL FACES OF THE RECESS BY ABRASIVE BLAST, AND AIR BLOW THE RESIDUE FROM THE RECESS. PRIME THE VERTICAL FACES WITH THE MANUFACTURER'S RECOMMENDED PRIMER, AND ALLOW TO DRY. PLACE A 15 mm DIA. SOFT CLOSED CELL BACKER ROD IN THE BOTTOM OF THE RECESS. POUR THE SILICONE TO A DEPTH OF APPROXIMATELY 9 mm. PAYMENT TO BE INCLUDED IN THE UNIT PRICE BID FOR THE APPROACH SLAB.
 - TOP SURFACES OF STRUCTURAL SLABS, APPROACH SLABS SHALL BE GROOVED UNDER THE TRANSVERSE SAWCUT GROOVING OF STRUCTURAL SLAB SURFACE ITEM 558.01M.
 - THE FULL DEPTH JOINT SHOWN IS MANDATORY. A PARTIAL DEPTH SAWCUT IS NOT PERMITTED.

CONCRETE TABLE			
	ITEM 557.20M	ITEM 558.01M	ITEM 10559.1096M
WEST	59.35 m ²	52.17 m ²	59.35 m ²
EAST	58.50 m ²	52.17 m ²	58.50 m ²

AS BUILT: REVISIONS 9/2003

ALL DIMENSIONS ARE IN mm UNLESS OTHERWISE NOTED

AS BUILT REVISIONS

Signature 9/2003
SIGNATURE DATE

COUNTY ROAD 18 OVER POULTNEY RIVER



APPROACH SLAB

WASHINGTON COUNTY
DEPARTMENT OF PUBLIC WORKS

PROJECT NAME	REGION	DATE	DRAWING NO.
175376AA.HSA	ONE	3/2002	ST-19


FED. ROAD DIST. NO.	STATE	CONTRACT NO.	SHEET NO.	TOTAL SHEETS
1	N.Y.		23	43

COUNTY ROAD 18 OVER POULTNEY RIVER
WASHINGTON COUNTY, NY / RUTLAND COUNTY, VT
TOWN OF HAMPTON, NY / POULTNEY, VT
CAPITAL PROJECT IDENTIFICATION NO. 1753.76

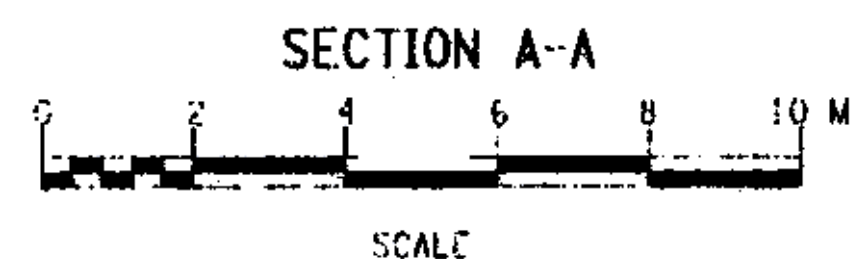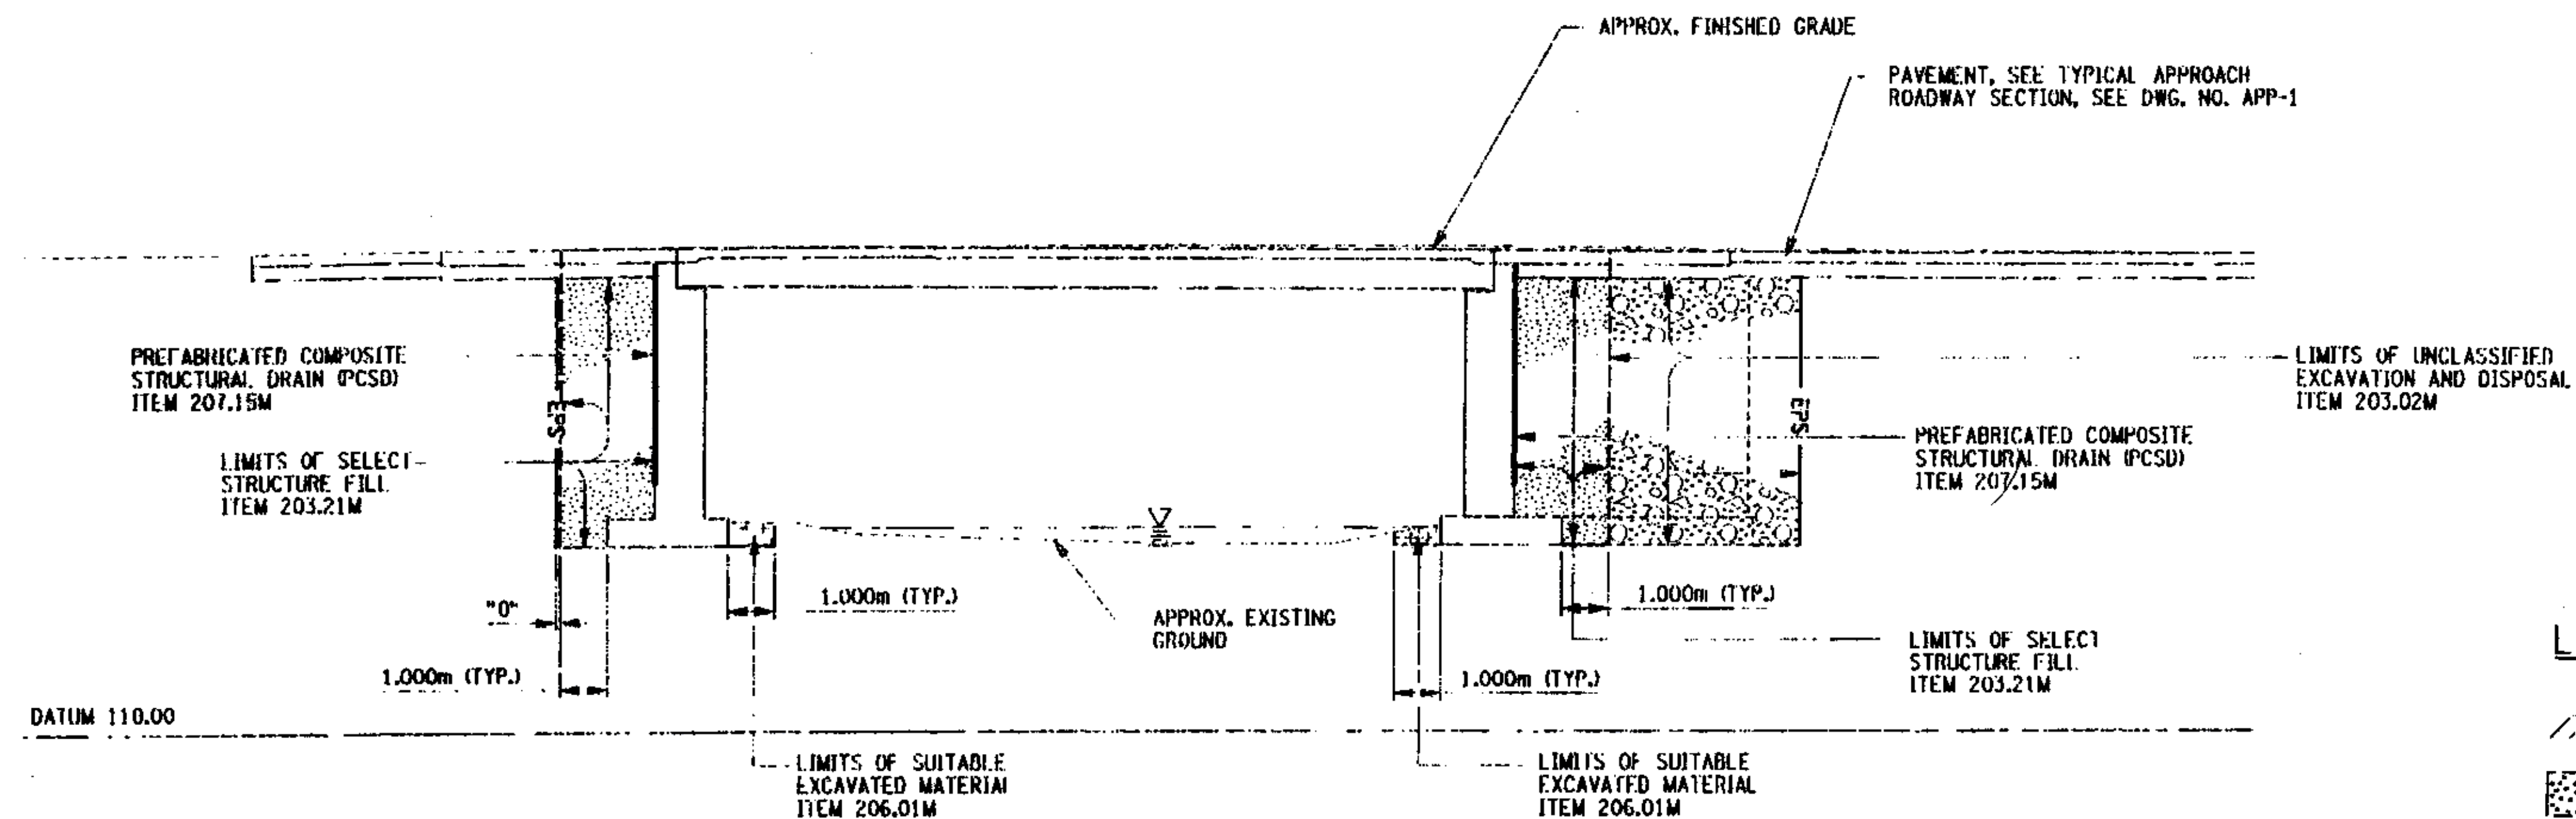


LEGEND

- EXISTING GROUND SURFACE
- SELECT STRUCTURE FILL (ITEM 203.21 M), COMPACTED TO 95% OF STANDARD PROCTOR MAXIMUM DENSITY.
- HIGHWAY EMBANKMENT MATERIAL ITEM 203.03 M
- BACKFILL WITH SUITABLE EXCAVATED MATERIAL AS PROVIDED FOR UNDER ITEM 206.01 M, STRUCTURE EXCAVATION
- APPROXIMATE LIMITS FOR REMOVAL OF SUBSTRUCTURES (ITEM 202.19 M)
- PREFABRICATED COMPOSITE STRUCTURAL DRAIN (PCSD) (ITEM 207.15 M)
- AREA ENCLOSED WITHIN THESE LINES DESIGNATES PAYMENT LINES FOR STRUCTURE EXCAVATION, (ITEM 206.01 M)
- EPS DESIGNATES PAYMENT LINES FOR EXCAVATION PROTECTION SYSTEM (ITEM 552.16M)

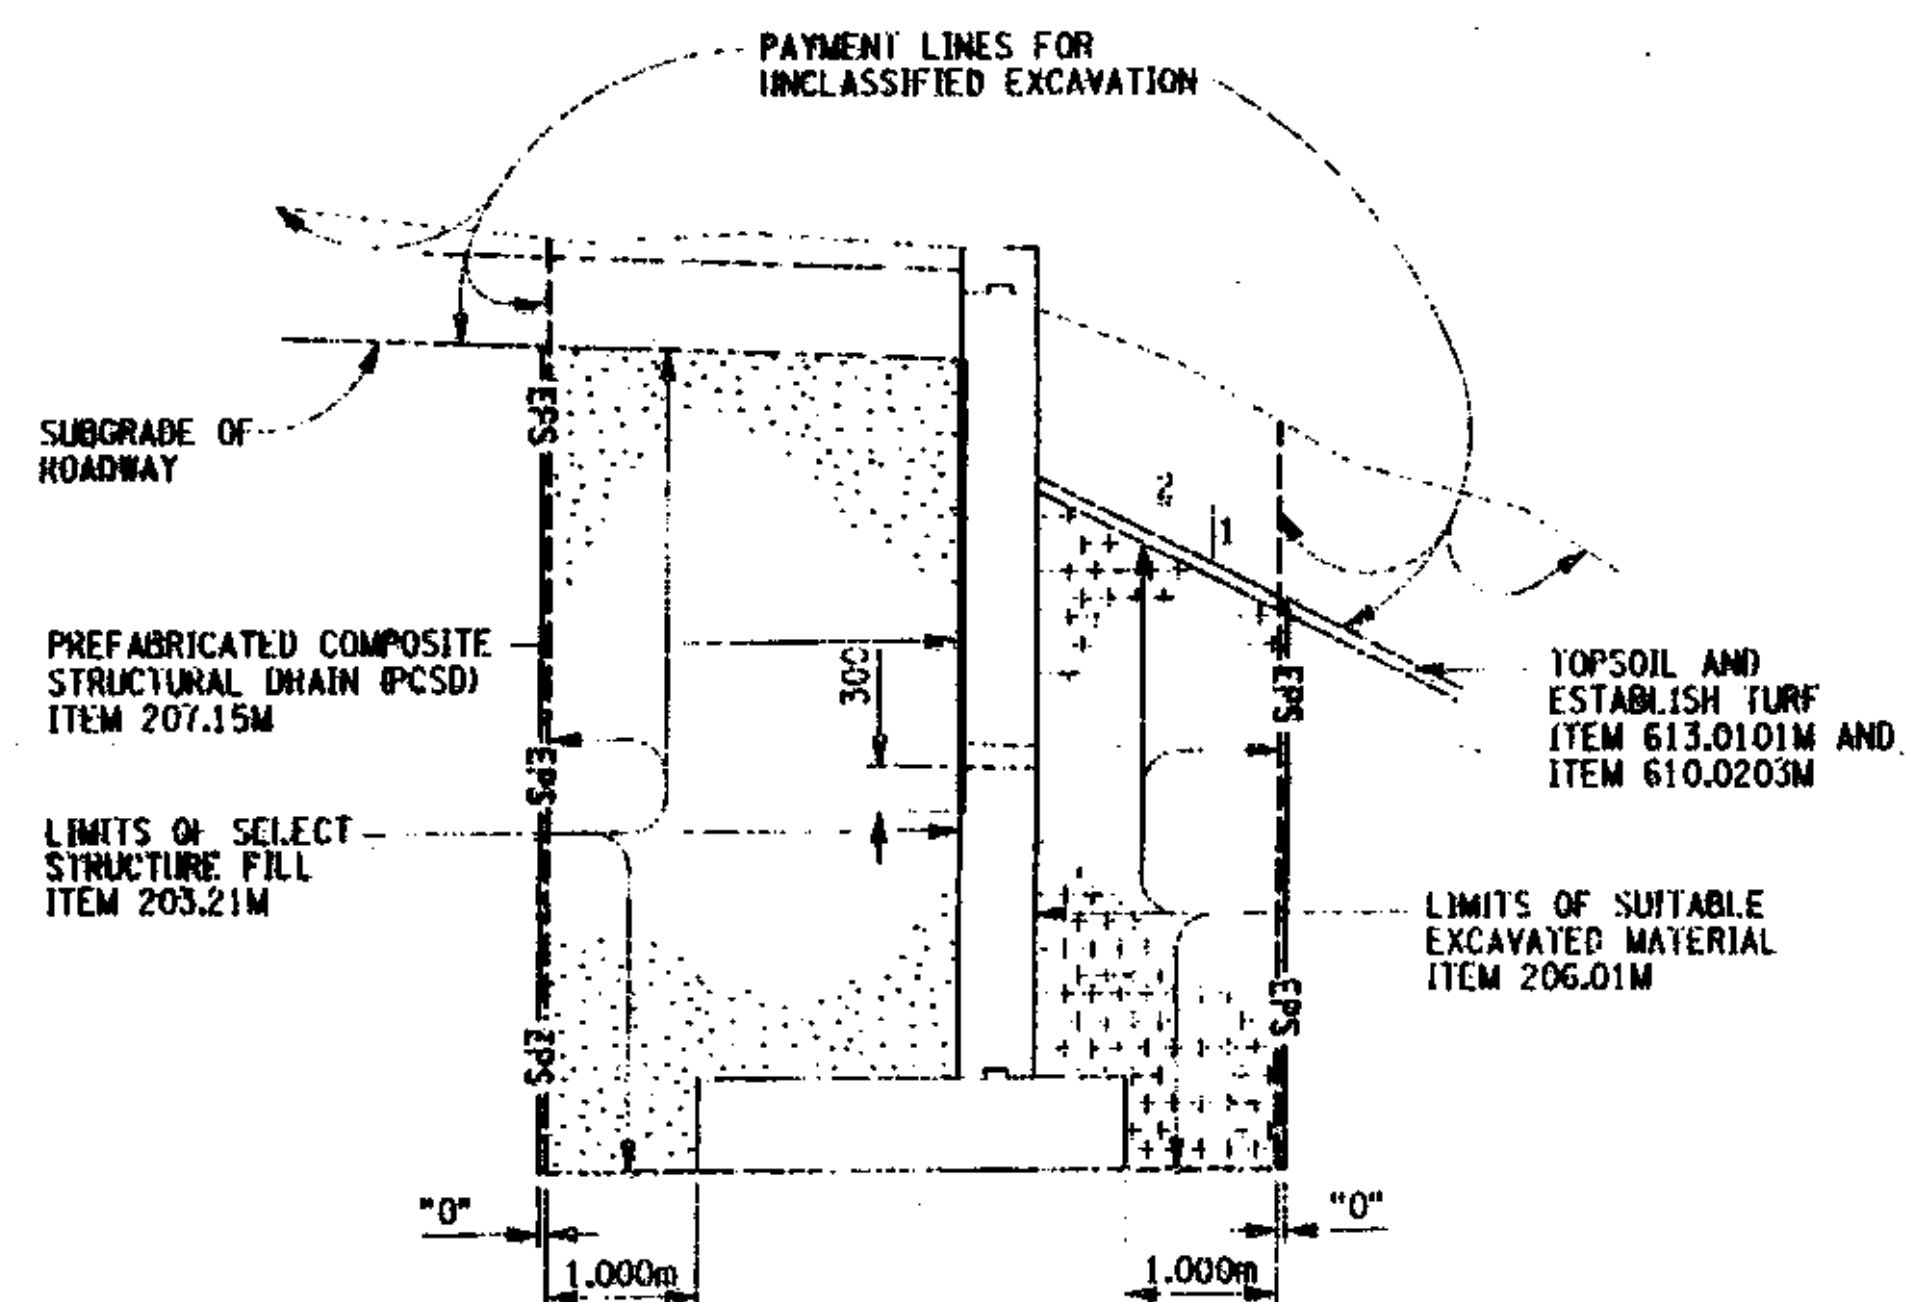

SECTION C-C
THRU U-WALL OR WING WALL
(U-WALL SHOWN, WINGWALL SIMILAR)

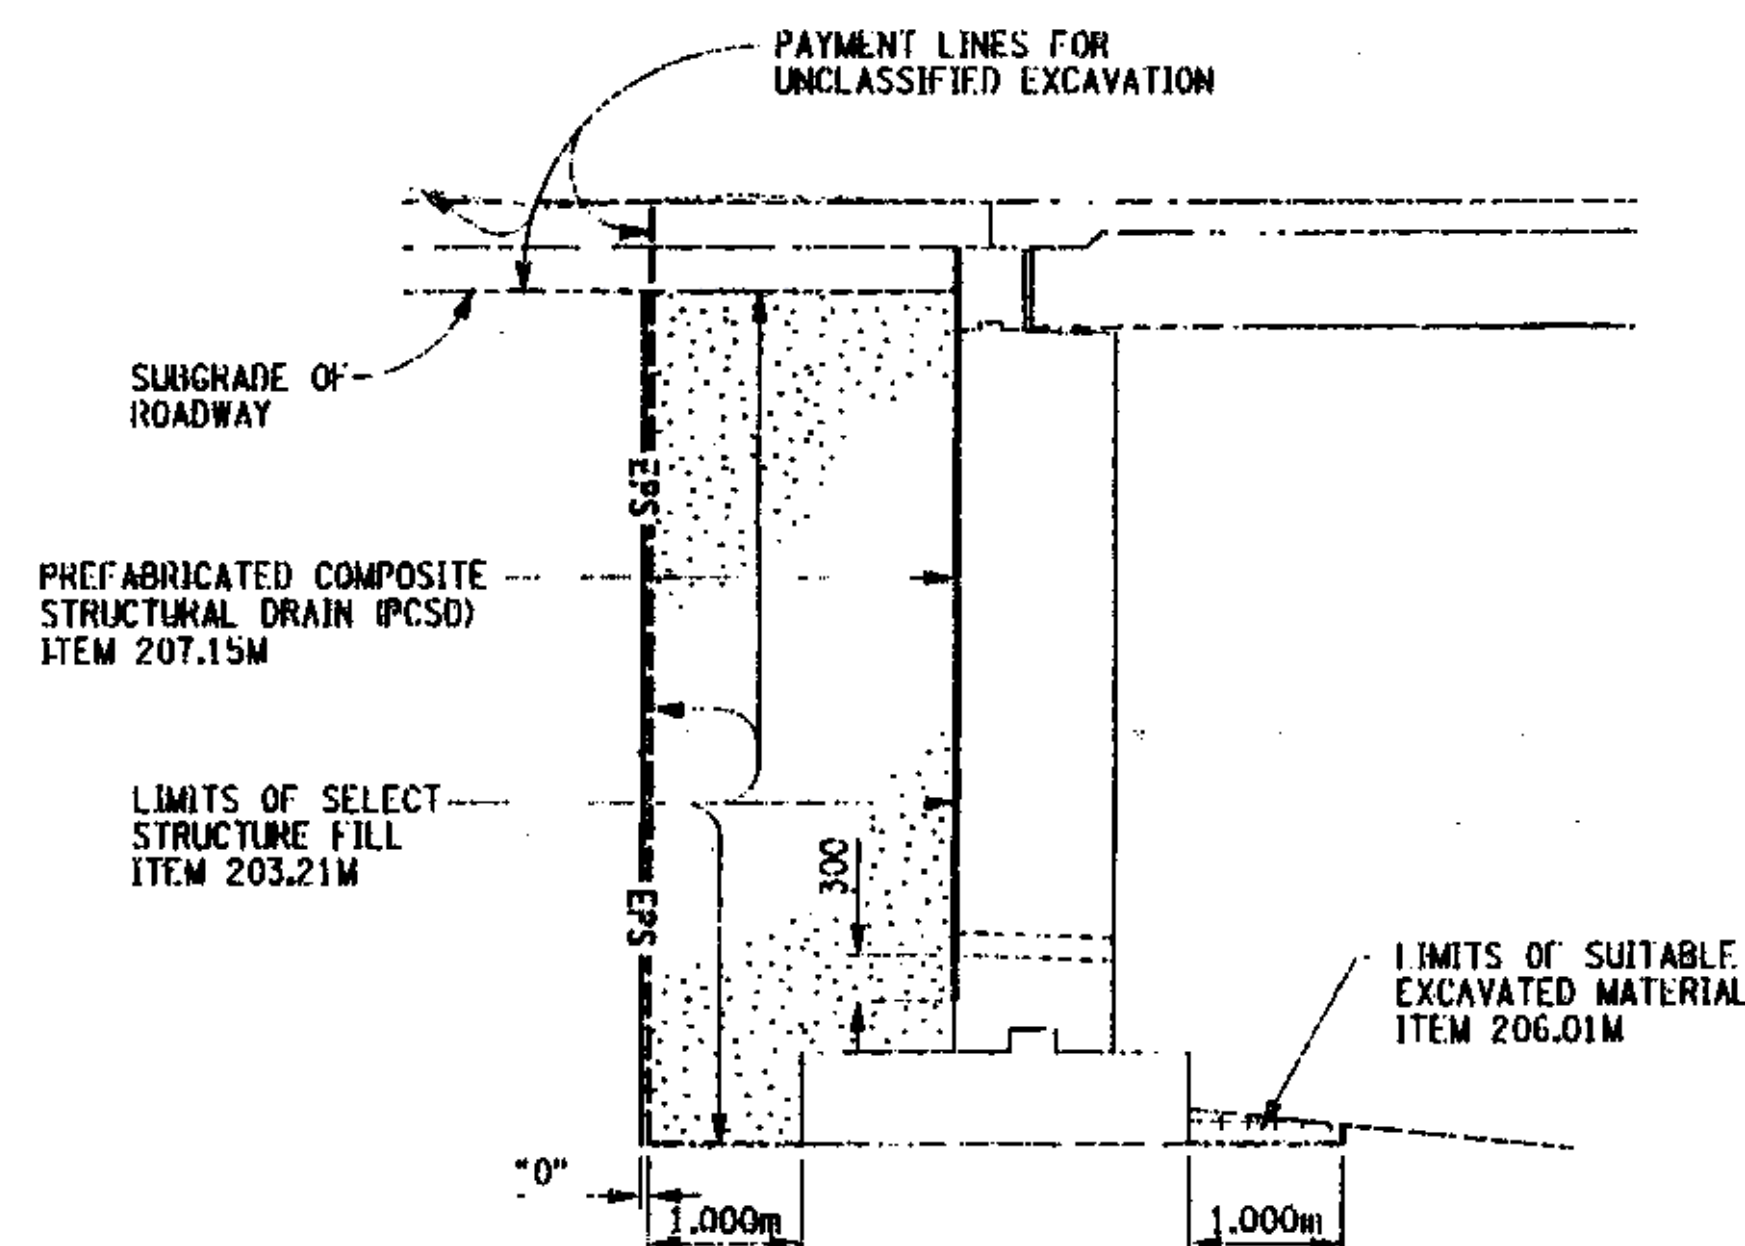

SECTION B-B
THRU ABUTMENT



AS BUILT: NO REVISIONS 9/2003

ALL DIMENSIONS ARE IN MM UNLESS OTHERWISE NOTED
AS BUILT REVISIONS

SIGNATURE: *Lawrence E. Stevens* DATE: 9/2003

COUNTY ROAD 18 OVER POULTNEY RIVER
EXCAVATION AND EMBANKMENT
SECTIONS



WASHINGTON COUNTY
DEPARTMENT OF PUBLIC WORKS

FILENAME: 175376AA.E1E REGION: ONE DATE: 3/2002 DRAWING NO.: ST-7

AS BUILT: NO REVISIONS 9/2003

FED. ROAD REG. NO.	STATE	CONTRACT NO.	SHEET NO.	TOTAL SHEETS
1	N.Y.		20	43

COUNTY ROAD 18 OVER POULTNEY RIVER
WASHINGTON COUNTY, NY / RUTLAND COUNTY, VT
TOWN OF HAMPTON, NY / POULTNEY, VT
CAPITAL PROJECT IDENTIFICATION NO. 1753.76

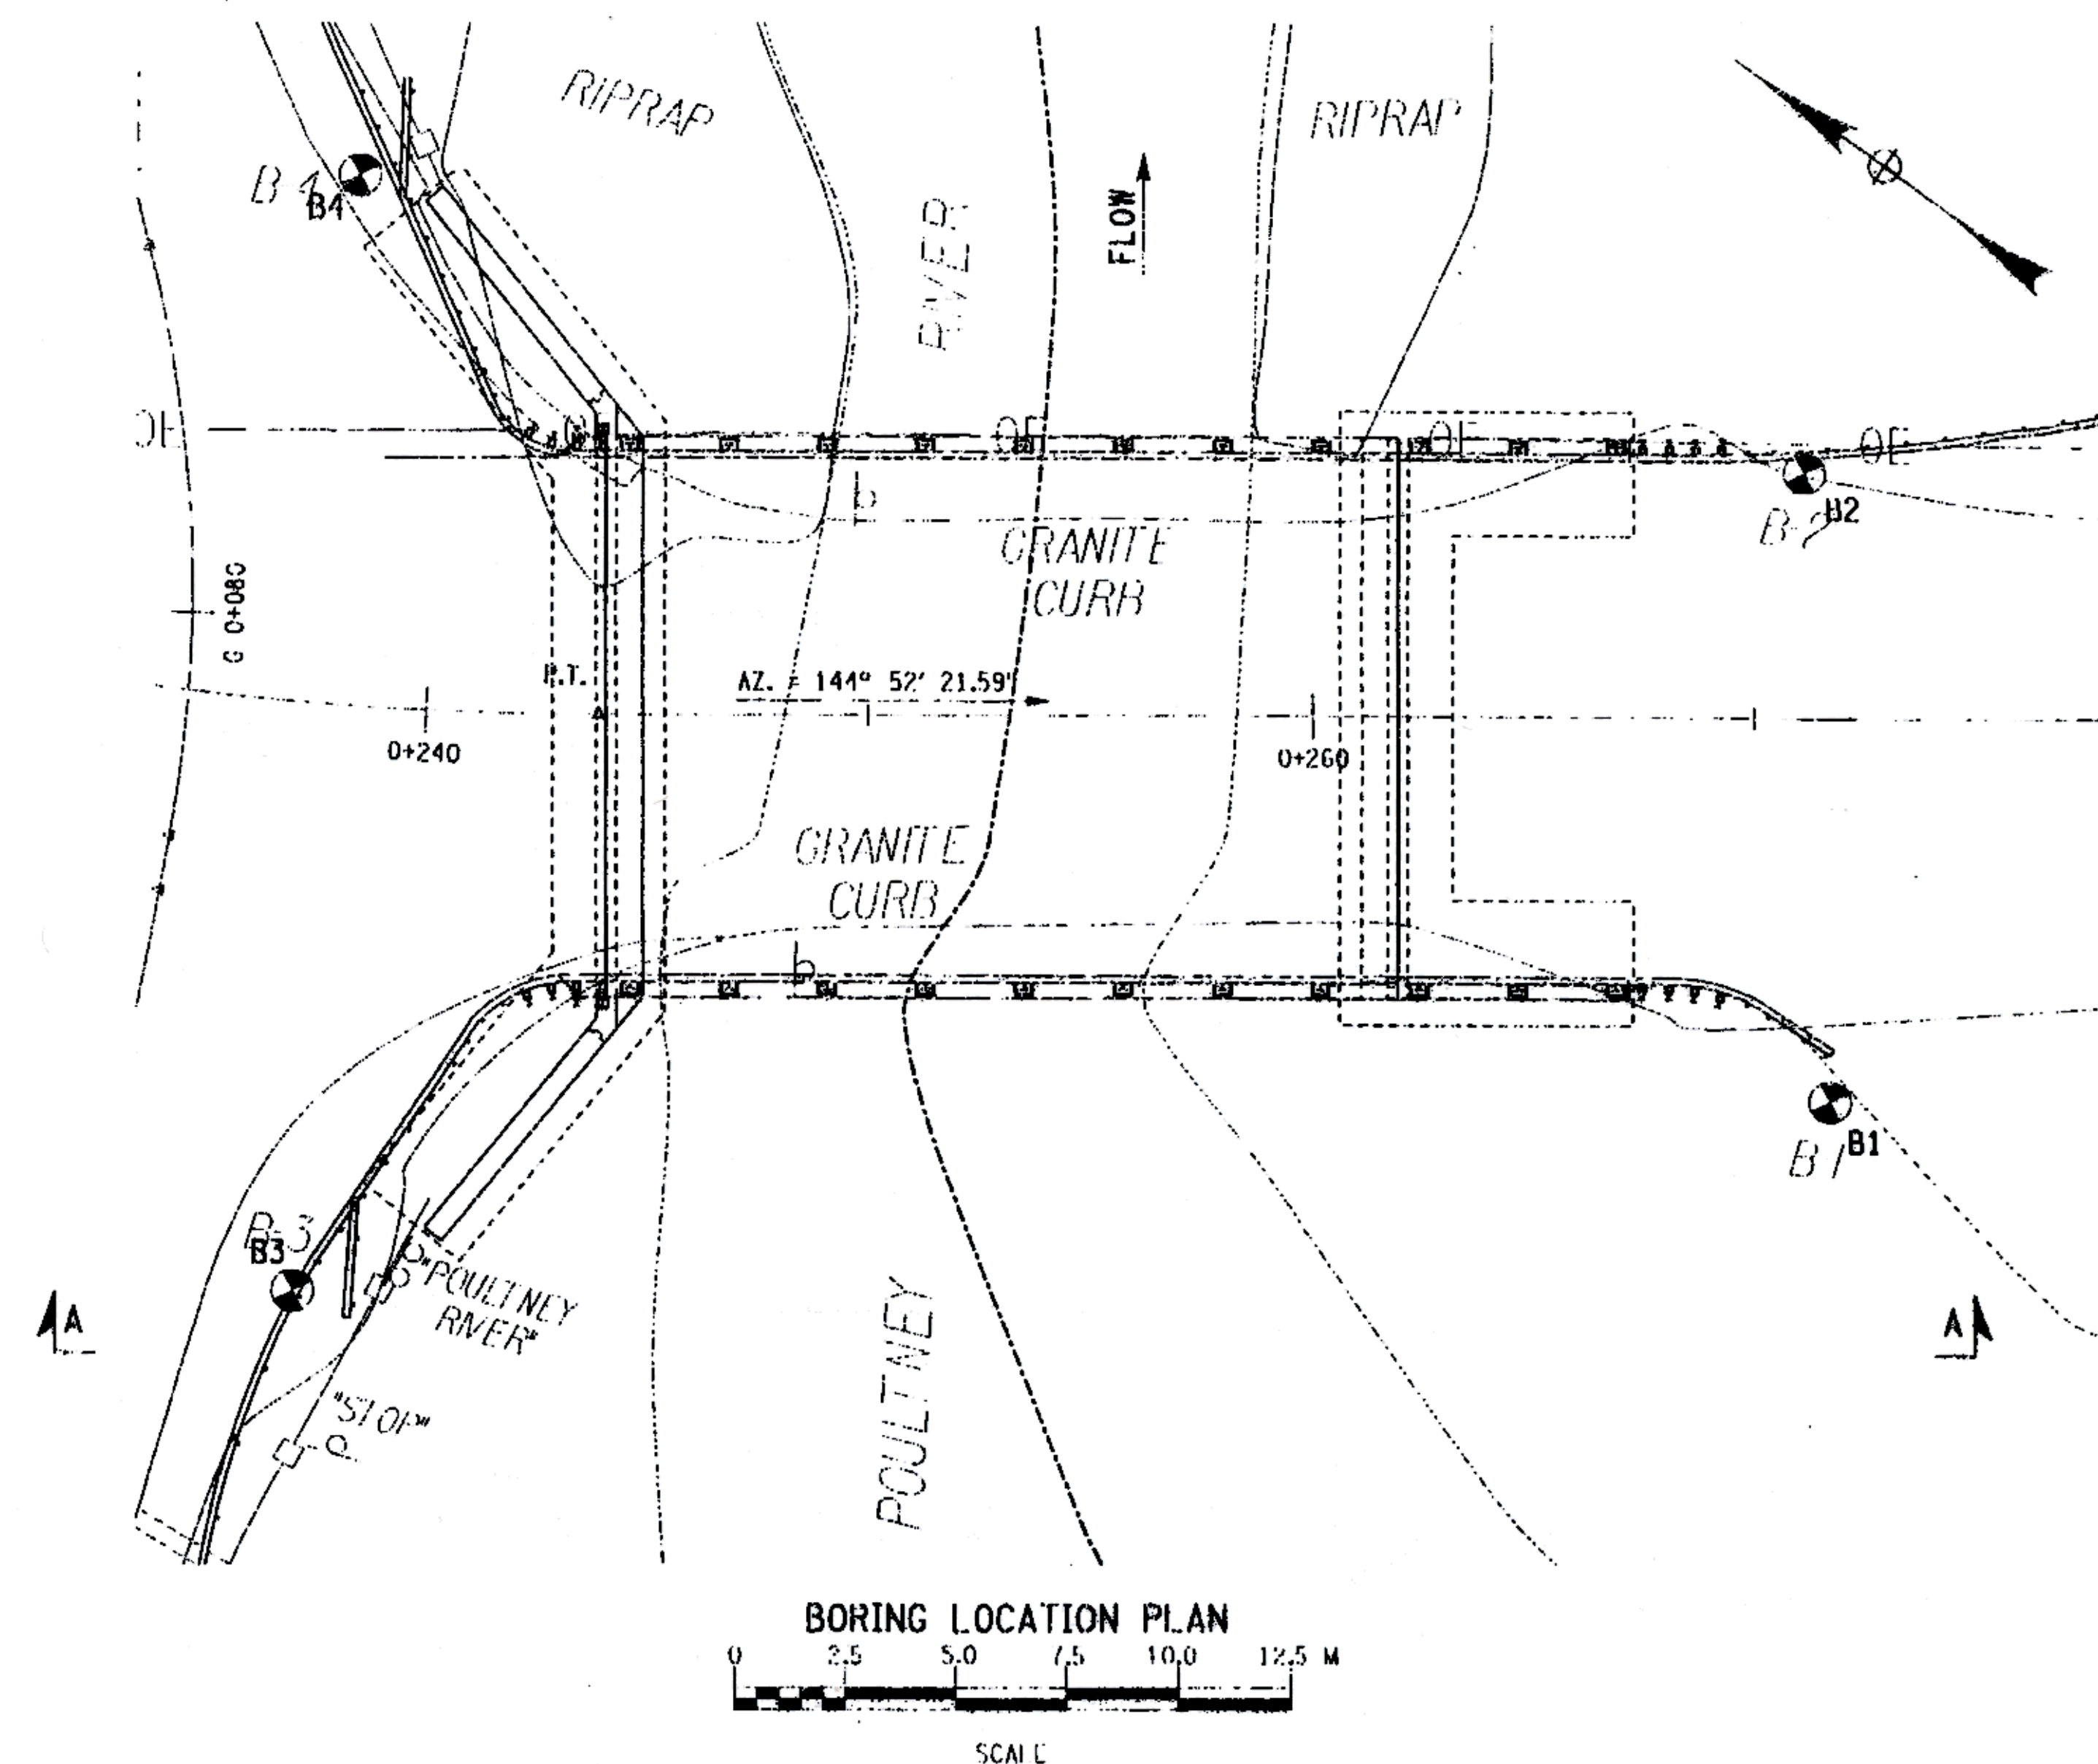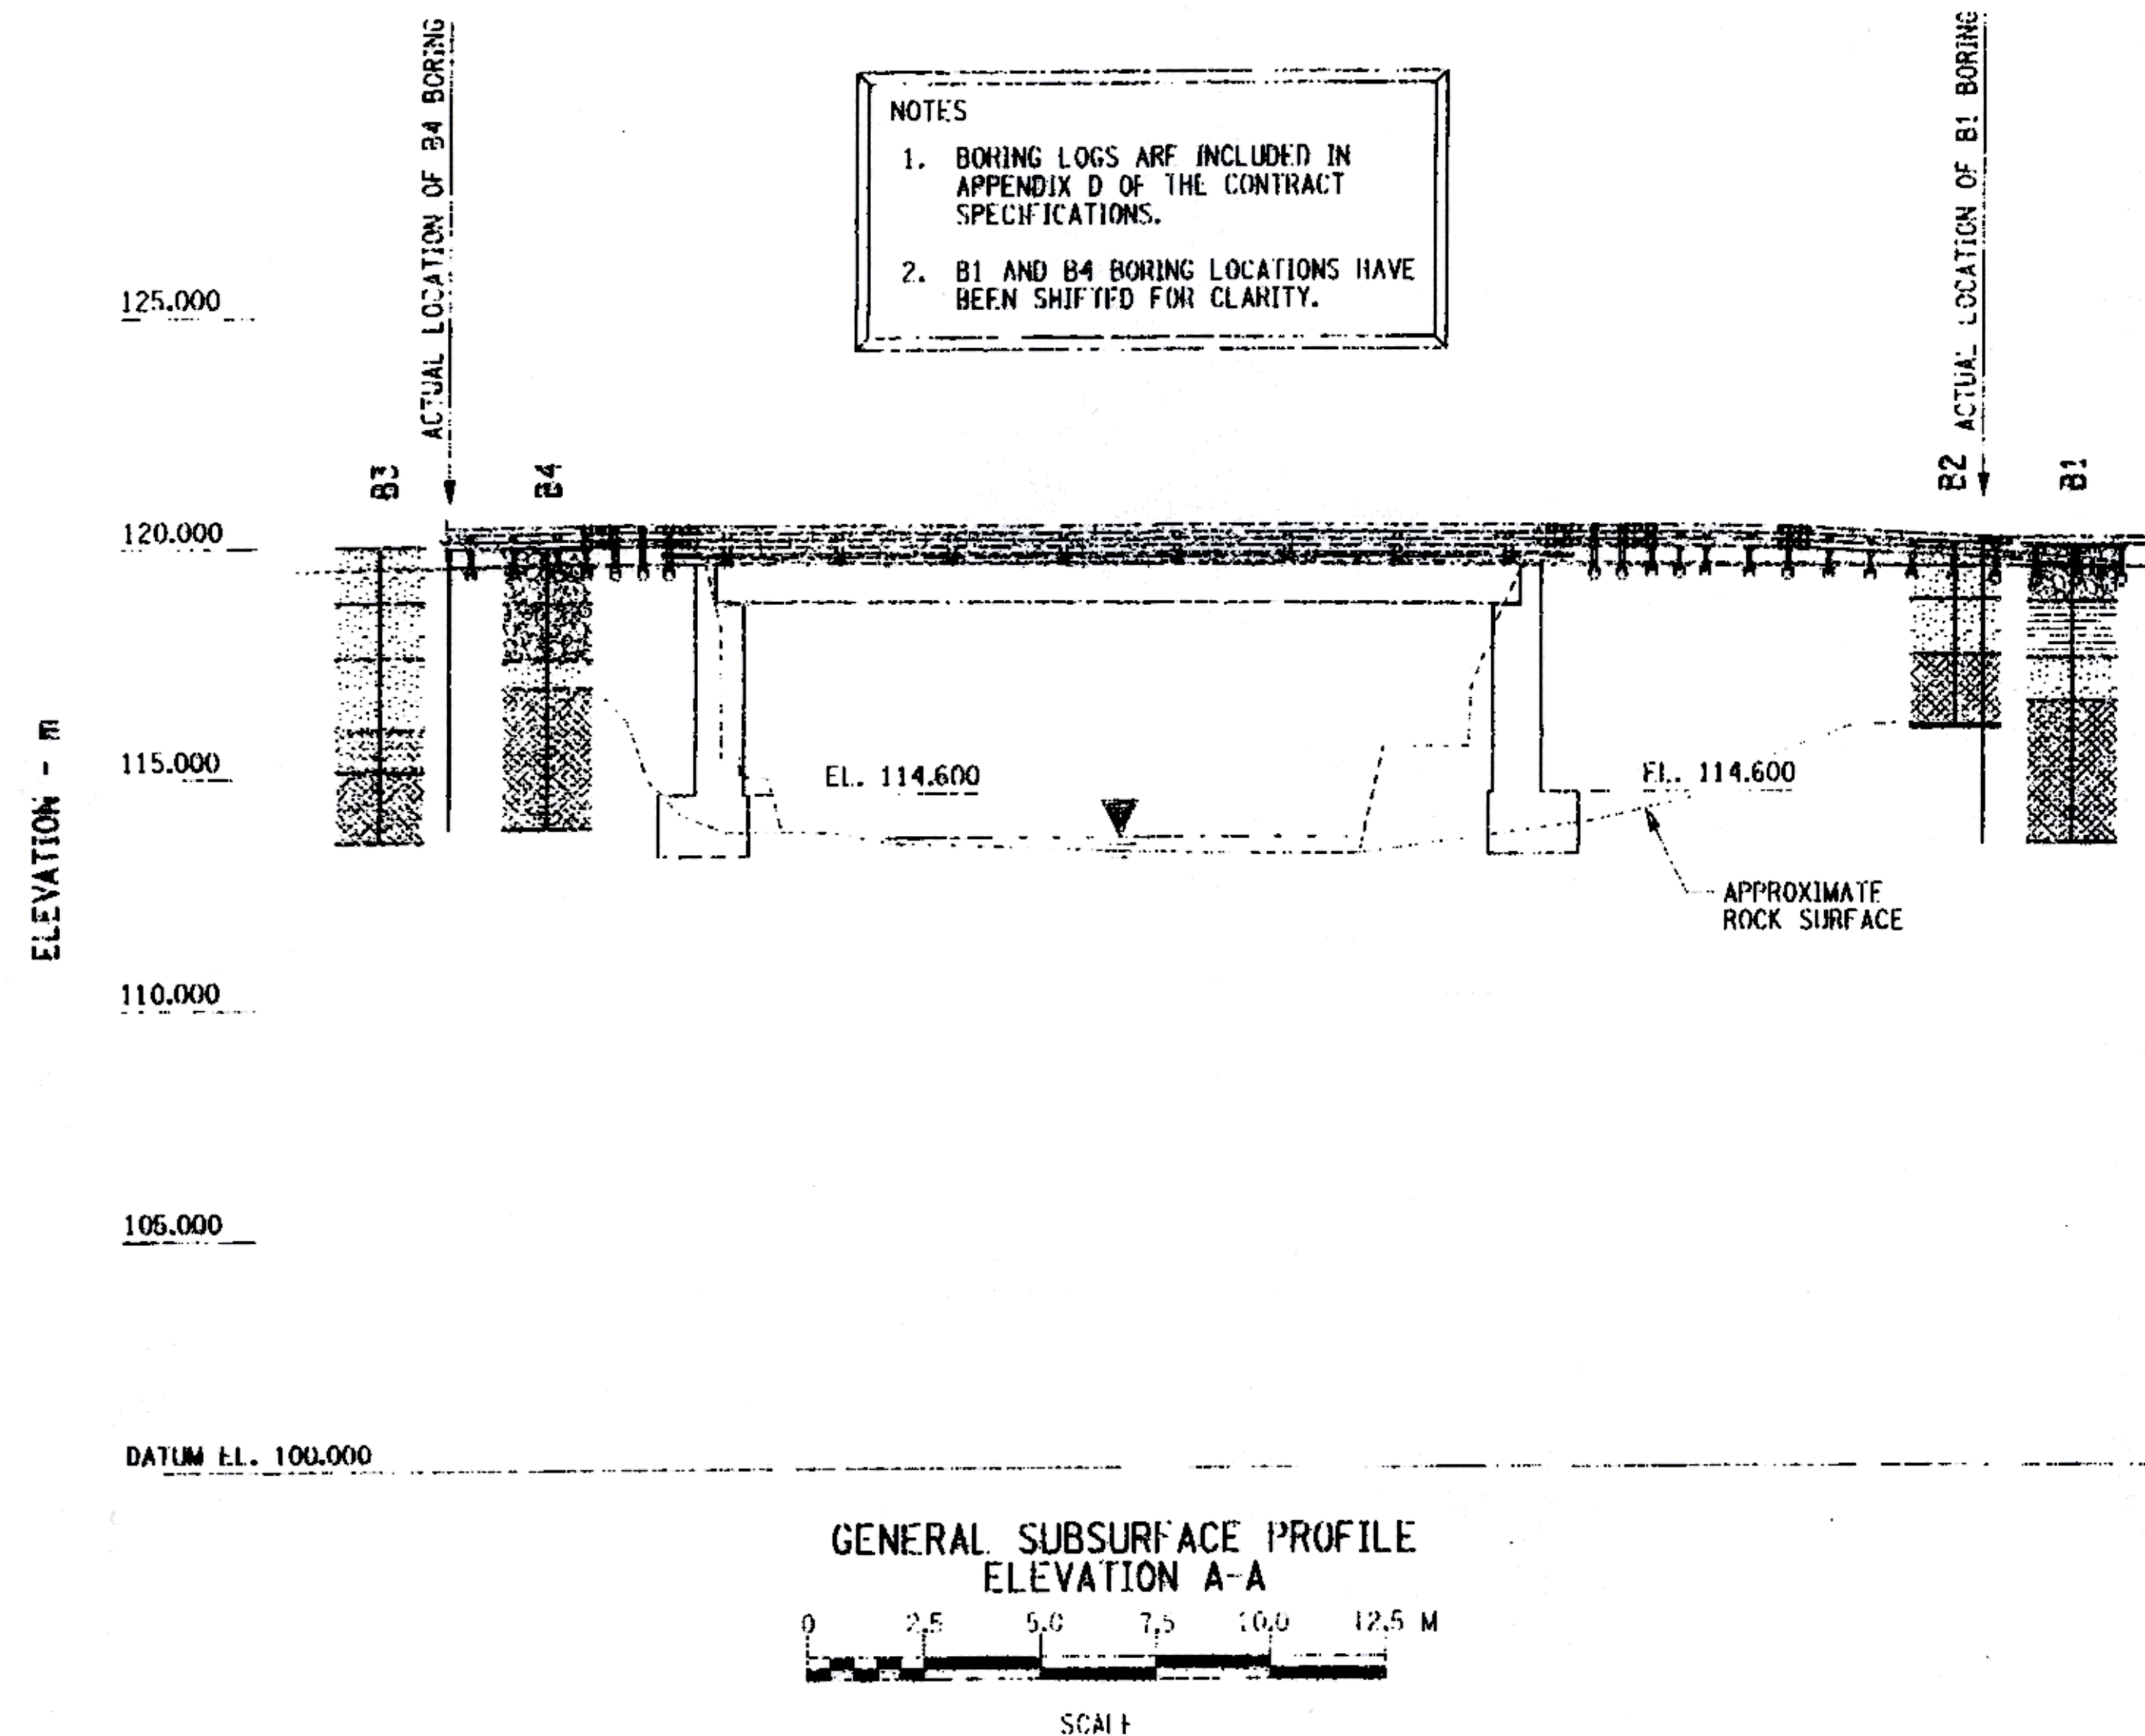

REFERENCE PLANS

PRELIMINARY STRUCTURE
PLANS USED FOR ANALYSIS
WERE:

PREPARED BY: EARTH TECH

GENERAL NOTES

1.) SOUND ENGINEERING JUDGMENT WAS EXERCISED IN PREPARING THE SUBSURFACE INFORMATION PRESENTED HEREON. THIS INFORMATION WAS PREPARED AND IS INTENDED FOR STATE DESIGN AND ESTIMATE PURPOSES ONLY. ITS PRESENTATION ON THE PLANS OR ELSEWHERE IS FOR THE PURPOSE OF PROVIDING INTENDED USERS WITH ACCESS TO THE SAME INFORMATION AVAILABLE TO THE STATE. THIS IS NOT INTENDED AS A SUBSTITUTE FOR PERSONAL INVESTIGATION, INDEPENDENT INTERPRETATIONS OR JUDGEMENT OF THE CONTRACTOR.

2.) GENERAL SOIL AND ROCK (WHERE ENCOUNTERED) STRATUM DESCRIPTIONS AND INDICATED BOUNDARIES ARE BASED ON AN ENGINEERING INTERPRETATION OF ALL AVAILABLE SUBSURFACE INFORMATION BY THE GEOTECHNICAL ENGINEERING BUREAU AND MAY NOT NECESSARILY REFLECT THE ACTUAL VARIATION IN SUBSURFACE CONDITIONS BETWEEN BORINGS AND SAMPLES. DETAILED DATA AND FIELD INTERPRETATIONS OF CONDITIONS ENCOUNTERED IN INDIVIDUAL BORINGS ARE SHOWN ON THE SUBSURFACE EXPLORATION LOGS.

3.) THE OBSERVED WATER LEVELS AND/OR CONDITIONS INDICATED ON THE SUBSURFACE PROFILES ARE AS RECORDED AT THE TIME OF EXPLORATION. ACTUAL WATER LEVELS MAY DIFFER FROM THE OBSERVED WATER LEVEL BECAUSE OF LIMITATIONS IN THE NUMBER AND DURATION OF OBSERVATIONS AND WILL VARY WITH CHANGES IN CLIMATE AND RAINFALL.

4.) ALL STRUCTURE DETAILS AND FOOTING ELEVATIONS SHOWN HEREON ARE FOR ILLUSTRATIVE PURPOSES ONLY AND MAY NOT BE INDICATIVE OF THE FINAL DESIGN CONDITIONS SHOWN ON THE CONTRACT PLANS.

LEGEND

THE FOLLOWING TABLES SUMMARIZE THE DESCRIPTIVE INFORMATION USED ON THIS PROFILE.

DENSITY (NON-PLASTIC SOILS)

Very Loose	0-3
Loose	4-8
Medium Compact	9-20
Compact	21-35
Very Compact	over 35

CONSISTENCY (PLASTIC SOILS)

Very Soft	0-2
Soft	3-6
Firm	7-12
Stiff	13-20
Hard	over 20

NO. OF BLOWS PER 0.3 m OF PENETRATION
OF A 50.8 mm O.D. (34.9 mm I.D.) SAMPLER
USING A 136 kg DROP HAMMER, 457 mm
FALL.

SYMBOLS

DRILL HOLE

VERY LOOSE TO MEDIUM COMPACT
BROWN BROWN-BLACK GRAVEL

VERY LOOSE TO MEDIUM COMPACT
BROWN OLIVE-BROWN BROWN GREY SAND

WOOD FRAGMENTS

GRAY SLATE FRAGMENTS

BLUE-GRAY SLATE WITH CALCITE SEAMS

ALL DIMENSIONS ARE IN mm UNLESS OTHERWISE NOTED
AS BUILT REVISIONS

James E. Sullivan
SIGNATURE

9/2003
DATE

COUNTY ROAD 18 OVER POULTNEY RIVER

BORING LOCATION PLAN
AND GENERAL SUBSURFACE PROFILE

WASHINGTON COUNTY
DEPARTMENT OF PUBLIC WORKS

FILE NAME	REGION	DATE	DRAWING NO.
175376AA.GP1	ONE	3/2002	ST-4

FED ROAD REG. NO.	STATE	CONTRACT NO.	SHEET NO.	TOTAL SHEETS
1	N.Y.		5	43

COUNTY ROAD 18 OVER POLTNEY RIVER
WASHINGTON COUNTY, NY / RUTLAND COUNTY, VT
TOWN OF HAMPTON, NY / POLTNEY, VT
CAPITAL PROJECT IDENTIFICATION NO. 1753.76

FEATURE	SYMBOL	
	EXISTING	PROPOSED
SURVEY DATA		
COORDINATE GRID		
SPOT ELEVATION	+103.2	
WATER ELEVATION	+102.5	
BENCH MARK	B.M. 12	
BASLINE POINT		
PERMANENT SURVEY MARKER POINT ON LINE (P.O.L.)		
NORTH ARROW (GRID)		
NORTH ARROW (MAGNETIC)		
BASLINE		
CENTERLINE		
CONTOURS		
MAJOR ELEVATION CONTOUR		
MINOR ELEVATION CONTOUR		
DEPRESSION		
TOPOGRAPHY		
ROCK OUTCROP		
BOULDER		
CUT LIMITS		
FILL LIMITS		
BOUNDARIES		
NATIONAL	CANADA U.S.A.	
STATE	NEW YORK CONNECTICUT MASSACHUSETTS VERMONT	
COUNTY	ALBANY CATTARAUGUS CHENANGO COLUMBIANA DARWIN DECATUR FRANKLIN HAMILTON HUNTERDON MADISON MONTGOMERY ORANGE PUTNAM SARATOGA SCHENECTADY SCHOENHOOD SHERBORN TOWN OF DICKINSON TOWN OF FORTYON CITY OF BINGHAMTON PORT JEFFERSON	
TOWN		
CITY OR VILLAGE		
PUBLIC LAND		
HIGHWAY BOUNDARY		
PROPERTY LINE		
PROPERTY LINE MARKER		
EASEMENT LINE		
RIGHT OF WAY LINE & MON.		
ACCESS INFORMATION	ROW W/O/A ROW W/A	
ACQUISITION INFORMATION		
FEE WITH ACCESS		
PERMANENT EASEMENT		
TEMPORARY EASEMENT		
TEMPORARY OCCUPANCY		

FEATURE	SYMBOL	
	EXISTING	PROPOSED
RAILROADS		
RAILROAD (1/4" > 500 SCALE)		
RAILROAD (1/4" < 500 SCALE)		
RAILROAD (ABANDONED)		
RAILROAD W/ CATERARY		
RAILROAD W/ ELECTRIC RAIL		
RAILROAD GRADE CROSSING GATE		
TREES AND BRUSH		
DECIDUOUS TREE		
CONIFEROUS TREE		
DECIDUOUS BUSH		
CONIFEROUS BUSH		
TREE TO BE REMOVED		
STUMP		
HEDGE		
BURN LINE		
WOODED AREA EDGE		
DECIDUOUS TREE ROW		
CONIFEROUS TREE ROW		
FOUNDATION PLANTING		
BUILDING AND SPECIAL SITES		
BUILDING		
BUILDING TO BE DEMOLISHED		
BUILDING UNDER CONSTRUCTION		
UNDERPASS		
MAILBOX		
POST, FLAGPOLE, PARKING METER (POLE (NON-UTILITY))		
WELL		
WATER LOCATIONS		
STREAM OR RIVER		
WATERFALLS OR RAPIDS		
INTERMITTENT STREAM		
SPRING		
MARSH OR SWAMP		
EDGE OF WATERWAY OR FEATURE		

FEATURE	SYMBOL	
	EXISTING	PROPOSED
ROUTE MARKERS		
INTERSTATE		
STATE		
COUNTY		
COUNTY TOURING ROUTE SHIELD		
TOWN		
U.S.		
ROADS		
PAVED ROADWAY		
UNPAVED ROADWAY		
SIDEWALK		
CURB/DROP CURB AS L.O.P.		
CHANGE OF PAVEMENT		
FLUSH MEDIAN		
GUIDE RAIL OR BARRIER		
TRAFFIC ATTENUATOR		
BOX BEAM OR "W" BEAM RAIL		
BOX BEAM OR "W" BEAM MED. BARR.		
CABLE GUIDE RAIL		
CONCRETE BARRIER		
RETAINING WALL		
FENCE		
GUIDE POSTS		
STONE WALL		
BARRICADE		
TRAFFIC CONTROL		
TEMPORARY CONCRETE BARRIER		
TEMPORARY CONCRETE BARRIER LIGHTED		
CONSTRUCTION BARRICADE		
CONST. BARRICADE LIGHTED		
PLASTIC DRUM		
PLASTIC DRUM LIGHTED		
FLASHING ARROW BOARD		
CONE		
FLAGGER		
VARIABLE MESSAGE DISPLAY		
SIGNS AND BILLBOARDS		
SIGN (GROUND MOUNTED)		
SIGN (OVERHEAD)		
BILLBOARD		
TWO POST SIGN		
SIGN LOCATION AND TEXT		
SIGN LOCATION AND MULTIPLE TEXT		
SIGN REMOVAL LOCATION		
SIGN TO BE RELOCATED		
SIGN TO REMAIN		

FEATURE	SYMBOL	
	EXISTING	PROPOSED
DRAINAGE FACILITIES		
CULVERT		
DRAINAGE STRUCTURE	DS DS DS DS	
GRATE	GRATE GRATE	
DITCH LINE		
PAVED GUTTER	PAVED GUTTER	
HEADWALL		
END SECTION		
RIP-RAP		
SANITARY SEWER	SA SA SA	
STORM SEWER	ST ST ST	
EROSION & SEDIMENTATION CONTROL		
STATE WETLAND	SW SW SW	
FEDERAL WETLAND	FW FW FW	
STATE/FED WETLAND	SW FW SW FW	
ADJACENT AREA	AA AA AA	
HAYBALE/STRAW BALE		
SILT FENCE		
VEGETATION FENCE		
SILT/VEG FENCE		
TURBIDITY CURTAIN		
SEDIMENT TRAP		
CHECK DAM (SILT FENCE)		
CHECK DAM (HAYBALE/STRAWBALE)		
CHECK DAM (STONE)		
UTILITY LINES		
UNDERGROUND ELECTRIC	UE UE UE	
OVERHEAD ELECTRIC	OE OE OE	
OVERHEAD ELECTRIC TRANSMISSION LINE	OE TL OE TL	
UNDERGROUND TELEPHONE	UT UT UT	
OVERHEAD TELEPHONE	OT OT OT	
UNDERGROUND CABLE T.V.	UCTV UCTV UCTV	
OVERHEAD CABLE T.V.	OCTV OCTV OCTV	
UNDERGROUND FIBER OPTIC	UFO UFO UFO	
OVERHEAD FIBER OPTIC	OFO OFO OFO	
GAS	G G G	
OIL	O O O	
WATER	W W W	
GEOTECHNICAL		
BORING LOCATION		
SHEET PILING		

FEATURE	SYMBOL	
	EXISTING	PROPOSED
UTILITIES ABOVE GROUND		
UTILITY POLE		
GUY WIRE W/ANCHOR		
TRANS. LINE AND TOWERS		
TRANS. LINE AND POLES		
LIGHT POLE		
PULLBOX STREET LIGHTS		
TRAFFIC SIGNAL POLE		
UTILITY BOX		
PULLBOX TRAFFIC SIGNALS		
RR SIGNALS		
TRAFFIC SIGNAL		
CALT. BOX POLICE, FIRE		
TELEPHONE BOOTH		
PAPER BOX		
ELECTRIC METER		
GAS METER		
WATER METER		
FIRE HYDRANT		
GAS LINE MARKER		
GUY WIRE		
WATER MANHOLE		
SANITARY SEWER MANHOLE		
TELEPHONE MANHOLE		
GAS MANHOLE		
MISC. MANHOLE		
WATER VALVE		
UTILITY VALVE		
GAS VALVE		

ALL DIMENSIONS ARE IN mm UNLESS OTHERWISE NOTED
AS BUILT REVISIONS

Lawrence E. Hines 9/2003
SIGNATURE DATE

COUNTY ROAD 18 OVER POLTNEY RIVER
LEGEND

WASHINGTON COUNTY
DEPARTMENT OF PUBLIC WORKS

FILE NAME 175376A1.EG REGION ONE DATE 3/2002 DRAWING NO. LE-1

AS BUILT: NO REVISIONS 9/2003

ESTIMATE OF QUANTITIES

ITEM NO.	DESCRIPTION	UNIT	ESTIMATED	FINAL
201.06M	CLEARING AND GRUBBING	NEC	1	
202.120001M	REMOVING EXISTING SUPERSTRUCTURES	NFE	1	
202.19M	REMOVAL OF SUBSTRUCTURES	CM	250	
203.02M	UNCLASSIFIED EXCAVATION AND DISPOSAL	CM	385	
203.03M	EMBANKMENT IN PLACE	CM	145	
203.21M	SELECT STRUCTURE FILL	CM	580	
205.01M	STRUCTURE EXCAVATION	CM	765	
207.15M	PREFABRICATED COMPOSITE STRUCTURAL DRAIN	SM	180	
209.05M	RAILROAD/STRAWDRALE	M	10	
209.07M	TURBIDITY CURTAIN	SM	43	
209.08M	SILT FENCE	M	54	
210.5303M	REMOVAL AND DISPOSAL OF ASBESTOS-CONTAINING BOND BREAKERS AND/OR JOINT FILLERS	NEC	1	
304.12M	SUBBASE COURSE, TYPE 2	CM	195	
403.110001M	ASPHALT CONCRETE - TYPE 1 BASE COURSE	MT	125	
403.130001M	ASPHALT CONCRETE - TYPE 3 BINDER COURSE	MT	45	
403.170001M	ASPHALT CONCRETE - TYPE 6F TOP COURSE (FRICTION) MARSHALL DESIGN	MT	45	
407.01M	TACK COAT	L	145	
08520.5014M	SAWCUT ASPHALT PAVEMENT, CONCRETE PAVEMENT AND ASPHALT OVERLAY ON CONCRETE PAVEMENT	M	52	
552.16M	EXCAVATION PROTECTION SYSTEM	SM	394	
553.02M	COFFERDAMS (TYPE 2)	EA	2	
555.0104M	FOOTING CONCRETE, CLASS A	CM	85	
555.0105M	CONCRETE FOR STRUCTURES, CLASS A	CM	200	
556.0202M	EPoxy-COATED BAR REINFORCEMENT FOR STRUCTURES	KG	12/45	
557.05M	SUPERSTRUCTURE SLAB WITH INTEGRAL WEARING SURFACE - BOTTOM FORMWORK NOT REQUIRED	SM	227	
557.20M	STRUCTURAL APPROACH SLAB WITH INTEGRAL WEARING SURFACE	SM	118	
558.01M	TRANSVERSE SAWCUT GROOVING OF STRUCTURAL SLAB SURFACE	SM	300	
18559.1696M	PROTECTIVE SEALING OF STRUCTURAL CONCRETE	SM	303	
18559.1896M	PROTECTIVE SEALING OF STRUCTURAL CONCRETE FOR NEW BRIDGE DECKS AND BRIDGE DECK OVERLAYS	SM	360	
563.02M	PRESTRESSED CONCRETE BOX BEAM UNITS	SM	205	
565.1922M	TYPE E.I. BEARING (251 TO 500 MM)	EA	20	
568.54M	STEEL BRIDGE RAILING (THREE RAIL)	M	46.88	
606.10M	BOX BEAM GUIDE RAILING	M	36.0	
606.100001M	BOX BEAM GUIDE RAILING (SHOP CURVED)	M	5.4	
606.1201M	BOX BEAM GUIDE RAILING END ASSEMBLY TYPE 1	EA	2	
606.63M	REMOVING AND STORING BOX BEAM GUIDE RAILING	M	52	
606.6928M	REMOVING AND STORING BOX BEAM GUIDE RAILING END ASSEMBLY	EA	2	
16606.80M	TRANSITION - BRIDGE RAILING OR CONCRETE BARRIER TO BOX BEAM GUIDE RAIL	M	34.89	
610.0209M	ESTABLISHING TOP	SM	130	
613.0101M	TOPSOIL	CM	10	
619.01M	BASIC MAINTENANCE AND PROTECTION OF TRAFFIC	NEC	1	
619.02M	CONSTRUCTION SIGNS	NEC	1	
619.0413M	TYPE III CONSTRUCTION BARRICADES	M	8.6	
619.0602M	LIGHTING FOR CONSTRUCTION BARRICADES	M	8.6	
10619.0939M	LIGHTS FOR CONCRETE BARRIER	M	42.7	
619.17M	TEMPORARY CONCRETE BARRIER	M	42.7	
619.2101M	CONSTRUCTION ZONE PAVEMENT MARKING STRIPES (OPTIONAL)	M	67.6	
625.01M	SURVEY AND STAKEOUT	NEC	1	
637.03M	CONCRETE CYLINDER CURING BOX	EA	1	
637.0502M	ENGINEER'S OFFICE TYPE A	MO	12	
15637.35M	MICROCOMPUTER SYSTEM	EA	1	
15637.51M	DIGITAL CAMERA SYSTEM	FLS	1	
15637.91M	CHAMP MANAGEMENT SYSTEM	FLS	1	
640.20M	WHITE PAINT REFLECTORIZED PAVEMENT STRIPES - 0.51 mm	M	107	
640.21M	YELLOW PAINT REFLECTORIZED PAVEMENT STRIPES - 0.51 mm	M	101	
647.02M	REMOVAL OF SIGNS - SIZE B (1.1 TO 2.0 SQUARE METERS)	EA	2	
647.12M	RELOCATING SIGNS - SIZE B (1.1 TO 2.0 SQUARE METERS)	EA	2	
697.01M	INTERIM PAYMENT	FLS	1	
698.01M	ASPHALT PRICE ADJUSTMENT	FLS	1	
698.02M	FUEL PRICE ADJUSTMENT	FLS	1	
699.04M	MOBILIZATION (4%)	NEC	1	

FED ROAD REC. NO.	STATE	CONTRACT NO.	SHEET NO.	TOTAL SHEETS
1	N.Y.		4	43
COUNTY ROAD 18 OVER POLLITNEY RIVER				
WASHINGTON COUNTY, NY / RUTLAND COUNTY, VT				
TOWN OF HAMPTON, NY / POLLITNEY, VT				
CAPITAL PROJECT IDENTIFICATION NO. 1753.76				

AS BUILT: NO REVISIONS 9/2003

ALL DIMENSIONS ARE IN mm UNLESS OTHERWISE NOTED

AS BUILT REVISIONS

Lawrence E. Starnes
SIGNATURE

9/2003
DATE

COUNTY ROAD 18 OVL R POLLITNEY RIVER

SUMMARY OF QUANTITIES

WASHINGTON COUNTY
DEPARTMENT OF PUBLIC WORKS

FILE NAME 175376AA.N1A	REGION ONE	DATE 5/2002	DRAWING NO. PLAN-1
---------------------------	---------------	----------------	-----------------------

INDEX

SHEET NO.	DESCRIPTION	DRAWING NO.
1	TITLE SHEET	COVER
2	INDEX AND ABBREVIATIONS	IN-1
3	TYPICAL SECTIONS	TS-1
4	SUMMARY OF QUANTITIES	QUAN-1
5	LEGEND	LE-1
6	MAINTENANCE & PROTECTION OF TRAFFIC (SHEET 1 OF 4)	MPT-1
7	MAINTENANCE & PROTECTION OF TRAFFIC (SHEET 2 OF 4)	MPT-2
8	MAINTENANCE & PROTECTION OF TRAFFIC (SHEET 3 OF 4)	MPT-3
9	MAINTENANCE & PROTECTION OF TRAFFIC (SHEET 4 OF 4)	MPT-4
10	MISCELLANEOUS TABLES	MT-1
11	GENERAL PLAN	GP-1
12	PROFILE	GP-2
13	BASIS LINE TIES AND TABLE OF MAINTENANCE JURISDICTION	BLT-1
14	EROSION AND SEDIMENT CONTROL PLAN	EPC-1
15	EROSION AND SEDIMENT CONTROL DETAILS	EPC-2
16	PROJECT LIMIT SIGNING AND STRIPING PLAN & DETAILS	SSP-1
17	PLAN AND ELEVATION	ST-1
18	TYPICAL BRIDGE SECTIONS	ST-2
19	GENERAL NOTES	ST-3
20	BORING LOCATION PLAN AND GENERAL SUBSURFACE PROFILE	ST-4
21	REMOVAL OF EXISTING STRUCTURES	ST-5
22	EXCAVATION AND EMBANKMENT DETAILS	ST-6
23	EXCAVATION AND EMBANKMENT SECTION	ST-7
24	WEST ABUTMENT PLAN AND ELEVATION	ST-8
25	WEST ABUTMENT PLAN AND WINGWALL ELEVATION REINFORCEMENT	ST-9
26	WEST ABUTMENT SECTION REINFORCEMENT	ST-10
27	EAST ABUTMENT PLAN AND ELEVATION	ST-11
28	EAST ABUTMENT PLAN AND U-WALL ELEVATION REINFORCEMENT	ST-12
29	EAST ABUTMENT SECTION REINFORCEMENT	ST-13
30	MISCELLANEOUS CONCRETE DETAILS	ST-14
31	TRANSVERSE SECTION AND PRESTRESSED CONCRETE BEAM LAYOUT	ST-15
32	PRESTRESSED CONCRETE BEAM DETAILS (SHEET 1 OF 2)	ST-16
33	PRESTRESSED CONCRETE BEAM DETAILS (SHEET 2 OF 2)	ST-17
34	ELASTOMERIC BEARINGS AND BOX BEAM ANCHOR DETAIL/MISC. DETAILS	ST-18
35	APPROACH SLAB	ST-19
36	RAILING LAYOUT	ST-20
37	BRIDGE RAIL (SHEET 1 OF 4)	ST-21
38	BRIDGE RAIL (SHEET 2 OF 4)	ST-22
39	BRIDGE RAIL (SHEET 3 OF 4)	ST-23
40	BRIDGE RAIL (SHEET 4 OF 4)	ST-24
41	BAR BENDING DIAGRAM	ST-25
42	BARLIST (SHEET 1 OF 2)	ST-26
43	BARLIST (SHEET 2 OF 2)	ST-27

ALIGNMENT

AH	= AHEAD
AZ	= AZIMUTH
BA	= BACK
BL	= BASELINE
BNG	= BEARING
CL	= CENTERLINE
CS	= CURVE TO SPIRAL
e	= CROSS SLOPE
EQ	= EQUALITY
EXT	= EXTERNAL
HCL	= HORIZONTAL CONTROL LINE
HSD	= HEADLIGHT SIGHT DISTANCE
L	= LENGTH OF CIRCULAR CURVE
LS	= LENGTH OF SPIRAL
LVC	= LENGTH OF VERTICAL CURVE
MC	= CENTER CORRECTION OF VERTICAL CURVE
ML	= MAIN LINE
PC	= POINT OF CURVATURE
PI	= POINT OF INTERSECTION
POL	= POINT ON LINE
PSD	= PASSING SIGHT DISTANCE
PT	= POINT OF TANGENT
PVC	= POINT OF VERTICAL CURVE
PVI	= POINT OF VERTICAL INTERSECTION
PVT	= POINT OF VERTICAL TANGENT
R	= RADIUS
SC	= SPIRAL TO CURVE
SSD	= STOPPING SIGHT DISTANCE
ST	= SPIRAL TO TANGENT
STA	= STATION
T	= TANGENT LENGTH
TGL	= THEORETICAL GRADE LINE
TS	= TANGENT TO SPIRAL
VC	= VERTICAL CURVE

TOPOGRAPHY (DRAINAGE)

BB	= BOTTOM OF BANK (STREAM)
BC	= BOTTOM OF CURB
BO	= BOTTOM OF OPENING
CAP	= CORRUGATED ALUMINUM PIPE
CB	= CATCH BASIN
CIP	= CAST IRON PIPE
CL	= CENTERLINE OF STREAM
CMP	= CORRUGATED METAL PIPE
CP	= CONCRETE PIPE
CSP	= CORRUGATED STEEL PIPE
CULV	= CULVERT
DIA	= DIAMETER
DMH	= DRAINAGE MANHOLE
DS	= DRAINAGE STRUCTURE
D'XING	= DITCH CROSSING
ELW	= EXTREME HIGH WATER
EL	= ELEVATION
ELV	= ELEVATION
ELW	= EXTREME LOW WATER
ES	= END SECTION
HW	= HEADWALL
INV	= INVERT
MH	= MANHOLE
MHW	= MEAN HIGH WATER
OHW	= ORDINARY HIGH WATER
OLW	= ORDINARY LOW WATER
STOPP	= SMOOTH INTERIOR CORRUGATED PE PIPE
ROP	= REINFORCED CONCRETE PIPE
TB	= TOP OF BANK (STREAM)
TC	= TOP OF CURB
TG	= TOP OF GRATE
VCP	= VITRIFIED CLAY PIPE

TOPOGRAPHY (MISCELLANEOUS)

ABUT	= ABUTMENT
AOBE	= AS ORDERED BY ENGINEER
ASPH	= ASPHALT
BDY	= BOUNDARY
BLDG	= BUILDING
BM	= BENCH MARK
CC	= CENTER TO CENTER
CONC	= CONCRETE
CONGT	= CONSTRUCTION
CR	= COUNTY ROAD
D	= DEED DISTANCE
DM	= DIRECT MEASUREMENT
DMY	= DRIVEWAY
EP	= EDGE OF PAVEMENT
ES	= EDGE OF SHOULDER
FP	= FENCE POST
FD	= FOUNDATION
FL	= FENCE LINE
GAR	= GARAGE
GR	= GRAVEL
HO	= HOUSE
HWY	= HIGHWAY
IP	= IRON PIN OR IRON PIPE
MB	= MAILBOX
MON	= MONUMENT
N&W	= NAIL AND WASHER
OG	= ORIGINAL GROUND
O/H	= OVERHEAD
P	= PARCEL
PAV'T	= PAVEMENT
PE	= PERMANENT EASEMENT
PED POLE	= PEDESTRIAN POLE
P	= PROPERTY LINE
POR	= PORCH
RR	= RAILROAD
RTE	= ROUTE
ROW	= RIGHT OF WAY
ROW W/A	= RIGHT OF WAY WITH ACCESS
ROW W/O/A	= RIGHT OF WAY WITHOUT ACCESS
RW	= RETAINING WALL
SH	= STATE HIGHWAY
SHDR	= SHOULDER
SPK	= SPIKE
ST	= STREET
STK	= STAKE
STY	= STORY
SW	= SIDEWALK
TE	= TEMPORARY EASEMENT
TO	= TEMPORARY OCCUPANCY
U/G	= UNDERGROUND
WW	= WING WALL

AS BUILT: NO REVISIONS 9/2003

STANDARD SYMBOL (PLANS)	ITEM PAYMENT UNIT: ESTIMATE OF QUANTITIES SHEET	EQUIVALENT NOMENCLATURE: SPEC BOOK/PROPOSAL
m	M	METER
m ²	SQM	SQUARE METER
m ³	CM	CUBIC METER
km	KM	KILOMETER
ha	HA	HECTARE
kg	KG	KILOGRAMS
† OR Mg	MT	METRIC TON
L	L	LITER

* THE METRIC TON EQUIVALENT TO THE MEGAGRAM (Mg)

FED ROAD REF. NO.	STATE	CONTRACT NO.	SHEET NO.	TOTAL SHEETS
1	N.Y.		2	43
COUNTY ROAD 18 OVER POULTNEY RIVER				
WASHINGTON COUNTY, NY / RUTLAND COUNTY, VT				
TOWN OF HAMPTON, NY / POULTNEY, VT				
CAPITAL PROJECT IDENTIFICATION NO. 1753.76				

UTILITIES

E	= ELECTRIC
EMH	= ELECTRIC MANHOLE
G	= GAS
GP	= GUY POLE
GSB	= GAS SERVICE BOX (HOUSE LINE)
GV	= GAS VALVE (MAIN LINE)
HYD	= HYDRANT
LP	= LIGHT POLE
LPG	= LOW PRESSURE GAS
HP	= POWER POLE
SA	= SANITARY SEWER
SMH	= SANITARY MANHOLE
ST	= STORM SEWER
T	= TELEPHONE
TCB	= TRAFFIC CONTROL BOX
TELBOX	= TELEPHONE BOX
TEL P	= TELEPHONE POLE
TMH	= TELEPHONE MANHOLE
CTV	= CABLE TELEVISION
W	= WATER
WSB	= WATER SERVICE BOX (HOUSE LINE)
WV	= WATER VALVE (MAIN LINE)

SUBSURFACE EXPLORATION

STANDARD SYMBOL	ANC-1
REPLACE ABBREVIATION "AB" WITH:	
AB	= HAND AUGER
CP	= CONE PENETROMETER
DA	= 60 mm CASSED DRILL HOLE
DM	= DRILLING MUD
DN	= 100 mm CASSED DRILL HOLE
FH	= HOLLOW FLIGHT AUGER
PA	= POWER AUGER
PH	= PROBE
PT	= PERCOLATION TEST HOLE
RP	= 25 mm SAMPLER (RETRACTABLE PLUG)
SP	= SEISMIC POINT
TP	= TEST PIT
REPLACE ABBREVIATION "C" IN CATEGORIES: DA, DM, DN AND FH WITH:	
B	= BRIDGE
C	= CUT
D	= DAM
F	= FILL
K	= CULVERT
W	= WALL
X	= TO BE USED IF ONE OF THE ABOVE CANNOT BE DEFINED AT THE TIME THE EXPLORATION IS MADE

ALL DIMENSIONS ARE IN mm UNLESS OTHERWISE NOTED

AS BUILT REVISIONS

Signature: *James E. Johnson* DATE: 9/2003

COUNTY ROAD 18 OVER POULTNEY RIVER
INDEX AND ABBREVIATIONS

WASHINGTON COUNTY
DEPARTMENT OF PUBLIC WORKS

FILE NAME	REGION	DATE	DRAWING NO.
175376AAJ.NX	ONE	3/2002	IN-1

FED. ROAD REG. NO.	STATE	CONTRACT NO.	SHEET NO.	TOTAL SHEETS
1	N.Y.		24	43

COUNTY ROAD 18 OVER POULTNEY RIVER
WASHINGTON COUNTY, NY / RUTLAND COUNTY, VT
TOWN OF HAMPTON, NY / POULTNEY, VT
CAPITAL PROJECT IDENTIFICATION NO. 1753.76

AS BUILT: NO REVISIONS 9/2003

CONCRETE TABLE (m³)		
POUR	ITEM	ITEM
	555.0104 M	555.0105 M
1	46.4	---
2	---	69.8
3	---	16.1
4	---	16.1
5	---	4.0
TOTAL	46.4	106.0

NOTE:
POUR # DOES NOT NECESSARILY INDICATE
CONSTRUCTION SEQUENCE.

NOTES:
FOR DESIGN PURPOSES, THE MAXIMUM FOOTING PRESSURE
DOES NOT EXCEED 1.0 MPa.
REINFORCEMENT NOT SHOWN
FOR SECTION A-A SEE DWG. NO. ST-10.
FOR SECTION B-B SEE DWG. NO. ST-10.
FOR WEST ABUTMENT REINFORCEMENT PLANS AND WINGWALL
REINFORCEMENT ELEVATION SEE DWG. NO. ST-9.
FOR WATERSTOP DETAIL, SEE DWG. NO. ST-14.
FOR CHAMFER DETAIL, SEE DWG. NO. ST-14.





ALL DIMENSIONS ARE IN mm UNLESS OTHERWISE NOTED

AS BUILT REVISIONS

Signature 9/2003
SIGNATURE DATE

COUNTY ROAD 18 OVER POULTNEY RIVER
WEST ABUTMENT
PLAN AND ELEVATION
WASHINGTON COUNTY
DEPARTMENT OF PUBLIC WORKS

FILENAME 175376AA.11A	REGION ONE	DATE 3/2002	DRAWING NO. ST-8
--------------------------	---------------	----------------	---------------------

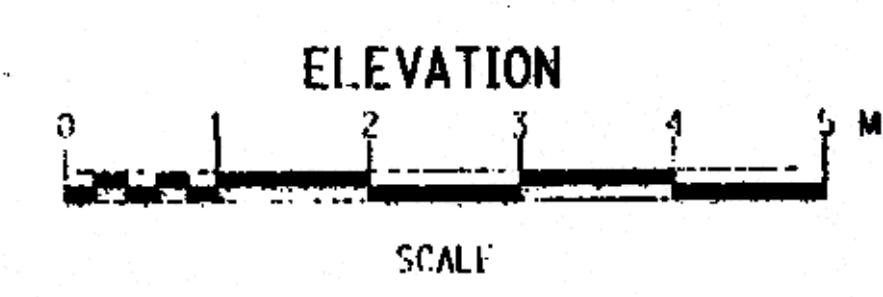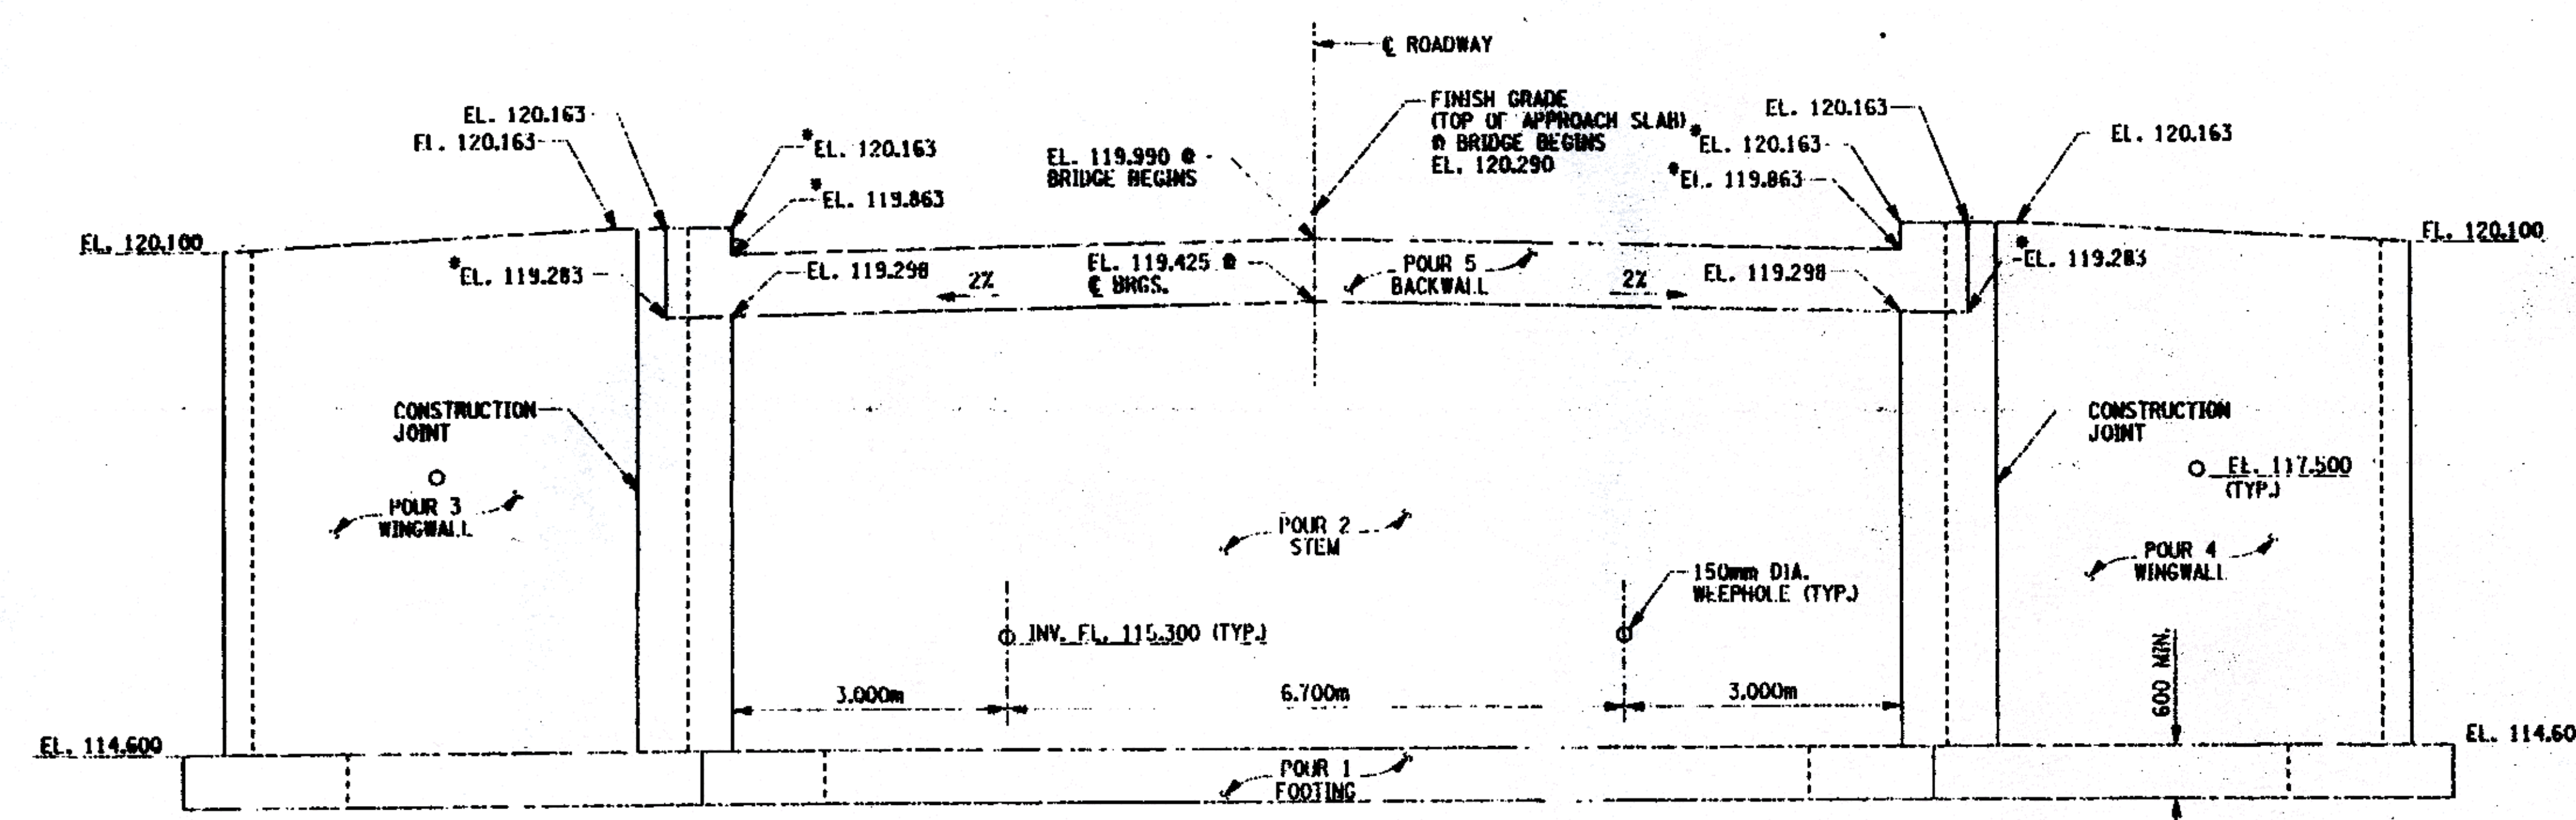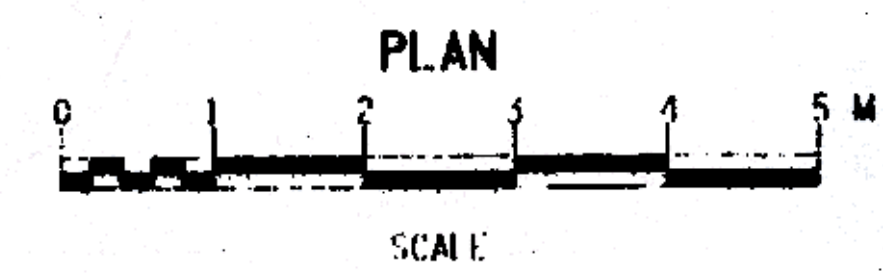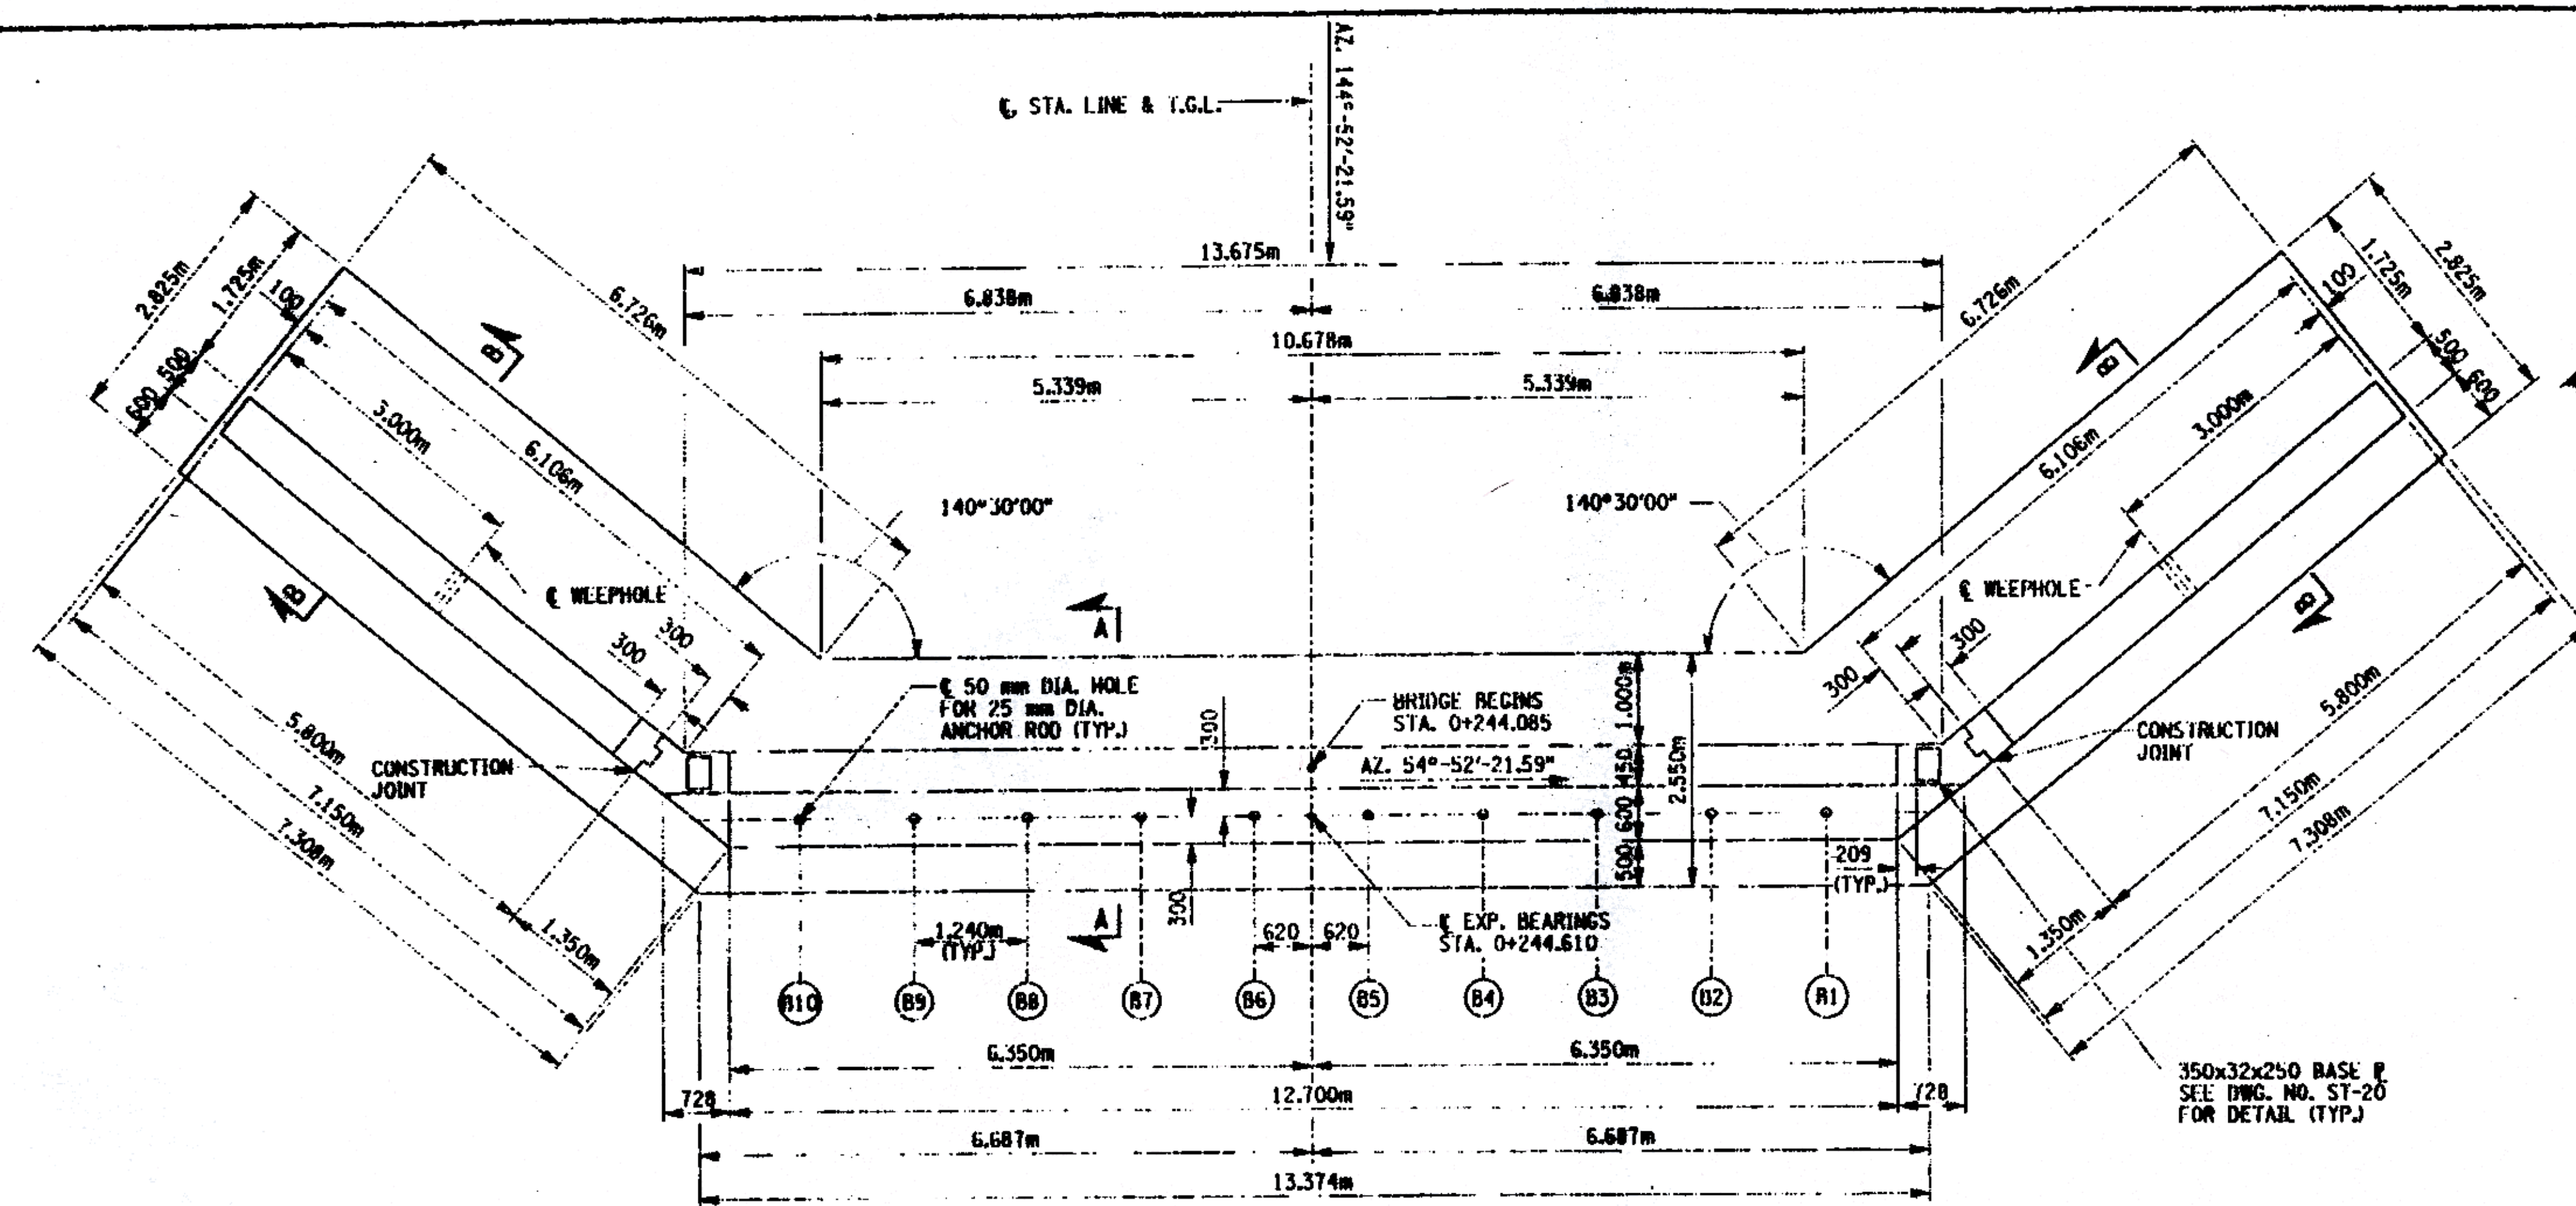

* INDICATES ELEVATIONS TAKEN AT FRONT
FACE OF BACKWALL.

FILE NAME: I:\work\175376\175376.dwg
DATE/TIME: 11/24/2003 10:43:17 AM
USER: JLN

DESIGNED BY: JLN
CHECKED BY: JLN
ESTIMATED BY: JLN
DRAFTED BY: JLN
JOB MANAGER: JLN
DESIGN SUPERVISOR: JLN

FILE NAME: J:\WORK\175376\175376A1C\175376A1C.dwg
DATE/TIME: 11/04/2003 10:05:44 AM
USER: JLN

DESIGN SUPERVISOR: JLN


DESIGNED BY: JLN

CHECKED BY: JLN


ESTIMATED BY: JLN

DRAWN BY: JLN

CHECKED BY: JLN

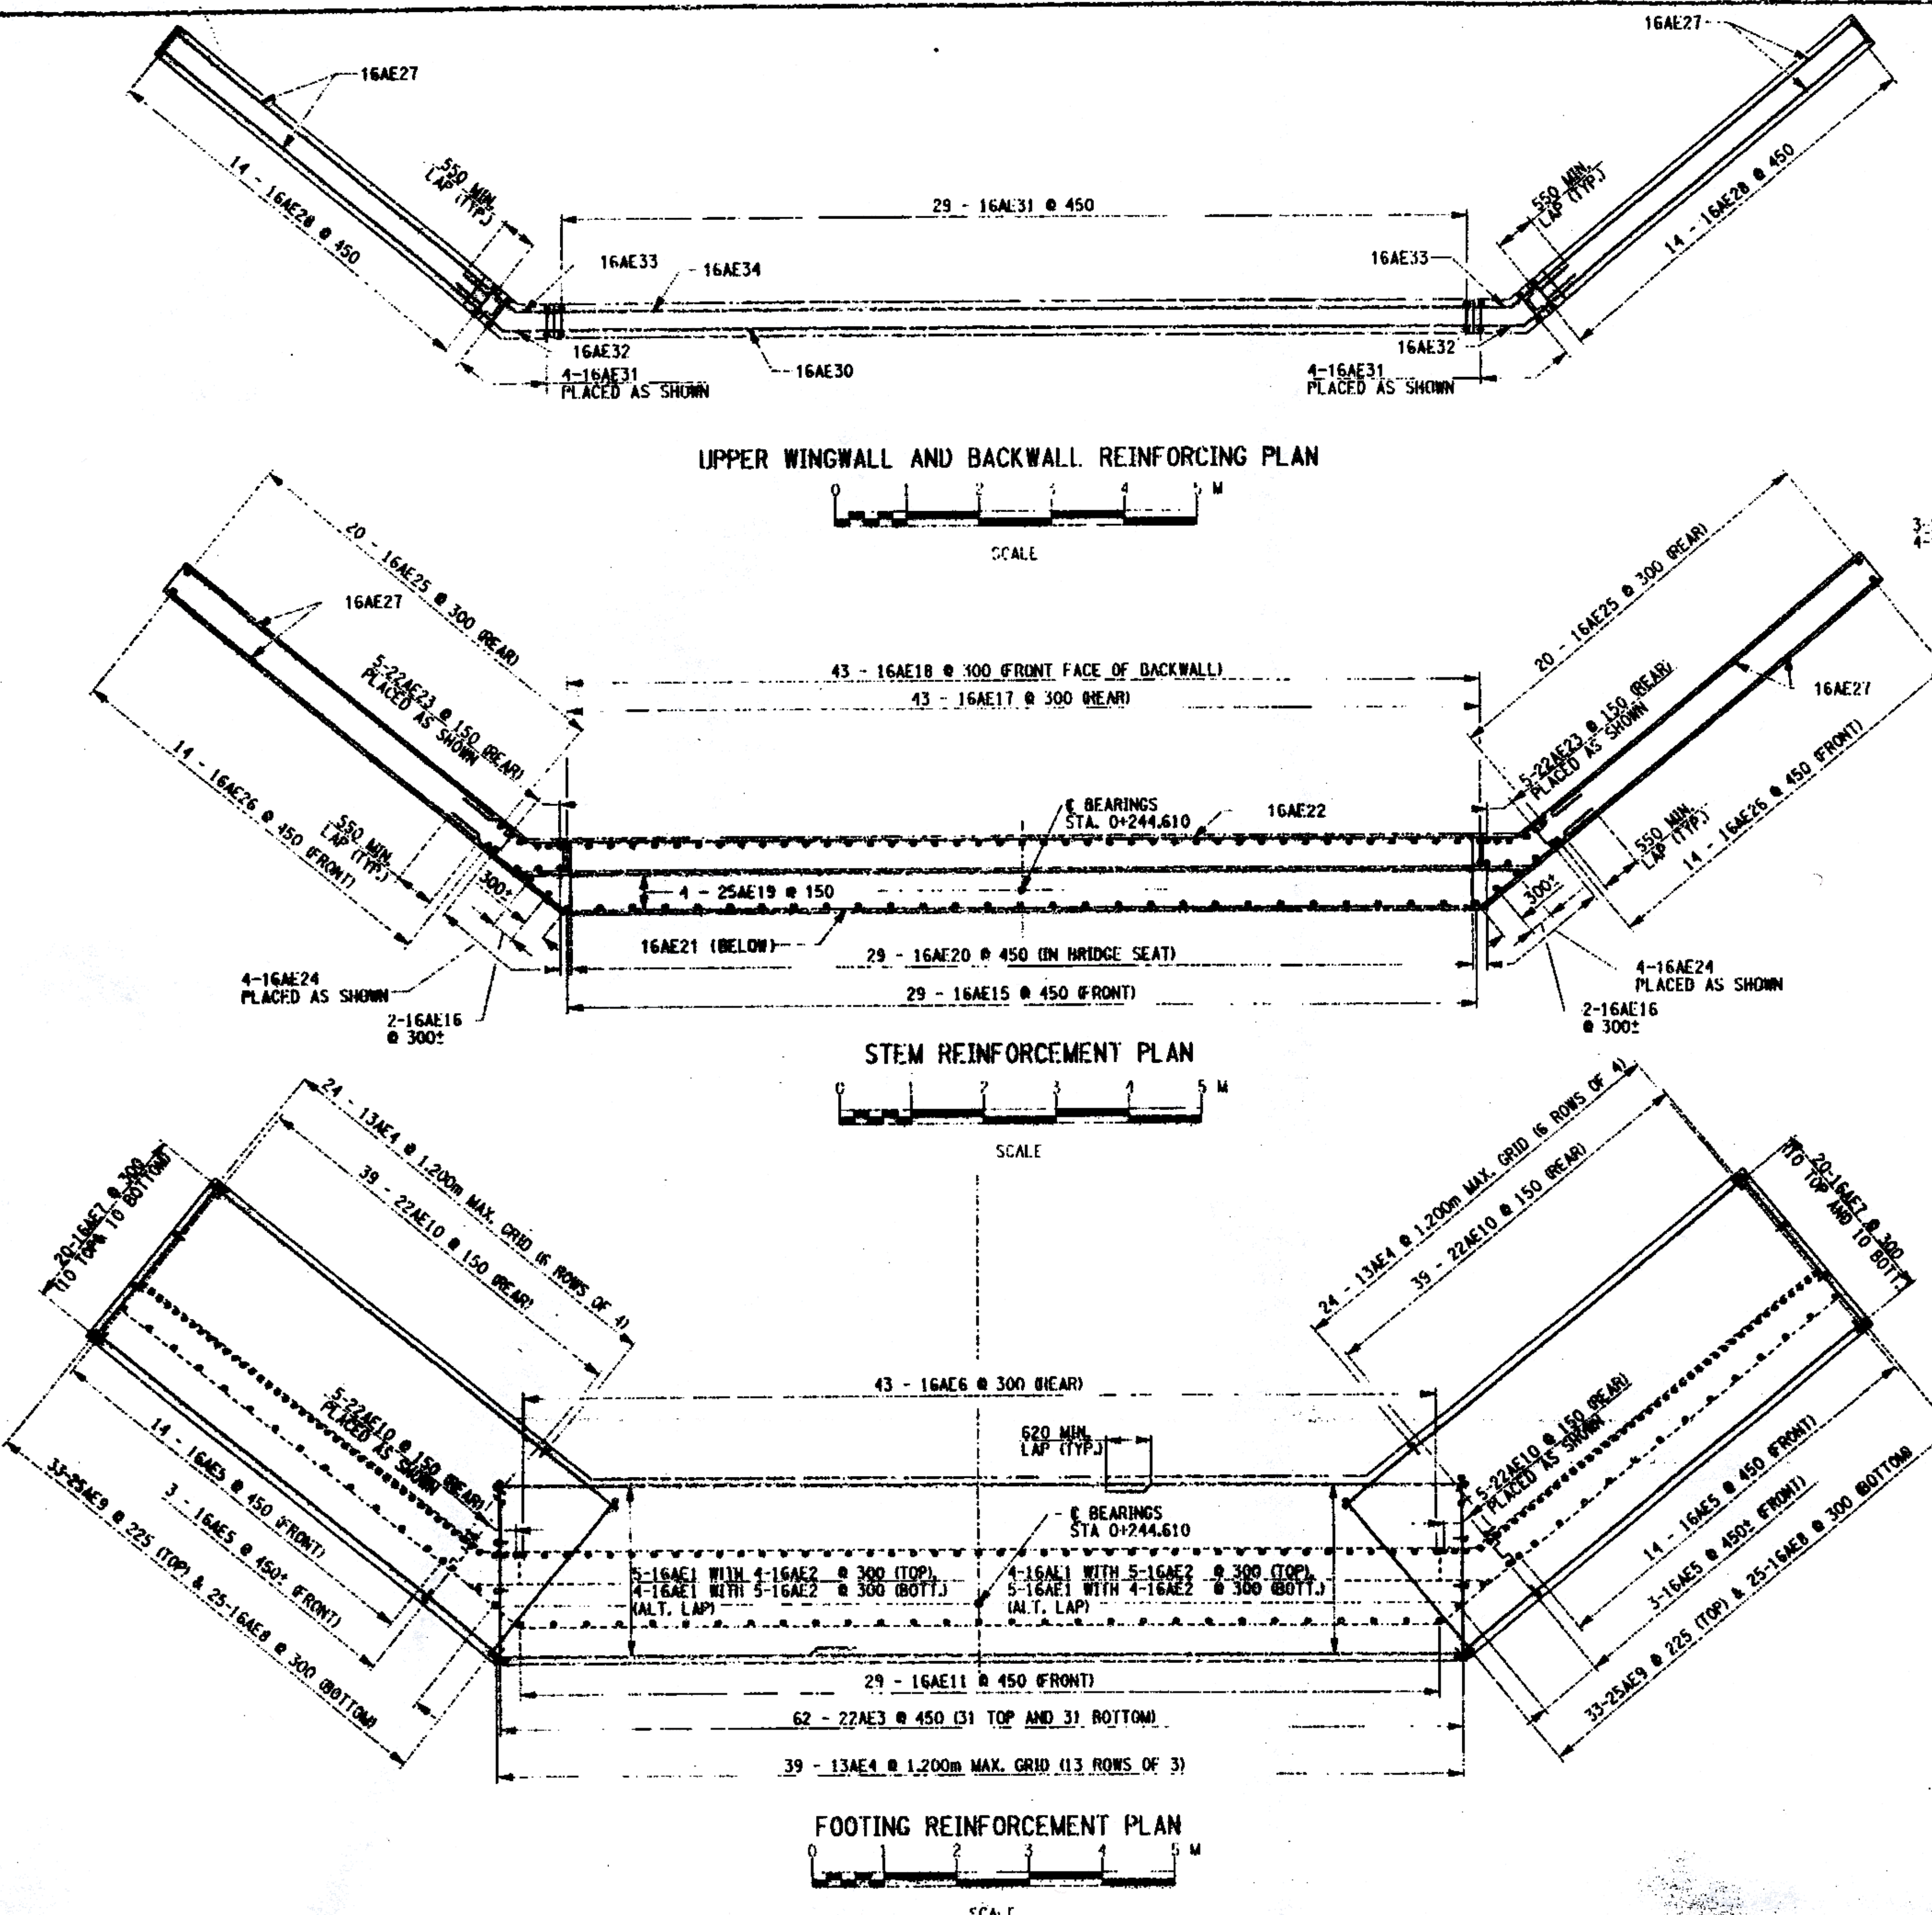

FLD ROAD	STATE	CONTRACT NO.	SHEET NO.	TOTAL SHEETS
1	N.Y.		25	43
COUNTY ROAD 18 OVER POULTNEY RIVER				
WASHINGTON COUNTY, NY / RUTLAND COUNTY, VT				
TOWN OF HAMPTON, NY / POULTNEY, VT				
CAPITAL PROJECT IDENTIFICATION NO. 1753.76				

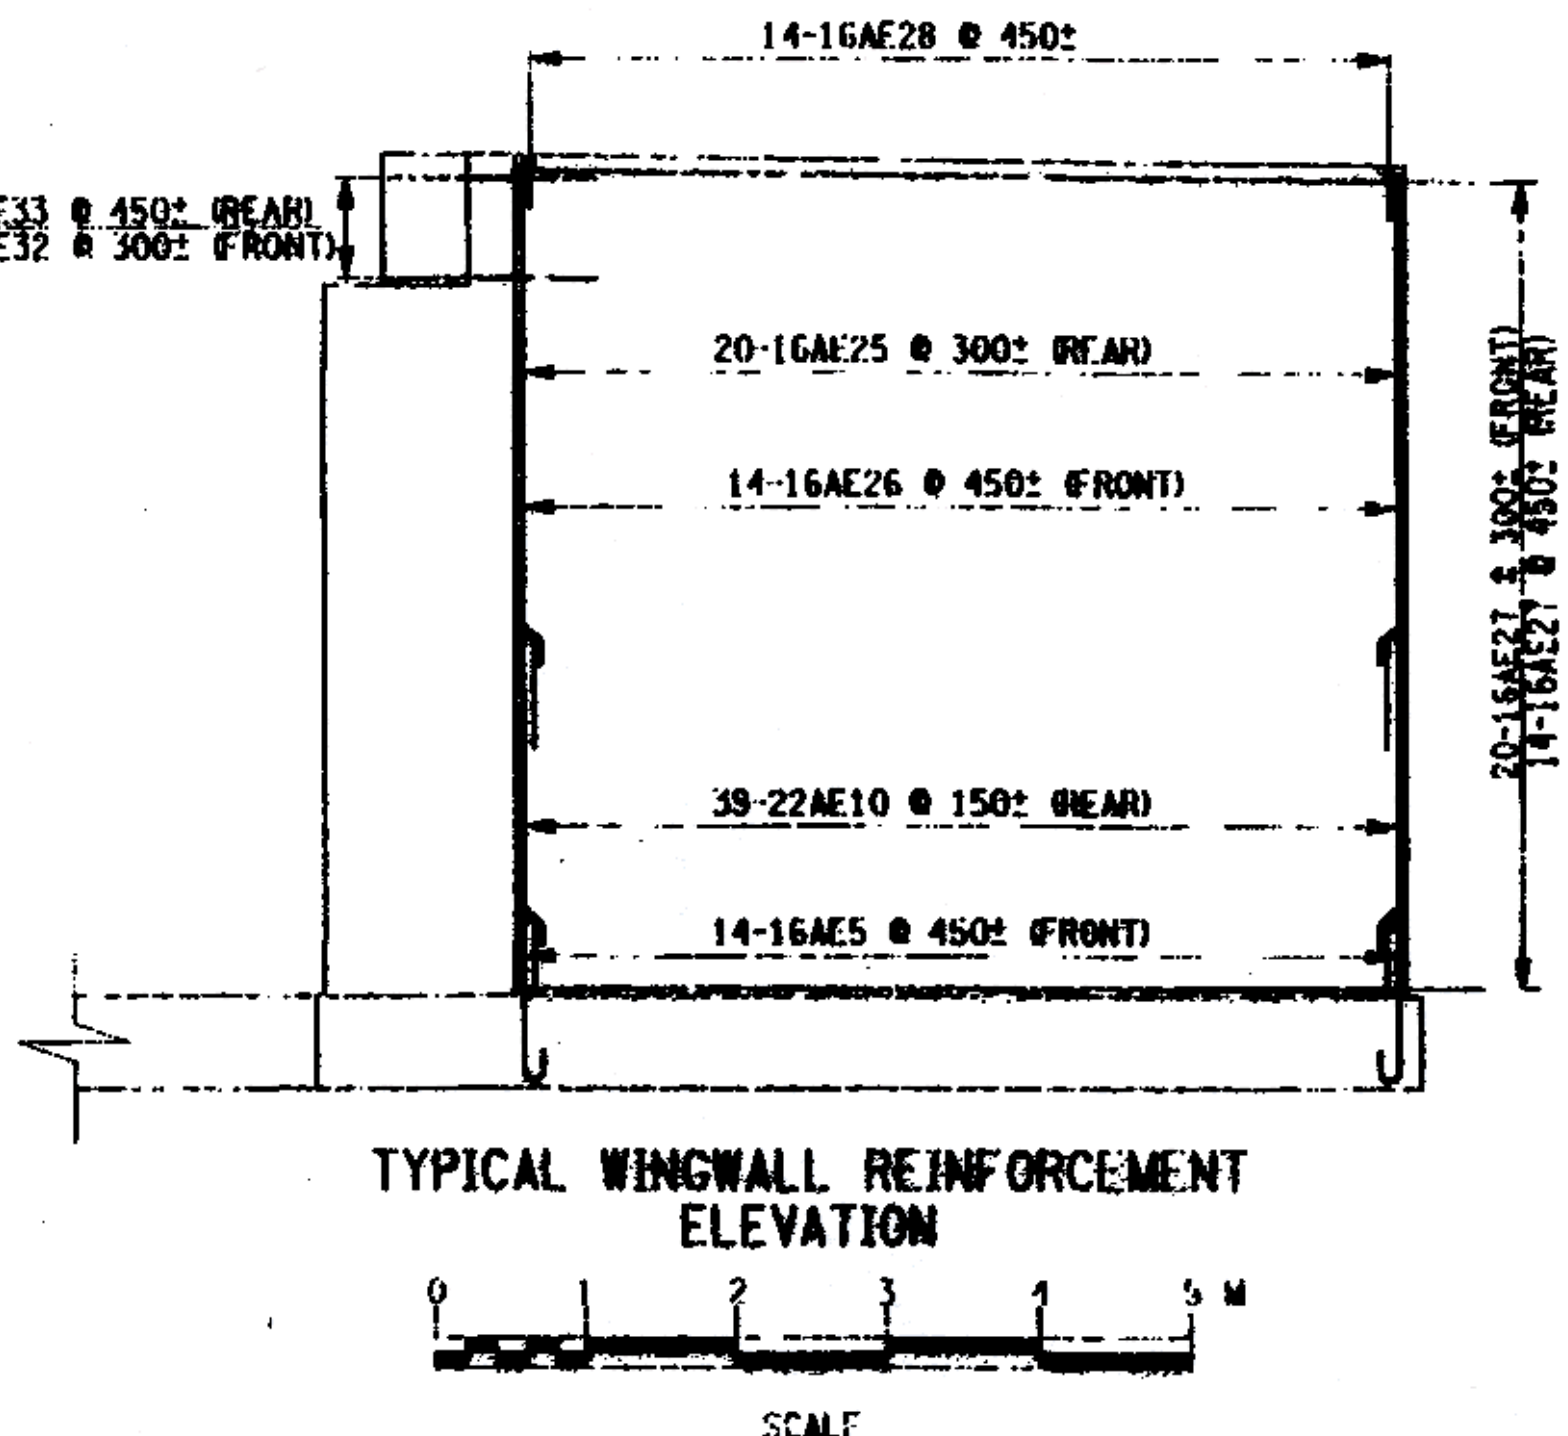



AS BUILT: NO REVISIONS 9/2003

NOTES:
FOR WEST ABUTMENT PLAN AND ELEVATION, SEE DWG. NO. ST-8
FOR ADDITIONAL WEST ABUTMENT REINFORCEMENT DETAILS, SEE DWG. NO. ST-10
ALL COVER SHALL BE 75mm IN THE FOOTING AND 50mm ELSEWHERE, UNLESS OTHERWISE NOTED.

ALL DIMENSIONS ARE IN mm UNLESS OTHERWISE NOTED			
AS BUILT REVISIONS			
SIGNATURE		DATE	
[Signature]		9/2003	
COUNTY ROAD 18 OVER POULTNEY RIVER			
WEST ABUTMENT PLAN AND WINGWALL ELEVATION REINFORCEMENT			
WASHINGTON COUNTY			
DEPARTMENT OF PUBLIC WORKS			
FILENAME	REGION	DATE	DRAWING NO.
175376A1C	ONE	3/2002	ST-9

F.I.D. ROAD R.G. NO.	STATE	CONTRACT NO.	SHEET NO.	TOTAL SHEETS
1	N.Y.		26	43

COUNTY ROAD 18 OVER POULTNEY RIVER	
WASHINGTON COUNTY, NY / RUTLAND COUNTY, VT	
TOWN OF HAMPTON, NY / POULTNEY, VT	
CAPITAL PROJECT IDENTIFICATION NO. 1753.76	

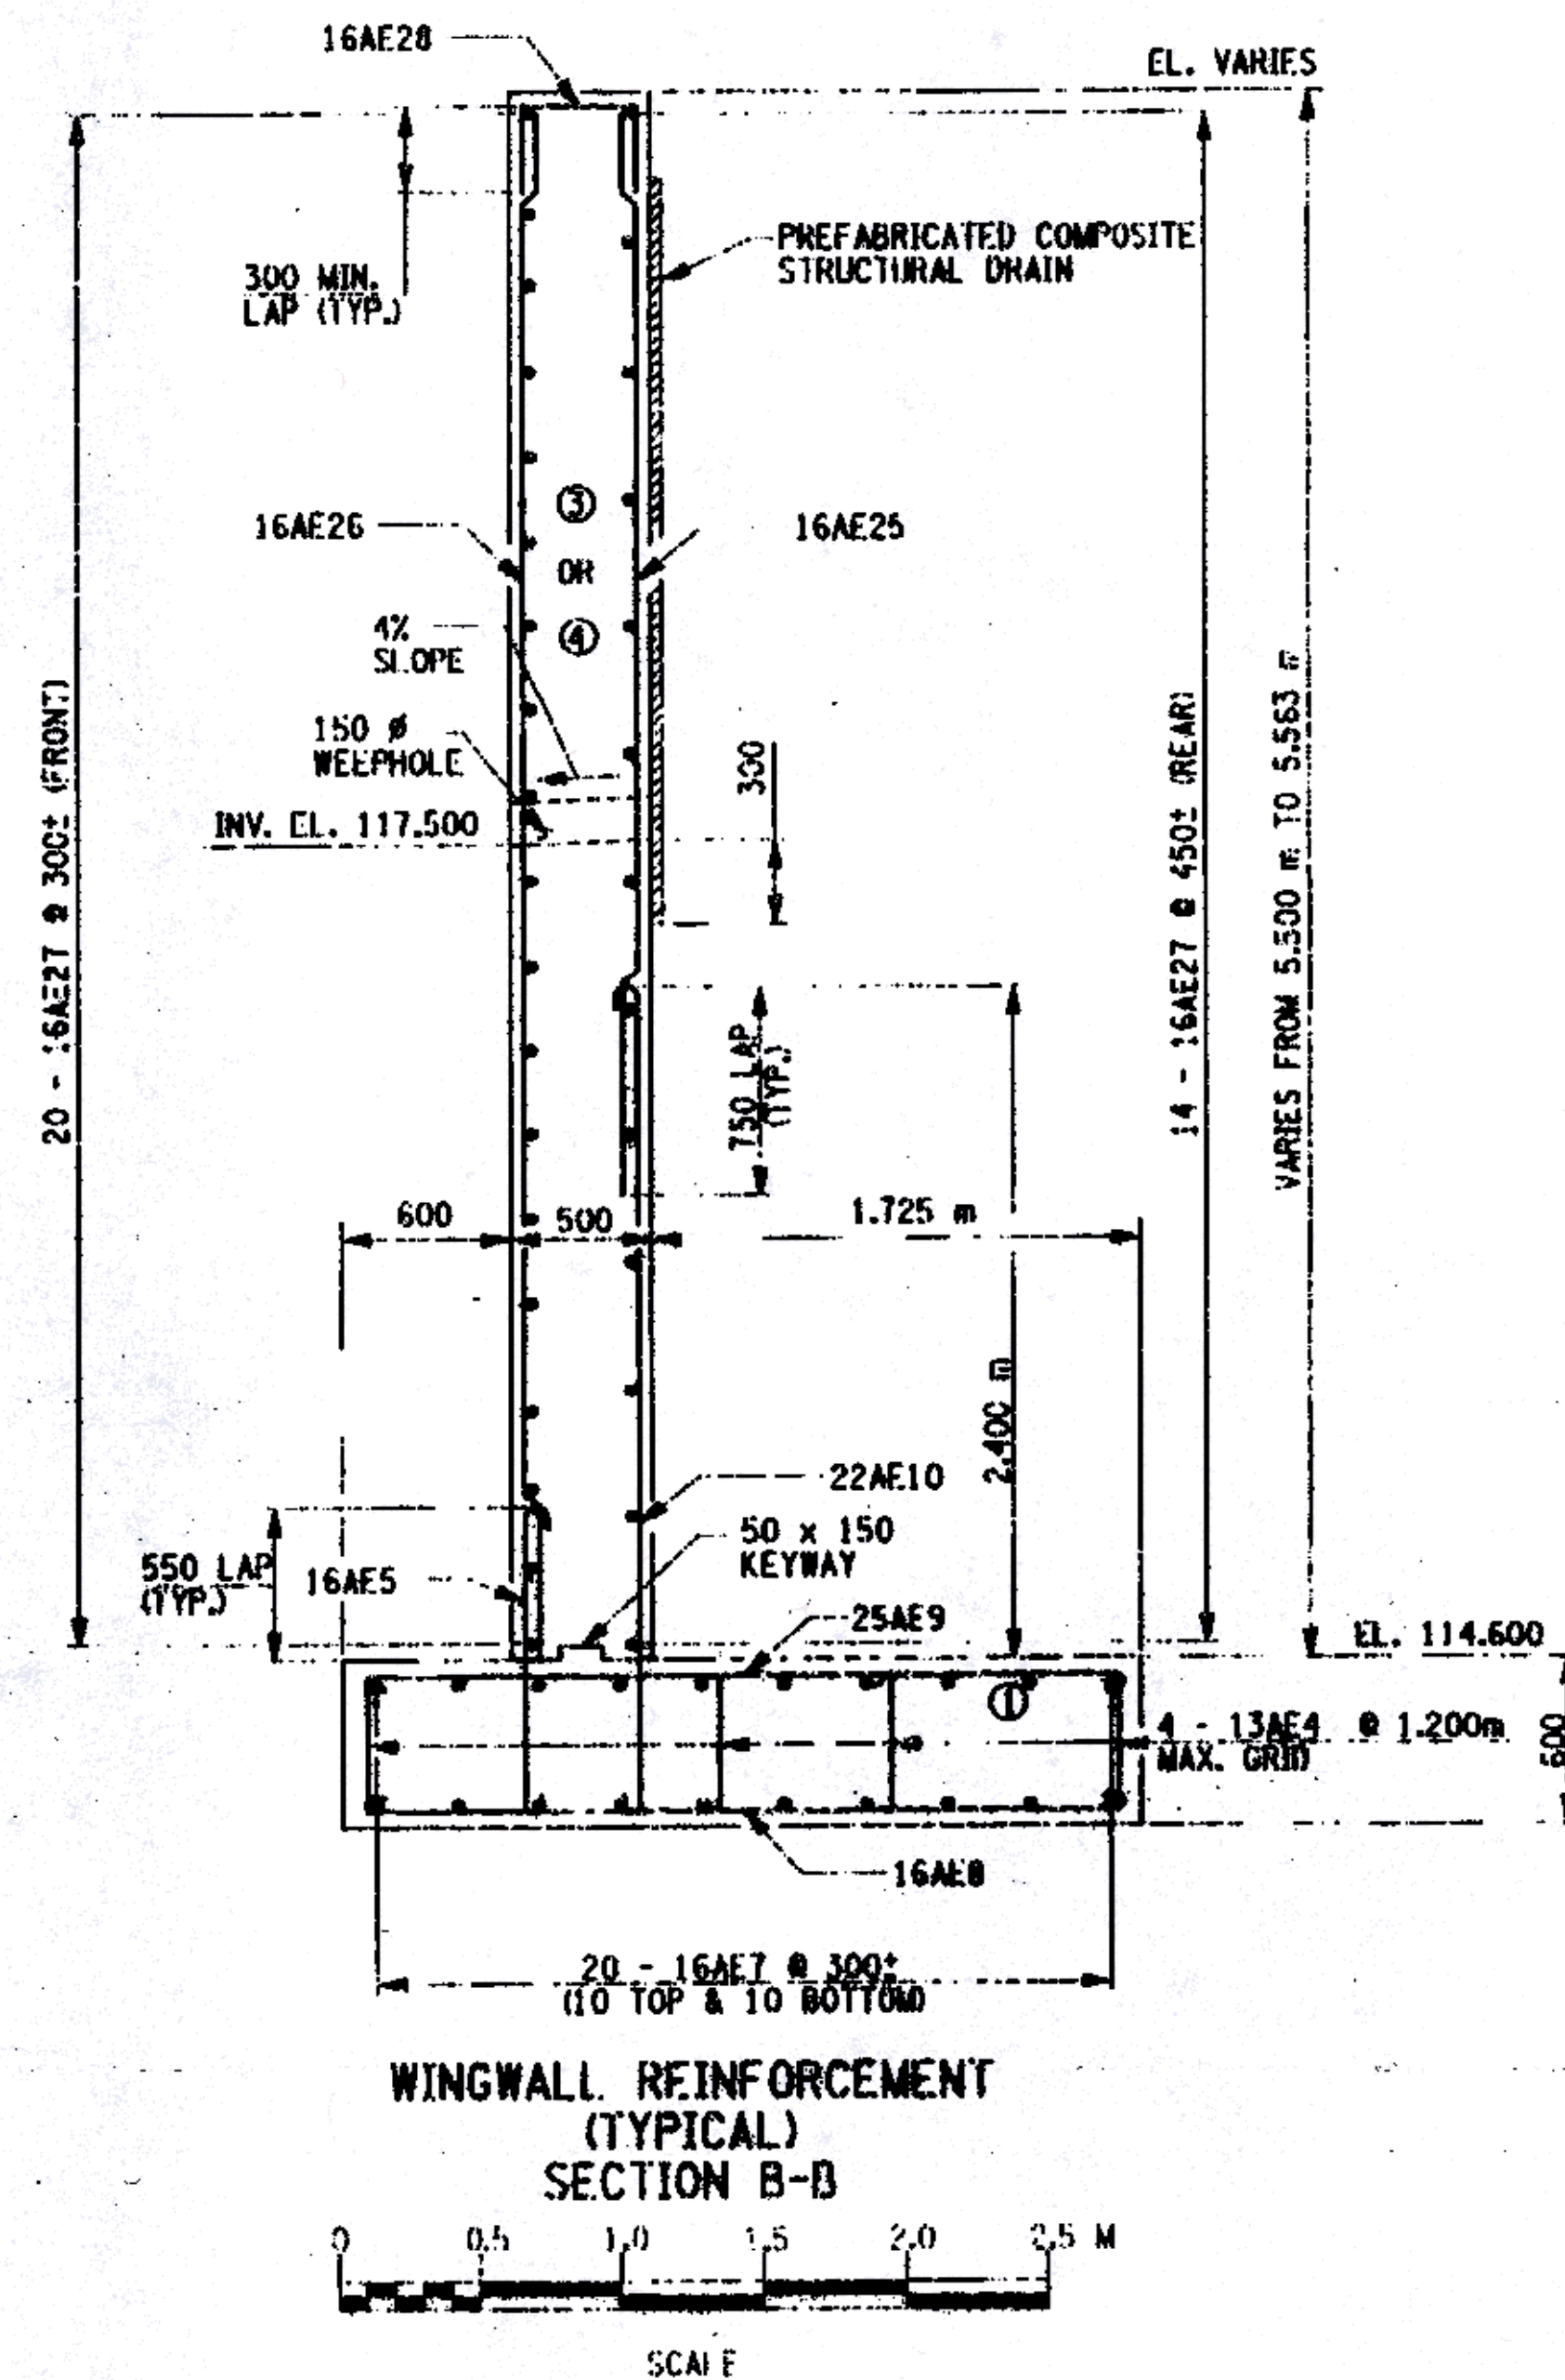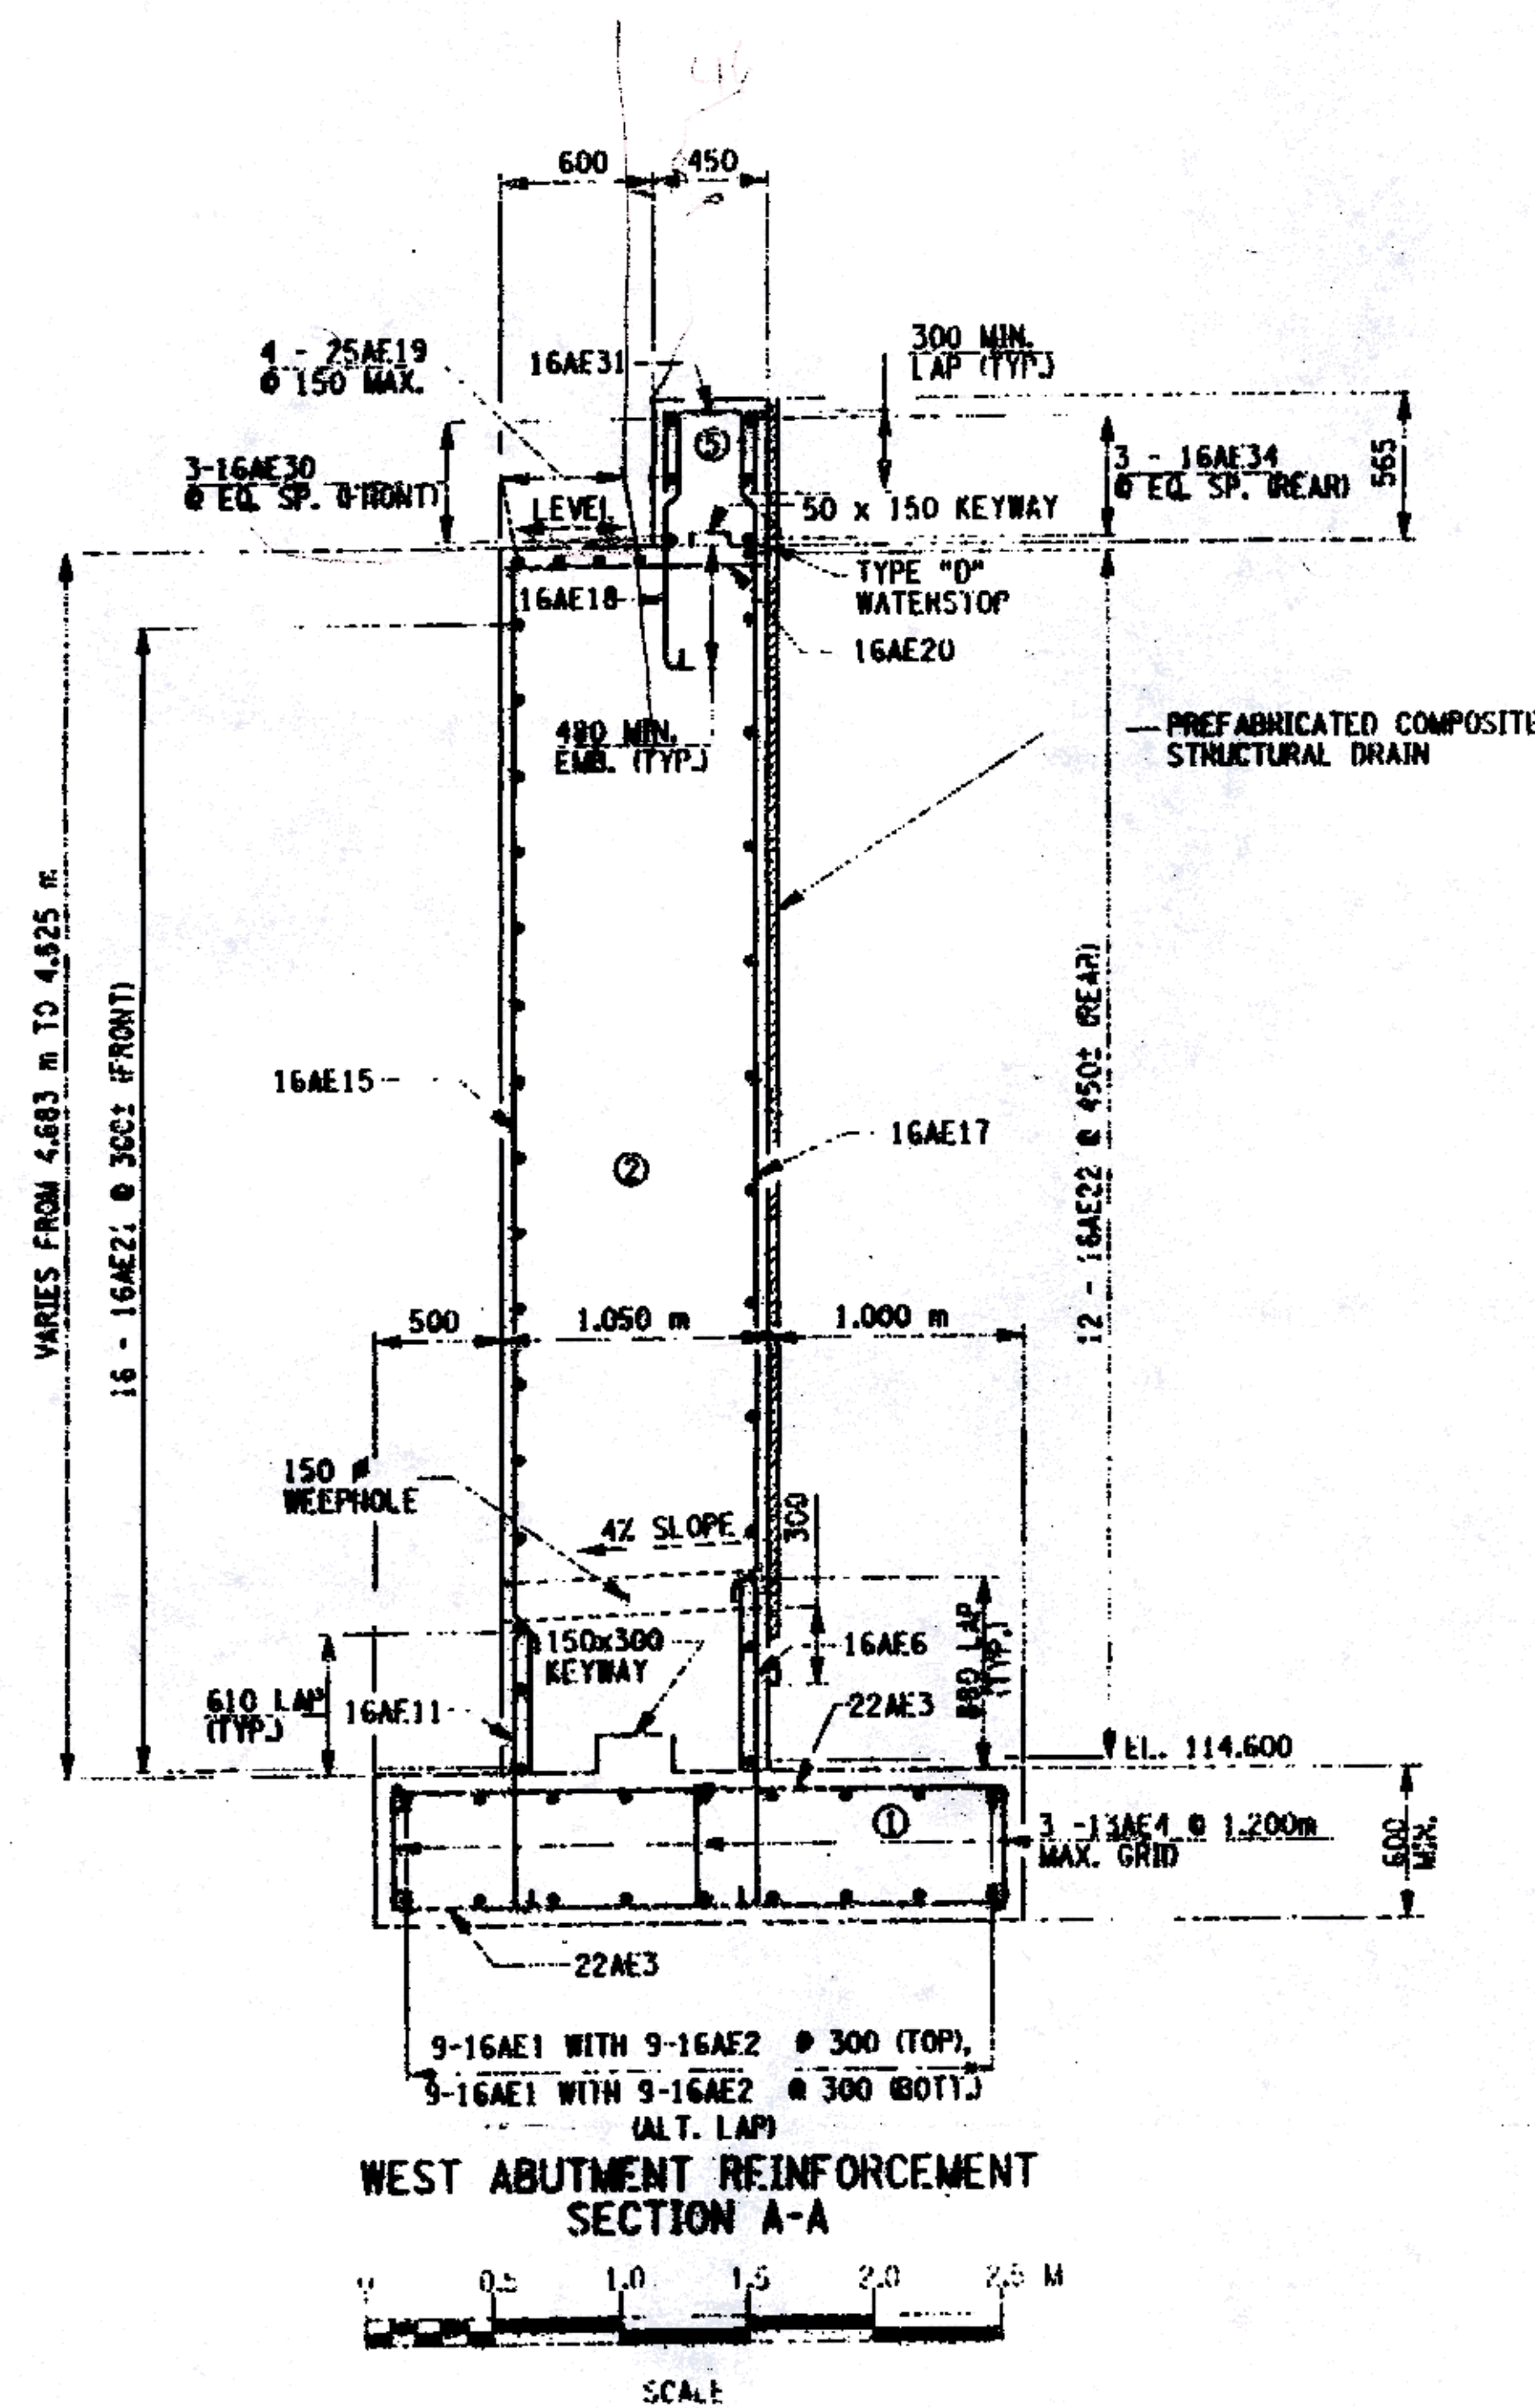

FILE NAME = J:\work\12087\CADD\Bulwark\175376.dwg
DATE/TIME = 11/04/2003 10:06:22 AM
USER = RJK

DESIGNED BY EKT

CHECKED BY LAK

ESTIMATED BY EKT


DESIGNED BY EKT

CHECKED BY LAK



DESIGN SUPERVISOR LJC

JOB MANAGER LJC


FED. ROAD REF. NO.	STATE	CONTRACT NO.	SHEET NO.	TOTAL SHEETS
1	N.Y.		28	43
COUNTY ROAD 18 OVER POULTNEY RIVER				
WASHINGTON COUNTY, NY / RUTLAND COUNTY, VT				
TOWN OF HAMPTON, NY / POULTNEY, VT				
CAPITAL PROJECT IDENTIFICATION NO. 1753.76				

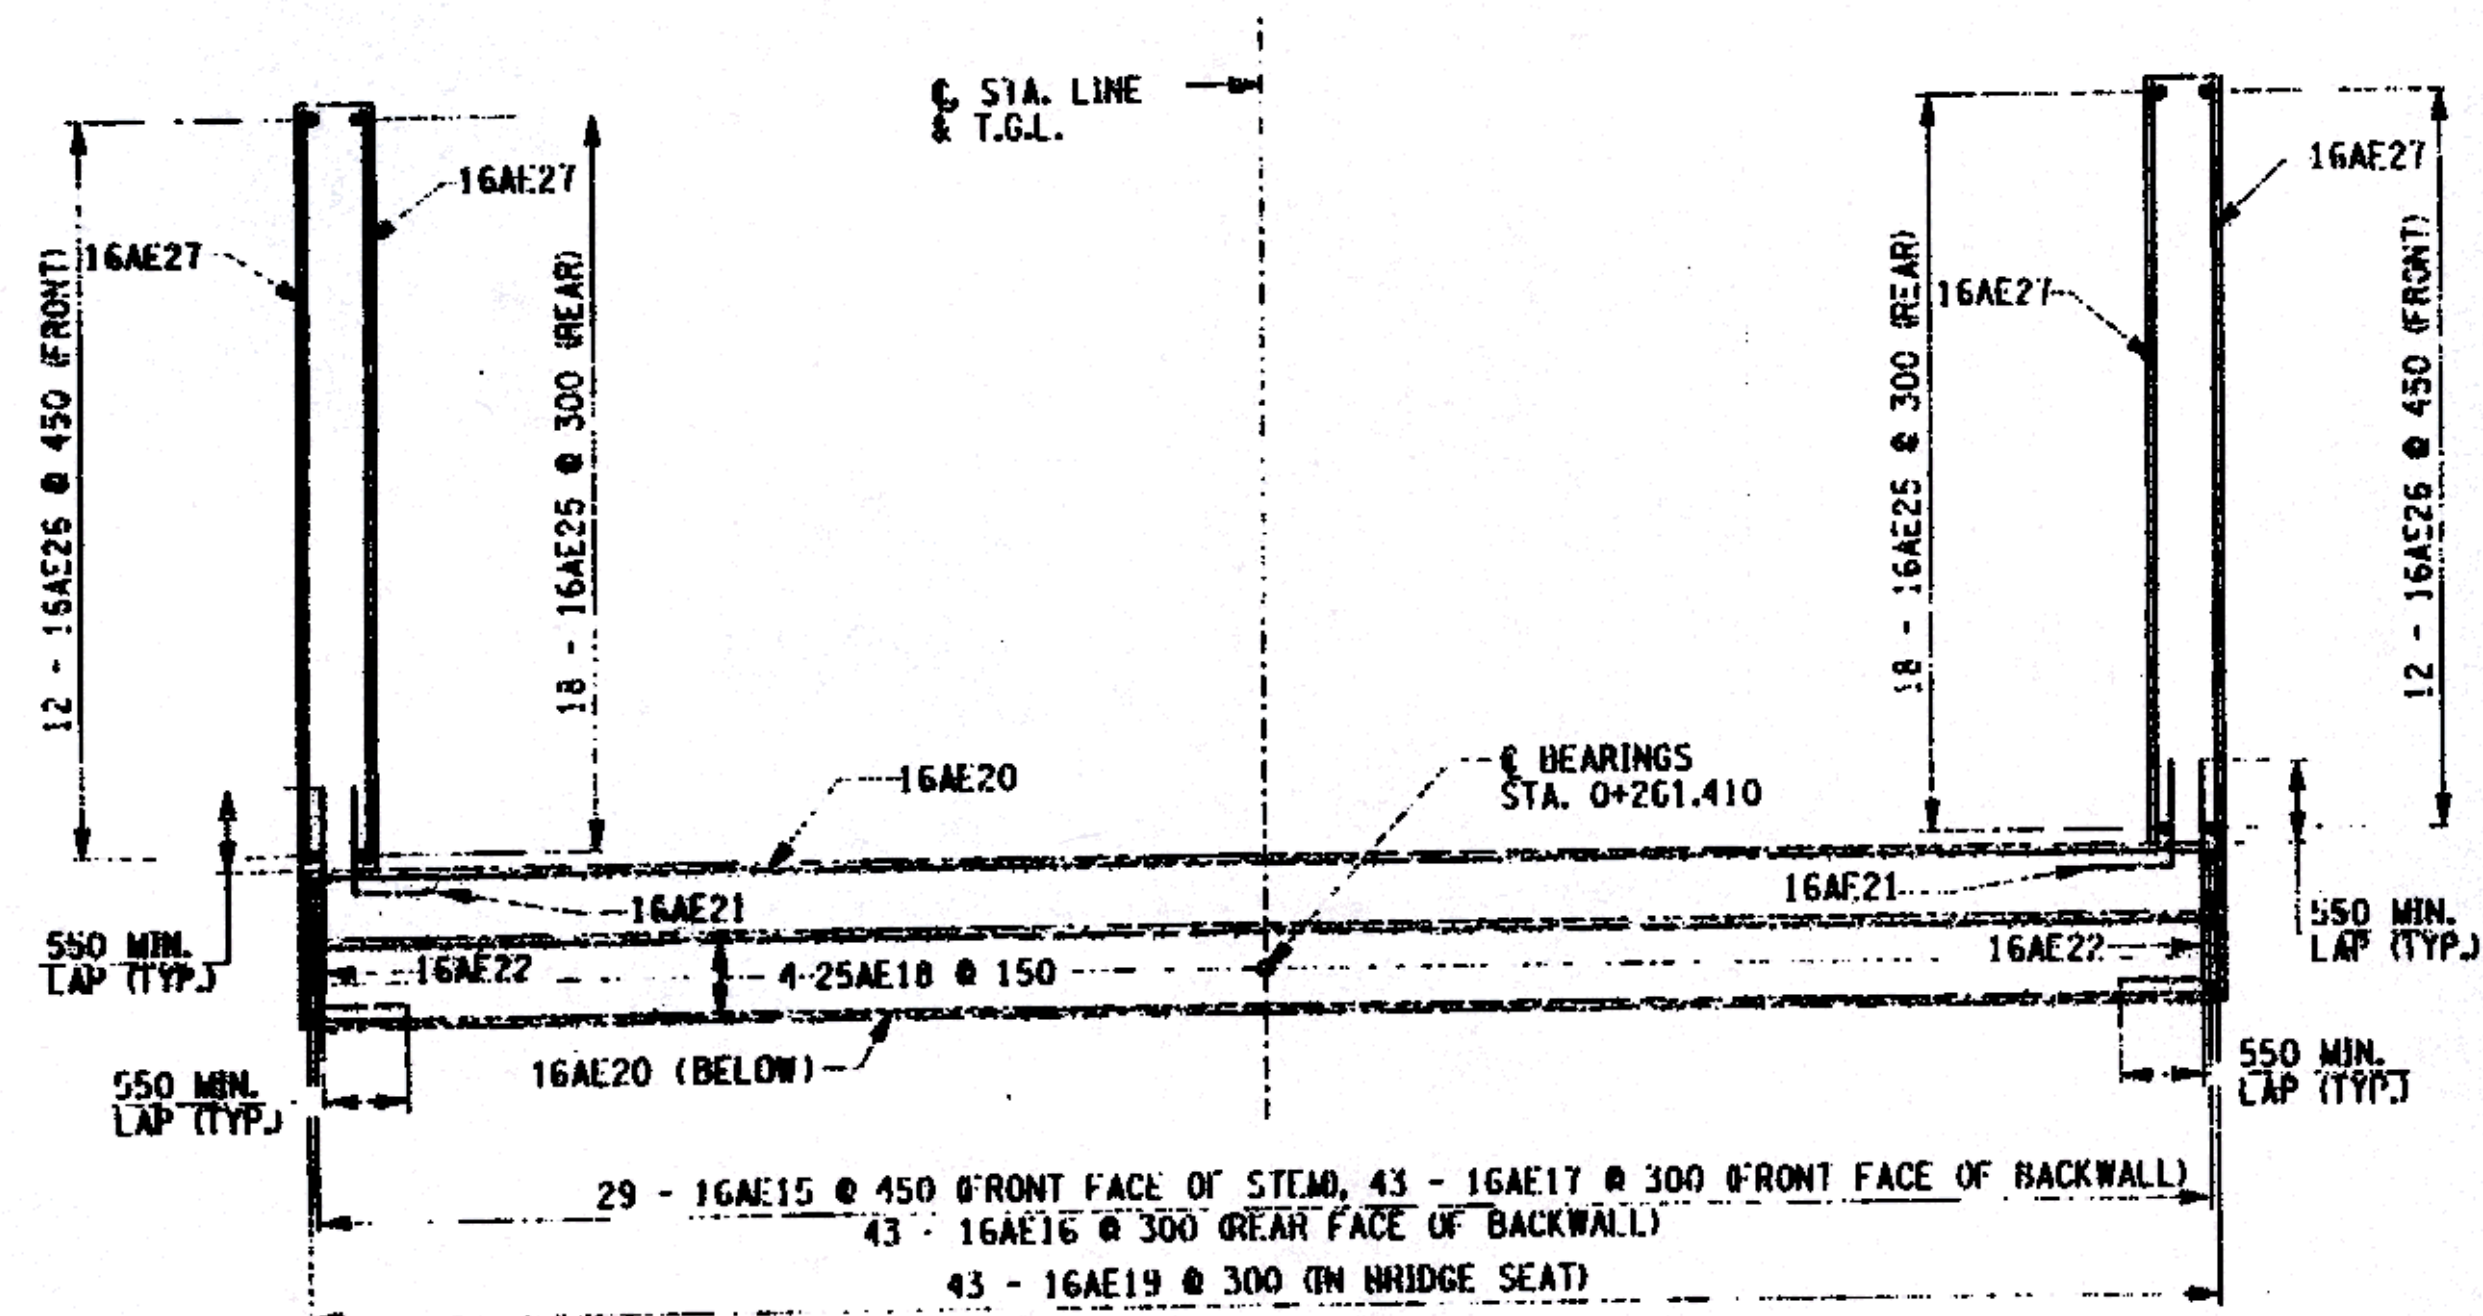



STEM AND LOWER WINGWALL
REINFORCEMENT PLAN

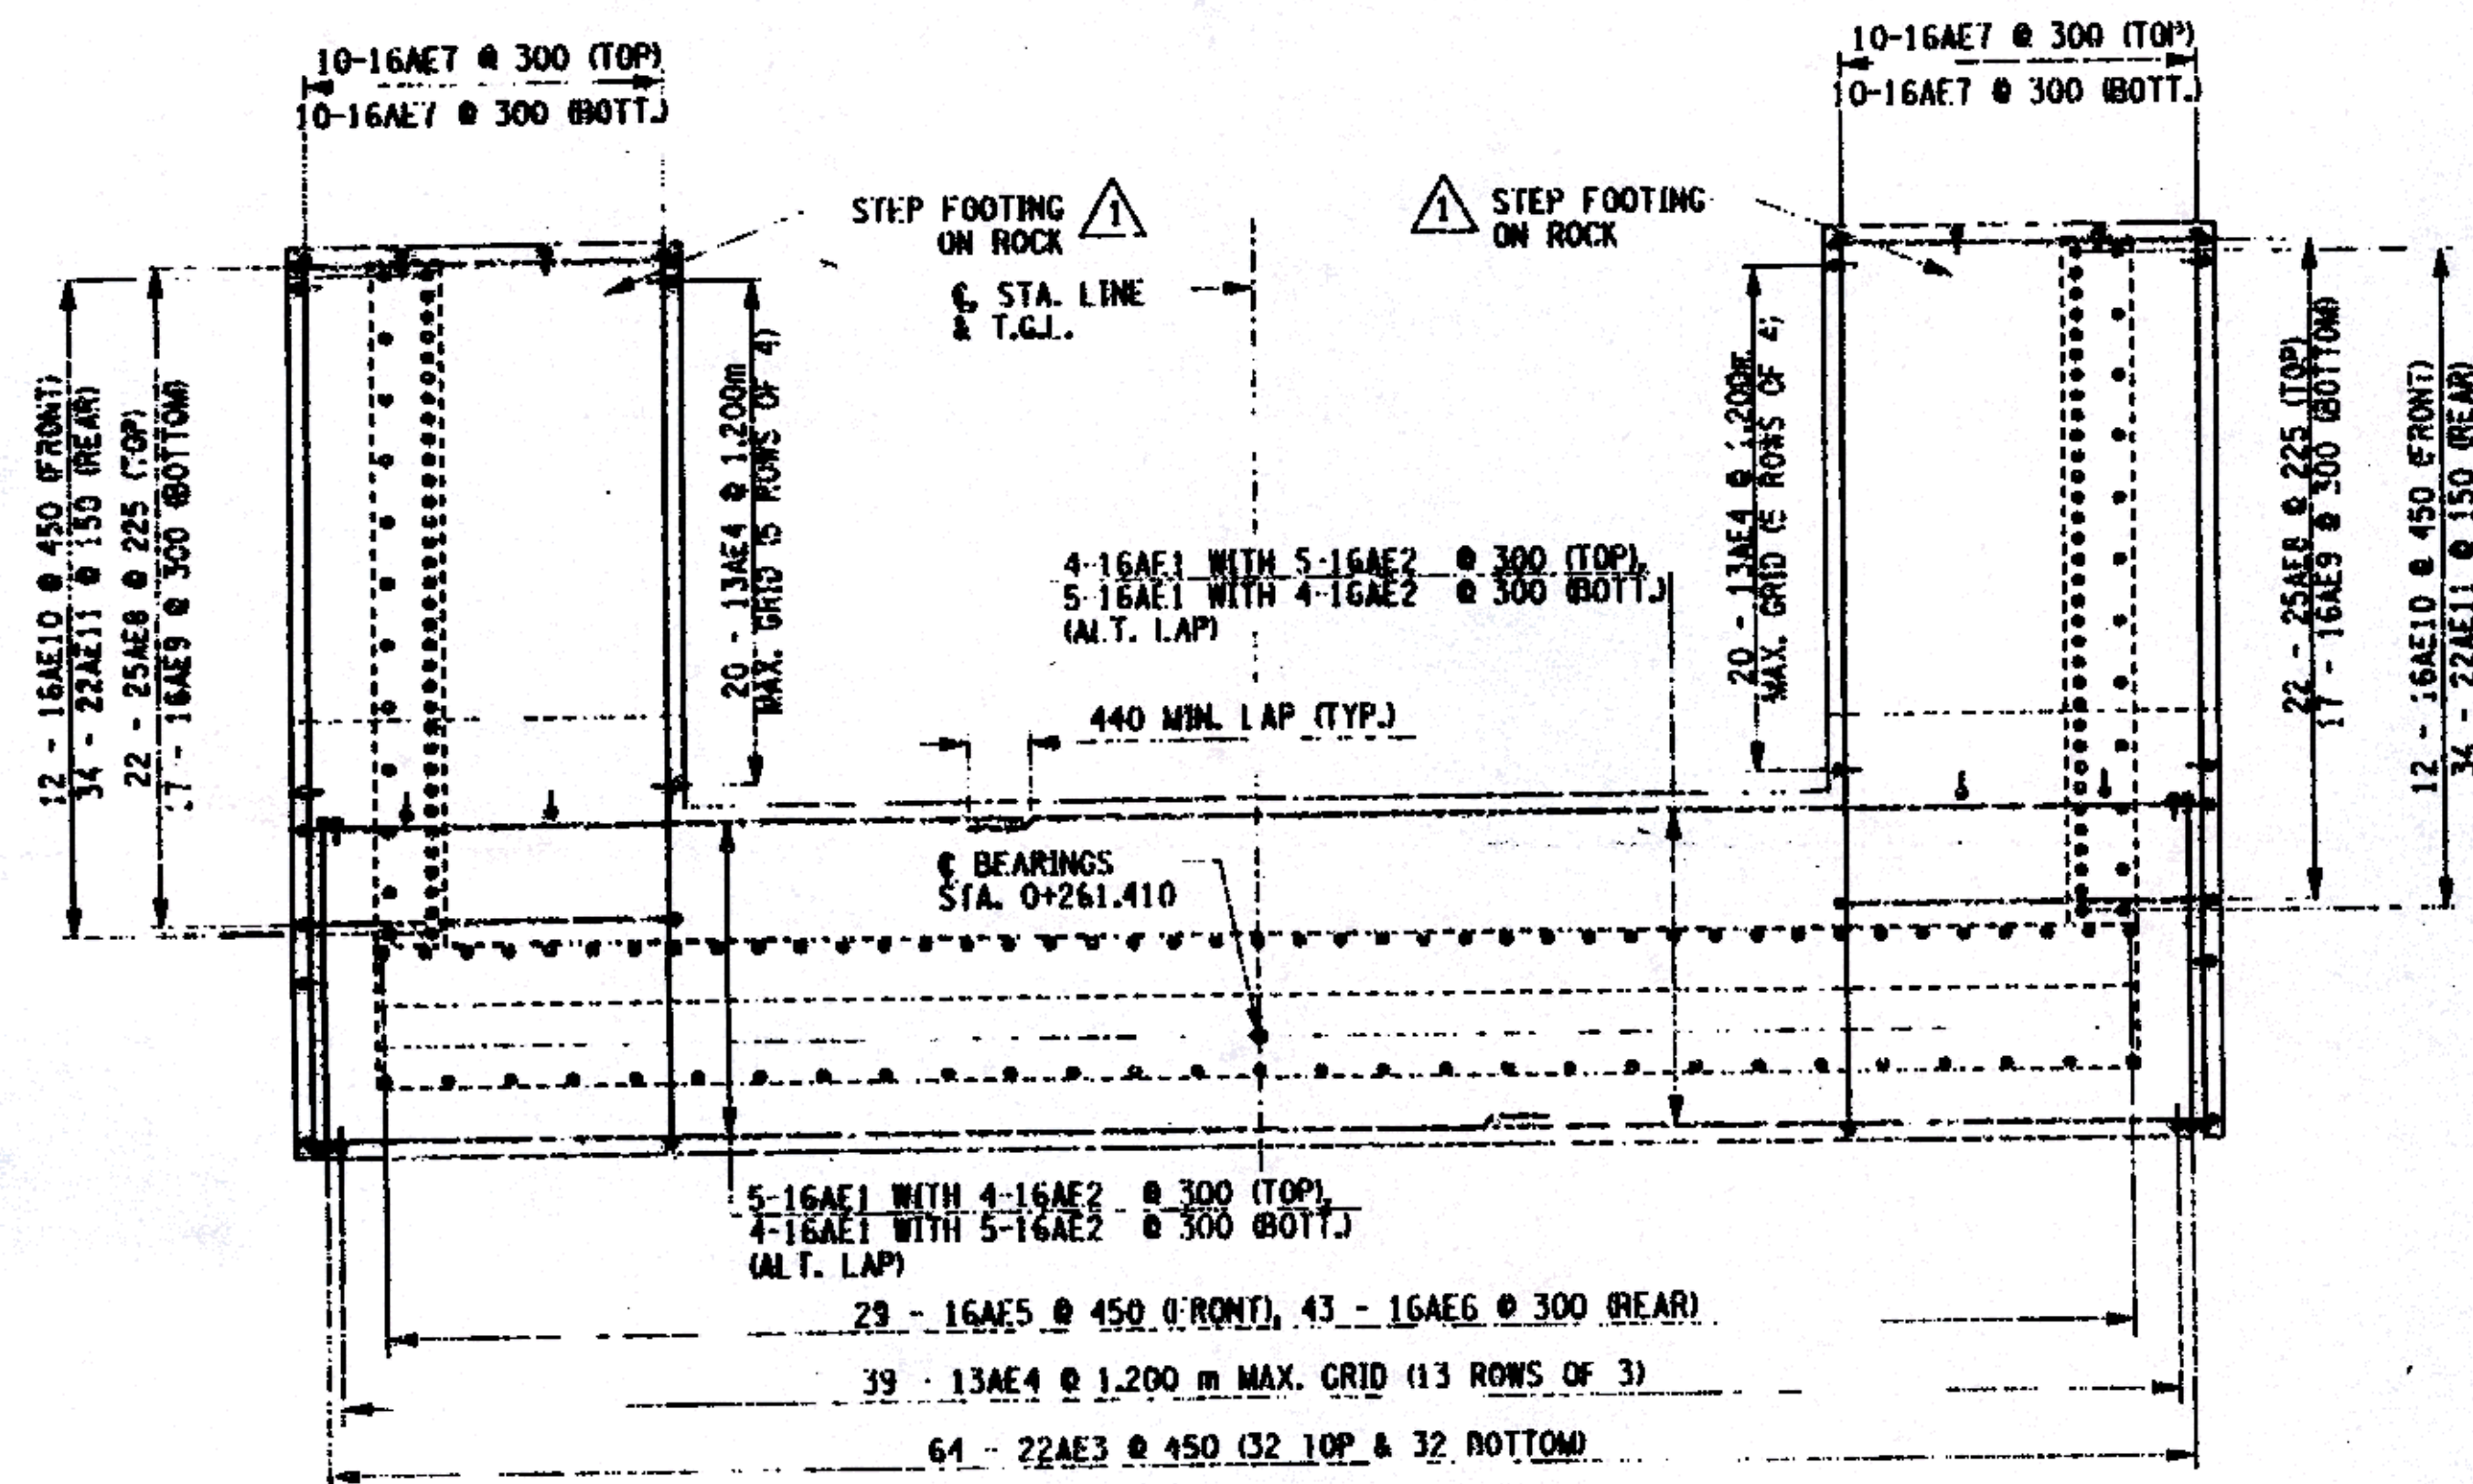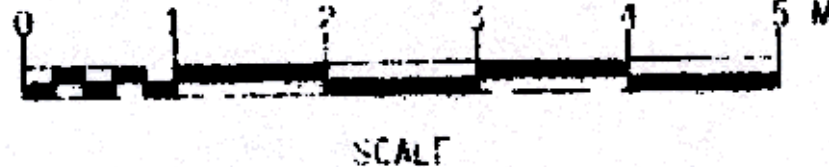

FOOTING REINFORCEMENT PLAN

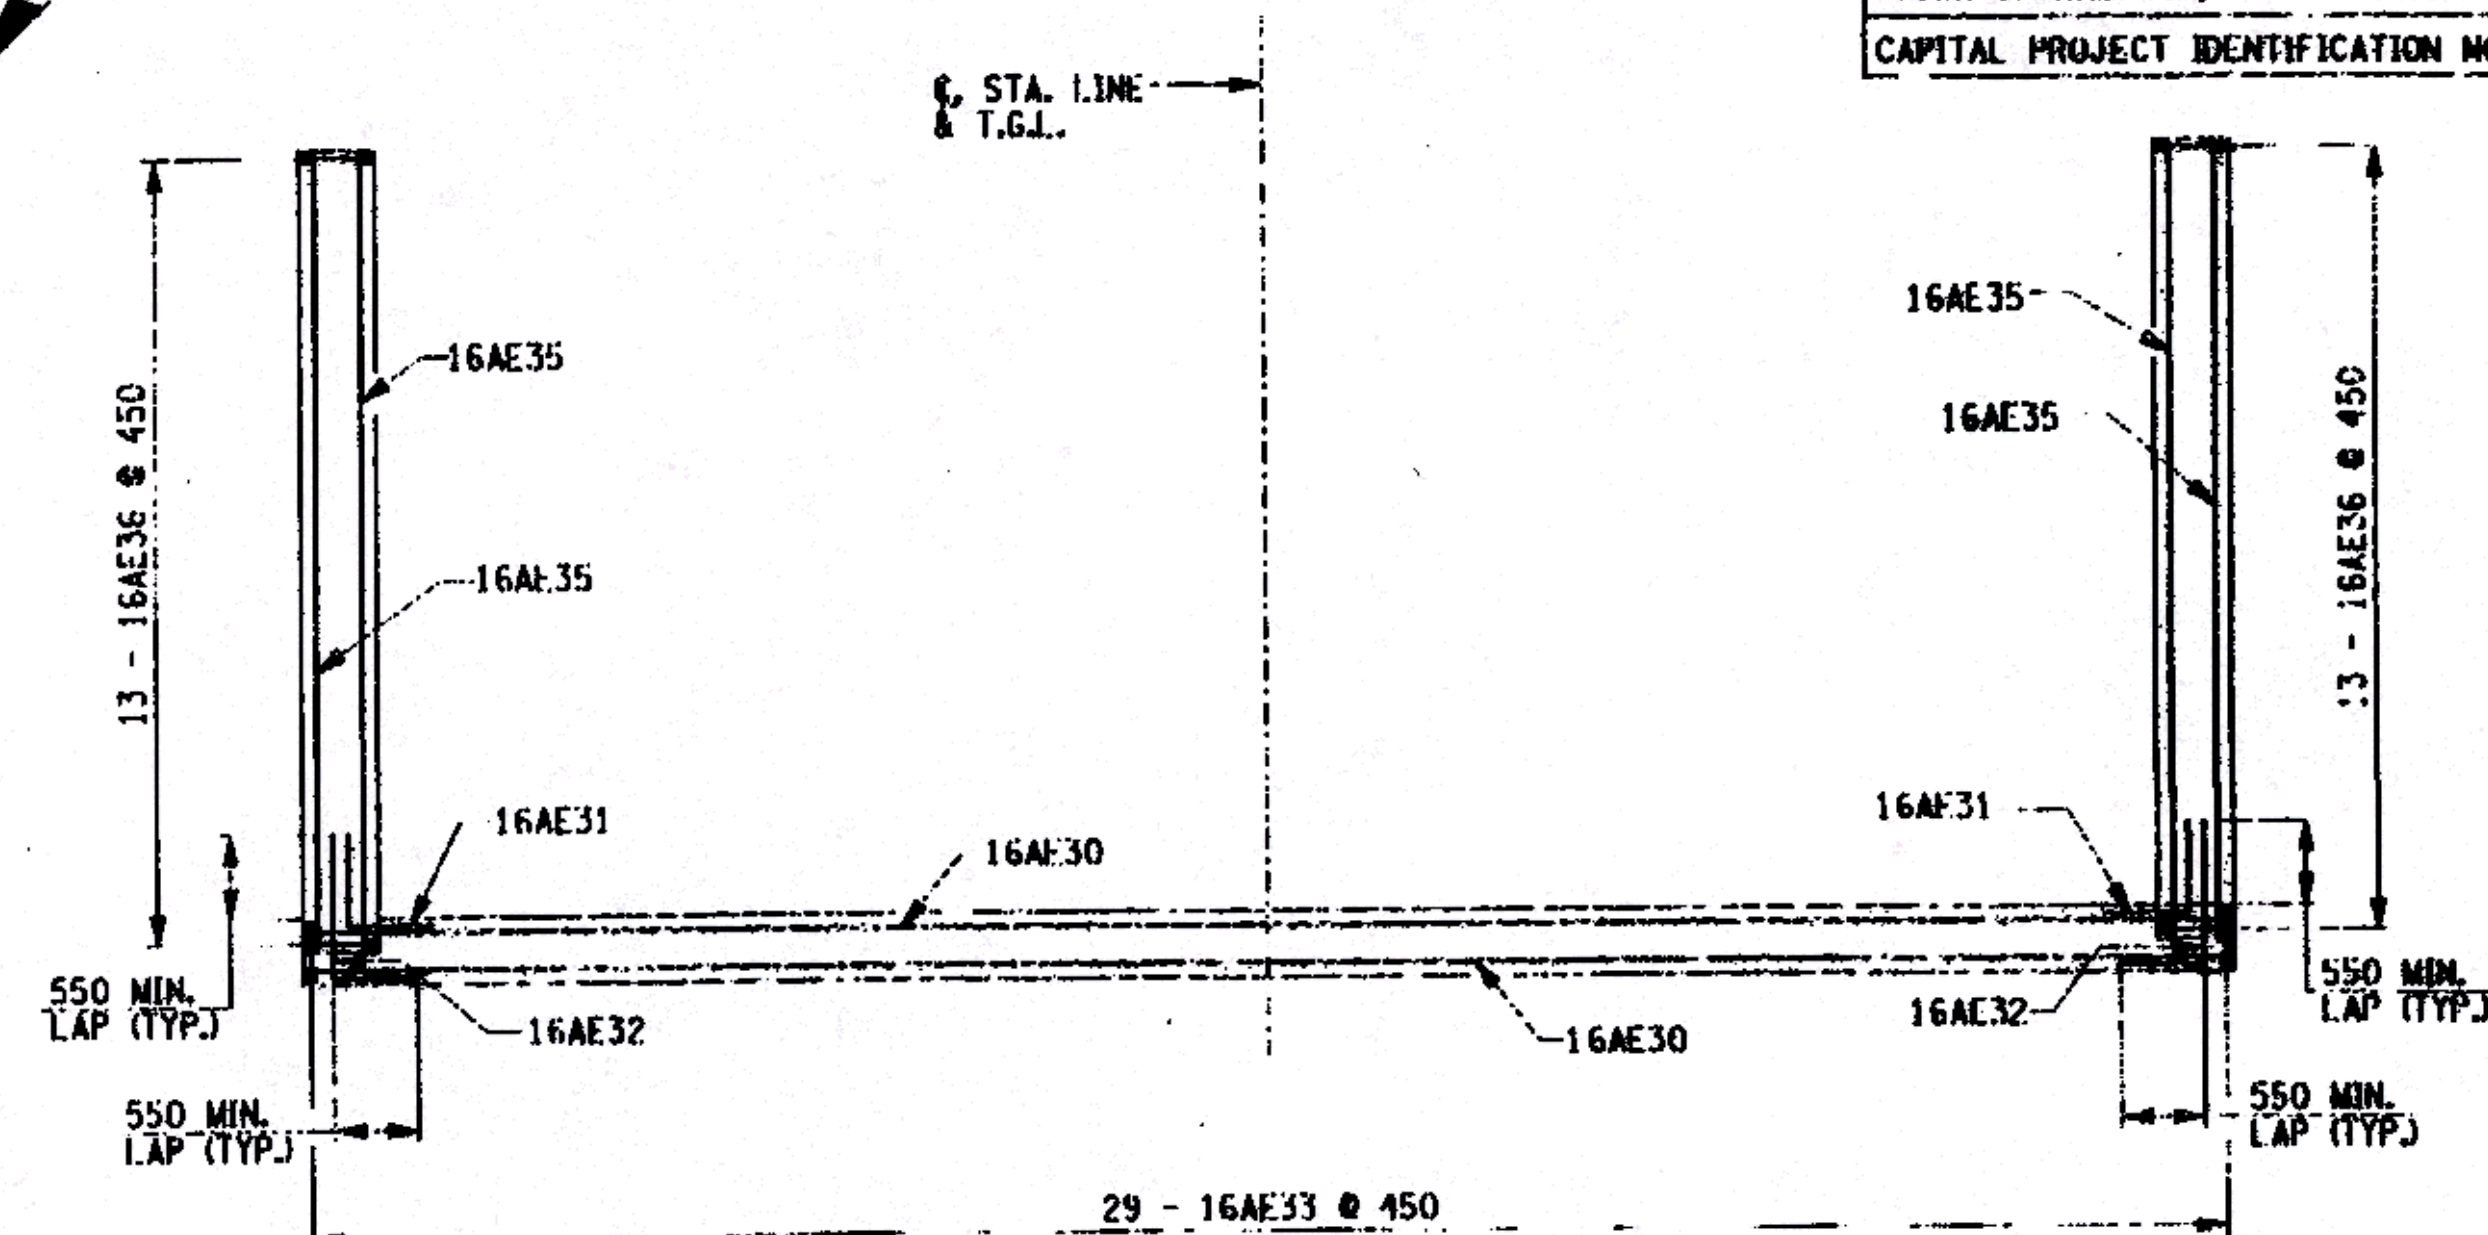

BACKWALL AND UPPER WINGWALL REINFORCING

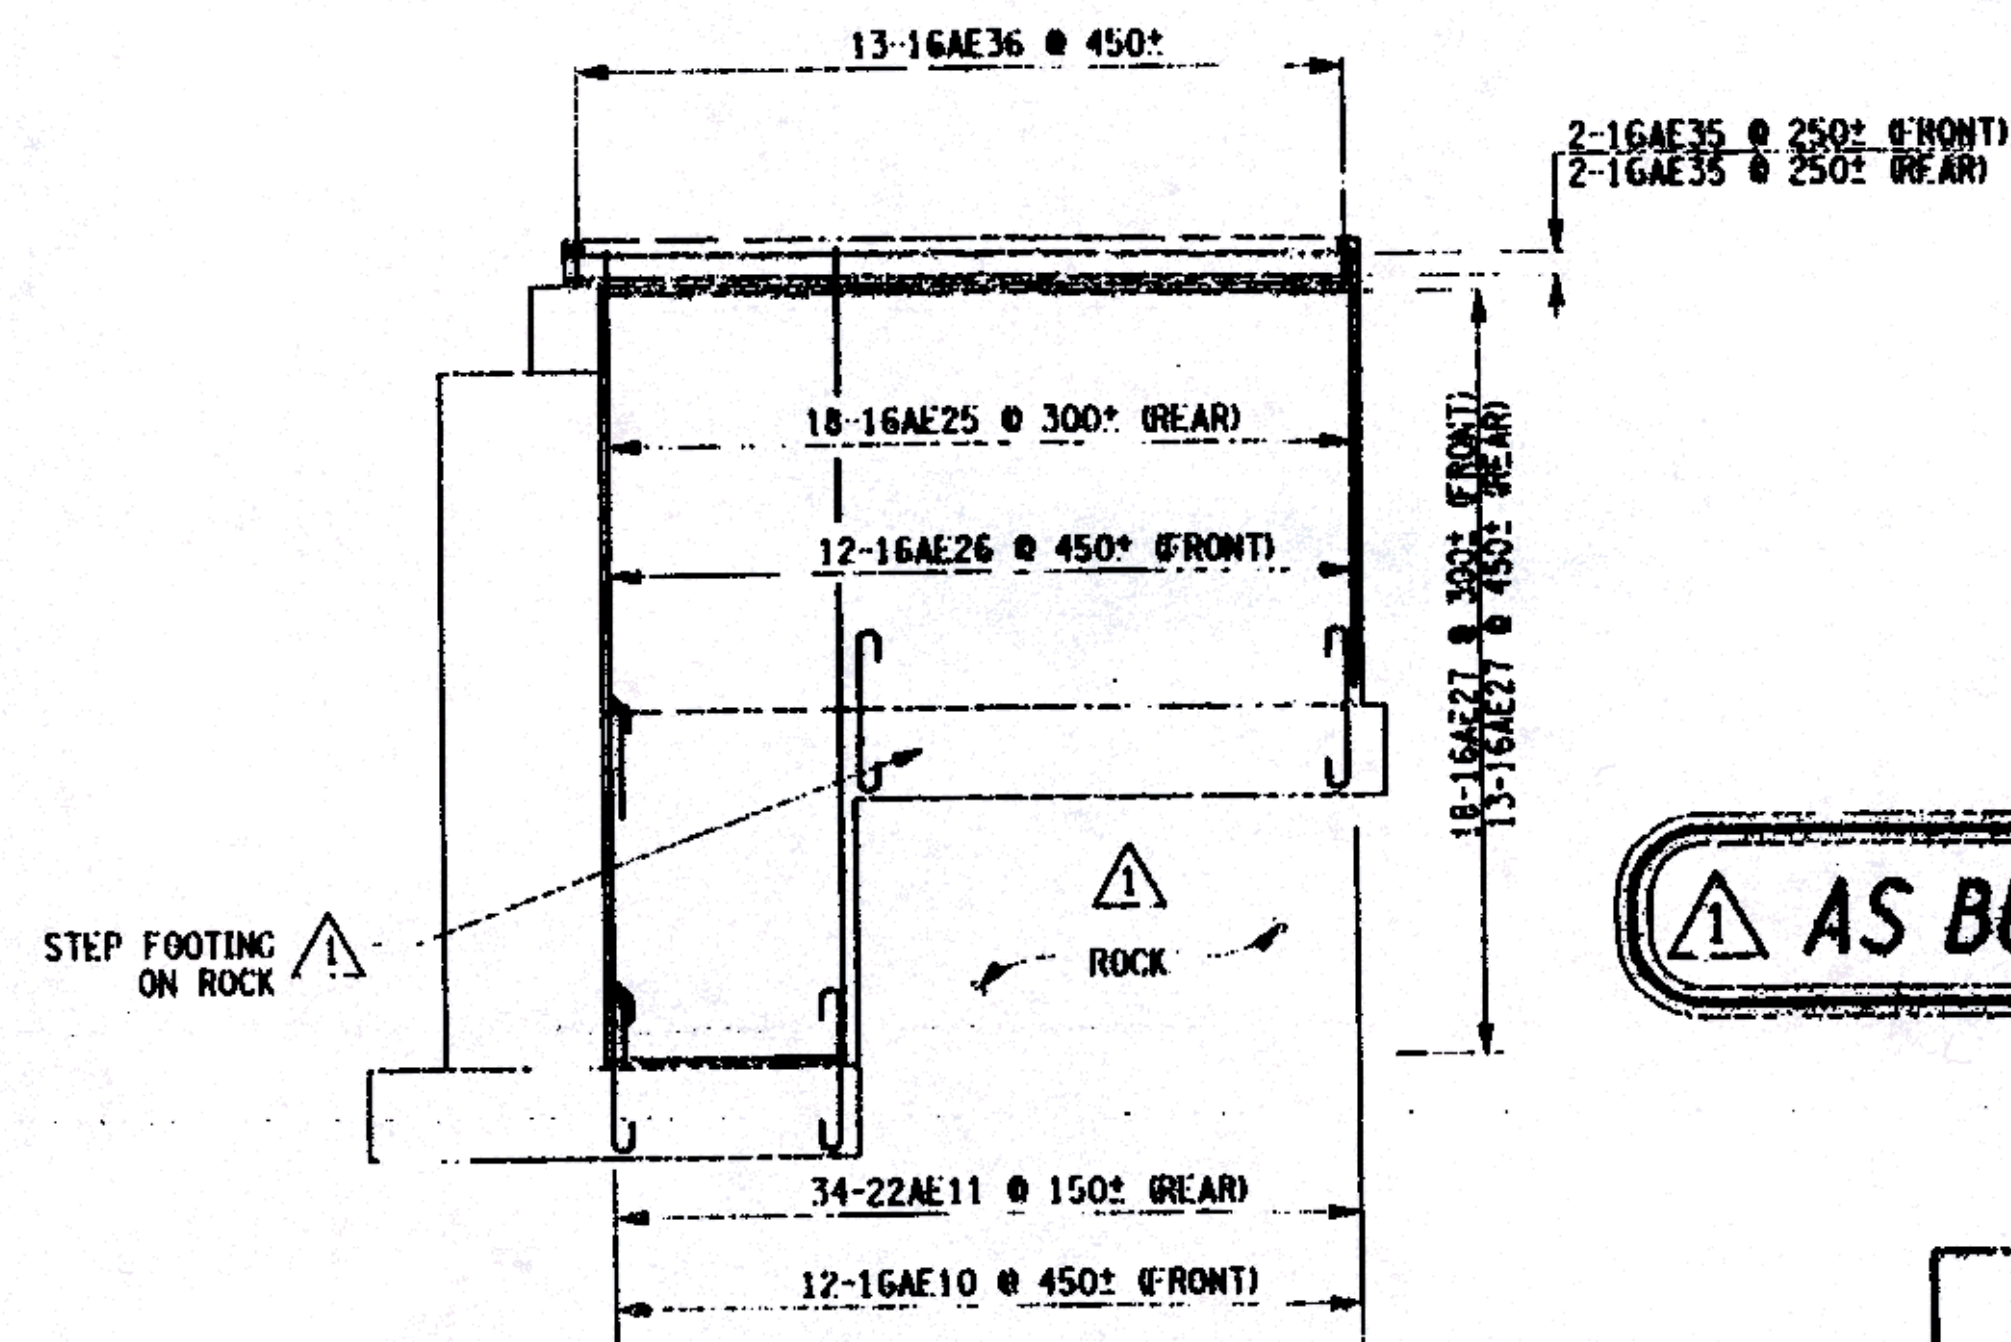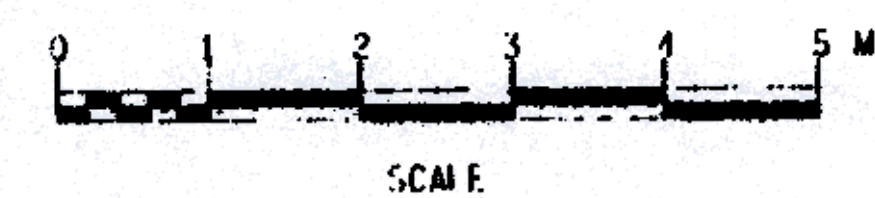

U-WALL REINFORCEMENT PLAN



NOTES:

FOR EAST ABUTMENT PLAN AND ELEVATION, SEE DWG. NO. ST-11.

FOR ADDITIONAL EAST ABUTMENT REINFORCEMENT DETAILS, SEE DWG. NO. ST-13.

ALL COVER SHALL BE 75 mm IN THE FOOTING AND 50 mm ELSEWHERE, UNLESS OTHERWISE NOTED.

AS BUILT: REVISIONS 9/2003

ALL DIMENSIONS ARE IN mm UNLESS OTHERWISE NOTED
AS BUILT REVISIONS

SIGNATURE: *James E. Starn* DATE: 9/2003

COUNTY ROAD 18 OVER POULTNEY RIVER

EAST ABUTMENT PLAN AND
U-WALL ELEVATION REINFORCEMENT

WASHINGTON COUNTY
DEPARTMENT OF PUBLIC WORKS

FILE NAME: 175376AA.A1F REGION: ONE DATE: 3/2002 DRAWING NO.: ST-12



NOTES

FILENAME	REGION	DATE	DRAWING NO.
175376AA-V18	ONE	3/2002	ST-17

```
FILE NAME = I:\work\42087\CADD\A65units\175376A.V29
DATE/TIME = 11/04/2013 . 12:09:16 AM
USER = RAN
```


FED. ROAD RLG. NO.	STATE	CONTRACT NO.	SHEET NO.	TOTAL SHEETS
1	N.Y.		37	43

COUNTY ROAD 18 OVER POULTNEY RIVER	
WASHINGTON COUNTY, NY / RUTLAND COUNTY, VT	
TOWN OF HAMPTON, NY / POULTNEY, VT	
CAPITAL PROJECT IDENTIFICATION NO. 1753.76	

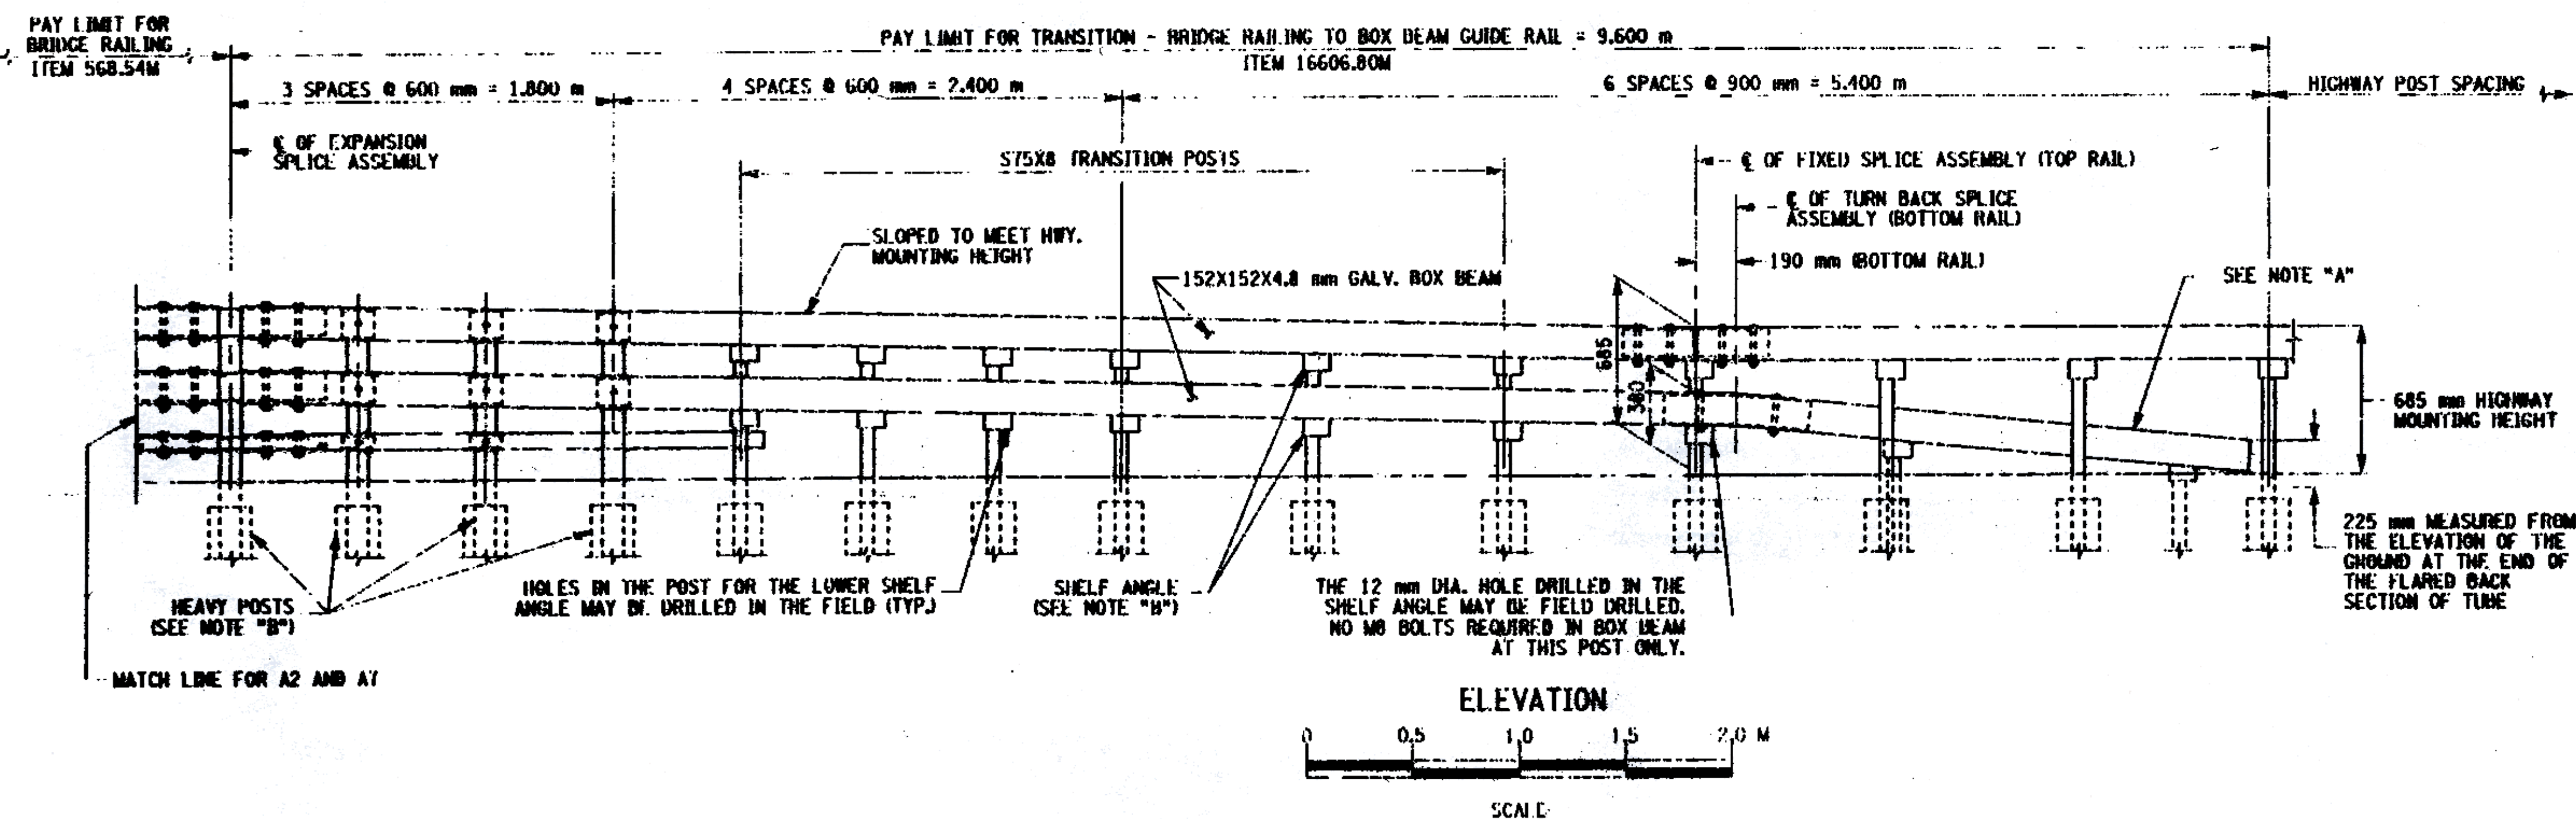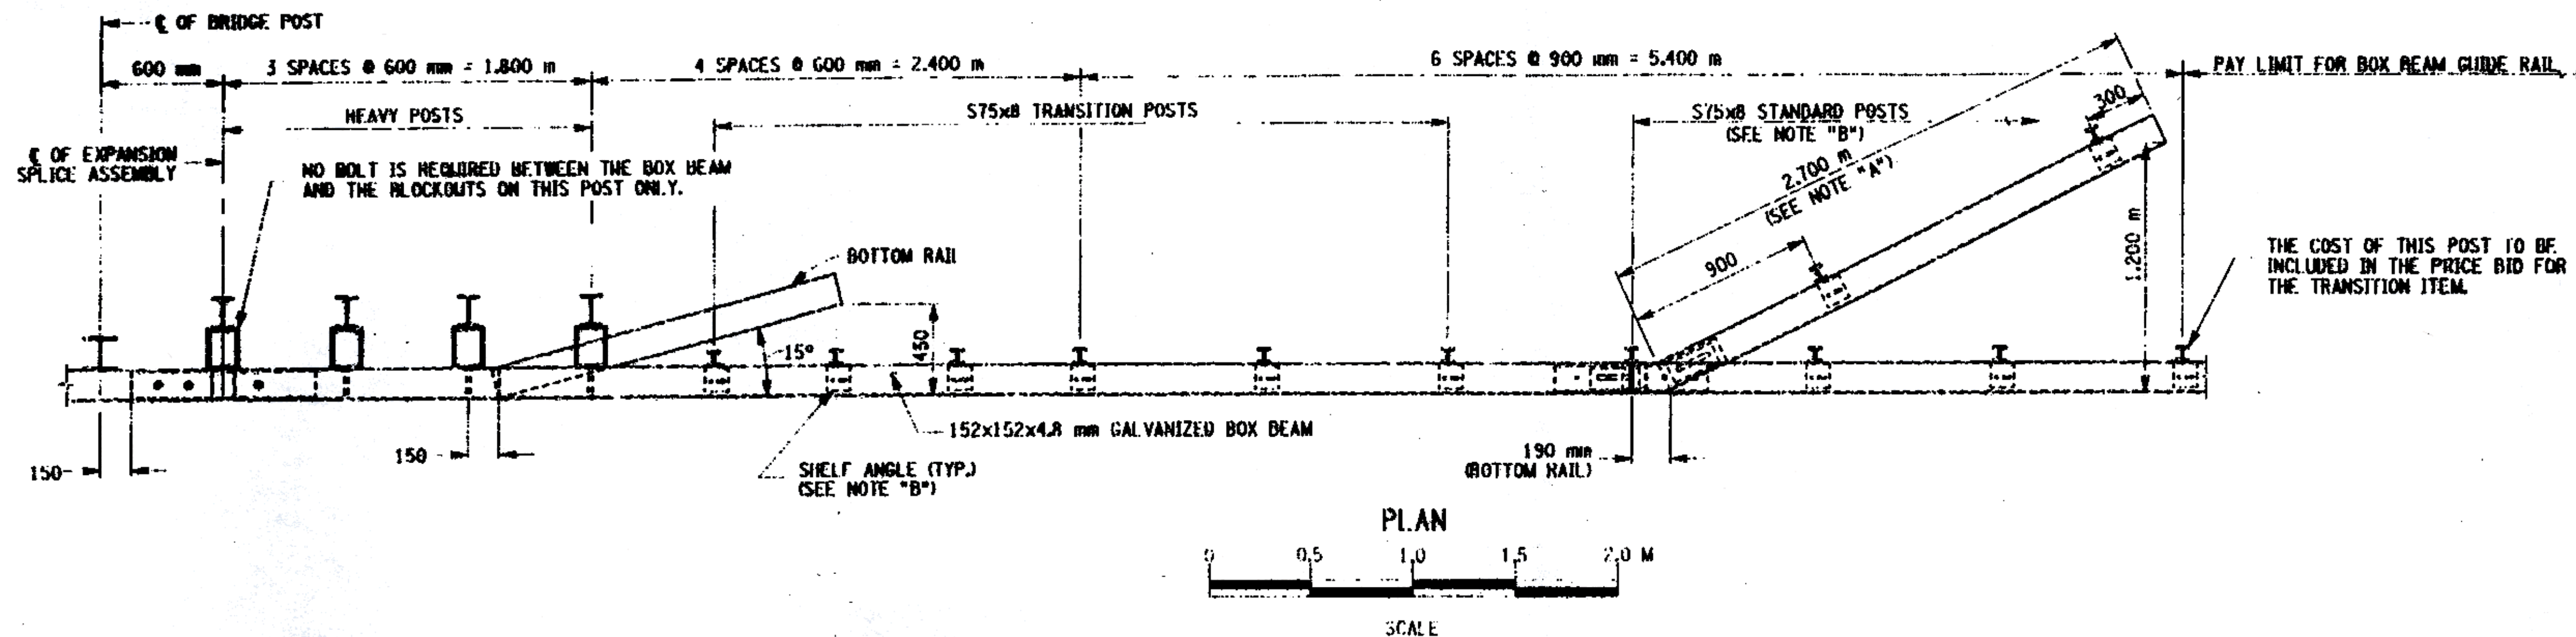

NOTE "A":
THE COST OF THE POSTS, SPLICE TUBE AND RAIL FOR THE LOWER TUBE FLARE SECTION IS INCLUDED IN THE PRICE BID FOR THE TRANSITION ITEM.

NOTE "B":
FOR ADDITIONAL DETAILS SEE DRAWING NO. ST-22.

NOTES:
ALL STEEL SHALL BE GALVANIZED IN ACCORDANCE WITH N.Y.S. STANDARD SPECIFICATIONS, SUBSECTION 719-01. ALL AREAS WHERE THE ZINC COATING IS DAMAGED DURING INSTALLATION INCLUDING FIELD DRILLING HOLES, SHALL BE REPAIRED ACCORDING TO SUBSECTION 719-01.

ALL RAILING IS TO BE FABRICATED AND ERECTED ACCORDING TO SECTION 568 OF THE STANDARD SPECIFICATIONS.

PRIOR TO GALVANIZING THE ASSEMBLED POST, GRIND ALL EDGES TO A MINIMUM RADIUS OF 2 mm.

BOLTS SHALL BE TORQUED SNUG TIGHT (APPROXIMATELY 135 N-m).

AS BUILT: NO REVISIONS 9/2003

ALL DIMENSIONS ARE IN mm UNLESS OTHERWISE NOTED

AS BUILT REVISIONS

Signature 9/2003
SIGNATURE DATE

COUNTY ROAD 18 OVER POULTNEY RIVER



BRIDGE RAIL
(SHEET 1 OF 4)

WASHINGTON COUNTY
DEPARTMENT OF PUBLIC WORKS

FILE NAME 175376AAR1A	REGION ONE	DATE 3/2002	DRAWING NO. ST-21
--------------------------	---------------	----------------	----------------------








FILE NAME: D:\NORTH\22827\CA001A\Buil\175376aar1a
DATE/TIME: 11/07/2003 10:11:34 AM
USER: RAN

DESIGN SUPERVISOR JAC JOB MANAGER JAC CHECKED BY LMK ESTIMATED BY LMK CHECKED BY BKT CRAFTED BY BKT

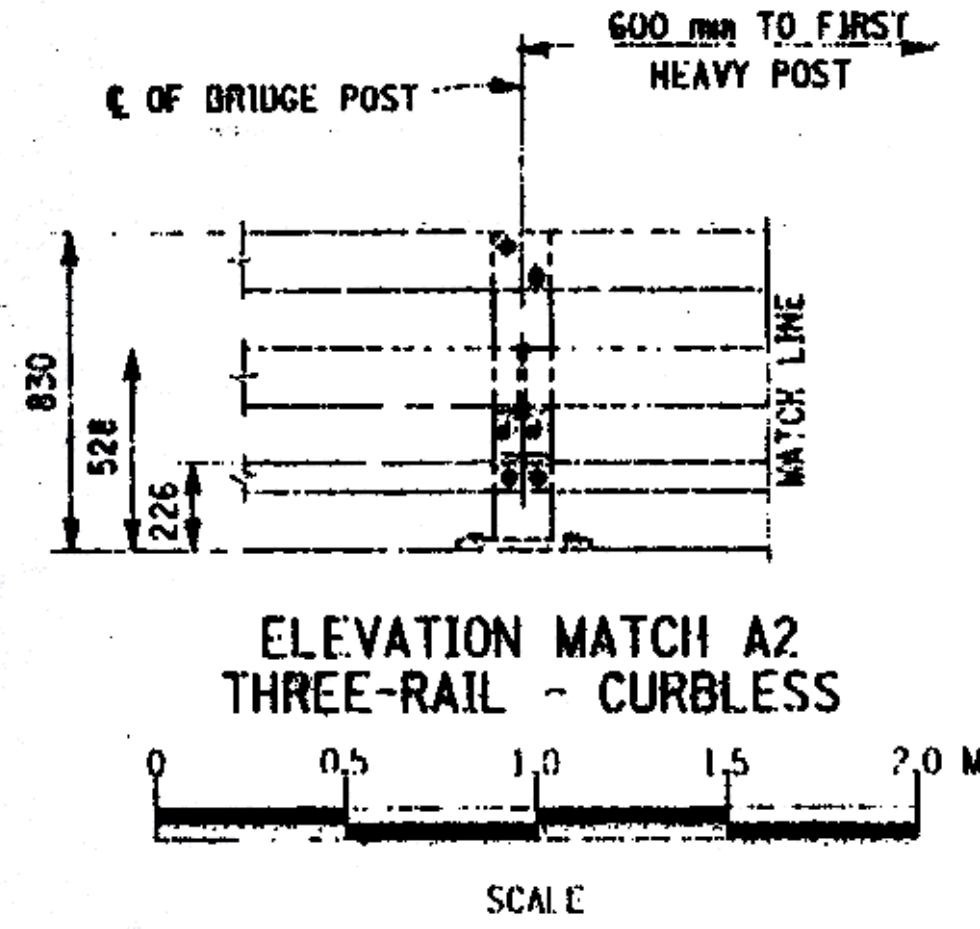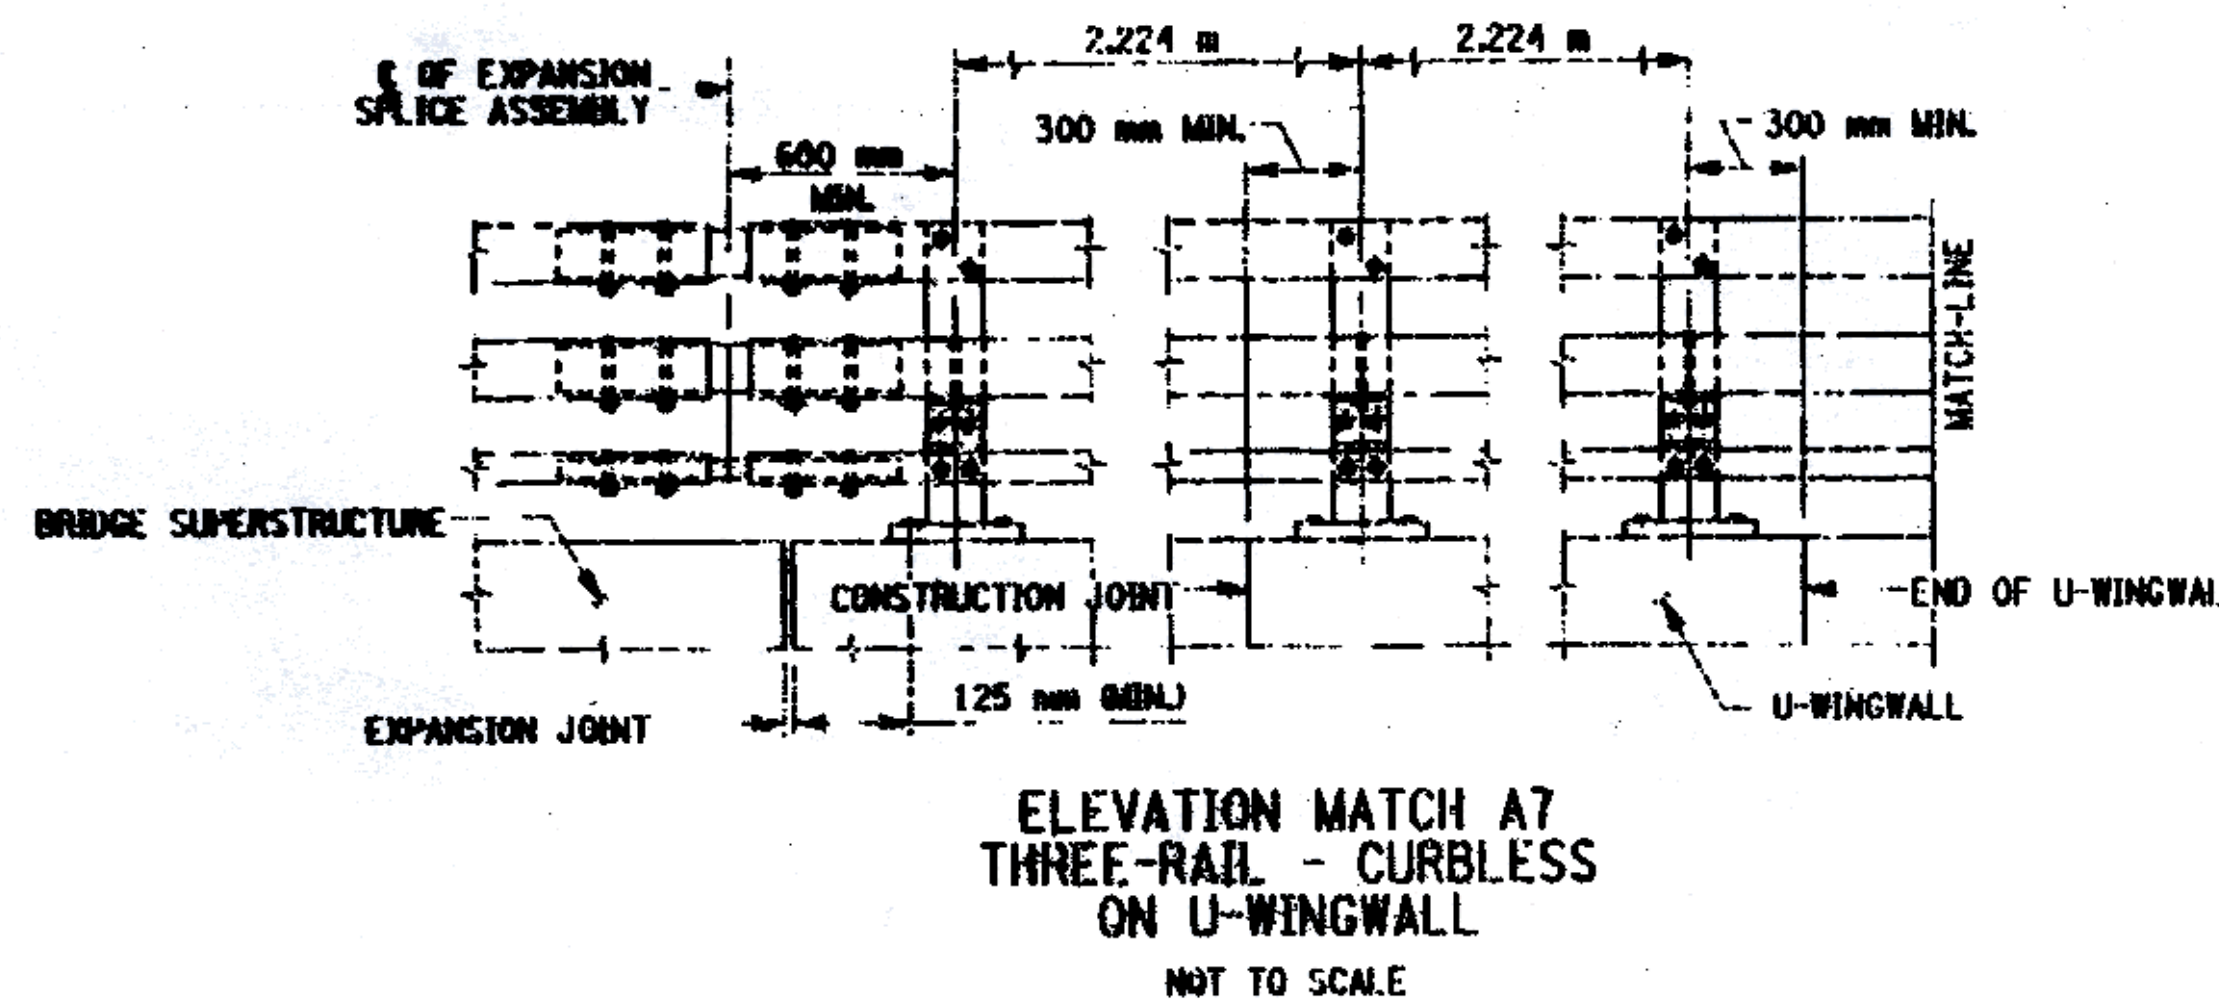

FED. ROAD REC. NO.	STATE	CONTRACT NO.	SHEET NO.	TOTAL SHEETS
1	N.Y.		38	43

COUNTY ROAD 18 OVER POULTNEY RIVER
WASHINGTON COUNTY, NY / RUTLAND COUNTY, VT
TOWN OF HAMPTON, NY / POULTNEY, VT
CAPITAL PROJECT IDENTIFICATION NO. 1753.76

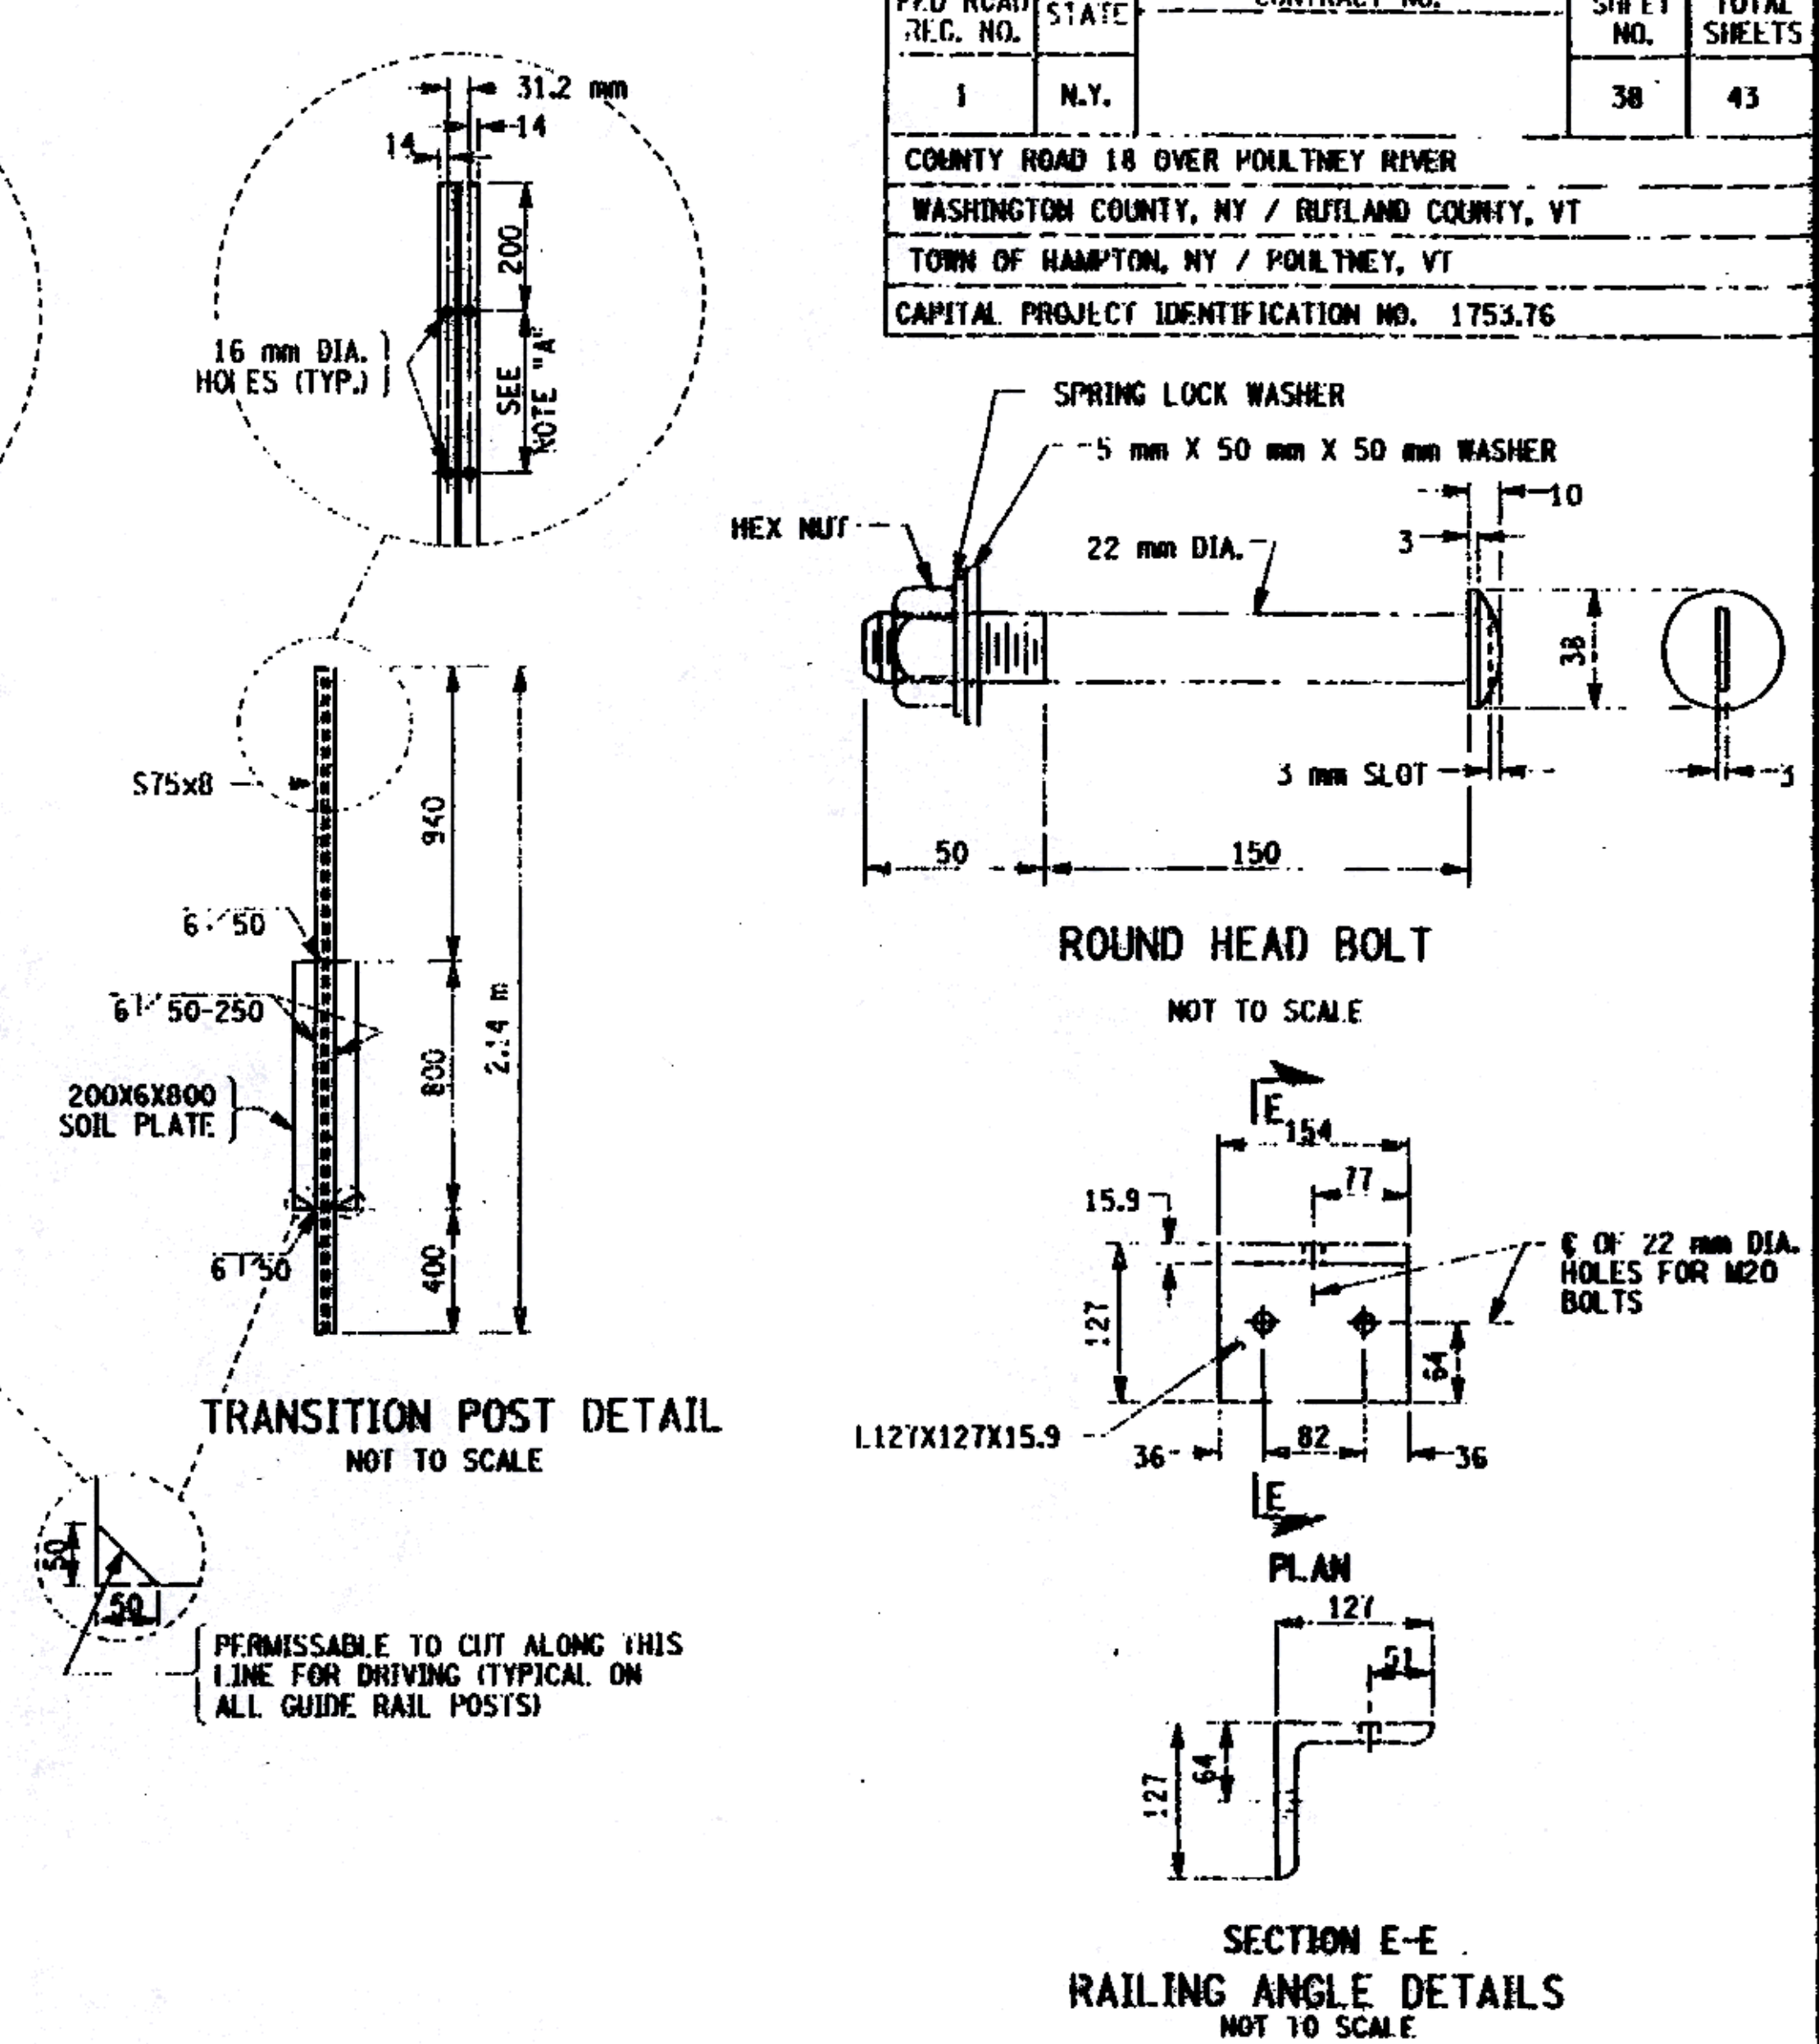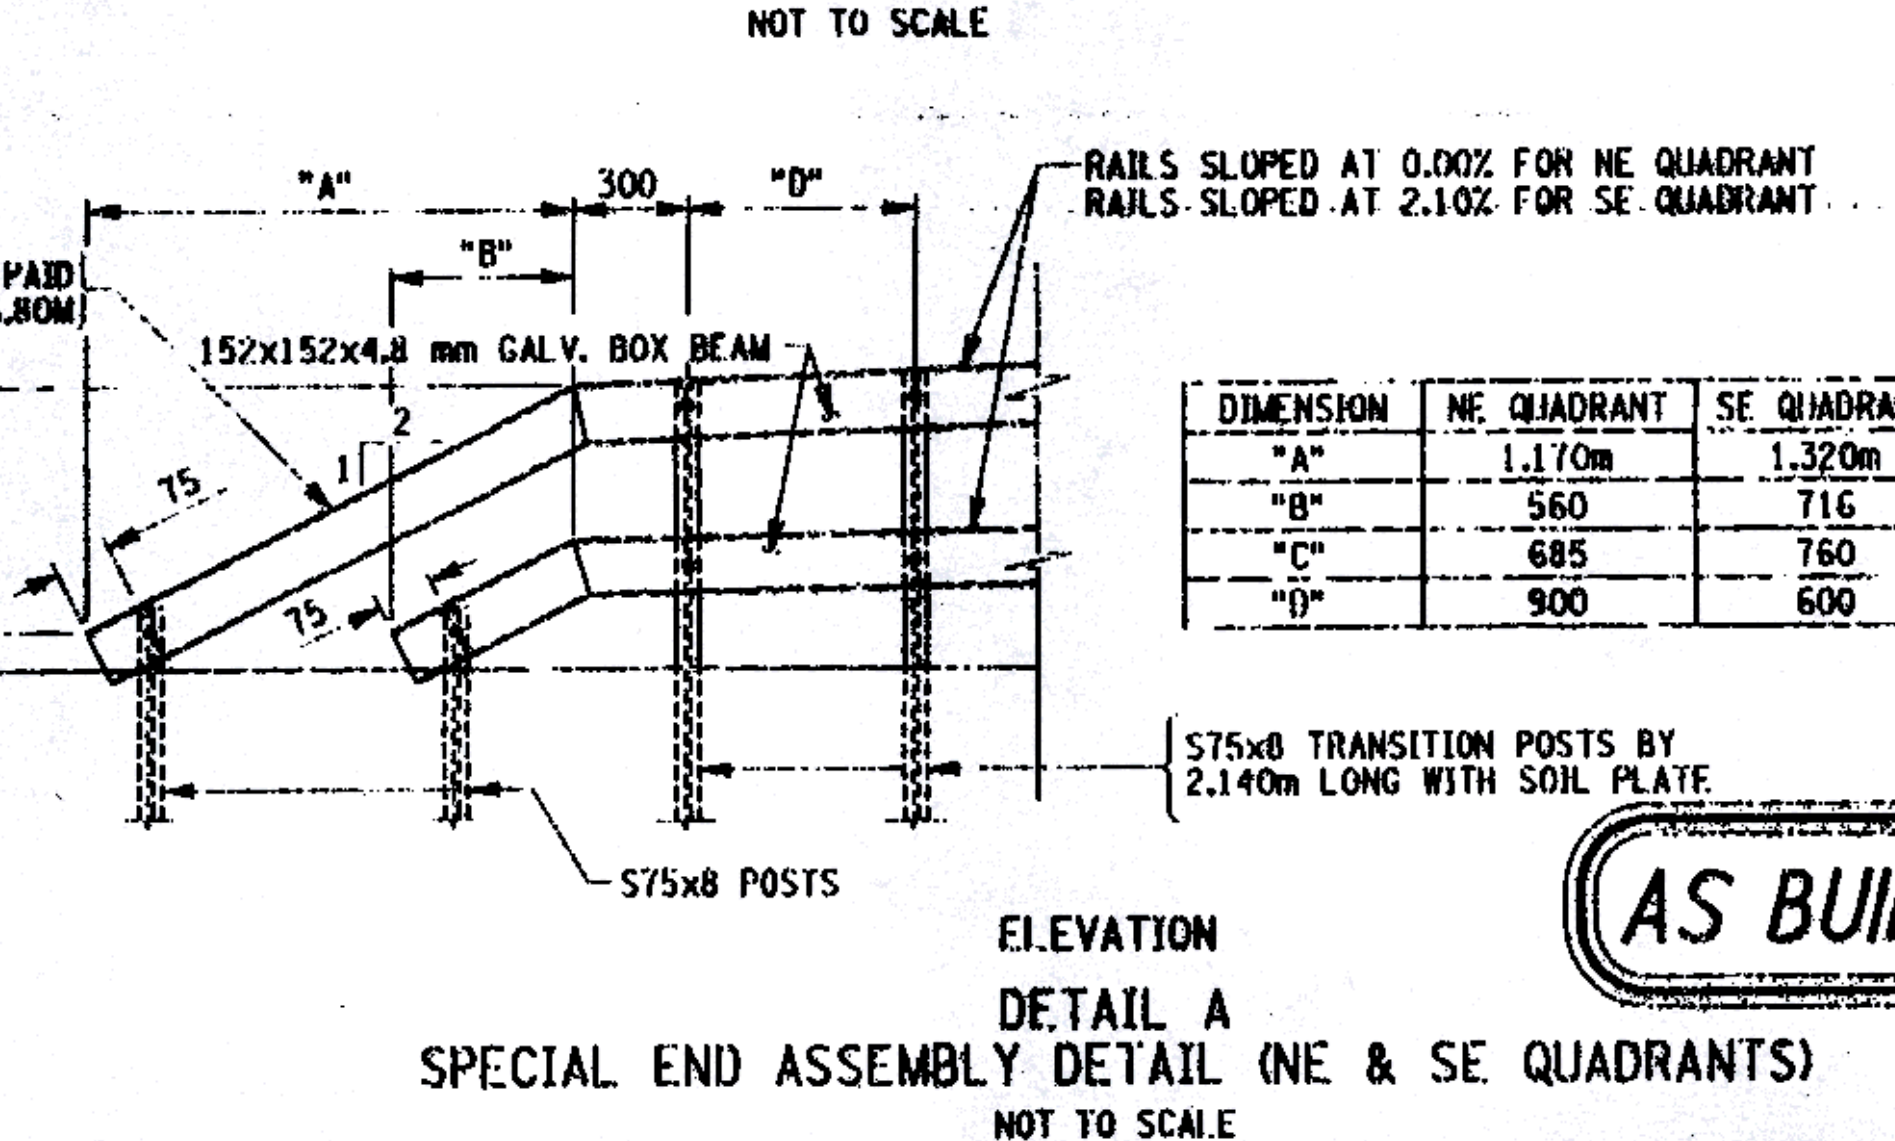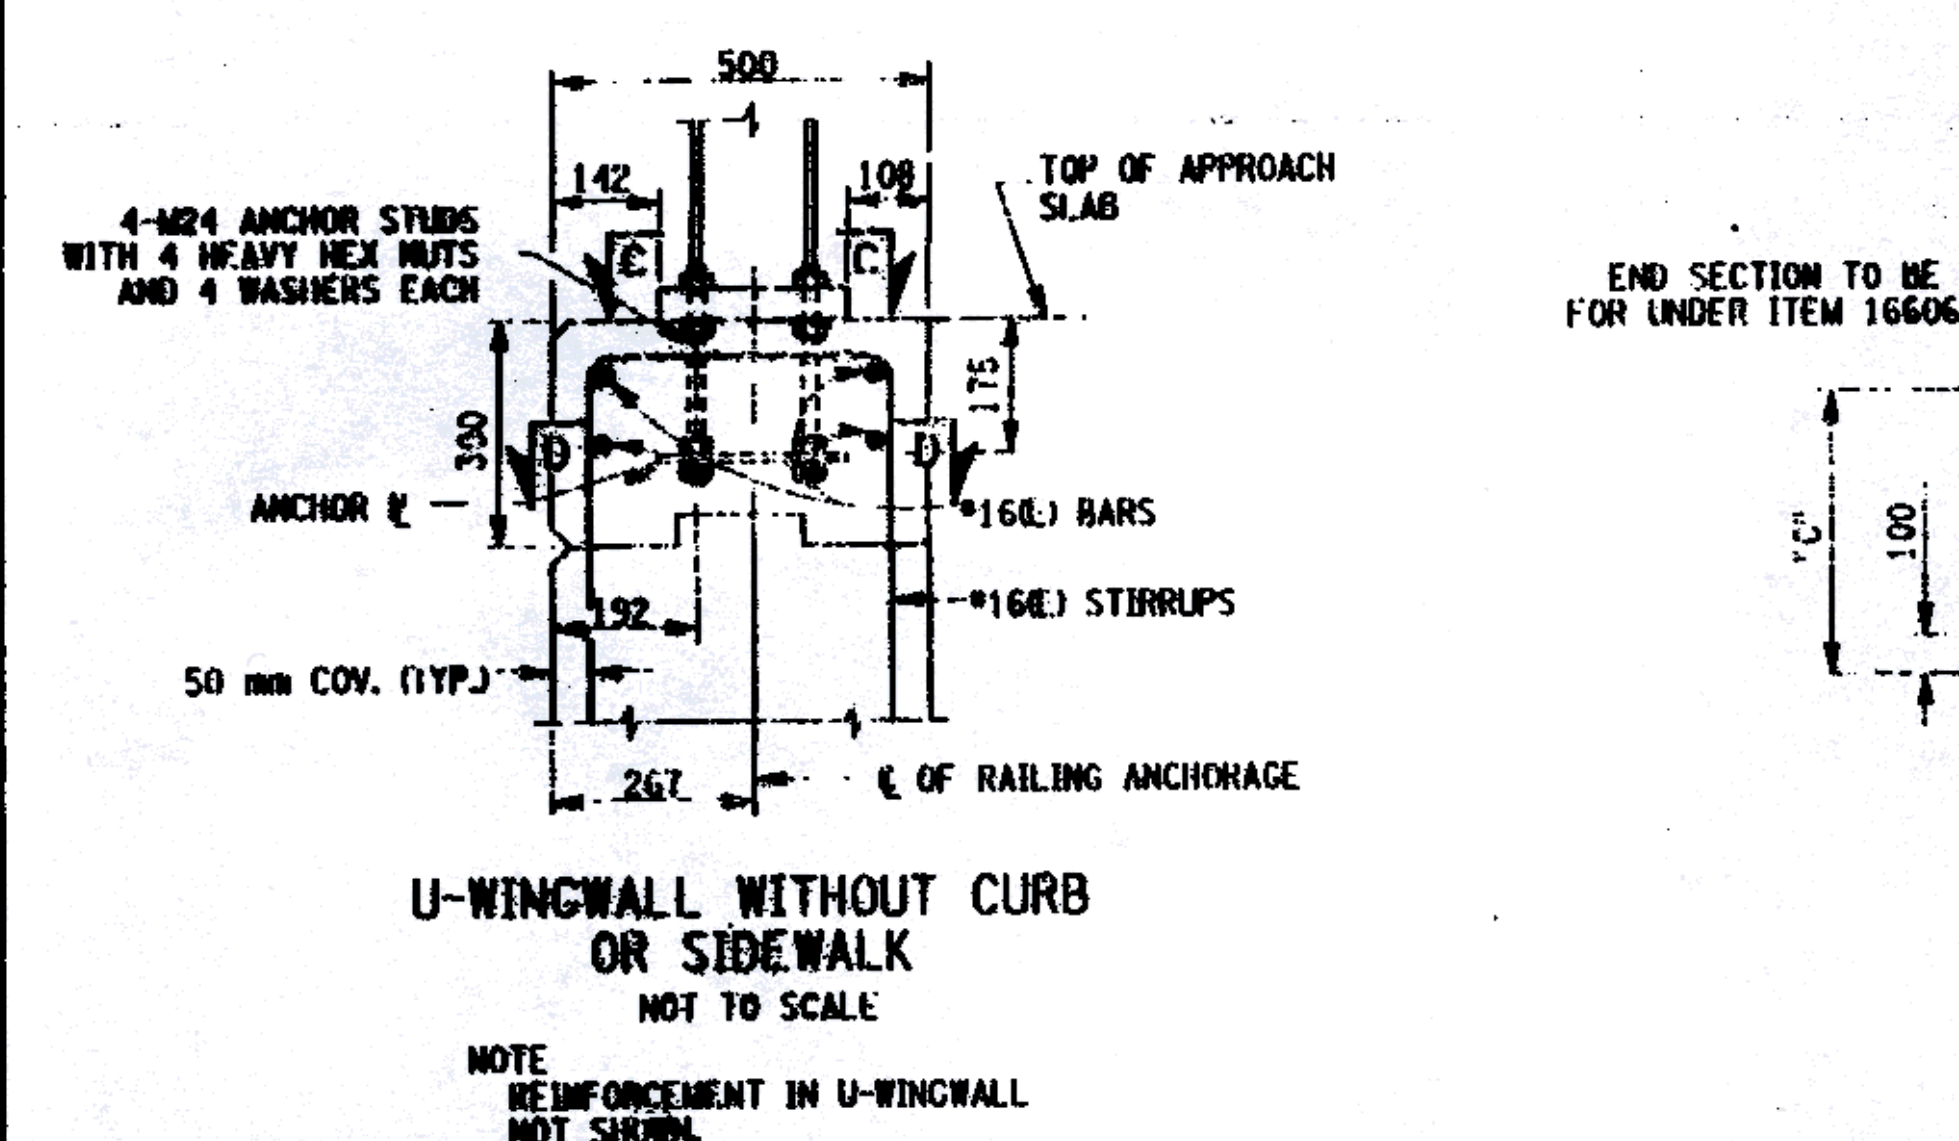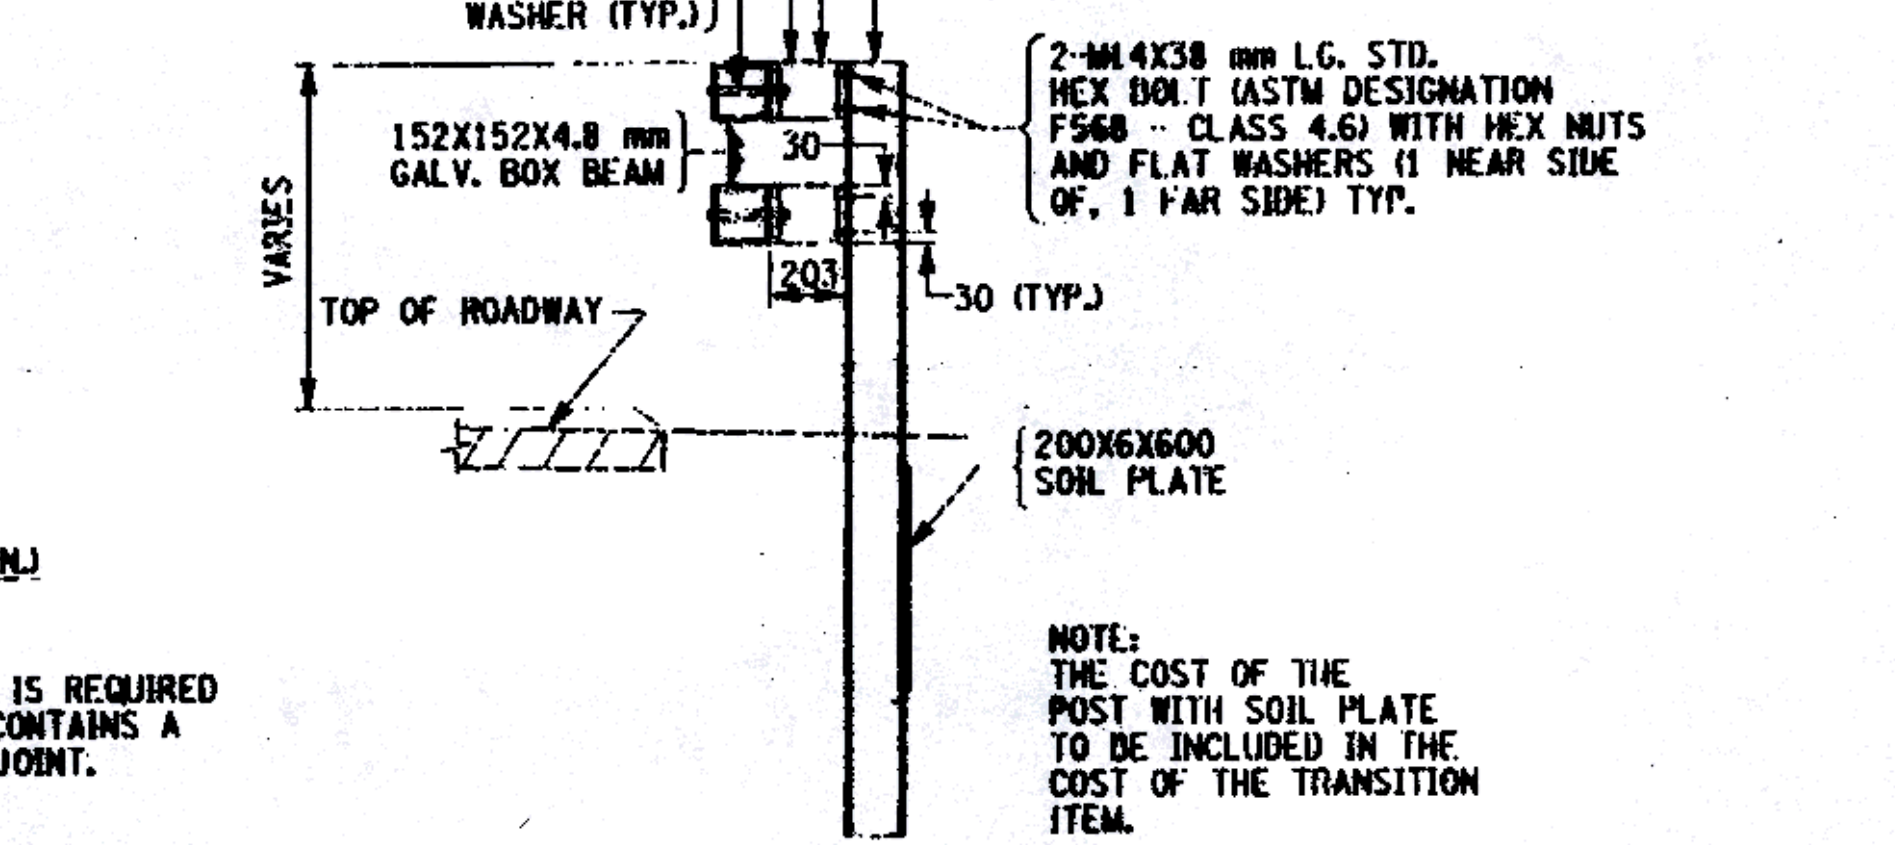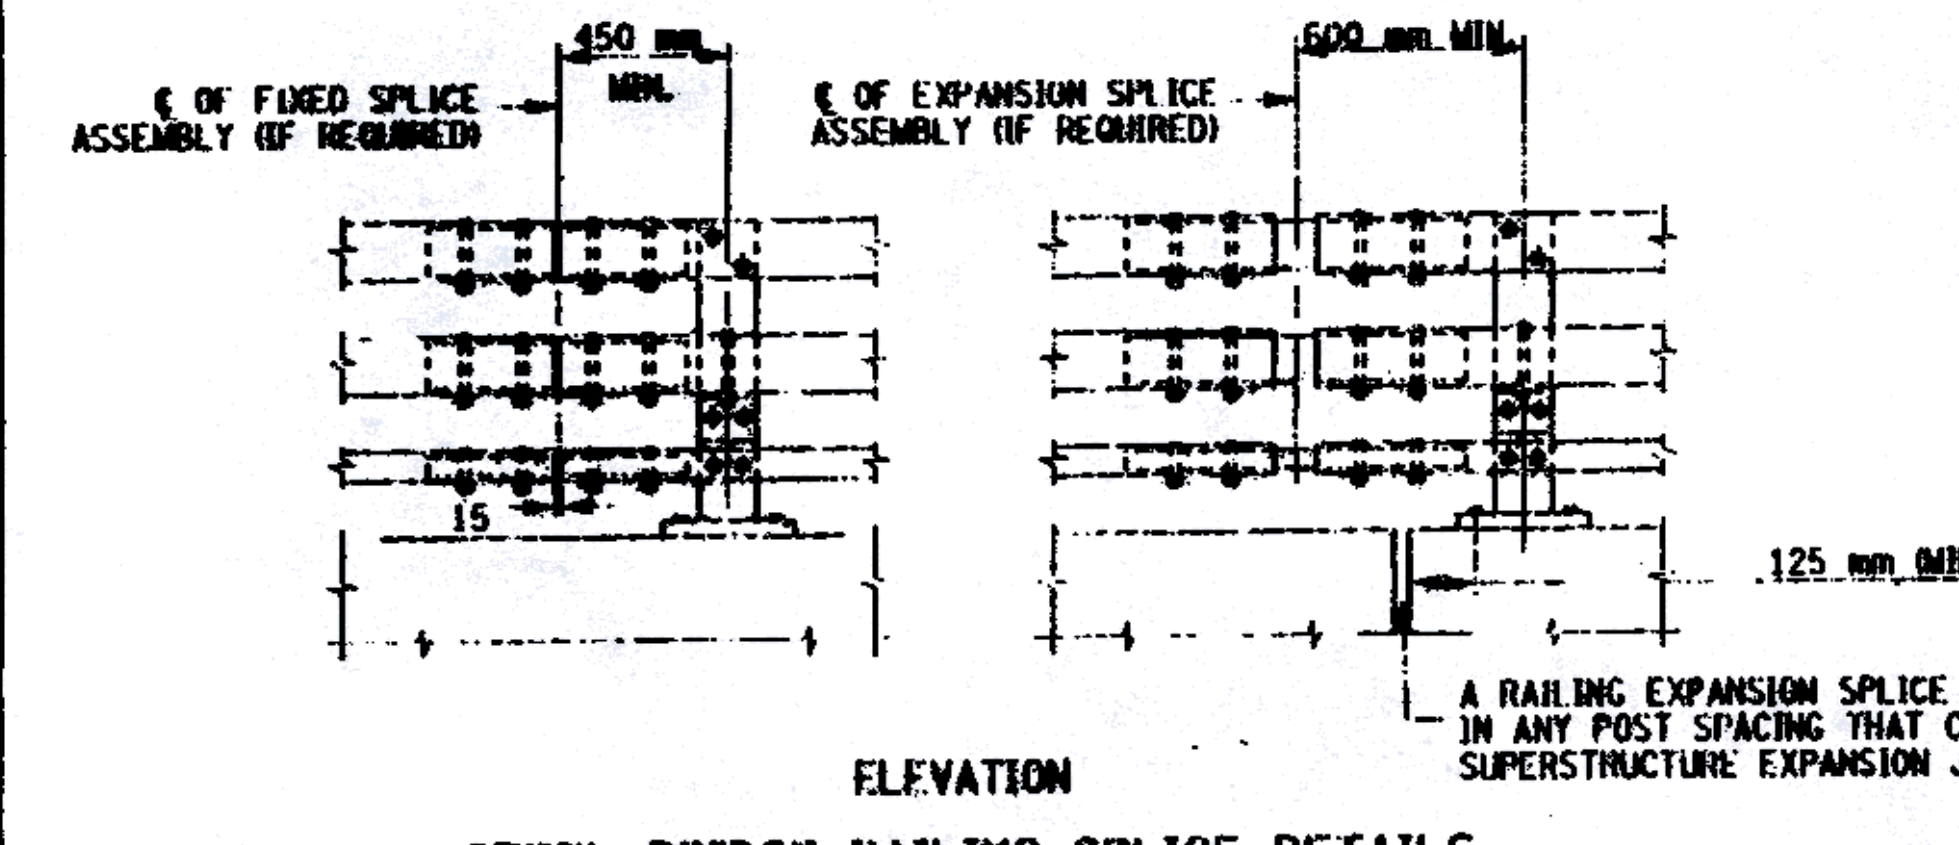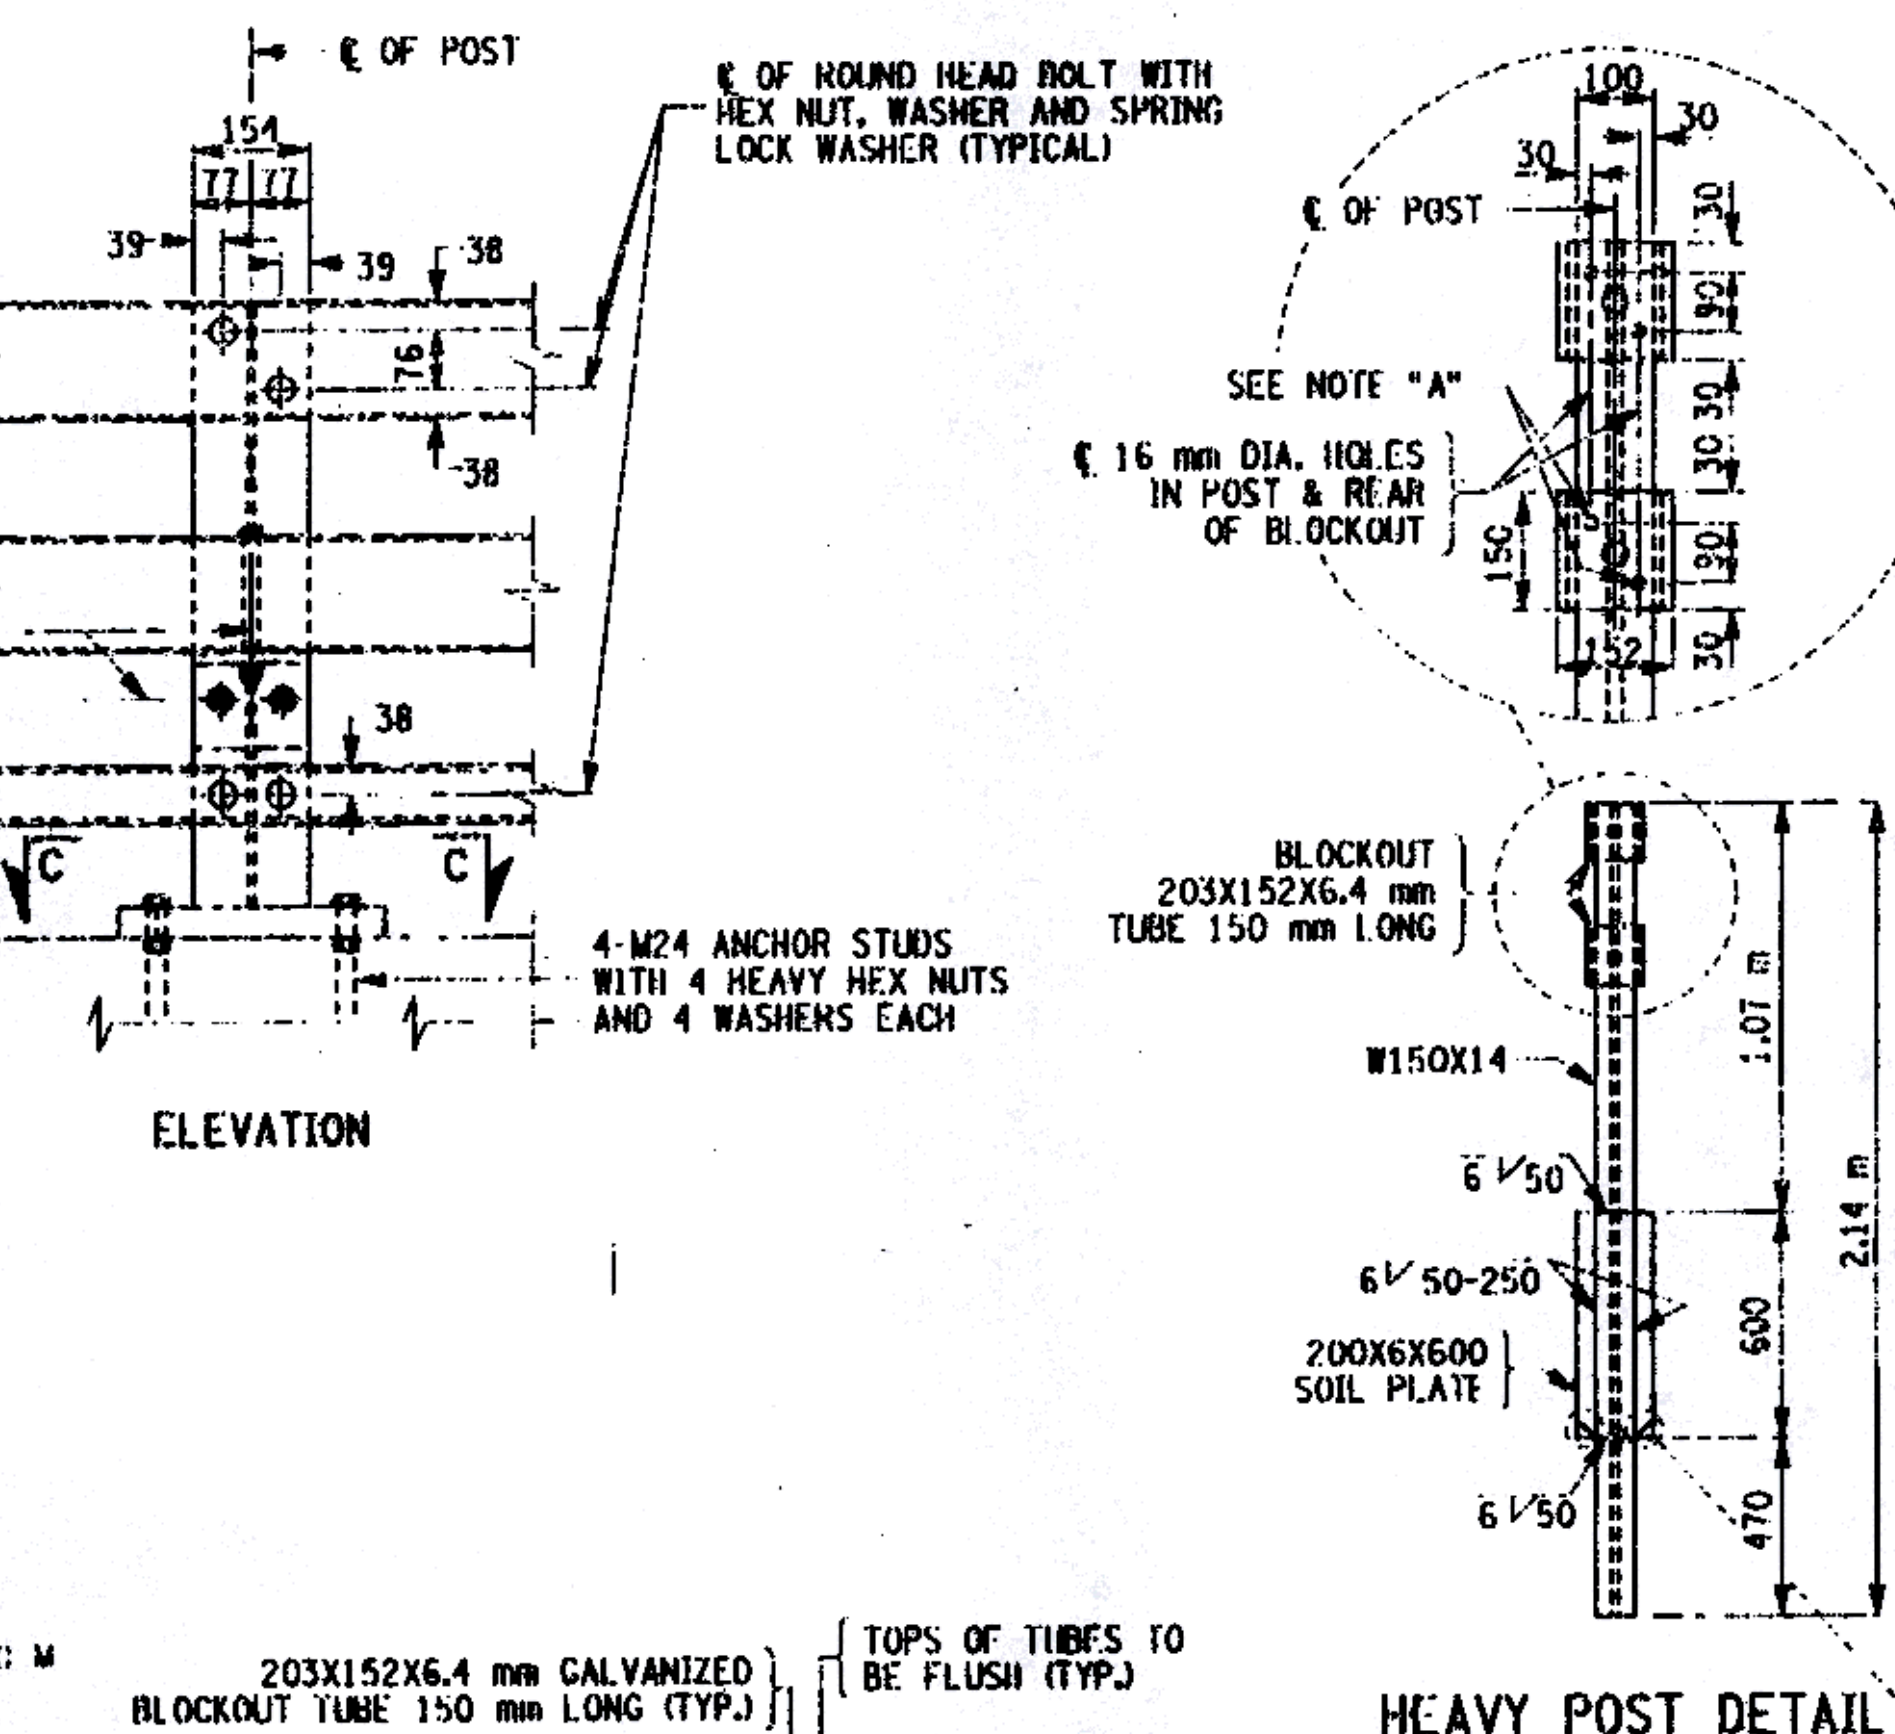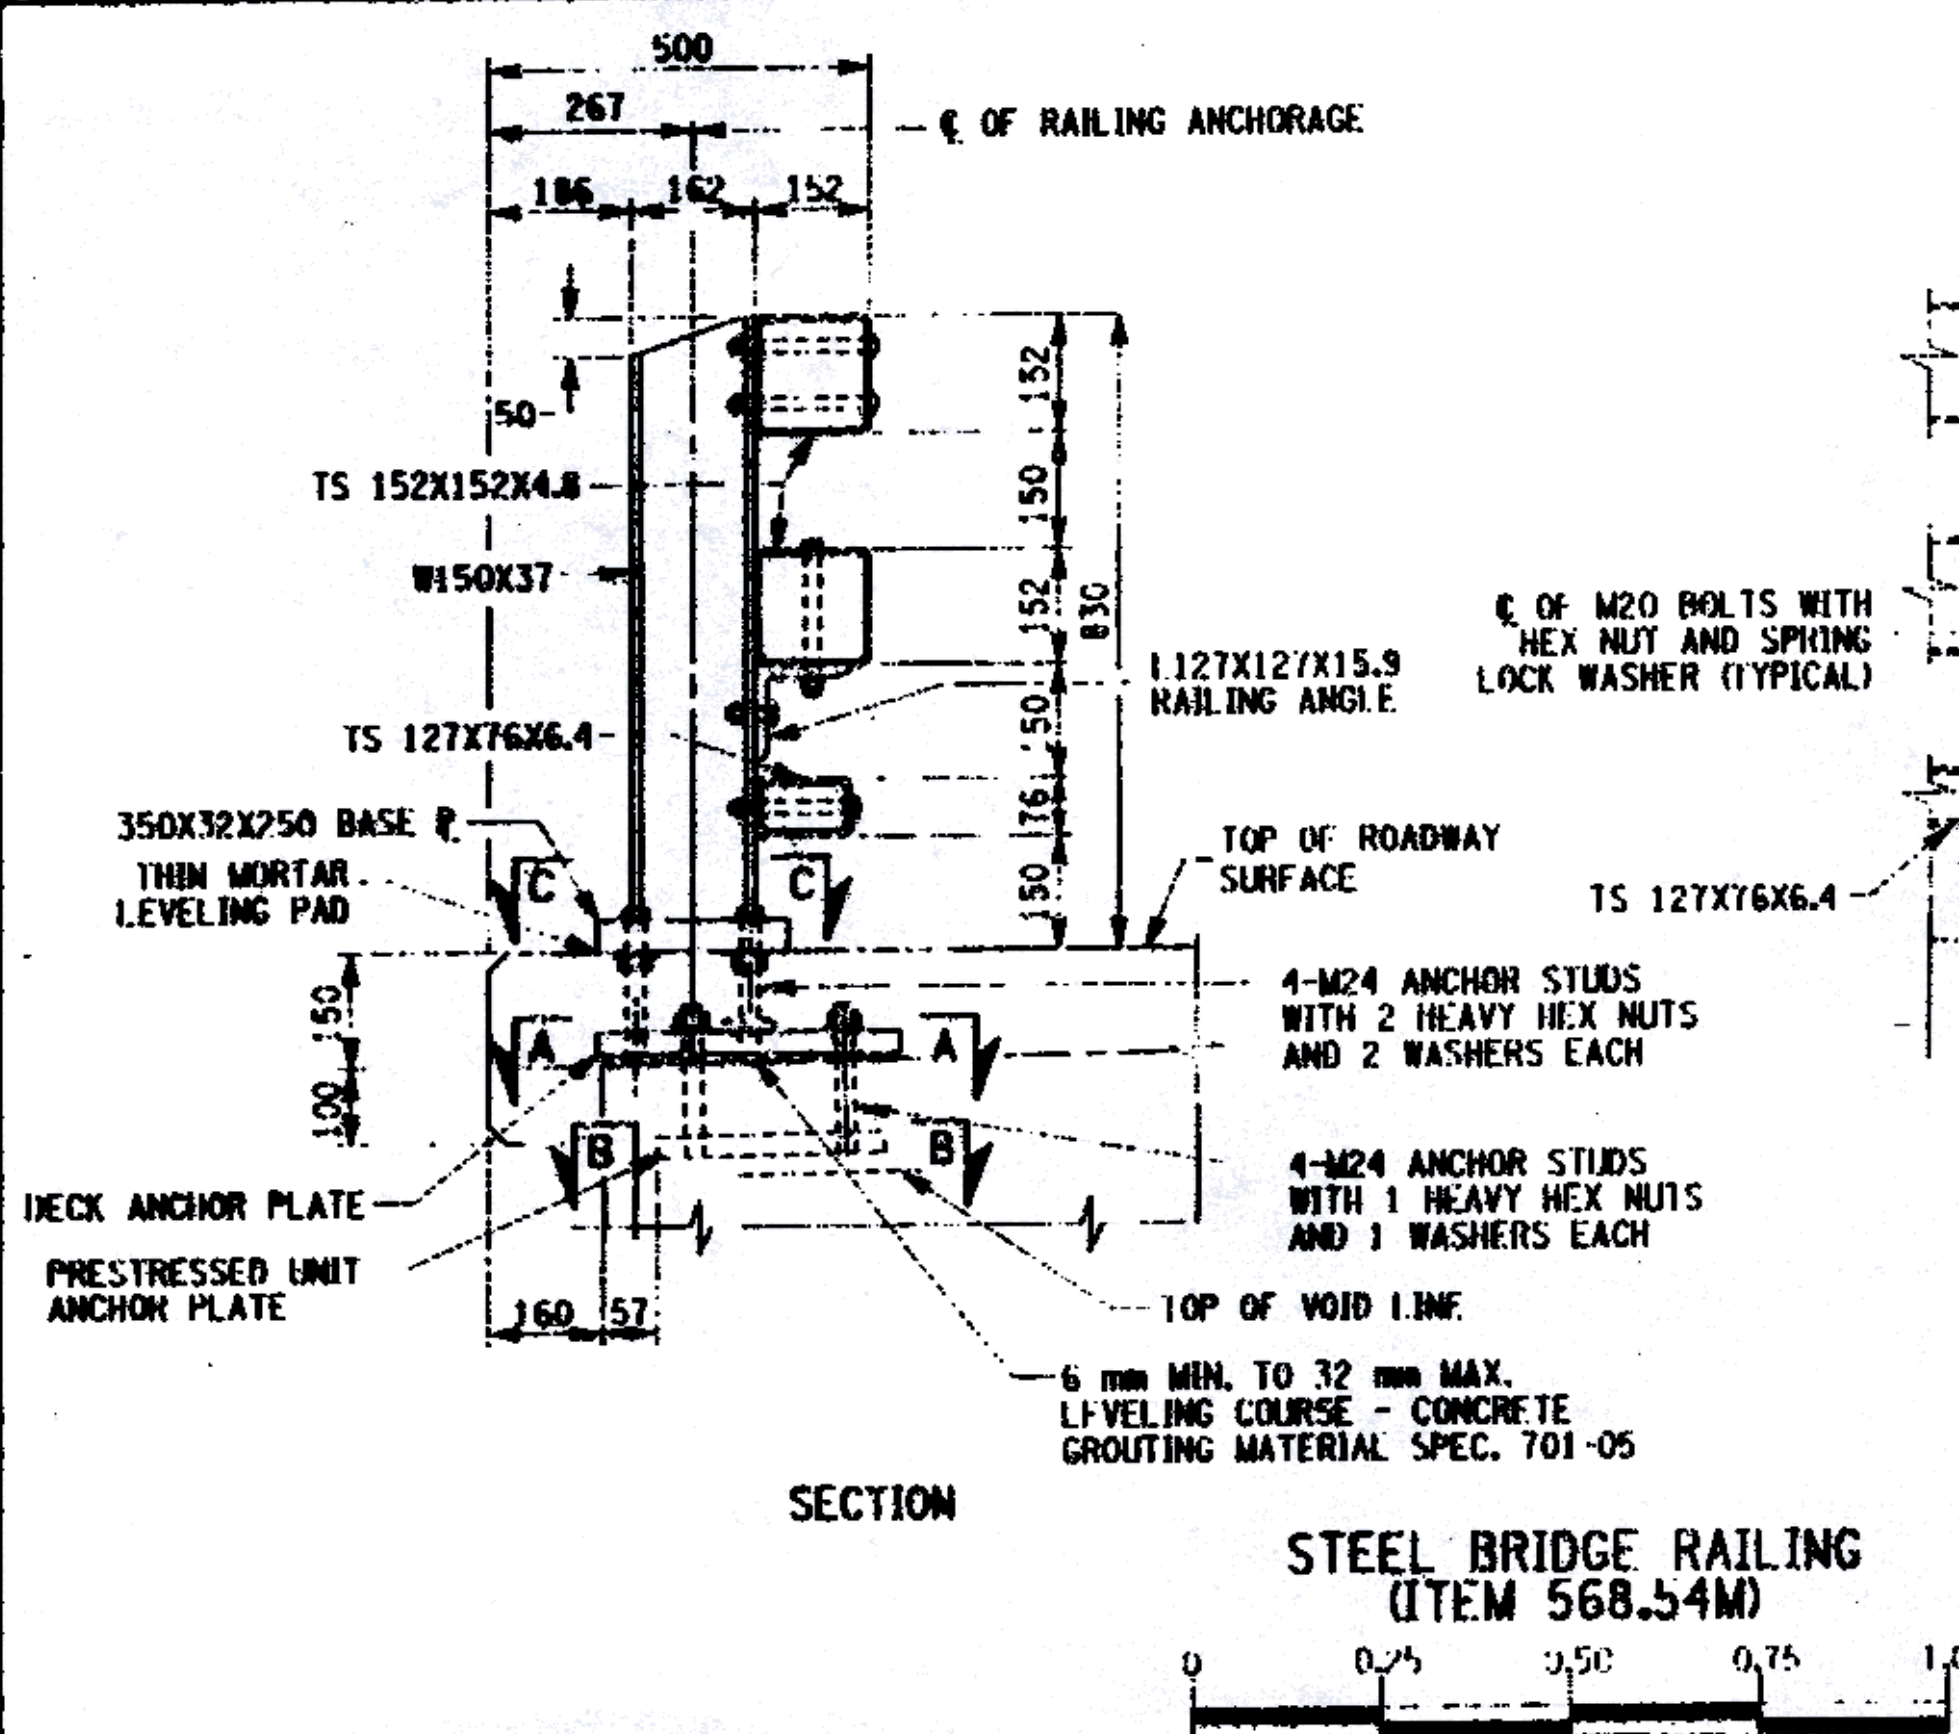

NOTE "A"
HOLES IN THE POST FOR THE LOWER RAIL MAY BE LOCATED AND DRILLED IN THE FIELD. IF SO, THE GALVANIZING SHALL BE REPAIRED IN ACCORDANCE WITH SUBSECTION 719-01.

NOTES:
ALL RAILING IS TO BE FABRICATED AND ERECTED ACCORDING TO SECTION 568 OF THE STANDARD SPECIFICATIONS.
PRIOR TO GALVANIZING THE ASSEMBLED POST, GRIND ALL EDGES TO A MINIMUM RADIUS OF 2 mm.
BOLTS SHALL BE TORQUED SNUG TIGHT (APPROXIMATELY 135 N-m).

ALL DIMENSIONS ARE IN mm UNLESS OTHERWISE NOTED
AS BUILT REVISIONS

Signature 9/2003
DATE

COUNTY ROAD 18 OVER POULTNEY RIVER
BRIDGE RAIL
(SHEET 2 OF 4)
WASHINGTON COUNTY
DEPARTMENT OF PUBLIC WORKS

FILENAME 175376AAR1D	REGION ONE	DATE 3/2002	DRAWING NO. ST-22
-------------------------	---------------	----------------	----------------------









AS BUILT: NO REVISIONS 9/2003

FILE NAME: 175376AAR1D
DATE/TIME: 11/06/2003 10:12:06 AM
USER: RUN
DESIGN SUPERVISOR: JLC
JOB MANAGER: JLC

DESIGNED BY: JLC
CHECKED BY: JLC
ESTIMATED BY: JLC
CHECKED BY: JLC

FILE NAME = I:\work\120007\CAD\DWG\175376.dwg
DATE/TIME = 11/04/2003 10:12:35 AM
USER = JCS

DESIGNED BY JCS
CHECKED BY JCS
ESTIMATED BY JCS
DRAFTED BY JCS
DESIGNED BY JCS
CHECKED BY JCS
ESTIMATED BY JCS
DRAFTED BY JCS
DESIGNED BY JCS
CHECKED BY JCS
ESTIMATED BY JCS
DRAFTED BY JCS

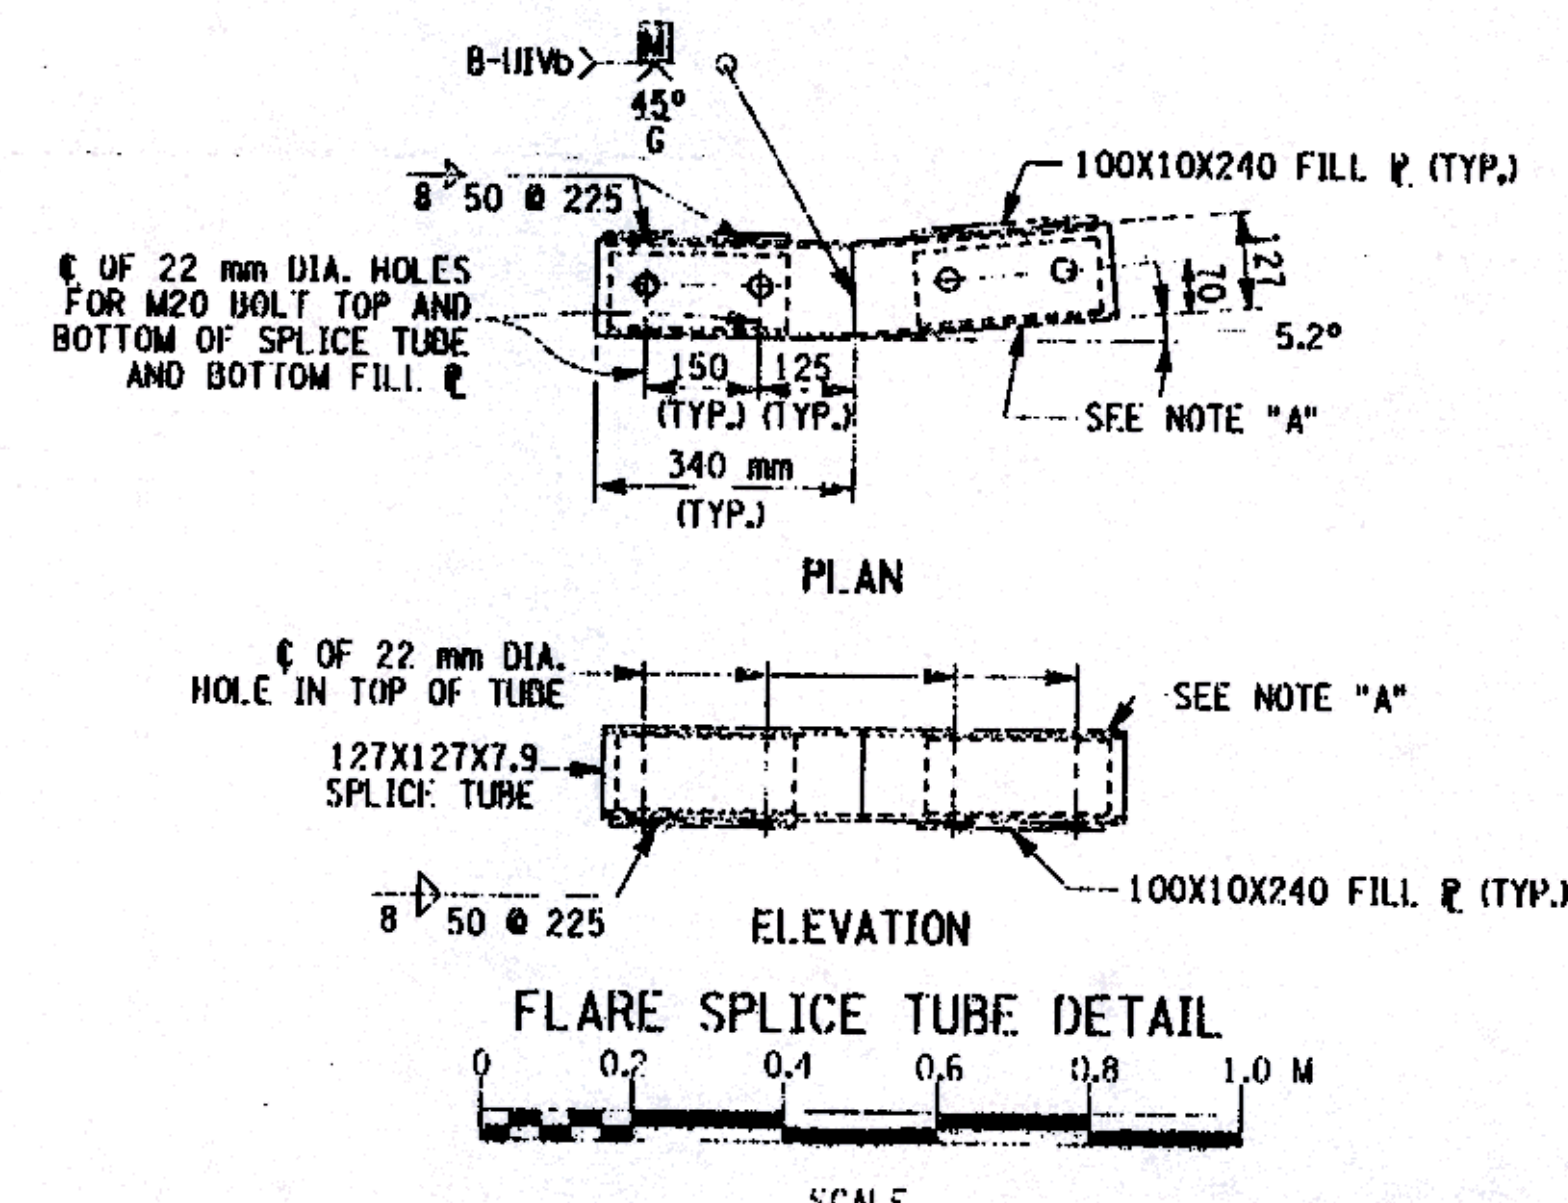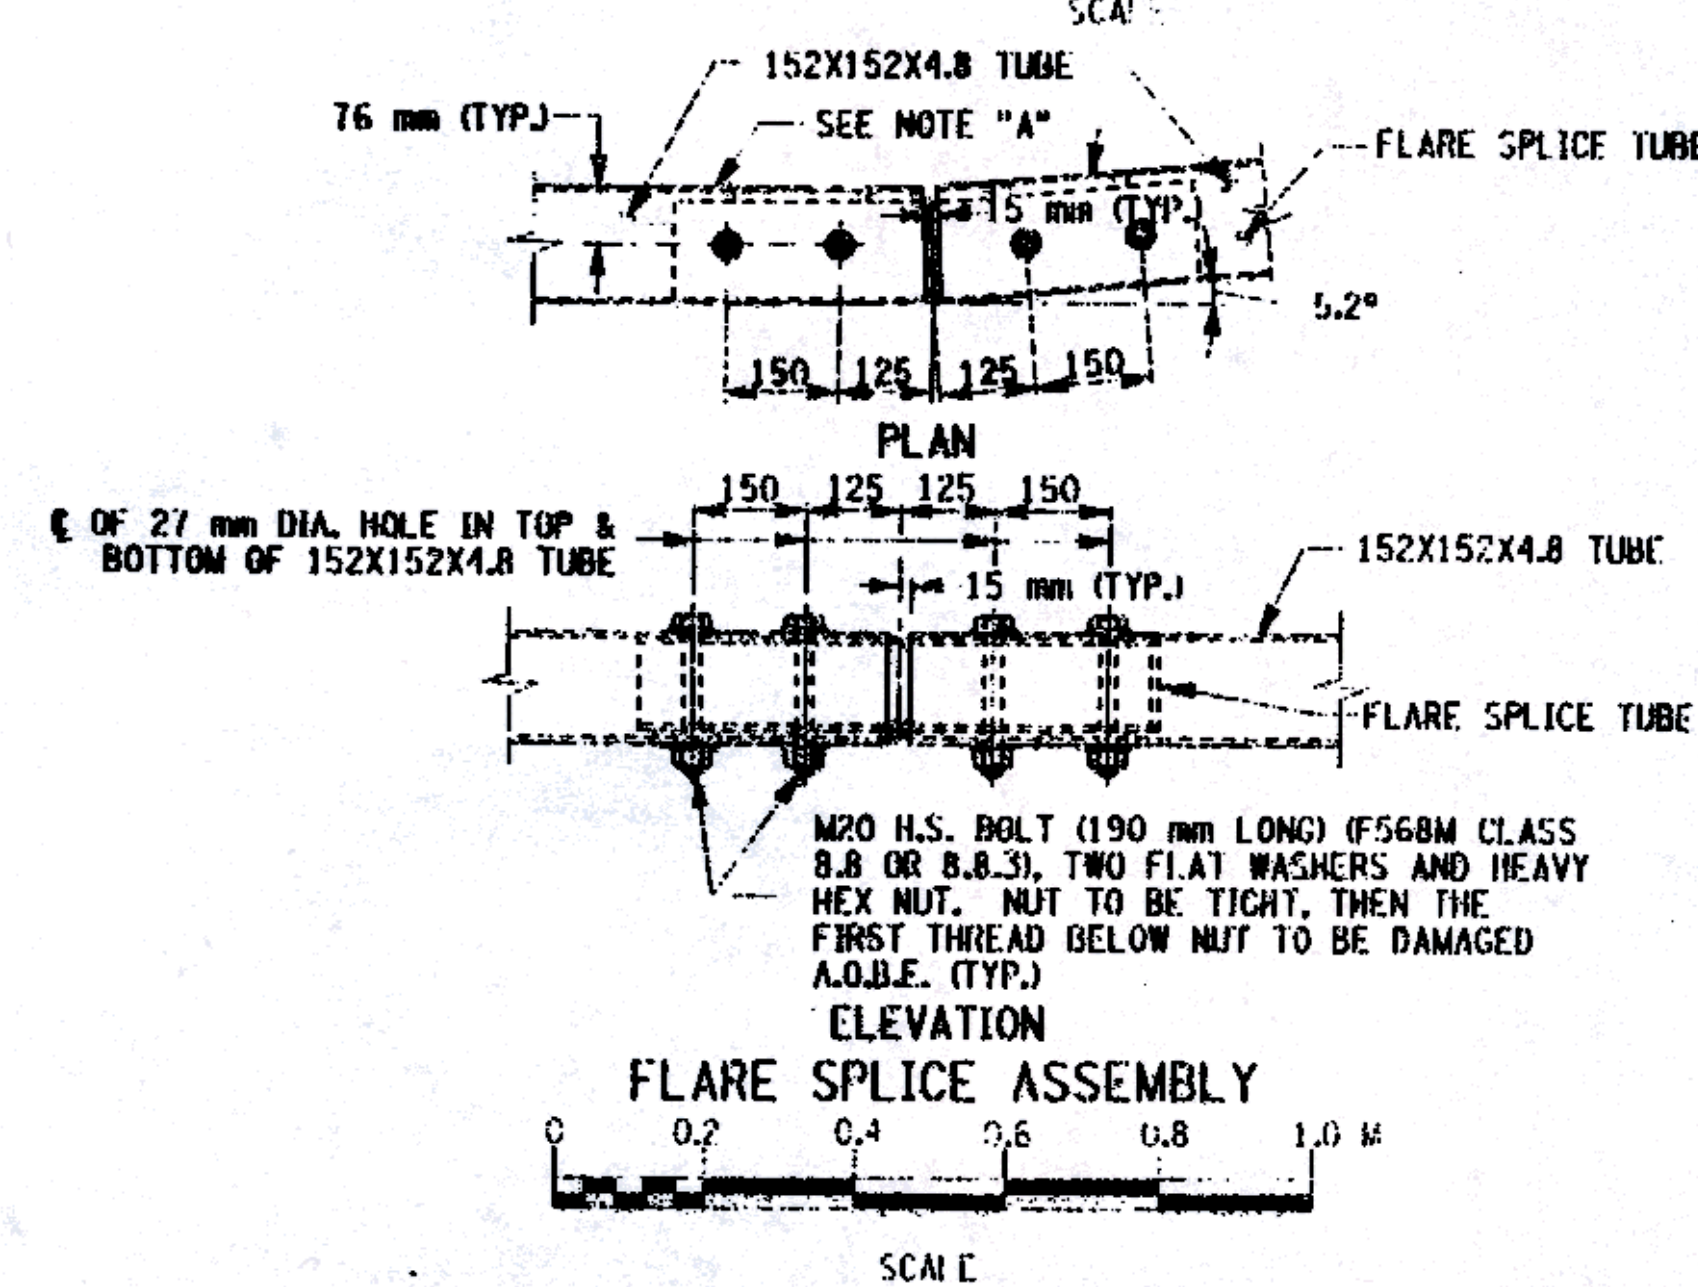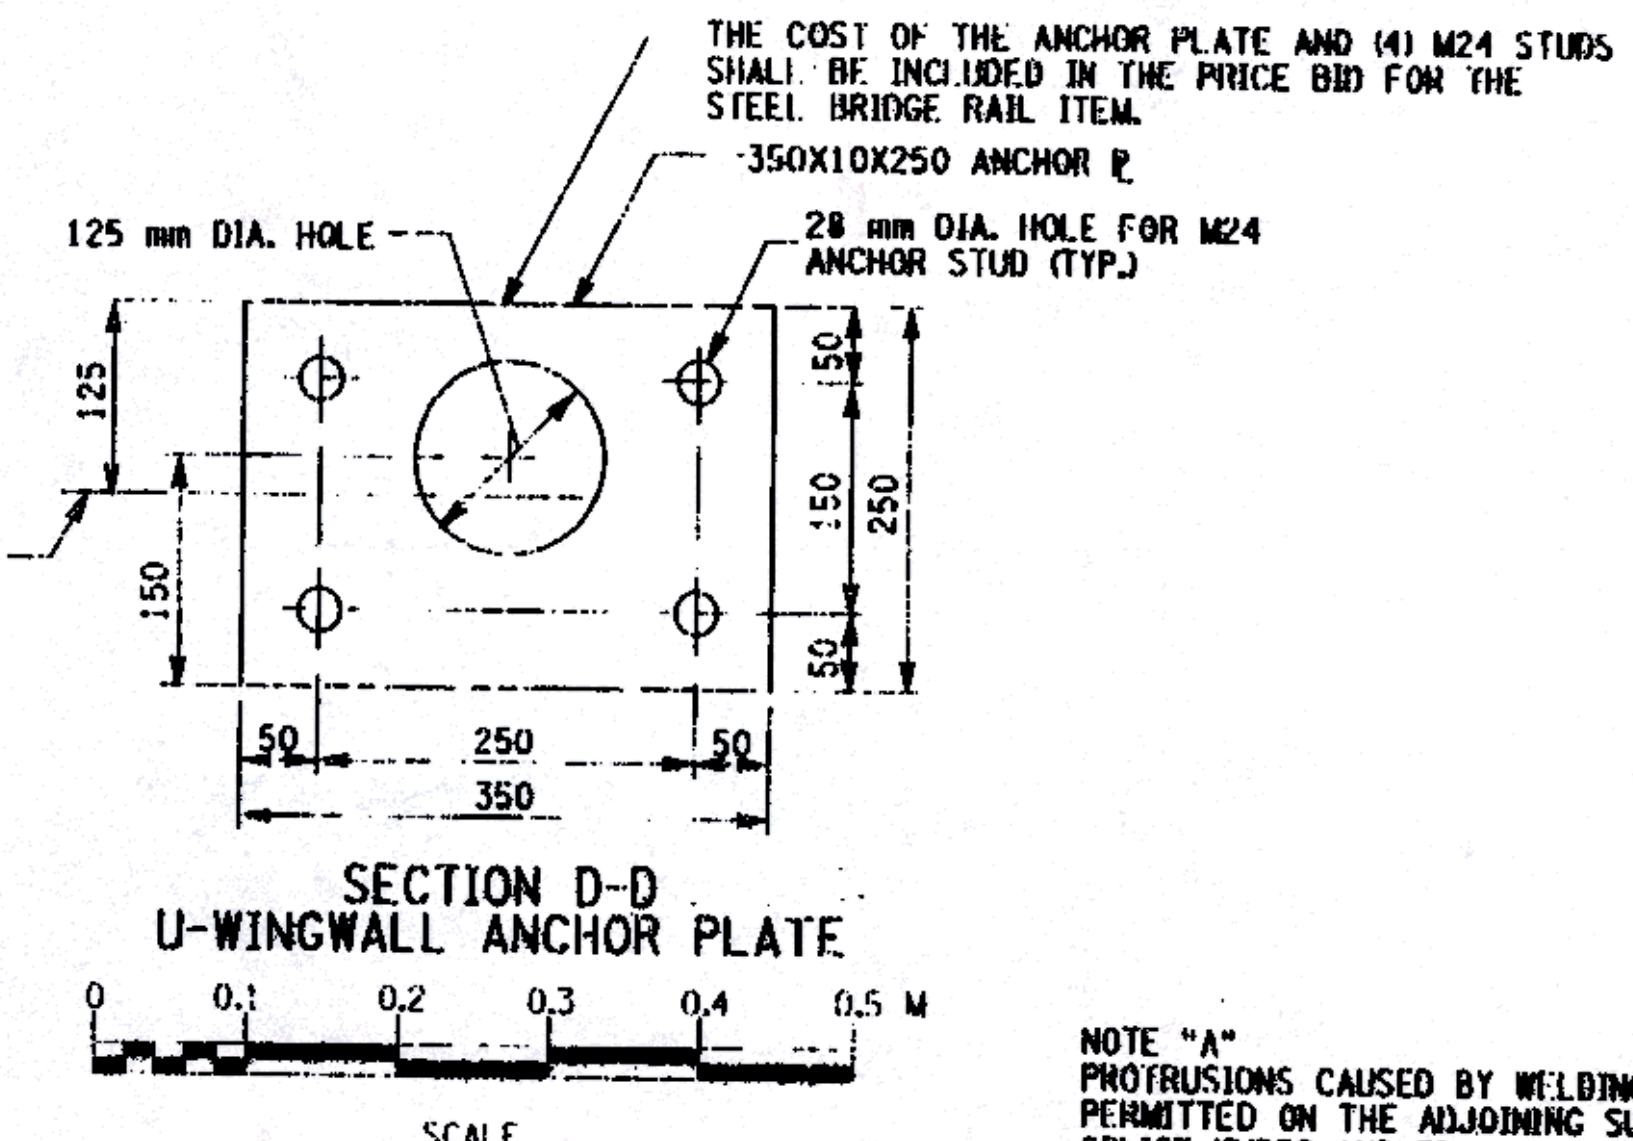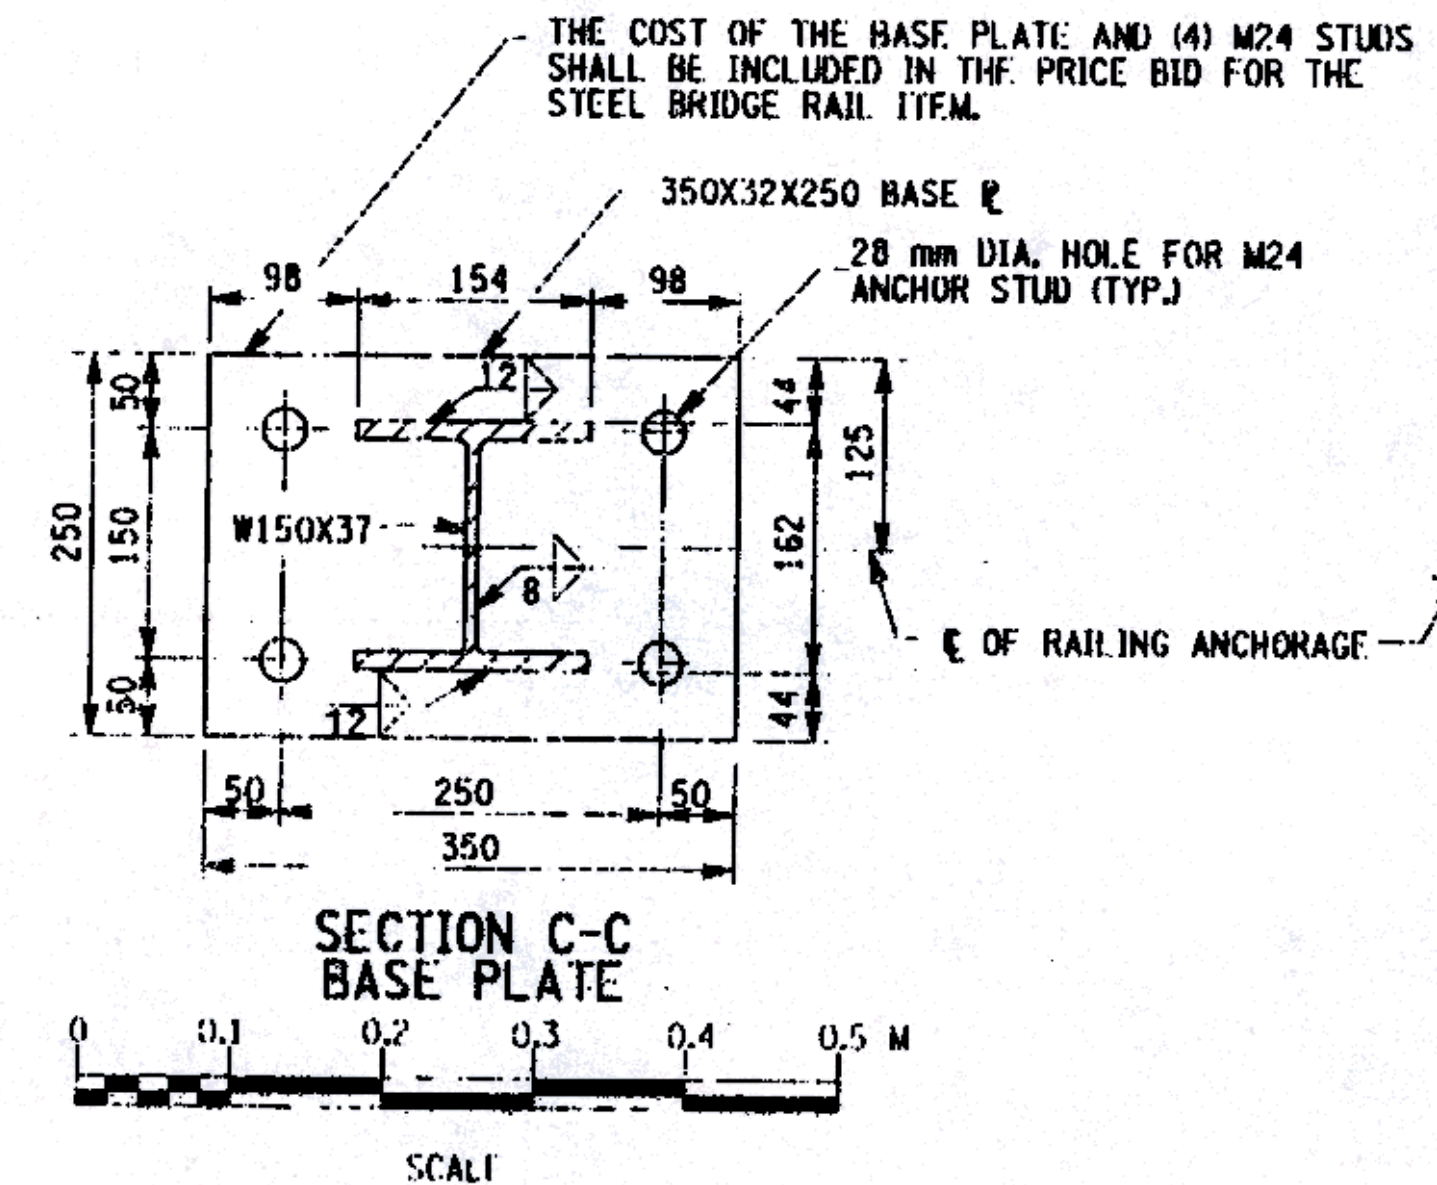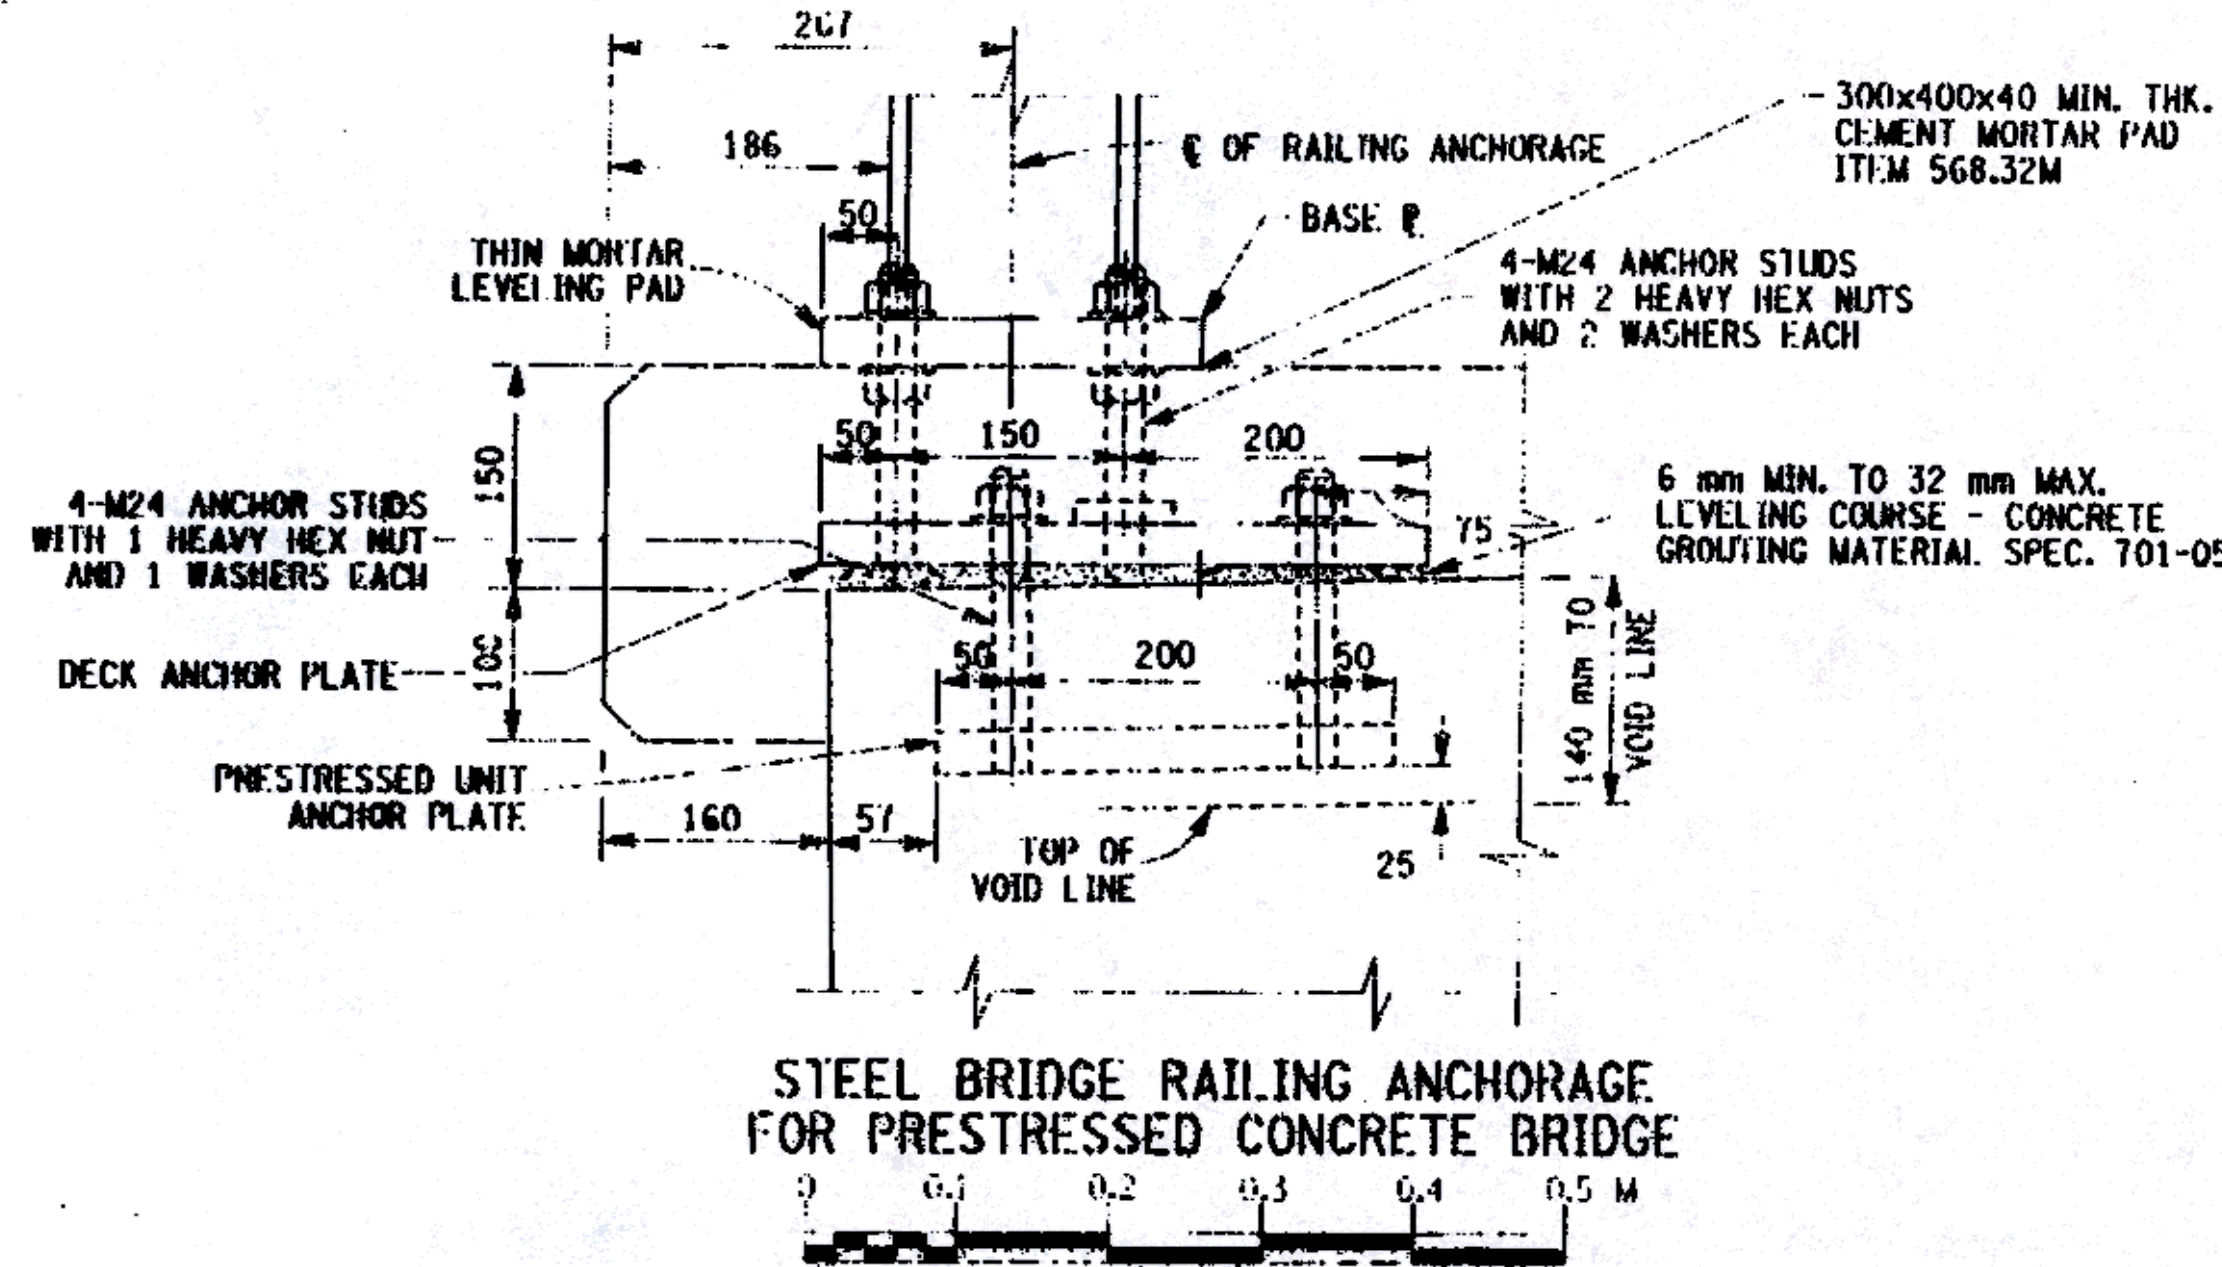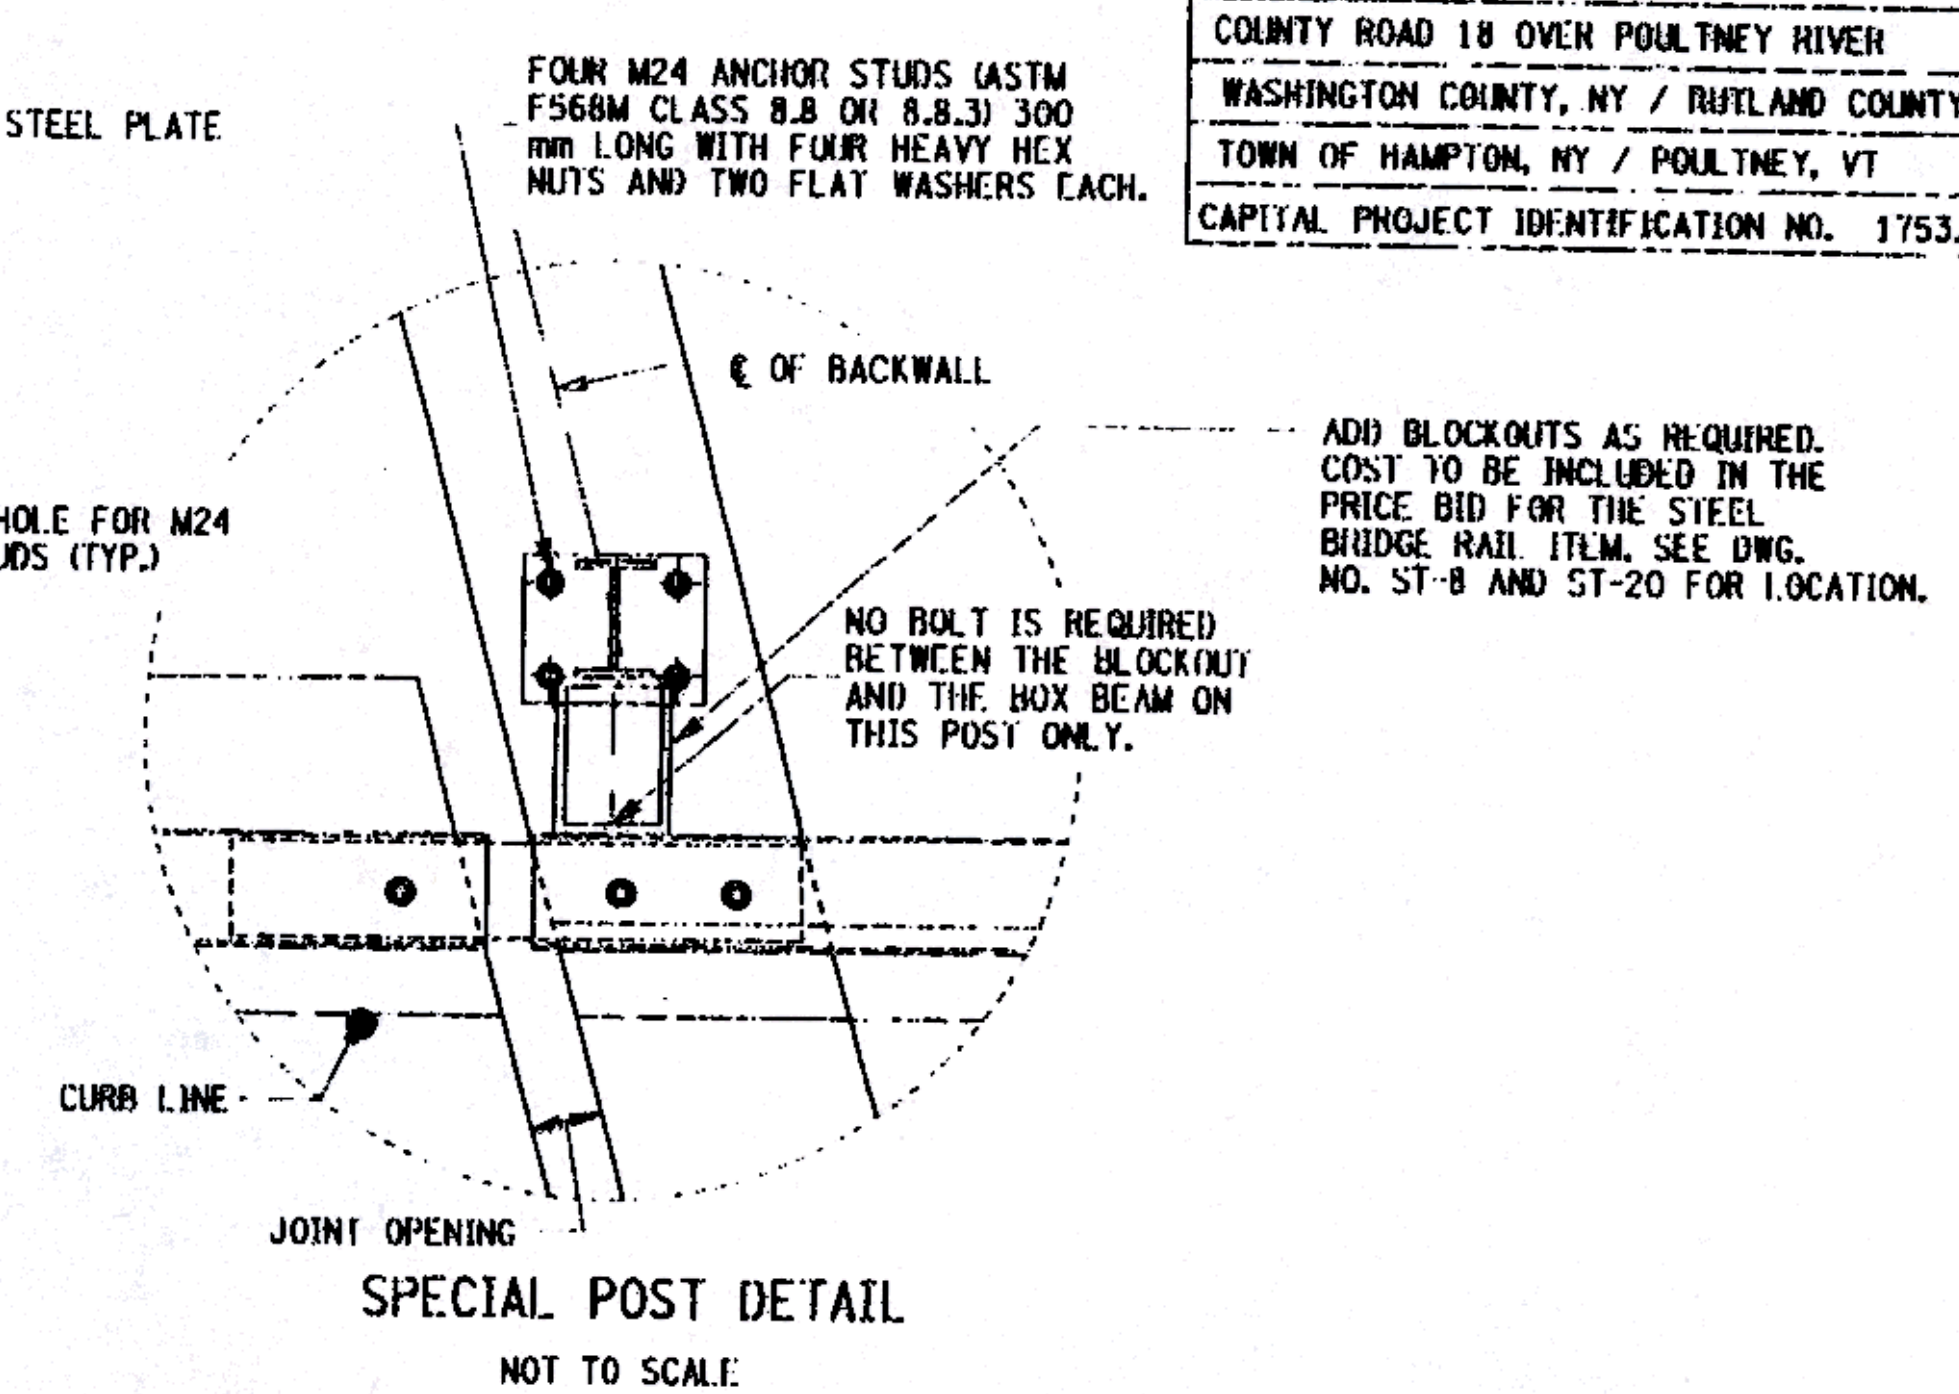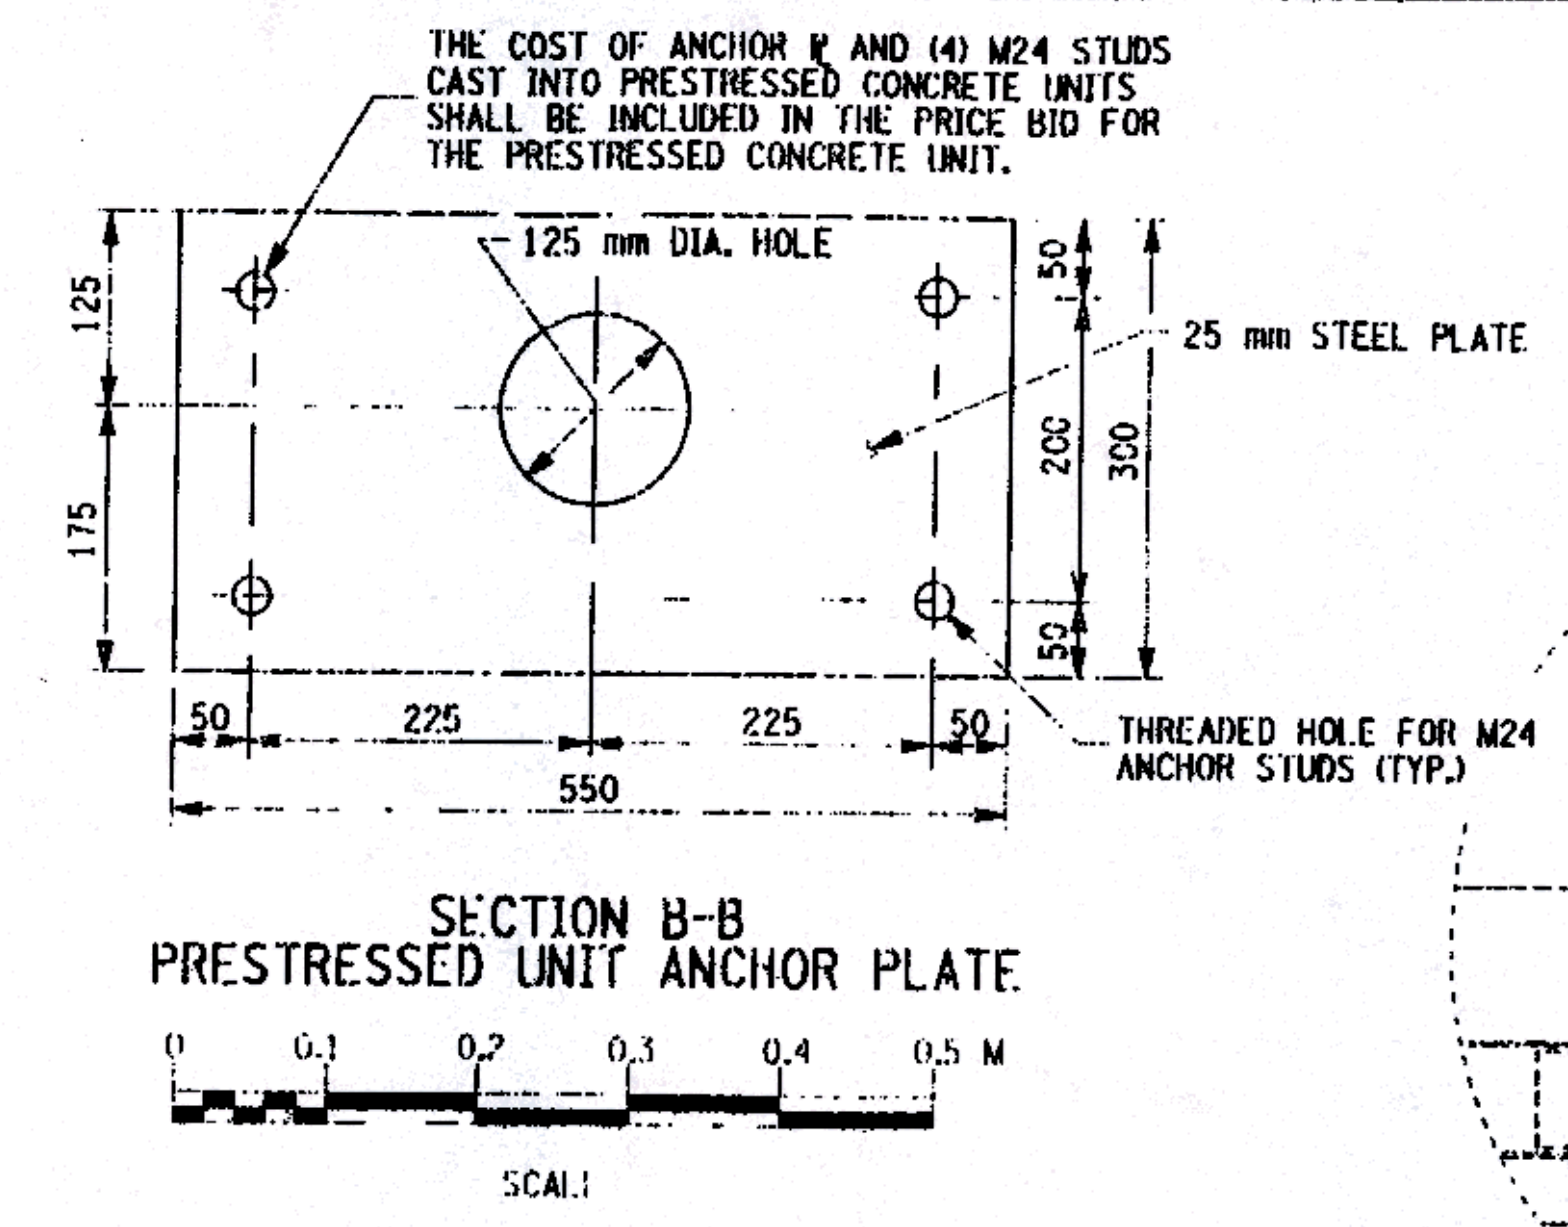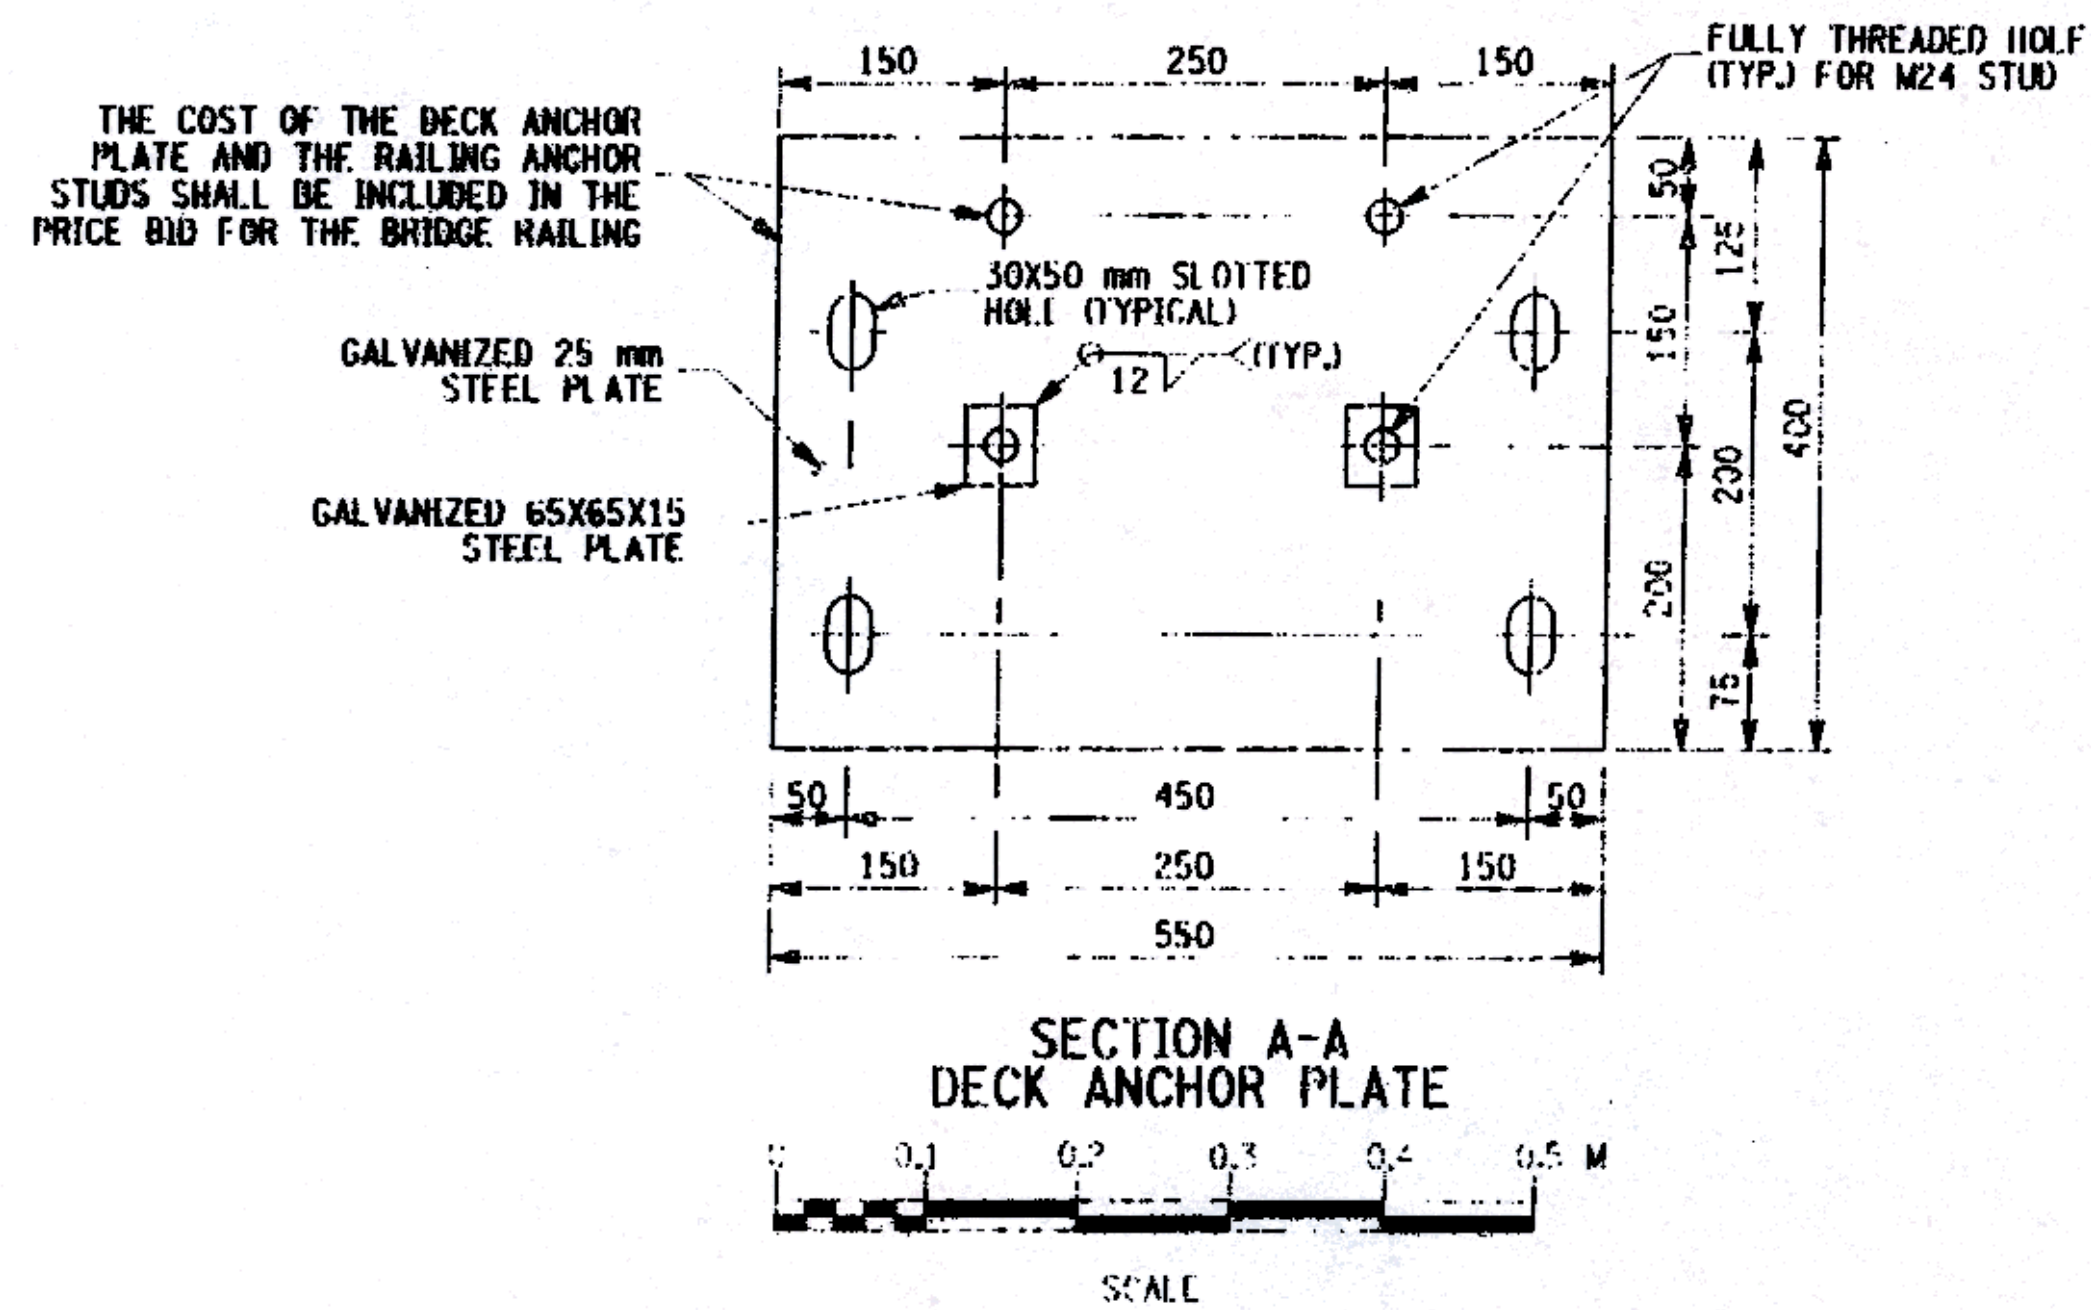

FED. ROAD R.F.C. NO.	STATE	CONTRACT NO.	SHEET NO.	TOTAL SHEETS
1	N.Y.		39	43

COUNTY ROAD 18 OVER POULTNEY RIVER
WASHINGTON COUNTY, NY / RUTLAND COUNTY, VT
TOWN OF HAMPTON, NY / POULTNEY, VT
CAPITAL PROJECT IDENTIFICATION NO. 1753.76

AS BUILT: NO REVISIONS 9/2003

ALL DIMENSIONS ARE IN mm UNLESS OTHERWISE NOTED

AS BUILT REVISIONS

SIGNATURE: *James E. Thomas* DATE: 9/2003

COUNTY ROAD 18 OVER POULTNEY RIVER

BRIDGE RAIL (SHEET 3 OF 4)

WASHINGTON COUNTY DEPARTMENT OF PUBLIC WORKS

FILENAME: 175376.dwg REGION: DATE: DRAWING NO.

FILE NAME = I:\work\142007\CAD\ASB\142007\175376a.dwg
DATE/TIME = 11/04/2003 10:13:00 AM
USER = RUN

DRAWN BY EKT

DRAWN BY RUN















ESTIMATED BY EKT

CHECKED BY LAK

DESIGNED BY EKT

JOB MANAGER ITC

DESIGN SUPERVISOR TJC

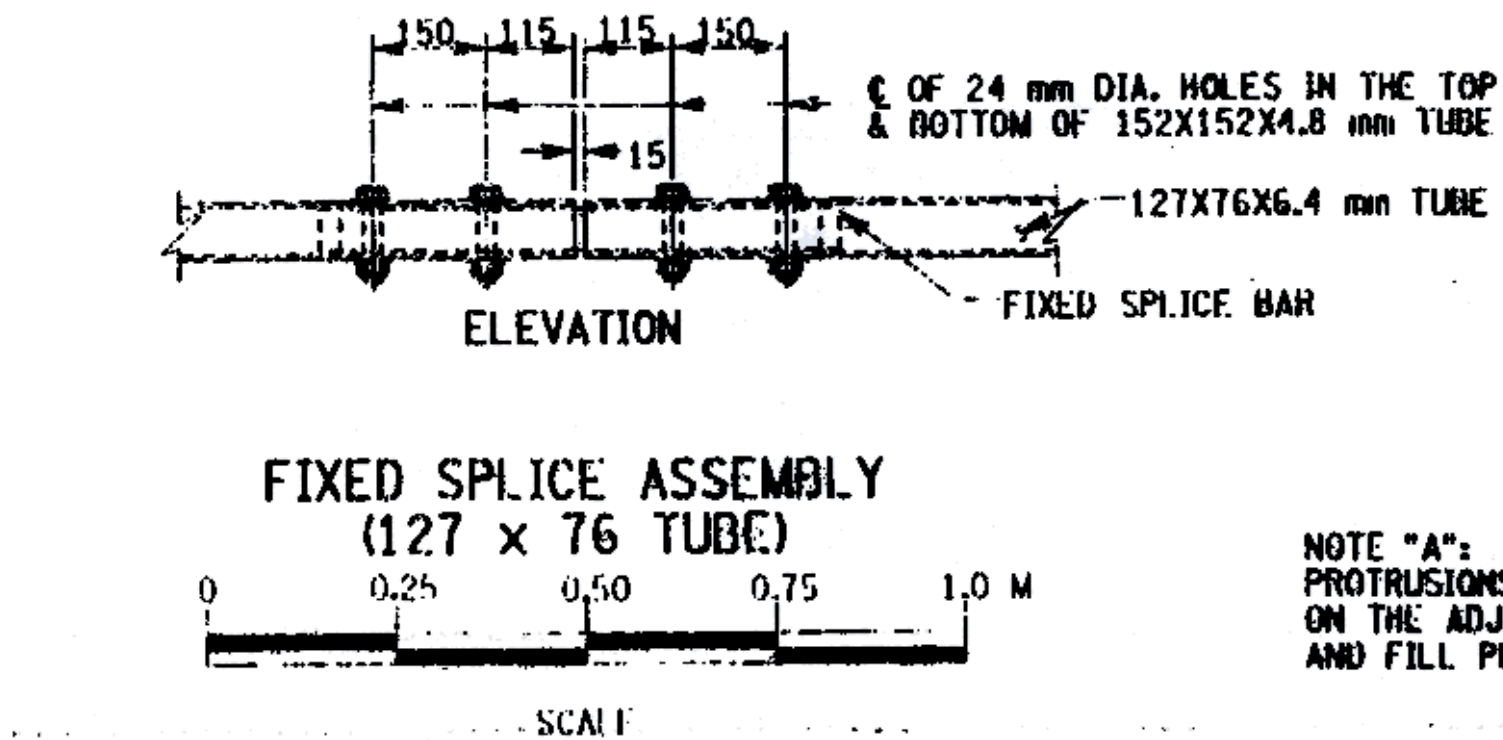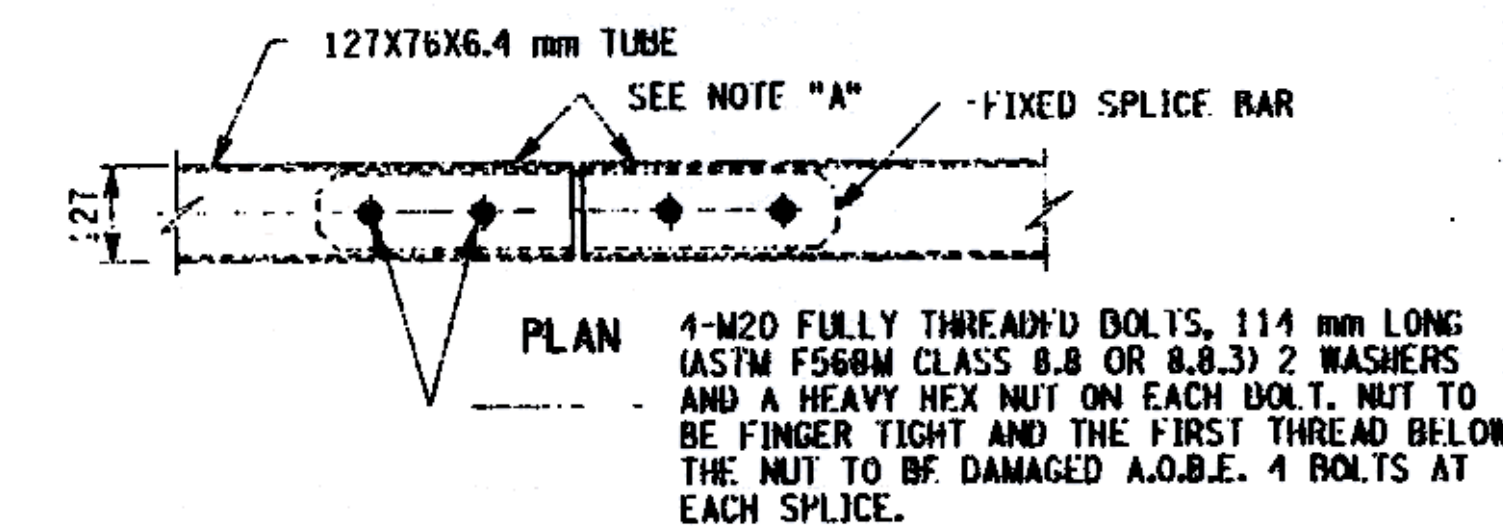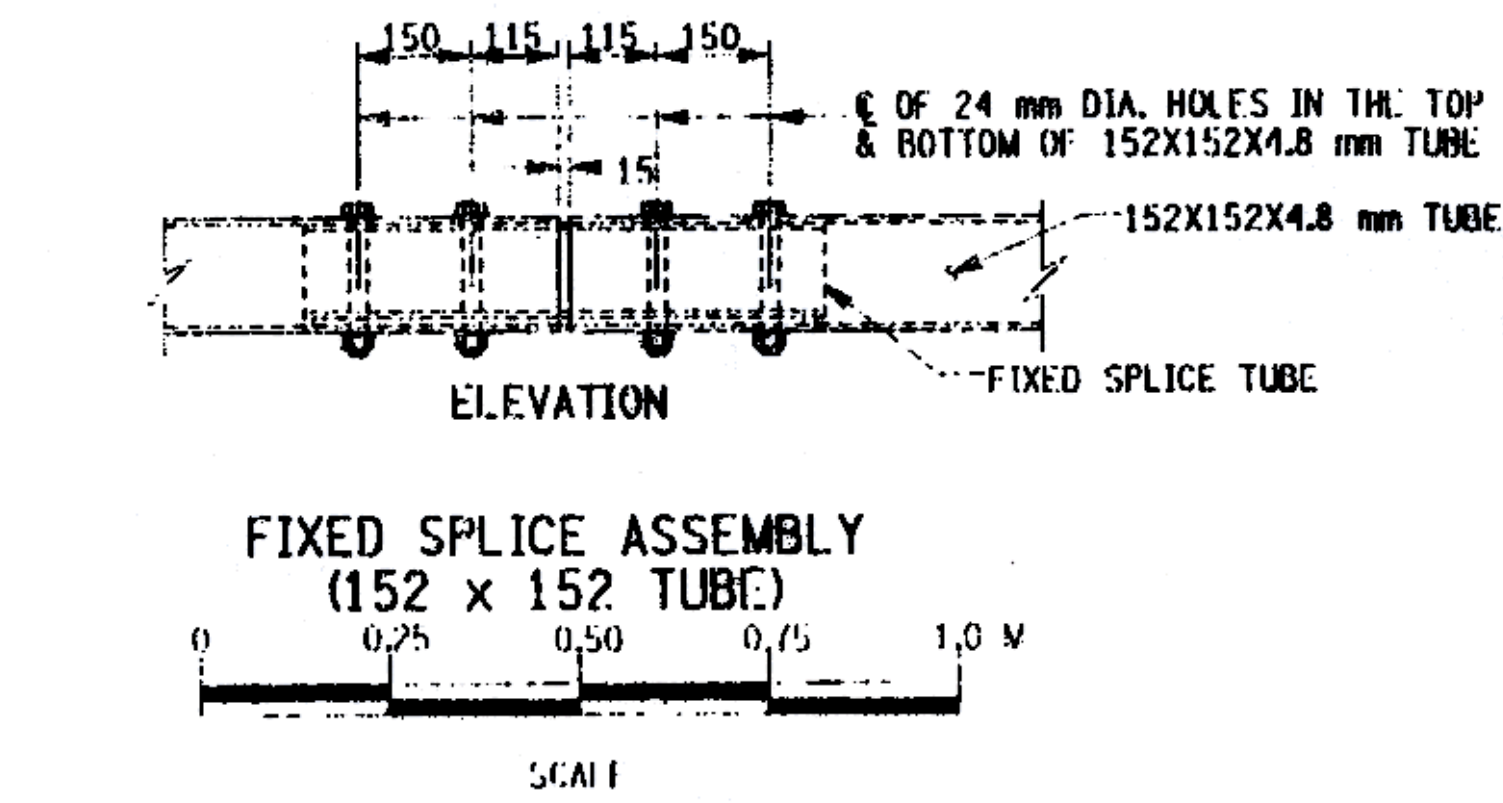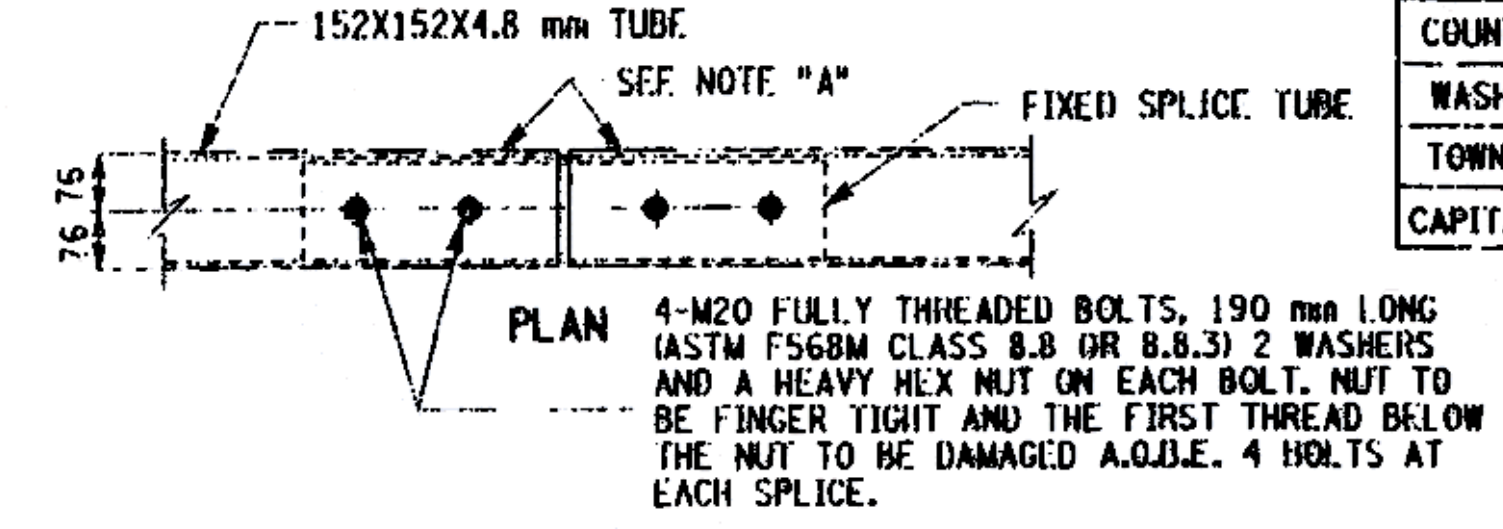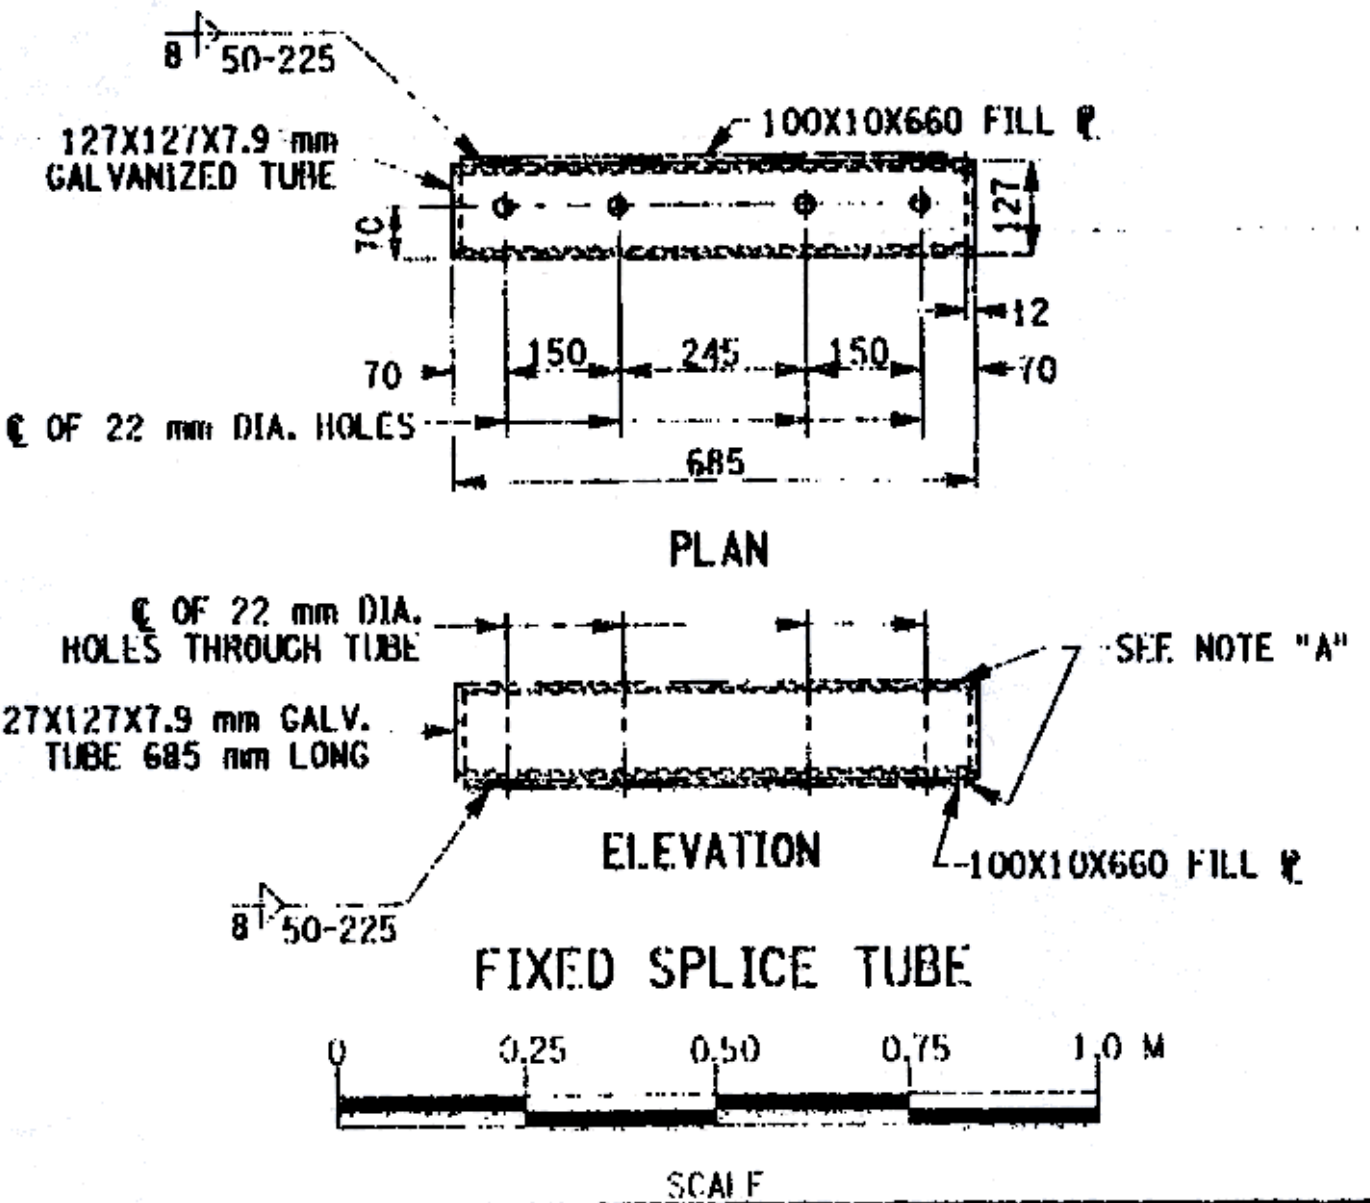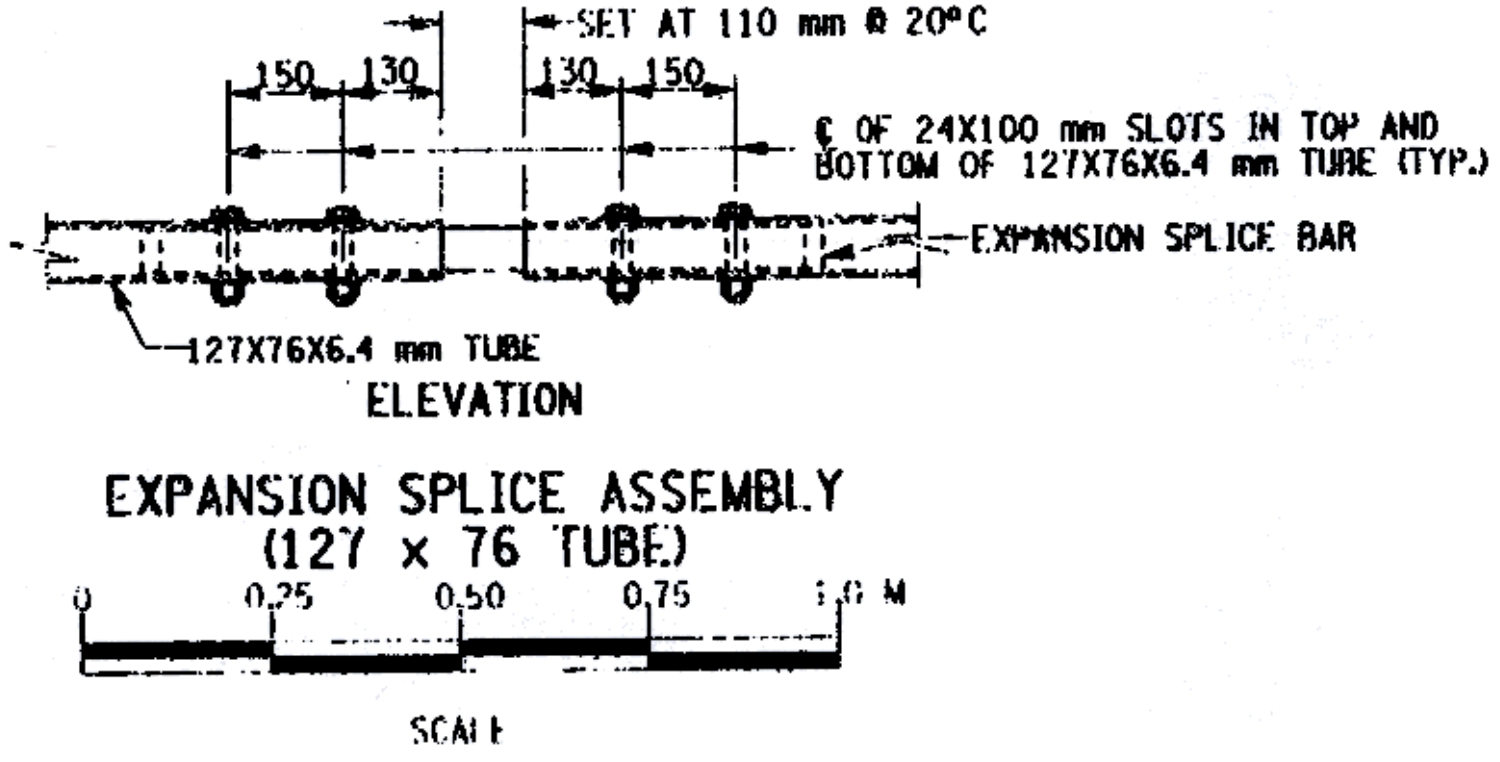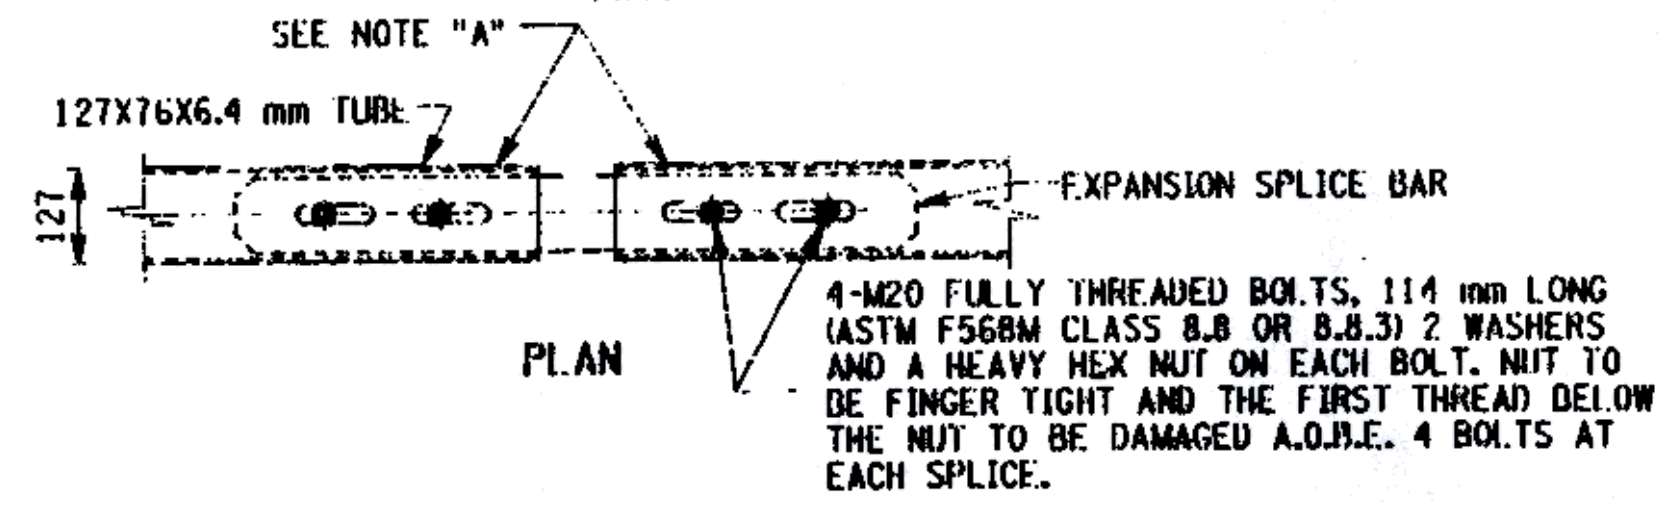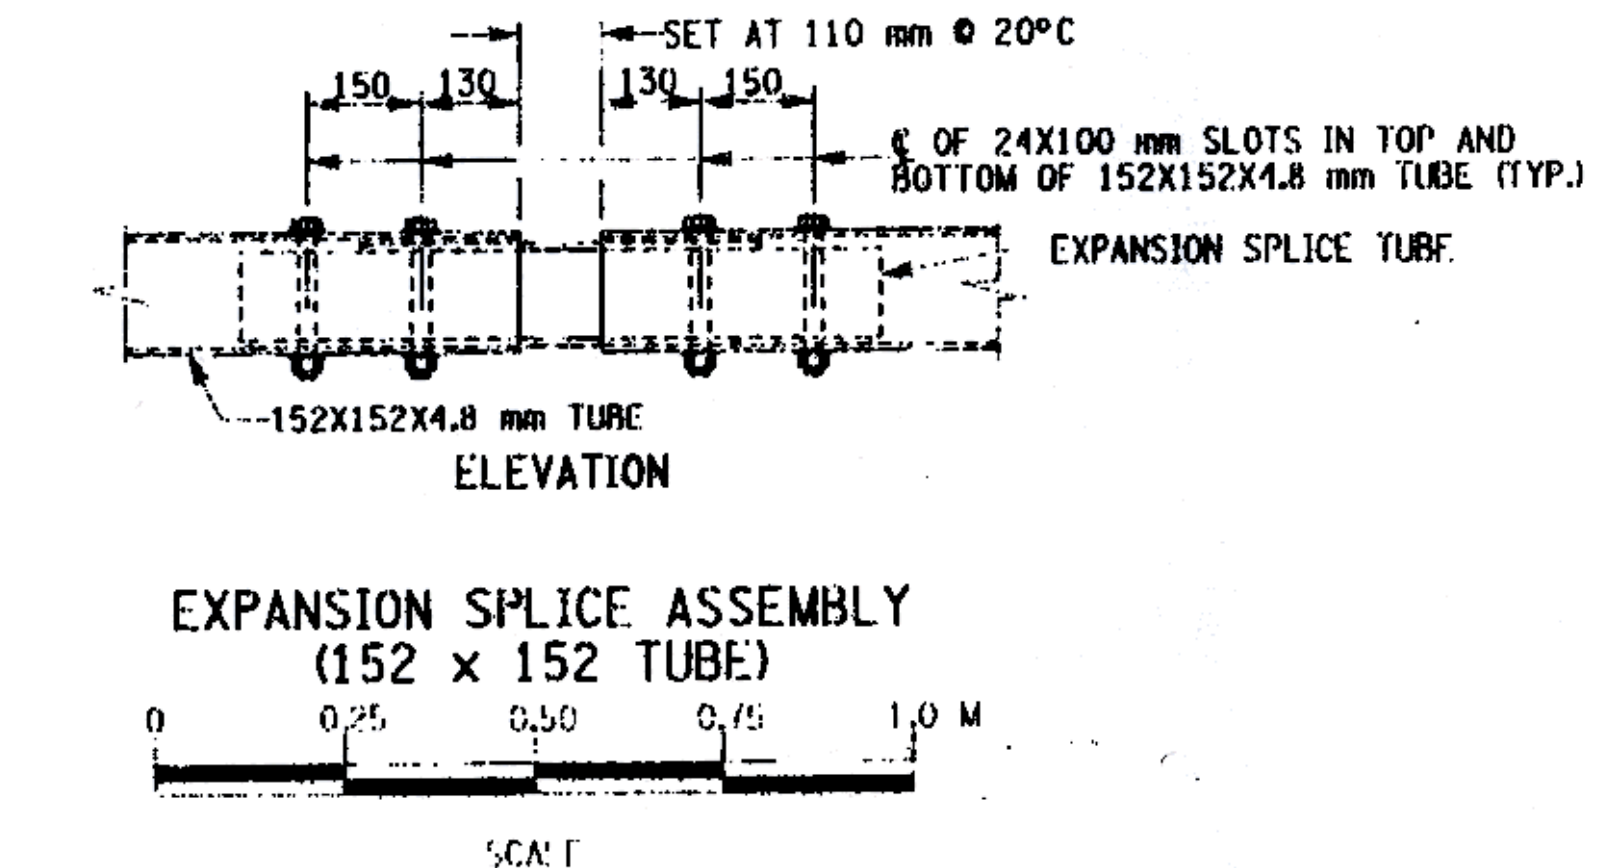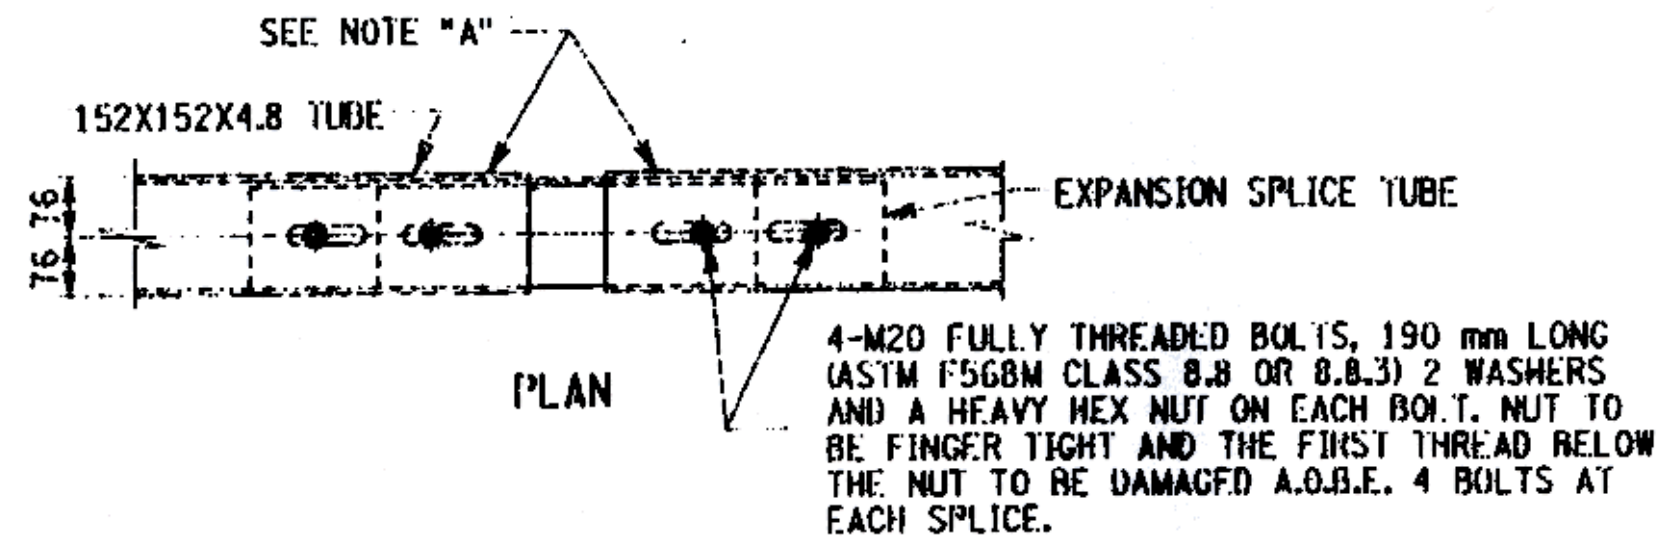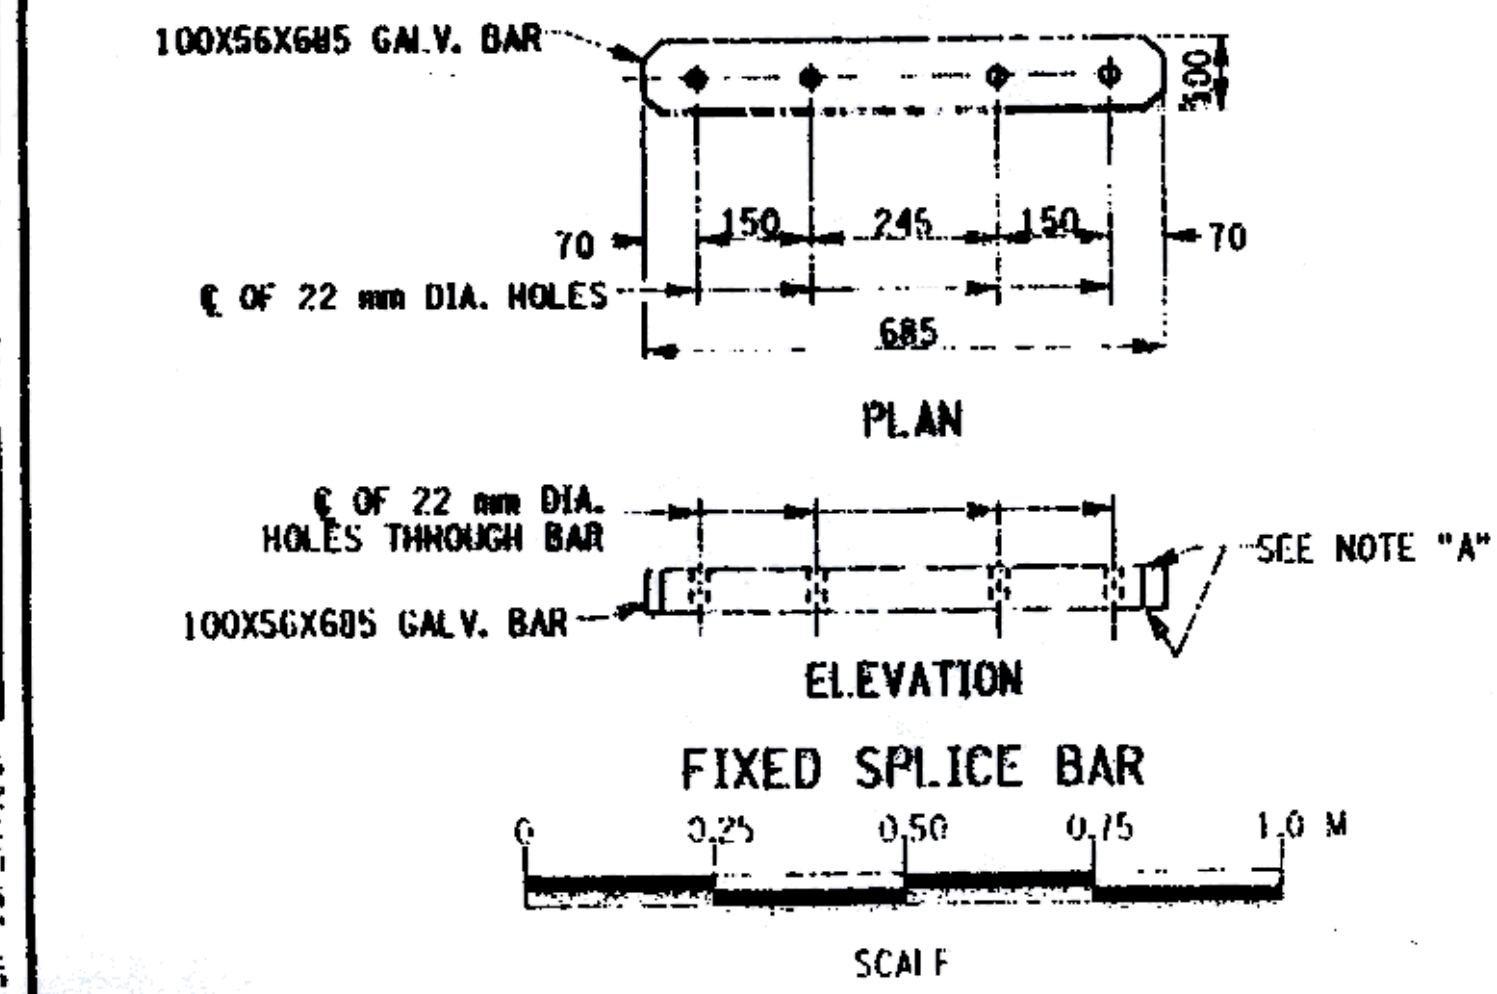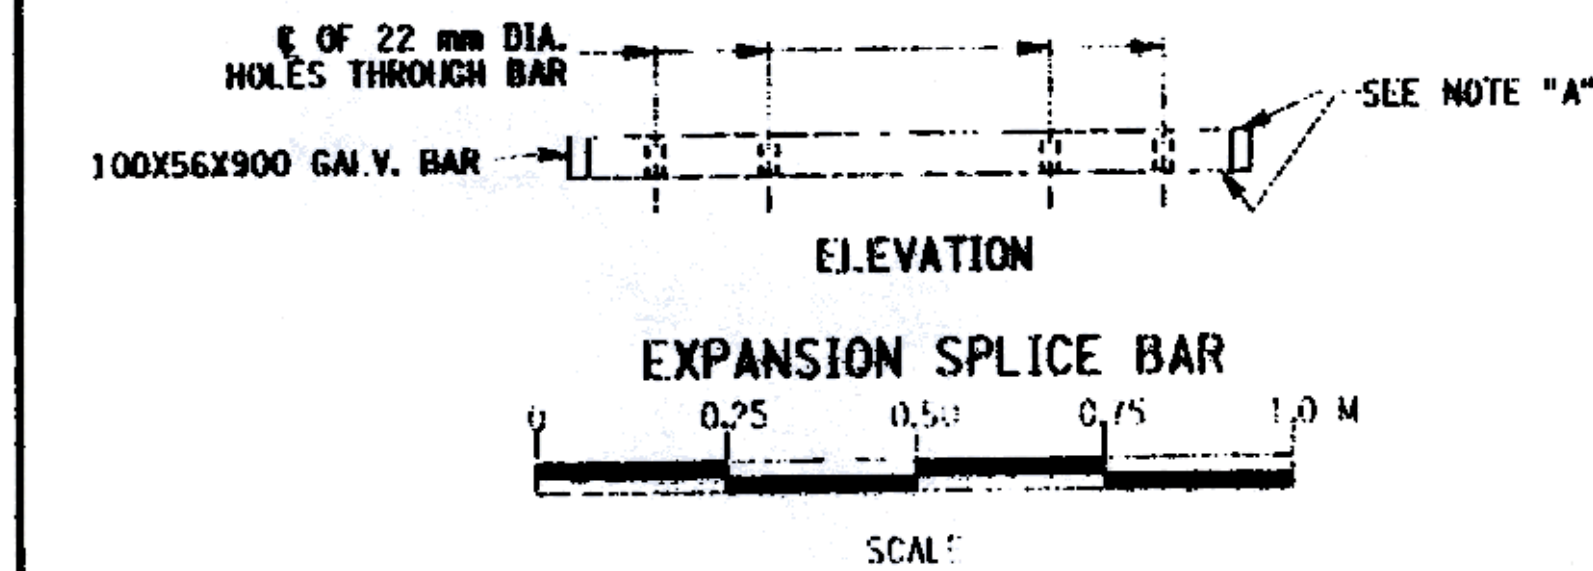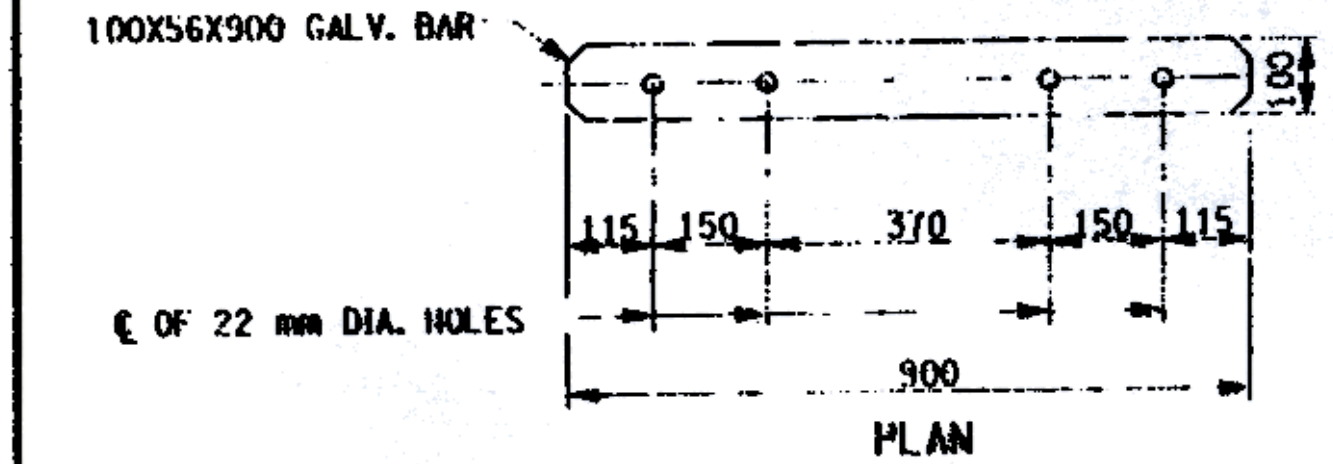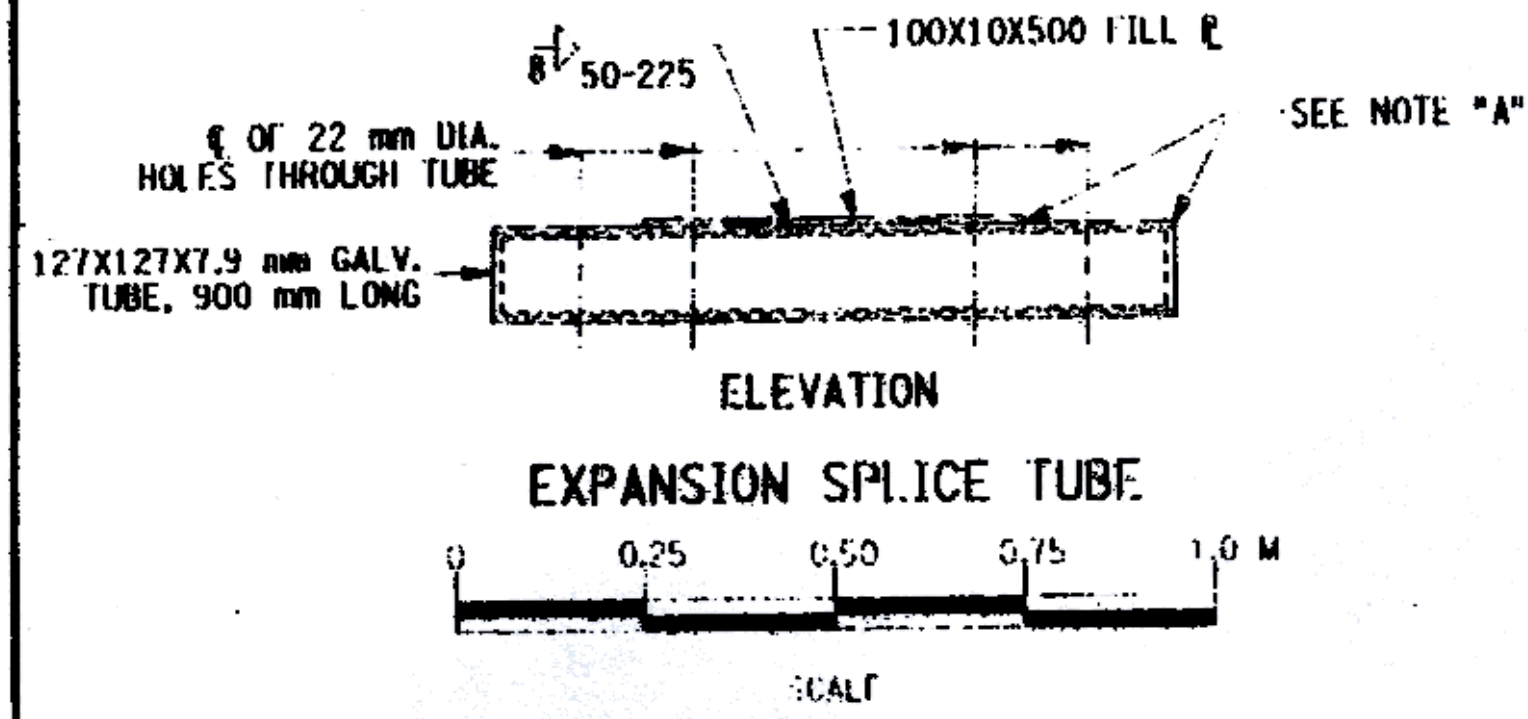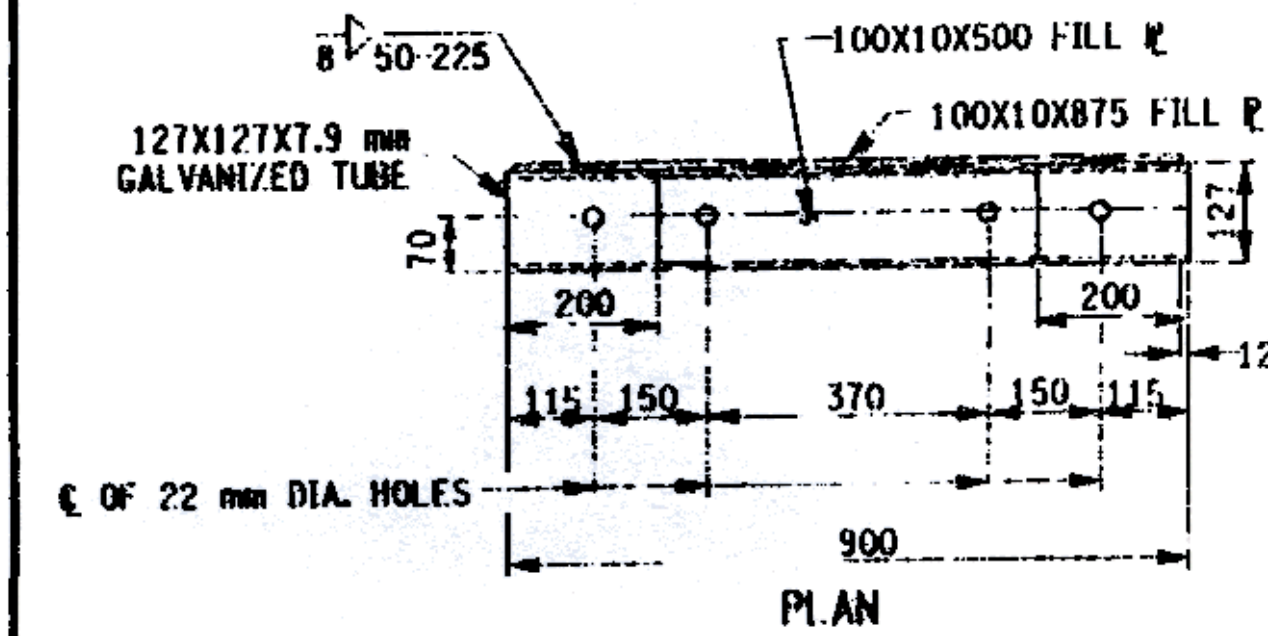

NOTE "A": PROTRUSIONS CAUSED BY WELDING OR GALVANIZING ARE NOT PERMITTED ON THE ADJOINING SURFACES OF THE BOX BEAM RAILS, SPLICE TUBES AND FILL PLATES.

ALL DIMENSIONS ARE IN mm UNLESS OTHERWISE NOTED

AS BUILT REVISIONS

SIGNATURE: *Russell E. Brown* DATE: 9/2003

COUNTY ROAD 18 OVER POULTNEY RIVER

BRIDGE RAIL (SHEET 4 OF 4)

WASHINGTON COUNTY DEPARTMENT OF PUBLIC WORKS

AS BUILT: NO REVISIONS 9/2003

FILE NAME	REGION	DATE	DRAWING NO.
175376AAR10	ONE	3/2002	ST-24