




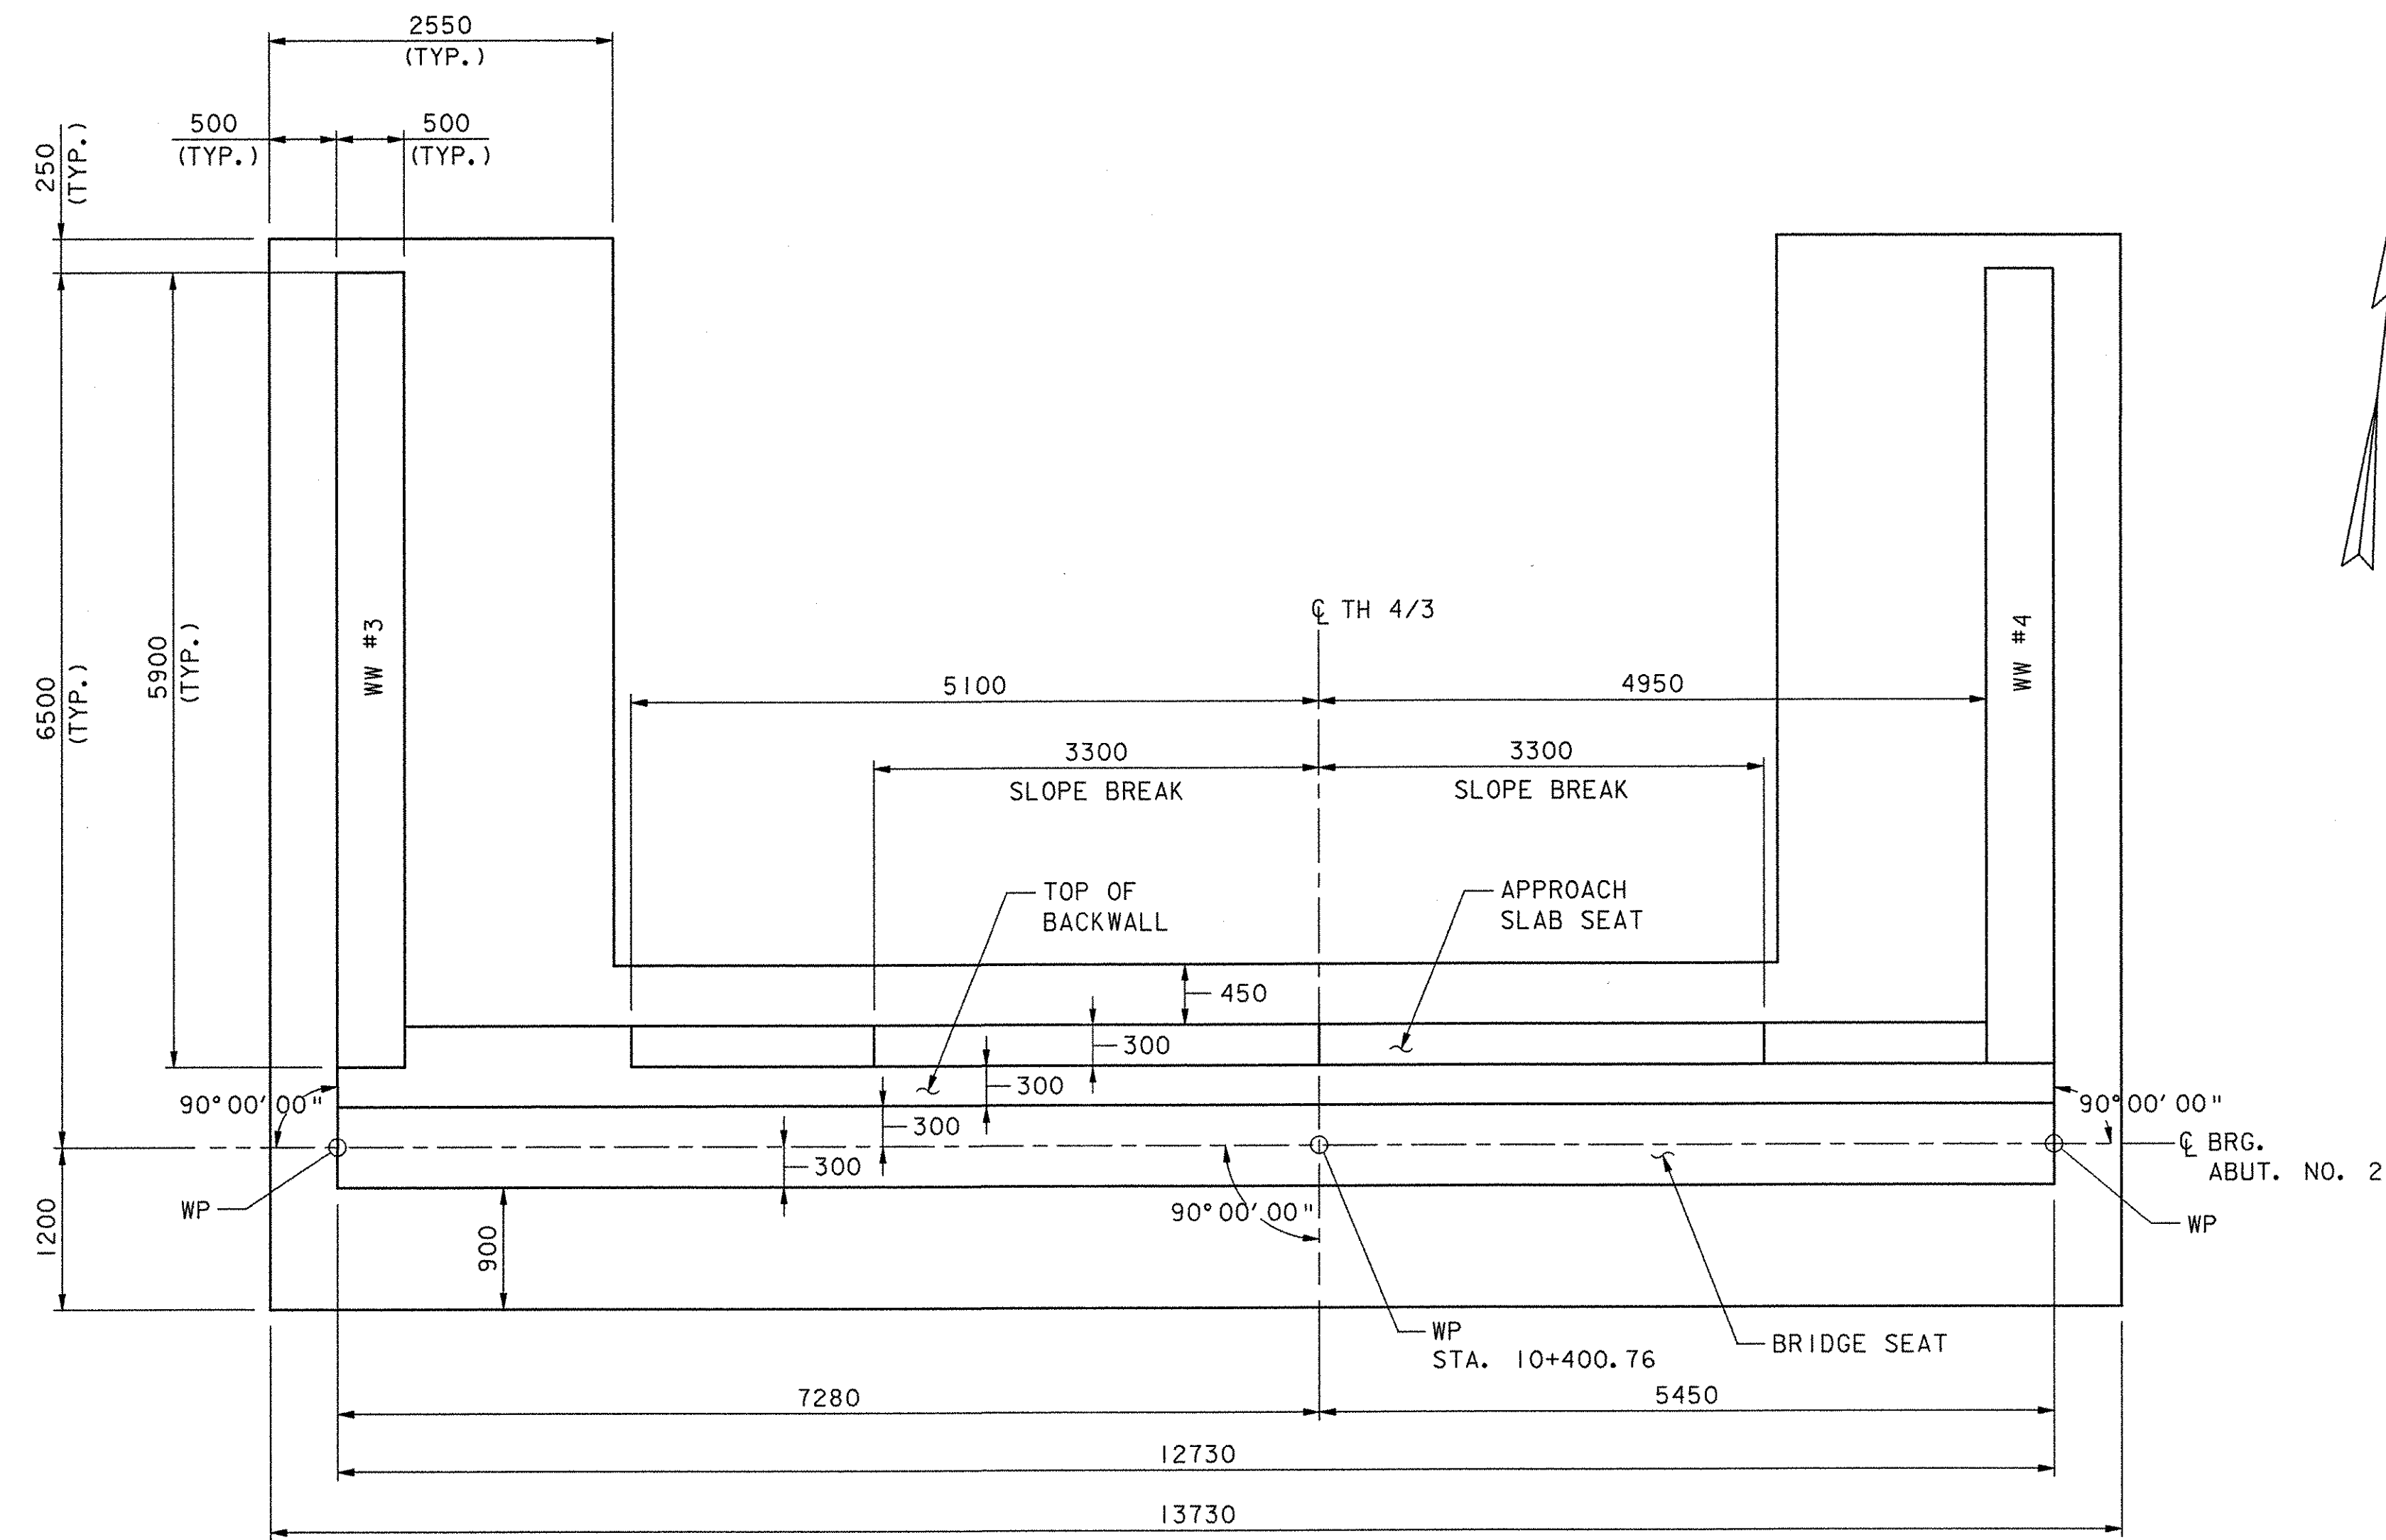



PLAN
SCALE: 1:40

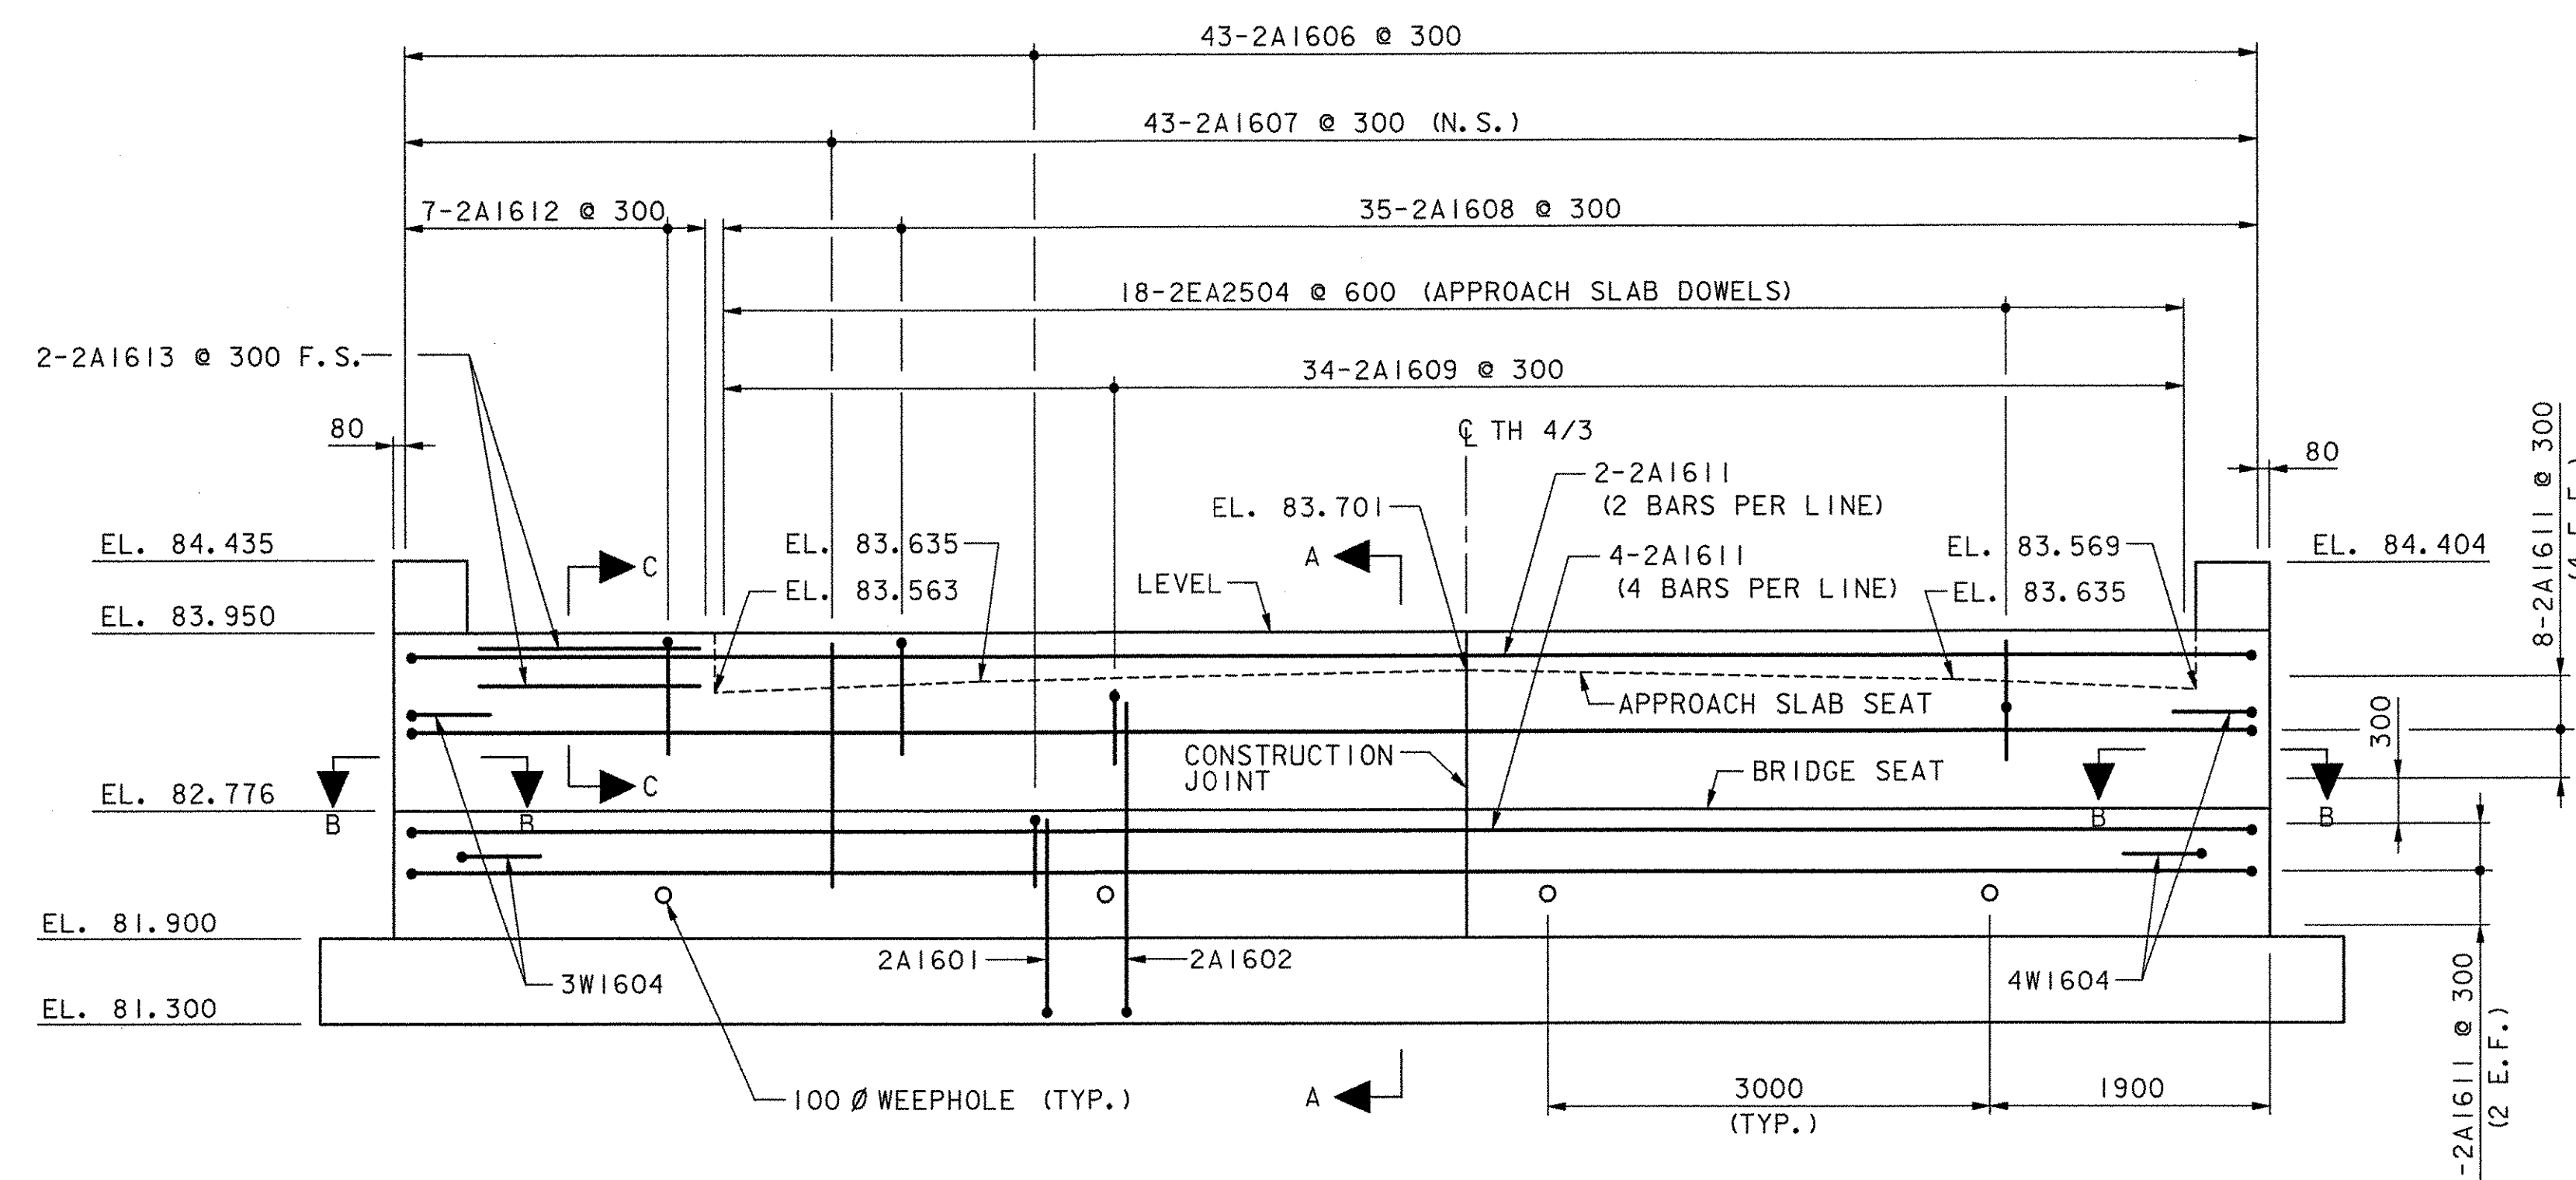


ELEVATION
SCALE: 1:40

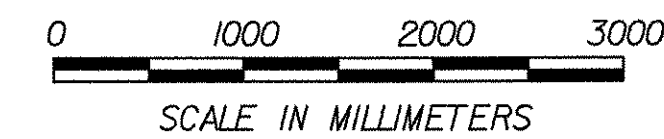


DATUM
VERTICAL NAVD 88
HORIZONTAL NAD 83 (92)

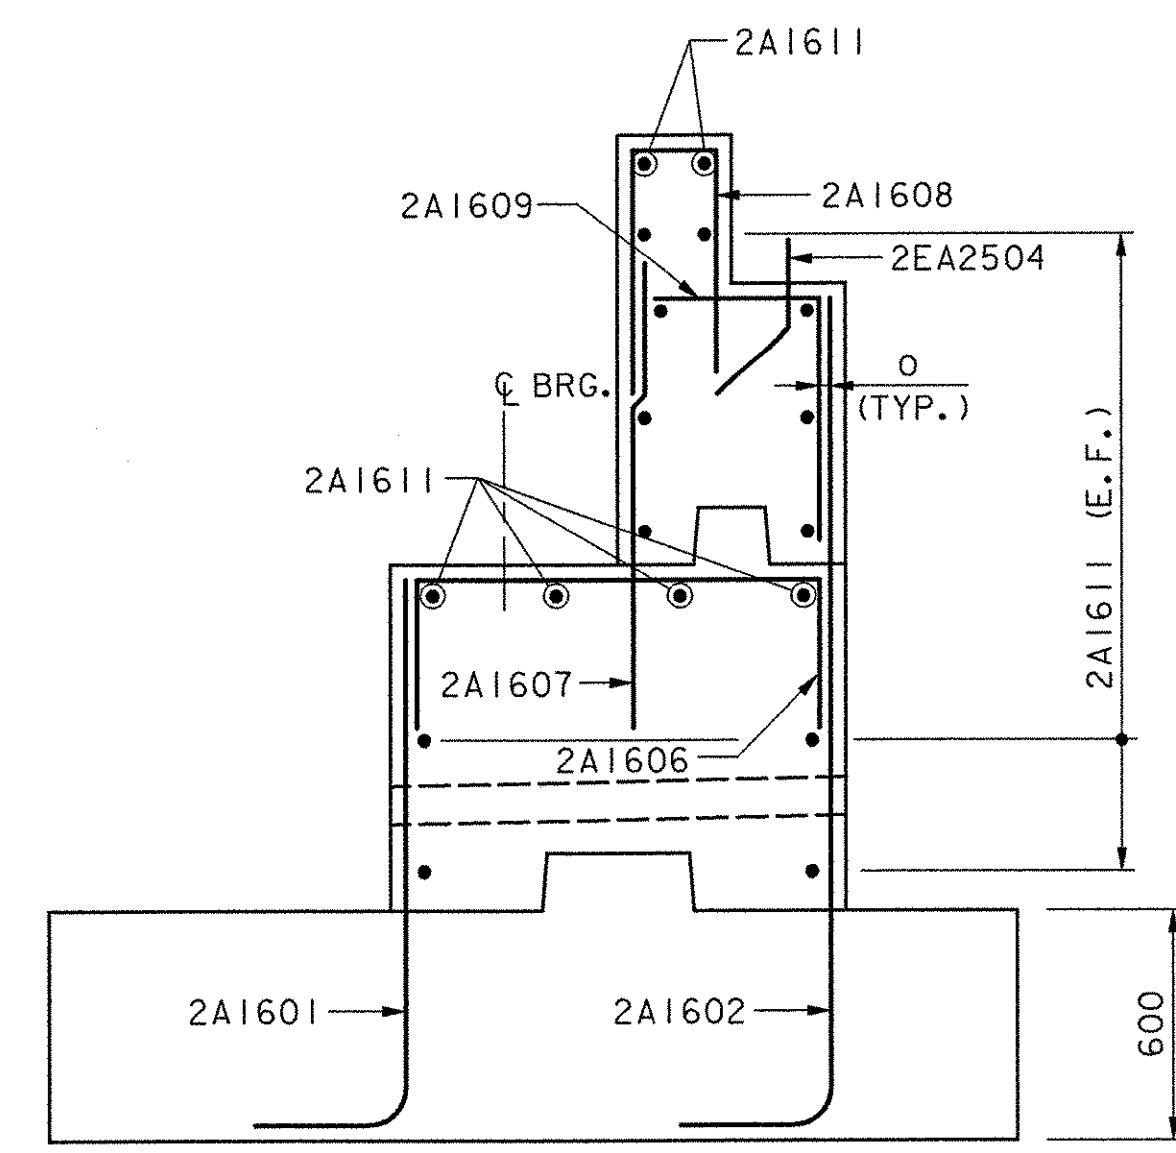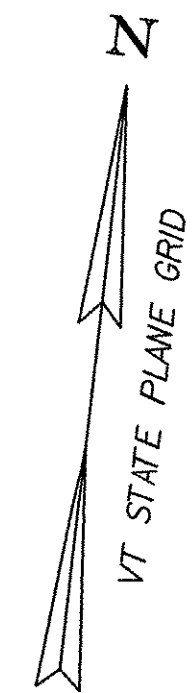

SECTION A-A
SCALE: 1:20

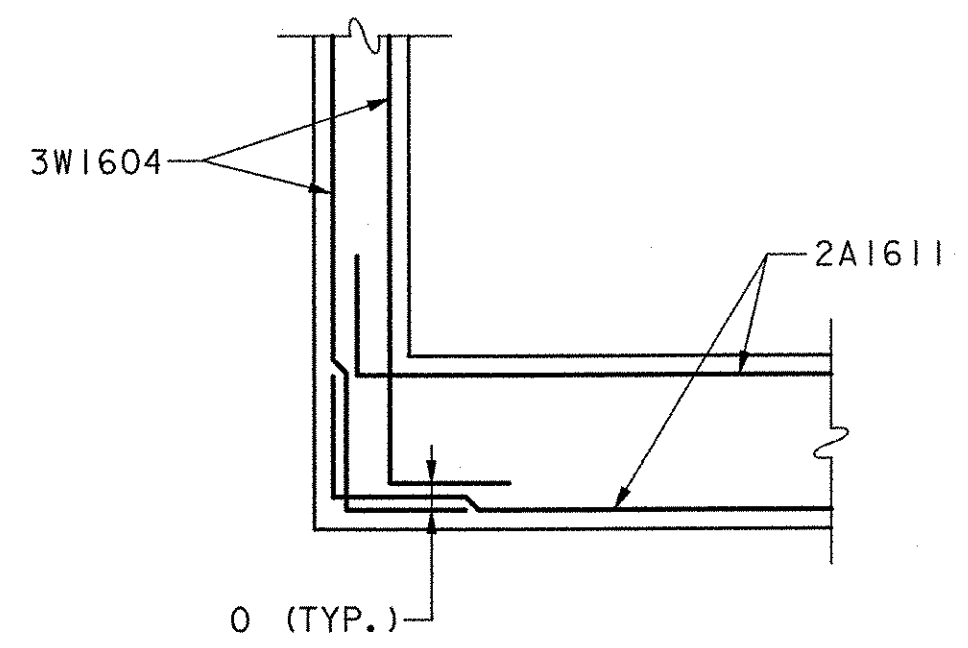

SECTION B-B
(WW #3 SHOWN, WW #4 SIMILAR)
(VERTICAL REINFORCING NOT SHOWN FOR CLARITY)
SCALE: 1:20

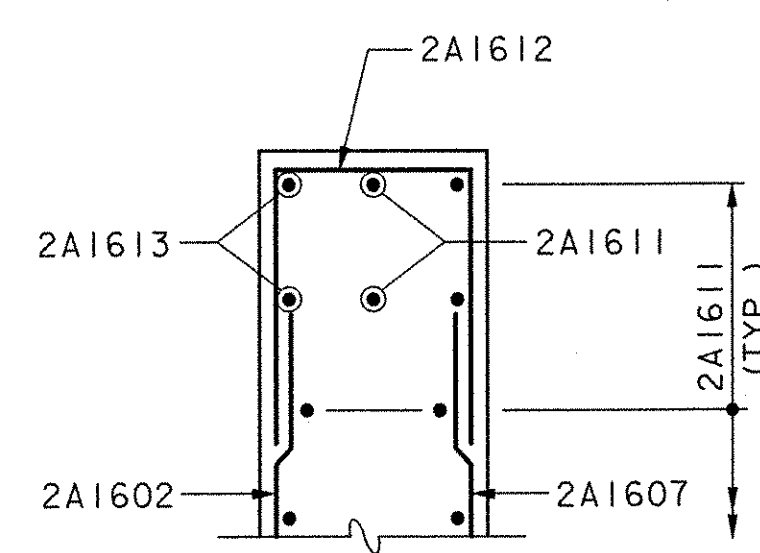

SECTION C-C
SCALE: 1:20



NOTES:

1. ALL FOOTING REINFORCING NOT SHOWN FOR CLARITY.
2. SEE SHEET 66 FOR WEEPHOLE DETAIL.

REINFORCING KEY

E.F. = EACH FACE
N.S. = NEAR SIDE
F.S. = FAR SIDE

**STATE OF VERMONT
AGENCY OF TRANSPORTATION**

Town Of COLCHESTER-SOUTH BURLINGTON	Bridge No. 6
Highway No. TH 4/3	Log Sta. Surv. Sta.
TH 4/3 OVER WINOOSKI RIVER & N.E.C.R.	
ABUTMENT NO.2	
Designed By J.T. KLEIN	Drawn By K.D. WENTWORTH
Checked By K.G. KRETSCH	Bridge Design Supervisor S.M. GUNN
Date 4/05	Date 4/05
PROJECT COLCHESTER-SOUTH BURLINGTON	PROJECT NO. BRM 5600 (6) S C/2
I.G.C. Info.	
Bridge Sheet No. ZD139A2	Sheet 69 of 124

VHB Vanasse Hangen Brustlin, Inc.