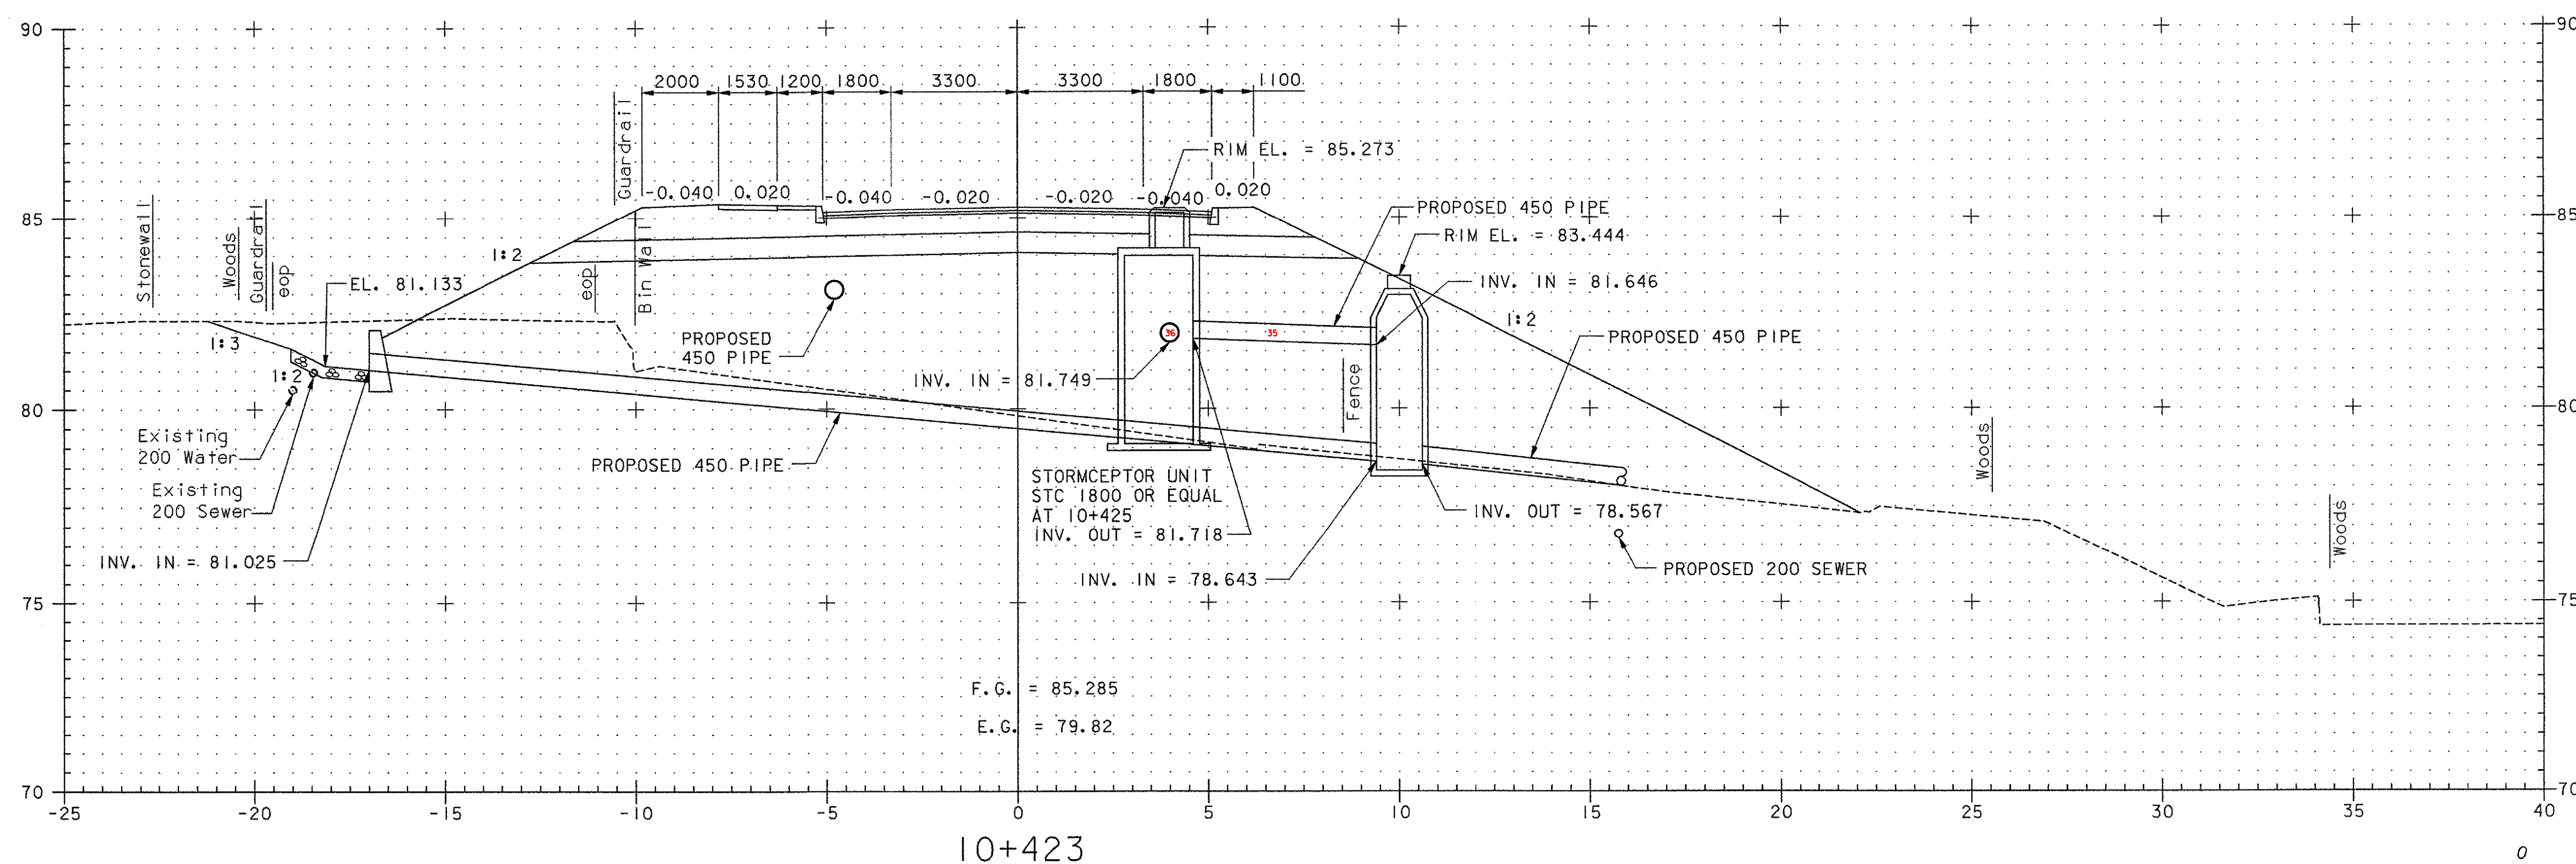
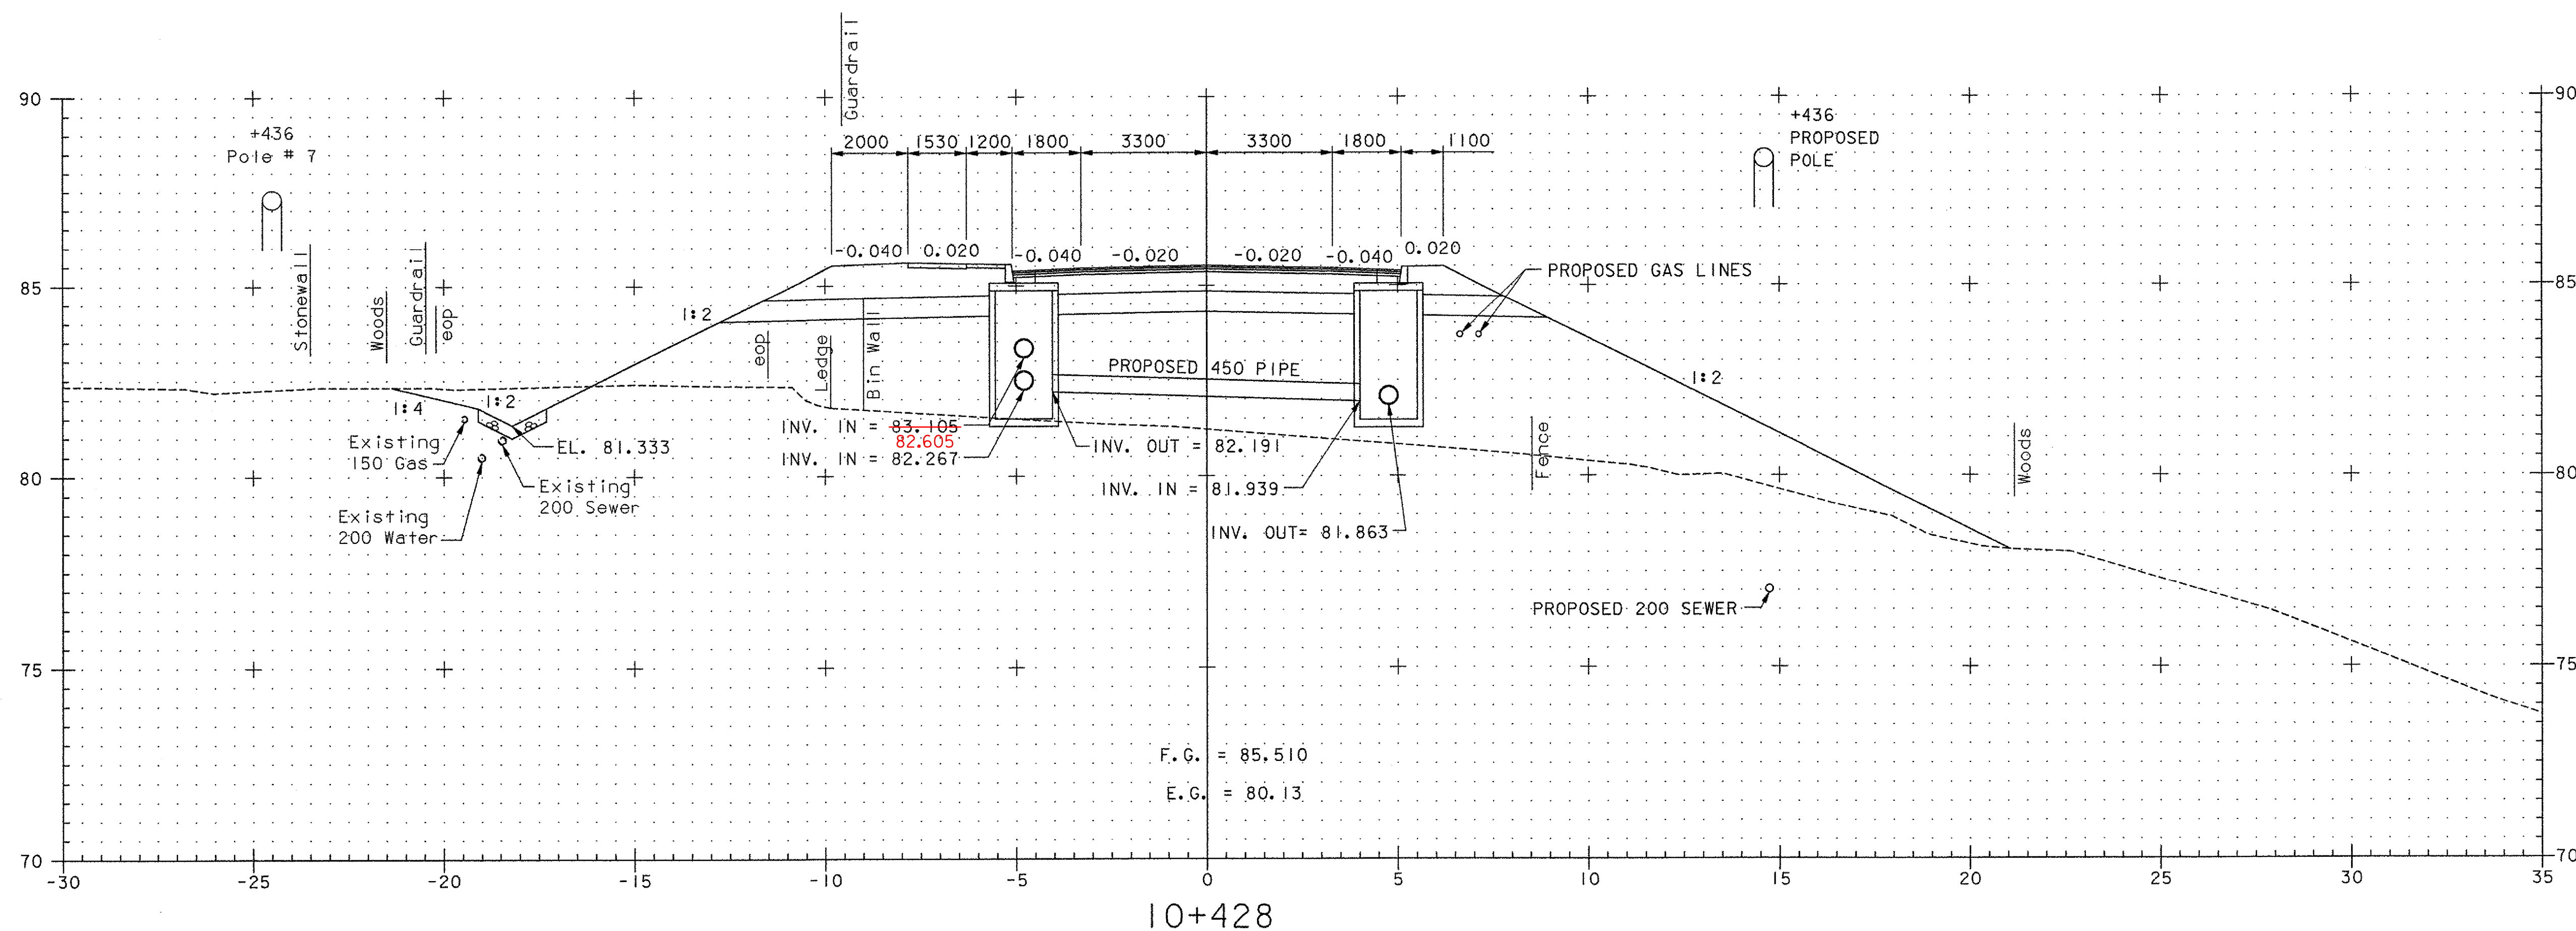


TH 4/3

FROM STA 10+423	TO STA 10+428
PROJECT NAME	COLCHESTER - SOUTH BURLINGTON
PROJECT NO.	BRM 5600(6)S C/2
SURVEYED BY	EIV TECH. SERV. 6/97, 11/02; VTRANS 2/02, 11/02
SHEET 109 OF 124	

VHB Vanasse Hangen Brustlin, Inc.

VHB NO. 50735

plot date: 4/25/2005