
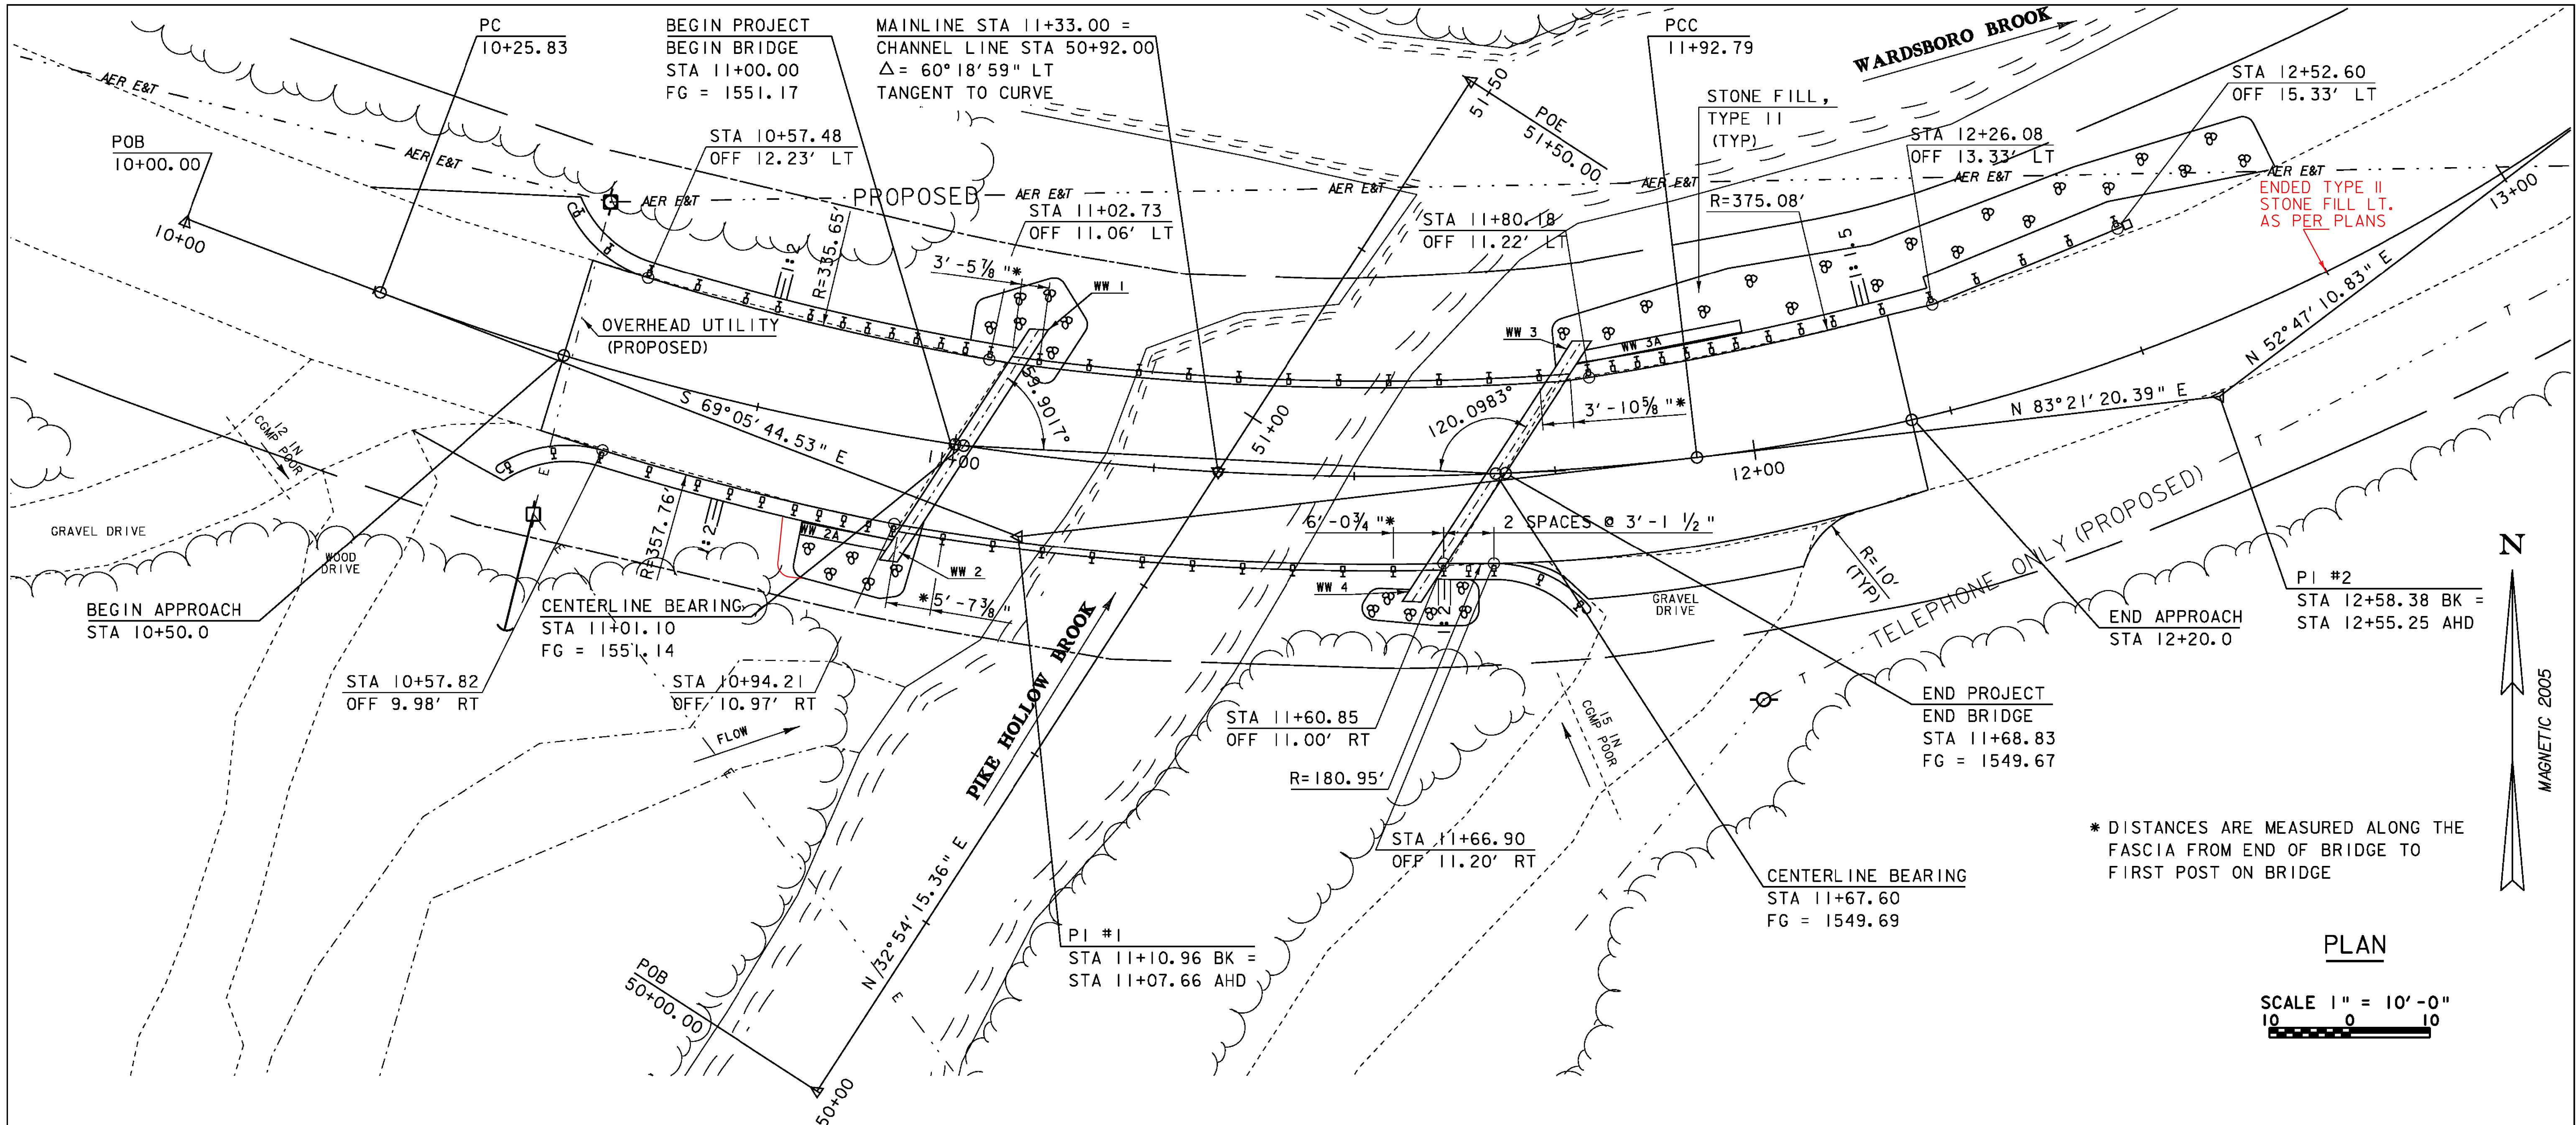


PLAN

SCALE 1" = 10'-0"

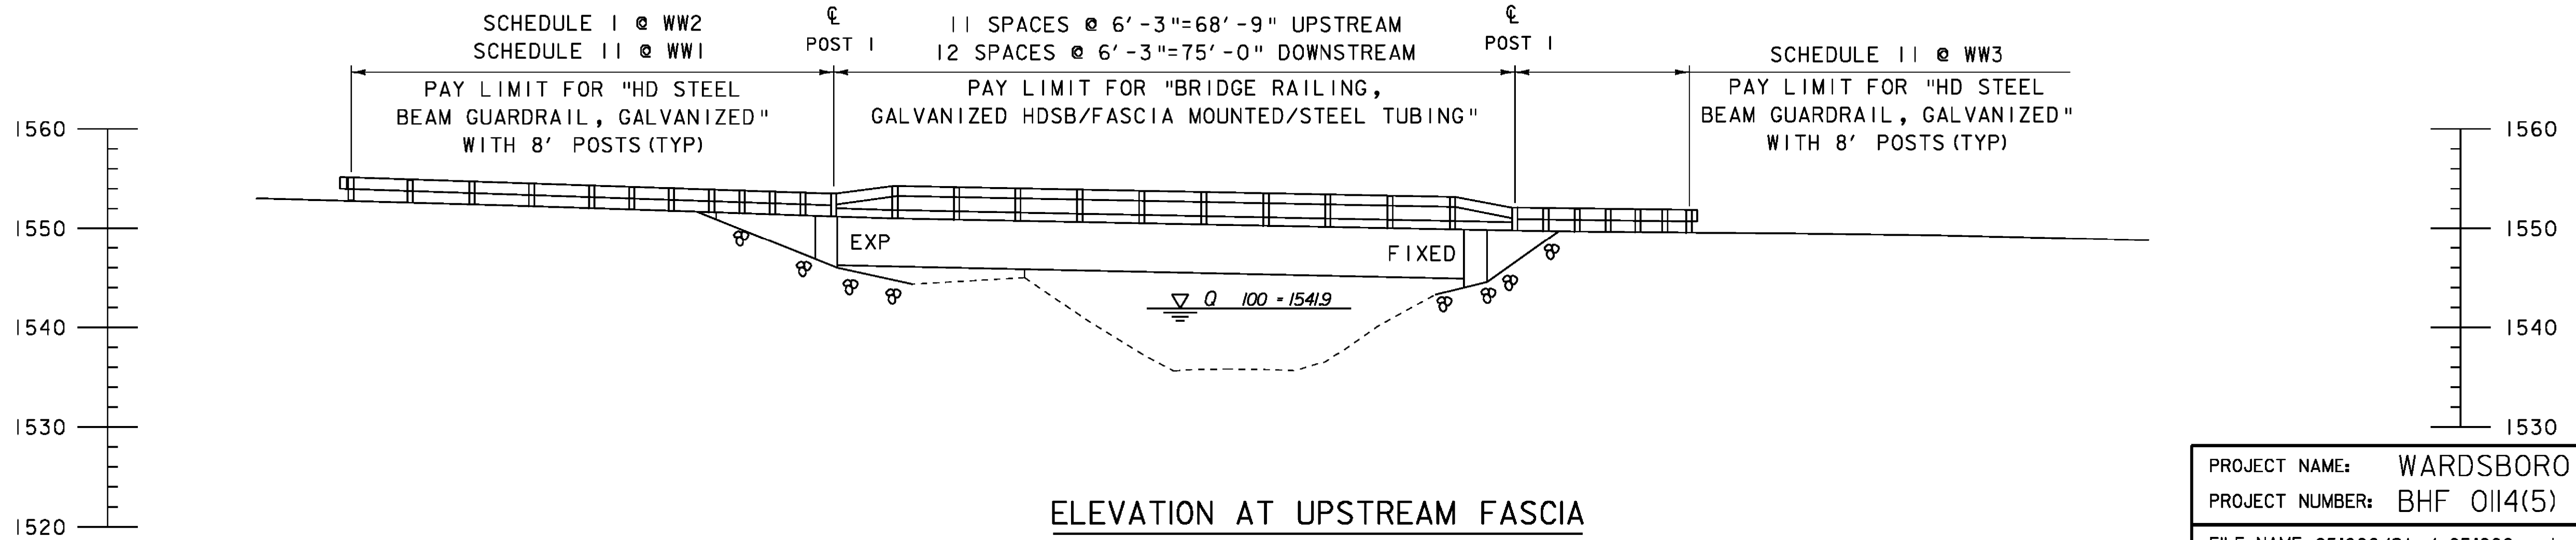

SCALE 1" = 10'-0"

NOTE:
SEE STANDARD SB-R6-82 FOR SCHEDULE DETAILS.

PROJECT NAME: WARDBORO	
PROJECT NUMBER: BHF 0114(5)	
FILE NAME: 05J006/Str/s05J006pe.dgn	PLOT DATE: 17-NOV-2009
PROJECT LEADER: C.P.WILLIAMS	DRAWN BY: M.FESSEL
DESIGNED BY: E.Charbonneau	CHECKED BY: E.Charbonneau
PLAN AND ELEVATION	SHEET 12 OF 33