




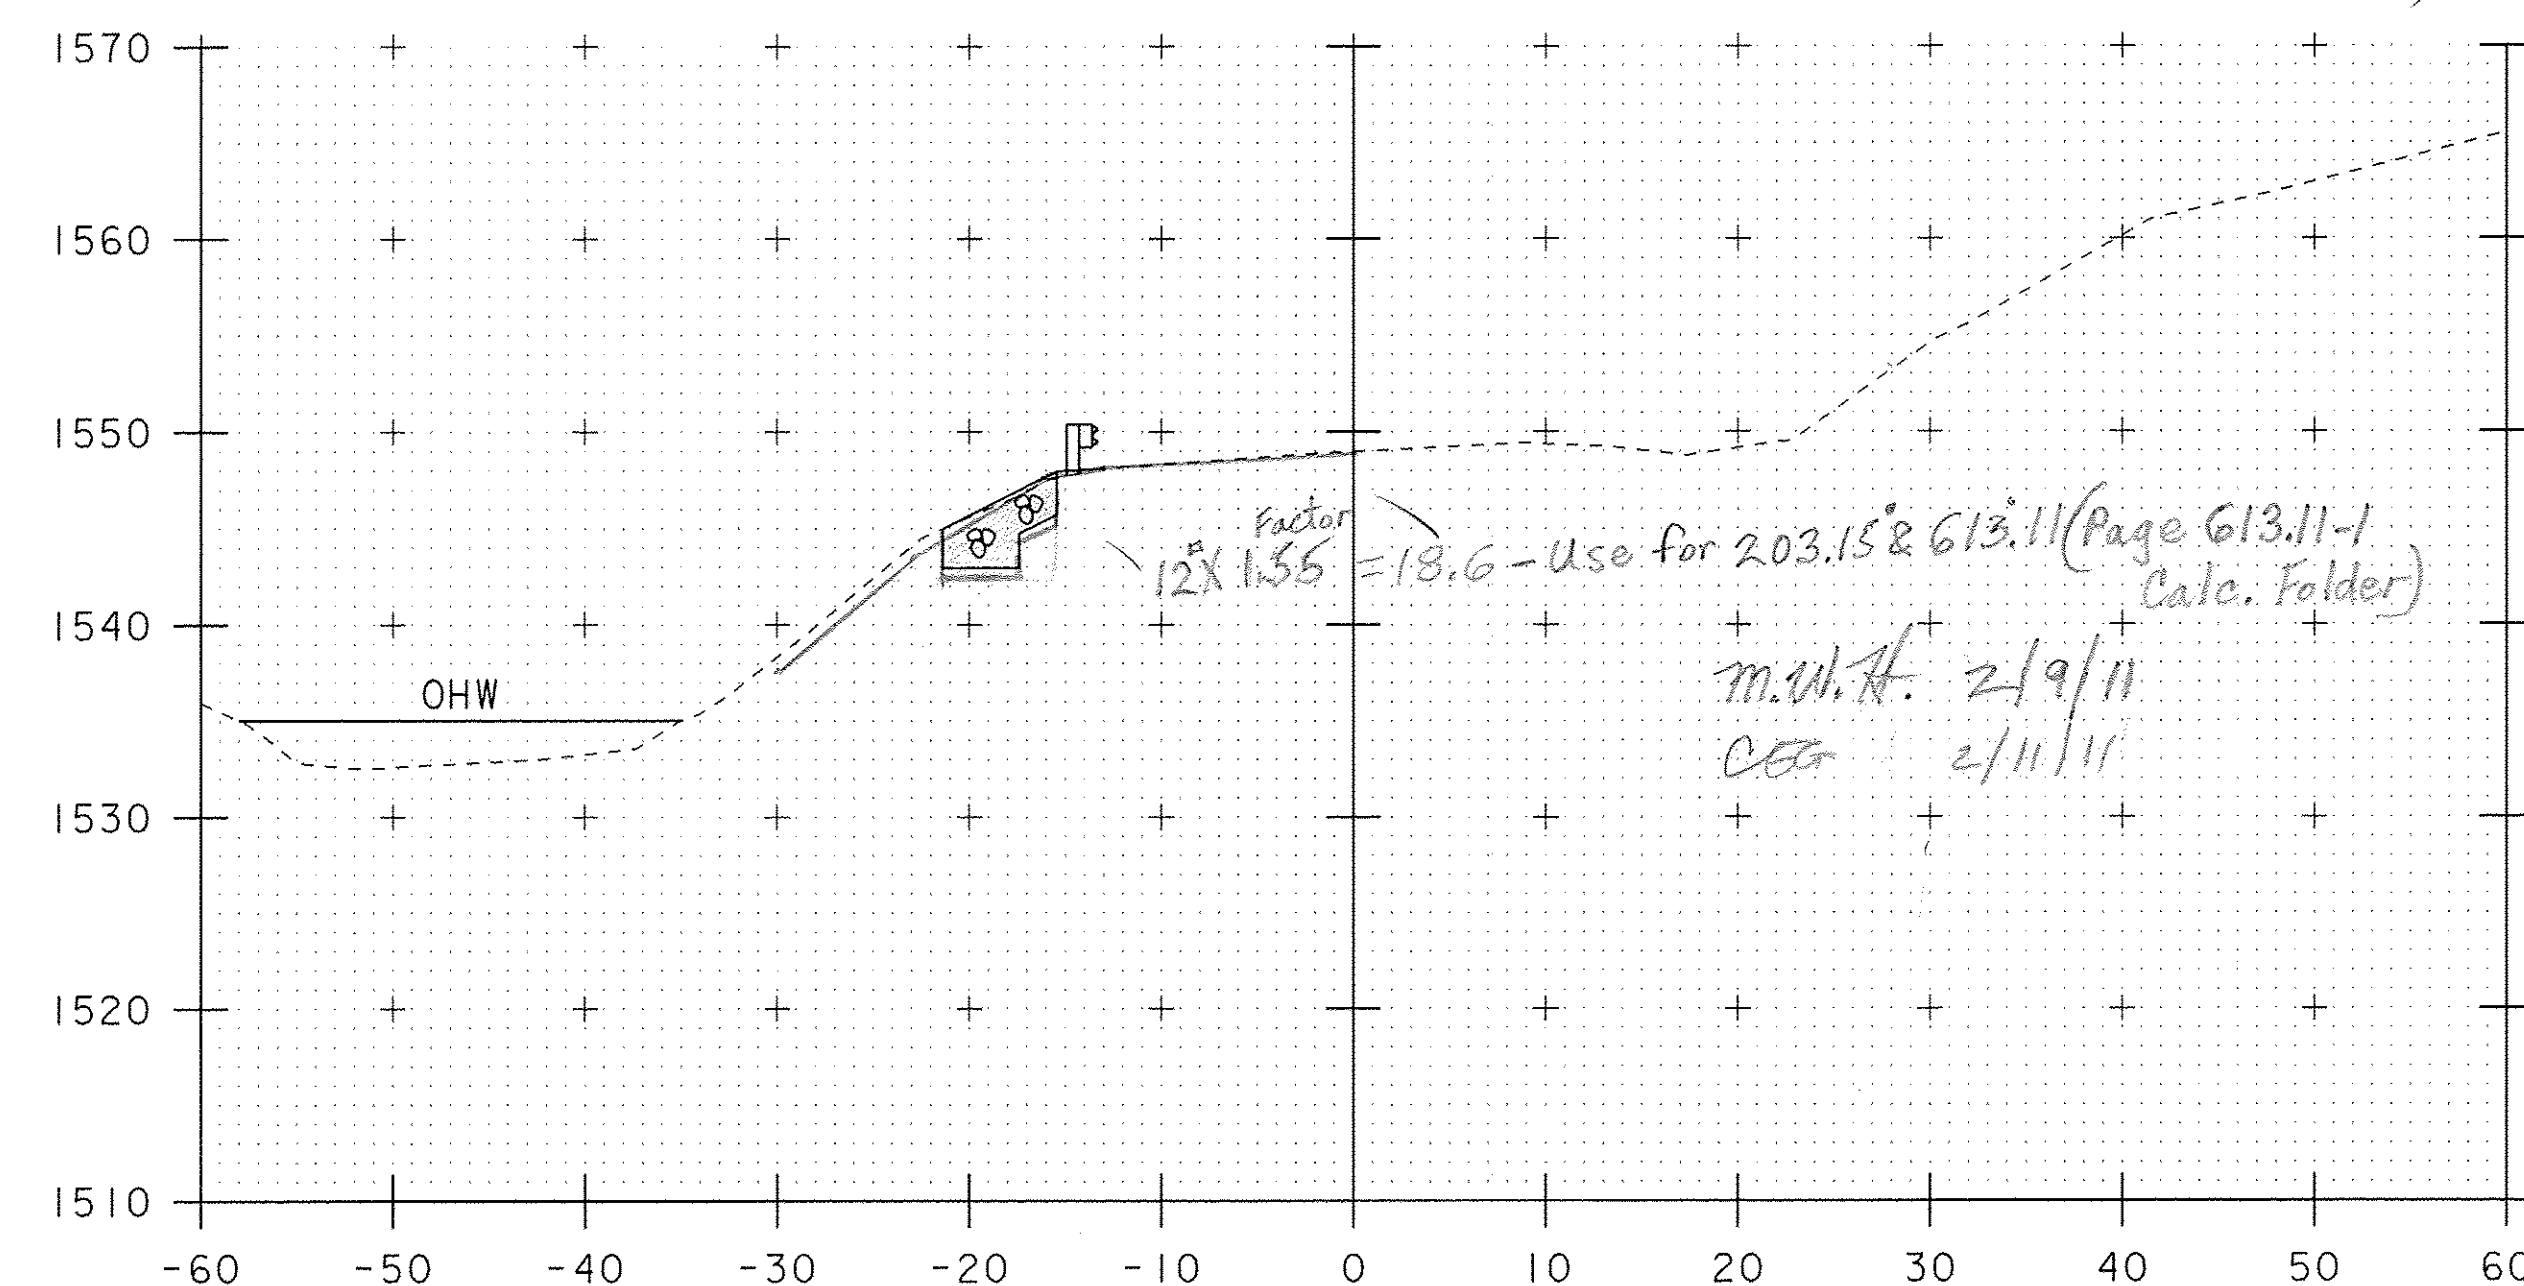


12+25
END APPROACH
STA 12+20

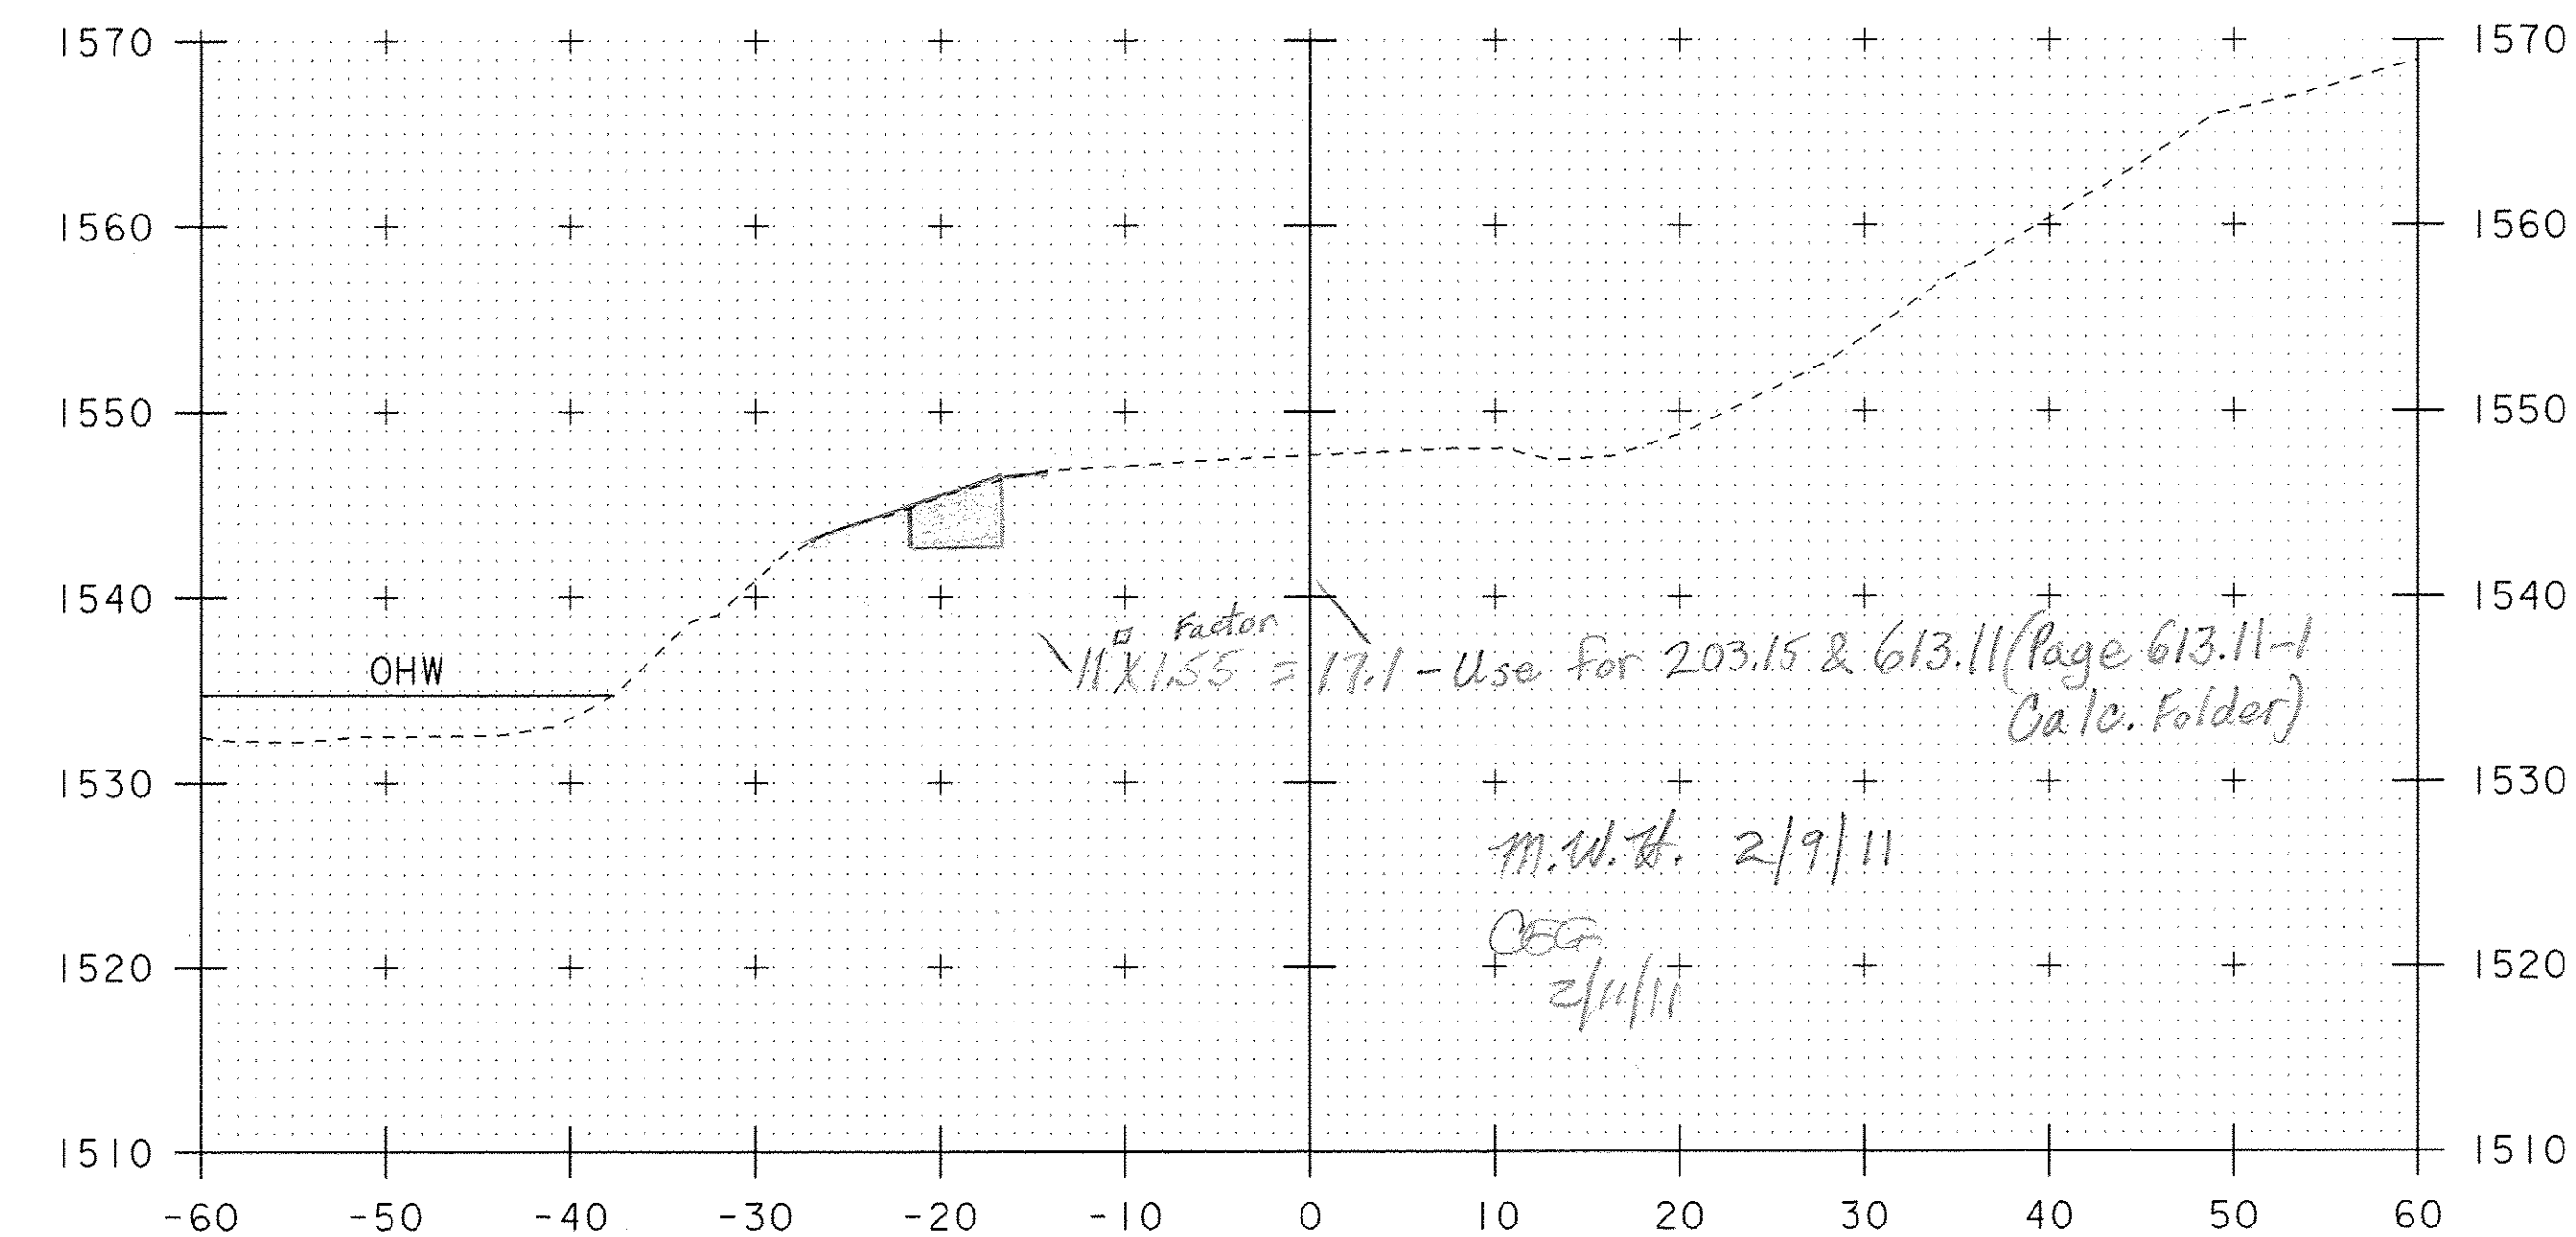

12+75 - End Stone Fill, Type II - Batt

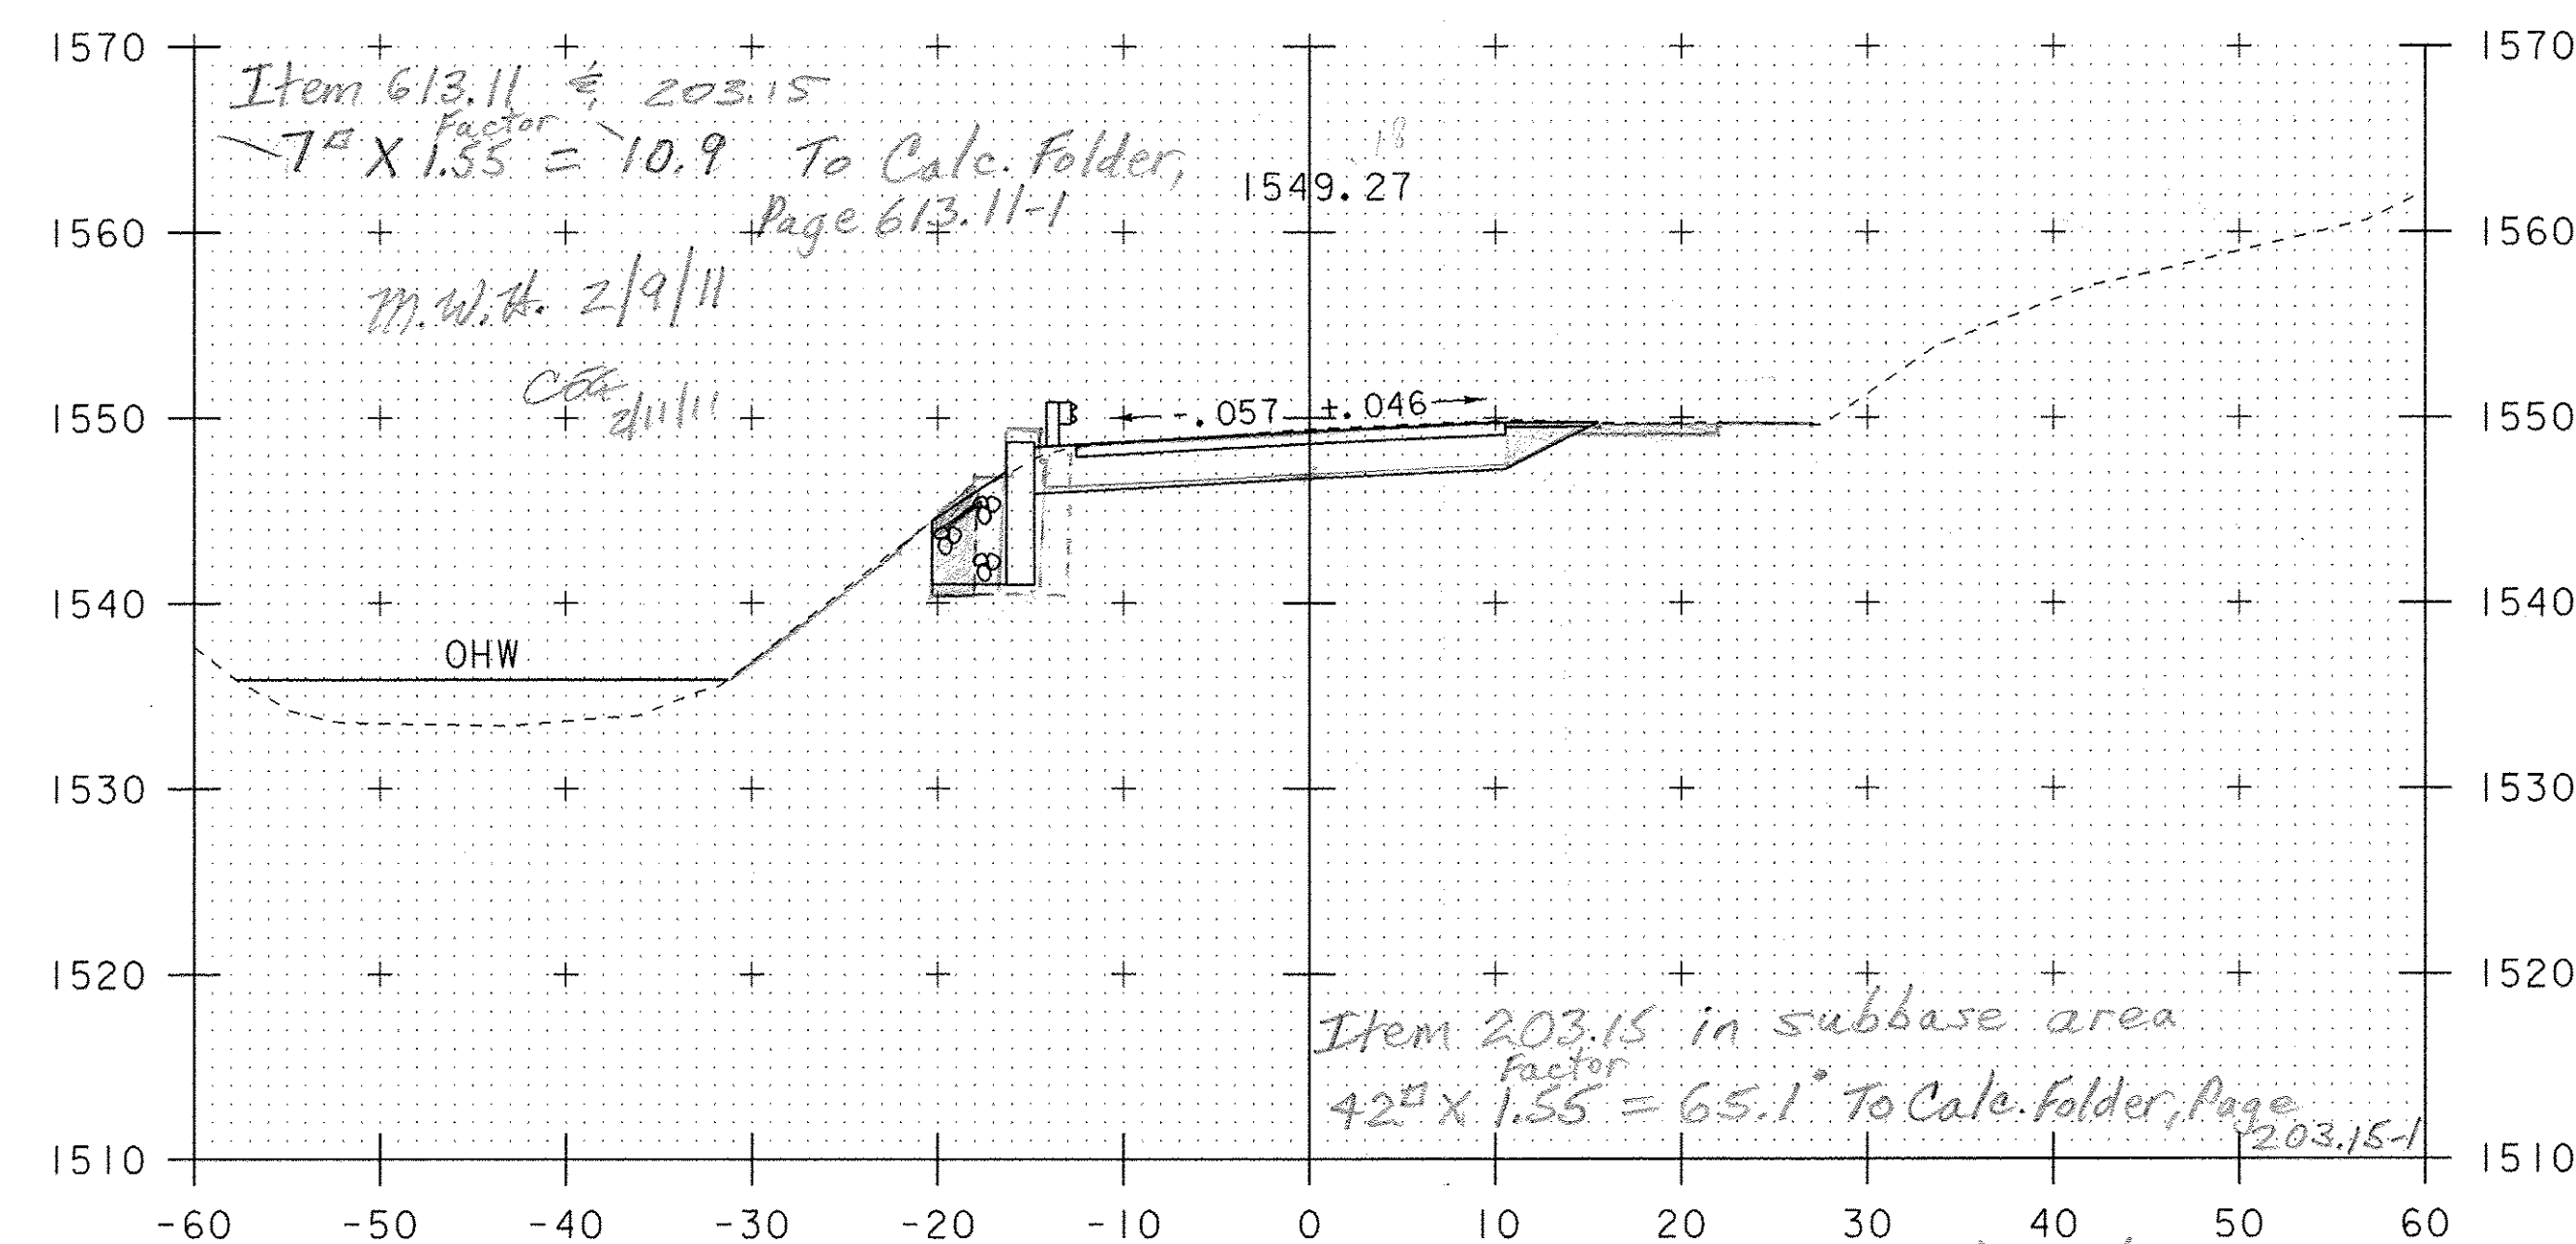

12+00

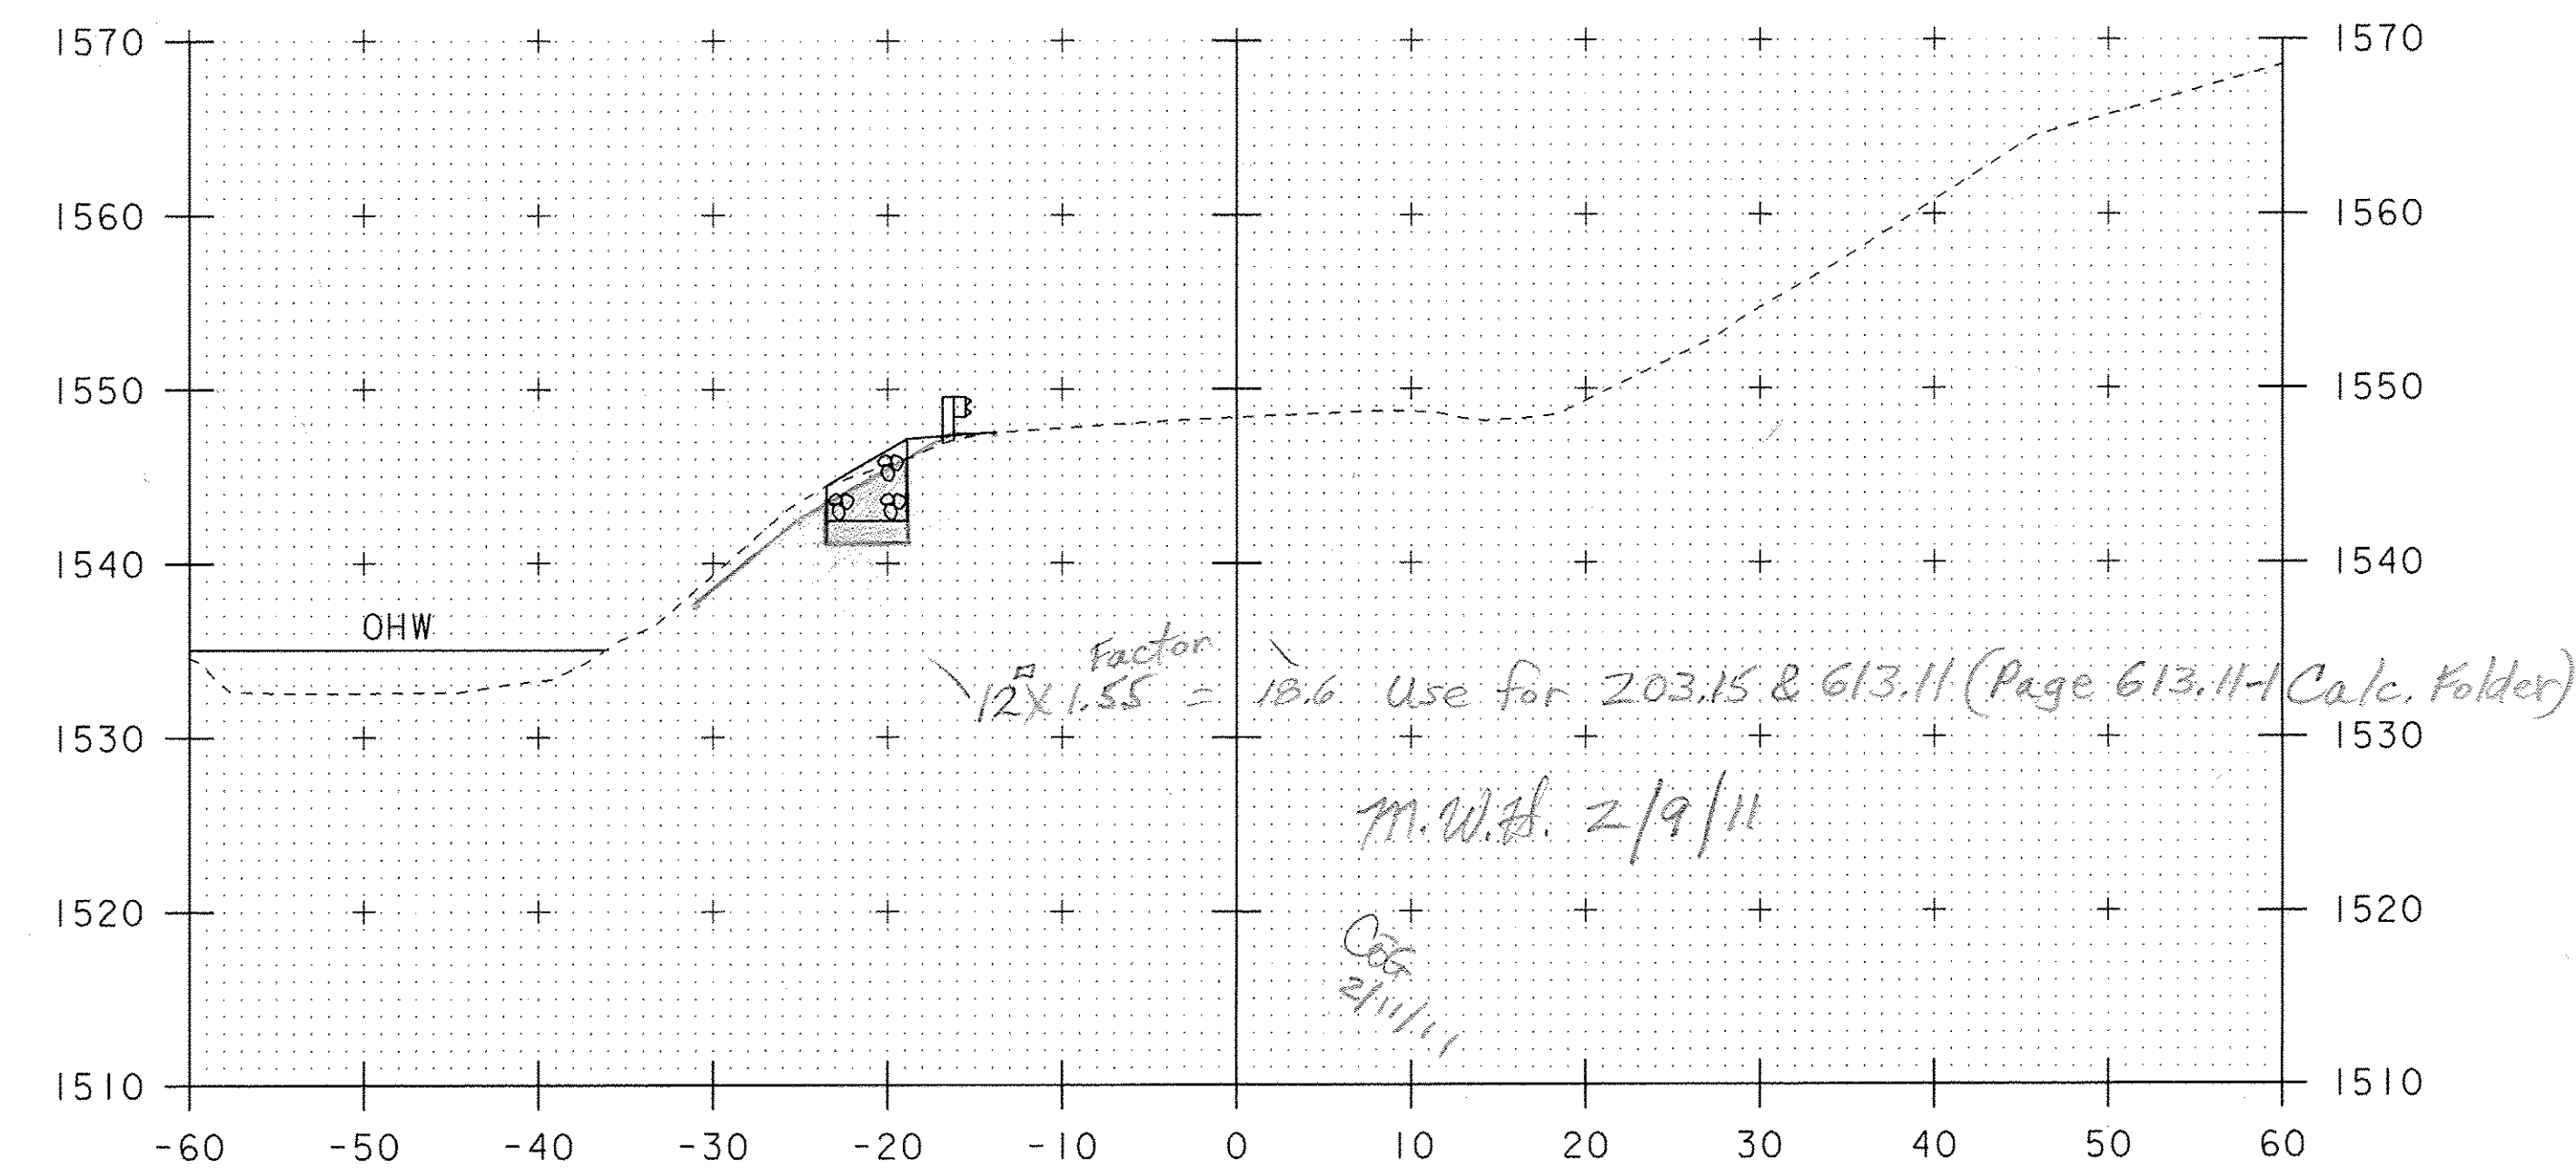

12+50

SCALE 1" = 10'-0"
10 0 10

STA. 12+00 TO STA. 12+75

PROJECT NAME: WARDBORO	
PROJECT NUMBER: BHF 0114(5)	
FILE NAME: s05j006xsl.dgn	PLOT DATE: 17-NOV-2009
PROJECT LEADER: C.P.WILLIAMS	DRAWN BY: M.FESSEL
DESIGNED BY: E.Charbonneau	CHECKED BY: E.Charbonneau
MAINLINE CROSS SECTIONS 3	SHEET 31 OF 33