

GPS CONTROL POINTS

B95065:
STATION MARK IS A VERMONT SURVEY DISK WITH SETTING IN THE TOP OF A BRIDGE ABUTMENT.
THE MARK IS STAMPED B95065.

NORTHING: 38968.9540
EASTING: 493532.1120
ELEVATION: 127.638 M (418.760 FT)

LOCATION:
BRATTLEBORO

DESCRIBED BY VERMONT AGENCY OF TRANSPORTATION 1995 (CHR):
GENERAL LOCATION, BRATTLEBORO, VT AT THE EAST END OF THE VT ROUTE 9 BRIDGE OVER I-91
IN BRATTLEBORO, SET IN THE TOP OF THE ABUTMENT AT THE NORTHEAST CORNER OF THE BRIDGE.
THE MARK IS 9.8 M (32.2 FT) NORTH OF AND ABOUT LEVEL WITH THE CENTERLINE OF THE MEDIAN
STRIP ON VT ROUTE 9, 0.4 M (1.3 FT) WEST OF THE EAST END OF THE BRIDGE DECK, 0.6 M
(2.0 FT) NORTH OF THE FACE OF THE BRIDGE CURB, AND 3.1 M (10.2 FT) SOUTHWEST OF A
FIBERGLASS WITNESS POST.


A 14:
STATION MARK IS A VERMONT SURVEY DISK WITH SETTING IN THE TOP OF A SQUARE CONCRETE MONUMENT.
THE MARK IS STAMPED A 14.

NORTHING: 38885.1910
EASTING: 493003.3870
ELEVATION: 127.763 M (419.170 FT)

LOCATION:
BRATTLEBORO

RECOVERY NOTE BY VERMONT AGENCY OF TRANSPORTATION 1995 (CHR):
GENERAL LOCATION, BRATTLEBORO, VT, ABOUT 2.4 KM (1.5 MI) WEST OF BRATTLEBORO, ABOUT 23.3 KM
(14.5 MI) EAST OF WILMINGTON, AND ABOUT 13.7 KM (8.5 MI) NORTH OF THE MASSACHUSETTS/VERMONT
STATE LINE. TO REACH FROM THE EAST END OF THE VT ROUTE 9 BRIDGE OVER I-91 IN BRATTLEBORO GO
WEST ALONG VT ROUTE 9 FOR 0.5 KM (0.3 MI) THE INTERSECTION OF GUILFORD STREET LEFT AT THE
CREAMERY COVERED BRIDGE, AND THE MARK ON THE LEFT IN THE EAST POINT OF THE MOWED TRIANGLE
FORMED BY THE INTERSECTION. THE MARK IS SET IN THE TOP OF A 15 CM SQUARE CONCRETE MONUMENT
2 CM BELOW GROUND SURFACE. IT IS 7.0 M (23.0 FT) SOUTH OF AND ABOUT LEVEL WITH THE CENTERLINE
OF VT ROUTE 9, 10.0 M (32.8 FT) WEST OF THE CENTERLINE OF THE EAST LEG OF GUILFORD STREET,
19.5 M (64.0 FT) EAST OF CENTERLINE OF THE WEST LEG OF GUILFORD STREET, 23.2 M (76.1 FT) NORTH
OF THE NORTHWEST CORNER OF THE COVERED BRIDGE, 14.2 M (46.6 FT) NORTH OF A FIRE HYDRANT, 9.5 M
(31.2 FT) EAST OF A SEWER MANHOLE, AND 0.4 M (1.3 FT) EAST OF A FIBERGLASS WITNESS POST AND ROAD
SIGN.

TRAVERSE TIES

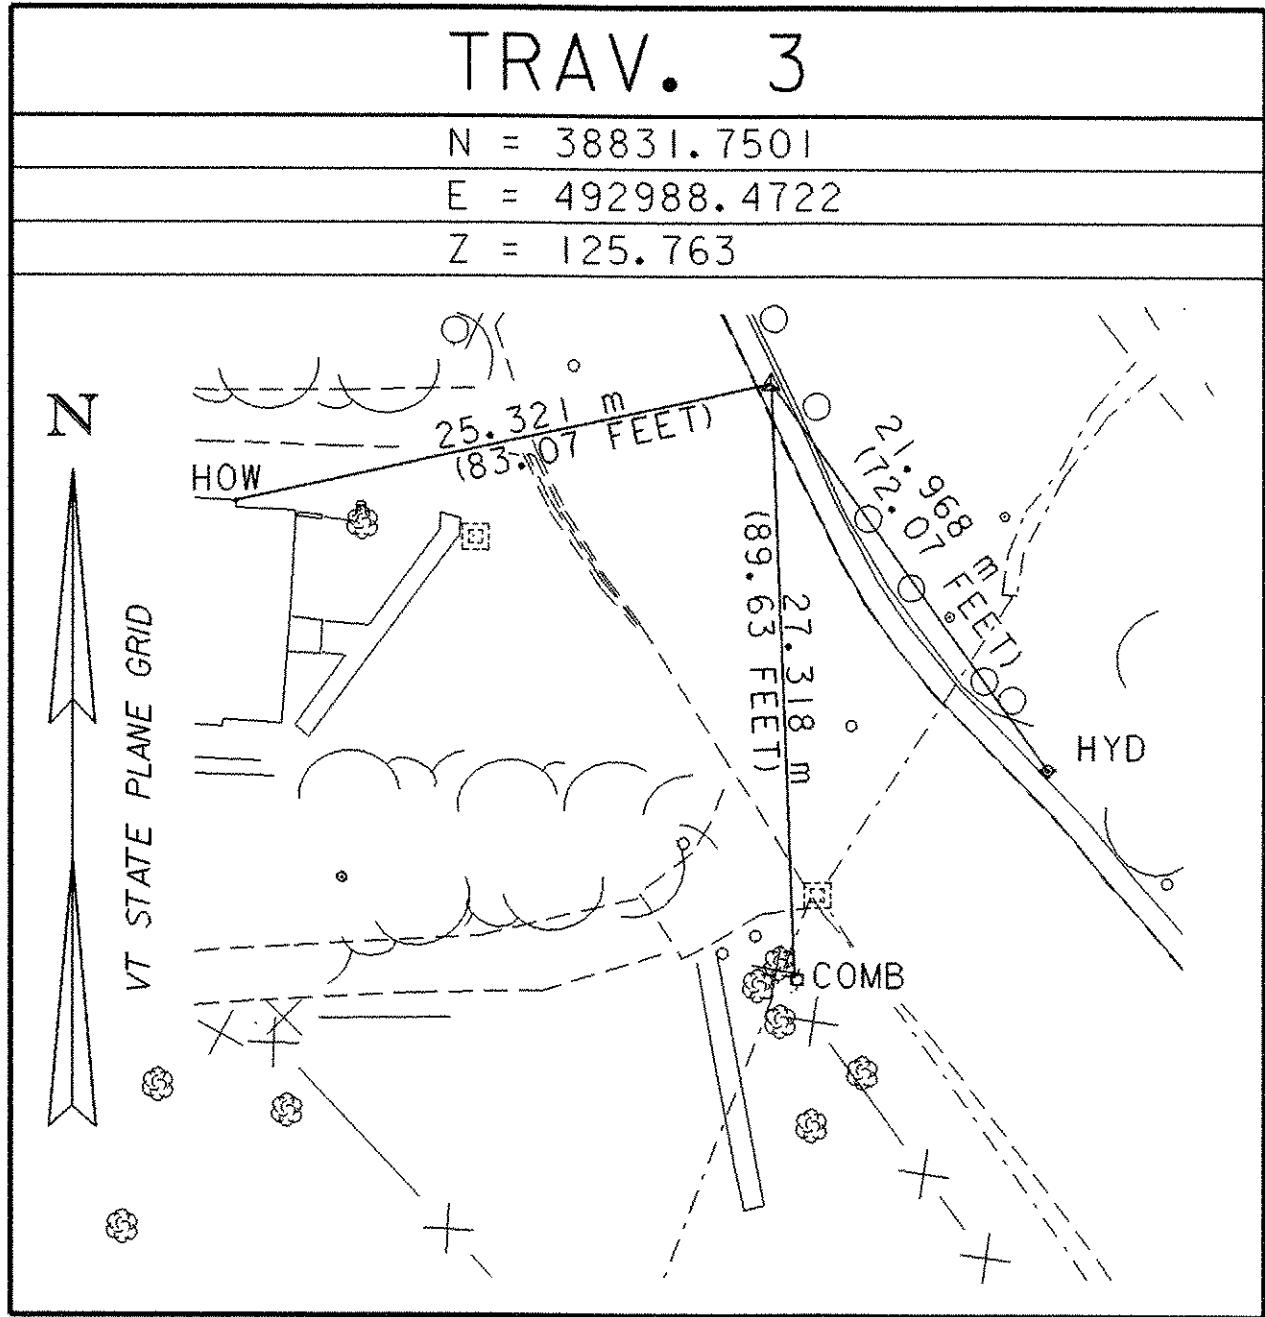

DATUM	
VERTICAL	NAVD 88
HORIZONTAL	NAD 83 (92)
ADJUSTED	NO
TYPE	N/A

PROJECT NAME: BRATTLEBORO	
PROJECT NUMBER: BHO 1442 (33)	
FILE NAME: 96j228\Structures\sj228tie.i	PLOT DATE: 10-AUG-2006
IPARM FILE NAME:	DRAWN BY: J. WHITE
DESIGNED BY: J. WEAVER	CHECKED BY: J. WEAVER
TIE SHEET	SHEET 3 OF 8