


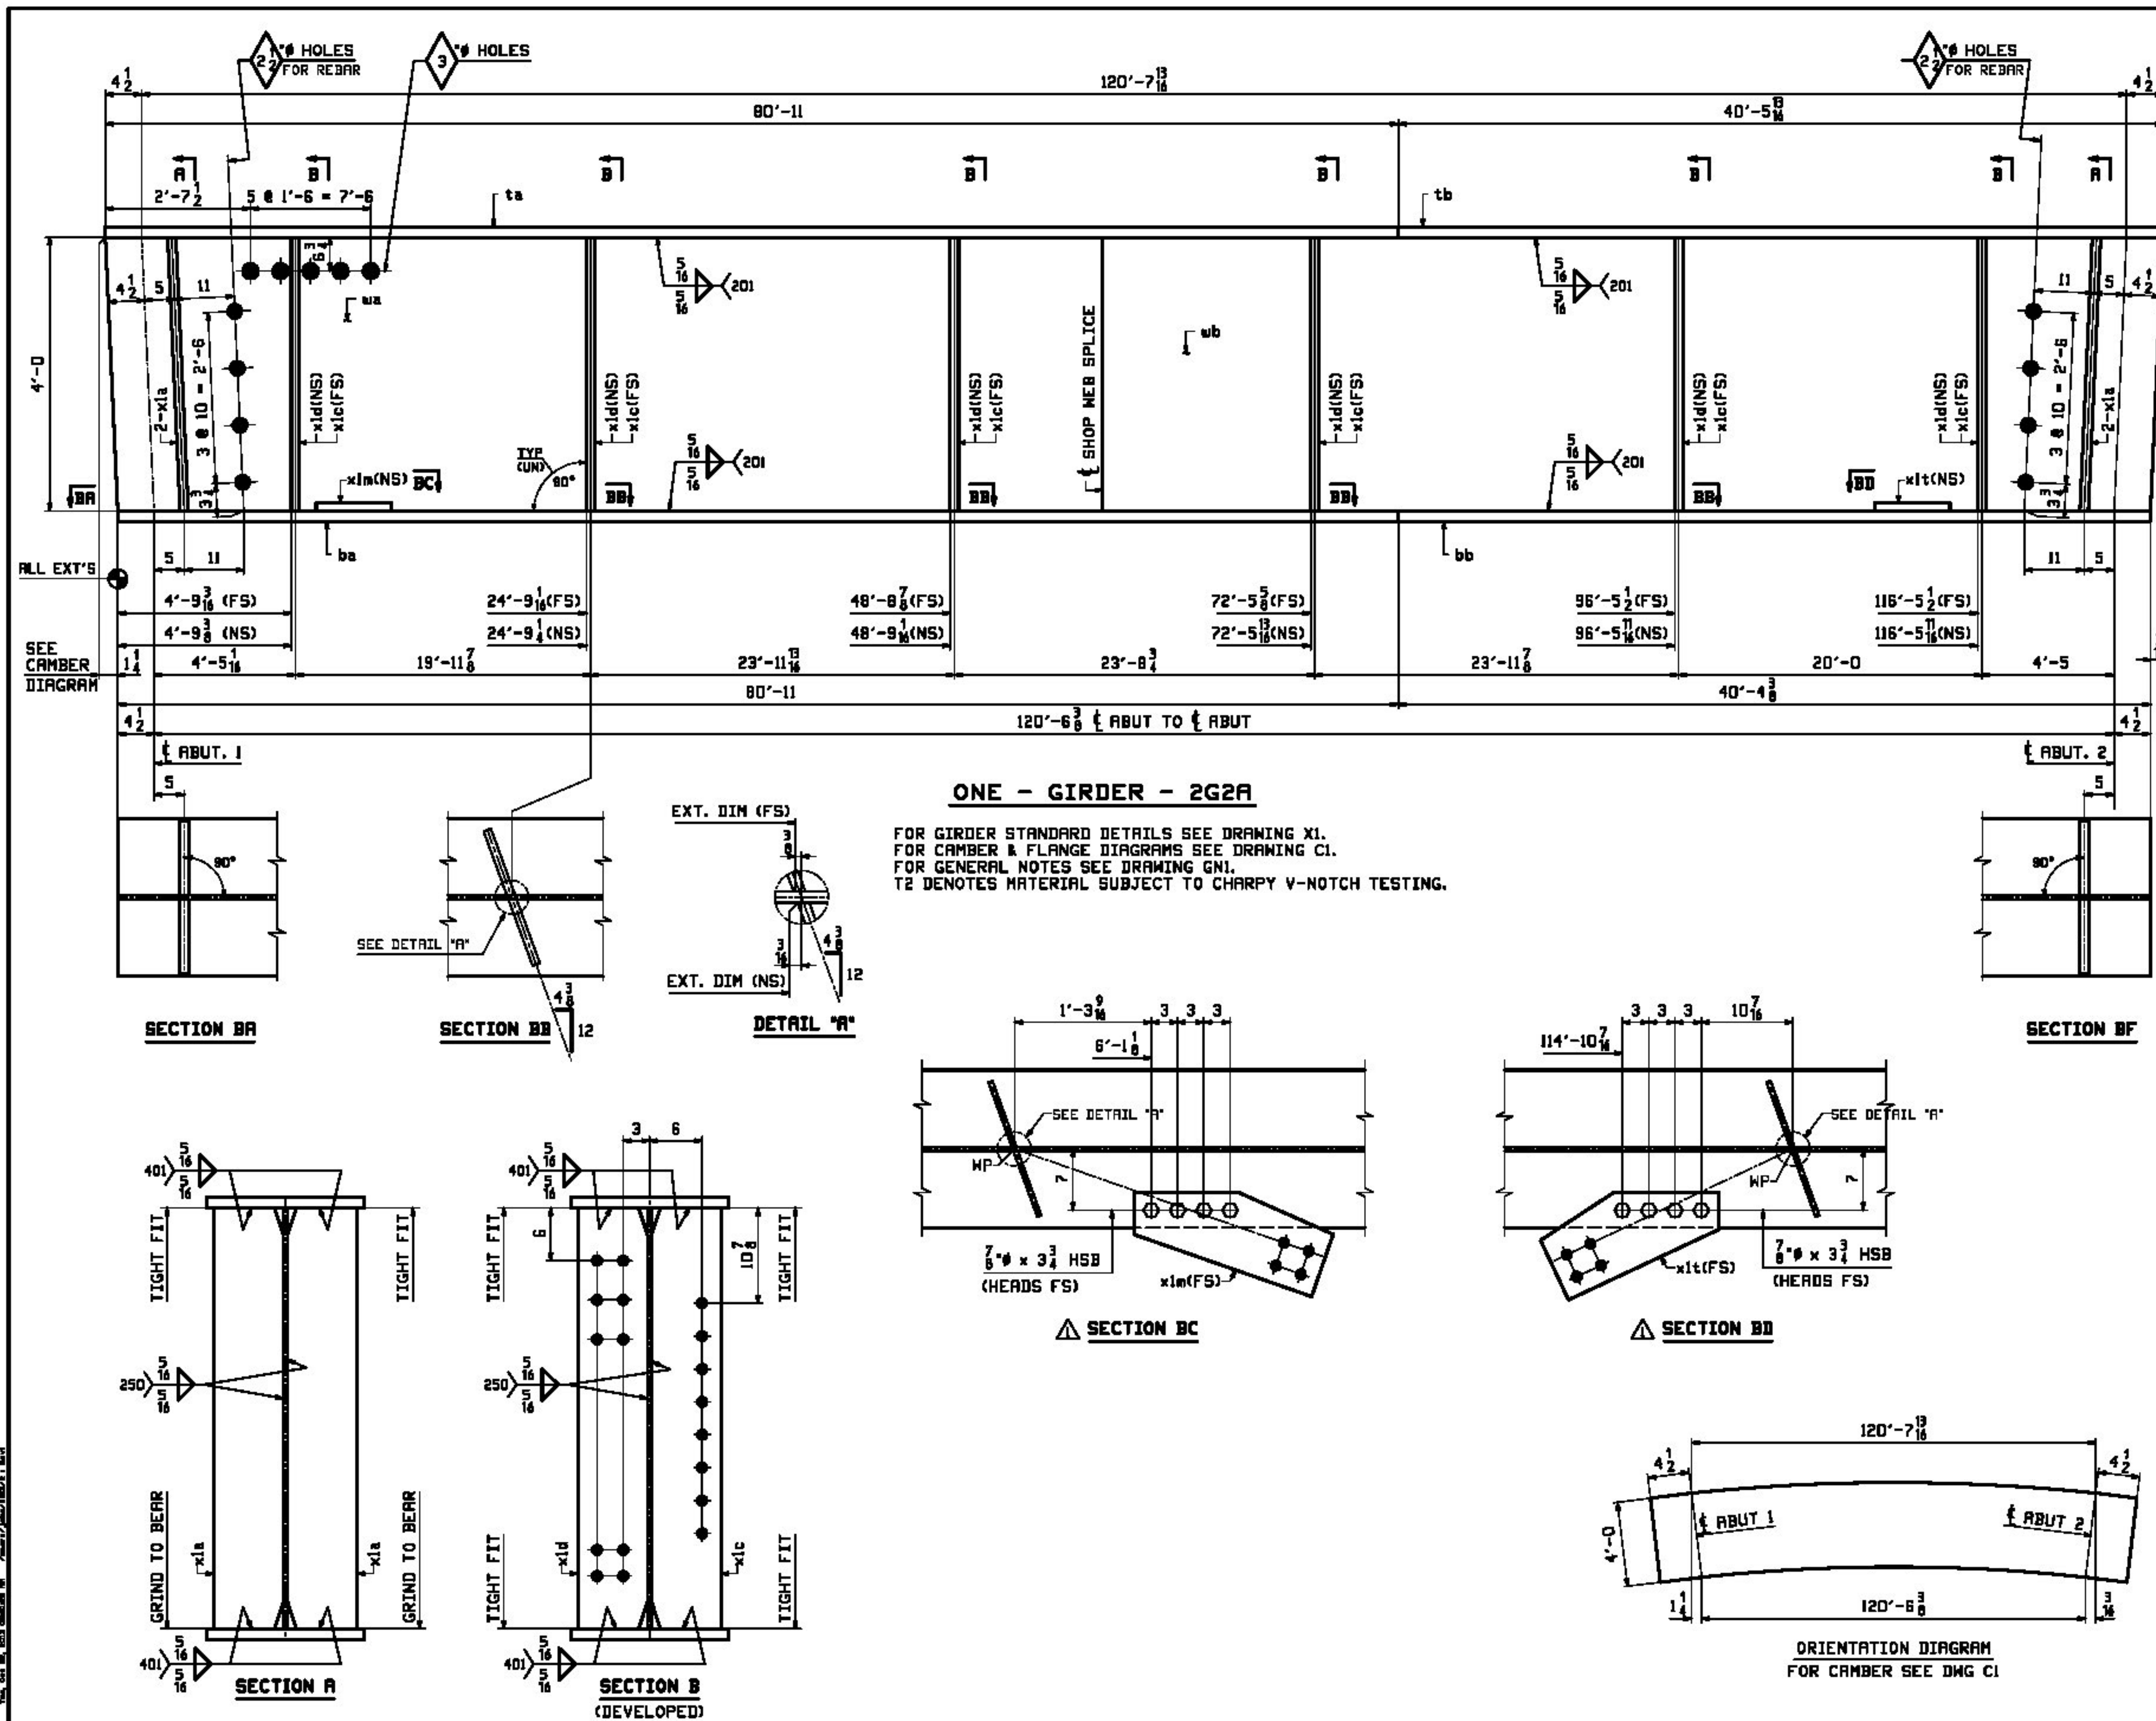

ITEM INFO		SHOP		BILL OF MATERIAL		JOB NO.		DRAWING NO.		REV.
ITEM	QTY	UNIT	DESCRIPTION	MATERIAL	LENGTH	REMARKS	MT	PROCUREMENT	NOTES	
1	1	EA	GIRDER	2G2A	120'-7 1/8"		25729			
1	1	EA	PL 1/2" x 4"	PL 1/2" x 4"	58' 4 1/2"	2270-SHUT	1851			
1	1	EA	PL 1/2" x 4"	PL 1/2" x 4"	62' 0 1/2"	2270-SHUT	3067			
1	1	EA	PL 1/2" x 4"	PL 1/2" x 4"	80' 11"	2270-SHUT	6185			
1	1	EA	PL 1/2" x 4"	PL 1/2" x 4"	40' 5 1/2"	2270-SHUT	3100			
1	1	EA	PL 1/2" x 4"	PL 1/2" x 4"	80' 11"	2270-SHUT	6185			
1	1	EA	PL 1/2" x 4"	PL 1/2" x 4"	40' 5 1/2"	2270-SHUT	3090			
2	4	EA	PL 1/2" x 8"	PL 1/2" x 8"	4' 0"	2270-SHUT	116			
2	5	EA	PL 1/2" x 8"	PL 1/2" x 8"	4' 0"	2270-SHUT	54			
2	5	EA	PL 1/2" x 8"	PL 1/2" x 8"	4' 0"	2270-SHUT	54			
2	1	EA	PL 1/2" x 8"	PL 1/2" x 8"	1' 11 1/2"	2270-SHUT	55			
2	1	EA	PL 1/2" x 8"	PL 1/2" x 8"	1' 11 1/2"	2270-SHUT	52			
5	5	EA	PL 1/2" x 8"	PL 1/2" x 8"	0' 2 1/2"	2270-SHUT	.60			
5	5	EA	PL 1/2" x 8"	PL 1/2" x 8"	0' 2 1/2"	2270-SHUT	.07			

☐ Approved
 ☐ Revised and Resubmit

☒ Approved as Noted
 ☐ Rejected

Hoyle, Tanner & Associates, Inc.

Project No. 904220

Approval is only for general compliance with the design concept to the Project and the information given in the Current Specification. Contractor is responsible for the information to be confirmed and approved at the job site. Information that concerns safety or the performance, process or the means and methods of construction, coordination of the work of all trades and performance of work in a safe and satisfactory manner. This approval does not modify Contractor's duty of compliance contract.

Reviewed By: JAS Date: 11/1/13

Approved By: JAS Date: 11/1/13

	ID/17	REVISE LATERAL GUSSETS	JTB	DBH		
0						
REV.	DATE	REMARKS	DMN	CHK	APVL	SHOP
MATERIAL: M270-SOW		SURFACE PREP. & PAINT: SEE DWG GNI		HOLES: 15 16" Ø (UN)		SHOP BOLTS: AS NOTED
DESCRIPTION: GIRDER - 2G2A						
CASCO BAY STEEL STRUCTURES, INC. 1 WALLACE AVE. PHONE (207) 780-6722 SOUTH PORTLAND, ME 04106 FAX. (207) 780-6726						 TEMPORARY
STRUCTURE: BRISTOL - BRIDGE NO. 31 VT ROUTE NO. 15 (SOUTH STREET) OVER NEW HAVEN RIVER			DRAWN: JTB CHKD: DBH		DATE: 08/14 DATE: 09/07	
LOCATION: TOWN OF BRISTOL, VT (ADDISON COUNTY)			JOB NO.		DWG NO.	
PROJ NO. BRO 1445 (32)			534		2	
CUSTOMER: BLOW AND COTE					REV. 	