



STATE OF VERMONT
AGENCY OF TRANSPORTATION

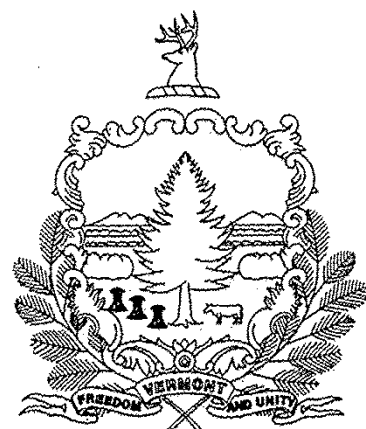

PROPOSED IMPROVEMENT
BRIDGE PROJECT

TOWN OF BARRE

COUNTY OF WASHINGTON

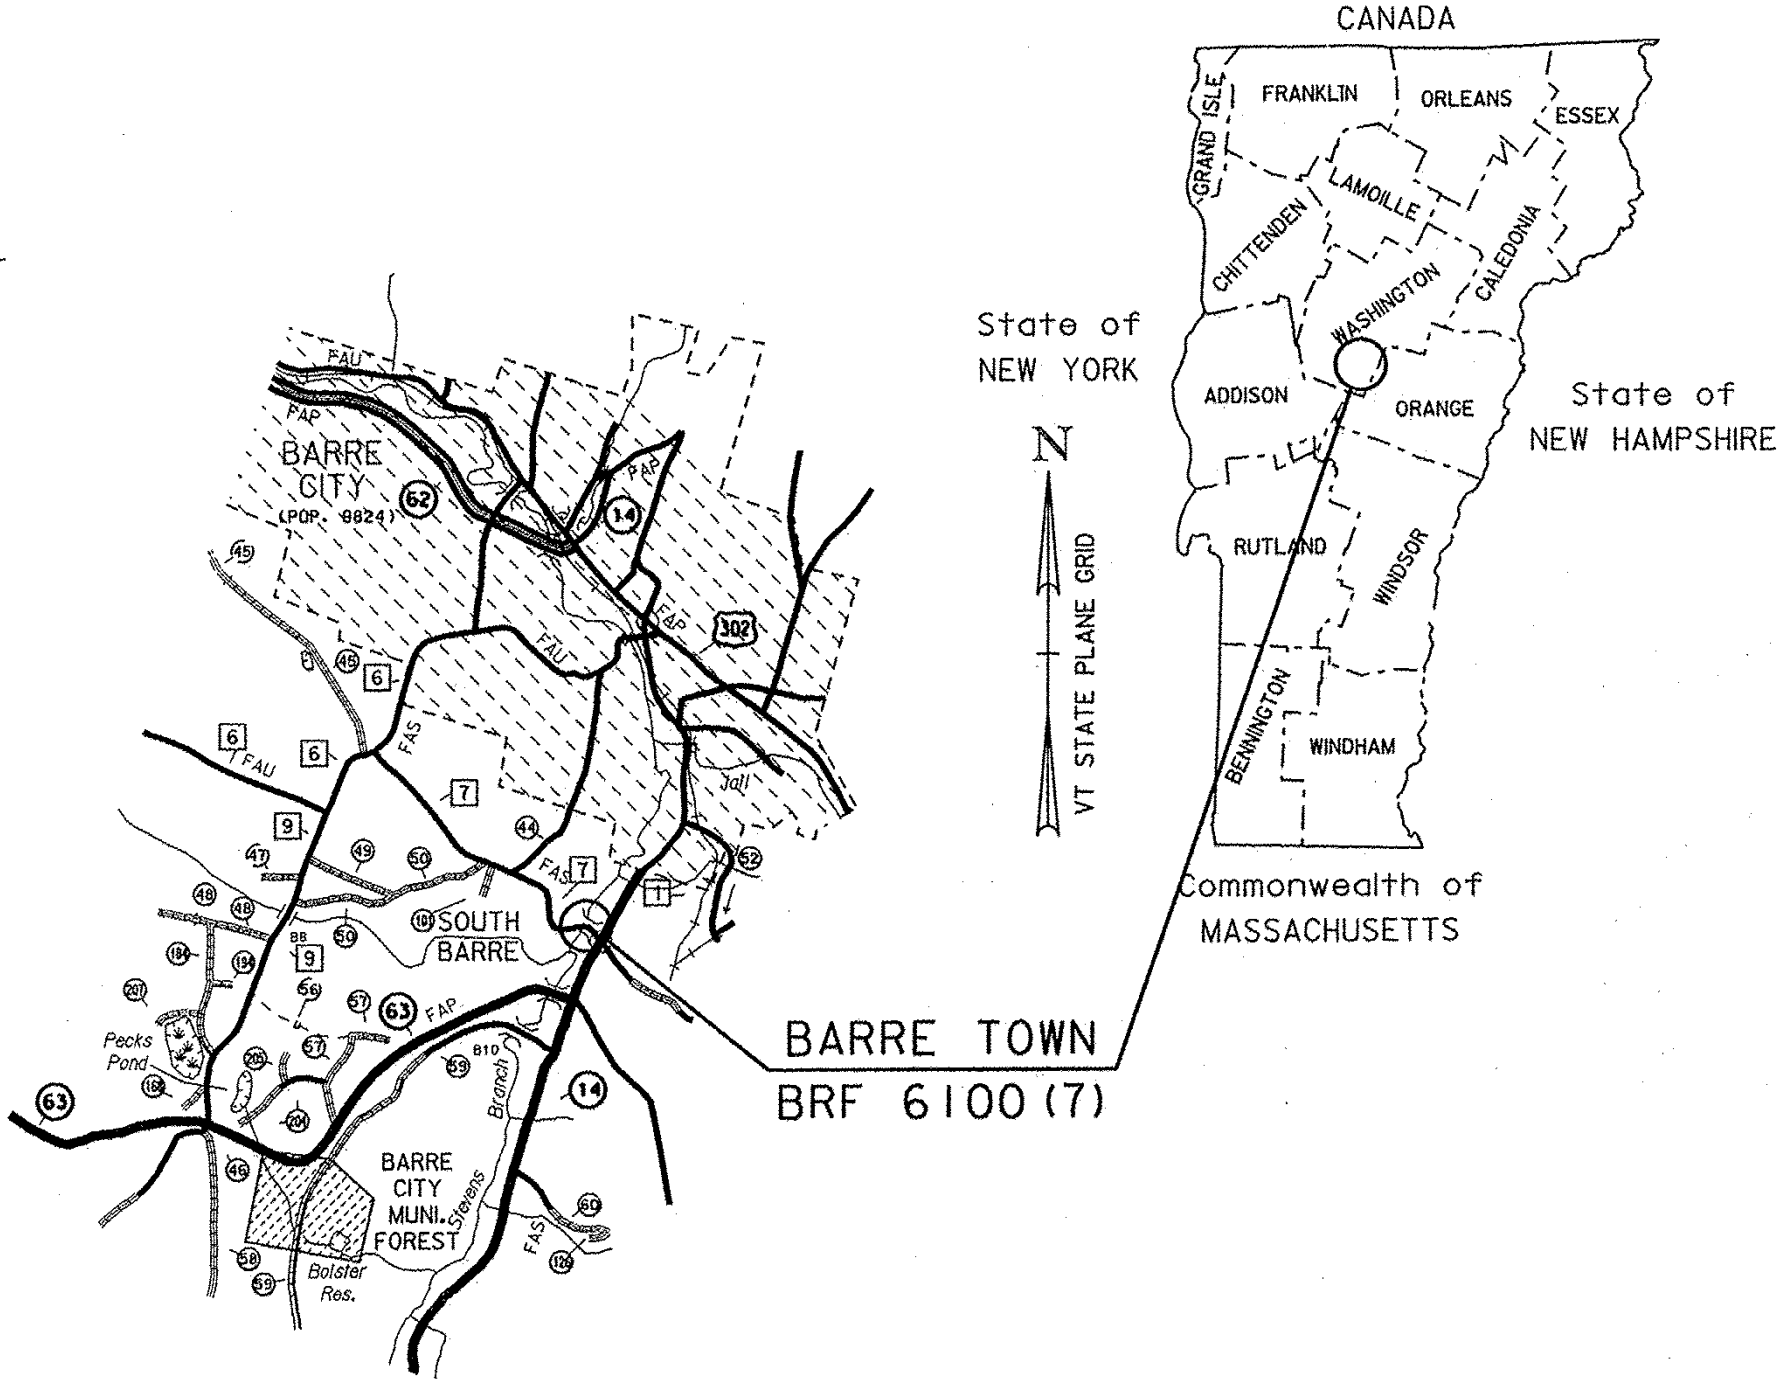

RECORD PLANS

CONTRACTOR: MILLER CONSTRUCTION, INC - WINDSOR, VT

RESIDENT ENGINEER: PETE HODGSON

CONSTRUCTION BEGAN: APRIL 1, 2013

CONSTRUCTION COMPLETE: OCTOBER 30, 2013

RECORD PLANS BY: PETE HODGSON & C. PIERCE

I HEREBY CERTIFY THAT ALL THE CONSTRUCTION REQUIRED BY THIS SET OF DRAWINGS HAS BEEN ACCOMPLISHED AS INDICATED HEREIN.

BY *Pete Hodgson* RESIDENT ENGINEER

DATE *3/14/16*

NOTE: Any further information concerning final quantities, amounts or other details relative to this project may be found at Central Files in the electronic archives.

ROUTE NO : TH 7 (BRIDGE STREET) MAJOR COLLECTOR BRIDGE NO : 11

PROJECT LOCATION : BRIDGE NO 11 IS LOCATED ON TH 7 (BRIDGE STREET), APPROXIMATELY 0.10 MILES WEST OF THE INTERSECTION WITH ROUTE 14

PROJECT DESCRIPTION : REPLACEMENT OF BRIDGE NO 11 ON EXISTING ALIGNMENT, INCLUDING RELATED CHANNEL AND APPROACH WORK.


LENGTH OF STRUCTURE : 124.12 FEET.

LENGTH OF ROADWAY : 150.88 FEET.

LENGTH OF PROJECT : 275.00 FEET.

QUALITY ASSURANCE PROGRAM: LEVEL 2

CONVENTIONAL SYMBOLS	
COUNTY LINE	
TOWN LINE	
LIMITS OF ACCESS	
POINT OF ACCESS	
FENCE LINE	
STONE WALL	
TRAVELED WAY	
GUARD RAIL	
RAILROAD	
SURVEY LINE	
CULVERT	
POWER POLE	
TELEPHONE POLE	
TREES	
CONTROL OF ACCESS	
PROPERTY LINE	
R.O.W. TAKING LINE	
SLOPE RIGHTS	
TOP OF CUT	
TOE OF SLOPE	

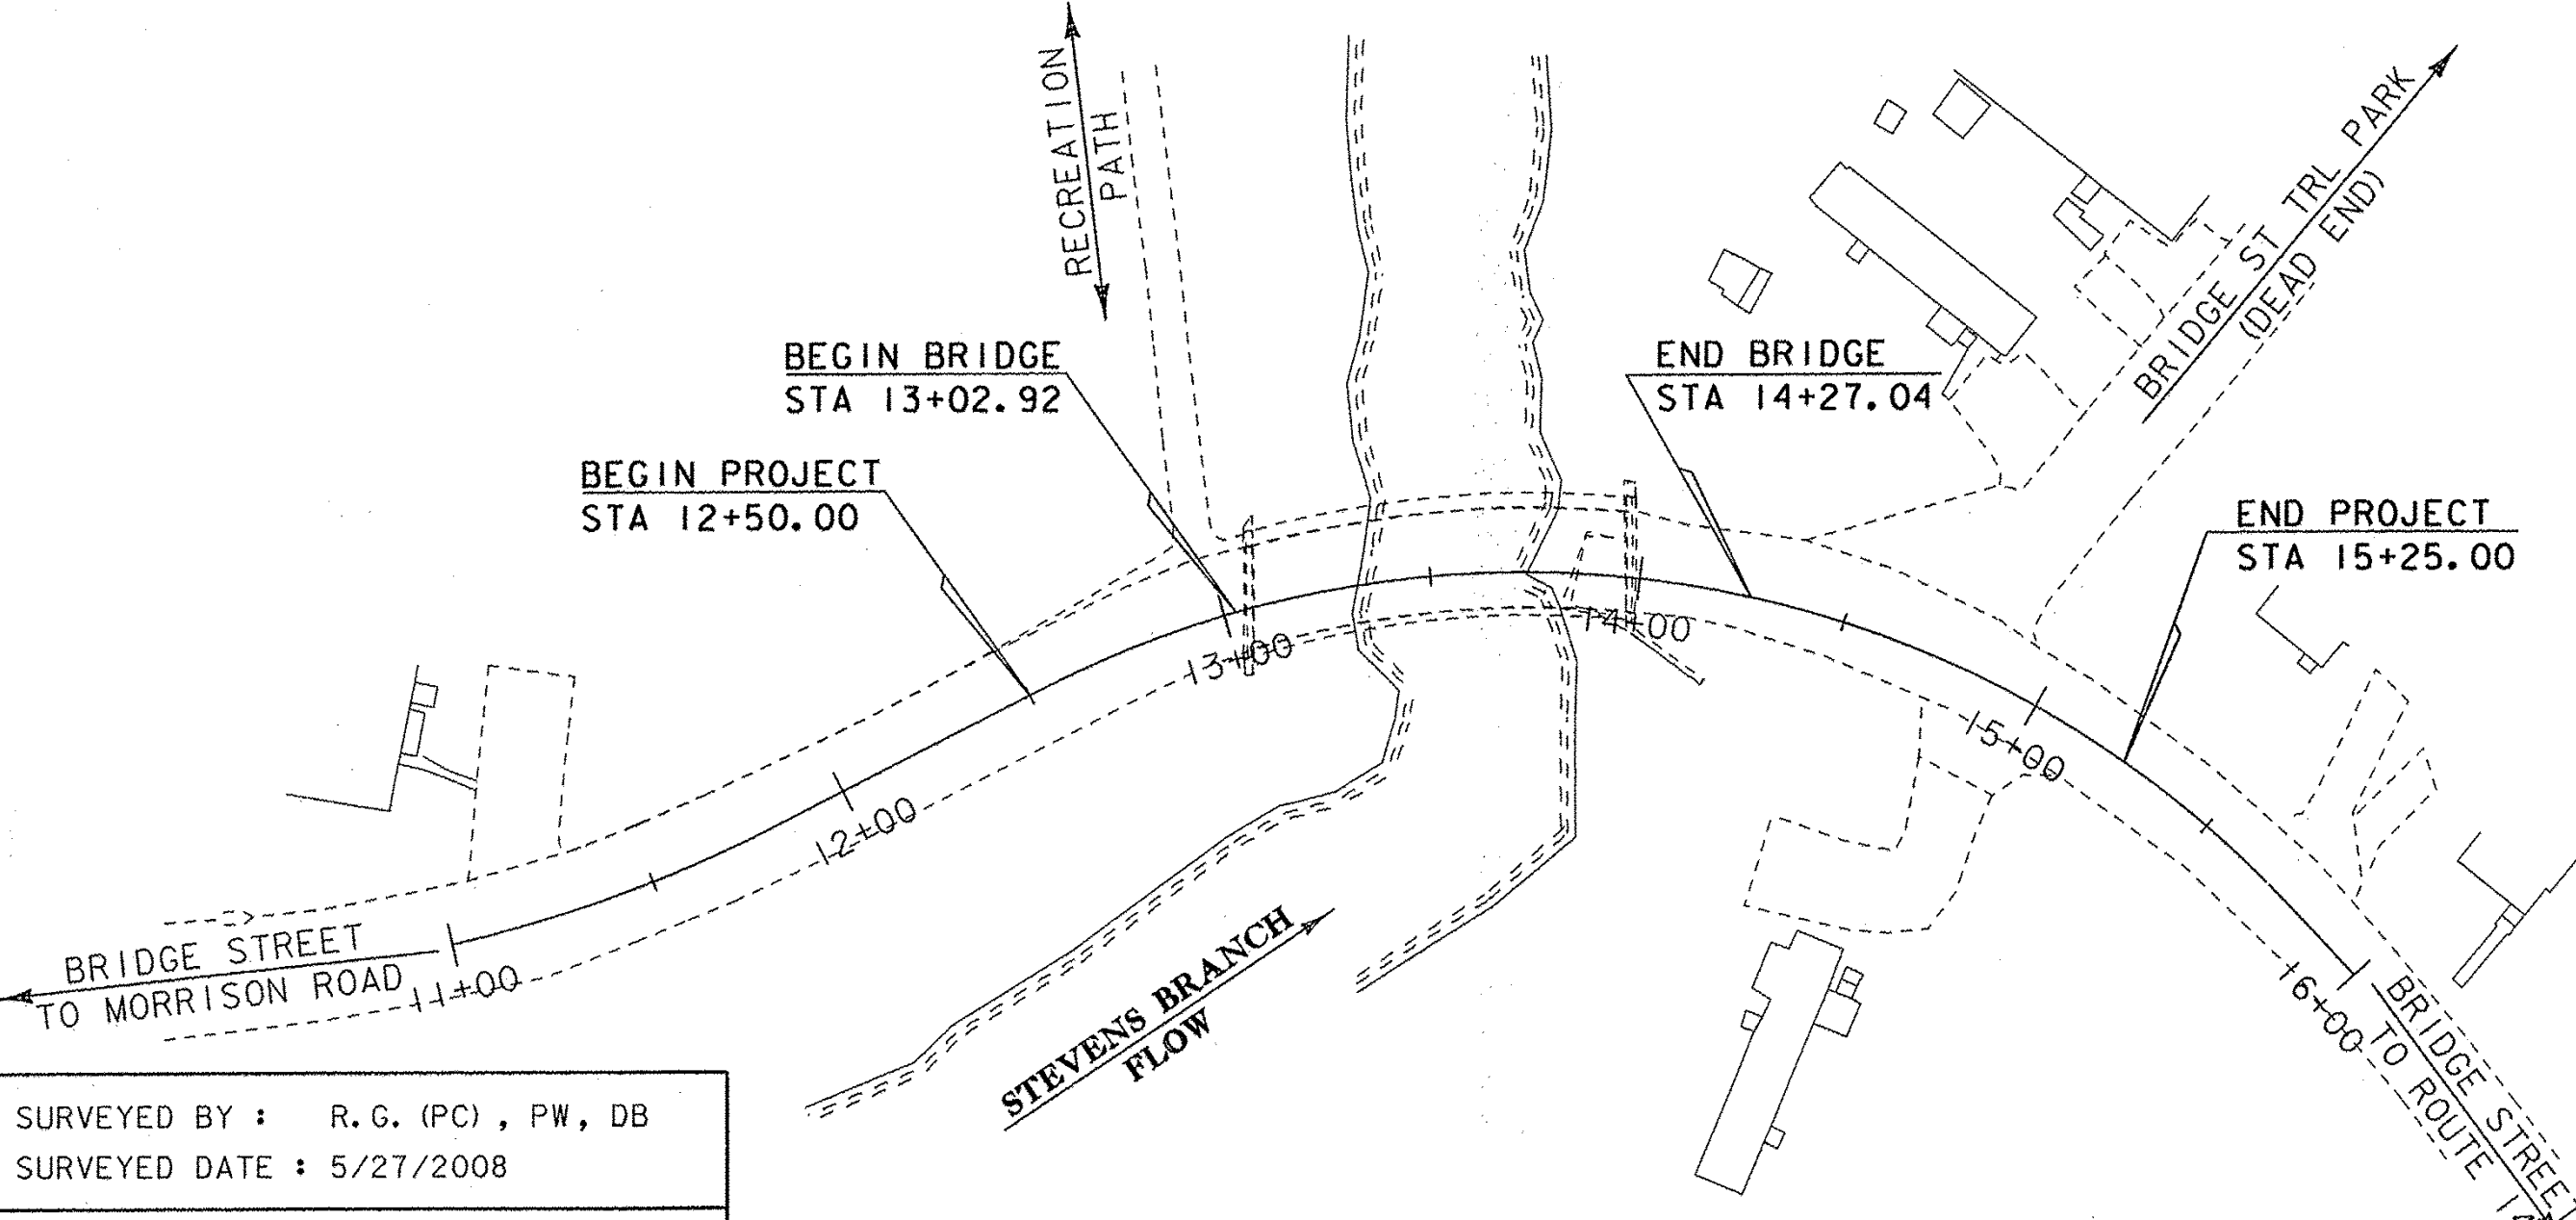

SURVEYED BY : R. G. (PC), PW, DB

SURVEYED DATE : 5/27/2008

DATUM

VERTICAL NAVD 88

HORIZONTAL NAD 83 (92)

SCALE 1" = 40'-0"

N

VT STATE PLANE GRID

THESE PLANS ARE SUBJECT TO SUCH ENGINEERING CHANGES AS MAY BE REQUIRED BY THE FEDERAL HIGHWAY ADMINISTRATION OR THE DIRECTOR OF PROGRAM DEVELOPMENT.

CONSTRUCTION IS TO BE CARRIED ON IN ACCORDANCE WITH THESE PLANS AND THE STANDARD SPECIFICATIONS FOR CONSTRUCTION DATED 2011, AS APPROVED BY THE FEDERAL HIGHWAY ADMINISTRATION ON JULY 20, 2011 FOR USE ON THIS PROJECT, INCLUDING ALL SUBSEQUENT REVISIONS AND SUCH REVISED SPECIFICATIONS AND SPECIAL PROVISIONS AS ARE INCORPORATED IN THESE PLANS.

DIRECTOR OF PROGRAM DEVELOPMENT

APPROVED *Pete Hodgson* DATE *2-26-12*

PROJECT MANAGER : J. LACROIX

PROJECT NAME : BARRE TOWN

PROJECT NUMBER : BRF 6100 (7)

SHEET 1 OF 70 SHEETS