



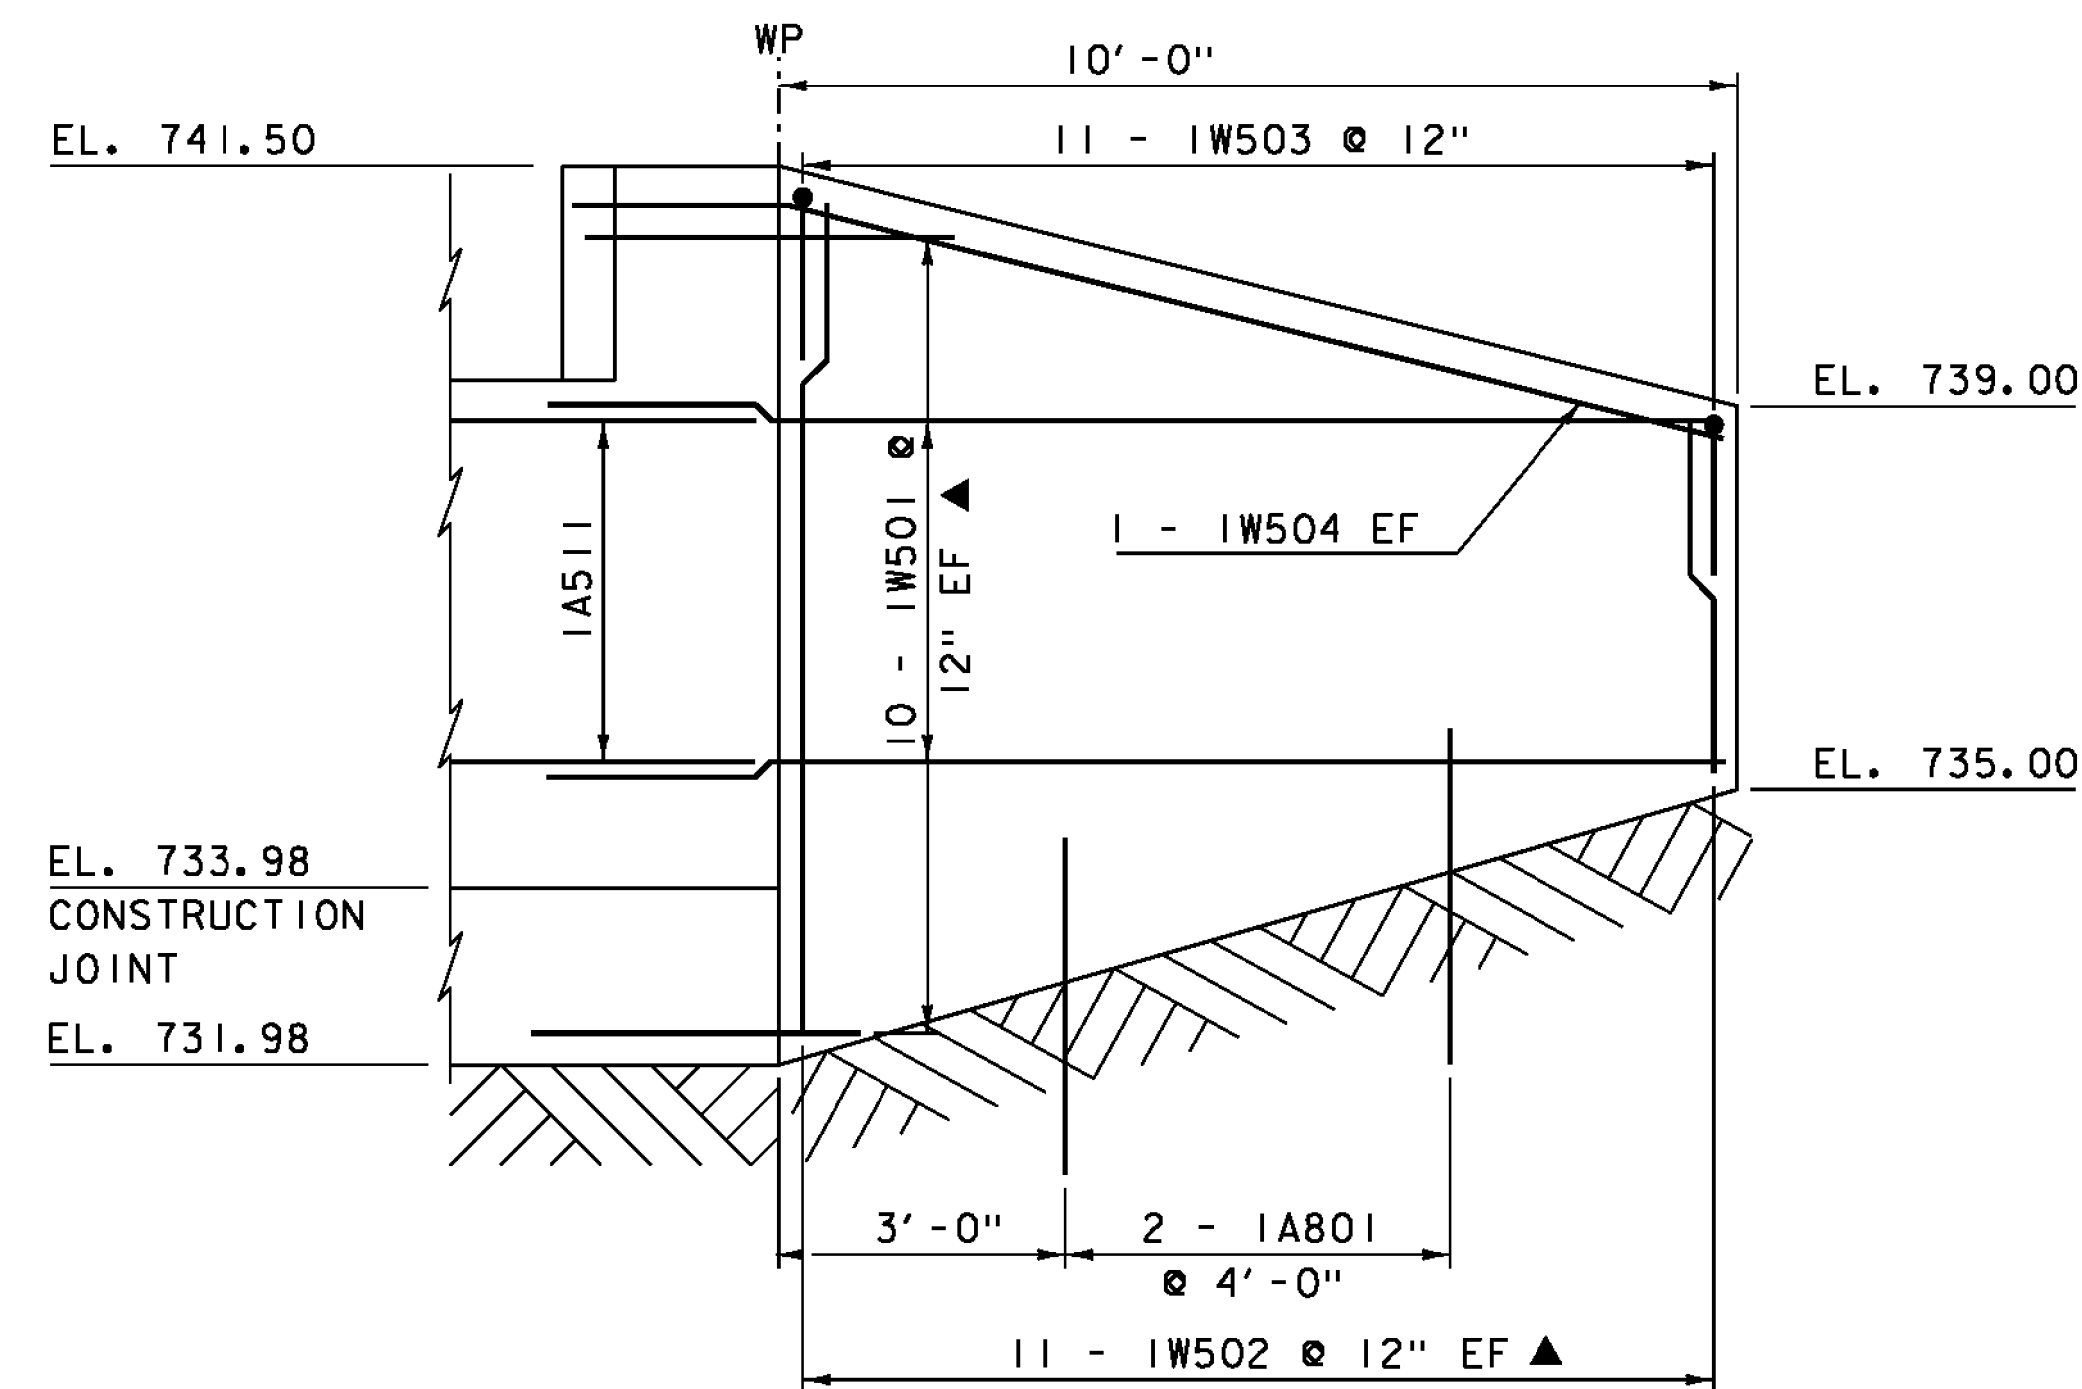


WINGWALL 1 ELEVATION

SCALE 1/2" = 1' - 0"

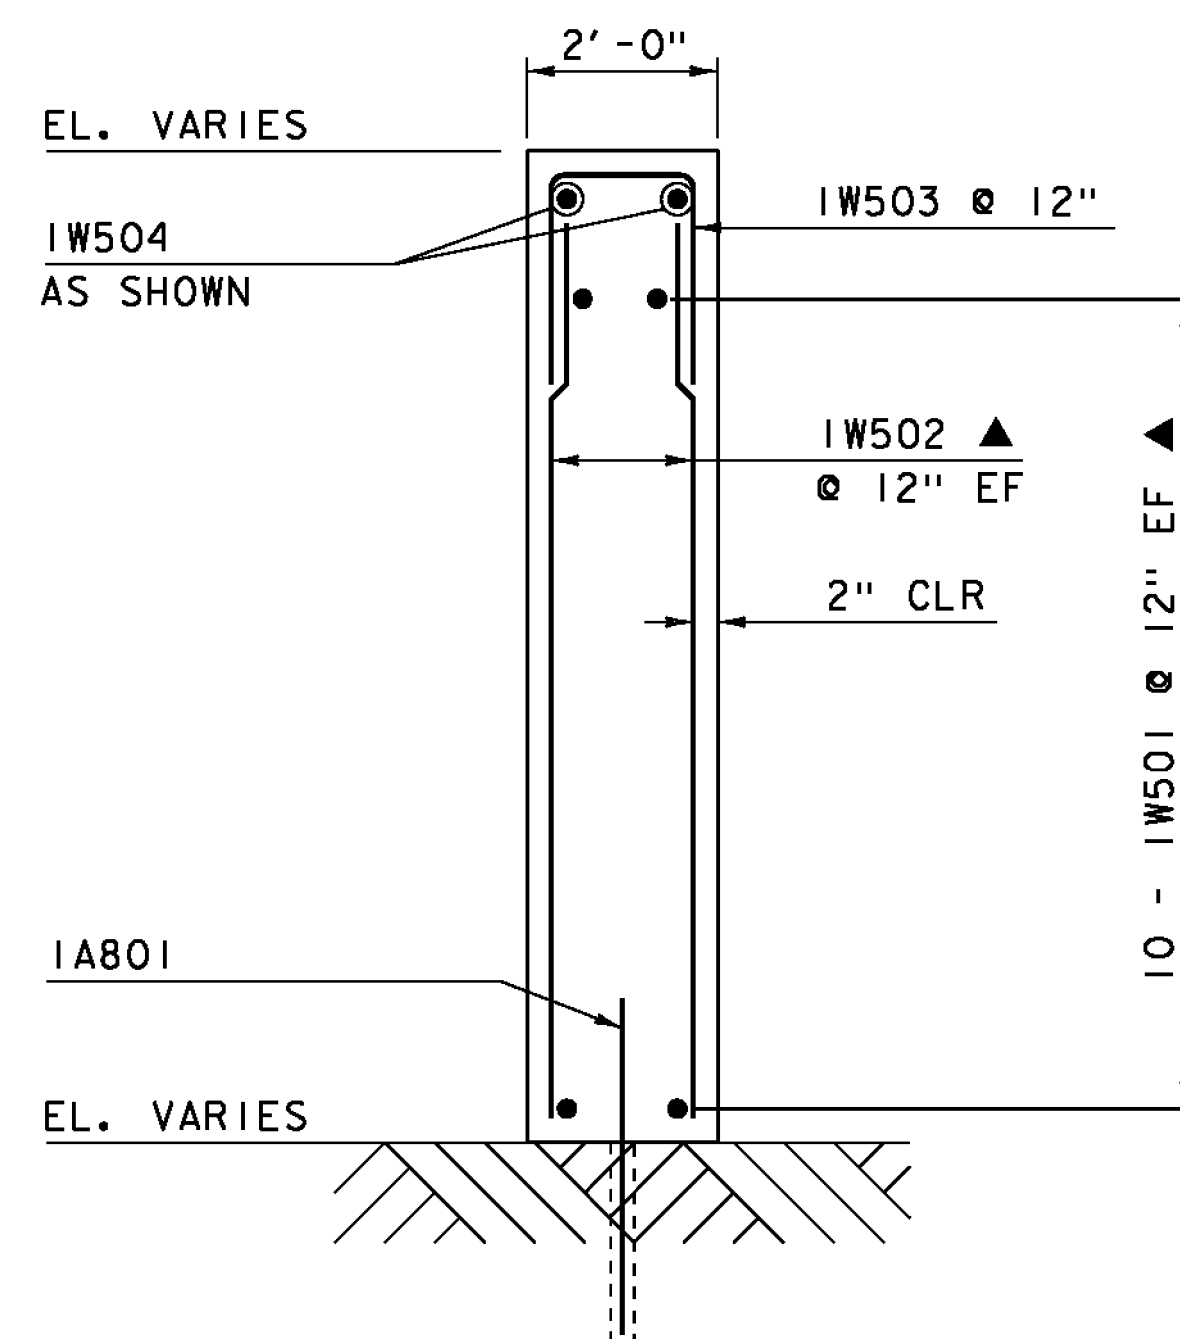


WINGWALL 1
TYPICAL SECTION

SCALE 1/2" = 1' - 0"

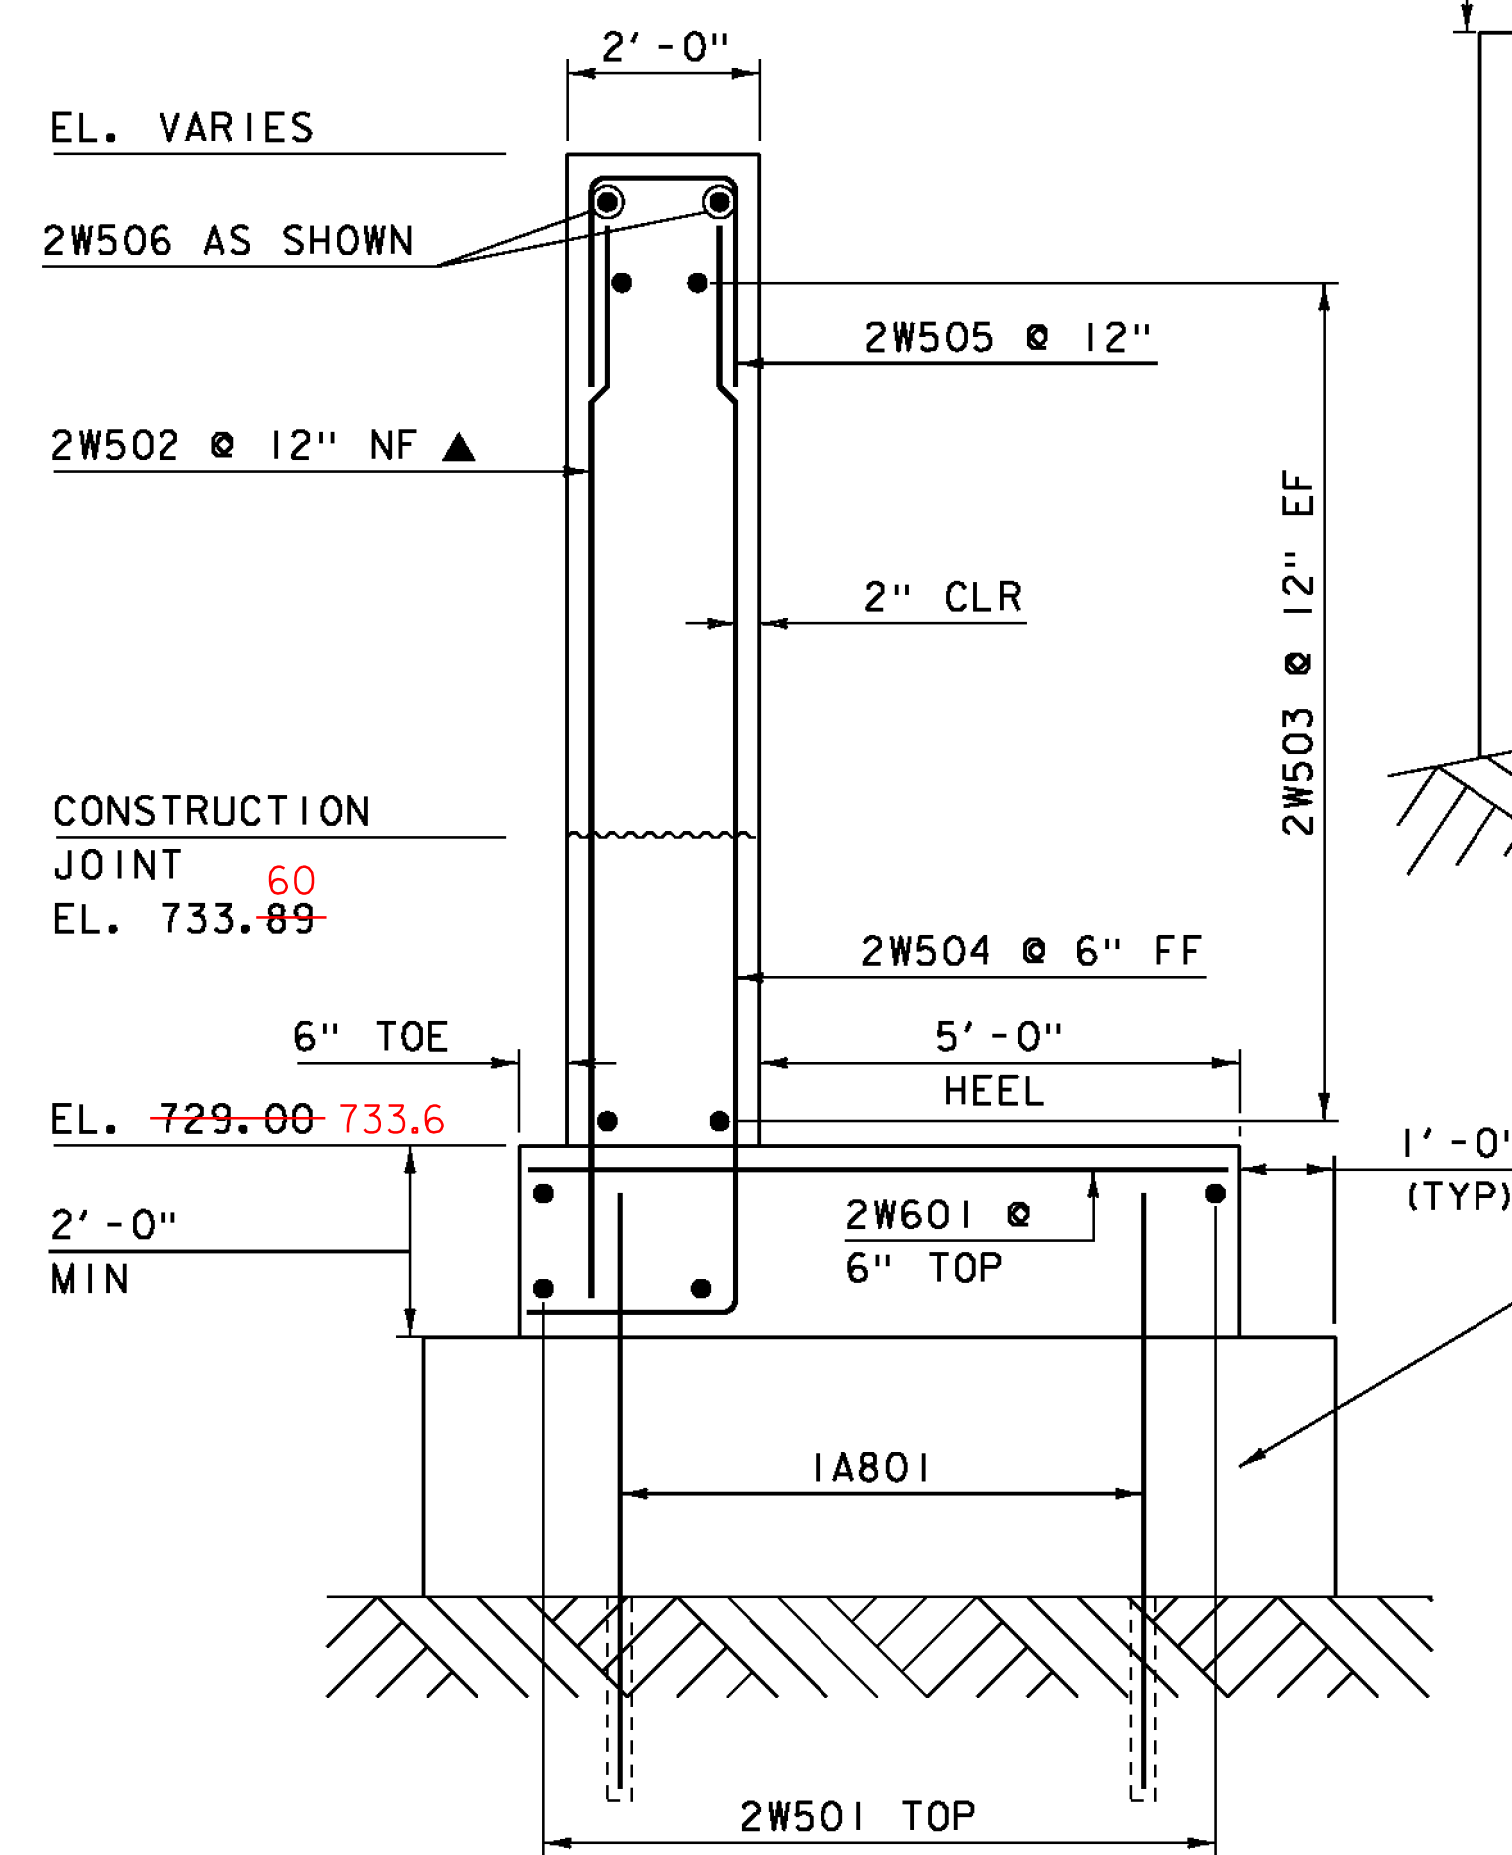

WINGWALL 2
TYPICAL SECTION

SCALE 1/2" = 1' - 0"

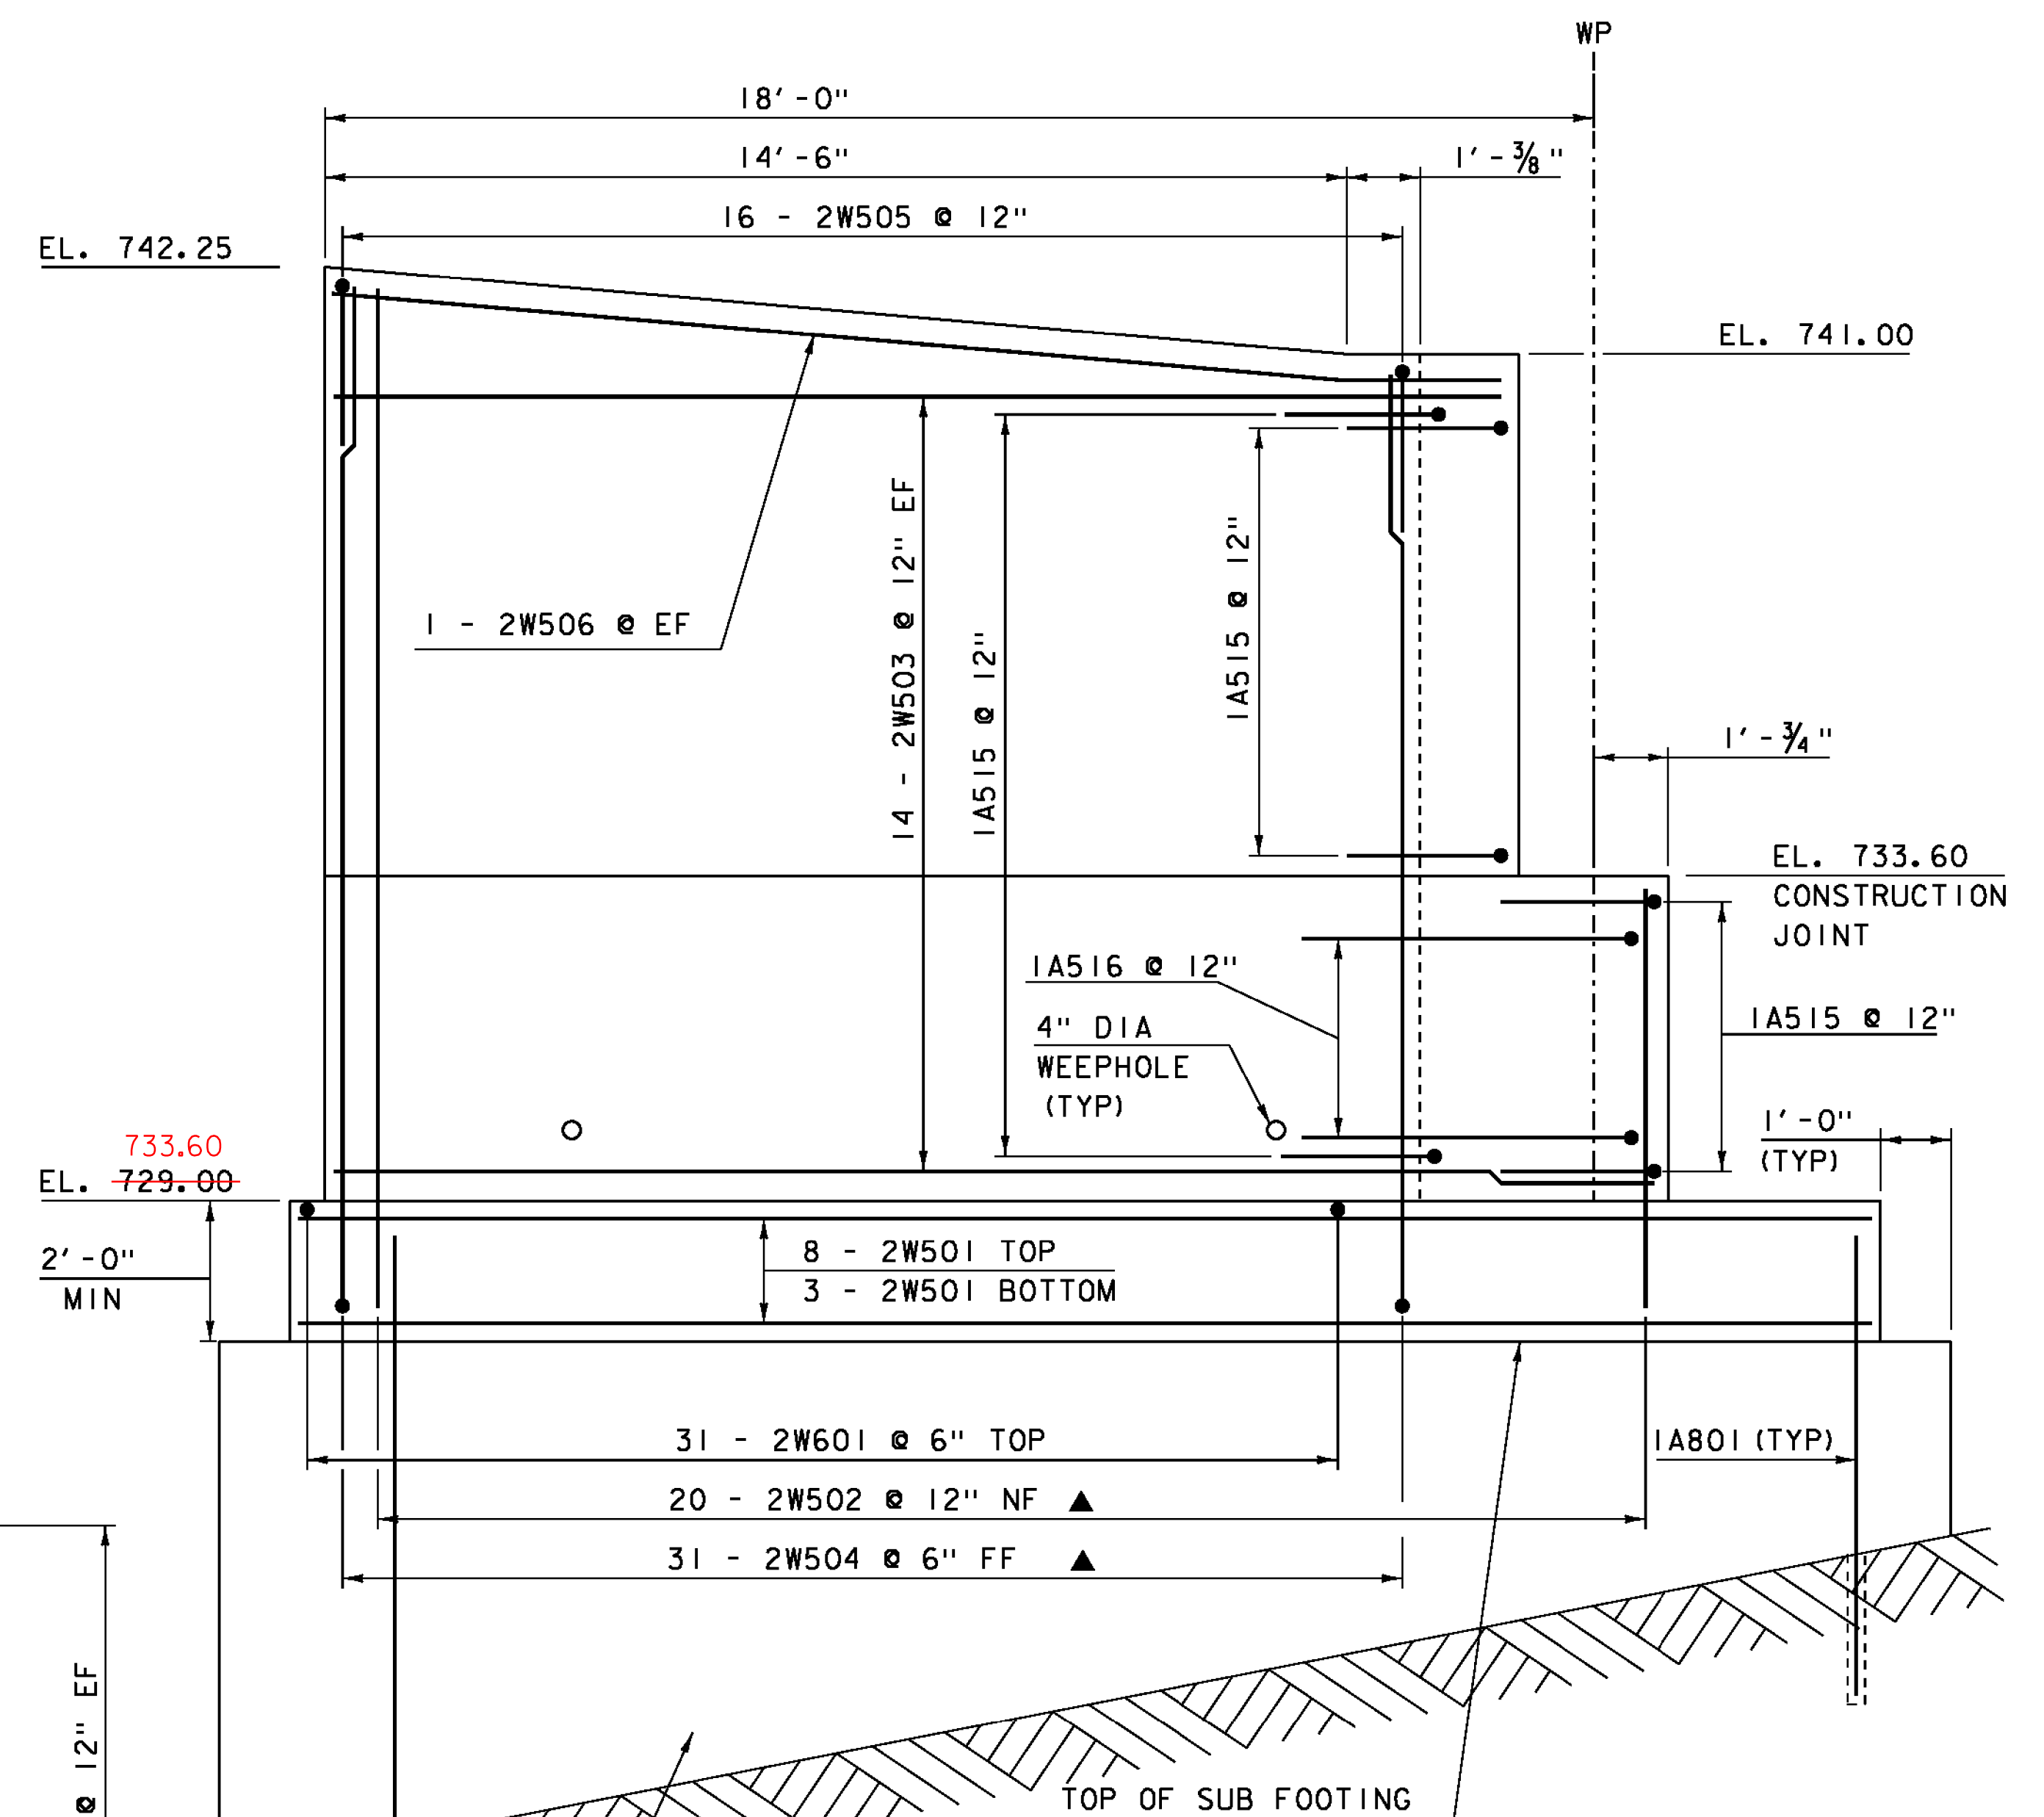

WINGWALL 2 ELEVATION

SCALE 1/2" = 1' - 0"

NOTE:

NF = NEAR FACE
FF = FAR FACE
EF = EACH FACE
E = LEVEL 2 REINFORCING STEEL
▲ = CUT TO FIT IN FIELD
3" CLEAR, UNLESS OTHERWISE SPECIFIED ON THE PLANS.
2'-2" BAR LAP UNLESS OTHERWISE SPECIFIED ON THE PLANS.

PROJECT NAME: BARRE TOWN
PROJECT NUMBER: BRP 6100(7)

FILE NAME: s06J002sub.dgn
PROJECT LEADER: J. LACROIX
DESIGNED BY: J. LACROIX
WING WALL 1&2

PLOT DATE: 27-SEP-2012
DRAWN BY: R. PELLETT
CHECKED BY: J. SALVATORI
SHEET 46 OF 70