



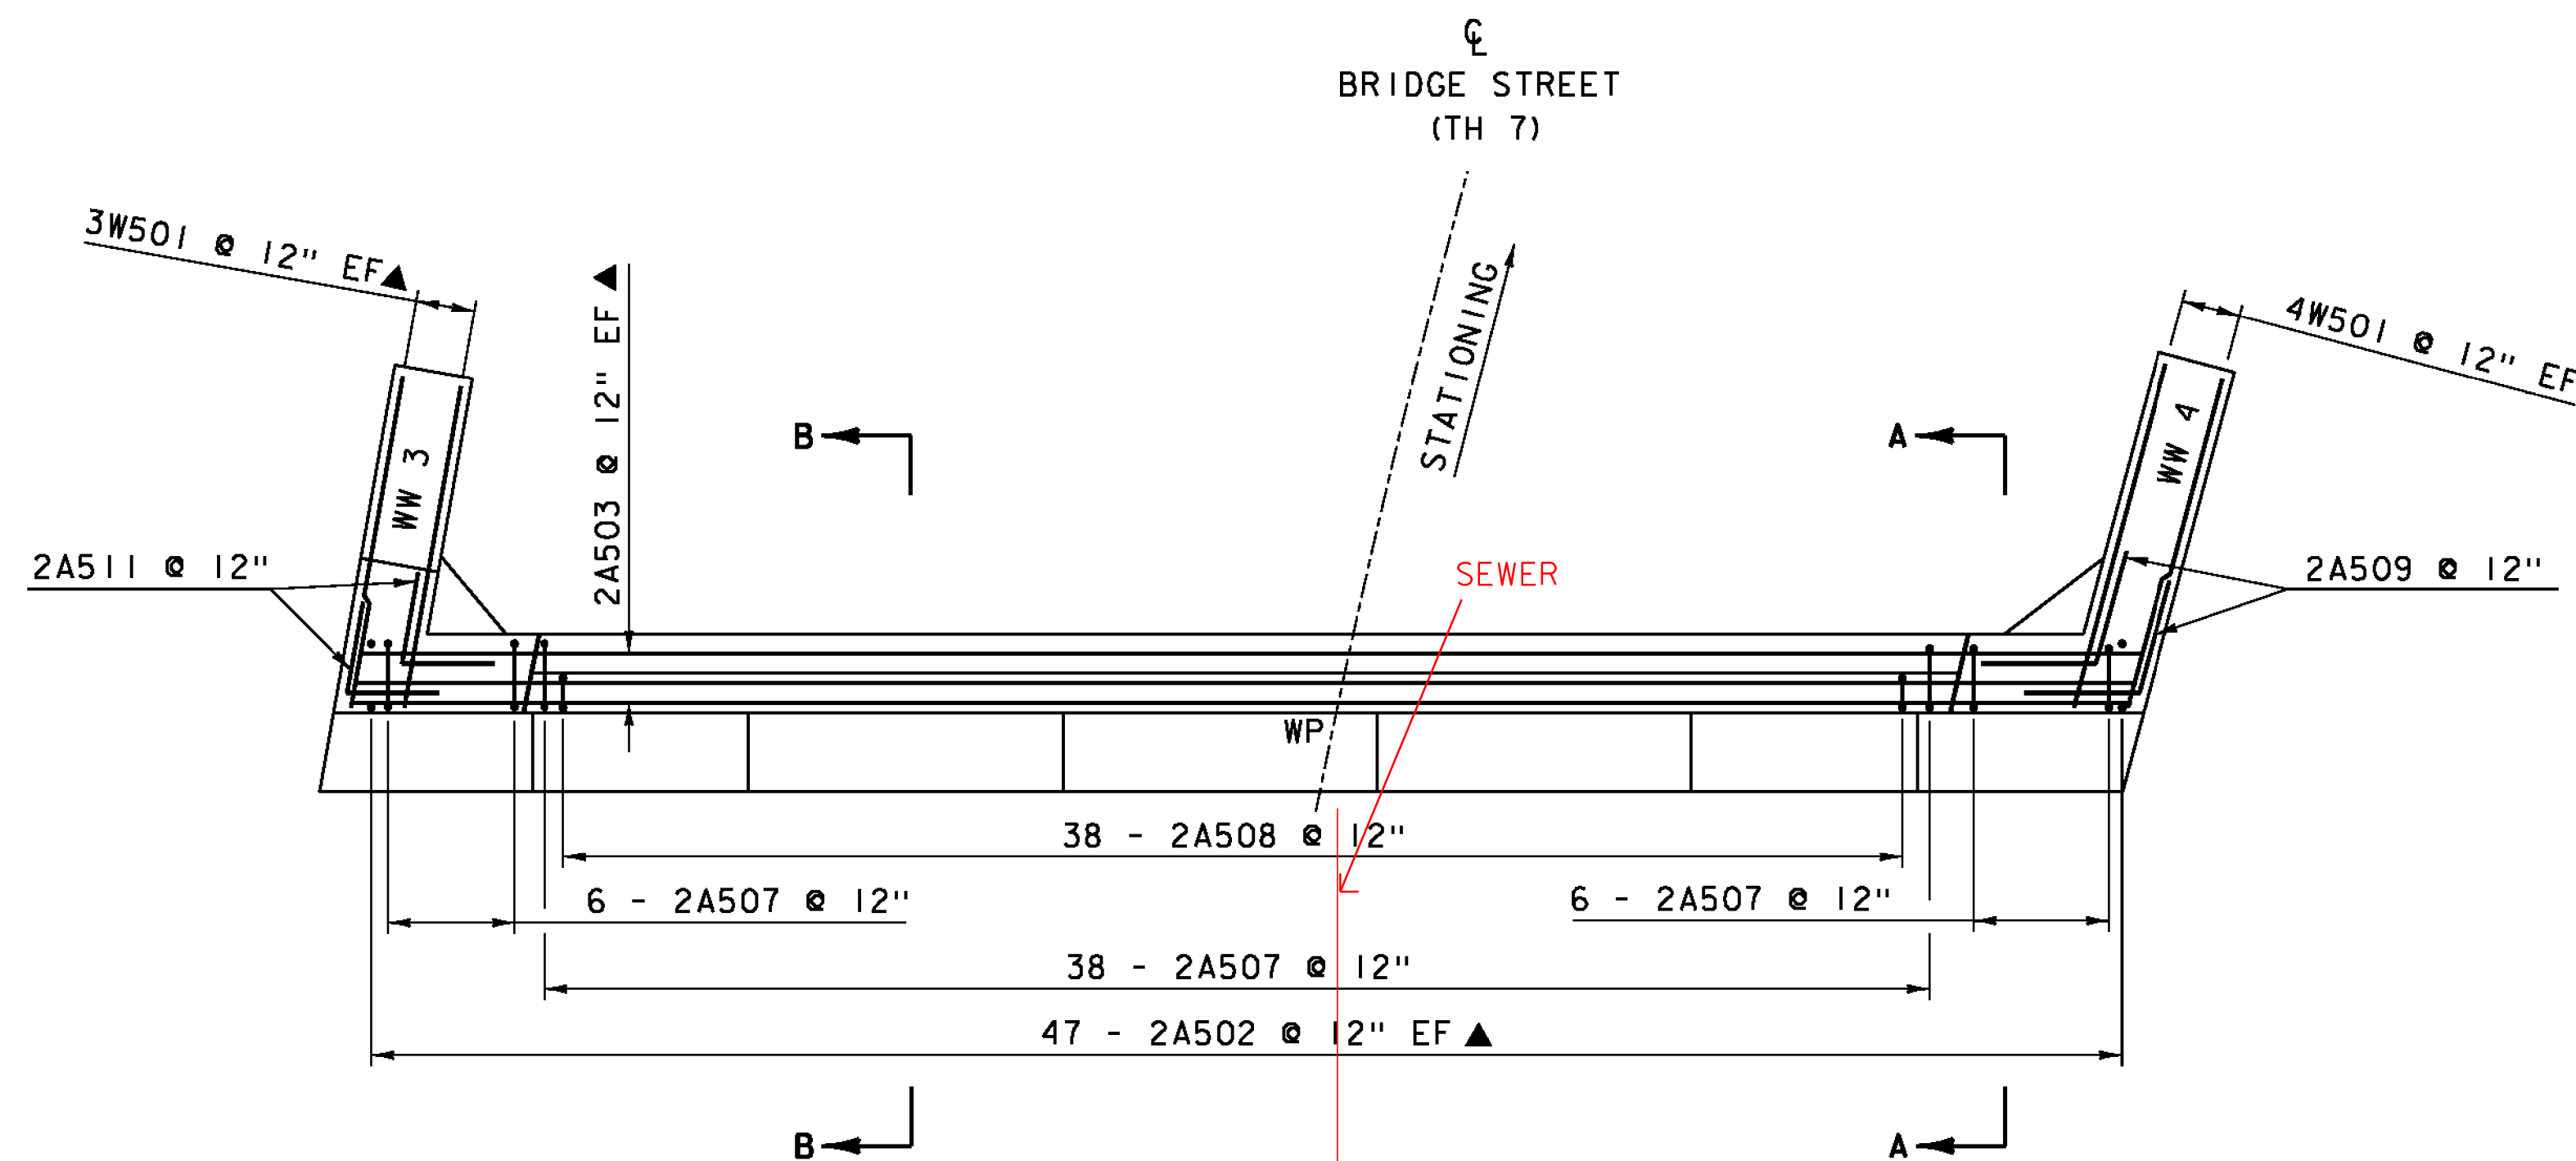

ABUTMENT 2 BACKWALL REINFORCING PLAN VIEW


SCALE $\frac{1}{4}'' = 1' - 0''$

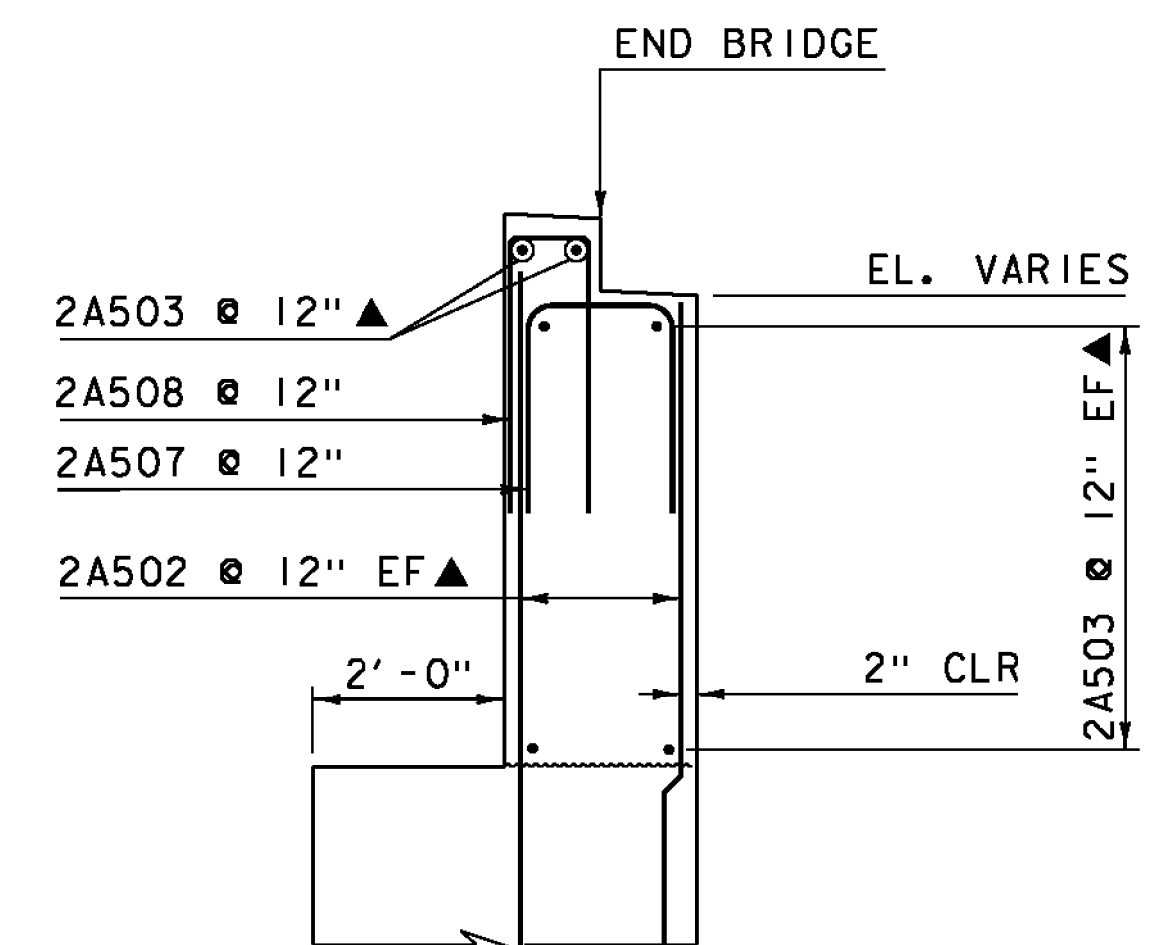

ABUTMENT 2 BACKWALL


SECTION B-B

SCALE $\frac{1}{2}'' = 1' - 0''$

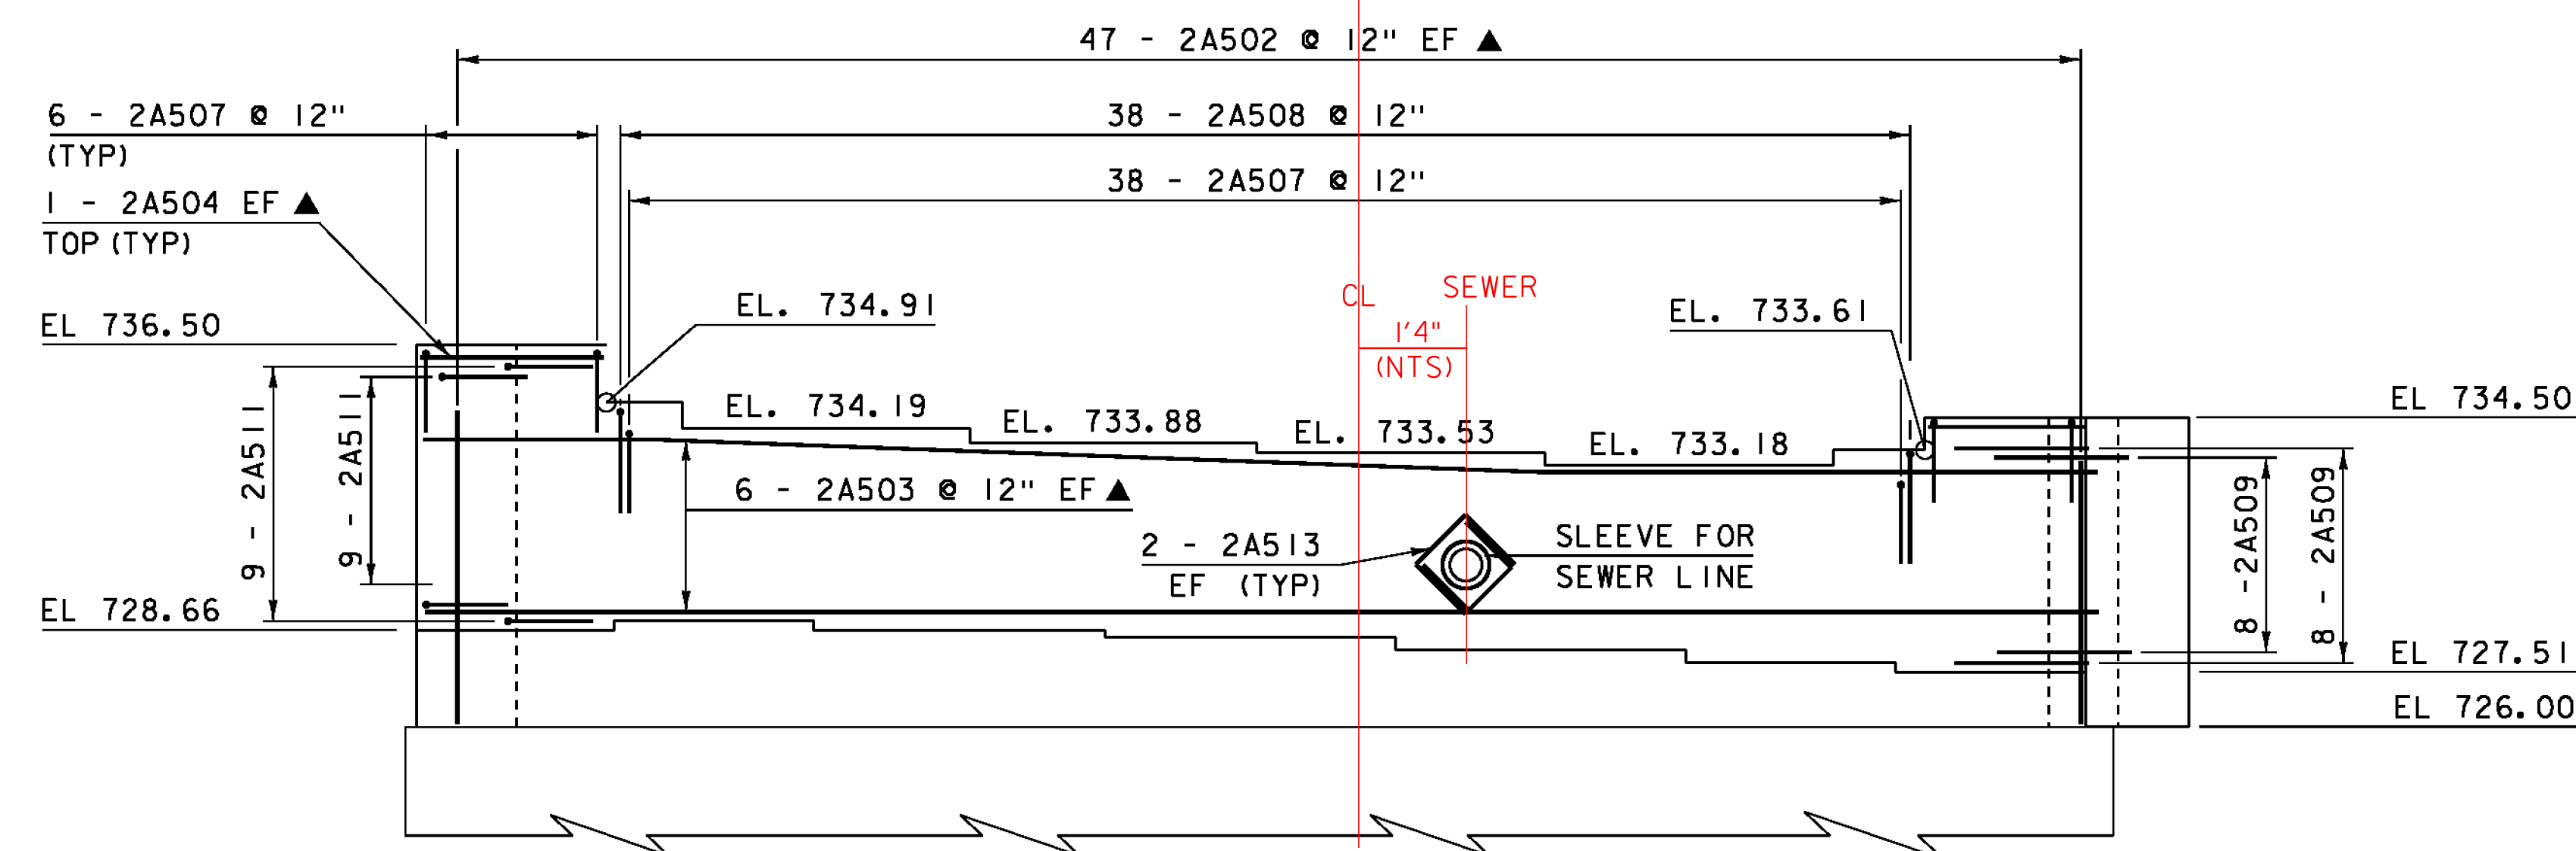

ABUTMENT 2 BACKWALL REINFORCING ELEVATION VIEW

SCALE $\frac{1}{4}'' = 1' - 0''$

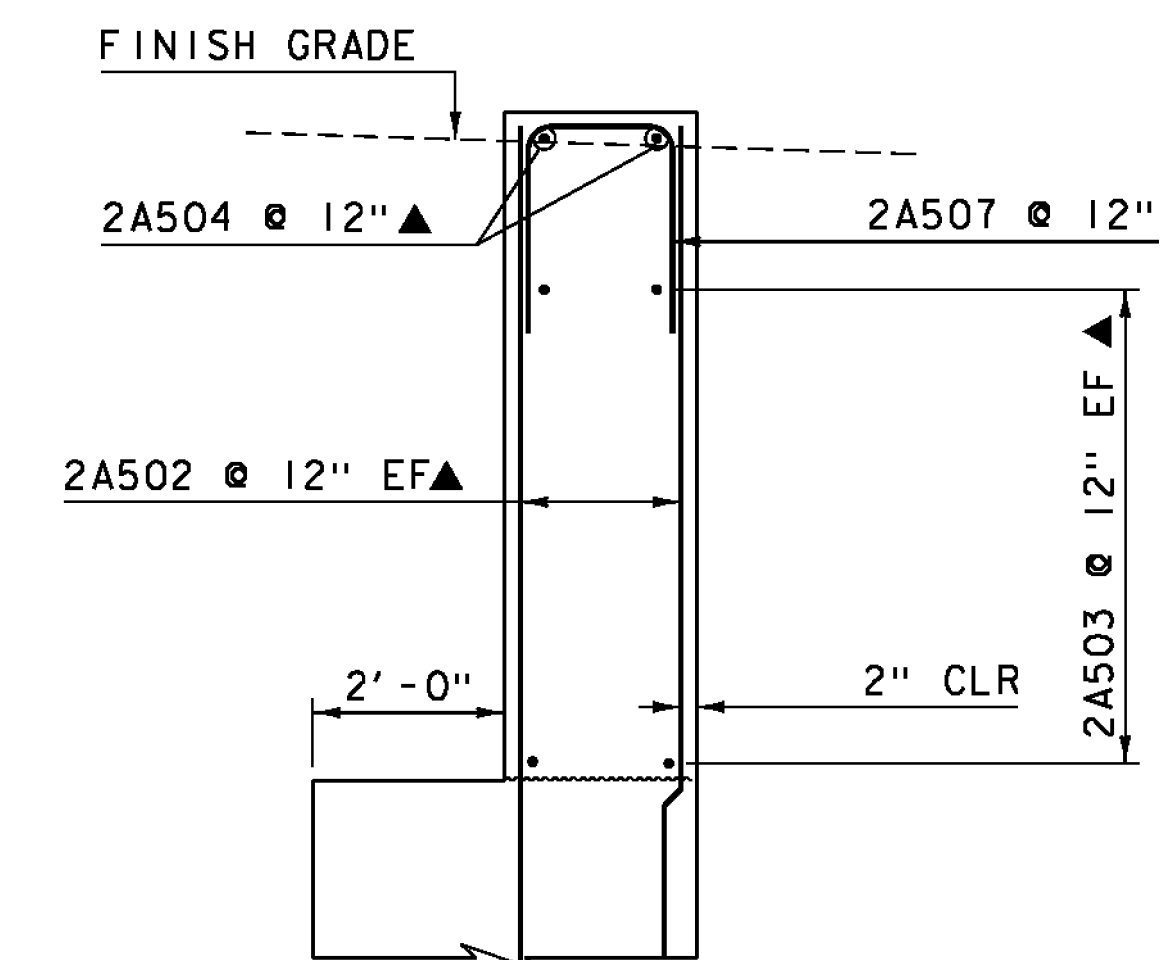

ABUTMENT 2 BACKWALL

SECTION A-A

SCALE $\frac{1}{2}'' = 1' - 0''$

NOTE:

NF = NEAR FACE
FF = FAR FACE
EF = EACH FACE
E = LEVEL 2 REINFORCING STEEL
▲ = CUT TO FIT IN FIELD
3" CLEAR, UNLESS OTHERWISE
SPECIFIED ON THE PLANS.
2'-2" BAR LAP UNLESS OTHERWISE
SPECIFIED ON THE PLANS.

PROJECT NAME: BARRE TOWN
PROJECT NUMBER: BR 6100 (7)

FILE NAME: s06j002sub2.dgn
PROJECT LEADER: J. LACROIX
DESIGNED BY: T. FILLBACH
ABUTMENT 2 BACKWALL DETAILS

PLOT DATE: 27-SEP-2012
DRAWN BY: K. FRIEDLAND
CHECKED BY: J. SALVATORI
SHEET 51 OF 70