


ENGLISH

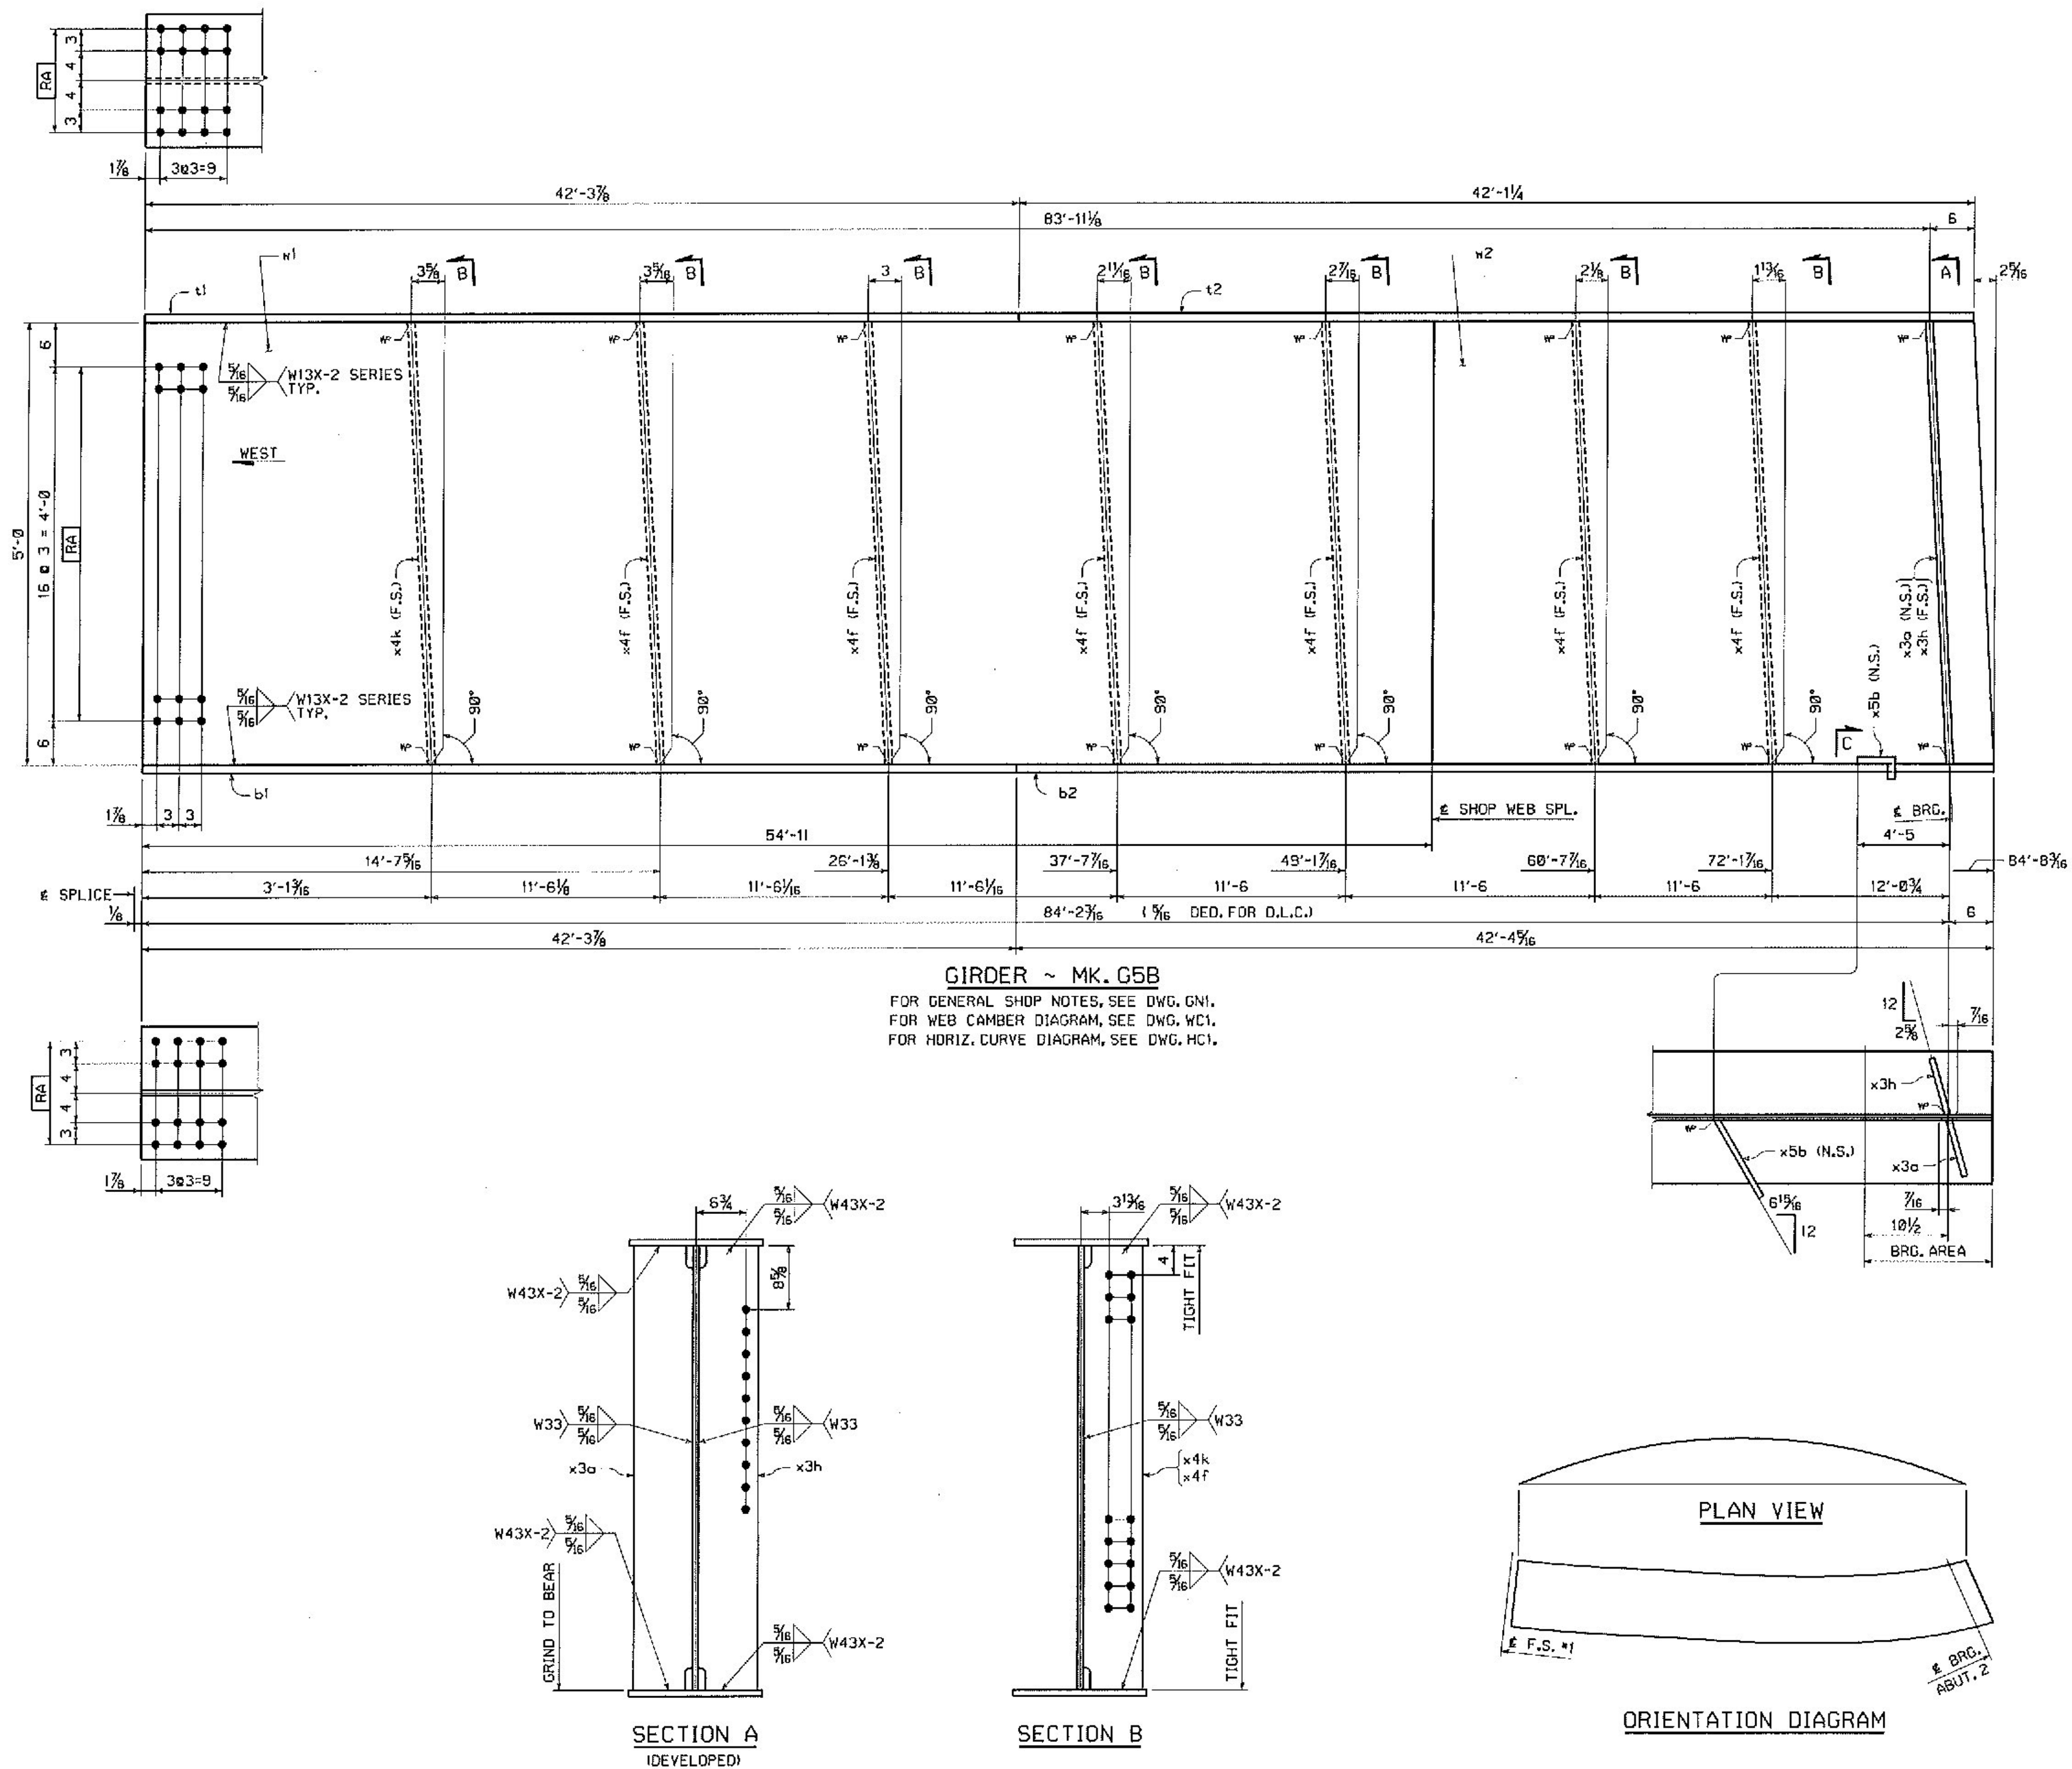


Vermont Agency of Transportation
RECEIVED

CK'D BY J. CLARK OK'D BY J. GRIFFIN

February 12, 2013

RESUBMIT NO Approved
 BY J. LACROIX DATE 02/25/2013

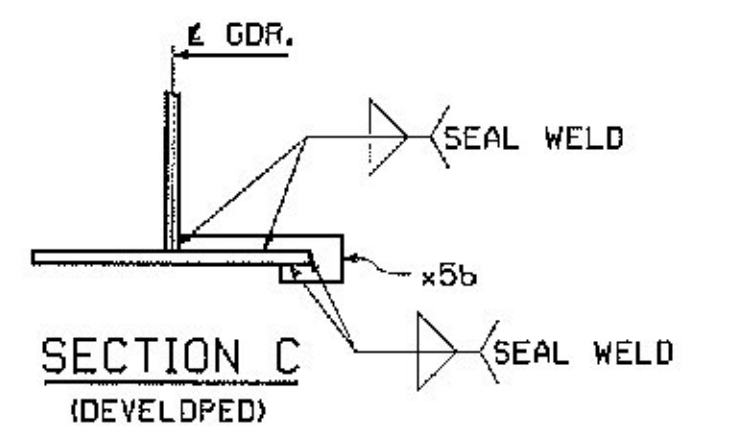

NO.	REVISION	BY	CHK'D	DATE
1				
2				
