


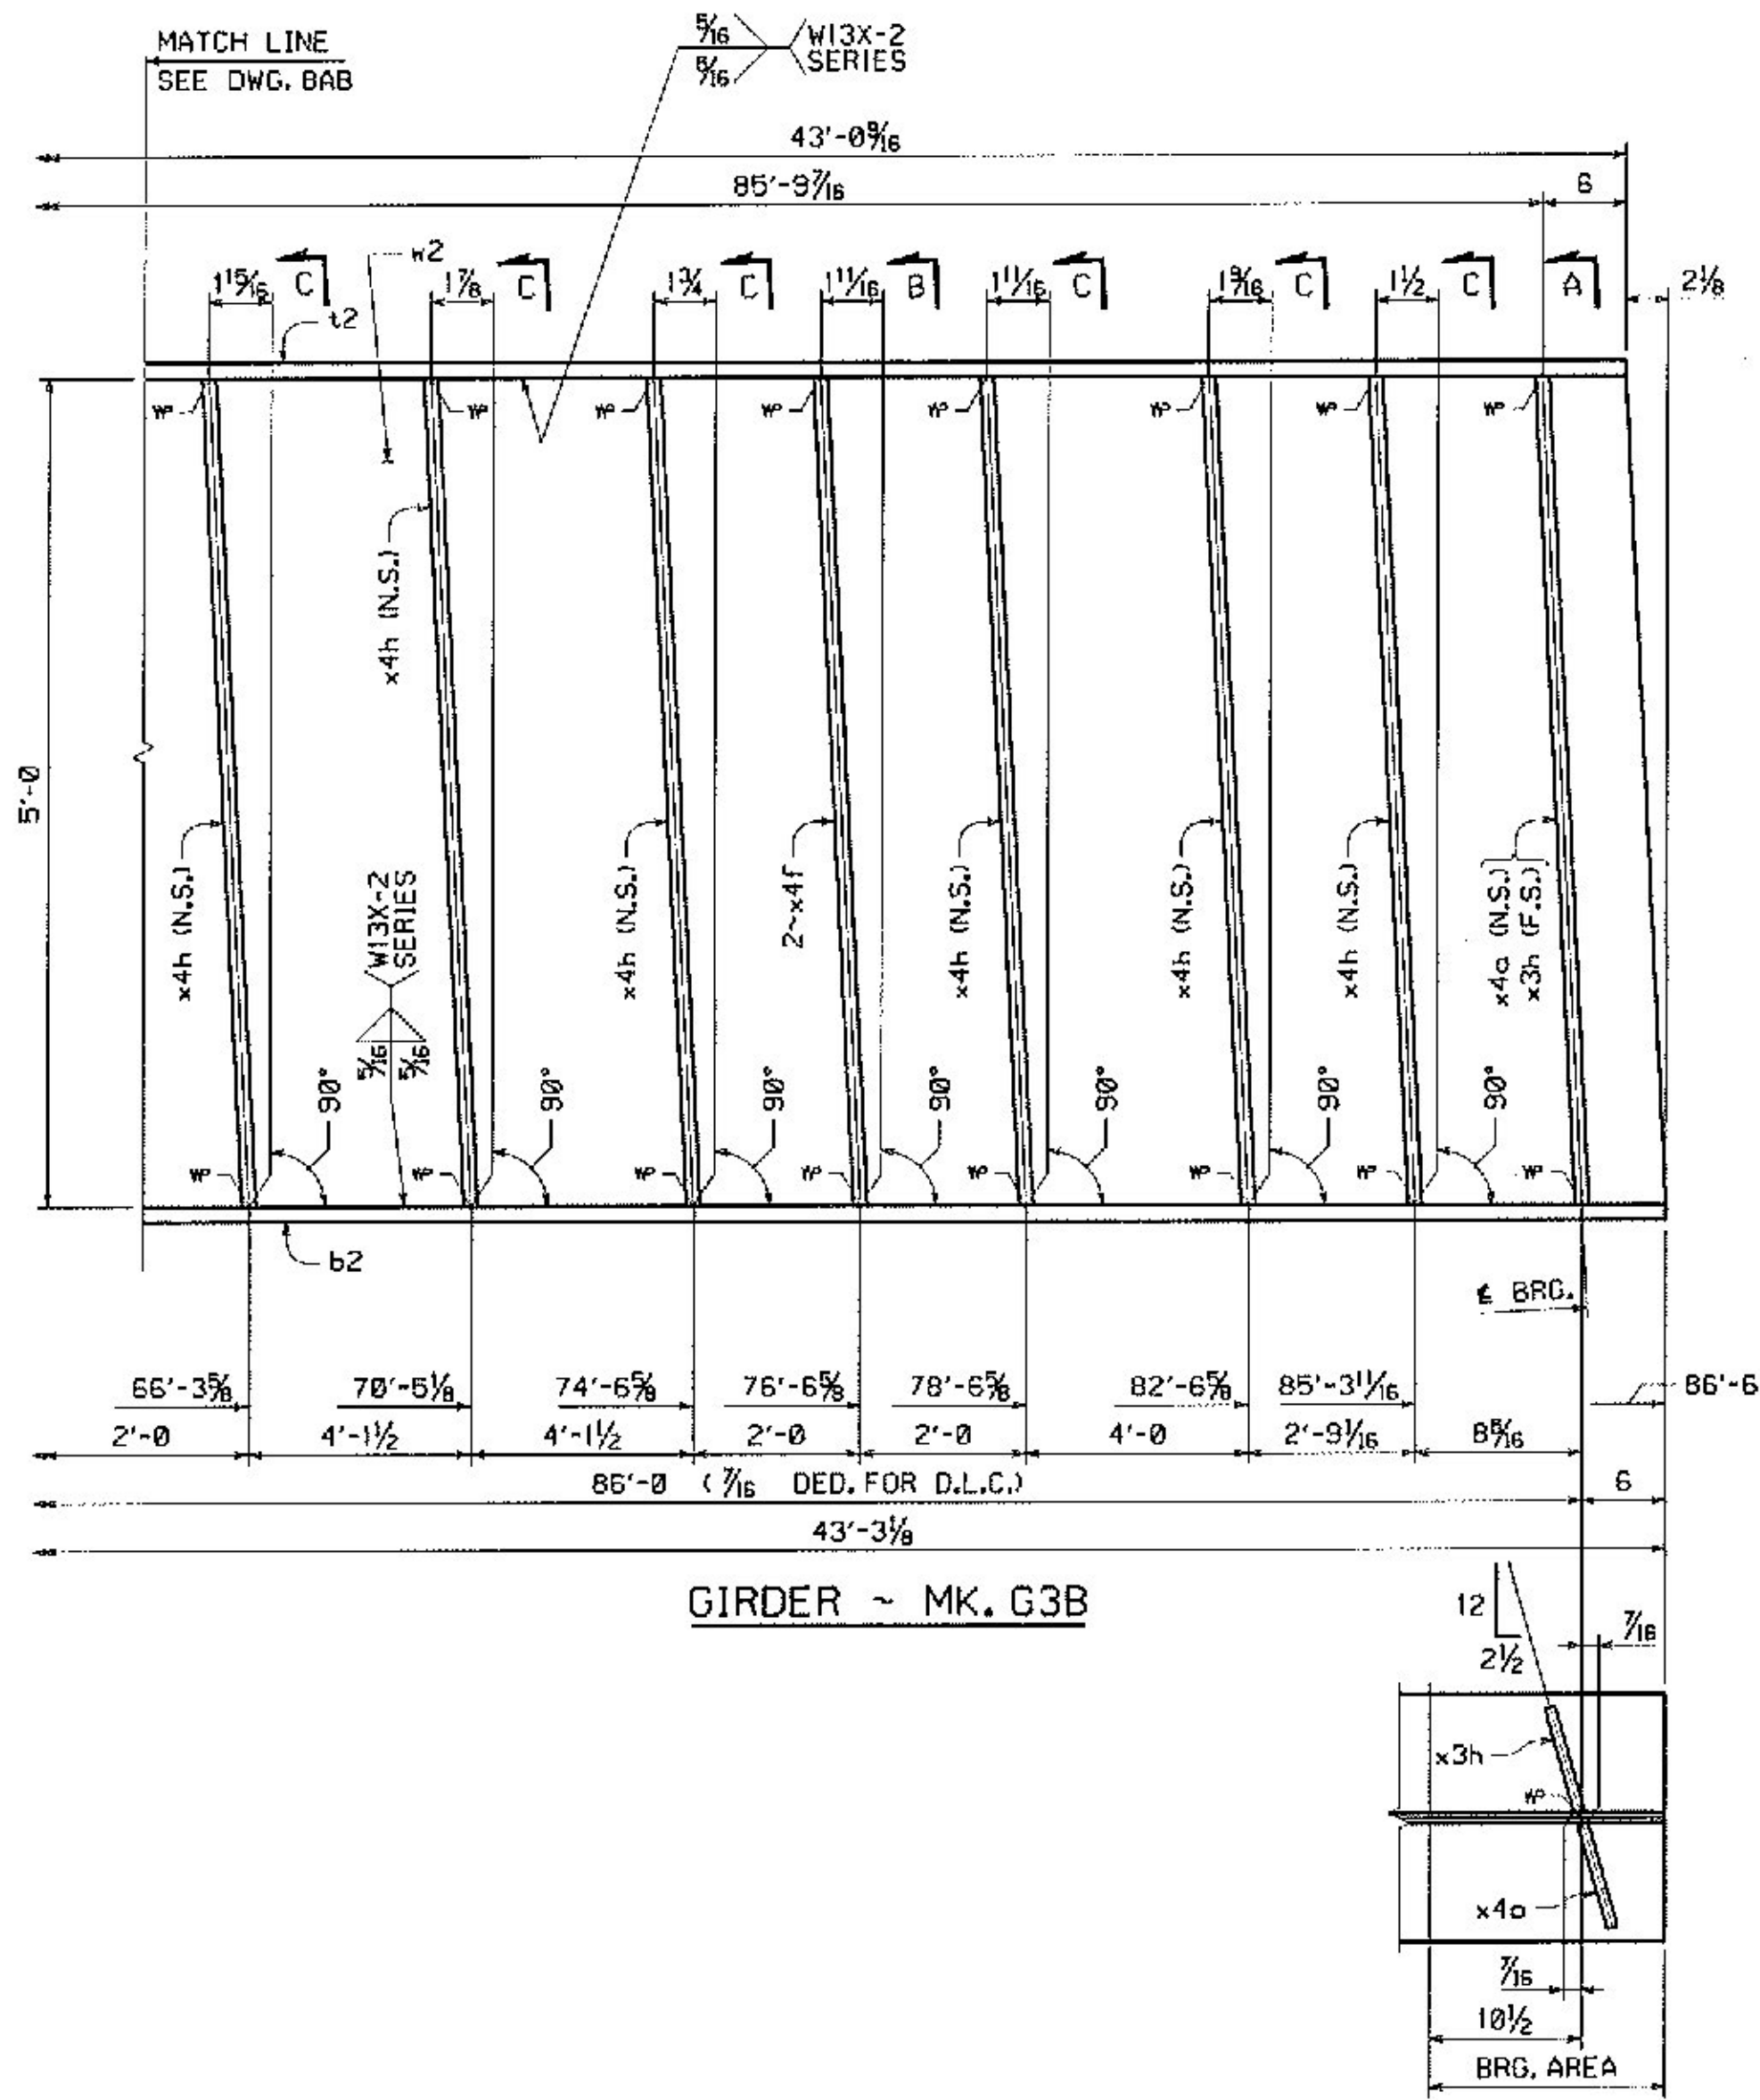

BILL OF MATERIAL											
QTY EA.	MARK	CONV	DESCRIPTION	LENGTH	SPEC	GRADE	TEST	REMARKS	ITEM	SNP W.T. EA. (LBS)	
1	G3B		GIRDER							22955	
1	w1	PL	5/8 x 60	54	11 1/16	M270	50W	T	03002		
1	w2	PL	5/8 x 60	31	6 15/16	M270	50W	T	03008		
1	t1	PL	7/8 x 18	43	2 7/8	M270	50W	T	04009		
1	t2	PL	7/8 x 18	43	0 9/16	M270	50W	T	04010		
1	b1	PL	7/8 x 18	43	2 7/8	M270	50W	T	04009		
1	b2	PL	7/8 x 18	43	3 1/8	M270	50W	T	04009		
1	x3h	PL	3/4 x 8	5	0 1/32	M270	50W	T	07001		
1	x4a	PL	3/4 x 8	5	0 1/32	M270	50W	T	07001		
12	x4f	PL	1/2 x 8	5	0 1/16	M270	50W	T	07002		
19	x4h	PL	1/2 x 8	5	0 1/16	M270	50W	T	07002		
2	x4k	PL	1/2 x 8	5	0 1/8	M270	50W	T	07002		
3	x4n	PL	1/2 x 8	5	0 1/8	M270	50W	T	07002		

Vermont Agency of Transportation

RECEIVED

CK'D BY J. CLARK OK'D BY J. GRIFFIN

February 12, 2013

RESUBMIT NO Approved
BY J. LACROIX DATE 02/25/2013

NO.	REVISION	BY	CHK'D	DATE
HOLES 15/16" (U.N.)				
BOLTS				
NONE				
COATING				
NONE				
CODES				
30				
SCALE N.T.S.	STATE CONT. OR REF. NO.	FED. AID PROJ. NO.	HSSJ PROJ. MGR	KEN GLIDDEN
DRAWING MANAGER	JOSH MURRY (IH)	MADE BY	CDS	CHK'D BY
HSSJ PROJECT NUMBER	S-1120266A-1	DRAWING NUMBER	8B	OF 14

NOTES:
WORK THIS DRAWING WITH DRAWING 8AB.