



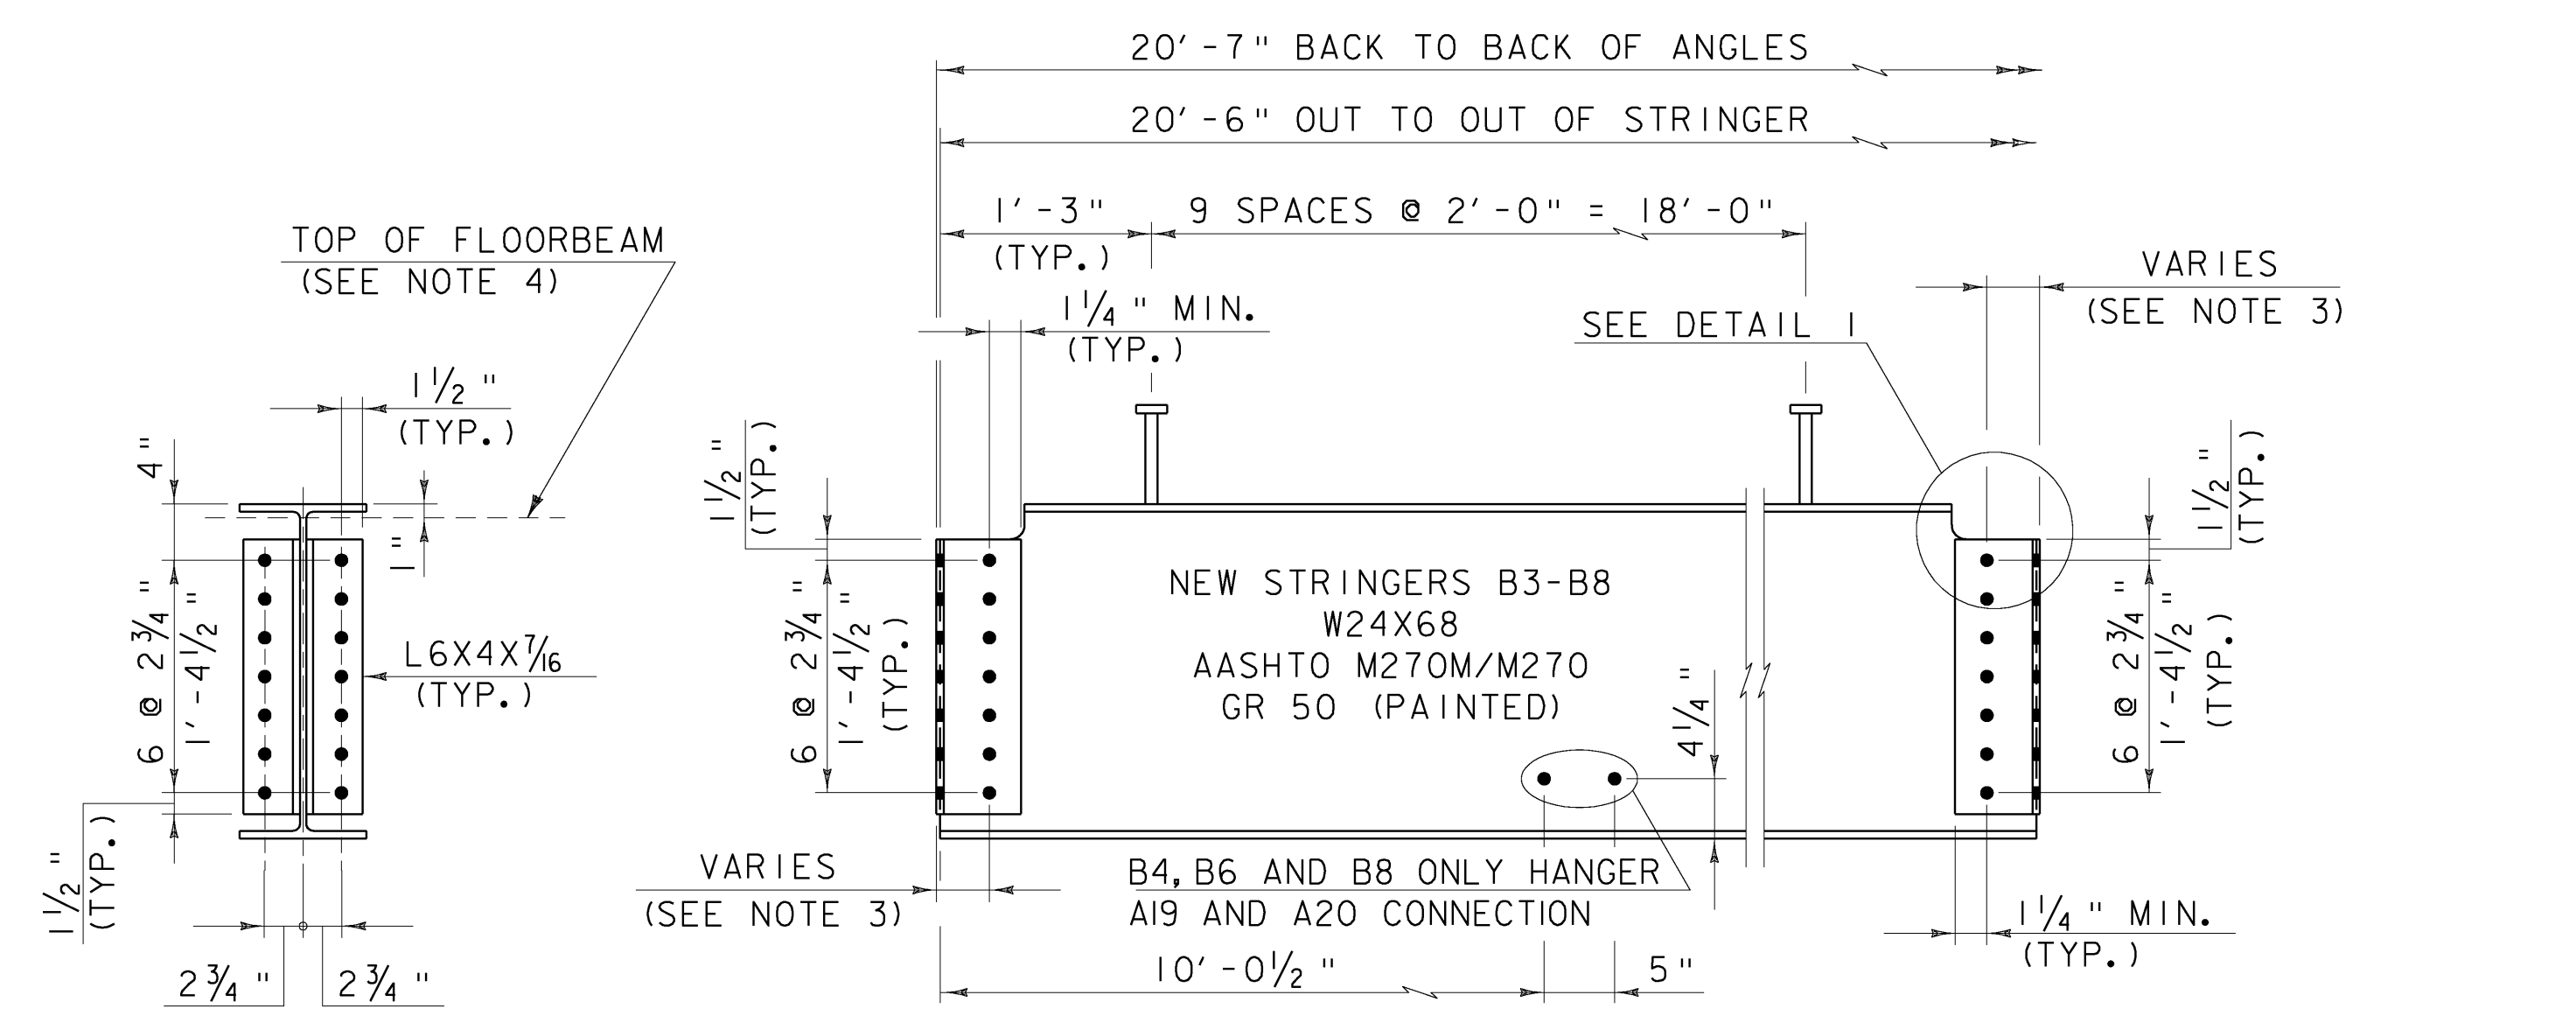


STRINGERS B3-B8

SCALE 1" = 1' - 0"

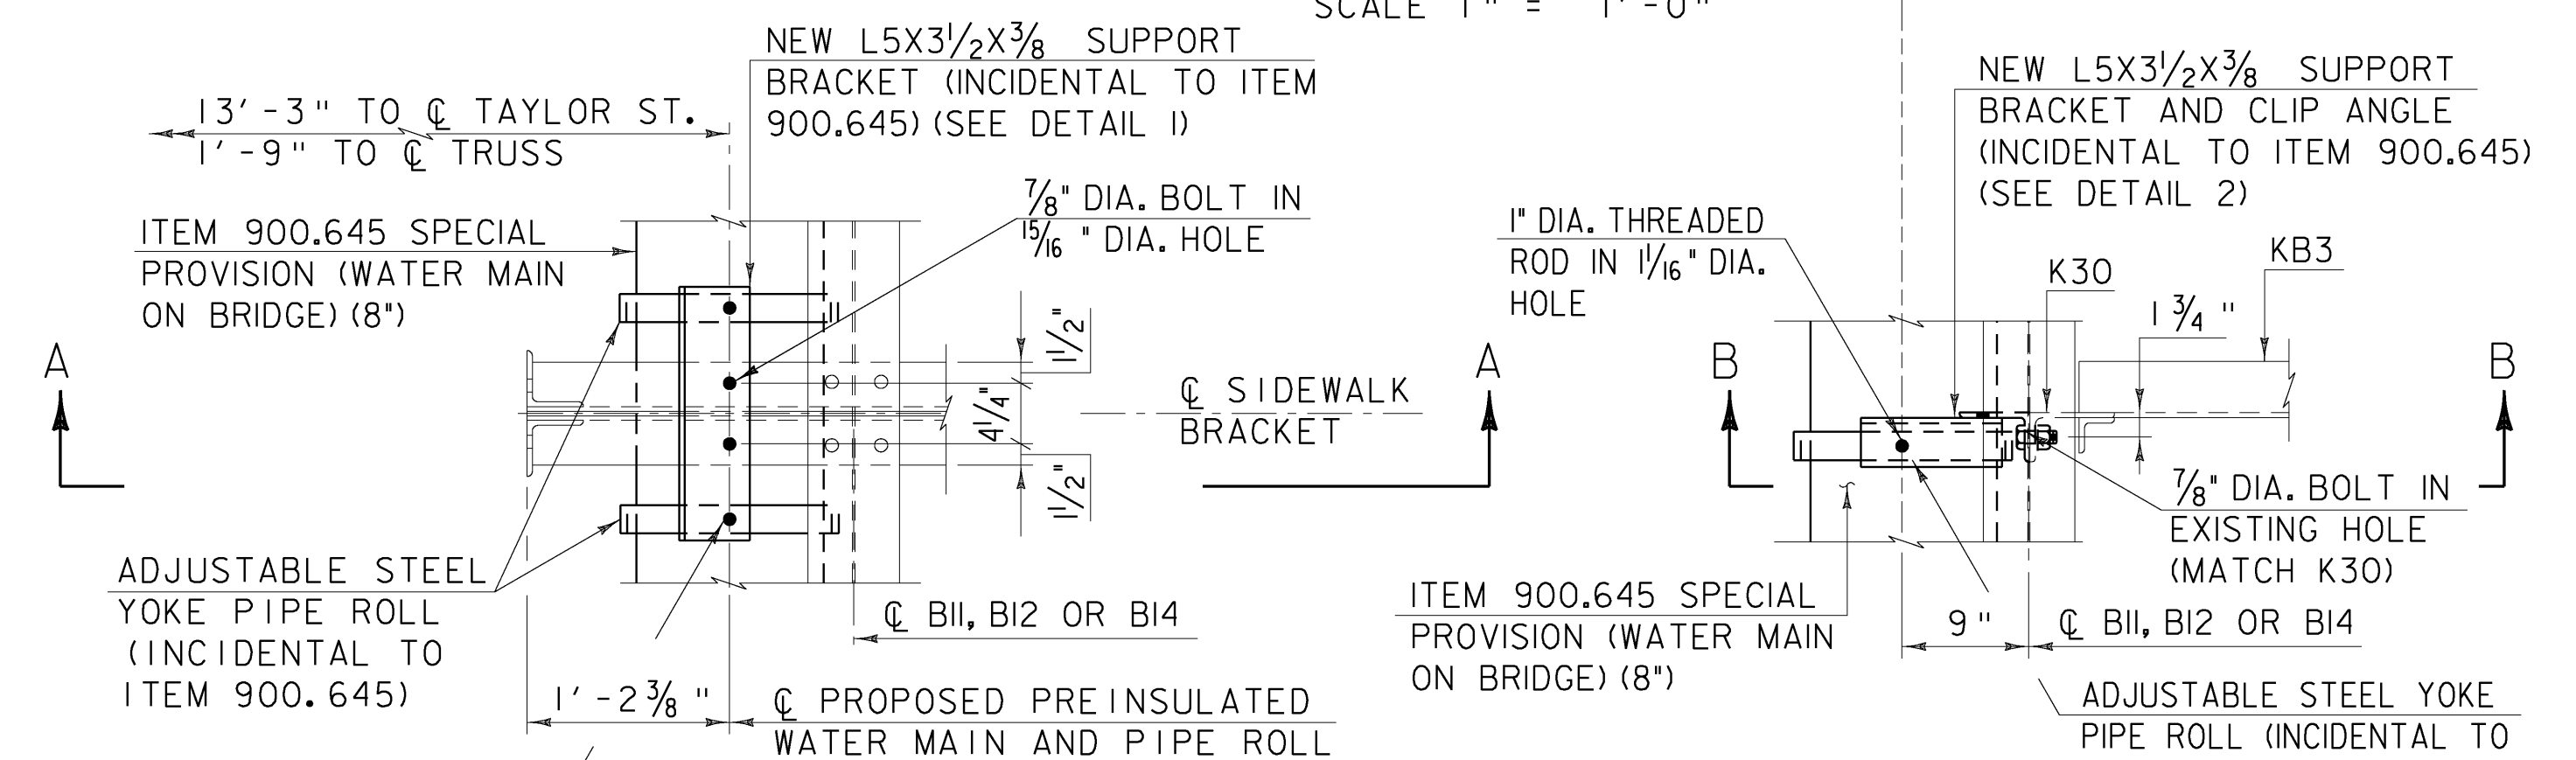


PLAN

(WATERMAIN HANGER CONNECTION AT KB3)

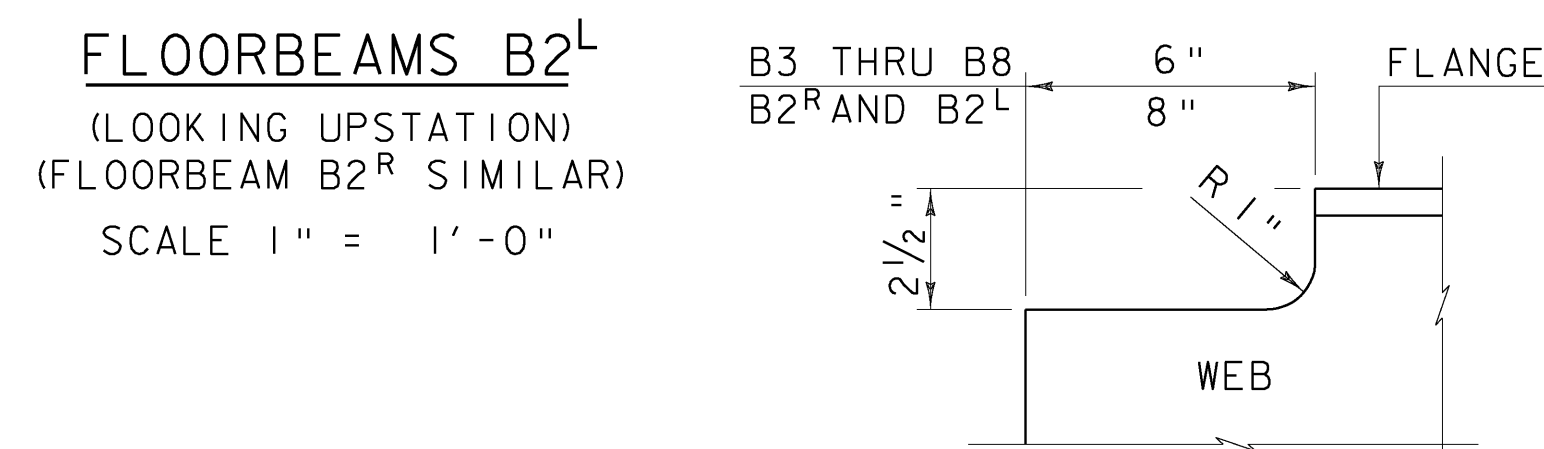

NOT TO SCALE

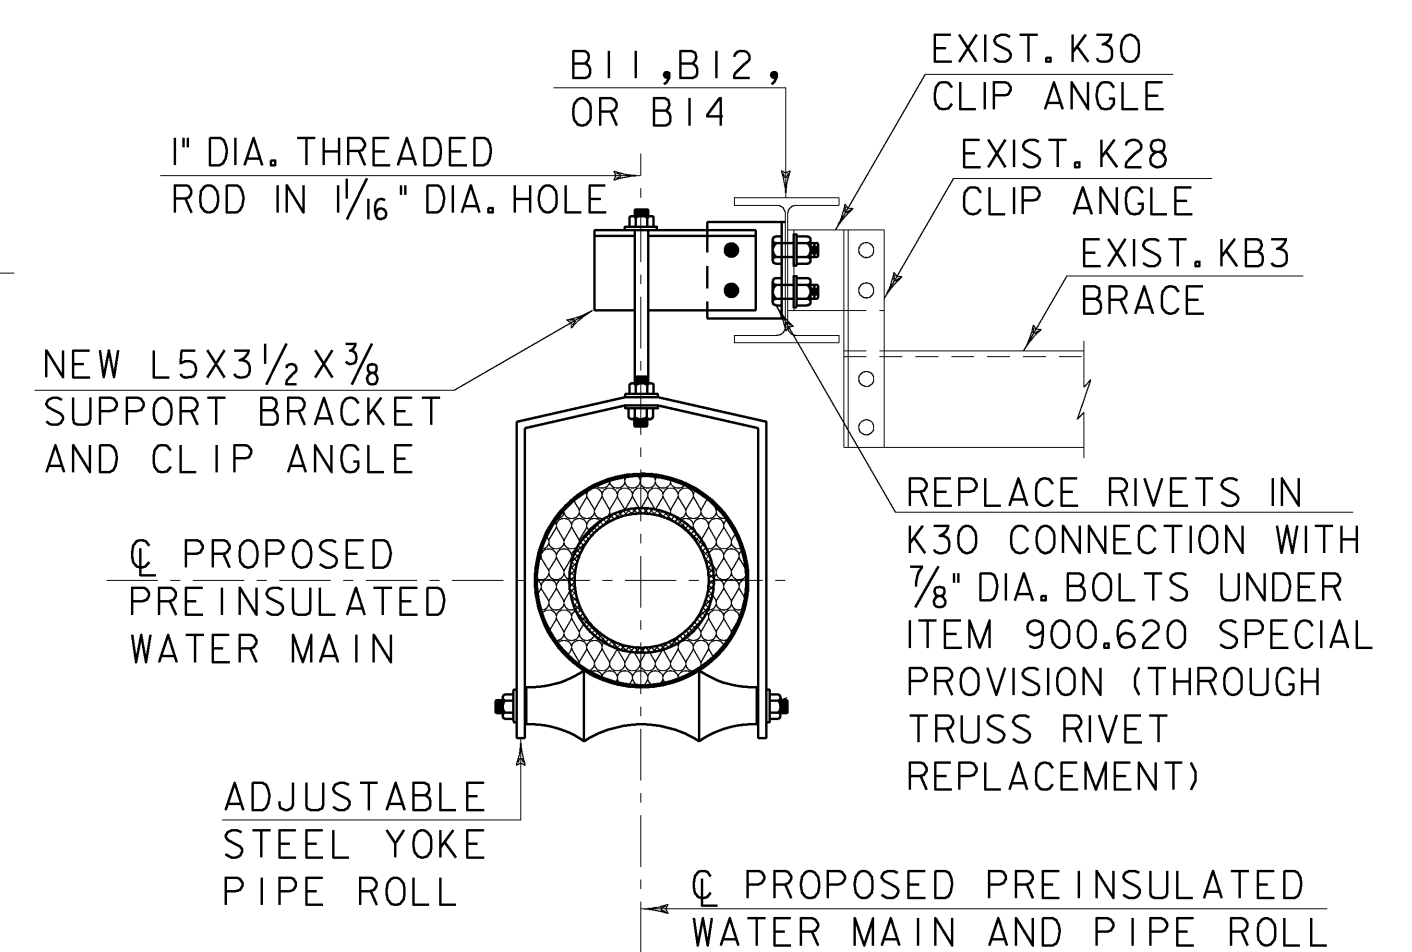

SECTION B-B

SIDEWALK BRACKET KB3

SCALE 1" = 1'-0"

STRUCTURAL STEEL DETAILS (I)

PROJECT NUMBER: BHF 6400(31)

PLOT DATE: 10/12/2009
DRAWN BY: D. D'AMATO

CHECKED BY: P. PERKINS
SHEET 30 OF 63

```
FILE NAME = k:\14506\mstn\plans\zsl4506_frameset1.dgn
DATE/TIME = 10/12/2009
USER = 2552
```