


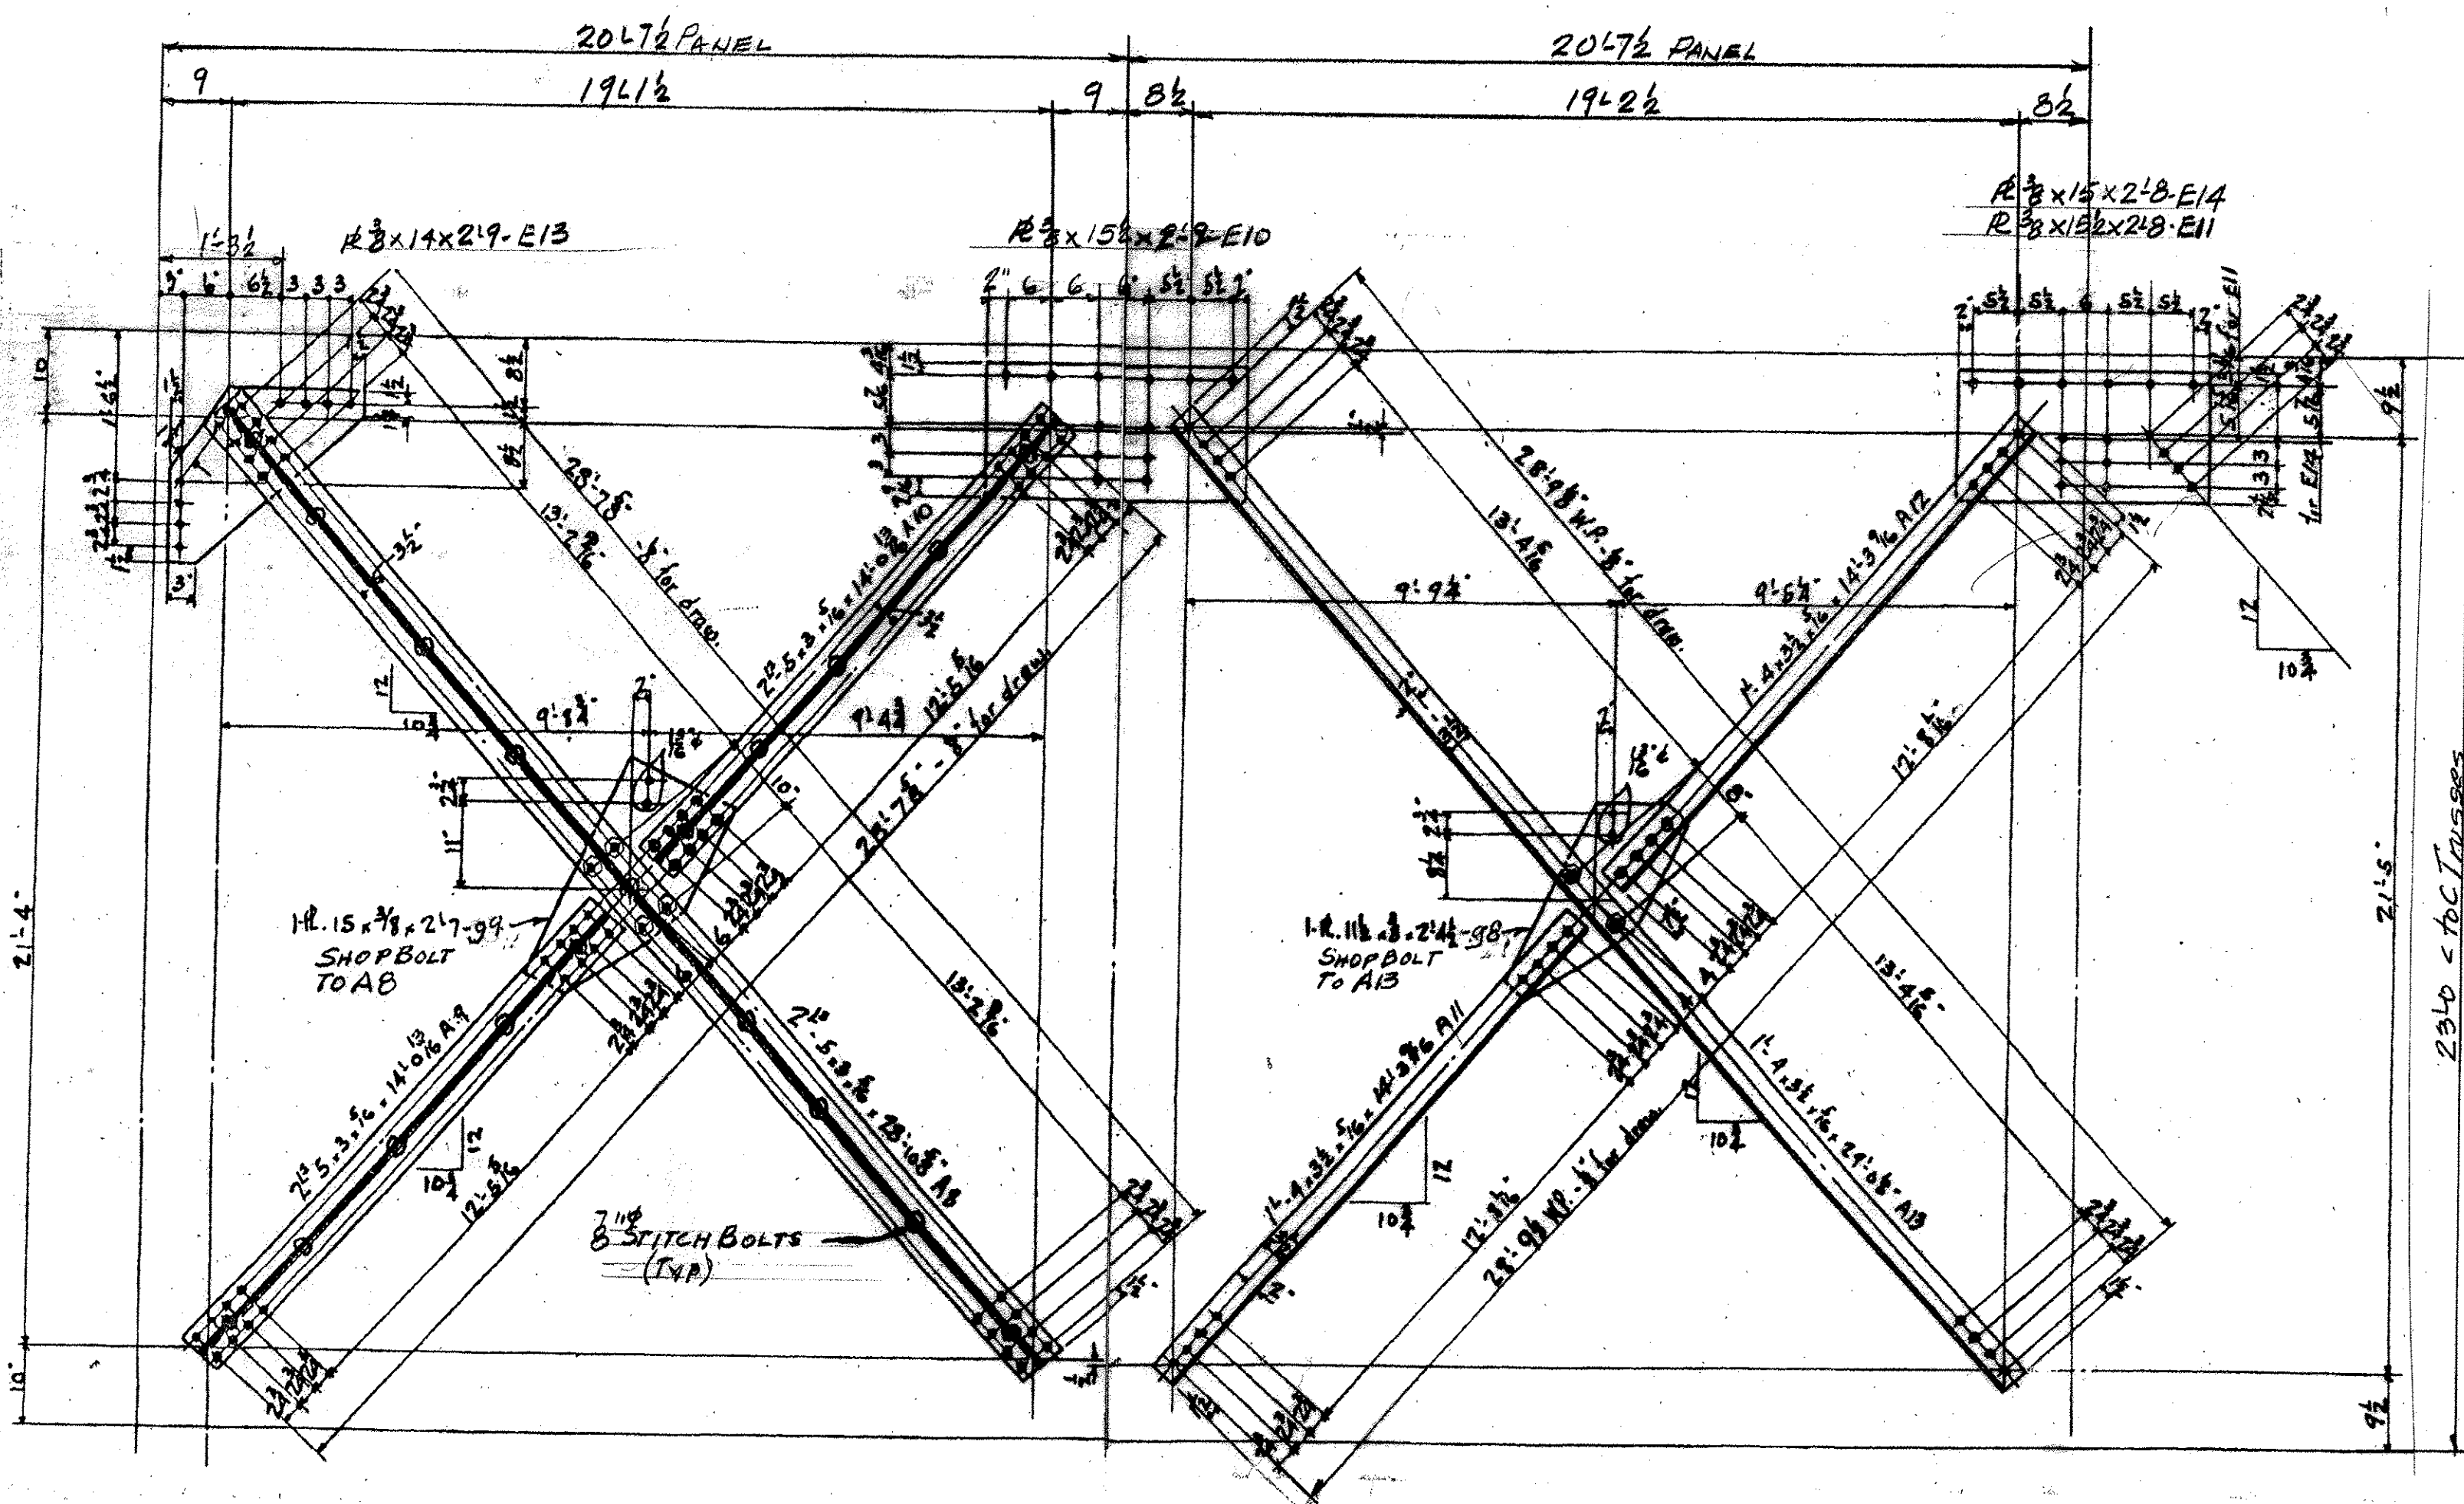

6-DIAGONALS - All
6- DO - A12
6- DO - A13
4- PLATES - E10
6- DO - E11
4- DO - E14

[illegible]