




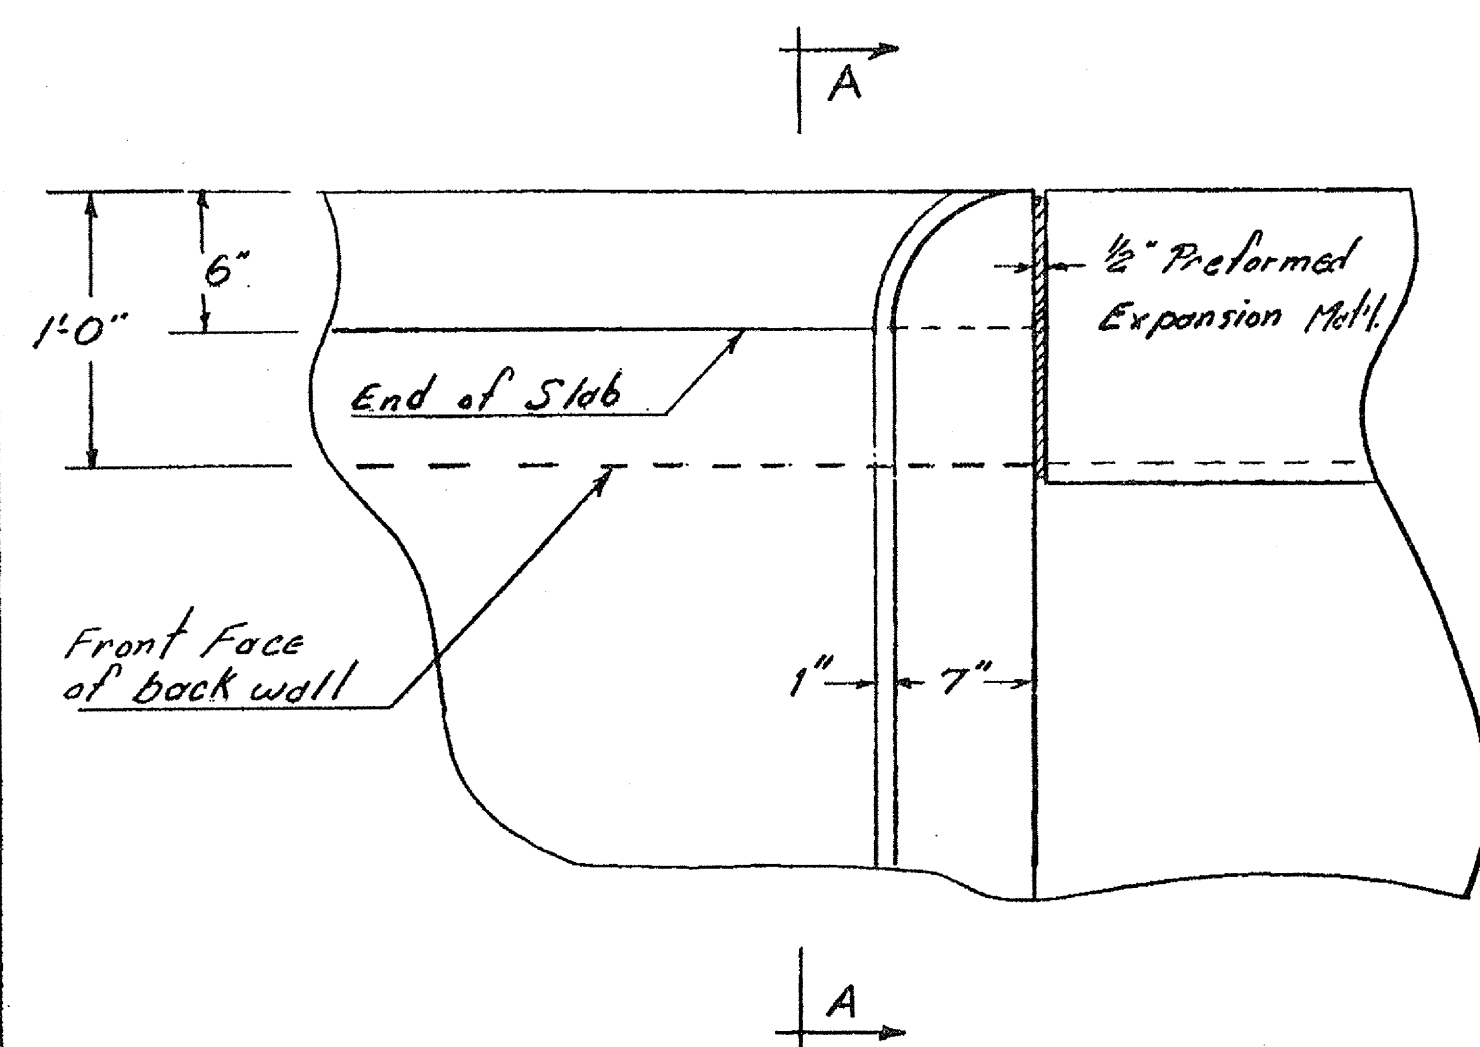


Abutment No. 1 Curb Detail
Scale: 1 1/2" = 1'

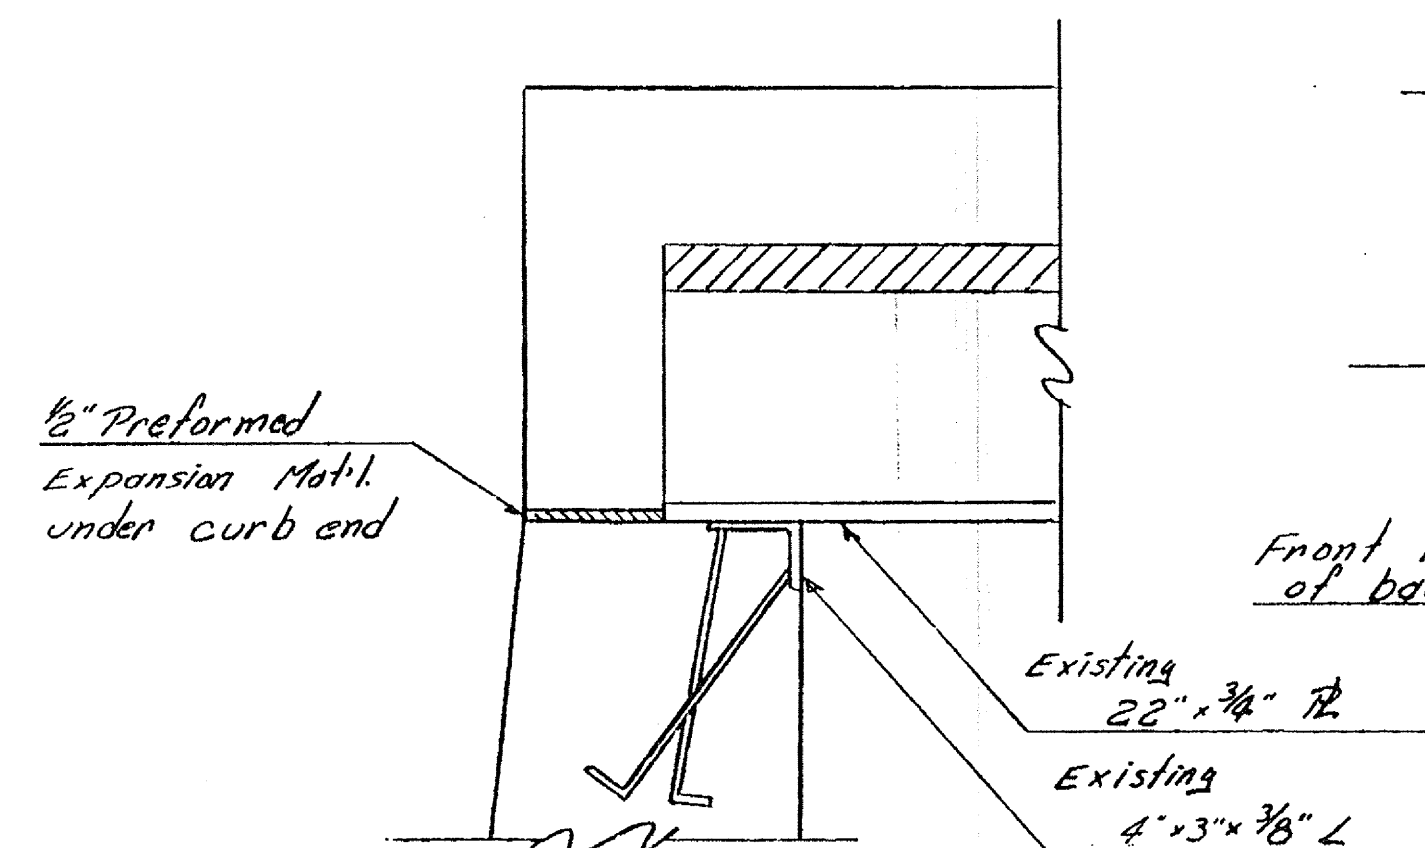


SECTION A-A
Scale: 1 1/2" = 1'

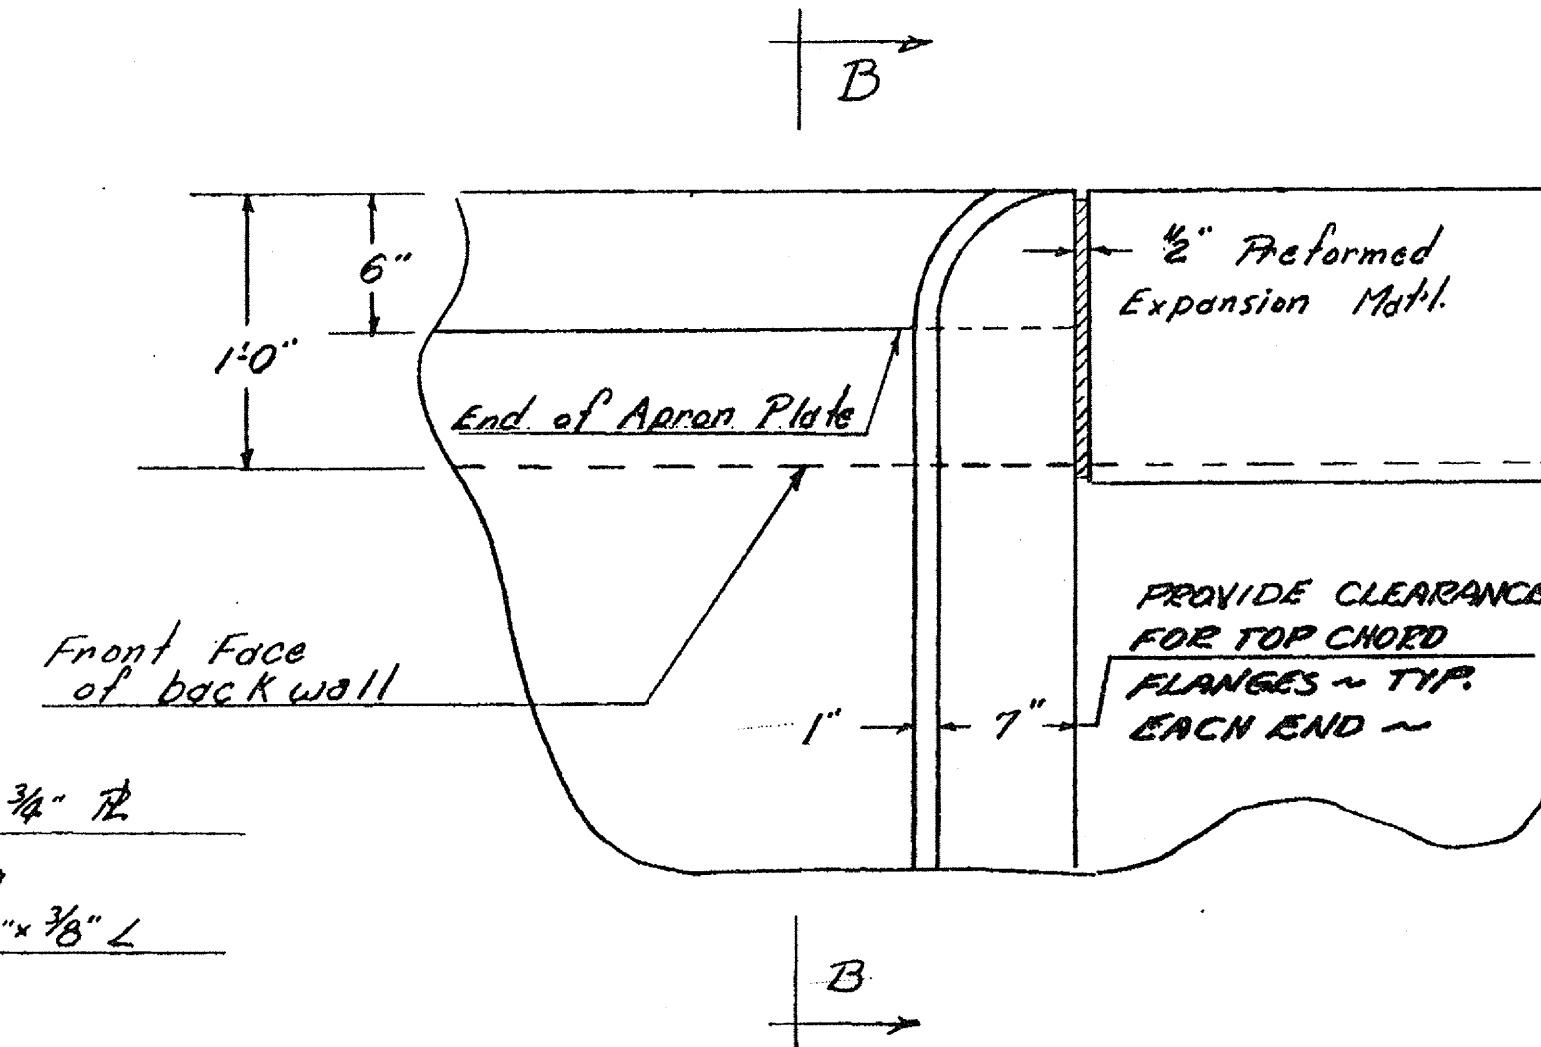


Abutment No. 2 Curb Detail
Scale: 1 1/2" = 1'

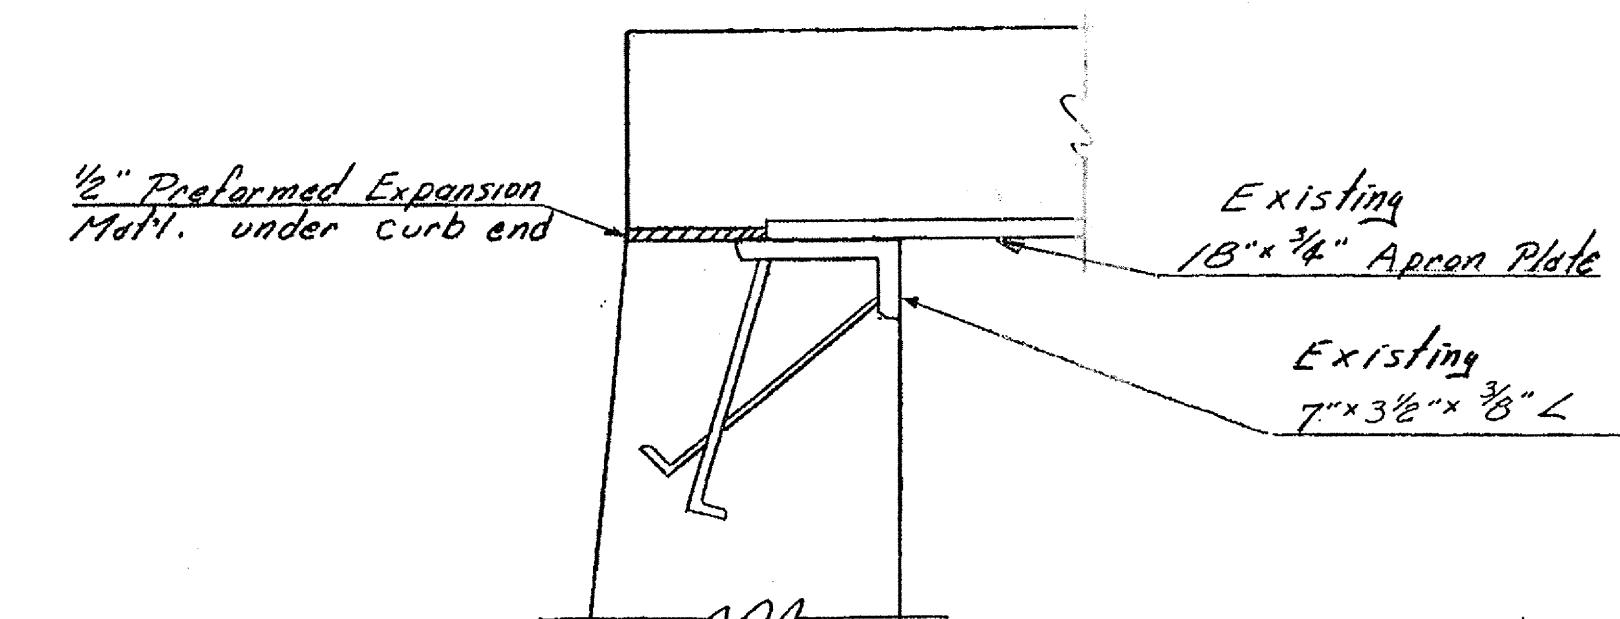

SECTION B-B
Scale: 1 1/2" = 1'

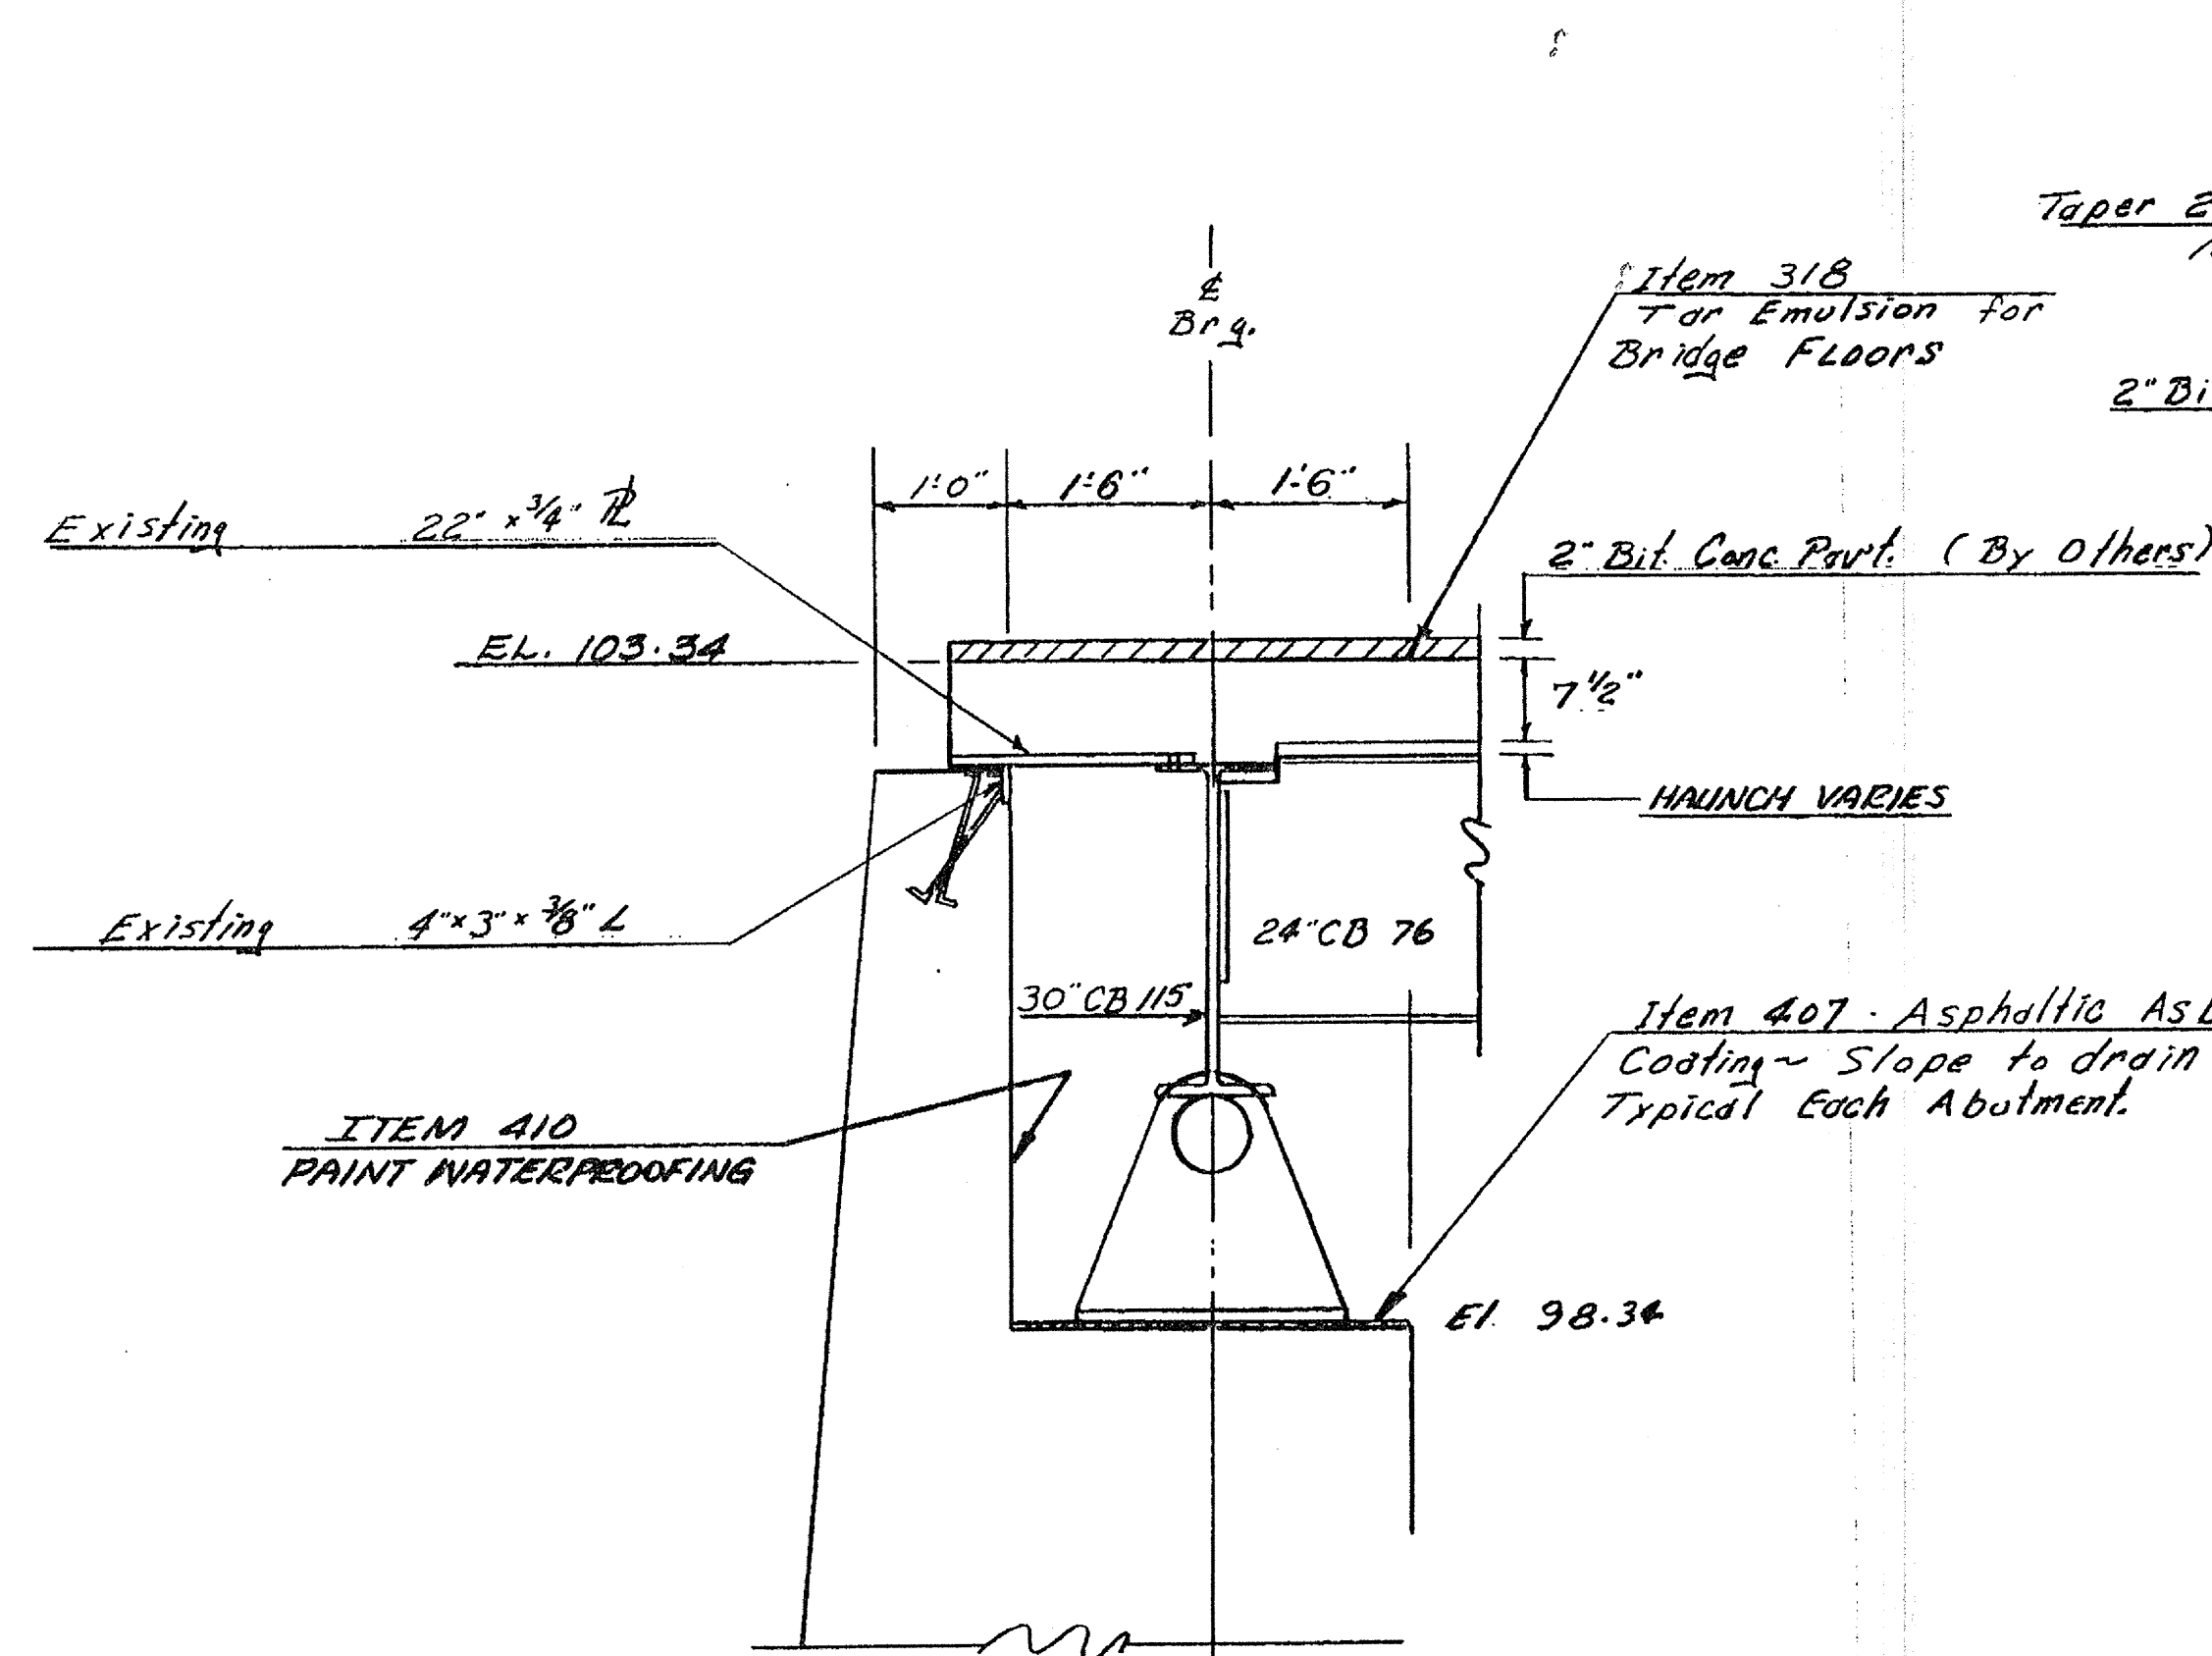

ABUTMENT NO. 1
FIXED
Scale: 3/4" = 1'

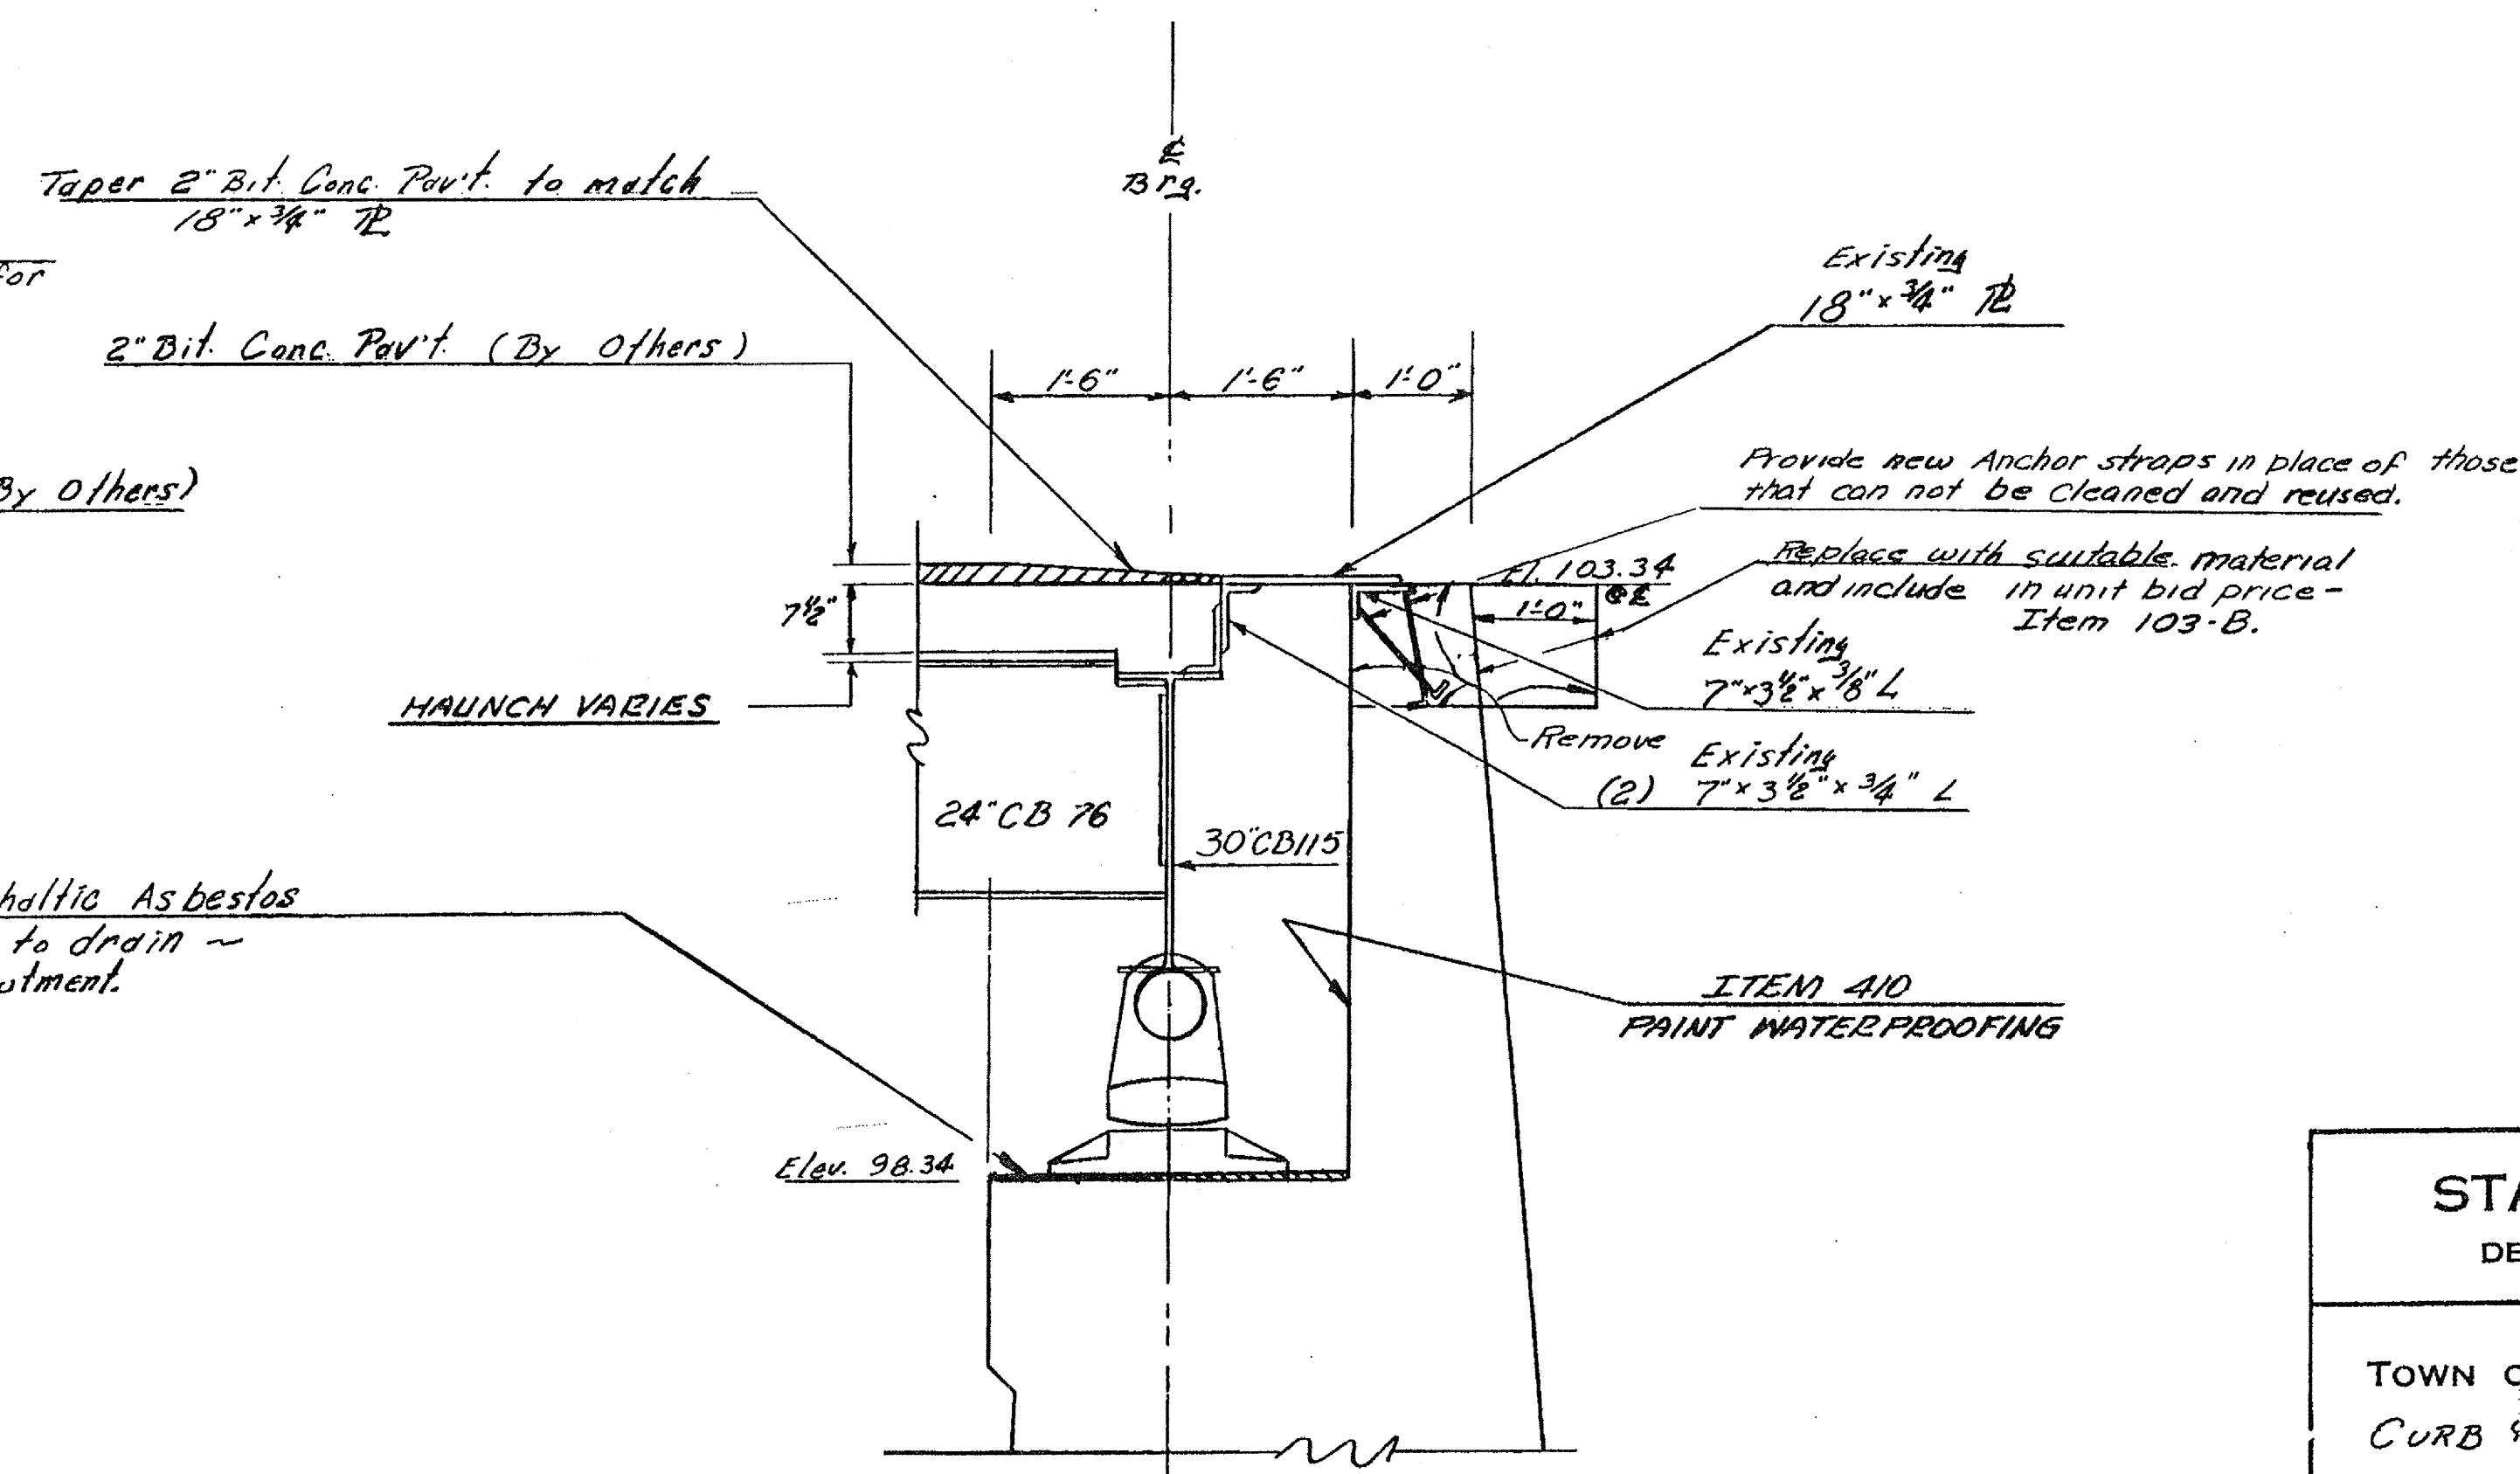

ABUTMENT NO. 2
EXPANSION
Scale: 3/4" = 1'

STATE OF VERMONT
DEPARTMENT OF HIGHWAYS

TOWN OF MONTPELIER
CURB & BEARING DETAILS
TAYLOR ST. BRIDGE
OVER WINDSOR RIVER

SCALE As Noted
IN CHARGE R. H. Watson

DRAWN BY D. Mayo CHECKED BY D. WALKER

PROJECT NO. SAB 6612

SHEET 4 OF 8