
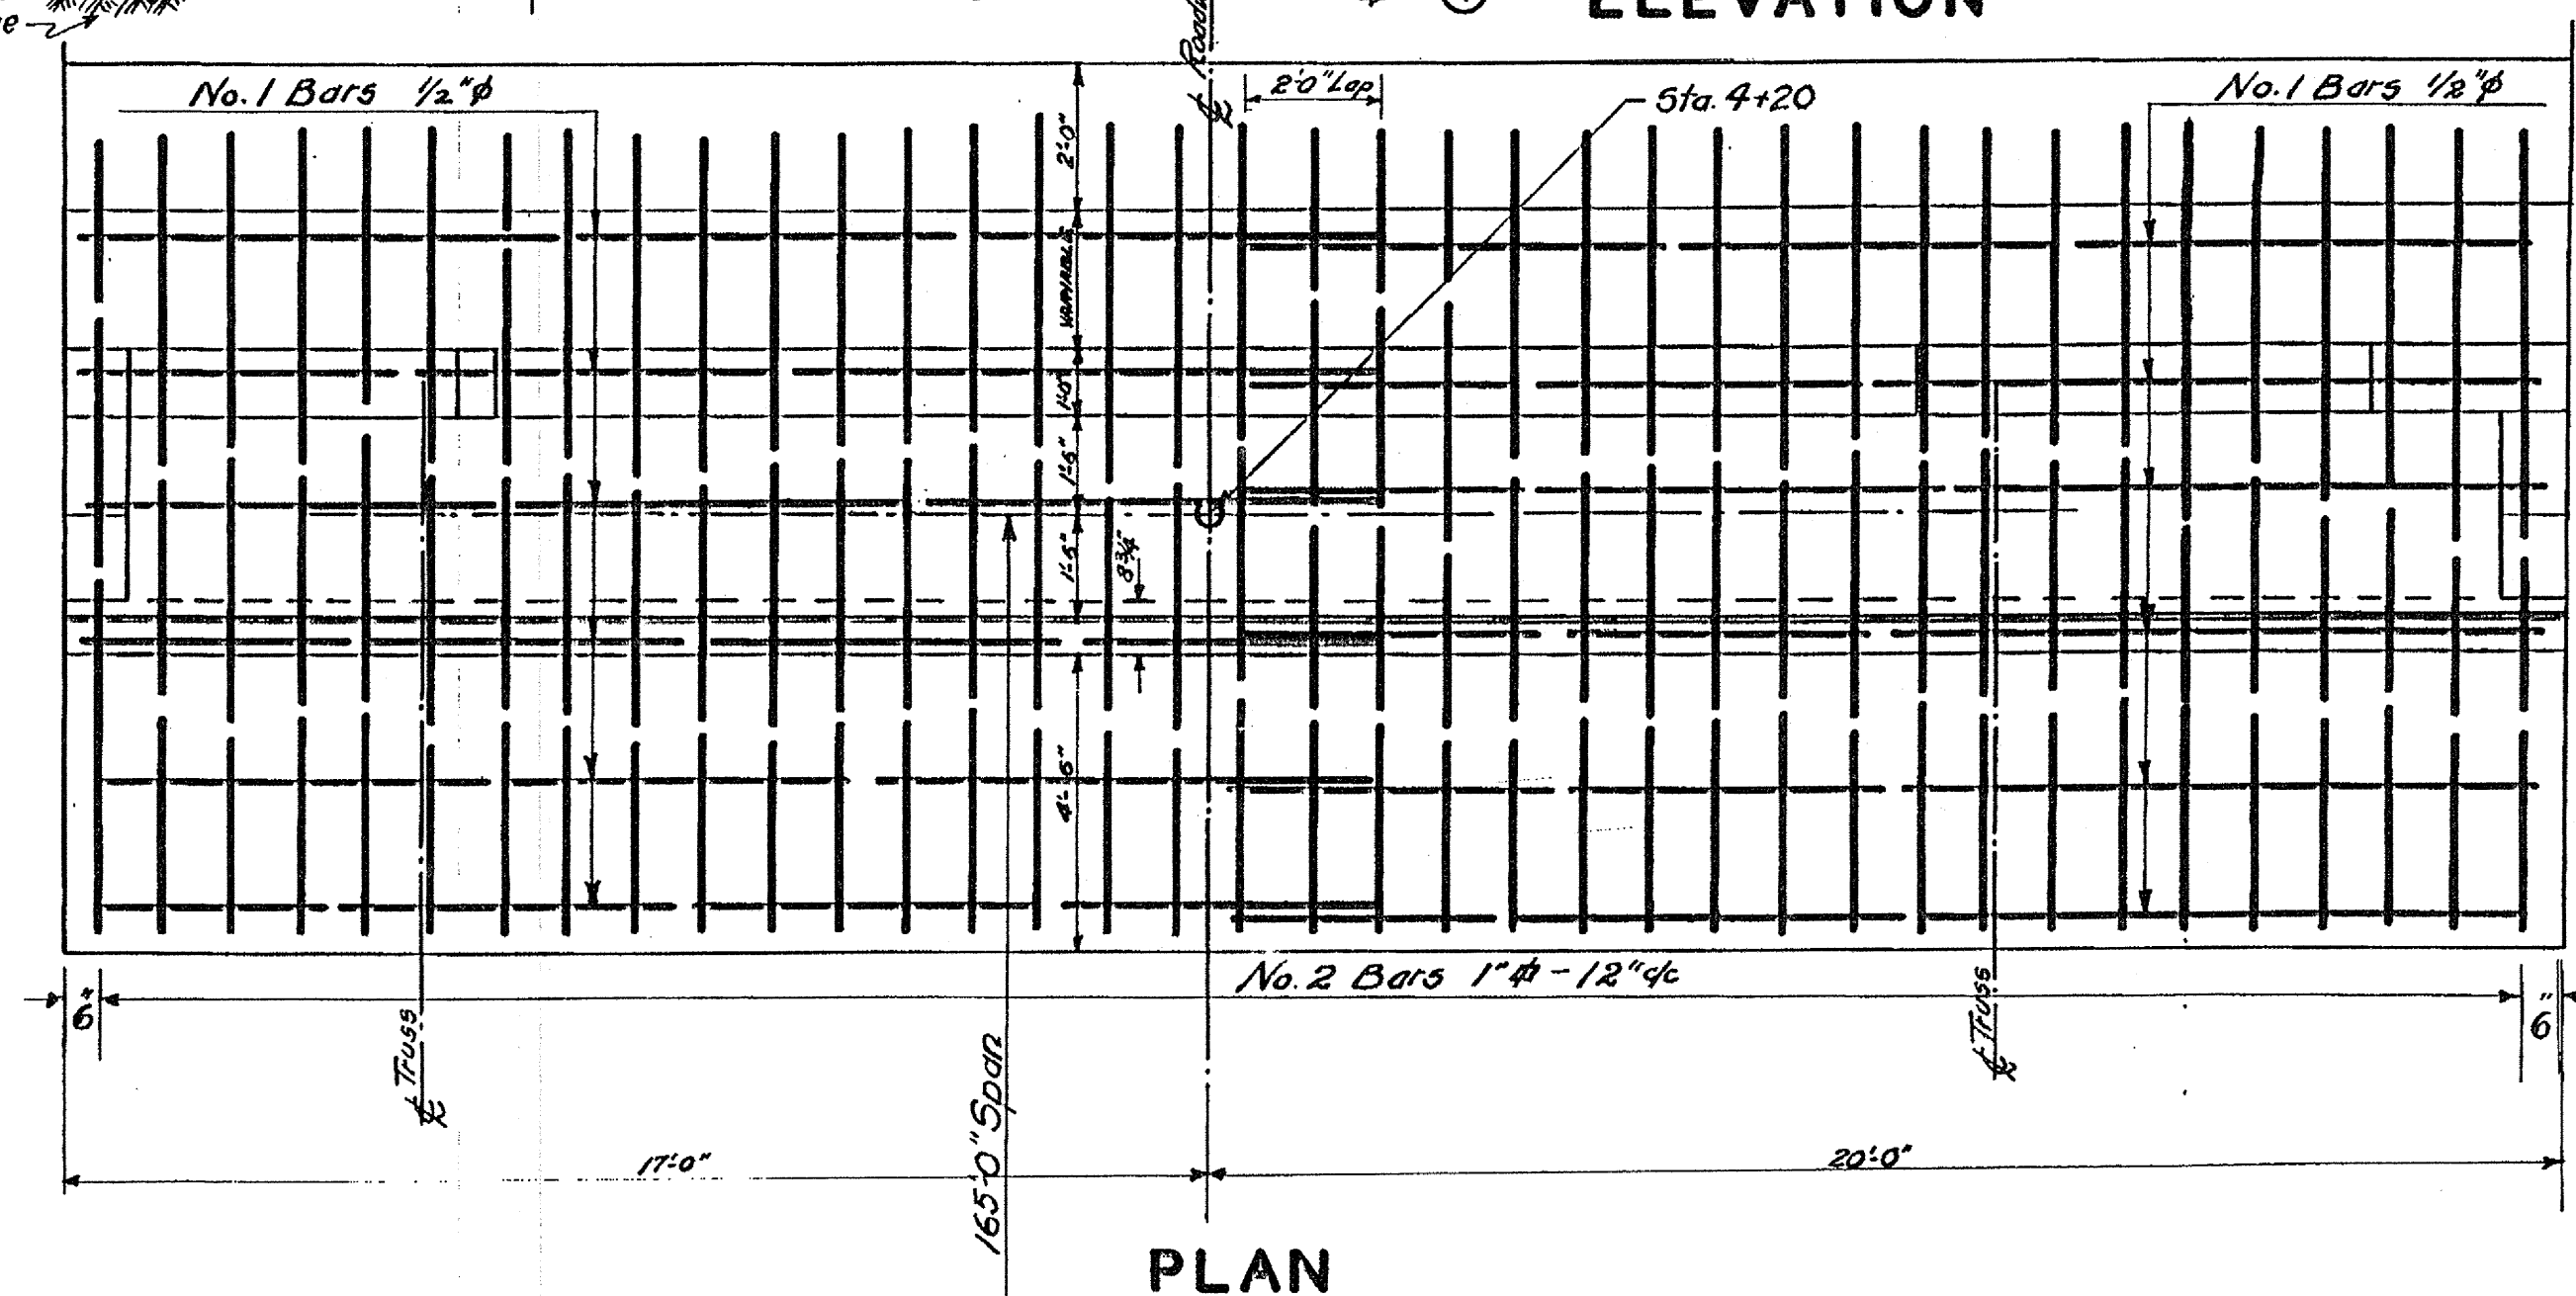
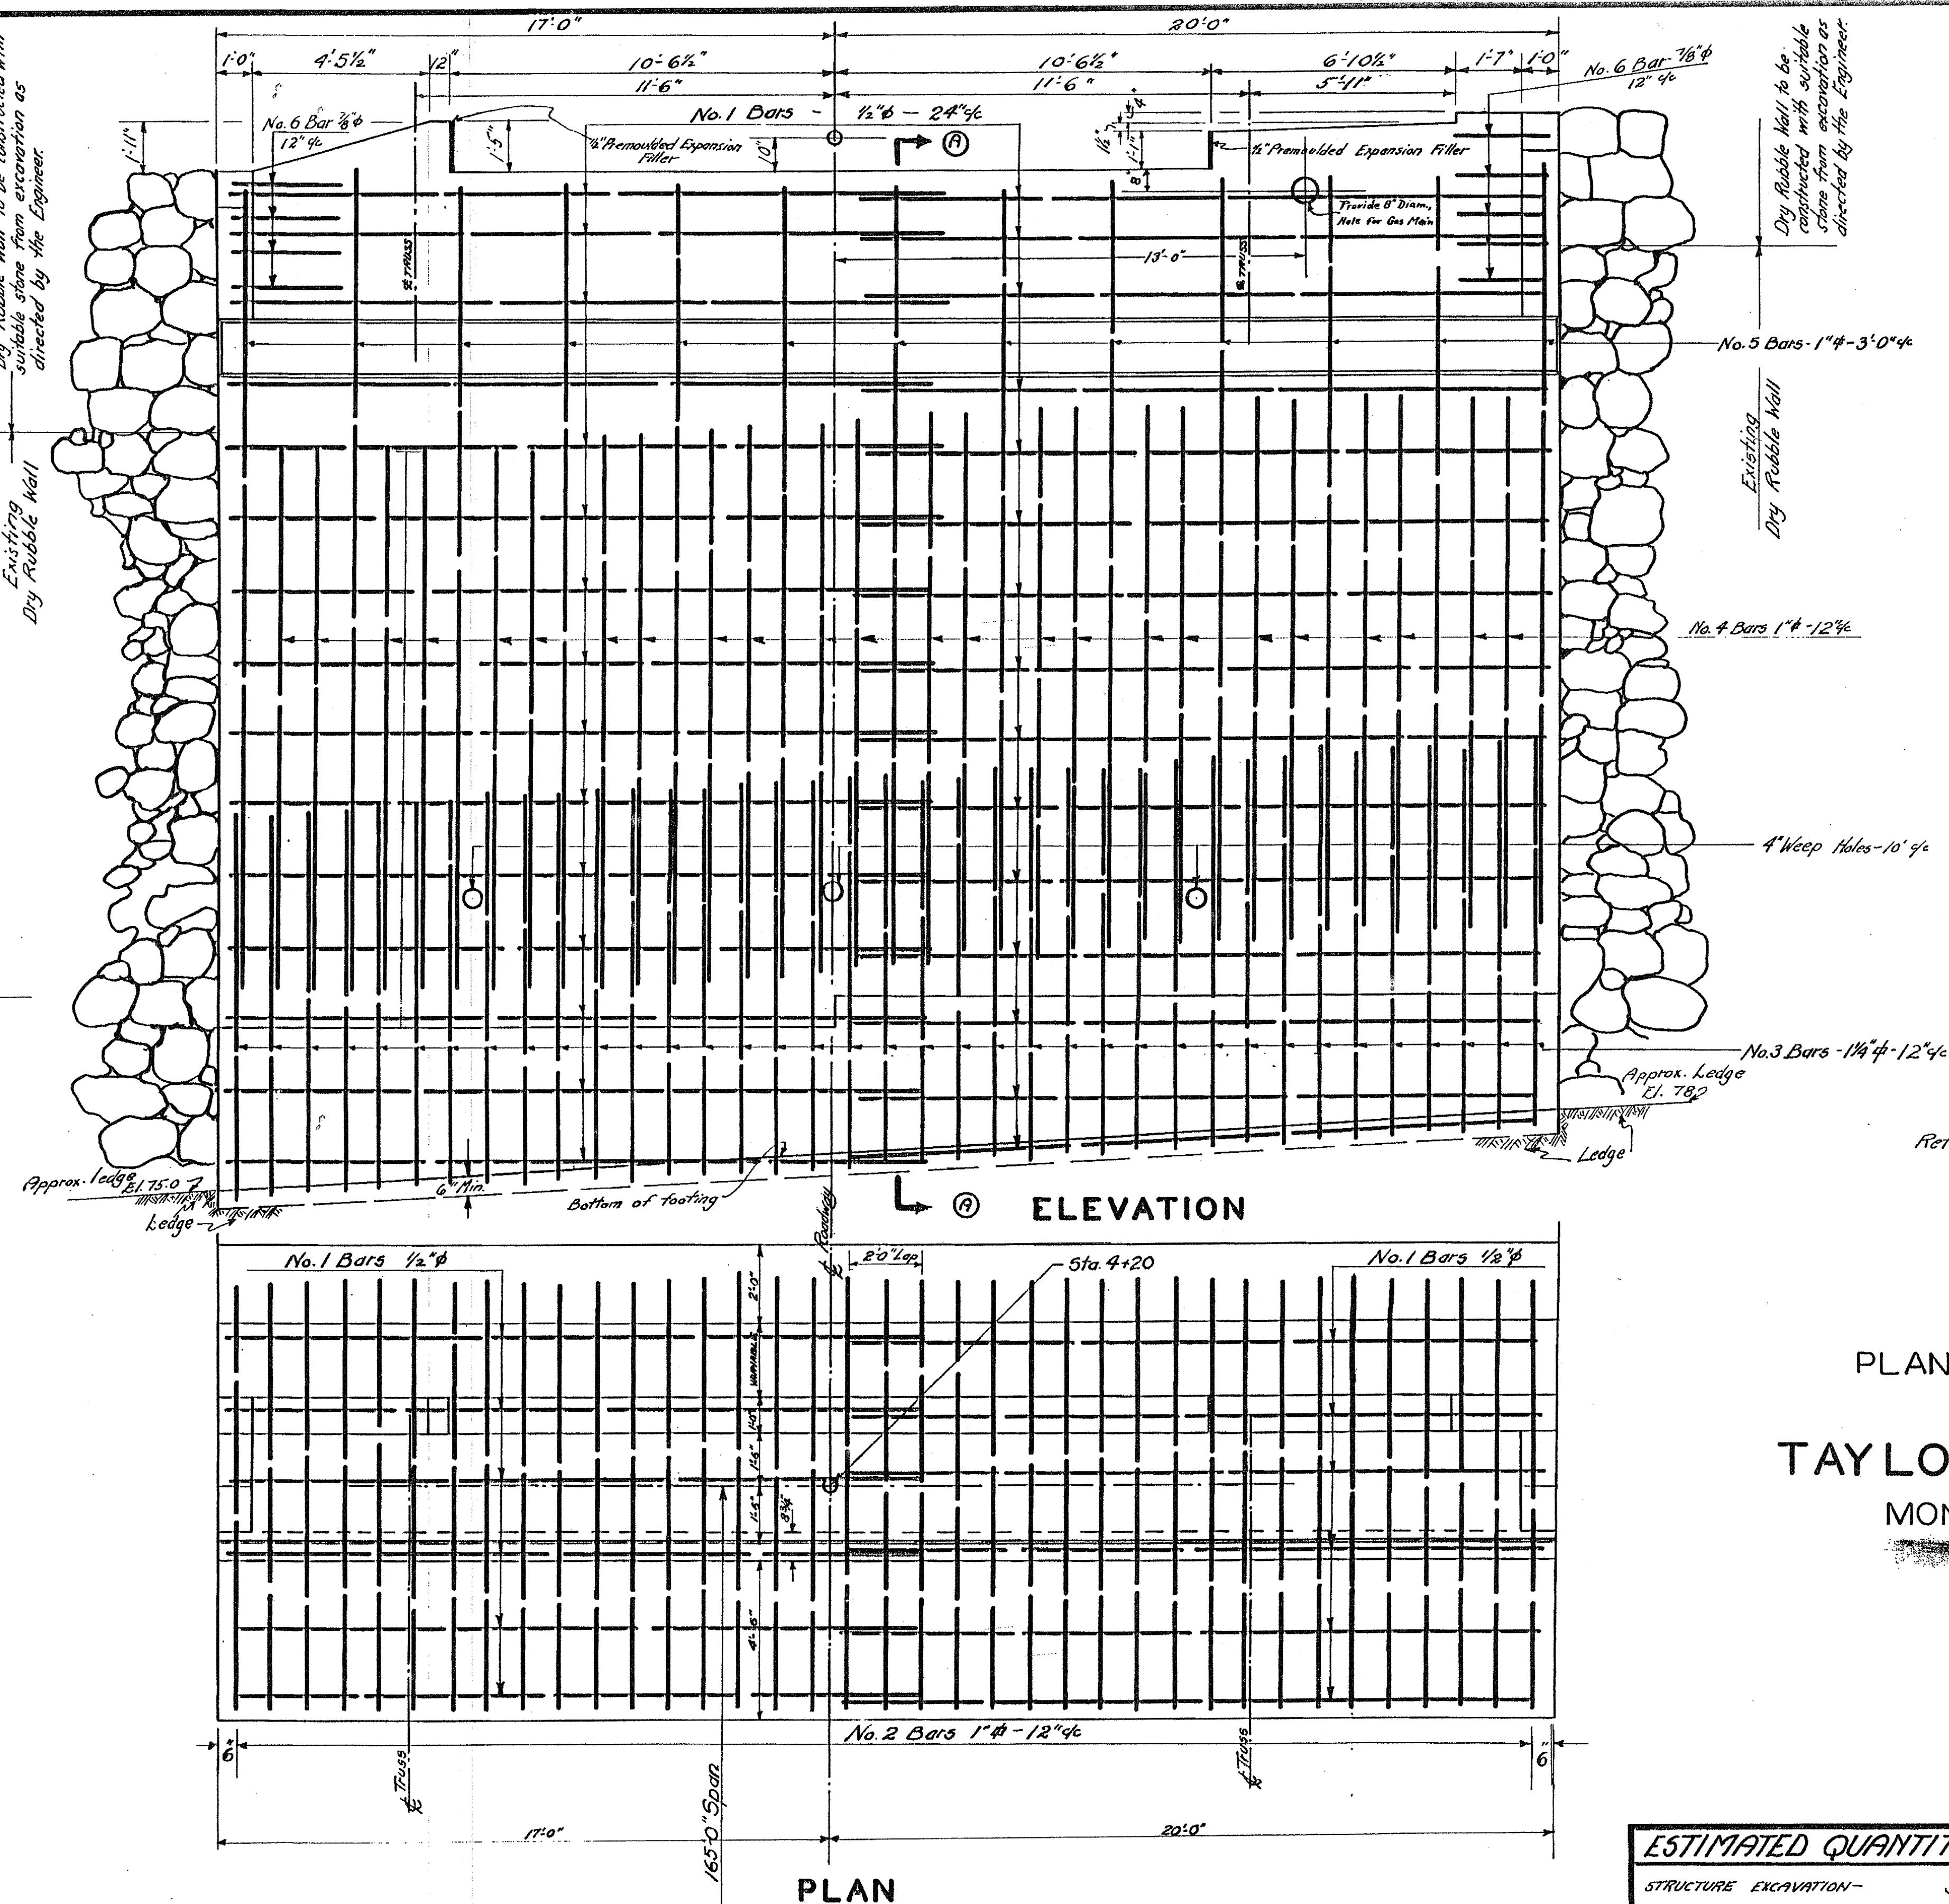
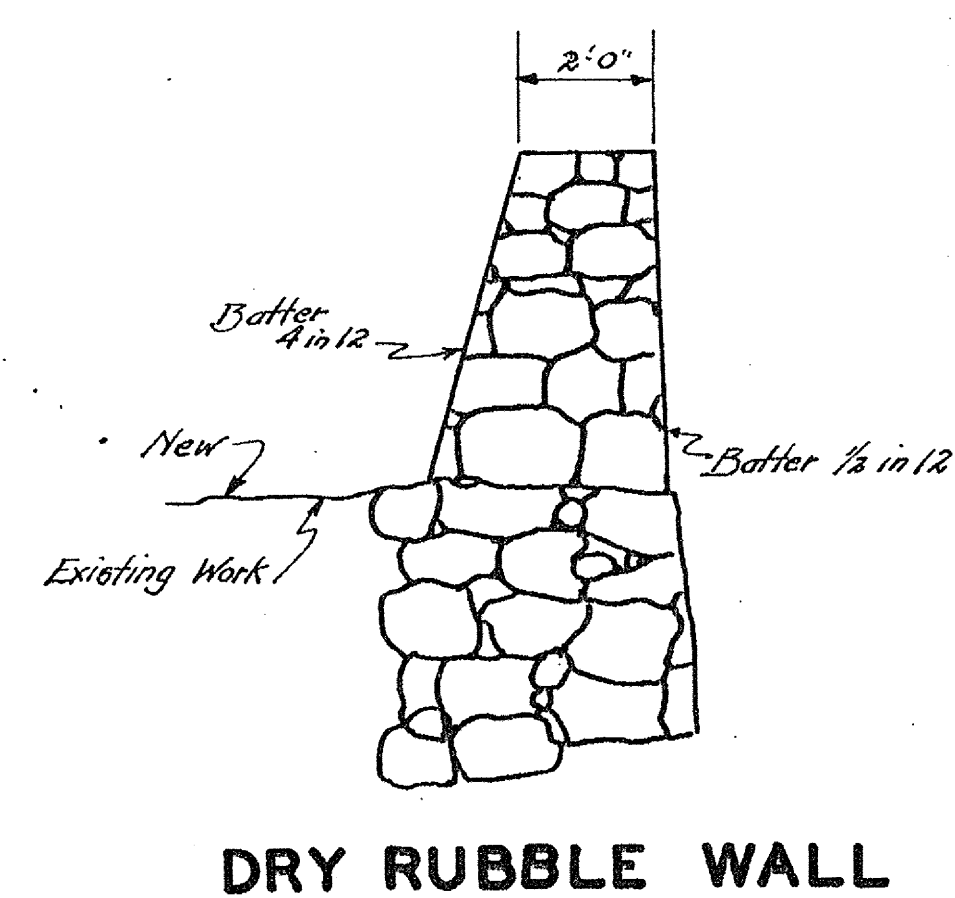


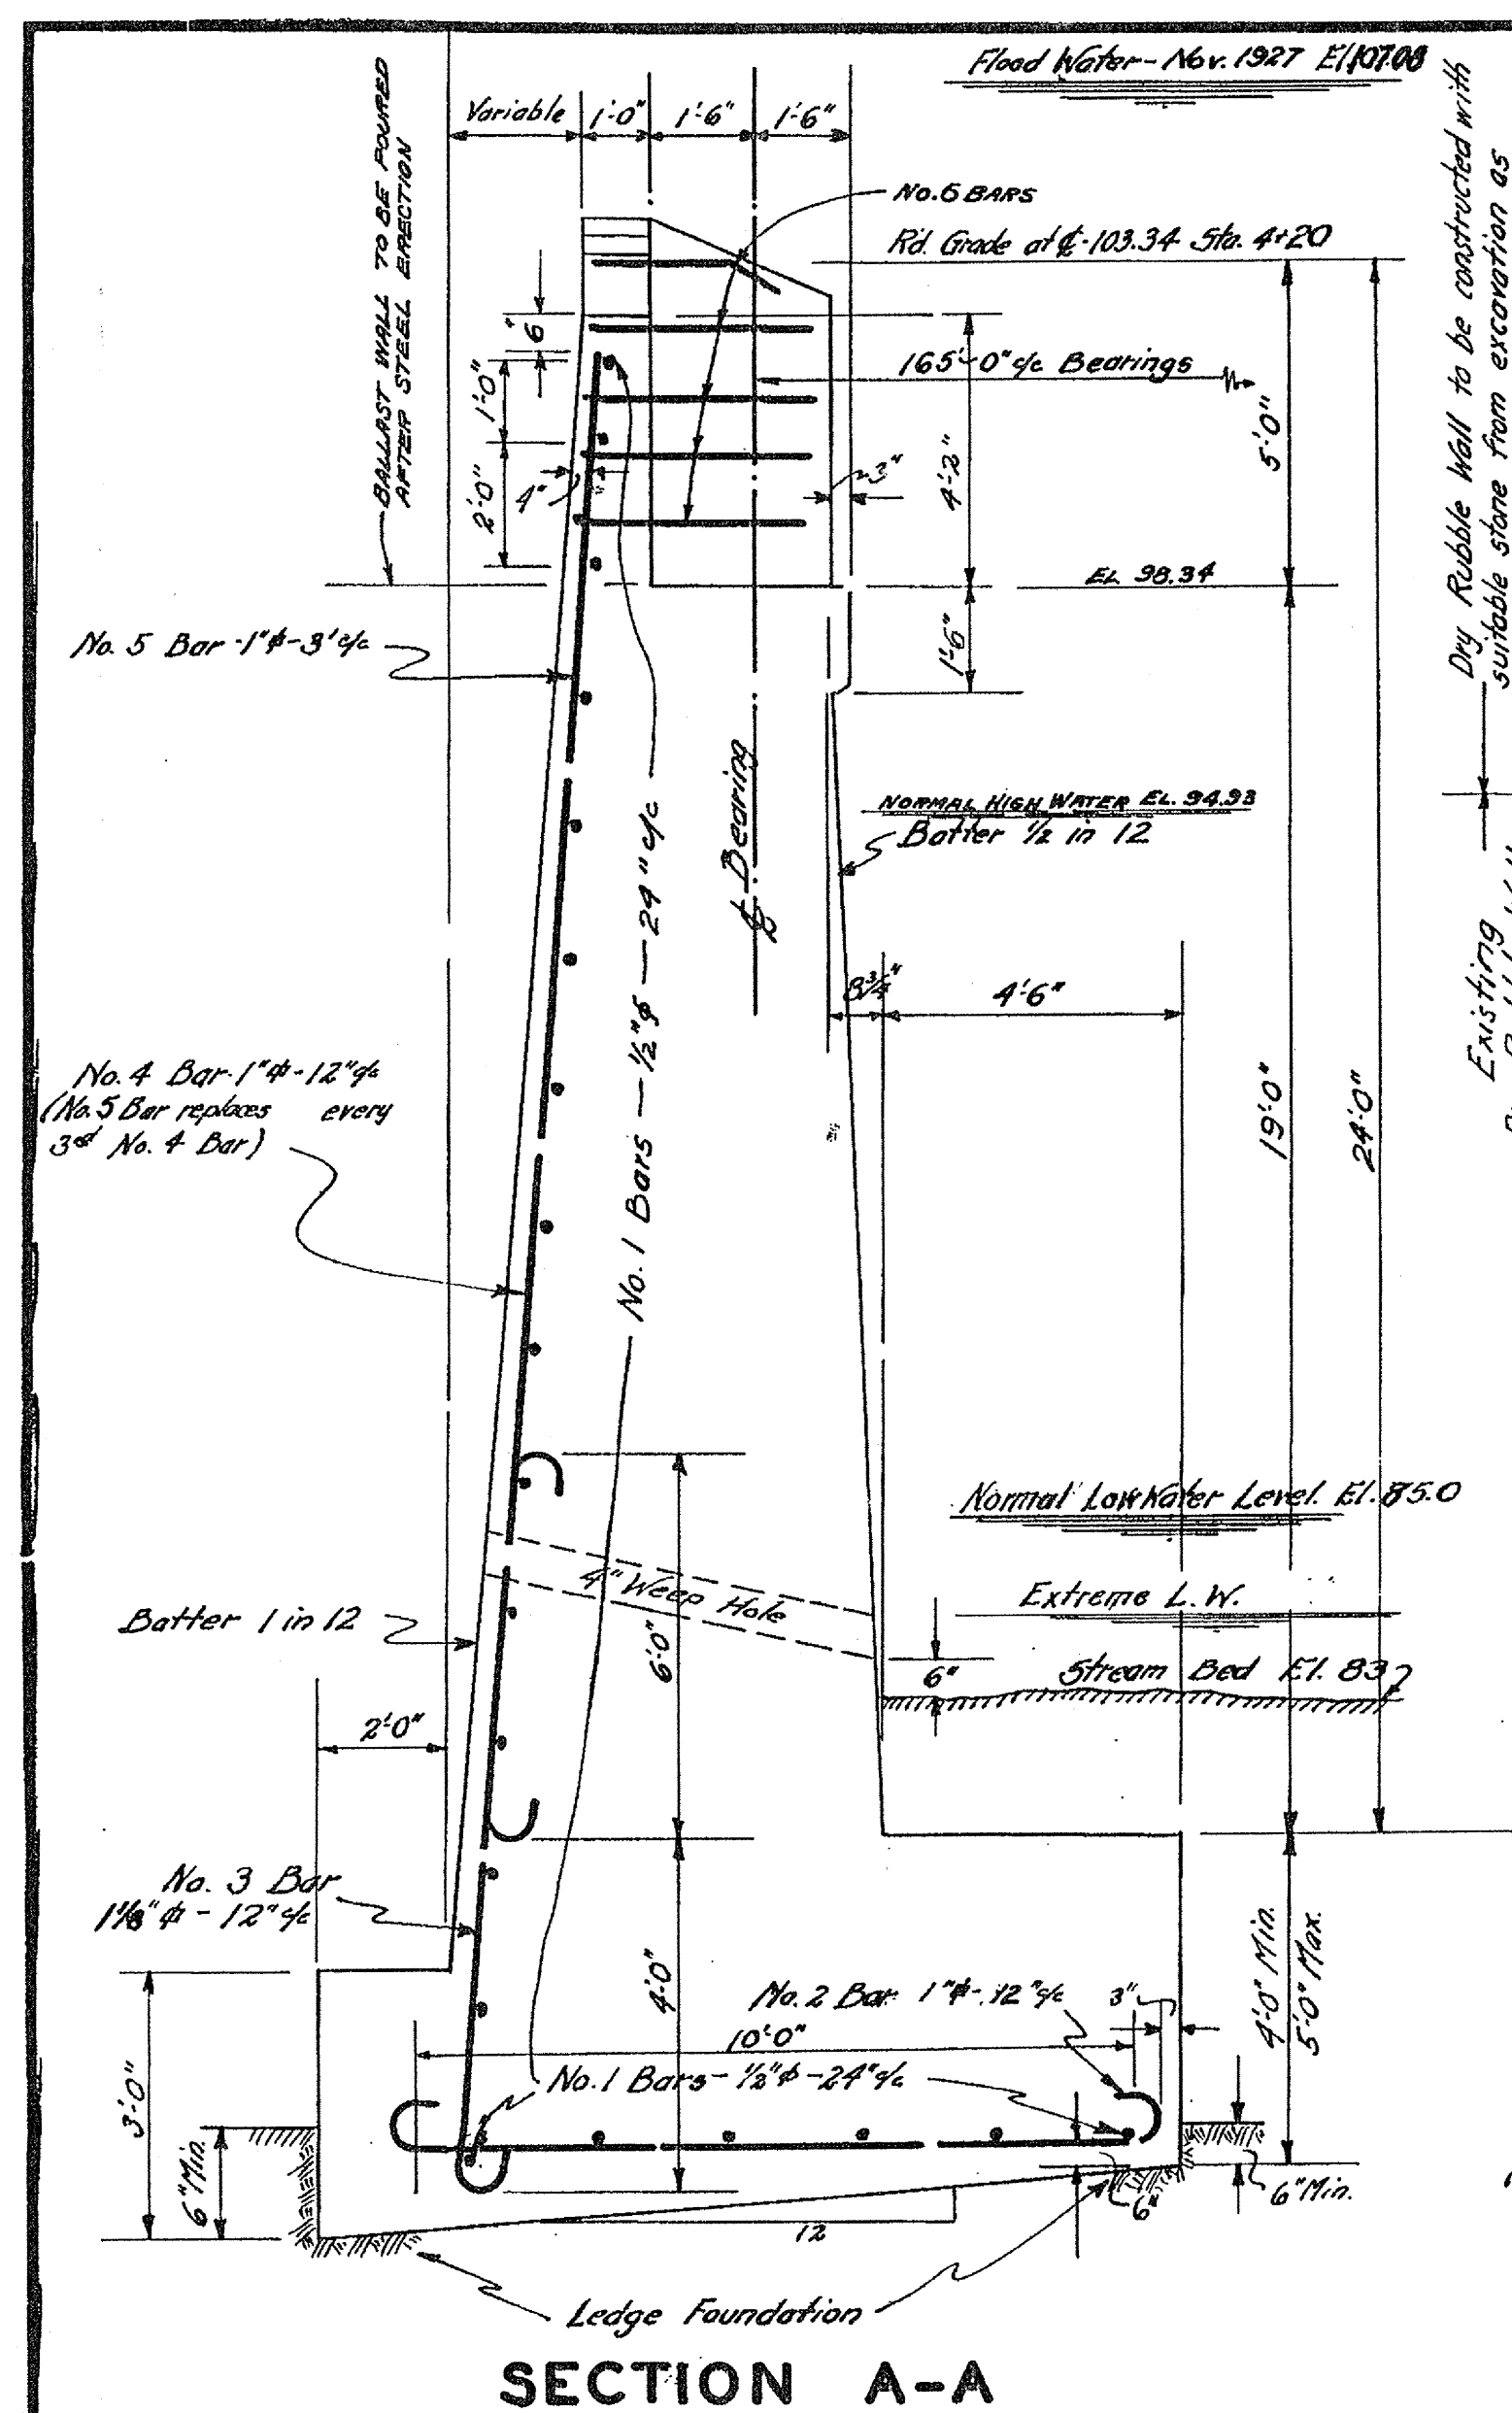

PLAN OF ABUT. NO. 1
STA. 4+20
TAYLOR ST. BRIDGE
MONTPELIER, VT.

SCALE: $\frac{3}{8}" = 1'-0"$

ESTIMATED QUANTITIES	
STRUCTURE EXCAVATION-	350 C.Y.
CONC. (CLASS C) 1:2:4	
	244 C.Y.
REINFORCING STEEL-	6393 #
DRY RUBBLE MASONRY	17 cu yds

Surveyed by Walker
Designed by A.D.B.
Drawn by A.D.B.
Traced by A.G. 1/14/28
Checked by H. Radigan 7/18/29
Series No. Filed
Sheet 2 of 2 Sheets