

GPS CONTROL POINTS

HVCTRL #_1_

STANDARD DISK STAMPED

East_Randolph-----

N = 52893.79-----
E = 1626547.81-----
ELEV. = 657.60-----

To reach from the intersection of VT route 14 and VT route 66 in East Randolph go south along route 14 for 0.9 mi to the intersection of a gravel drive left, at the south edge of a cemetery, and the site of the mark on the left, south of the gravel drive. The mark is set 1 in below the ground surface in the top of a 12 in diameter concrete monument poured 4 ft deep. It is 21.7 ft east of and about 1.6 ft higher than the centerline of route 14, 16.7 ft south of the centerline of the gravel drive, 43 ft east of pole # 301/7/122/61/30, 48.6 ft southwest of the southwest corner of the gravestone of Blodgett, and 1 ft west of a fiberglass witness post.

• DESCRIPTION PROVIDED BY VERMONT AGENCY OF TRANSPORTATION GEODETIC SURVEY UNIT

HVCTRL #_2_






STANDARD DISK STAMPED

East_Randolph_Az_Mk-----

N = 520093.26-----
E = 1626438.54-----
ELEV. = 647.11-----






To reach from the intersection of VT route 14 and VT route 66 in East Randolph go south along route 14 for 0.6 mi to the East Randolph School on the left and the site of the mark on the left, in a lawn in front of the school. The mark is set 4 in below the ground surface in the top of a 12 in diameter concrete monument poured 4 ft deep. It is 22 ft east of and about 0.3 ft lower than the centerline of route 14, 42.7 ft north of the centerline of the most southernly entrance drive to the school, 89 ft west northwest of the southwest corner of the school building, and 59 ft southwest of pole # 61/20 and a fiberglass witness post.

TRAVERSE TIES

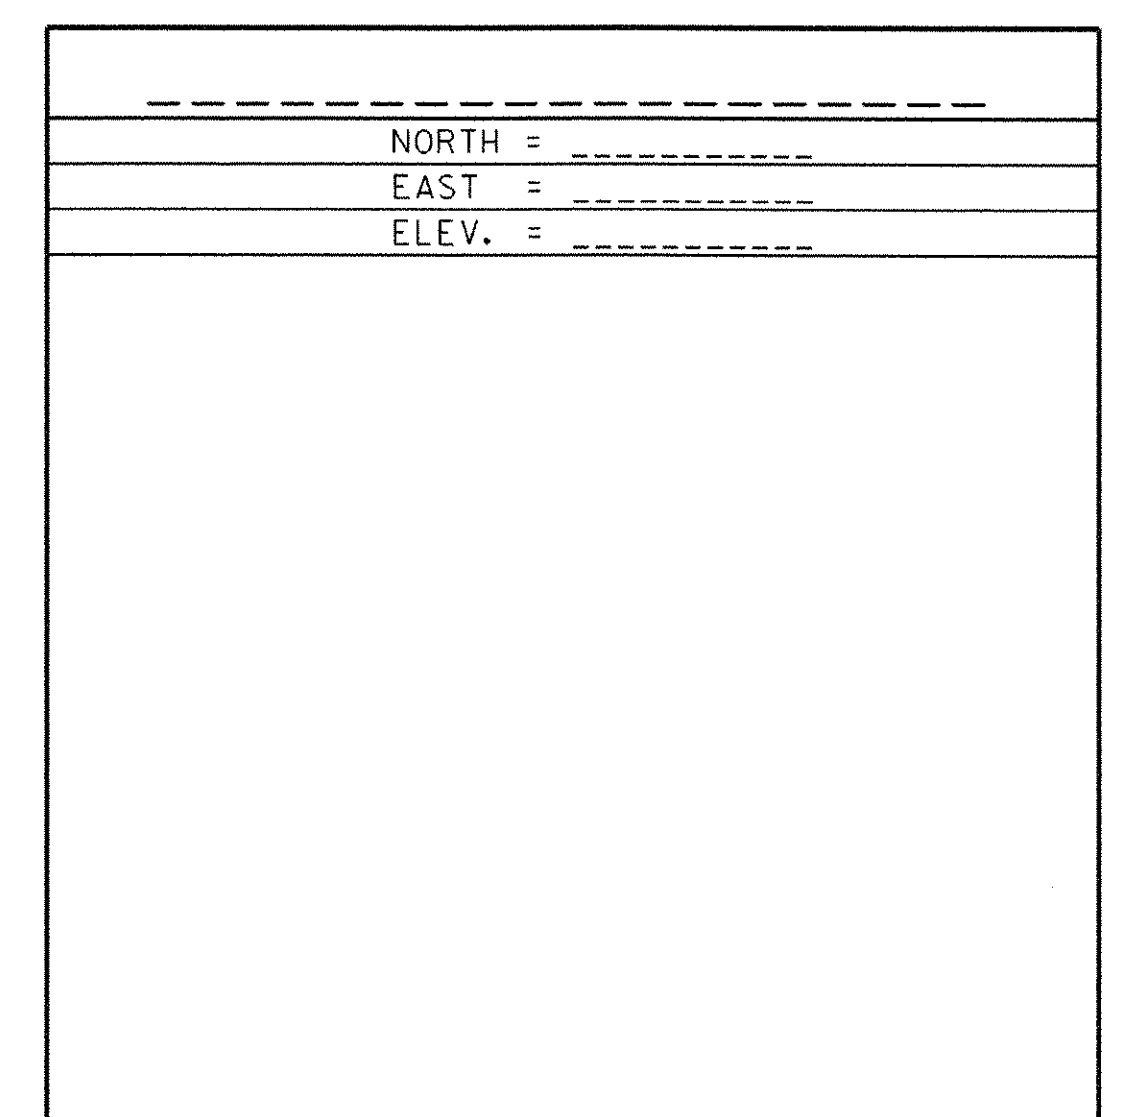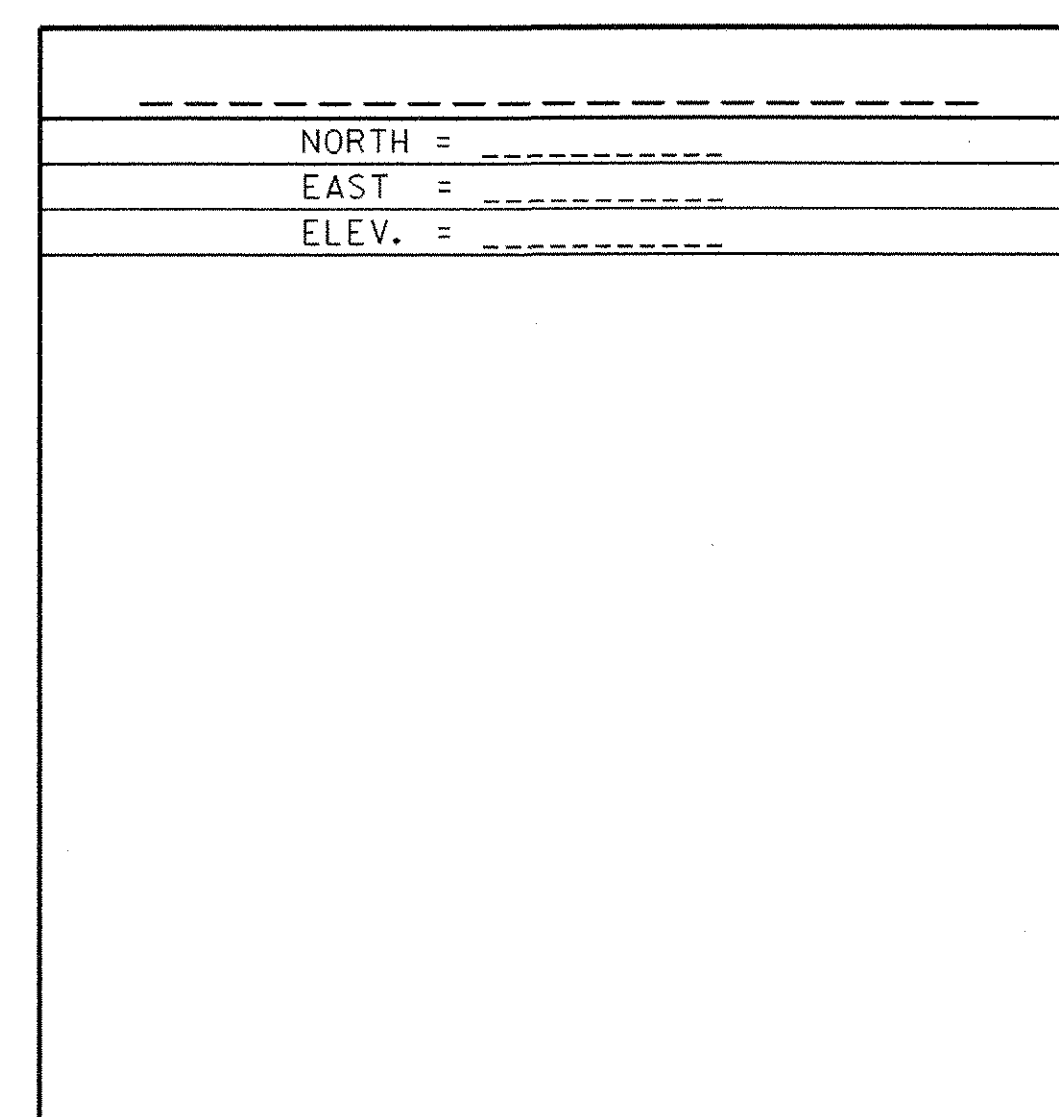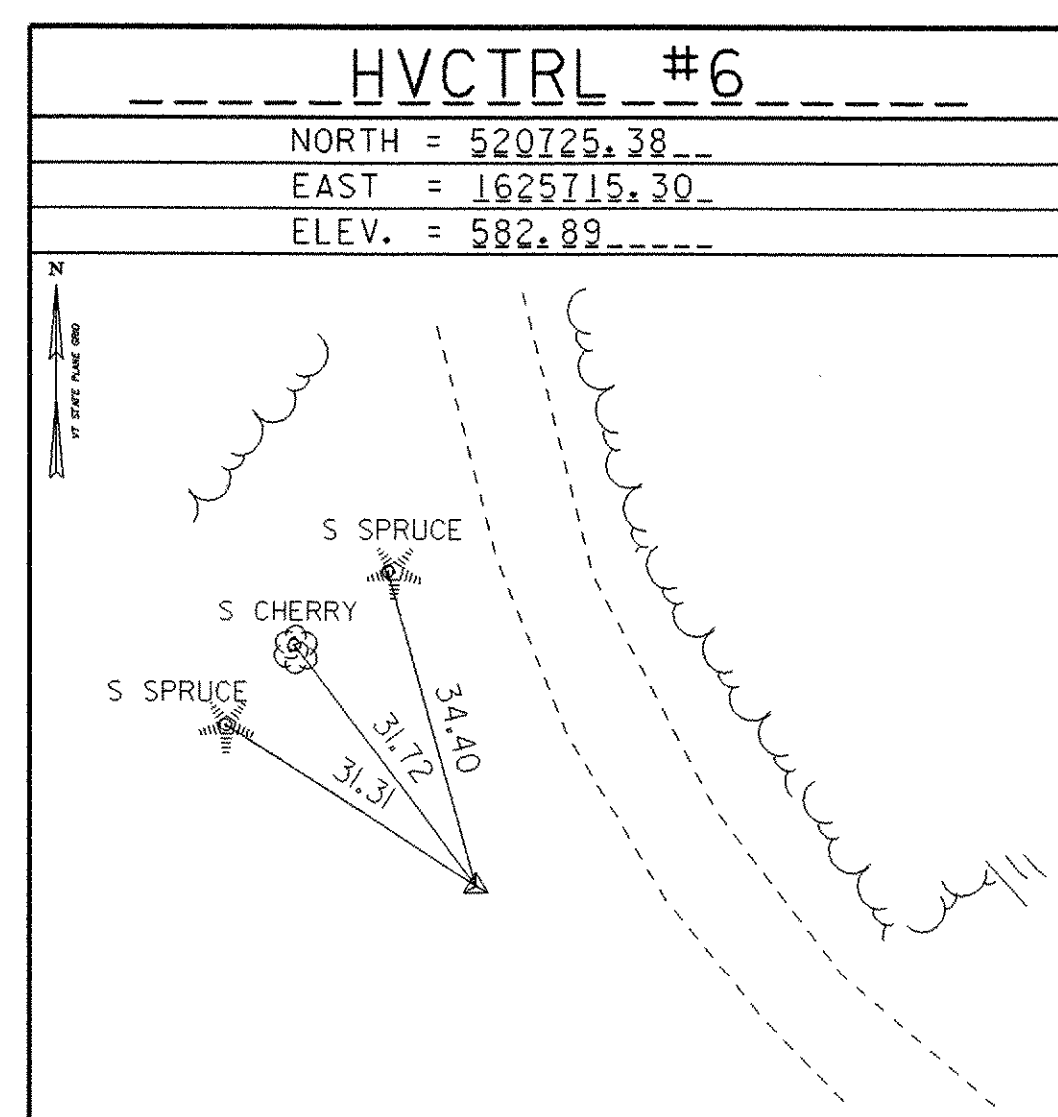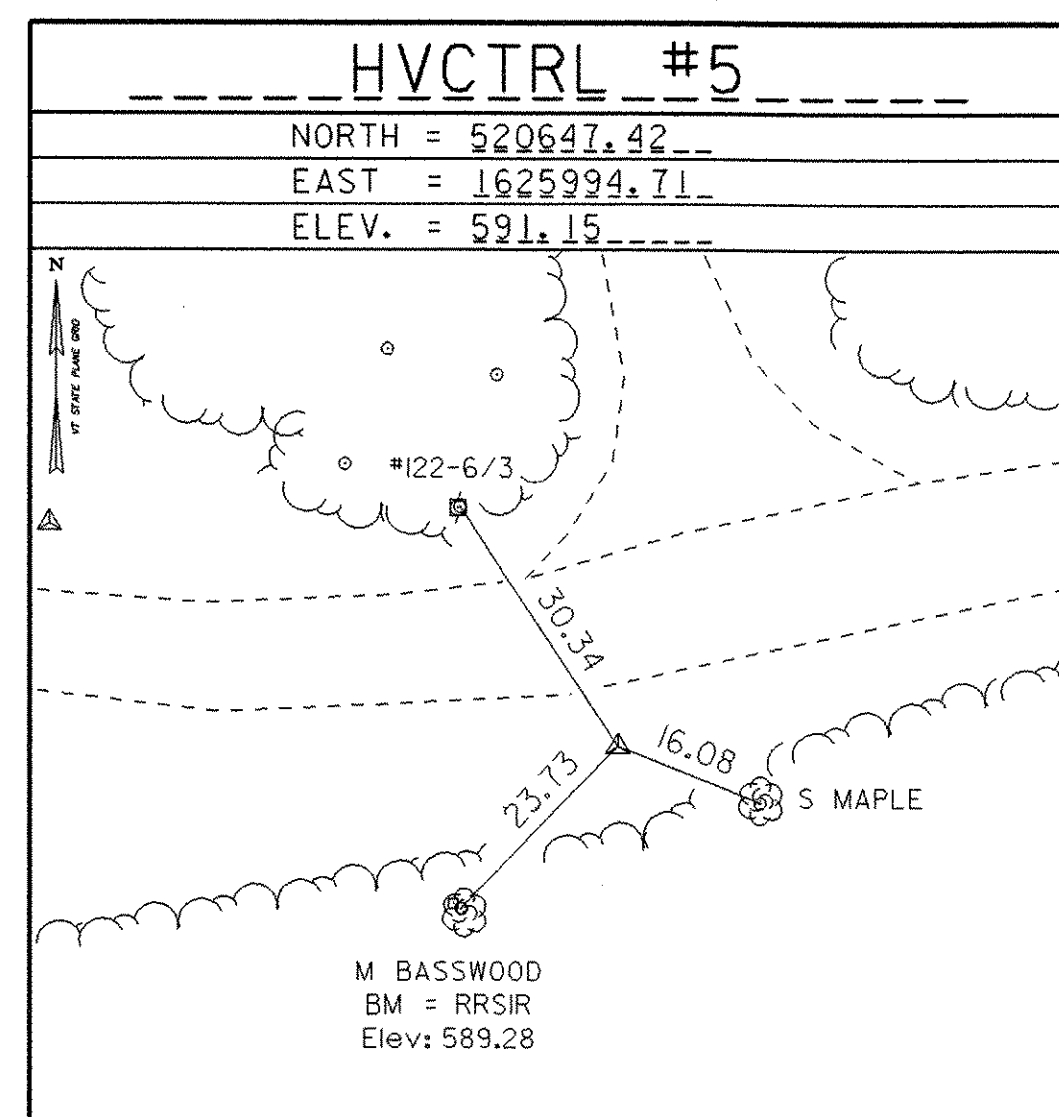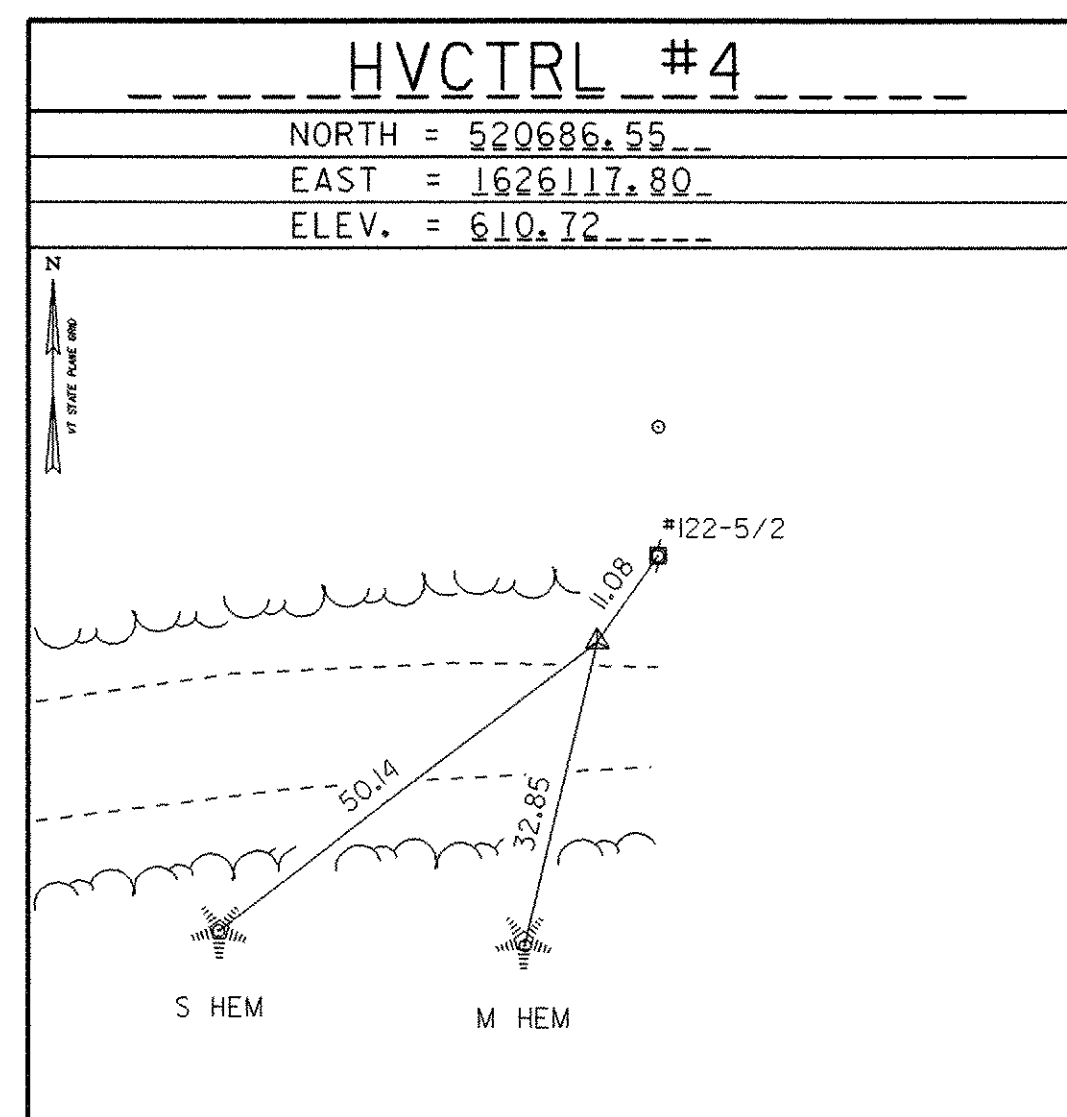

• MAIN TRAVERSE COMPLETED 08/24/05 by B. Gilman, P. C. & P. Winters

ALIGNMENT TIES

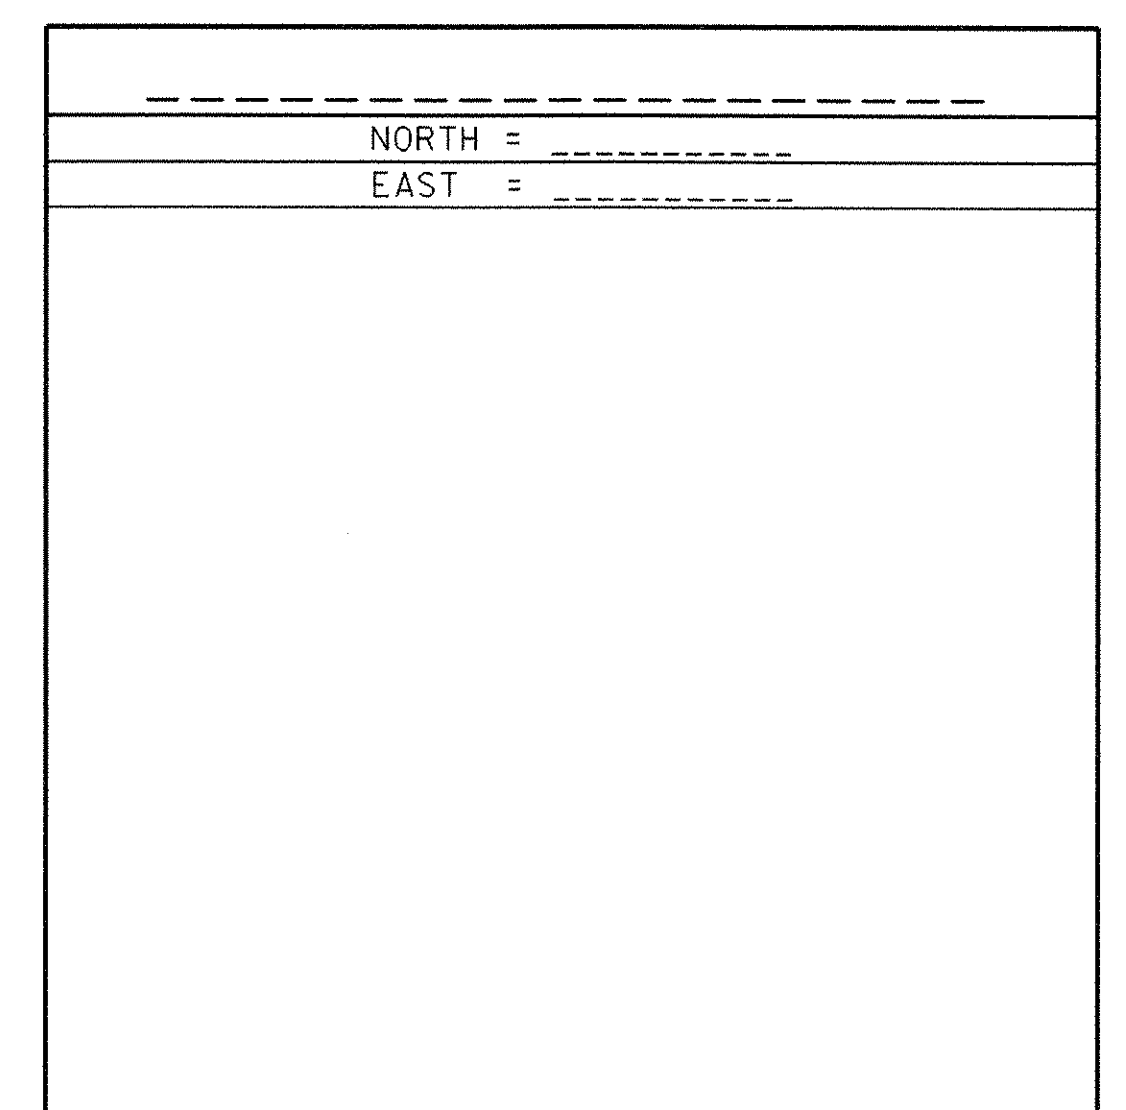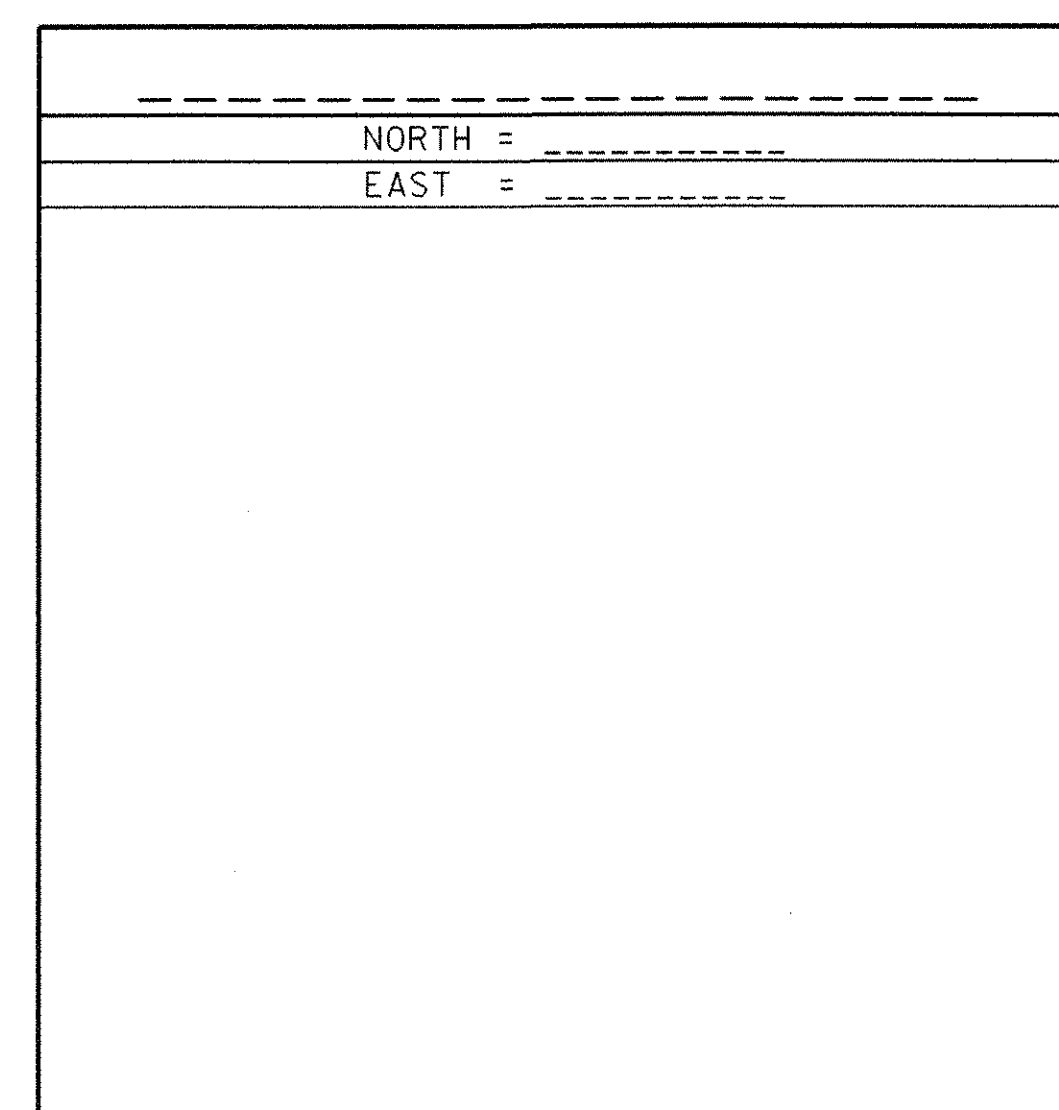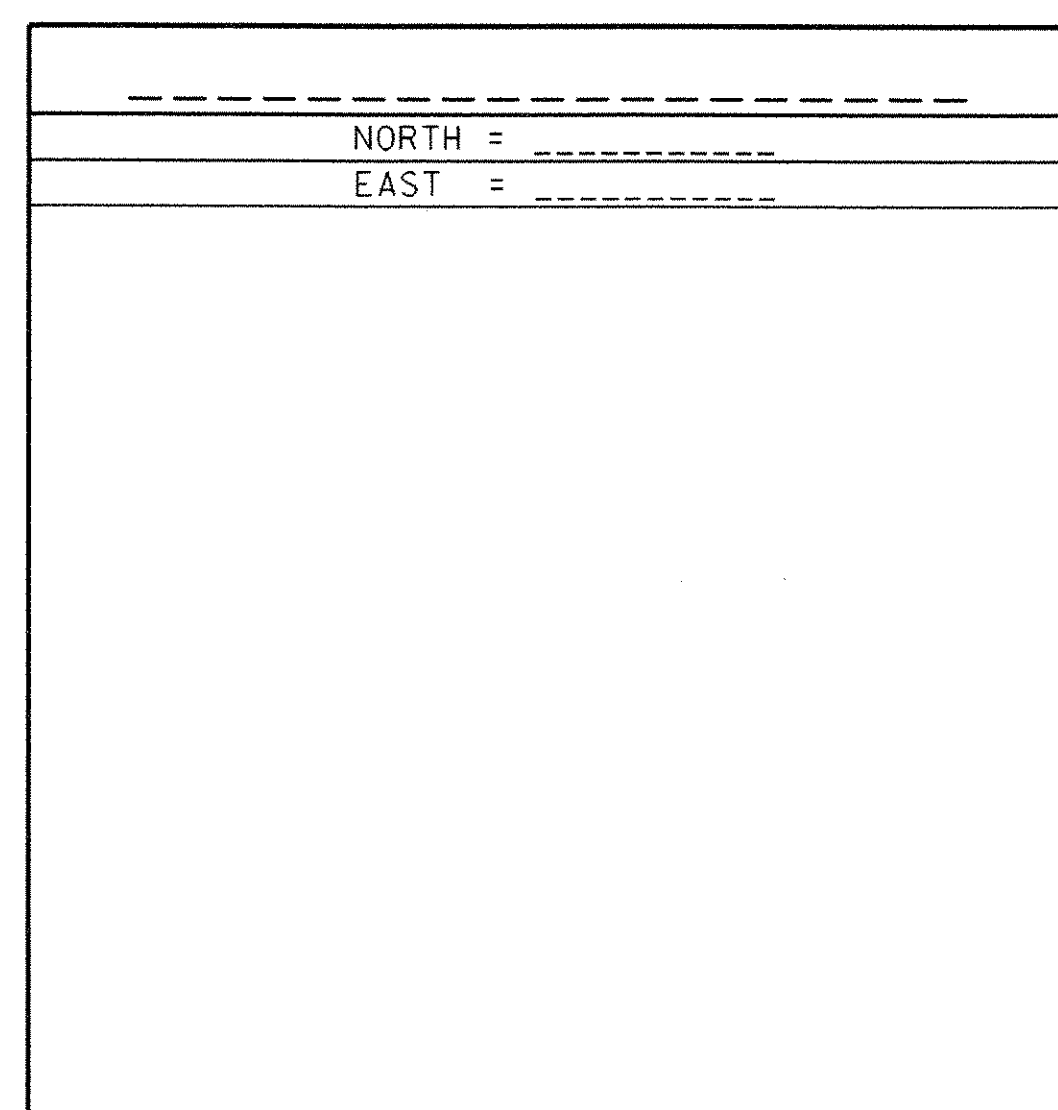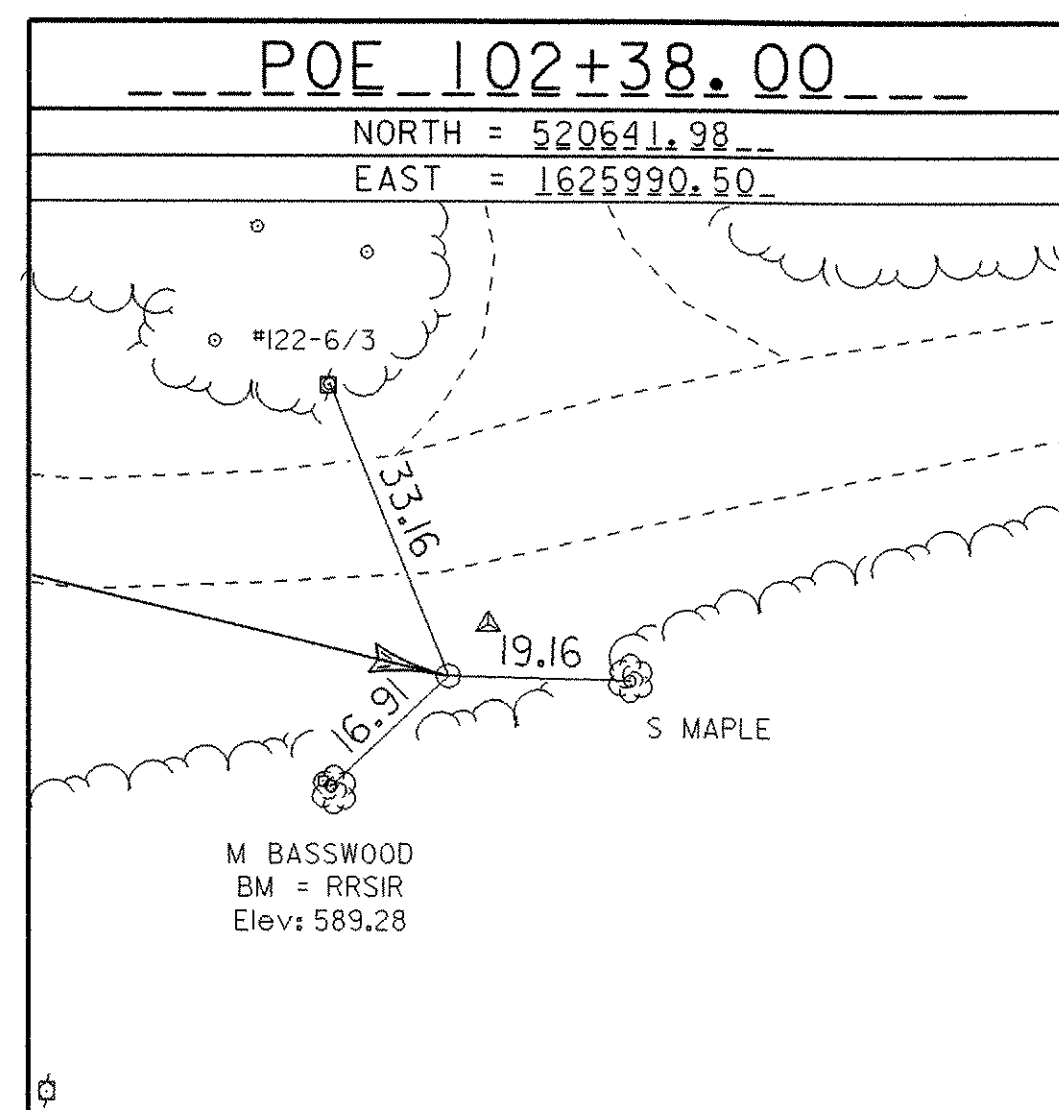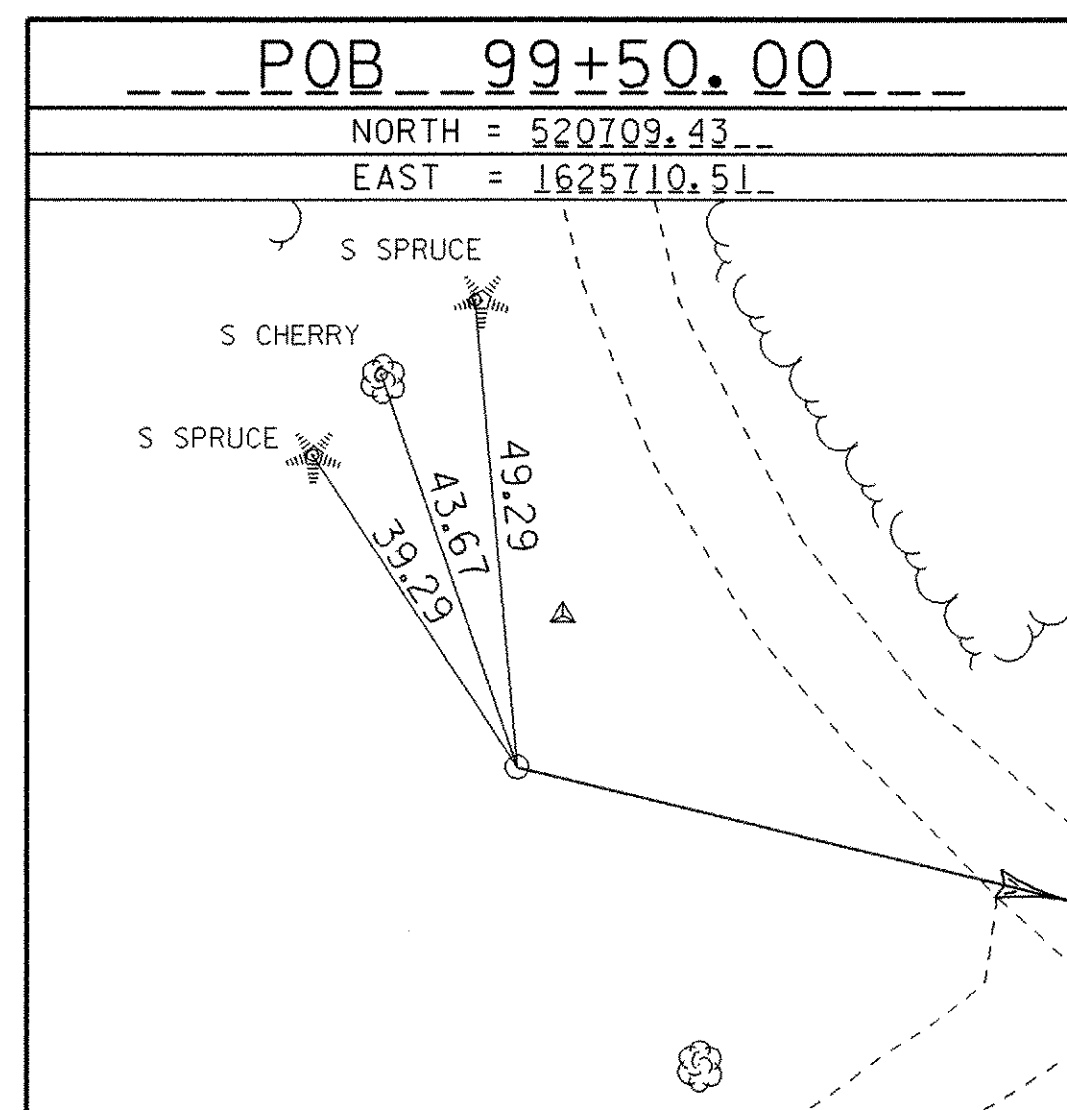

• ALIGNMENT STAKED 12/19/2005 by B. Gilman, P. C. & P. Winters

DATUM

VERTICAL NAVD88
HORIZONTAL NAD 83(96)
ADJUSTMENT COMPOSS

PROJECT NAME: RANDOLPH
PROJECT NUMBER: BHO 1444(50)
FILE NAME: survey\806109411.dgn
PROJECT LEADER: J. WEAVER
DESIGNED BY: J. WEAVER
IIE SHEET: 3 OF 18
PLOT DATE: 4/11/06
DRAWN BY: B. Bullock
CHECKED BY: J. TREI