
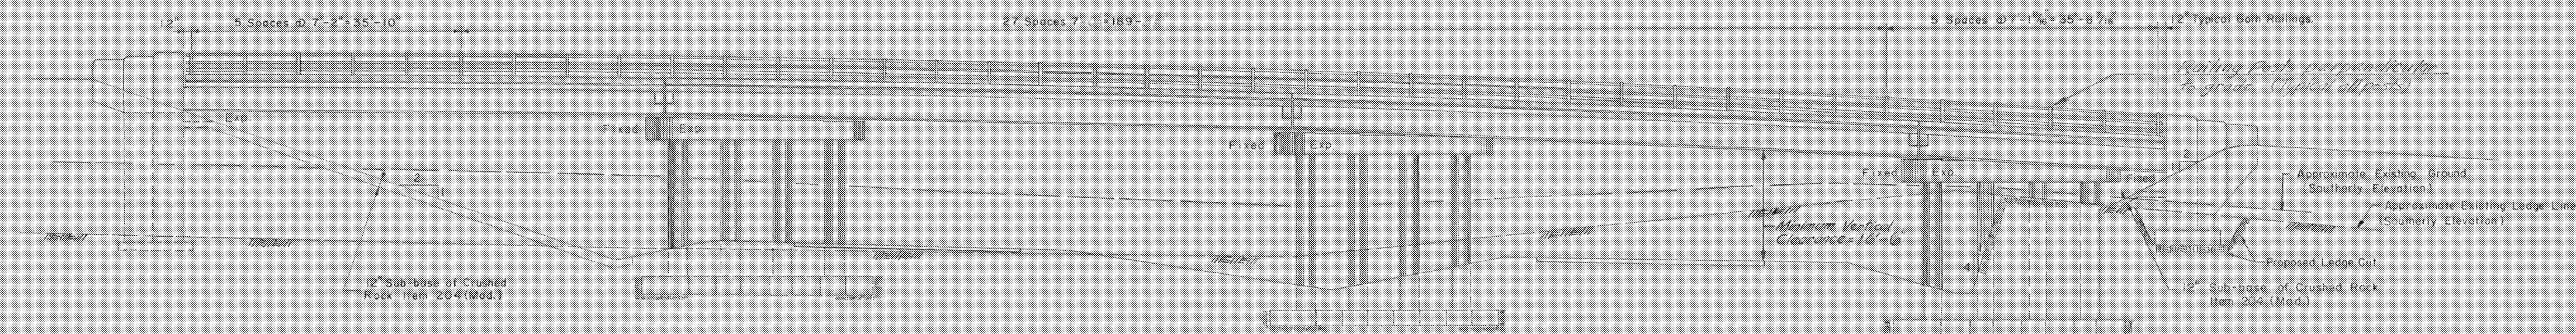


B.P.R.	STATE	PROJECT NO.	SHEET	TOTAL
DIV. NO.	VT.	I 91-1 (17)	211	555

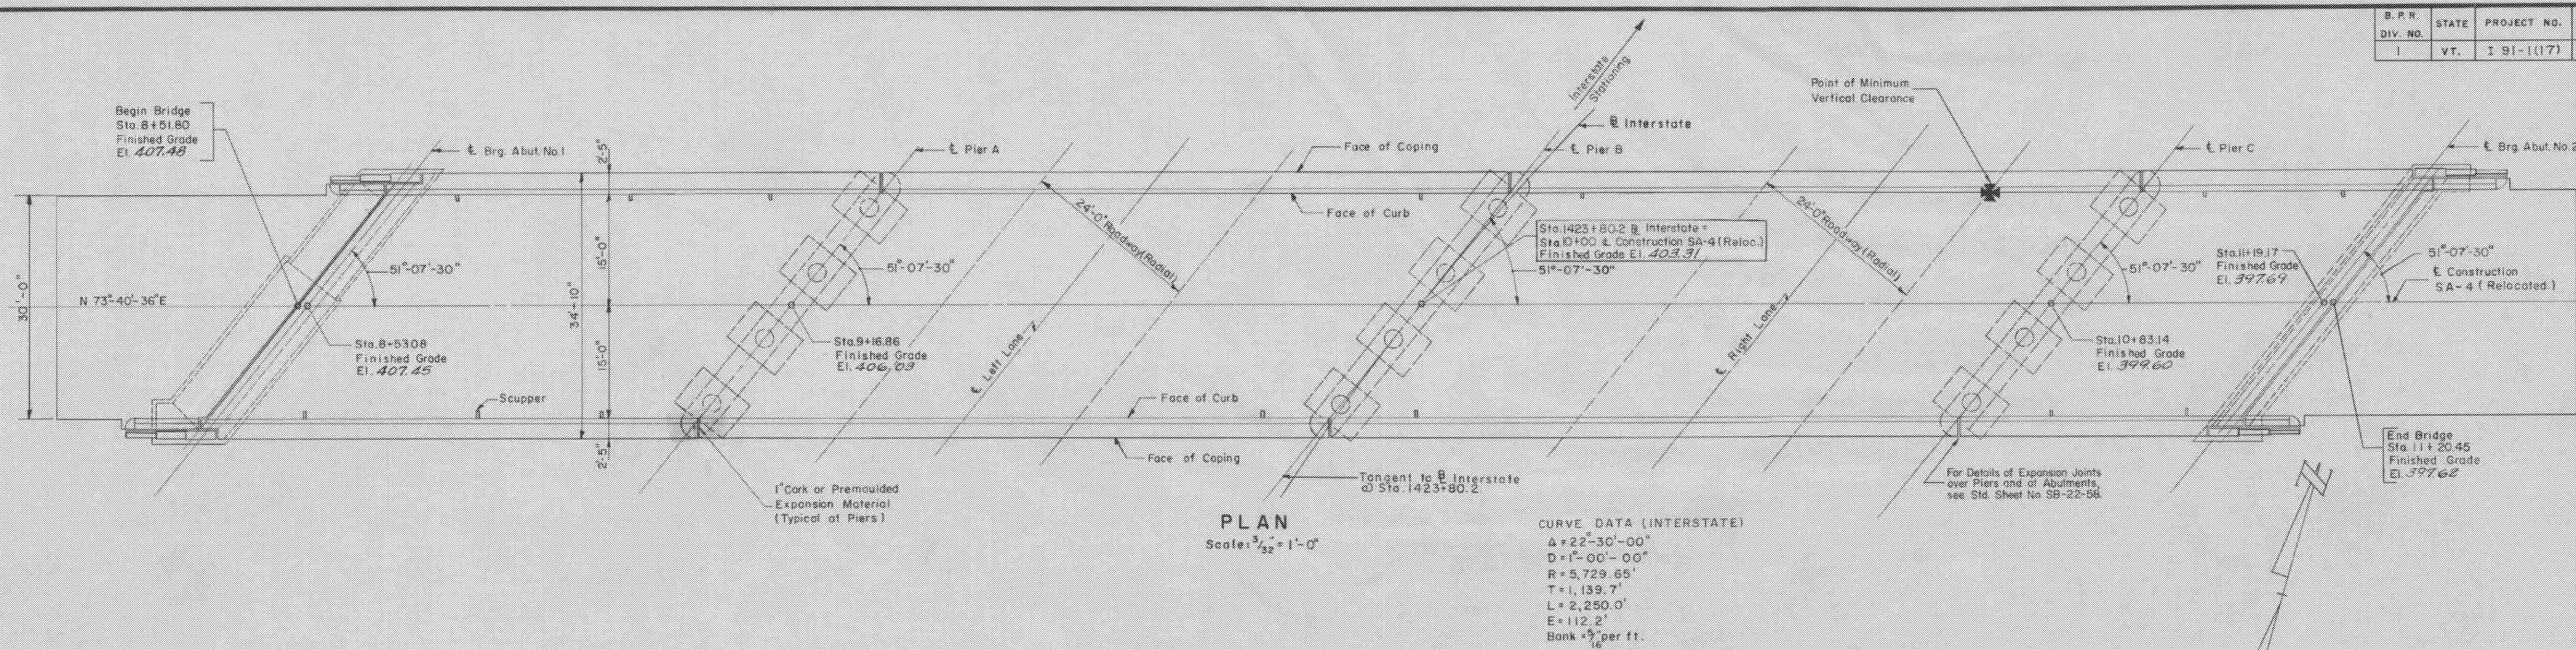

ESTIMATED QUANTITIES

ITEM NO.	DESCRIPTION	UNIT	NET	OVER-RUN	TOTAL	FINAL
556-C	Granite Bridge Curb (Mod.)	L.F.	570	-	570	574
572	Bridge Railing	L.F.	525	-	525	525

- Notes: 1. Railing posts to be set normal to grade.
 2. Omit set screws of one end of railing panel at expansion joints over piers.
 3. All dimensions are horizontal dimensions.
 4. For scupper spacing see Sheet 215.
 5. For Bridge Marker see Drawing SB-20-56 (Detail A).
 6. For Details of Railing see standard Sheet SB-50-60 (1 & 2).

STATEWIDE - SOUTHEAST
 REGION
 BHF MEMB(21)

SHEET 26 OF 34
 BRIDGE D19
 FOR REFERENCE ONLY

BRIDGE 19
 STAGE I CONSTRUCTION
 PLAN AND ELEVATION

STATE OF VERMONT DEPARTMENT OF HIGHWAYS	
INTERSTATE PROJECT in the town of WESTMINSTER	
INTERSTATE	STA. 1423 + 80.2
UNDER	SA-4 (RELOCATED)
THE CLARKSON ENGINEERING CO. INC.	STA. 10+00
BOSTON	CONSULTING ENGINEERS MASSACHUSETTS
SURVEYED BY	CHECKED BY D.S.P.G. SCALE AS NOTED
DRAWN BY A.R.C.	IN CHARGE J.V.B. DATE 12-8-87
PROJECT NO. I 91-1 (17)	SHEET 27 OF 143

CONTRACT NO. 1 37