


STATE OF VERMONT
AGENCY OF TRANSPORTATION



PROPOSED IMPROVEMENT
TOWNS OF ENOSBURG, FERRISBURGH, HINESBURG,
NEW HAVEN, NORTHFIELD, RICHMOND, ST. ALBANS TOWN AND WEYBRIDGE
COUNTIES OF ADDISON, CHITTENDEN, FRANKLIN AND WASHINGTON
VARIOUS TOWN HIGHWAYS

INDEX OF SHEETS
SEE SHEET 2

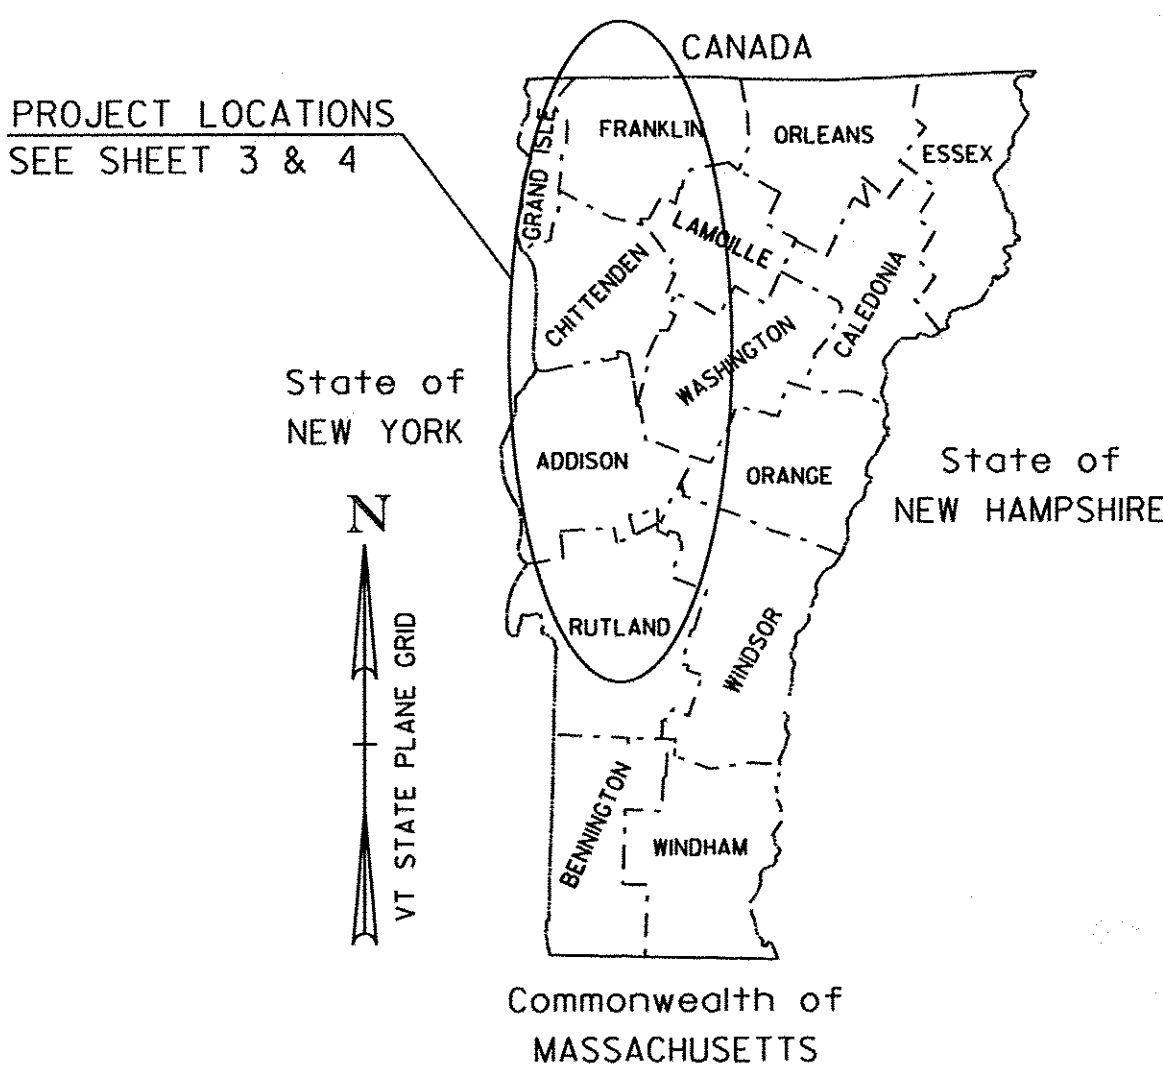

PROJECT DESCRIPTION: WORK TO BE PERFORMED UNDER THIS PROJECT INCLUDES THE REMOVAL OF EXISTING SIGNS & POSTS, PAVEMENT MARKINGS, AND GUARDRAIL, AND THE INSTALLATION OF NEW SIGNS & POSTS, PAVEMENT MARKINGS (CENTERLINE, EDGELINE, SYMBOLS AND LETTERS, AND OTHER RELATED ITEMS FOR THE DESCRIBED WORK.

RECORD PLANS

CONTRACTOR: MIDDLEBURY FENCE COMPANY, LLC - NEW HAVEN, VT

RESIDENT ENGINEER: JEFF COTA

CONSTRUCTION BEGAN: SEPTEMBER 21, 2010

CONSTRUCTION COMPLETE: NOVEMBER 11, 2011

RECORD PLANS BY: JEFF COTA & JENNA HYDE

I HEREBY CERTIFY THAT ALL THE CONSTRUCTION REQUIRED BY THIS SET OF DRAWINGS HAS BEEN ACCOMPLISHED AS INDICATED HEREIN.

BY: [Signature] RESIDENT ENGINEER

DATE: 8/13/12

NOTE: Any further information concerning final quantities, amounts or other details relative to this project may be found at Central Files in the electronic archives.

PROJECT LOCATION:	TH-1.	MM 0.000 - 0.216	ENOSBURG (TYLER BRANCH ROAD)
	TH-2.	MM 0.000 - 0.600	ENOSBURG (BOSTON POST ROAD)
	TH-5.	MM 0.000 - 3.540	FERRISBURGH (LITTLE CHICAGO ROAD)
	TH-7.	MM 0.000 - 0.903	NEW HAVEN (PEARSON ROAD)
	TH-8.	MM 0.000 - 1.500	NORTHFIELD (UNION BROOK ROAD)
	TH-1.	MM 0.000 - 4.300	RICHMOND (HUNTINGTON ROAD)
	TH-2.	MM 0.000 - 0.149	RICHMOND (HINESBURG ROAD)
	TH-14.	MM 0.000 - 3.200	ST. ALBANS (KELLOGG ROAD)
	TH-11.	MM 0.000 - 1.628	WEYBRIDGE (MORGAN HORSE FARM ROAD)

PROJECT LENGTHS:	0.216	MILES	(1140.48 FT)
	0.600	MILES	(3168.00 FT)
	3.540	MILES	(18691.20 FT)
	0.903	MILES	(4767.84 FT)
	1.500	MILES	(7920.00 FT)
	4.300	MILES	(22704.00 FT)
	0.149	MILES	(786.72 FT)
	3.200	MILES	(16896.00 FT)
	1.628	MILES	(8595.84 FT)
TOTAL LENGTH OF PROJECT:	16.036	MILES	(84670.08 FT)

QUALITY ASSURANCE PROGRAM: LEVEL

CONVENTIONAL SYMBOLS	
COUNTY LINE	
TOWN LINE	
LIMITS OF ACCESS	
POINT OF ACCESS	
FENCE LINE	
STONE WALL	
TRAVELED WAY	
GUARD RAIL	
RAILROAD	
SURVEY LINE	
CULVERT	
POWER POLE	
TELEPHONE POLE	
TREES	
CONTROL OF ACCESS	
PROPERTY LINE	
R.O.W. TAKING LINE	
SLOPE RIGHTS	
TOP OF CUT	
TOE OF SLOPE	
ROAD/PC/GR/ND	

SURVEYED BY :	N/A
SURVEYED DATE :	N/A
DATUM	
VERTICAL	N/A
HORIZONTAL	N/A

THESE PLANS ARE SUBJECT TO SUCH ENGINEERING CHANGES AS MAY BE REQUIRED BY THE FEDERAL HIGHWAY ADMINISTRATION OR THE DIRECTOR OF PROGRAM DEVELOPMENT.

CONSTRUCTION IS TO BE CARRIED ON IN ACCORDANCE WITH THESE PLANS AND THE STANDARD SPECIFICATIONS FOR CONSTRUCTION DATED 2006, AS APPROVED BY THE FEDERAL HIGHWAY ADMINISTRATION ON JUNE 15, 2006 FOR USE ON THIS PROJECT, INCLUDING ALL SUBSEQUENT REVISIONS AND SUCH REVISED SPECIFICATIONS AND SPECIAL PROVISIONS AS ARE INCORPORATED IN THESE PLANS.

DIRECTOR OF PROGRAM DEVELOPMENT

APPROVED: _____ DATE: _____

PROJECT MANAGER : JOSH SCHULTZ

PROJECT NAME : STATEWIDE NORTHWEST REGION

PROJECT NUMBER : STP HRRR(5)

SHEET 1 OF 51 SHEETS

1	TITLE SHEET
2	INDEX OF SHEETS & GENERAL NOTES
3-4	LOCATION MAPS 1-2
5	QUANTITY SHEET
6-7	GENERAL SIGN DETAILS 1-2
8	SPECIFIC SIGN DETAILS FOR ENOSBURG, NORTHFIELD, NEW HAVEN, AND WEYBRIDGE
9	SPECIFIC SIGN DETAILS FERRISBURGH
10	SPECIFIC SIGN DETAILS RICHMOND
11	SPECIFIC SIGN DETAILS RICHMOND AND ST. ALBANS
12-16	ENOSBURG TRAFFIC SIGN SUMMARY SHEETS 1-5
17-22	FERRISBURGH TRAFFIC SIGN SUMMARY SHEETS 1-6
23-26	NEW HAVEN TRAFFIC SIGN SUMMARY SHEETS 1-4
27-29	NORTHFIELD TRAFFIC SIGN SUMMARY SHEETS 1-3
30-40	RICHMOND TRAFFIC SIGN SUMMARY SHEETS 1-11
41-45	ST. ALBANS TRAFFIC SIGN SUMMARY SHEETS 1-5
46	WEYBRIDGE TRAFFIC SIGN SUMMARY SHEET
47	TOWN TOTAL SIGN SUMMARY SHEET
48	TOWN HIGHWAY PAVEMENT MARKINGS
49	ITEM DETAIL SUMMARY SHEET
50-51	TRAFFIC CONTROL SHEETS 1-2

STANDARDS

E-121	STANDARD SIGN PLACEMENT- CONVENTIONAL ROAD	08/08/1995
E-123	GUIDE SIGN PLACEMENT - MISCELLANEOUS DETAILS	03/16/2004
E-127	ROUTE MARKINGS AT RURAL INTERSECTIONS	08/08/1995
E-136B	STATE ROUTE MARKER SIGN DETAILS	08/08/1995
E-136C	STATE NUMBERED TOWN HIGHWAY SIGN DETAILS	08/08/1995
E-138	MILEMARKER DETAILS - STATE AND TOWN HIGHWAYS	05/30/2003
E-145A	REGULATORY SIGN DETAILS - LANE USE CONTROL SIGNS	12/23/1994
E-154	WARNING SIGN DETAILS	05/01/2004
E-164	SQUARE STEEL SIGN POST	06/08/2009
E-191	PAVEMENT MARKING DETAILS	02/01/1999
E-193	PAVEMENT MARKING DETAILS	08/18/1995
G-1	STEEL BEAM GUARDRAIL DETAILS (POST, DELINEATORS, TYPICALS)	01/03/2000
G-1d	STEEL BEAM GUARDRAIL DETAILS (END TERMINAL, ANCHOR, MEDIAN)	01/03/2000
G-19	GENERIC GRADING PLANS FOR GUARDRAIL END TERMINALS	11/15/2002

VAOT RURAL AREA MIX					
	LBS/AC				
% WEIGHT	BROADCAST	HYDROSEED	NAME	GERM %	PURITY %
37.5%	22.5	45	CREEPING RED FESCUE	85%	98%
37.5%	22.5	45	TALL FESCUE	90%	95%
5.0%	3	6	RED TOP	90%	95%
15.0%	9	18	BIRDSFOOT TREFOIL	85%	98%
5.0%	3	6	ANNUAL RYE GRASS	85%	95%
100%	60	120			

GENERAL GUIDANCE			
FERTILIZER		LIME	
BROADCAST	HYDROSEED	BROADCAST	HYDROSEED
10-20-10	19-19-19	PELLETIZED	LIQUID
500 LBS/AC		2 TONS/AC	4.4 GAL/AC

CONSTRUCTION GUIDANCE

- 1.RURAL SEED MIX: USE AS INDICATED IN THE PLANS AND/OR FOR ALL ESTABLISHED UPLAND (NON WETLAND) AREAS DISTURBED BY THE CONTRACTOR.
- 2.ALL SEED MIXTURES: SHALL NOT HAVE A WEED CONTENT EXCEEDING 0.40% BY WEIGHT AND SHALL BE FREE OF ALL NOXIOUS SEED.
- 3.FERTILIZER AND LIMESTONE: SHALL FOLLOW RATES SHOWN ON PLAN OR AS DIRECTED BY THE ENGINEER
- 4.HAY MULCH: TO BE PLACED ON EARTH SLOPES AT THE RATE OF 2 TONS/ACRE , ACHIEVE 90% GROUND COVER OR AS DIRECTED BY THE ENGINEER.
- 5.TOPSOIL: TO BE USED WITH SEED AS INDICATED ON THE PLANS , OR AS DIRECTED BY THE ENGINEER.
- 6.HYDROSEEDING: ALTHOUGH GUIDANCE IS GIVEN ABOVE THE SITE CONDITIONS AND THE TYPE OF HYDROSEED WILL ULTIMATELY DICTATE THE AMOUNTS AND TYPES OF SOIL AMENDMENTS TO BE APPLIED
- 7.TURF ESTABLISHMENT: PLACING SEED , FERTILIZER , LIME AND MULCH PRIOR TO SEPTEMBER 15 AND AFTER APRIL 15 CAN BETTER ENSURE A VIGOROUS GROWTH OF GRASS.


ADAPTED FROM VTRANS TECHNICAL LANSCAPE MAUAL FOR ROADWAYS AND TRANSPORTATION FACILITIES	TURF ESTABLISHMENT
---	--------------------

REVISIONS	
JUNE 23, 2009	WHF
JANUARY 15, 2010	WHF


GENERAL NOTES

1. ALL NEW SIGNS SHALL BE IN ACCORDANCE WITH THESE PLANS, THE LATEST EDITION OF THE 2009 MANUAL ON UNIFORM TRAFFIC CONTROL DEVICES (MUTCD), THE STANDARD HIGHWAY SIGNS BOOK (SHS)PUBLISHED BY THE FEDERAL HIGHWAY ADMINISTRATION (FHWA), AND APPLICABLE VTRANS E-SERIES STANDARDS OR AS DIRECTED BY THE ENGINEER. SIGN LOCATIONS AS SHOWN ON THE PLANS ARE APROXIMATE. EXACT LOCATIONS TO BE DETERMINED BY THE ENGINEER IN THE FIELD.
2. ALL SIGNS WITHIN THE PROJECT LIMITS ARE TO BE REPLACED UNLESS OTHERWISE NOTED OR AS DIRECTED BY THE RESIDENT ENGINEER.
3. THE CONTRACTOR SHALL BE RESPONSIBLE FOR REPAIRING ANY DAMAGE TO PRIVATE OR PUBLIC PROPERTY CAUSED BY THE CONTRACTOR, AT THE CONTRACTORS'S EXPENSE.
4. EXISTING STREET NAME SIGNS ATTACHED TO SIGN POSTS THAT ARE TO BE REPLACED, SHALL BE REMOVED AND INSTALLED ONTO NEW POSTS. ALL WORK AND MATERIALS NECESSARY TO REMOVE AND INSTALL THE STREET NAME SIGNS SHALL BE PAID UNDER ITEM 675.50 REMOVING SIGNS. AN ESTIMATED QUANTITY FOR ERECTING SALVAGEDDD SIGNS, PAY ITEM 675.60 AND SETTING SALVAGED POSTS PAY ITEM 675.61WAS ADDED TO THE QUANTITY SHEET TO PAY FOR THIS WORK. ALL EXISTING STREET NAME SIGNS INSTALLED ON STAND ALONE SIGN POSTS SHALL BE RETAINED WITHIN THE PROJECT LIMITS, UNLESS OTHERWISE NOTED OR AS DIRECTED BY THE RESIDENT ENGINEER. .
5. ALL SIGN PLACEMENT SHALL BE IN CONFORMANCE WITH STATE STANDARD E-121DRAWINGS.
6. ALL SIGN LETTERING, DIGITS, ARROWS, AND DESIGN OF SYMBOLS FOR SIGNS DETAILED IN THESE PLANS SHALL CONFORM WITH THE "STANDARD ALPHABET FOR HIGHWAY SIGNS AND PAVEMENT MARKING" AS ADOPTED BY THE U.S. DEPARTMENT OF TRANSPORTATION AND THE FEDERAL HIGHWAY ADMINISTRATION (FHWA), UNLESS OTHERWISE DETAILED WITHIN THESE PLANS.
7. WITHIN THE TRAFFIC SIGN SUMMARY SHEETS FY= FLUORESCENT YELLOW SHEETING (ASTM TYPE VII, VIII, OR IX) AND FYG = FLUORESCENT YELLOW-GREEN SHEETING (ASTM TYPE VII, VIII, OR IX). REFER TO ITEM 750.08 RETRORREFLECTIVE SHEETING. NOTE THESE ABBREVIATIONS CAN BE FOUND UNDER SHEETING REMARKS ON THE TRAFFIC SIGN SUMMARY SHEET INCLUDED WITHIN THESE PROJECT PLANS.
8. UNLESS OTHERWISE DETAILED ON THE PLANS, ALL SIGN BASE MATERIAL SHALL BE FLAT SHEET ALUMINUM WITH THE FOLLOWING MINIMUM THICKNESSES:

SIZES				
	24" X 8"			
	24" X 10"			
	24" X 12"			
	24" X 18"			
	24" X 24"			
	24" X 30"			
	30" X 8"	36" X 12"		
	30" X 15"	36" X 15"		
	30" X 18"	36" X 18"	48" X 18"	
	30" X 30"	36" X 24"	48" X 24"	
	30" X 42"	30" X 42"	48" X 30"	
	12" X 12"	36" X 8"	36" X 36"	48" X 42"
	18" X 18"	42" X 8"	36" X 48"	48" X 48"
	21" X 15"	48" X 8"	36" X 54"	48" X 60"
THICKNESS	0.060"	0.080"	0.100"	0.125"

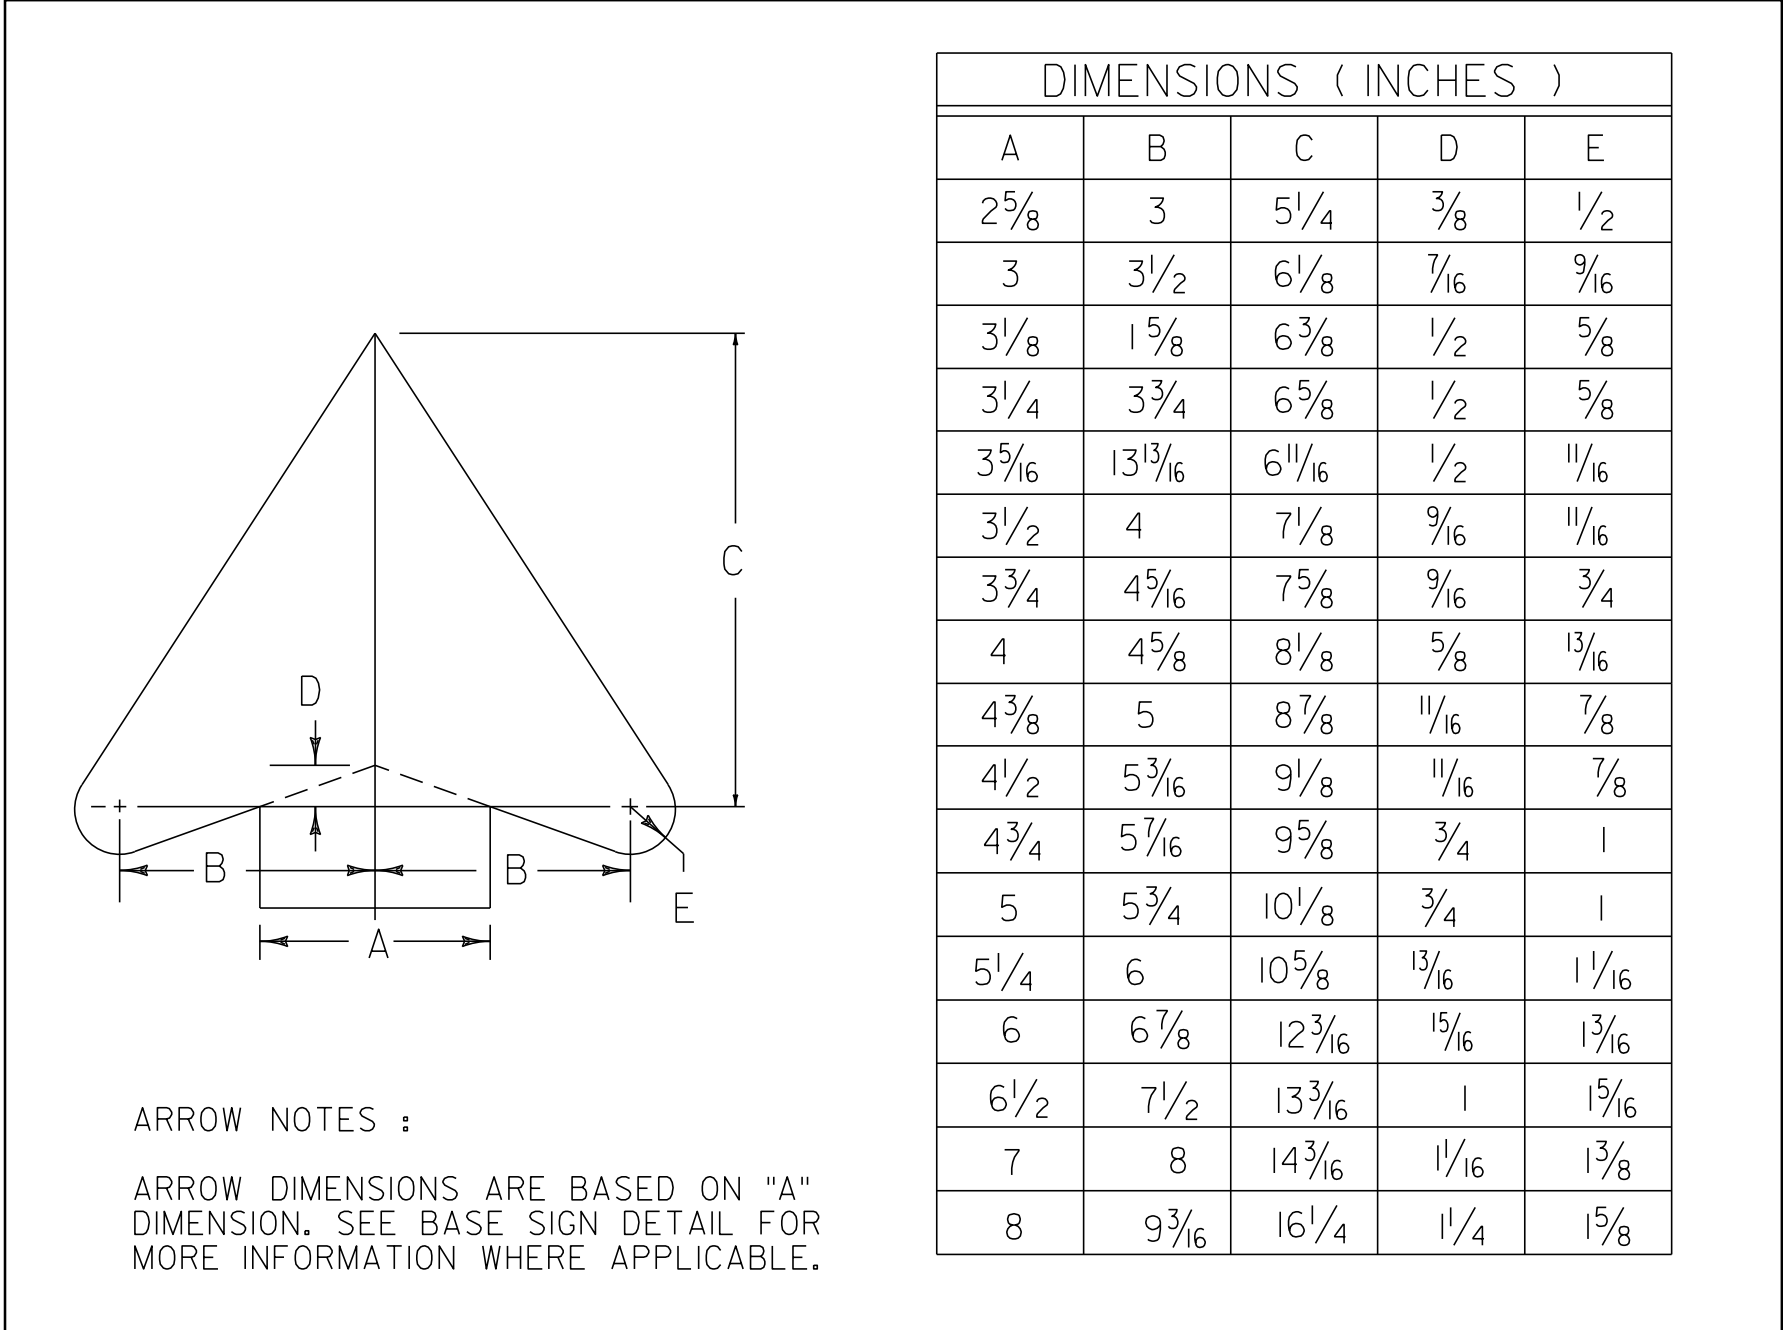

DIMENSIONS (INCHES)				
A	B	C	D	E
2 ⁵ / ₈	3	5 ¹ / ₄	3 ⁷ / ₈	1 ¹ / ₂
3	3 ¹ / ₂	6 ¹ / ₈	7 ¹ / ₁₆	9 ¹ / ₁₆
3 ¹ / ₈	1 ⁵ / ₈	6 ³ / ₈	1 ¹ / ₂	5 ⁵ / ₈
3 ¹ / ₄	3 ³ / ₄	6 ⁵ / ₈	1 ¹ / ₂	5 ⁵ / ₈
3 ⁵ / ₁₆	13 ¹³ / ₁₆	6 ¹¹ / ₁₆	1 ¹ / ₂	11 ¹ / ₁₆
3 ¹ / ₂	4	7 ¹ / ₈	9 ¹ / ₁₆	11 ¹ / ₁₆
3 ³ / ₄	4 ⁵ / ₁₆	7 ⁵ / ₈	9 ¹ / ₁₆	3 ³ / ₄
4	4 ⁵ / ₈	8 ¹ / ₈	5 ⁵ / ₈	13 ¹ / ₁₆
4 ³ / ₈	5	8 ⁷ / ₈	11 ¹ / ₁₆	7 ⁷ / ₈
4 ¹ / ₂	5 ³ / ₁₆	9 ¹ / ₈	11 ¹ / ₁₆	7 ⁷ / ₈
4 ³ / ₄	5 ⁷ / ₁₆	9 ⁵ / ₈	3 ³ / ₄	1
5	5 ³ / ₄	10 ¹ / ₈	3 ³ / ₄	1
5 ¹ / ₄	6	10 ⁵ / ₈	13 ¹ / ₁₆	1 ¹ / ₁₆
6	6 ⁷ / ₈	12 ³ / ₁₆	15 ¹ / ₁₆	13 ¹ / ₁₆
6 ¹ / ₂	7 ¹ / ₂	13 ³ / ₁₆	1	15 ¹ / ₁₆
7	8	14 ³ / ₁₆	11 ¹ / ₁₆	13 ³ / ₈
8	9 ³ / ₁₆	16 ¹ / ₄	11 ¹ / ₄	15 ³ / ₈

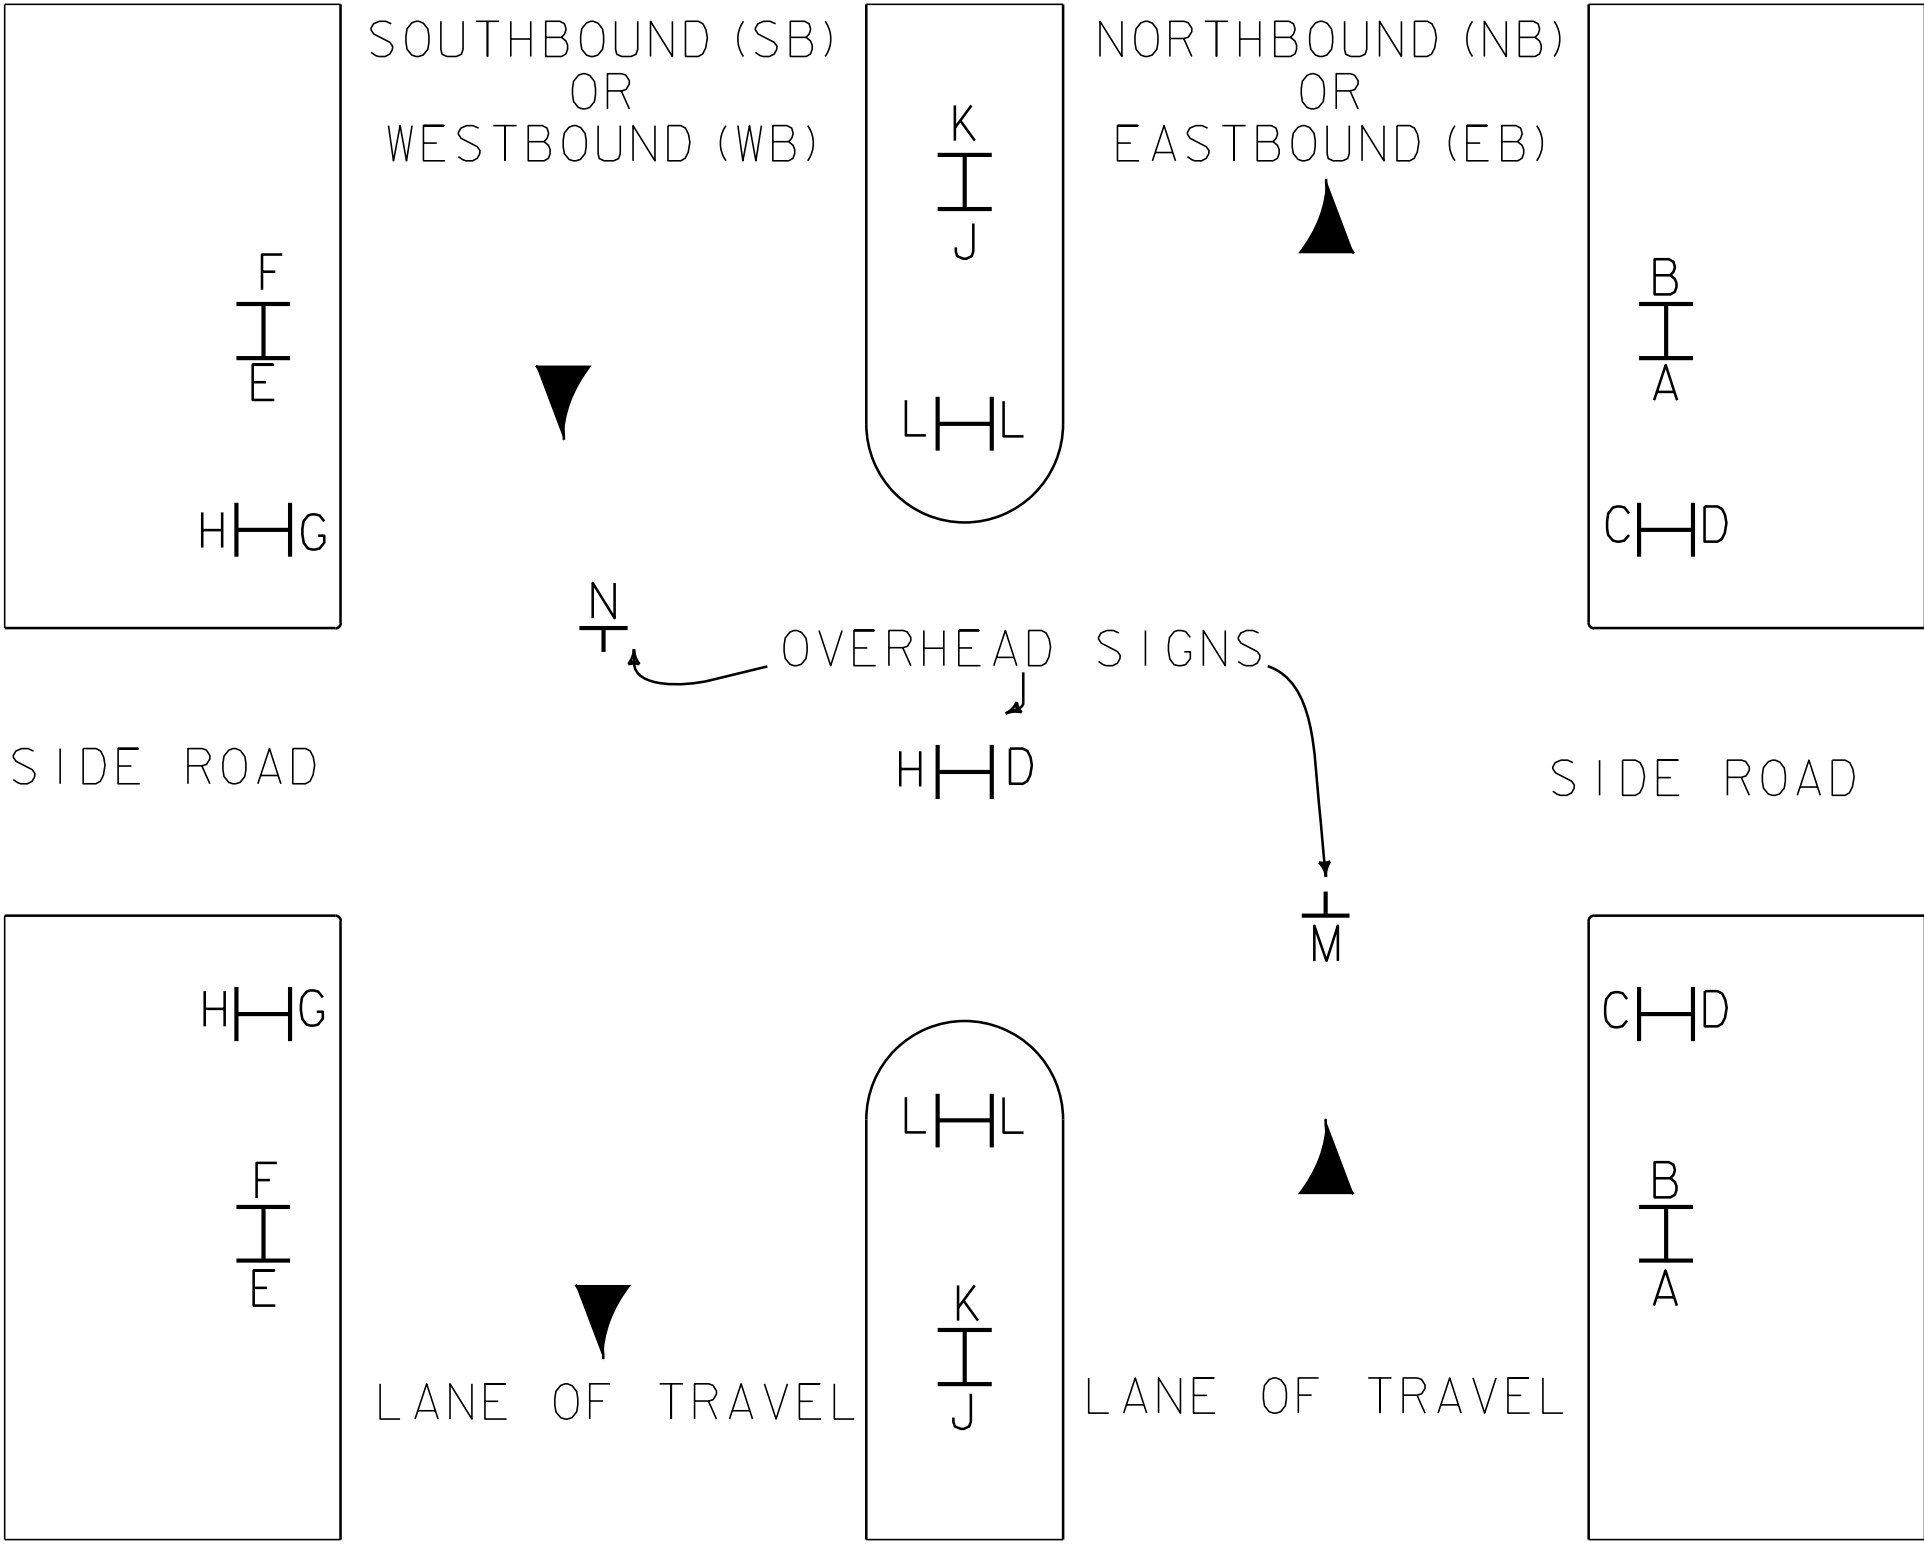

THE TRAFFIC SIGN LOCATION CODES ARE TO BE USED IN CONJUNCTION WITH THE SIGN SUMMARY SHEETS TO ESTABLISH PROPER SIGN INSTALLATION IN THE FIELD.

TRAFFIC SIGN LOCATION CODES

NOT TO SCALE


GUARDRAIL GENERAL NOTES

1. STEEL BEAM GUARDRAIL WITH STEEL POSTS SHALL BE USED ON THIS PROJECT.
2. ESTIMATED QUANTITIES OF ITEMS 608.25 ALL PURPOSE EXCAVATOR RENTAL, TYPE 1; 608.37 TRUCK RENTAL; AND 608.40 LOADER RENTAL, TYPE 1; ARE INCLUDED FOR THE PROVISION OF CONSTRUCTING GUARDRAIL END SECTION FLARES WITH EXCAVATED MATERIAL. AN ESTIMATED QUANTITY OF ITEM 203.30 EARTH BORROW HAS BEEN INCLUDED IN THE CASE THAT THE DITCHING MATERIAL IS NOT SUITABLE TO USE IN THE GUARDRAIL END SECTION FLARE AREA. 25 CUBIC YARDS OF EARTH MATERIAL HAS BEEN ESTIMATED FOR EACH NEW GUARDRAIL END SECTION FLARE. ITEM 653.20 TEMPORARY EROSION MATTING SHALL BE PLACED ON ALL SLOPES CREATED BY THE GUARDRAIL END SECTION FLARE. THE QUANTITIES INCLUDED REFLECT 25 SY OF ITEM 653.20 TEMPORARY EROSION MATTING FOR EACH NEW GUARDRAIL END SECTION FLARE.

PROJECT NAME:	STATEWIDE NORTHWEST REGION
PROJECT NUMBER:	STP HRRR(5)


FILE NAME: 10k018_wrk.dgn	PLOT DATE: 17-SEP-2012 11:31
PROJECT LEADER: JLS	DRAWN BY: NLA
DESIGNED BY: NLA	CHECKED BY: JLS
INDEX OF SHEETS & GENERAL NOTES	SHEET 2 OF 51

TOWN OF ENOSBURG

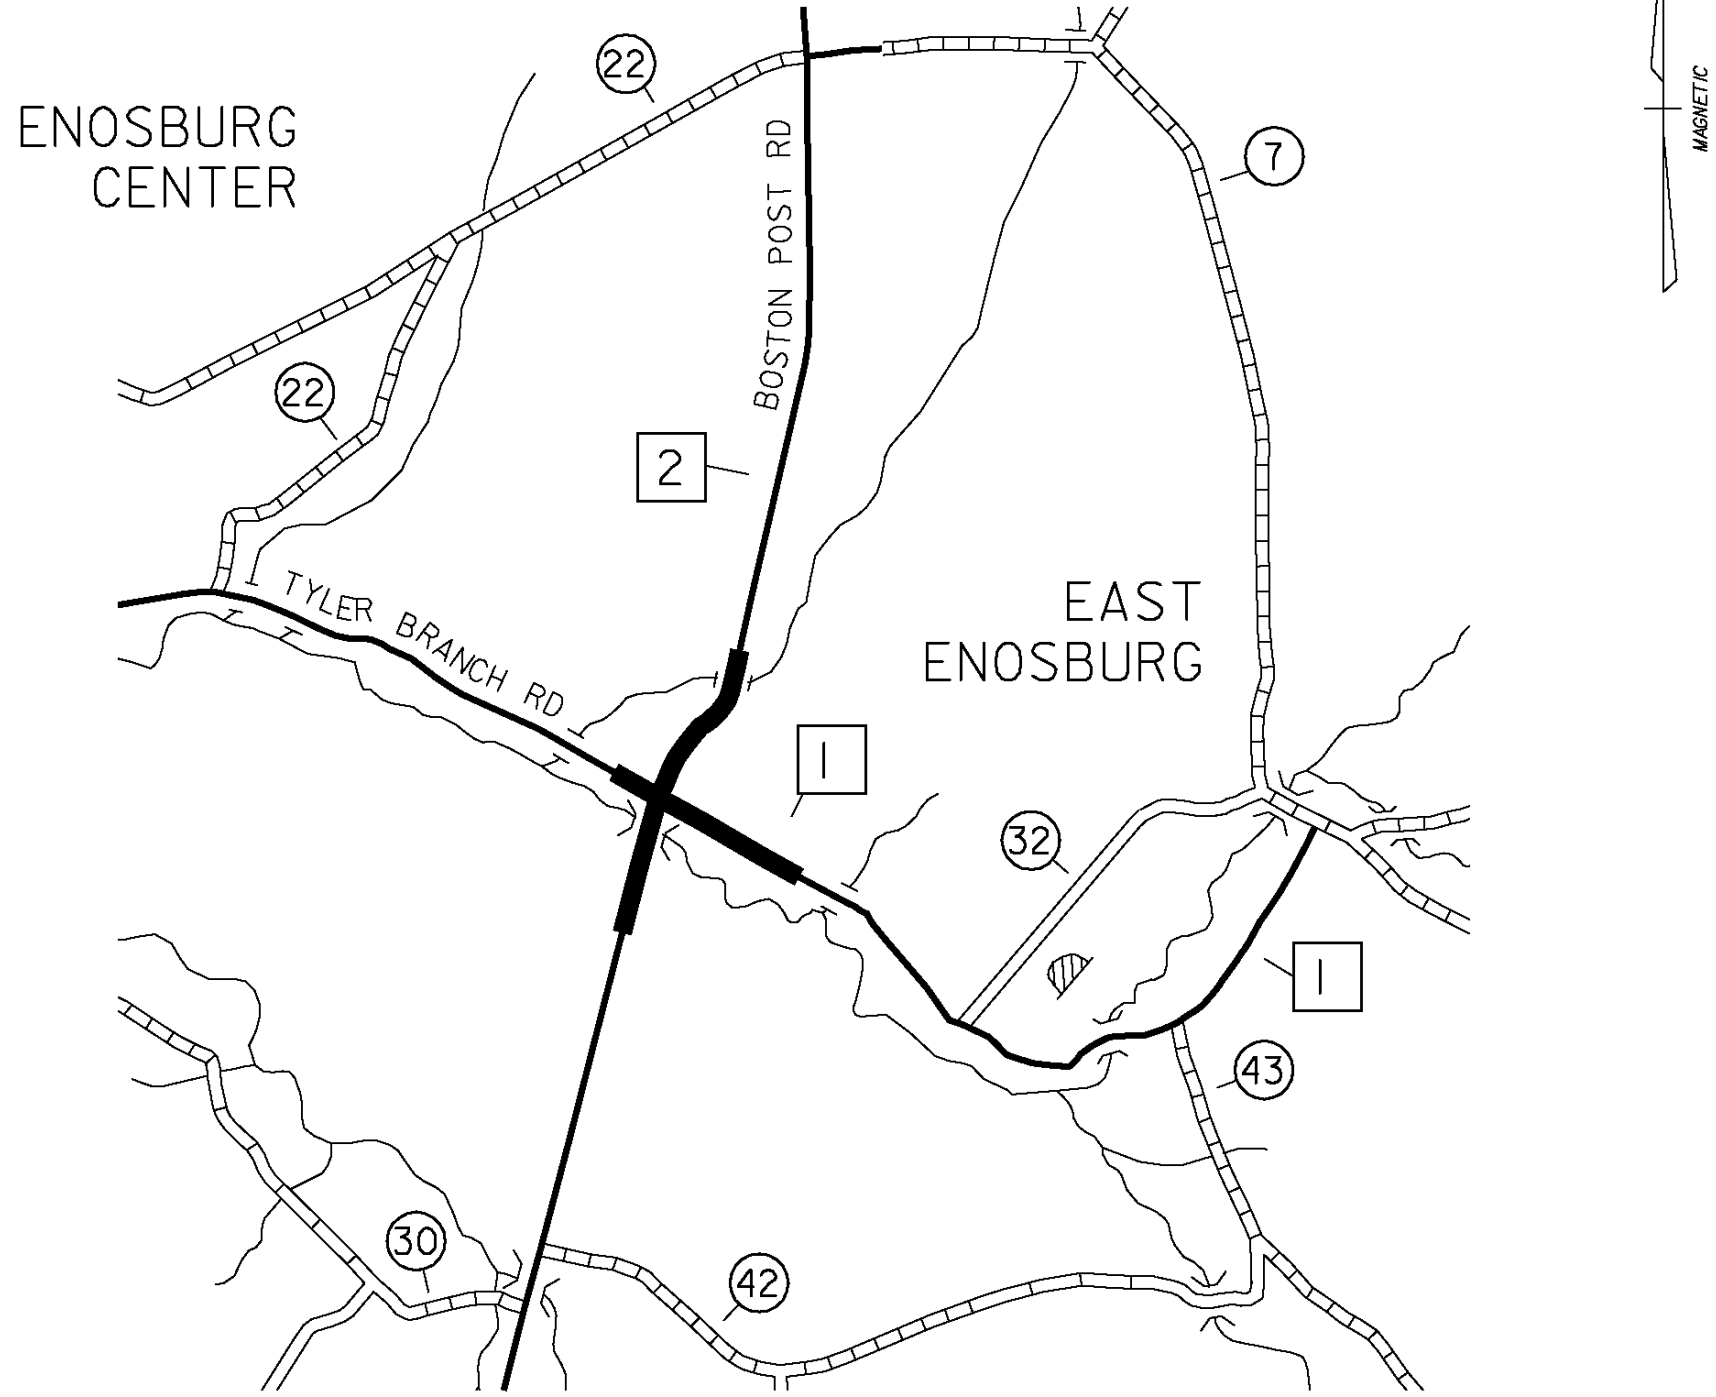


ON TYLER BRANCH ROAD (TH-1) IN THE TOWN OF ENOSBURG BEGINNING 0.099 MILES WEST OF BOSTON POST ROAD (TH-2) AND DESIGNATING THAT POINT AS MILE MARKER 0.000 EXTENDING EASTERLY ALONG TYLER BRANCH ROAD FOR A DISTANCE OF 0.216 MILES TO CONCLUDE THIS SEGMENT. ALSO ON ANOTHER ROADWAY, ON BOSTON POST ROAD (TH-2) IN THE TOWN OF ENOSBURG BEGINNING 0.084 MILES SOUTH OF PINE LN (PVT) AND DESIGNATING THAT POINT AS MILE MARKER 0.000 EXTENDING NORTHERLY ALONG BOSTON POST ROAD FOR A DISTANCE OF 0.600 MILES TO CONCLUDE THIS SEGMENT.

TOWN OF FERRISBURGH

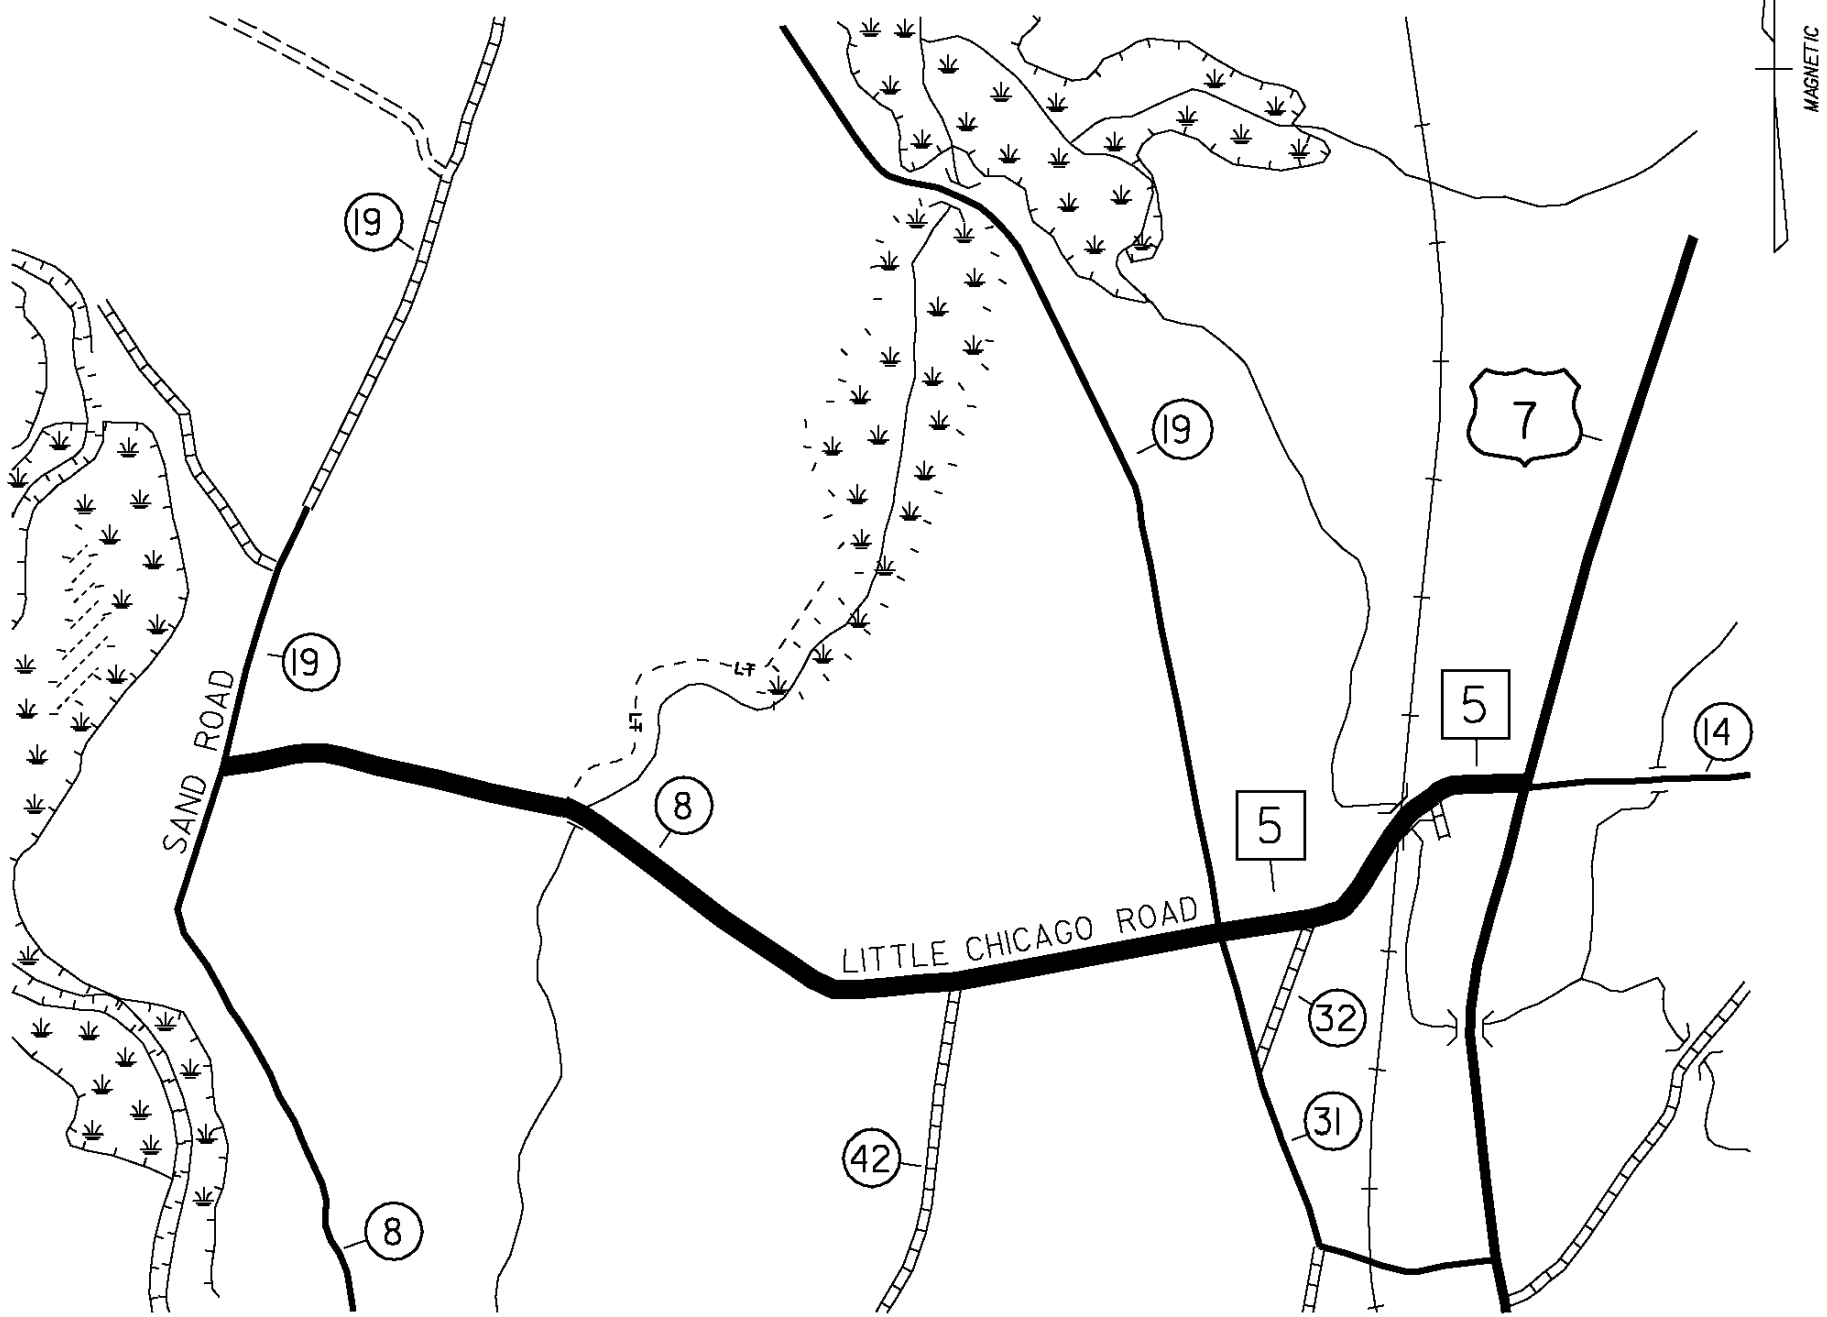

BEGINNING AT THE INTERSECTION OF US ROUTE 7 AND LITTLE CHICAGO ROAD (TH-5) IN THE TOWN OF FERRISBURGH DESIGNATING WHERE THE CENTERLINE OF EACH ROAD INTERSECTS WITH EACH OTHER AS MILE MARKER 0.000 AND EXTENDING WESTERLY ALONG LITTLE CHICAGO ROAD FOR A DISTANCE OF 3.540 MILES TO THE INTERSECTION OF SAND ROAD (TH-8) TO CONCLUDE THIS SEGMENT FOR THIS PROJECT.


TOWNS OF NEW HAVEN AND WEYBRIDGE

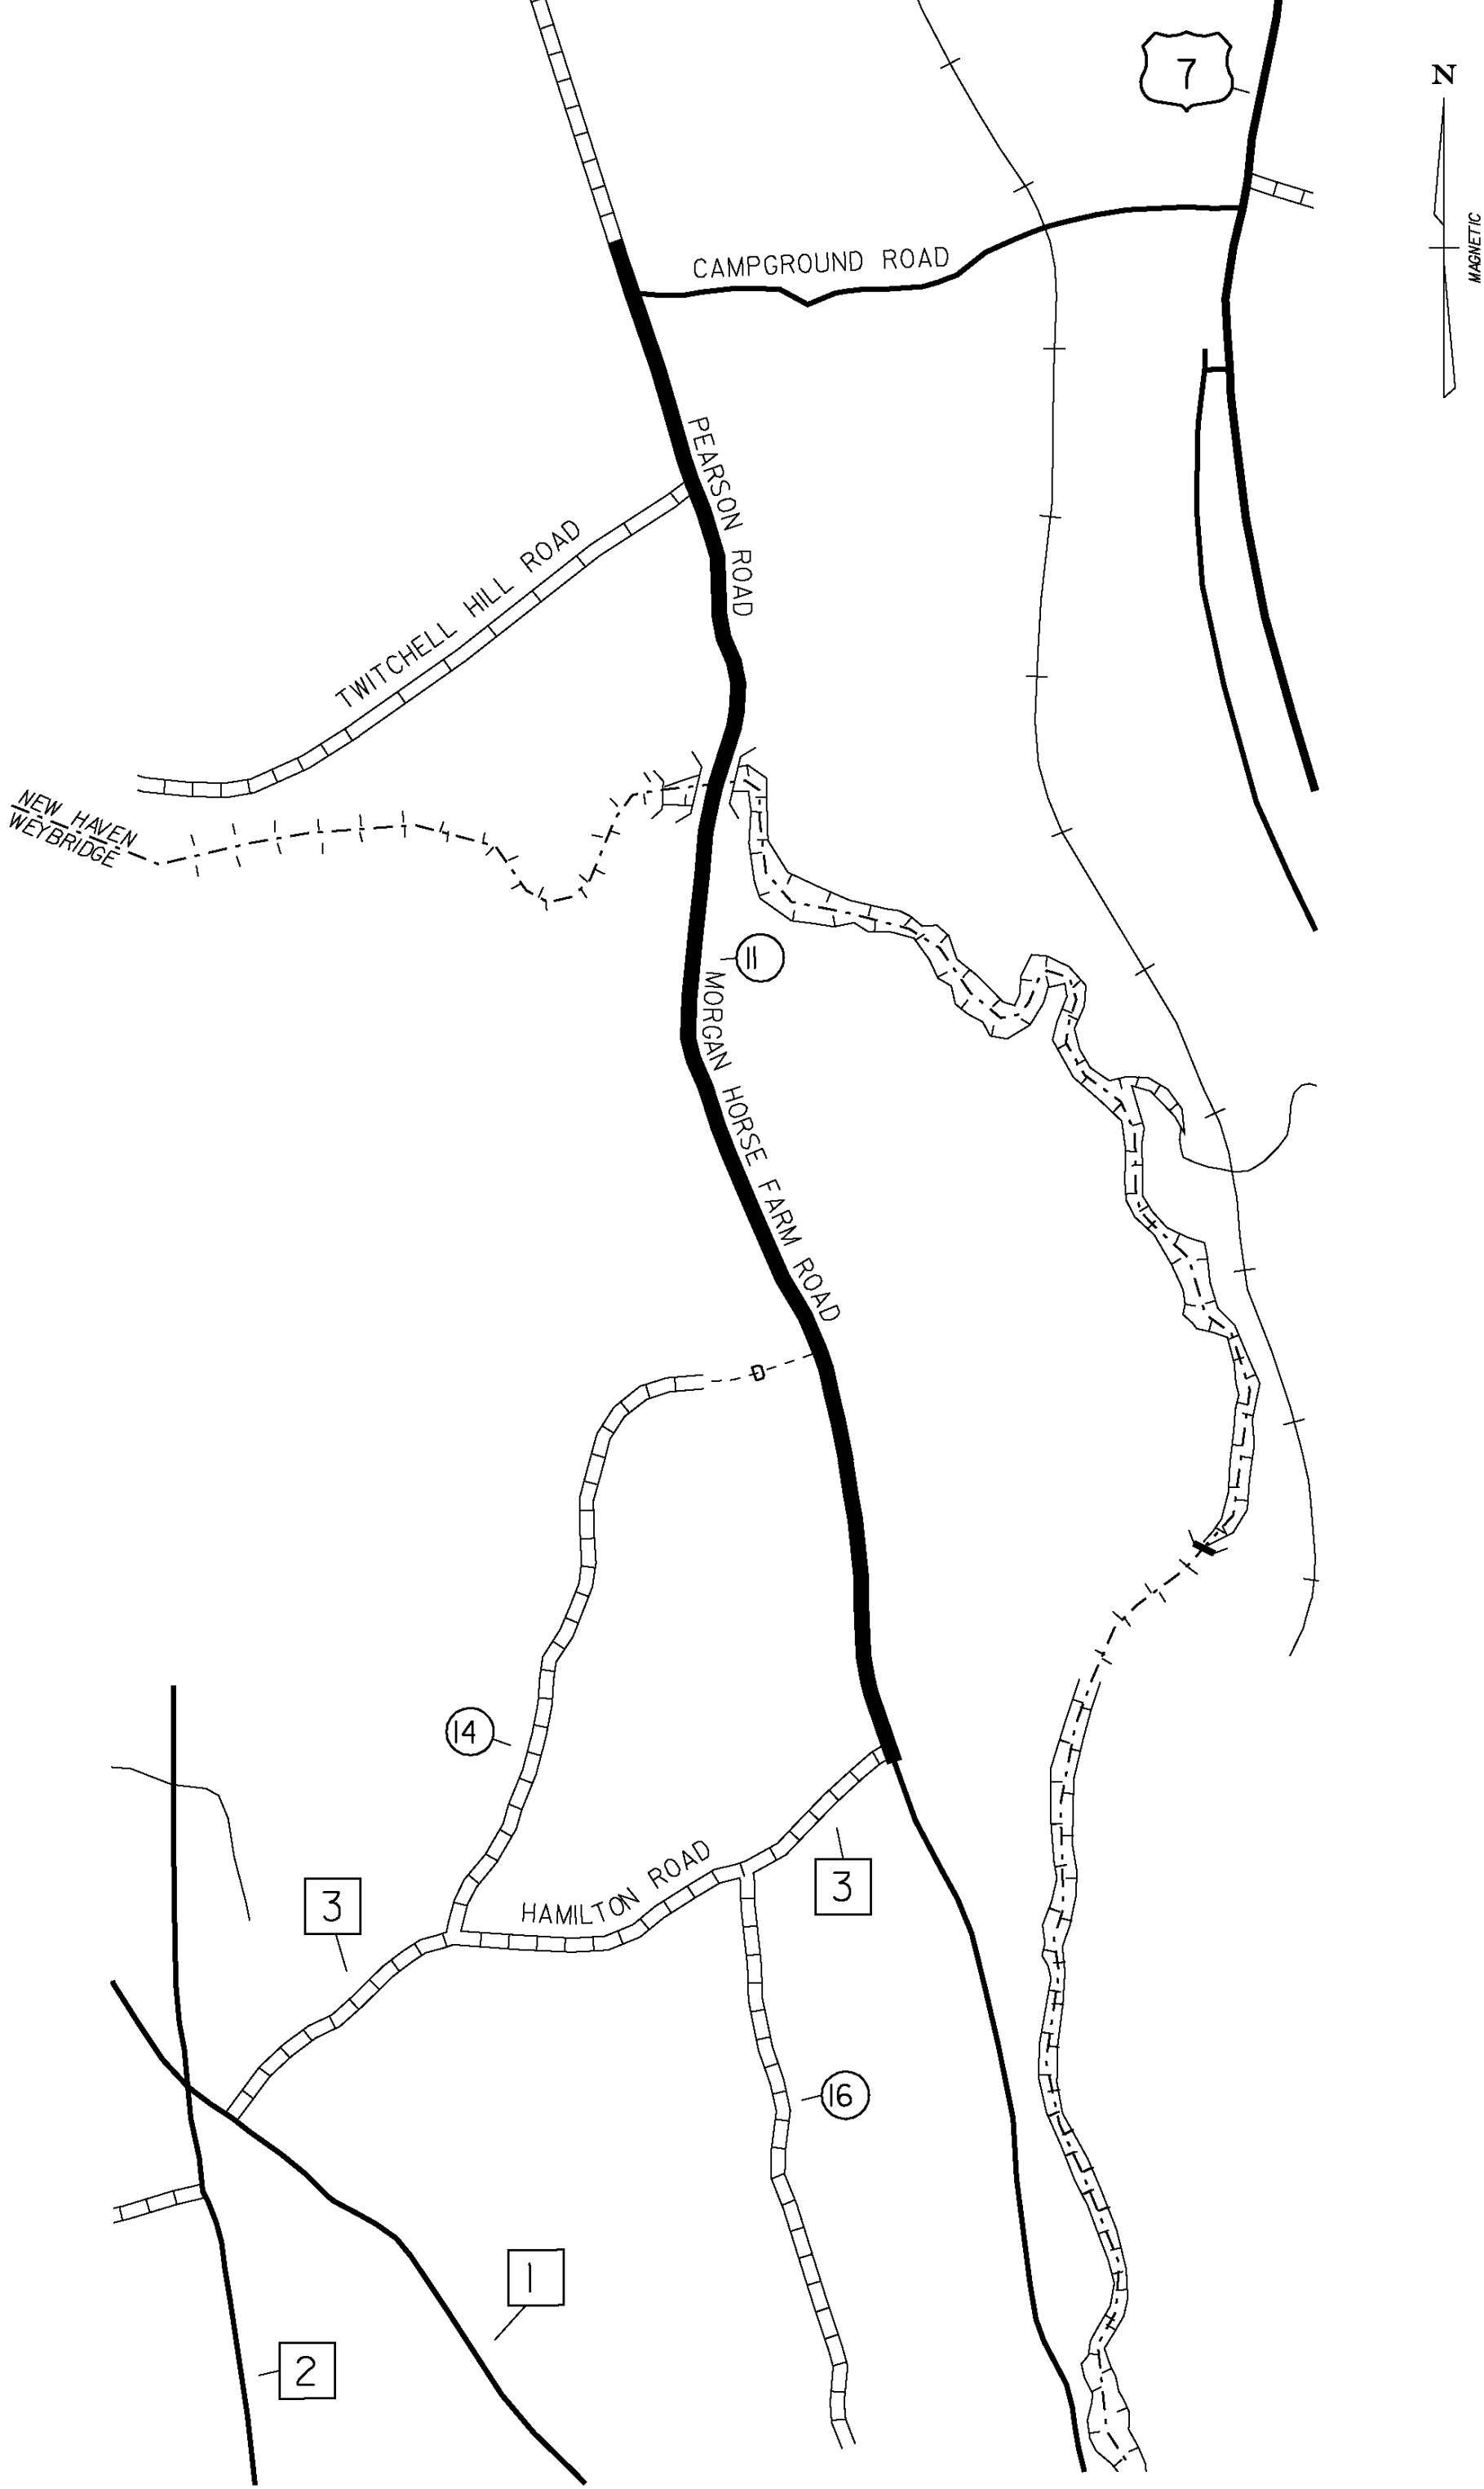

BEGINNING AT THE NEW HAVEN / WEYBRIDGE TOWNSHIP LINE ON MORGAN HORSE FARM ROAD (TH-11) IN THE TOWN OF WEYBRIDGE, DESIGNATING WHERE THE CENTER OF THE RATTLIN BRIDGE IS MARKED WITH A TOWNSHIP SIGN AS MILE MARKER 0.000 AND EXTENDING SOUTHERLY ALONG MORGAN HORSE FARM ROAD FOR A DISTANCE OF 1.628 MILES TO A POINT 0.005 MILES SOUTH OF THE INTERSECTION OF HAMILTON ROAD (TH-3). THIS SEGMENT CONCLUDES THIS PORTION OF THE PROJECT.

BEGINNING AT THE NEW HAVEN / WEYBRIDGE TOWNSHIP LINE ON PEARSON ROAD (TH-7) IN THE TOWN OF NEW HAVEN, DESIGNATING WHERE THE CENTER OF THE RATTLIN BRIDGE IS MARKED WITH A TOWNSHIP SIGN AS MILE MARKER 0.000 AND EXTENDING NORTHERLY ALONG PEARSON ROAD FOR A DISTANCE OF 0.903 MILES TO A POINT 0.066 MILES NORTH OF THE INTERSECTION OF CAMPGROUND ROAD (TH-26), WITH MINIMAL WORK TO BE PERFORMED ON CAMPGROUND ROAD AND ON TWITCHELL HILL ROAD (TH-25). THESE SEGMENTS CONCLUDE THIS PORTION OF THE PROJECT.

TOWN OF NORTHFIELD

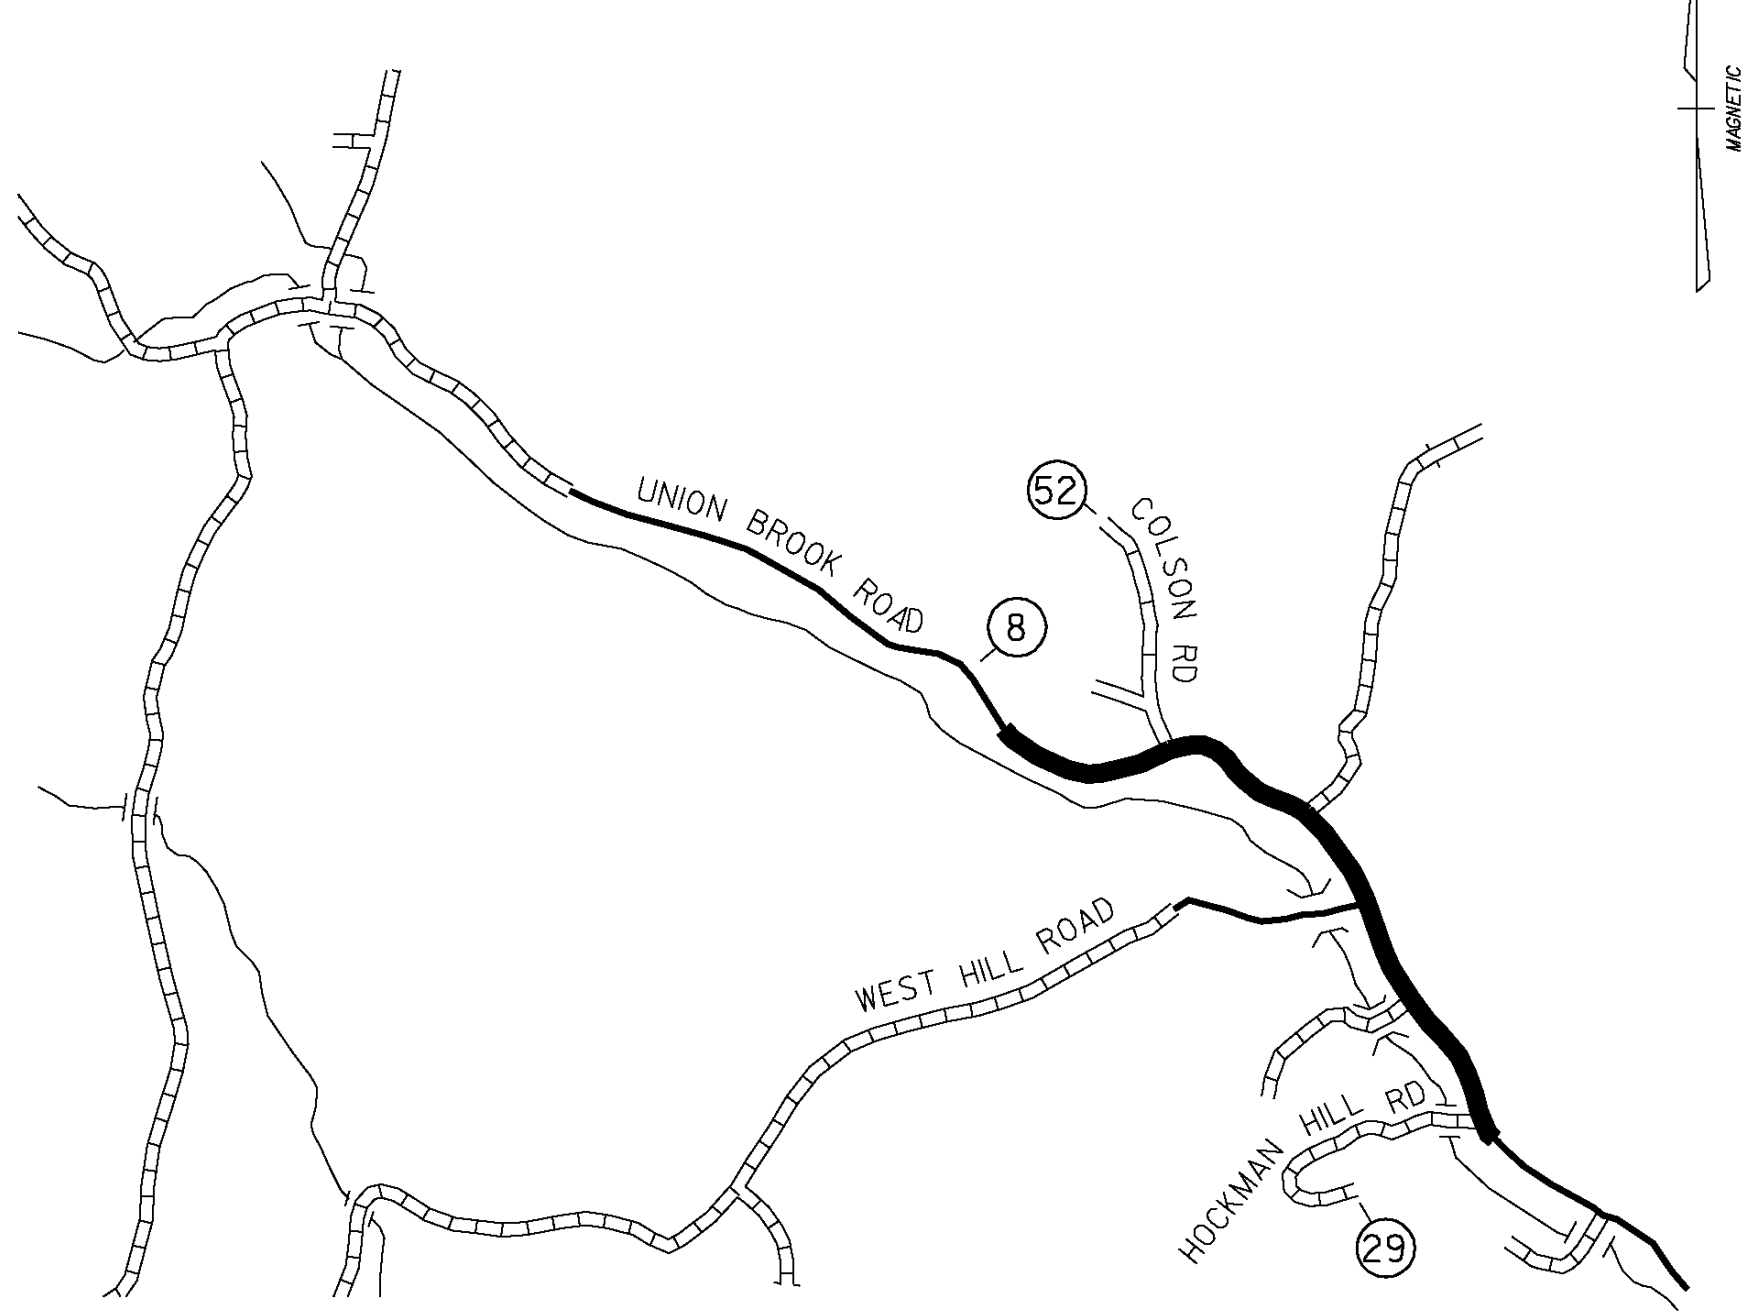


ON UNION BROOK ROAD (TH-8) IN THE TOWN OF NORTHFIELD BEGINNING 0.032 MILES SOUTHEAST OF HOCKMAN HILL ROAD (TH-29) AND DESIGNATING THAT POINT AS MILE MARKER 0.000 EXTENDING NORTHWESTERLY ALONG UNION BROOK ROAD FOR A DISTANCE OF 1.500 MILES TO A POINT 0.500 MILES NORTHWEST OF COLSON ROAD (TH-52) TO CONCLUDE THIS SEGMENT.

NOT TO SCALE

PROJECT NAME:	STATEWIDE NORTHWEST REGION
PROJECT NUMBER:	STP HRRR(5)
FILE NAME:	10K018_wrk.dgn
PROJECT LEADER:	JLS
DESIGNED BY:	NLA
LOCATION MAPS:	1
PLOT DATE:	23-JUN-2010
DRAWN BY:	I. SHEA
CHECKED BY:	JLS
SHEET	3 OF 51


TOWN OF RICHMOND

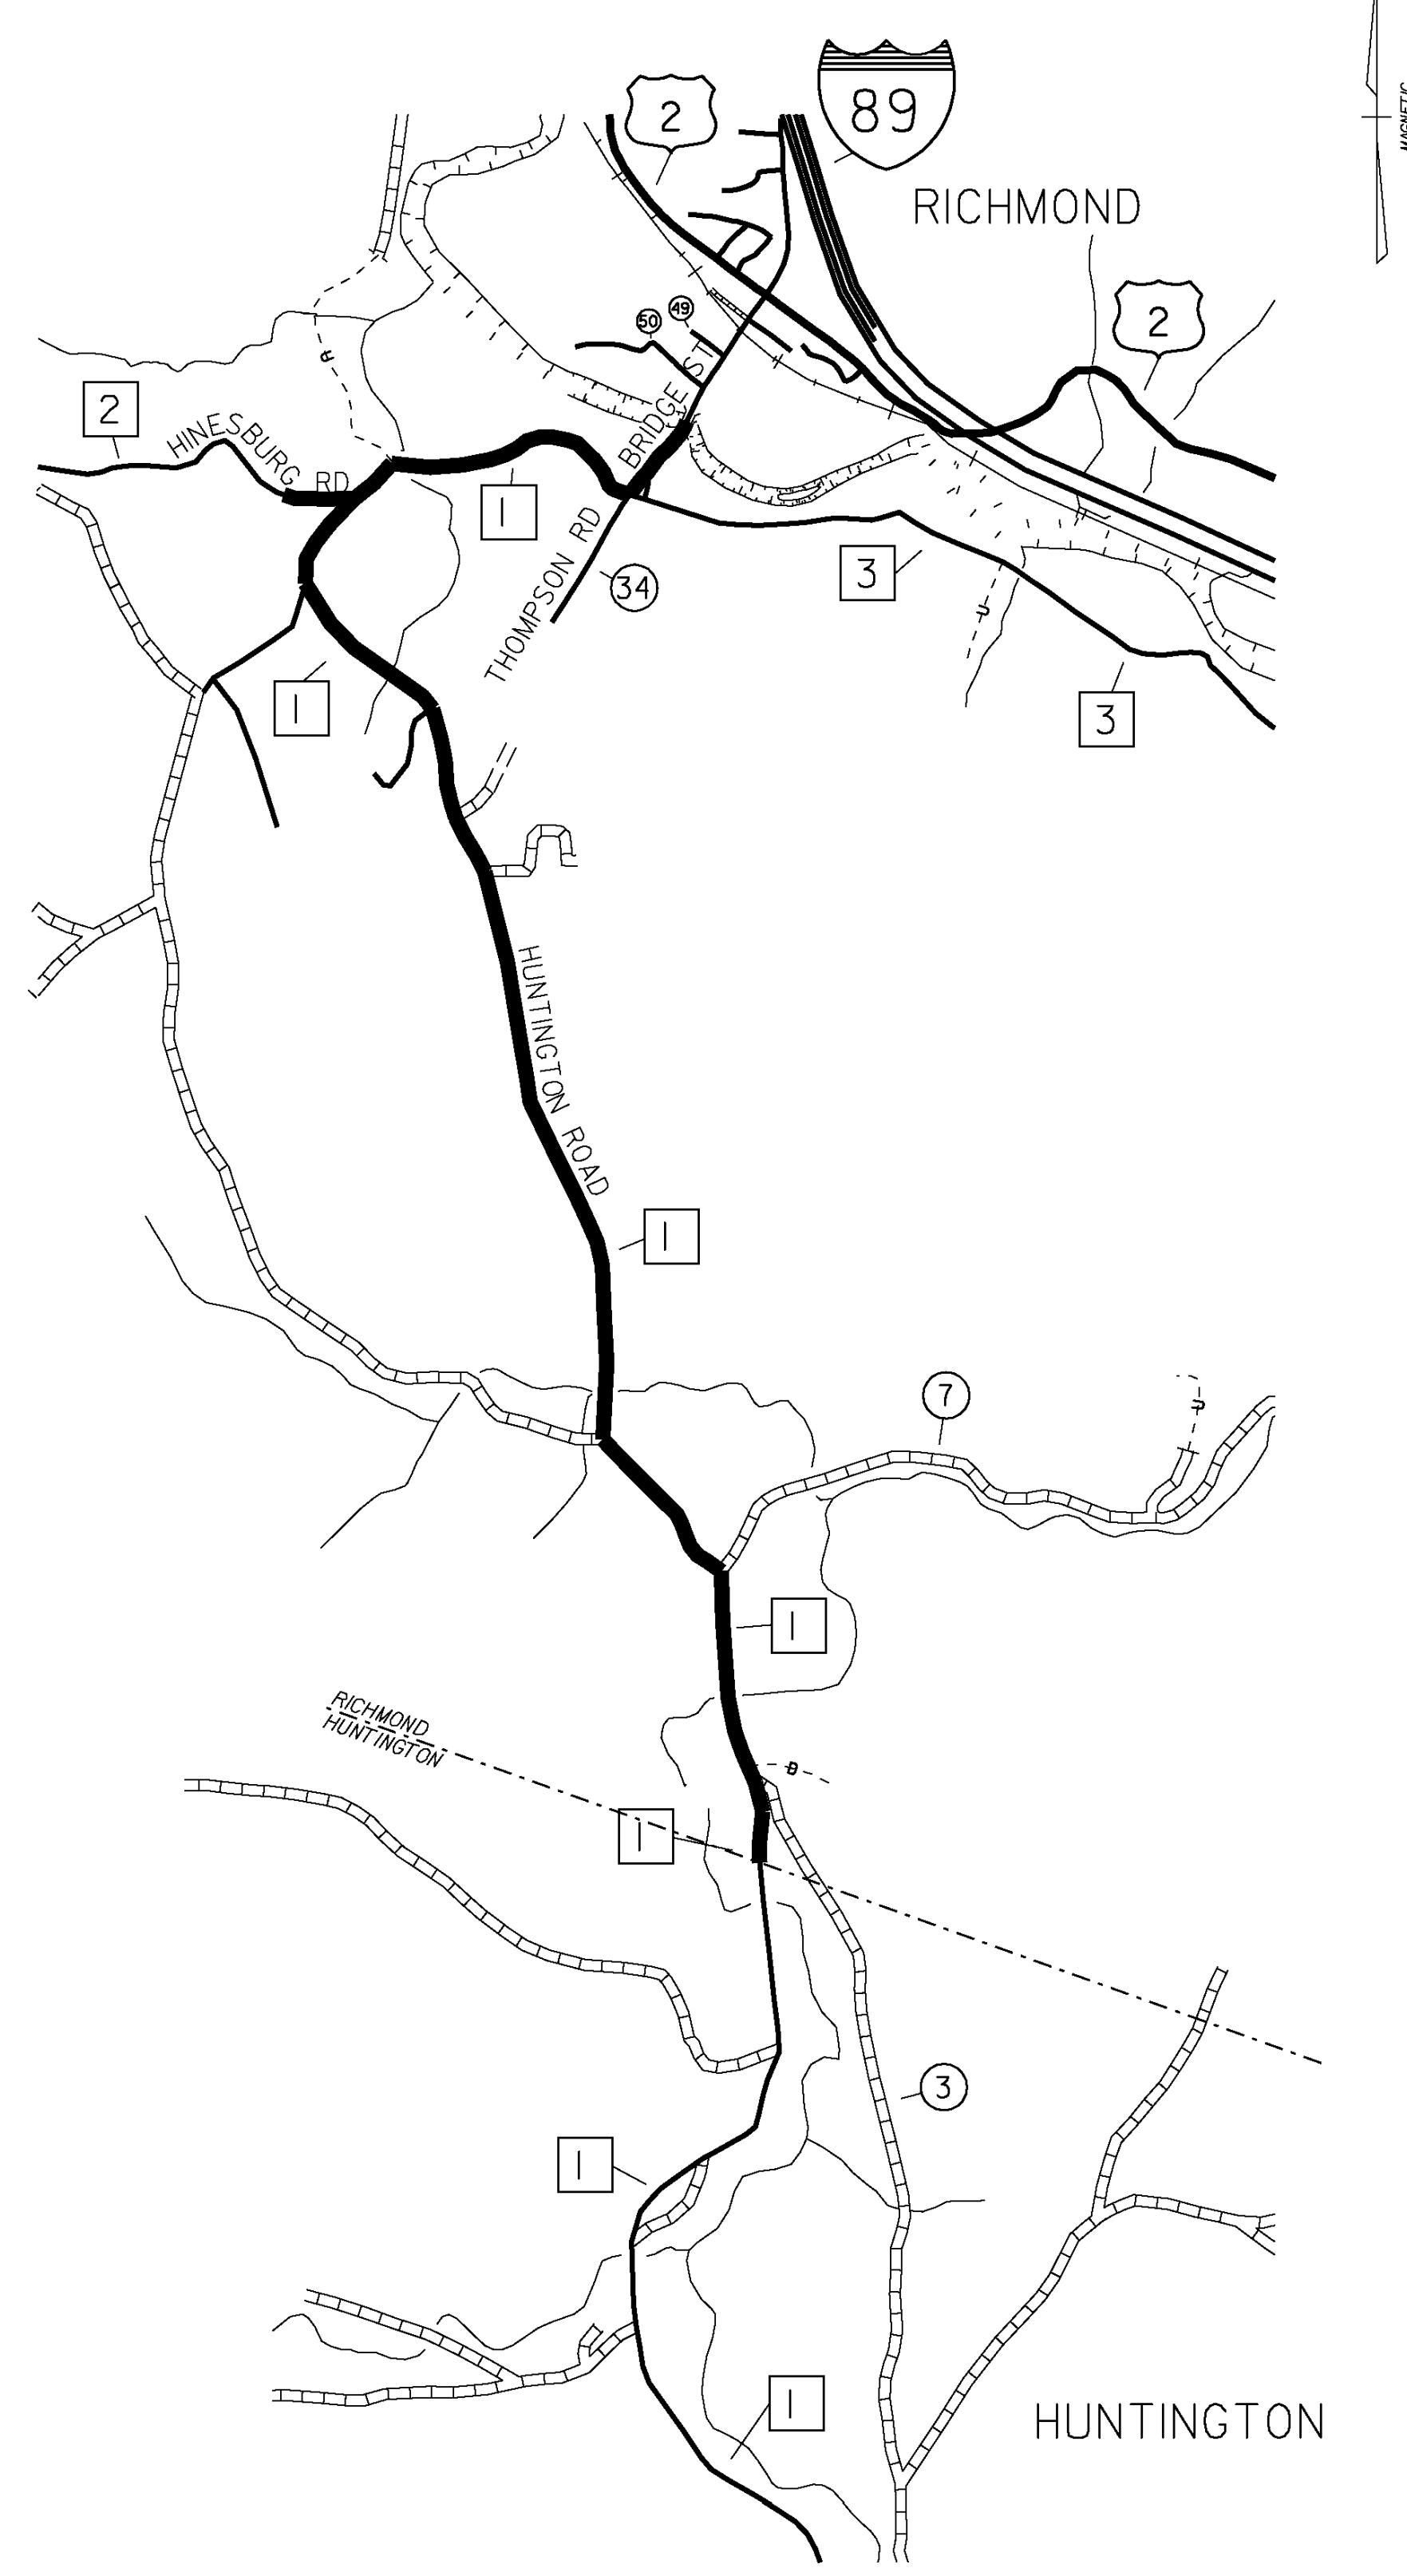

BEGINNING AT THE BRIDGE, 0.222 MILES NORTH OF THOMPSON ROAD (TH-34) IN THE TOWN OF RICHMOND AND PROCEEDING SOUTHERLY ON BRIDGE STREET CONTINUING ALONG HUNTINGTON ROAD (TH-1) TO THE RICHMOND - HUNTINGTON TOWN LINE FOR A TOTAL DISTANCE OF 4.300 TO CONCLUDE THIS SEGMENT.

ALSO ON ANOTHER ROADWAY, BEGINNING AT THE INTERSECTION OF HUNTINGTON ROAD (TH-1) AND HINESBURG ROAD IN THE TOWN OF RICHMOND DESIGNATING WHERE THE CENTERLINE OF EACH ROAD INTERSECTS WITH EACH OTHER AS MILE MARKER 0.000 EXTENDING WESTERLY ALONG HINESBURG ROAD FOR A DISTANCE OF 0.149 MILES TO CONCLUDE THIS SEGMENT.

TOWN OF ST. ALBANS

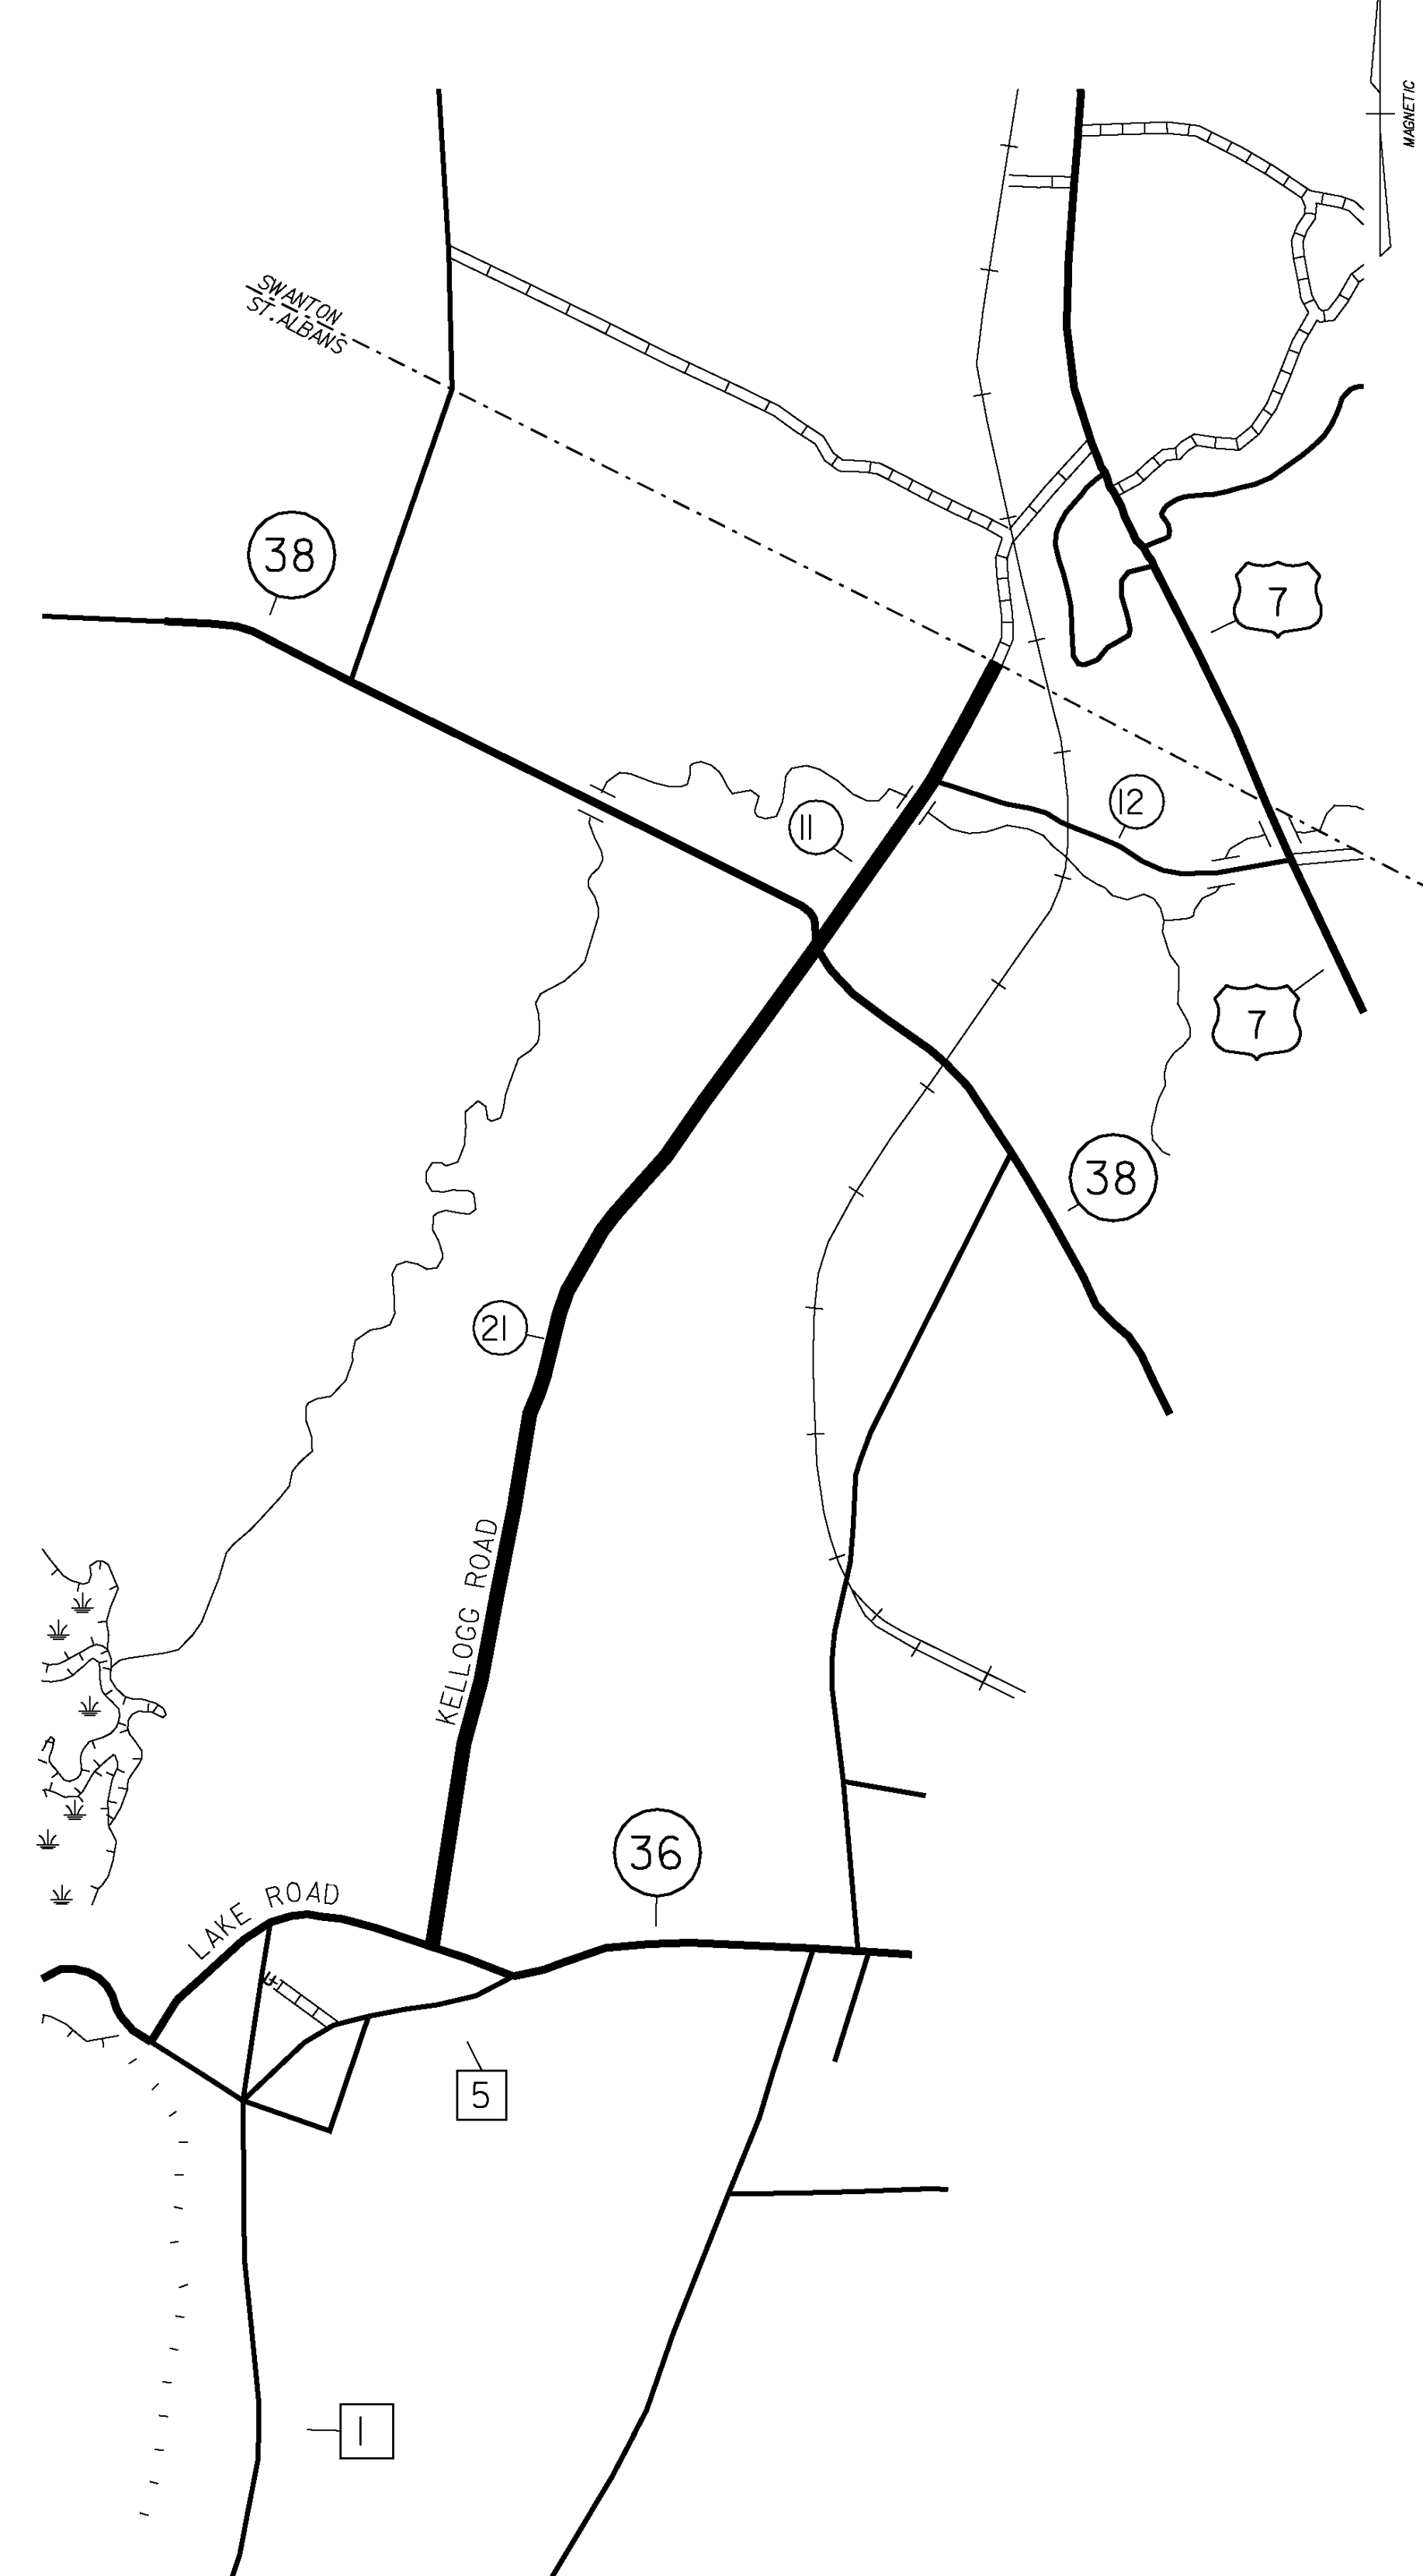

BEGINNING AT THE INTERSECTION OF KELLOGG ROAD (TH-14) AND LAKE ROAD (VT 36/TH 38) IN THE TOWN OF ST. ALBANS DESIGNATING THE INTERSECTION WHERE THE CENTERLINE OF EACH ROAD INTERSECTS AS MILE MARKER 0.000 AND EXTENDING NORTHERLY ALONG KELLOGG ROAD FOR A DISTANCE OF 3.200 MILES TO THE ST. ALBANS - SWANTON TOWN LINE TO CONCLUDE THIS SEGMENT.

NOT TO SCALE

PROJECT NAME:	STATEWIDE NORTHWEST REGION		
PROJECT NUMBER:	STP HRRR(5)		
FILE NAME:	10k018_wrk.dgn	PLOT DATE:	23-JUN-2010
PROJECT LEADER:	JLS	DRAWN BY:	I. SHEA
DESIGNED BY:	NLA	CHECKED BY:	JLS
LOCATION MAPS	2	SHEET	4 OF 51


STATE OF VERMONT
AGENCY OF TRANSPORTATION

QUANTITY SHEET


[illegible]

PROJECT NAME: STATEWIDE NORTHWEST REGION
PROJECT NUMBER: STP HRRR(5)


FILE NAME: ppps*/Section/-----.dgn	PLOT DATE: 23-JUN-2010
PROJECT LEADER: JLS	DRAWN BY: NLA
DESIGNED BY: NLA	CHECKED BY: JLS
QUANTITY SHEET	SHEET 5 OF 51

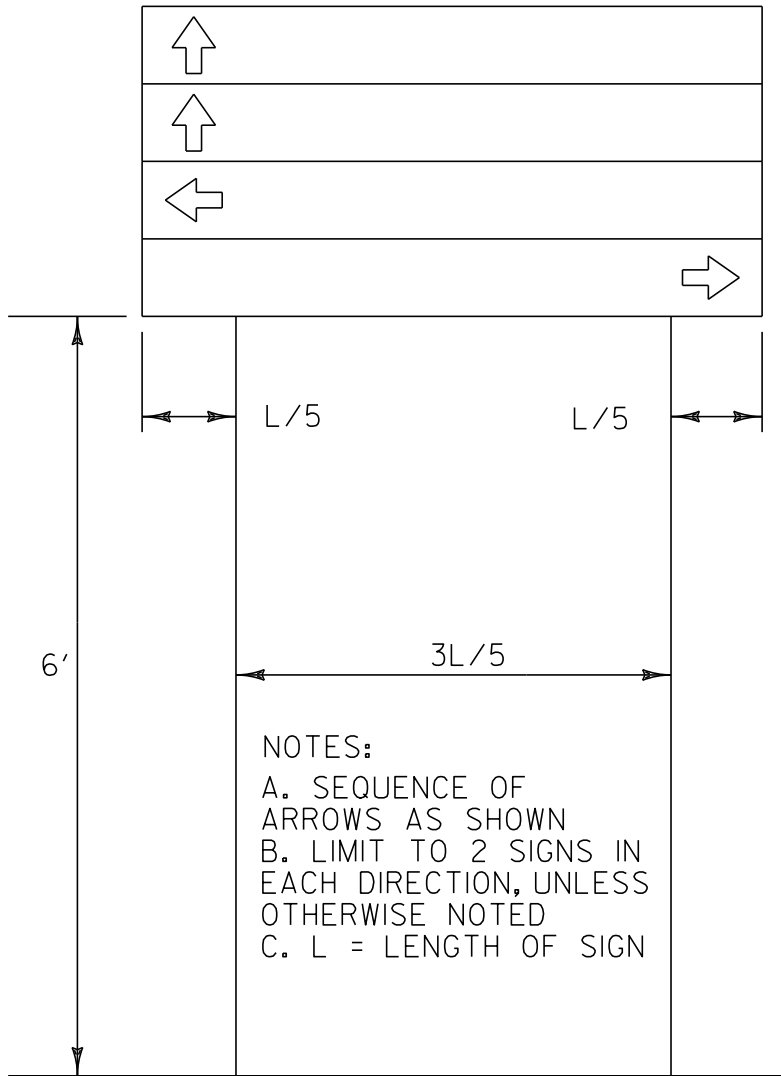

DESTINATION ASSEMBLY

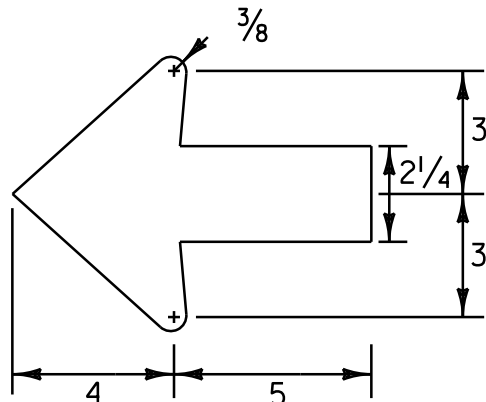


STANDARD ARROW

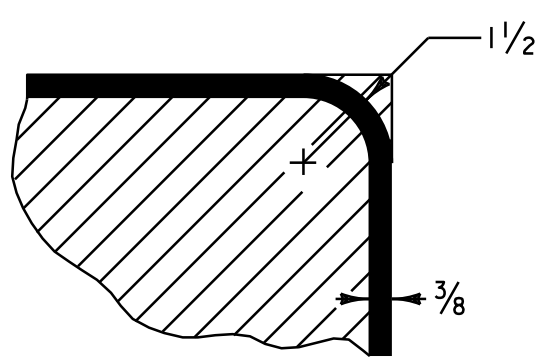

BORDER DETAIL


STANDARD DESTINATION SIGN NOTES
D1-1, D1-1A, D1-2, D2-1

- ALL SIGNS SHALL BE IN ACCORDANCE WITH THE MUTCD AND THE "STANDARD HIGHWAY SIGNS" BOOK (SHS) PUBLISHED BY THE FEDERAL HIGHWAY ADMINISTRATION (FHWA).
- THE SIGN BASE MATERIAL SHALL BE HIGH DENSITY OVERLLAID PLYWOOD 5/8 INCH THICK OR ALUMINUM SHEETING 0.125 IN MINIMUM THICKNESS. THE DESTINATION SIGNS SHOWN ON THIS SHEET SHALL HAVE WHITE RETROREFLECTIVE ASTM TYPE III (MINIMUM) TEXT, ARROWS, AND BORDERS ON A GREEN RETROREFLECTIVE ASTM TYPE III (MINIMUM) BACKGROUND. THE COLORS SHALL CONFORM WITH THE COLORS ADOPTED BY AASHTO AND APPROVED BY THE FHWA.
- MULTIPLE SIGN ASSEMBLIES SHALL USE THE SAME SIZE THROUGHOUT. DO NOT MIX AND MATCH OLDER SIGN SIZES WITH NEW SIGN HEIGHTS AND WIDTHS.

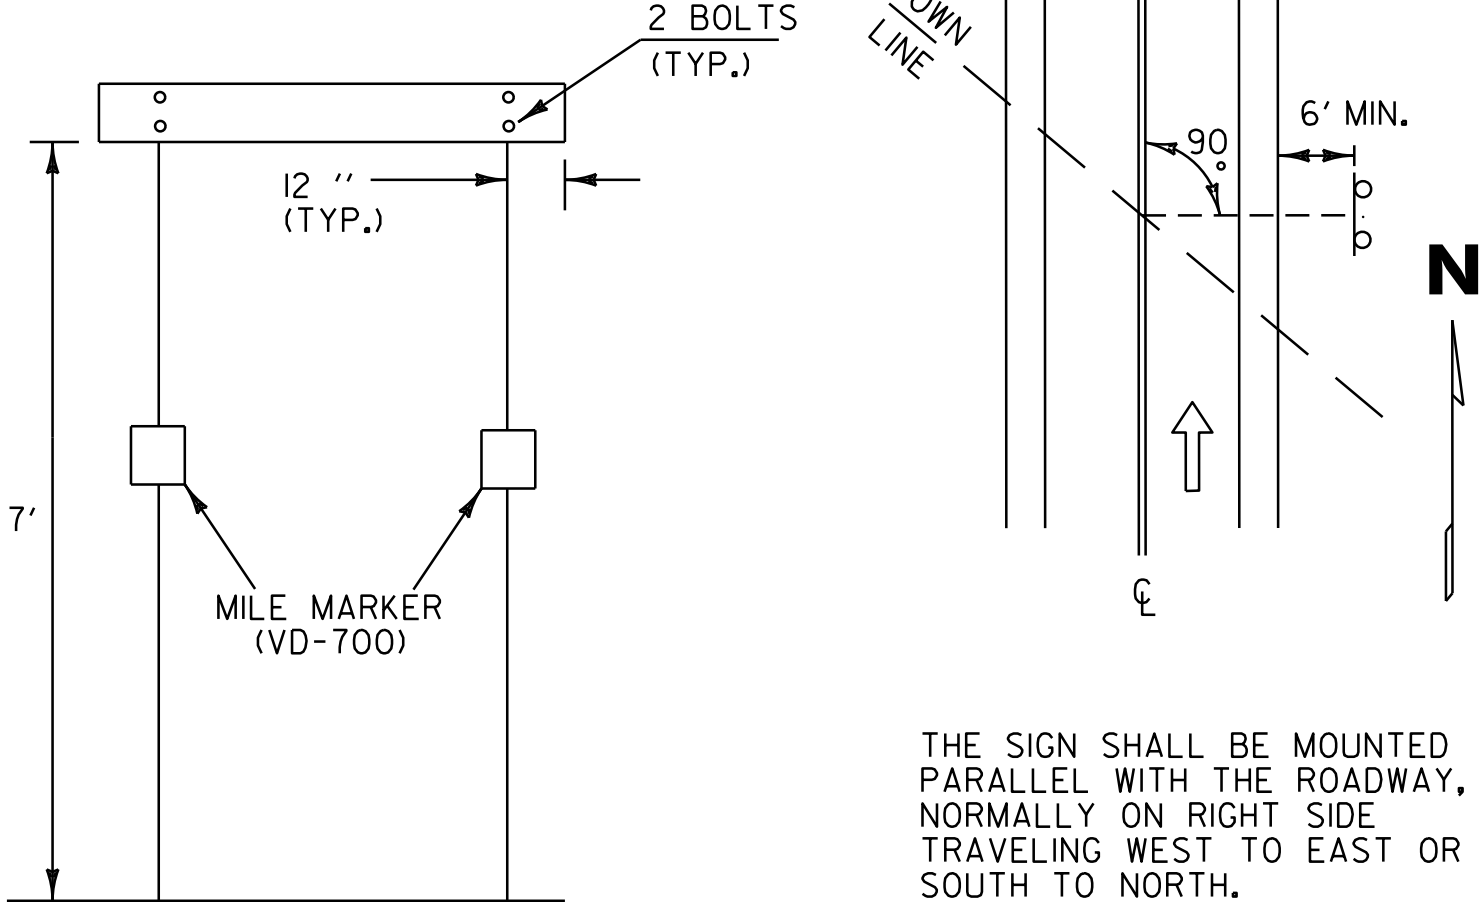

THE SIGN SHALL BE MOUNTED PARALLEL WITH THE ROADWAY, NORMALLY ON RIGHT SIDE TRAVELING WEST TO EAST OR SOUTH TO NORTH.


WHEN CROSSING COUNTY BOUNDARIES AN ADDITIONAL COUNTY LINE SIGN SHALL BE MOUNTED BELOW THE TOWN LINE SIGN MAINTAINING A SEVEN FOOT CLEARANCE.

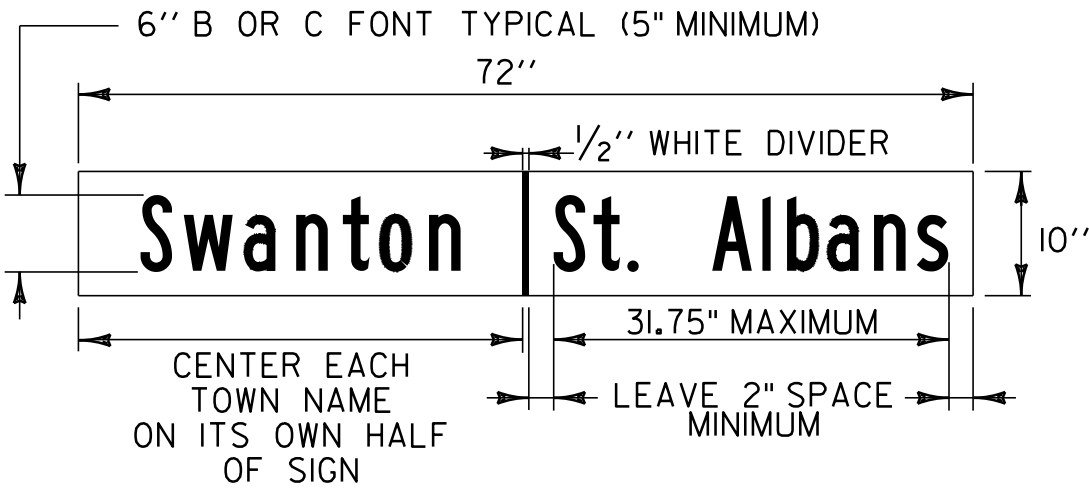

VD-024 TOWN LINE SIGN
VD-025 COUNTY LINE SIGN (SIMILAR)

TOWN/COUNTY LINE SIGN NOTES:

- THE SIGN BASE MATERIAL SHALL BE HIGH DENSITY OVERLLAID PLYWOOD 5/8 INCH THICK OR ALUMINUM SHEETING 0.125 IN MINIMUM THICKNESS. THE DESTINATION SIGNS SHOWN ON THIS SHEET SHALL HAVE WHITE RETROREFLECTIVE ASTM TYPE III (MINIMUM) TEXT, ARROWS, AND BORDERS ON A GREEN RETROREFLECTIVE ASTM TYPE III (MINIMUM) BACKGROUND. THE COLORS SHALL CONFORM WITH THE COLORS ADOPTED BY AASHTO AND APPROVED BY THE FHWA.
- THE LETTERING FOR NAMES OF TOWNS AND COUNTIES SHALL BE A COMBINATION OF LOWERCASE LETTERS WITH INTIAL UPPER-CASE LETTERS. WHEN A MIXED-CASE LEGEND IS USED, THE HIEGHT OF THE LOWER-CASE LETTERS SHALL BE 3/4 OF THE HEIGHT OF THE INTIAL UPPER-CASE LETTER.

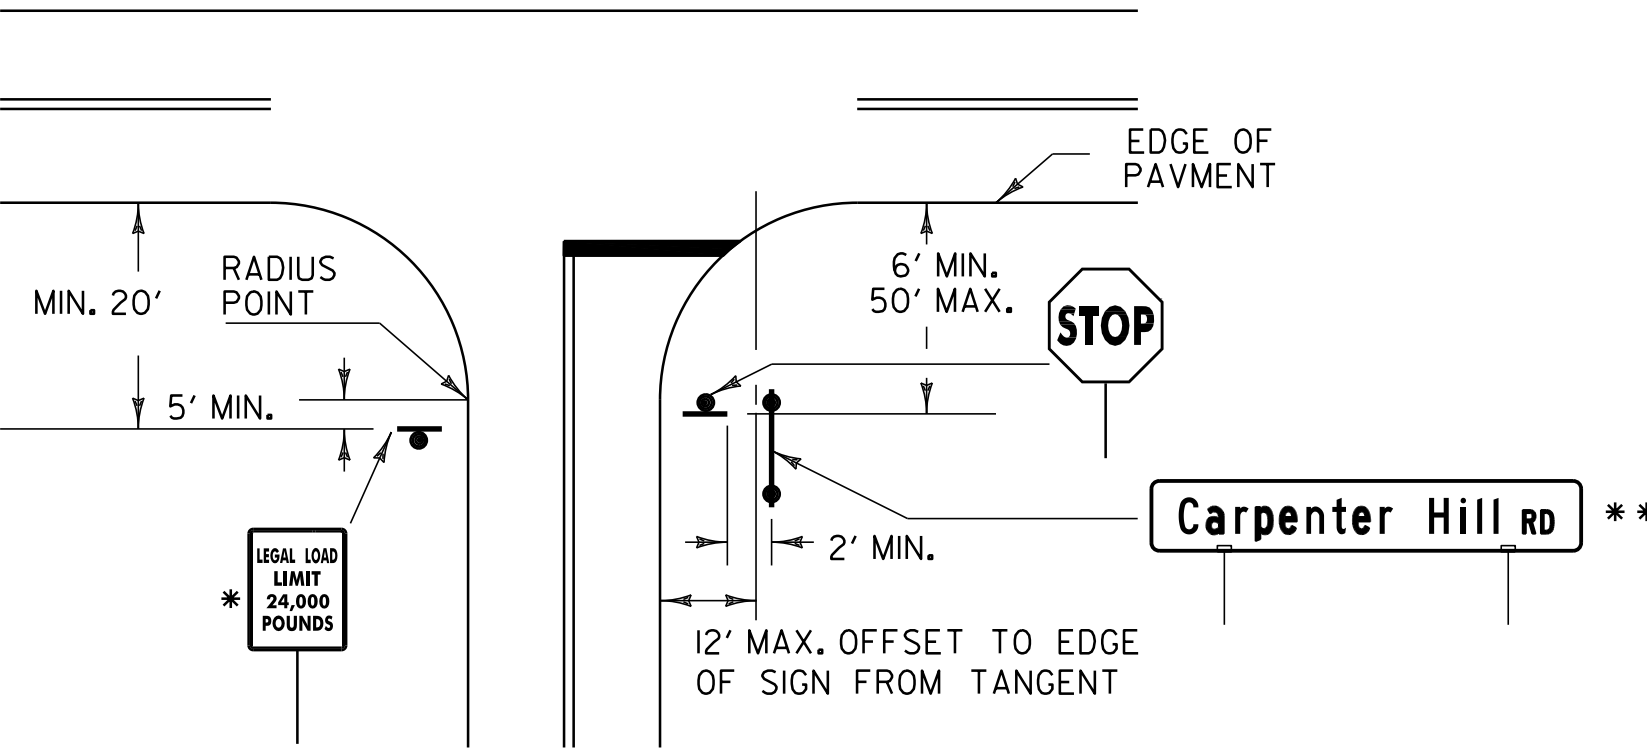

* MAY VARY ACCORDING TO ROADWAY CONDITIONS. SIDE ROAD SPEED LIMIT SIGN MAY BE INSTALLED BENEATH THIS SIGN AS REQUIRED.

STOP SIGN SHALL BE PLACED ON DRIVER'S RIGHT. MAINTAIN MAXIMUM VISIBILITY. THE STOP SIGN DOES NOT HAVE TO BE ADJACENT TO THE STOP BAR.

** STREET NAME SIGNS MAY BE INSTALLED AT 90 DEGREES ON TOP OF TOP THE STOP SIGN. STREET NAME SIGNS 48 INCHES OR LESS IN LENGTH. IF THE STREET NAME SIGN IS GREATER THAN 48 INCHES IN LENGTH THEN THE SIGN SHALL BE INSTALLED ON TWO SIGN POSTS TO THE RIGHT OF THE STOP SIGN AT A 2 FOOT MINIMUM LATERAL OFFSET MAINTAINING MAXIMUM VISIBILITY AT THE INTERSECTION FOR THE STOPPED VEHICLE.

LEGAL LOAD LIMIT AND STOP
SIGNS AT INTERSECTIONS WITH
TOWN HIGHWAYS

STREET NAME SIGNS NOTES

- THE SIGN BASE MATERIALS USED FOR THE STREET SIGNS MAY BE EITHER OF THE FOLLOWING:

A - EXTRUDED ALUMINUM BLADES
B - FLAT ALUMINUM BLADES


THE MATERIAL FOR THE BLADES SHALL BE EITHER EXTRUDED ALUMINUM WITH A 0.25 INCH FLANGE THICKNESS AND A 0.090 INCH WEBB (MIN) OR FLAT SHEET ALUMINUM WITH A MINIMUM THICKNESS OF 0.125 INCH. THE PREFERRED MOUNTING METHOD FOR STREET SIGNS IS POST TOP MOUNTING BRACKETS. HARDWARE FOR MOUNTING SIGNS TO POST SHALL BE INCIDENTAL TO OTHER ITEMS. MOUNTING METHOD WILL BE AS SHOWN ON THE PLANS. FOR POST TOP MOUNTINGS SIGNS SHALL HAVE TEXT ON BOTH SIDES.

- ALL STREET NAME SIGNSD BASE MATERIAL ON THIS SHEET SHALL HAVE WHITE RETROREFLECTIVE ASTM TYPE III (MINIMUM) TEXT, ON A GREEN RETROREFLECTIVE ASTM TYPE III (MINIMUM) BACKGROUND. THE COLORS SHALL CONFORM WITH THE COLORS ADOPTED BY AASHTO AND APPROVED BY THE FHWA.

ALL DIMENSIONS SHOWN IN INCHES UNLESS OTHERWISE NOTED.

PROJECT NAME:	STATEWIDE NORTHWEST REGION
PROJECT NUMBER:	STP HRRR(5)
FILE NAME:	10k018_wrk.dgn
PROJECT LEADER:	JLS
DESIGNED BY:	NS
GENERAL SIGN DETAILS I	
PLOT DATE:	17-SEP-2012 11:31
DRAWN BY:	NS
CHECKED BY:	JLS
SHEET	6 OF 51

ROUTE MARKER ASSEMBLY FRAMES

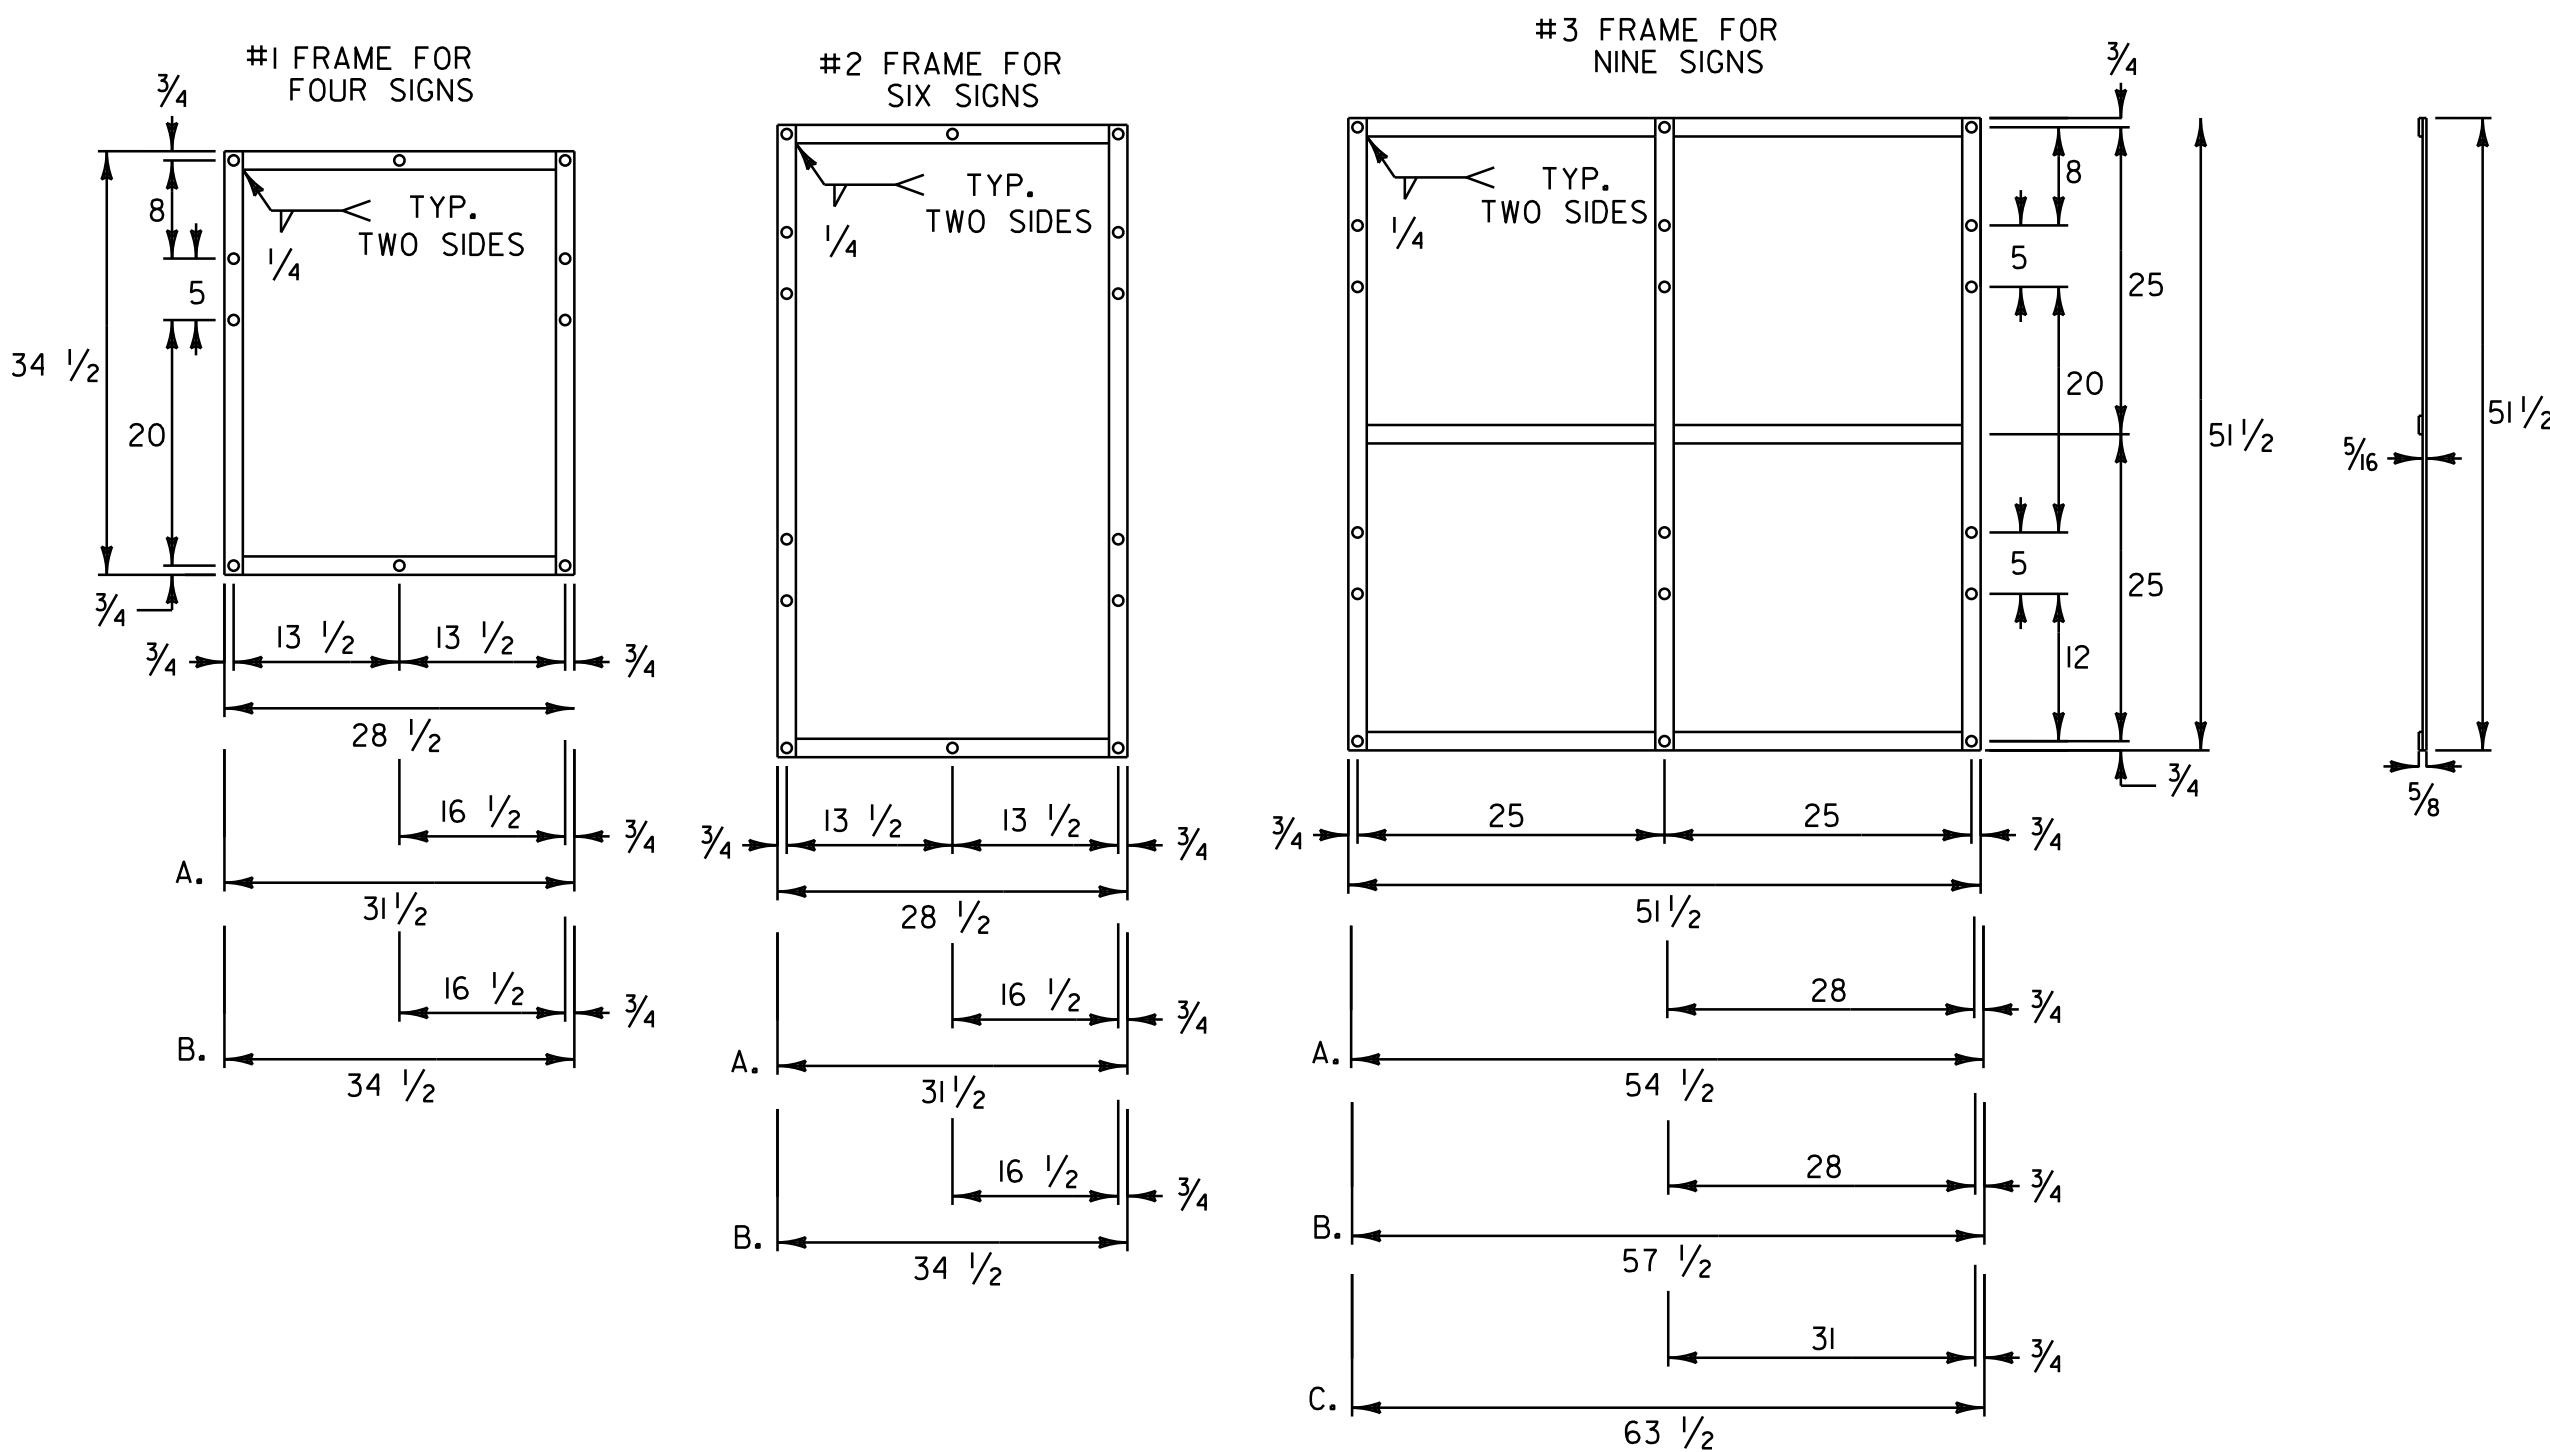

NOTES:

1. NOTES FOR 1 AND 2 FRAME:


- A. WITH ONE 30 INCH THREE DIGIT SIGN
- B. WITH TWO 30 INCH THREE DIGIT SIGNS

2. NOTES FOR 3 FRAME:

- A. WITH ONE 30 INCH THREE DIGIT SIGN IN AN OUTSIDE POSITION.
- B. WITH ONE 30 INCH THREE DIGIT SIGN IN THE CENTER POSITION OR TWO SUCH SIGNS IN THE OUTSIDE POSITIONS.
- C. WITH THREE 30 INCH THREE DIGIT SIGNS.

3. ALL HOLES SHALL BE 7/16 INCH DIAMETER. FOR OTHER SIGN COMBINATIONS THAN ABOVE, THE FRAME DIMENSIONS AND HOLE SPACING SHALL BE MODIFIED AS NECESSARY. THE FRAME SHALL BE PAINTED WITH ONE COAT OF PRIMER AND A SECOND COAT OF BLACK PAINT. THE PAINT SHALL BE OF THE TYPE USED ON EXTERIOR METAL SURFACES TO PREVENT METAL CORROSION.


4. STANDARD FRAMES SHALL BE 5/16 INCH x 1 1/2 INCH WELDED A-36 STEEL.

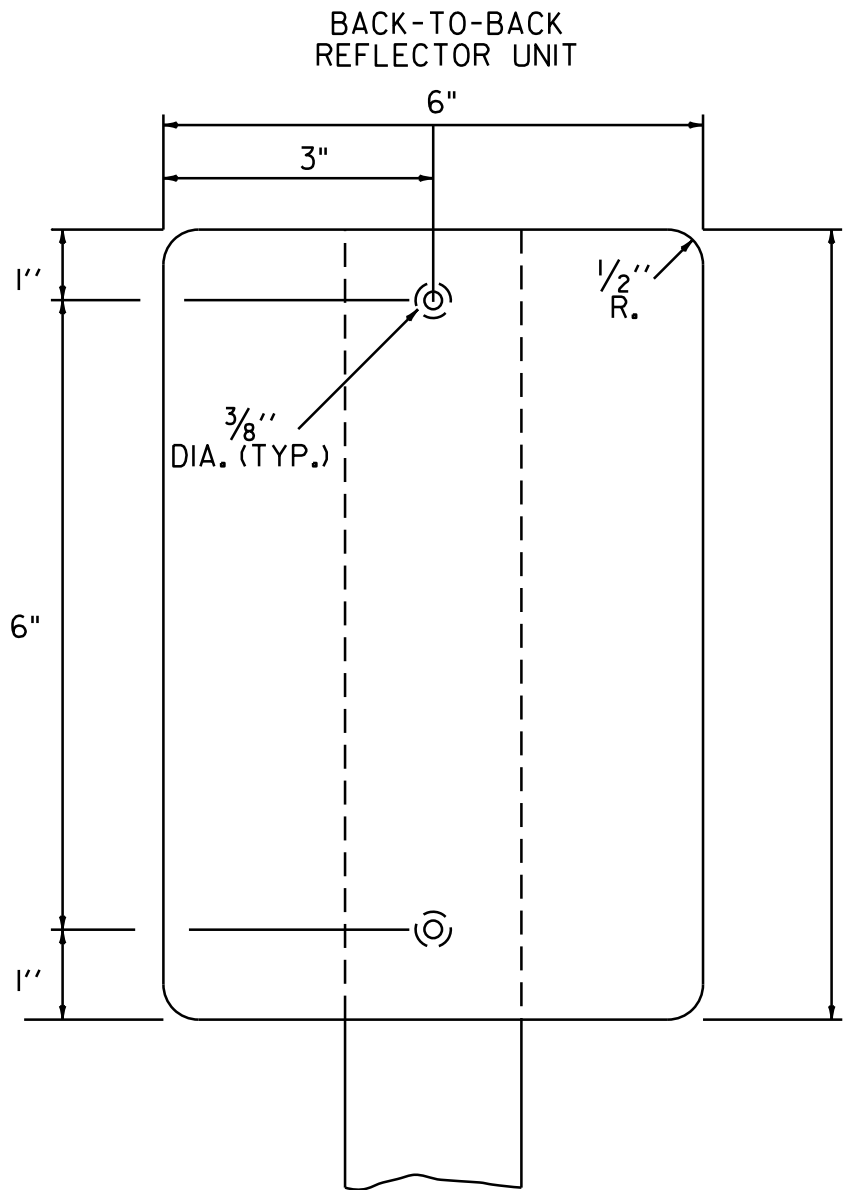


TYPE II (6"X8")

DELINEATORS WITH RETROREFLECTIVE SHEETING

- MATERIAL FOR RETROREFLECTIVE SHEETING FOR DELINEATORS SHALL BE A 0.063" ALUMINUM BACKING WITH A WHITE ASTM TYPE III OR TYPE IV.
- ALL TYPE II (6"X8") DELINEATOR POSTS SHALL BE 1.88 LB/FT SQUARE STEEL WITH A 12 GUAGE ANCHOR, WITH A ANCHOR REVEAL OF 2 INCHES.

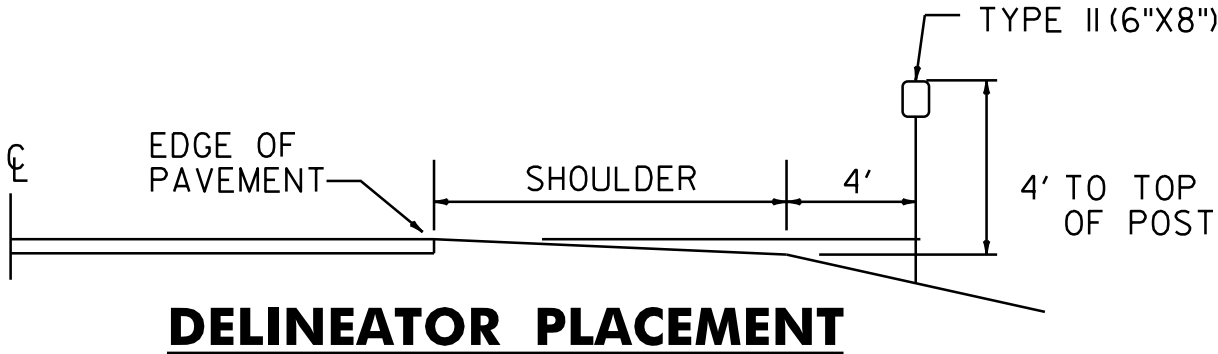

DELINEATOR PLACEMENT

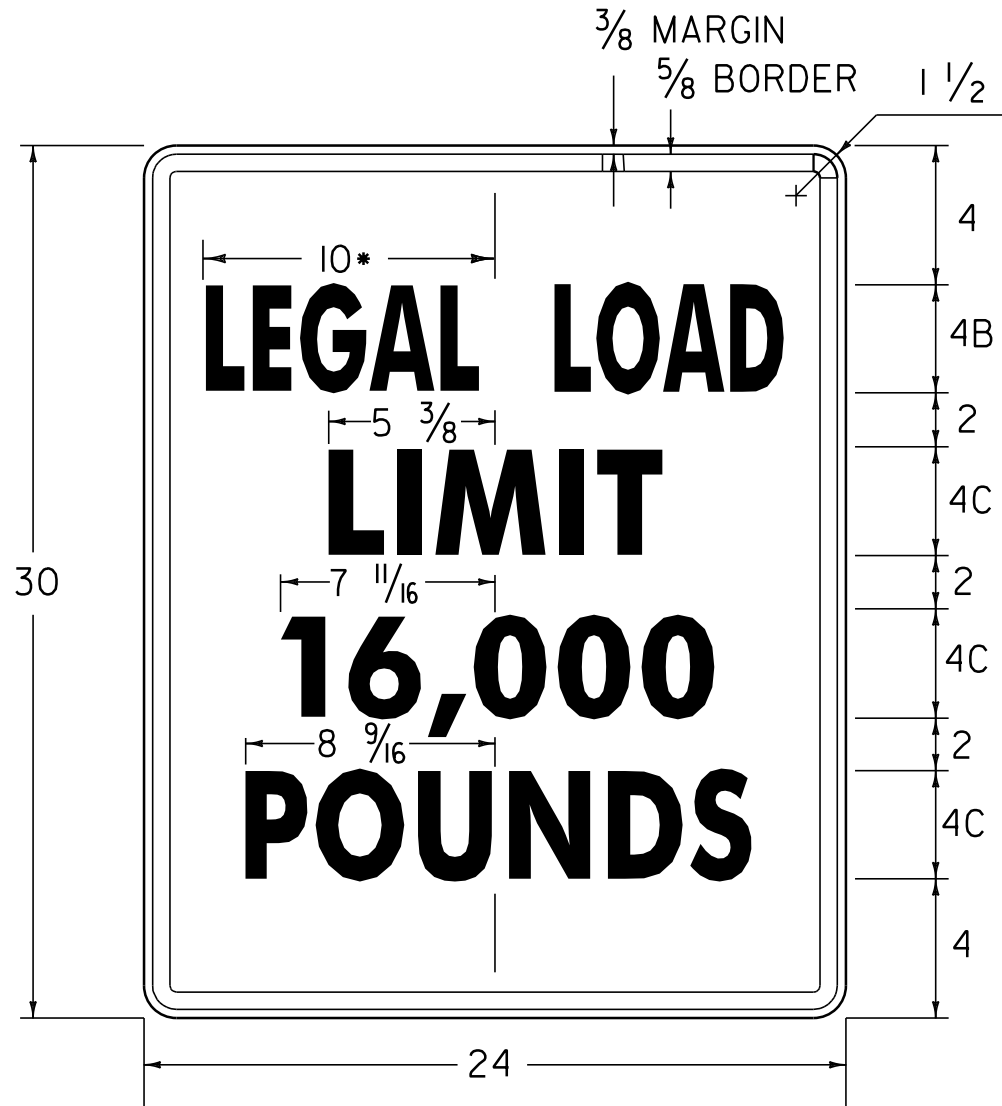


* REDUCE SPACING 50 %

LINE 3 ALTERNATE - 16,000

VR-017

1.500" RADIUS, 0.625" BORDER, 0.375" INDENT
COLORS: LEGEND - BLACK
BACKGROUND - WHITE
TEXT STYLE: "LEGAL LOAD" B; "LIMIT" C;
"16,000" C; "POUNDS" C

STANDARD MOUNTING OF ROUTE MARKER ASSEMBLIES

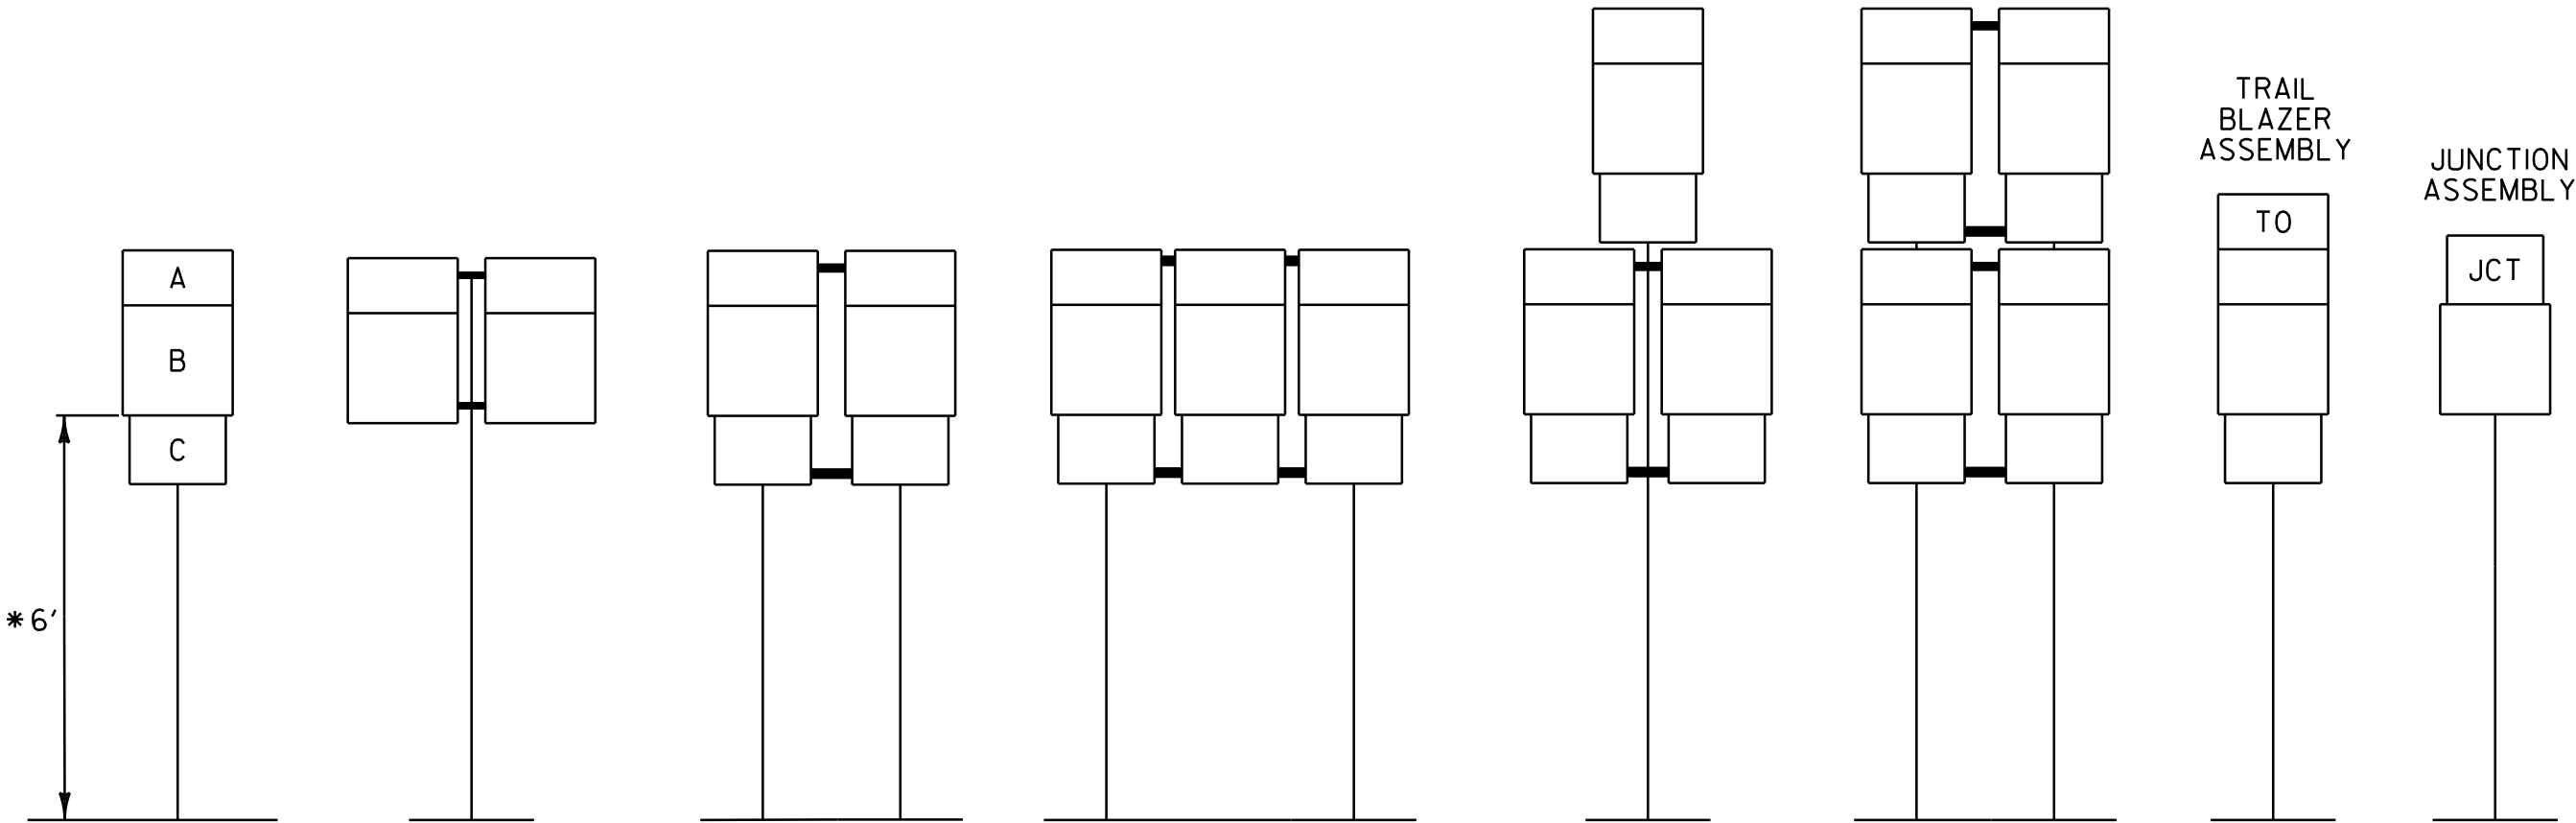


INSTALLATION SEQUENCE:

IN MULTIPLE HORIZONTAL MOUNTINGS PLACE A ROUTE MARKER ASSEMBLY INDICATING A LEFT TURN ON THE LEFT SIDE OF THE ASSEMBLY; RIGHT TURN ON THE RIGHT SIDE. FOR VERTICALLY STACKED MOUNTINGS PLACE THE STRAIGHT THROUGH MOVE INDICATION ON TOP, THE LEFT OR RIGHT TURNS AS APPROPRIATE BENEATH.

NOTES:

- ALL DIMENSIONS SHOWN IN INCHES UNLESS OTHERWISE NOTED.
- VERTICAL FRAME MEMBERS SHALL LINE UP WITH SIGN POST ON WHICH THEY ARE MOUNTED.

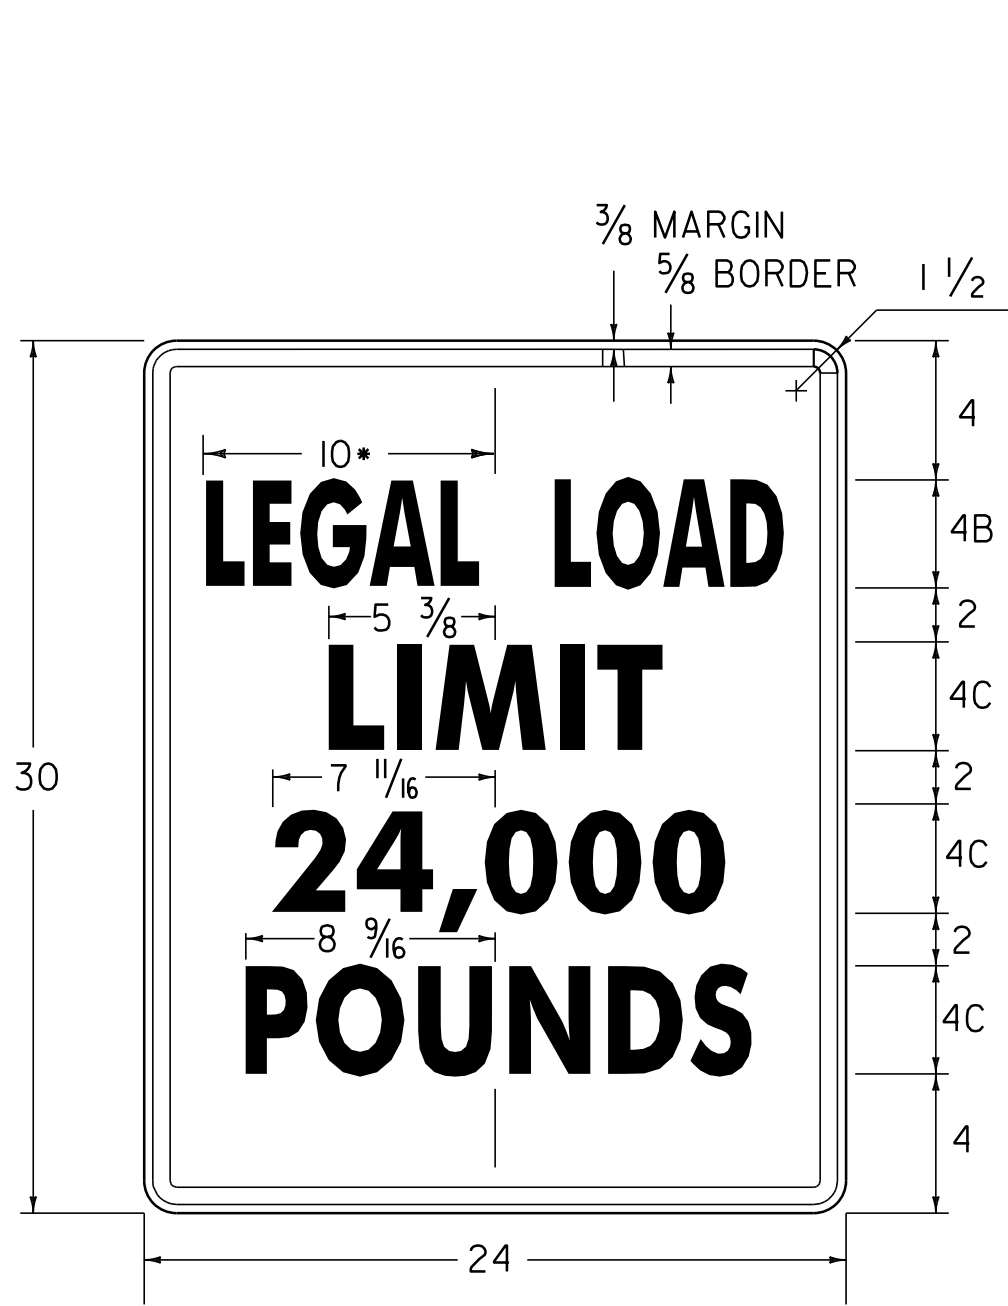

* REDUCE SPACING 50 %

LINE 3 ALTERNATE - 16,000

VR-017

1.500" RADIUS, 0.625" BORDER, 0.375" INDENT
COLORS: LEGEND - BLACK
BACKGROUND - WHITE
TEXT STYLE: "LEGAL LOAD" B; "LIMIT" C;
"24,000" C; "POUNDS" C



VR-345


* OPTICALLY CENTER (HERE, TO, CORNER)

1.500" RADIUS, 0.625" BORDER, 0.375" INDENT
COLORS: LEGEND - RED
BACKGROUND - WHITE
TEXT STYLE: "NO" D; "PARKING" B; "HERE TO" B;
"CORNER" B

ALL DIMENSIONS SHOWN IN INCHES UNLESS OTHERWISE NOTED.


PROJECT NAME: STATEWIDE NORTHWEST REGION
PROJECT NUMBER: STP HRRR(5)

FILE NAME: I0K018.wr.k.dgn
PROJECT LEADER: JLS
DESIGNED BY: NLA
GENERAL SIGN DETAILS 2
PLOT DATE: 17-SEP-2012 11:31
DRAWN BY: NLA
CHECKED BY: JLS
SHEET 7 OF 51

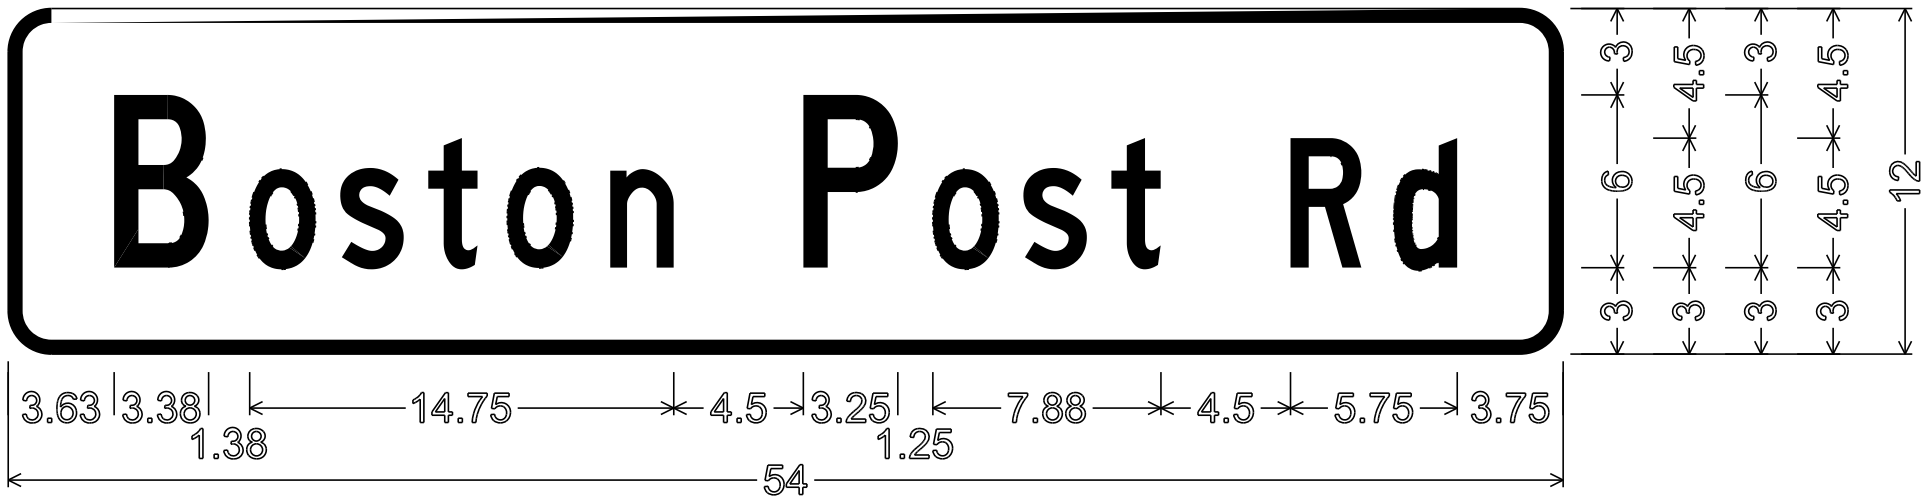

1.50" RADIUS, 0.50" BORDER, 0.00" INDENT
COLORS: LEGEND - WHITE
BACKGROUND - GREEN
TEXT STYLE: C

D3-1

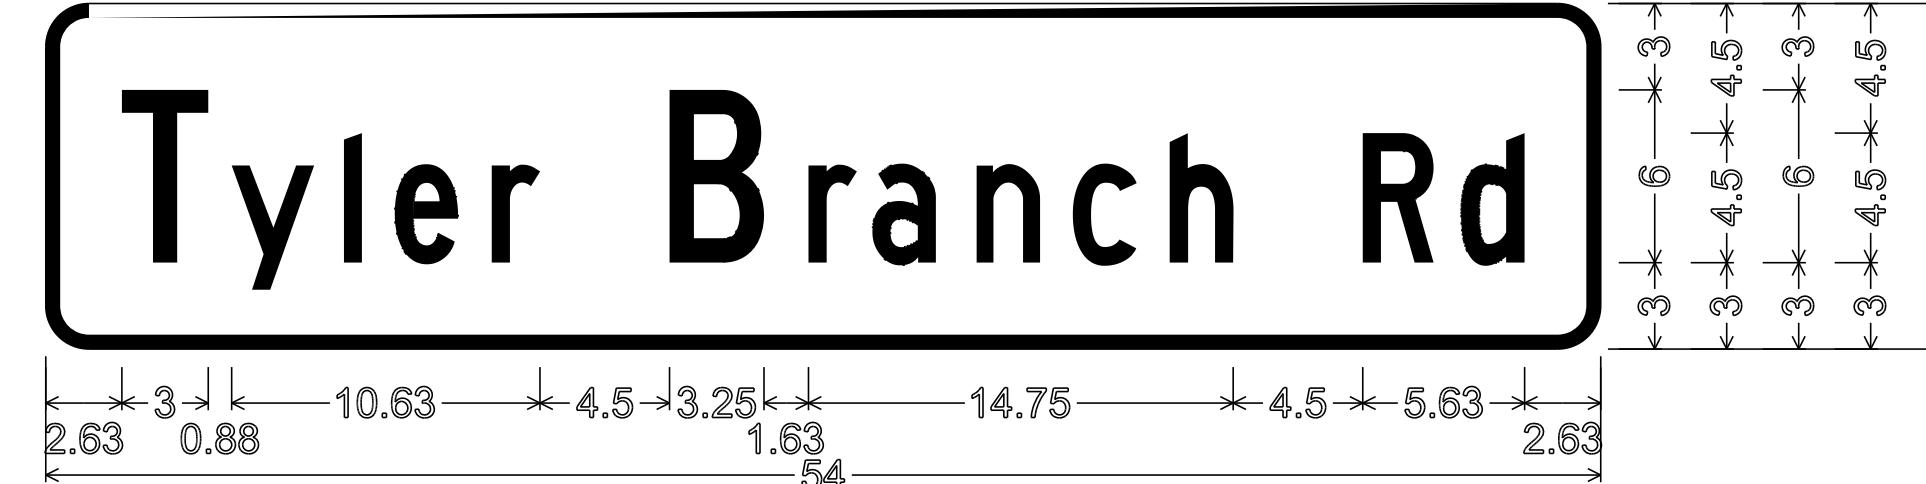

1.50" RADIUS, 0.50" BORDER, 0.00" INDENT
COLORS: LEGEND - WHITE
BACKGROUND - GREEN
TEXT STYLE: C

D3-1



1.5" RADIUS, 0.375" BORDER, 0.375" INDENT
COLORS: LEGEND - BLACK
BACKGROUND - YELLOW
TEXT STYLE: B

W16-8P

ENOSBURG




1.5" RADIUS, 0.375" BORDER, 0.375" INDENT
COLORS: LEGEND - BLACK
BACKGROUND - YELLOW
TEXT STYLE: B

W16-8P



1.50" RADIUS, 0.50" BORDER, 0.00" INDENT
COLORS: LEGEND - WHITE
BACKGROUND - GREEN
TEXT STYLE: C


D3-1

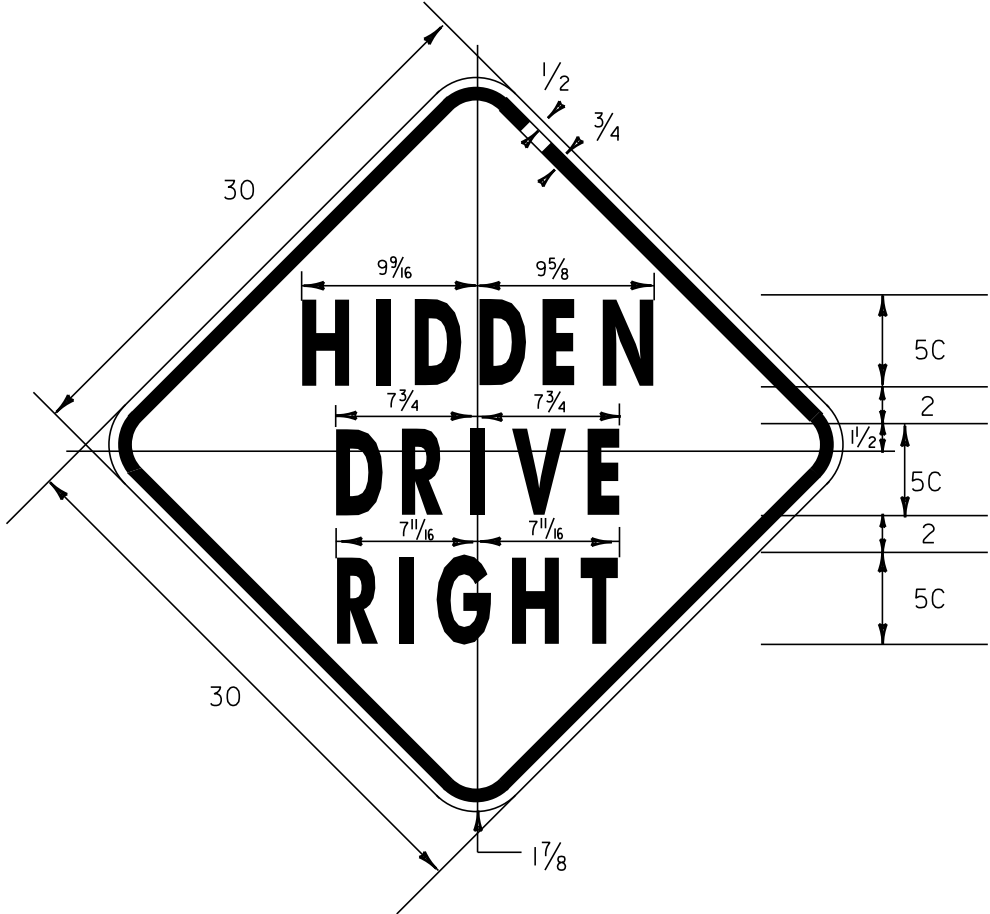

VW-054

1.875" RADIUS, 0.75" BORDER, 0.50" INDENT
COLORS: LEGEND - BLACK
BACKGROUND - YELLOW
TEXT STYLE: "HIDDEN" C; "DRIVE" C; "LEFT" C


NORTHFIELD

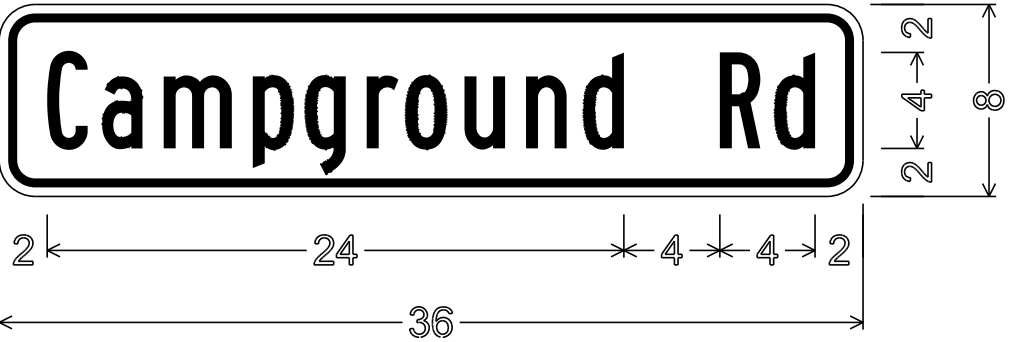

1.5" RADIUS, 0.375" BORDER, 0.375" INDENT
COLORS: LEGEND - BLACK
BACKGROUND - YELLOW
TEXT STYLE: B

W16-8P

NEW HAVEN

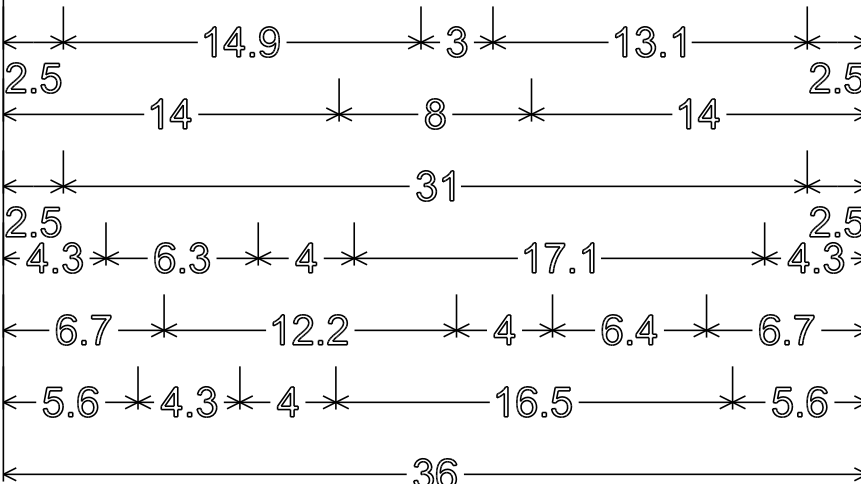

2.5" RADIUS, 0.625" BORDER, 0.375" INDENT
COLORS: LEGEND - BLACK
BACKGROUND - WHITE
TEXT STYLE: RATTLIN BRIDGE - C
NOT - C
RECOMMENDED - C
FOR CAMPERS, - B
BUSES, RVs - B
OR TRAILERS - B


VR-493M

WEYBRIDGE


ALL DIMENSIONS SHOWN IN INCHES UNLESS OTHERWISE NOTED.

PROJECT NAME: STATEWIDE NORTHWEST REGION
PROJECT NUMBER: STP HRRR(5)


FILE NAME: I0k0I8_wrk.dgn PLOT DATE: 17-SEP-2012 11:31
PROJECT LEADER: JLS DRAWN BY: NLA
DESIGNED BY: NLA CHECKED BY: JLS
SPECIFIC SIGN DETAILS ENO/NOR/NEW H/WEY SHEET 8 OF 51

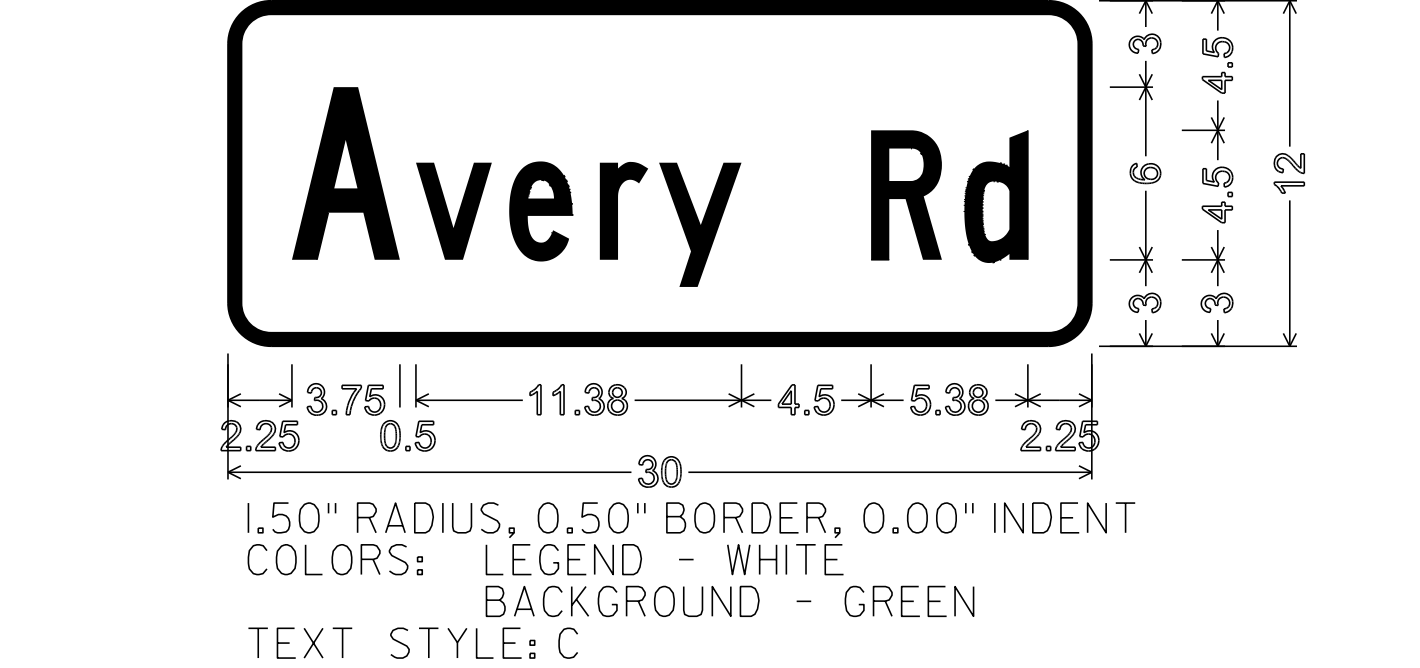


D3-1

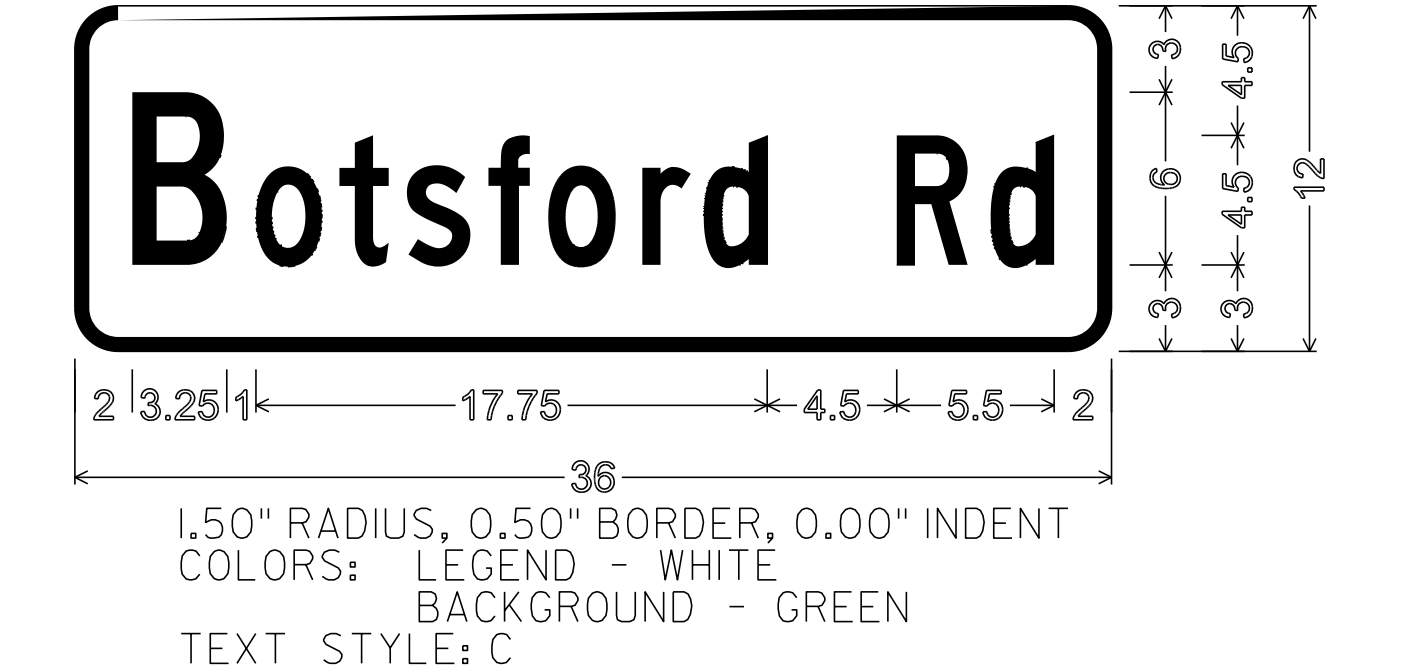

D3-1

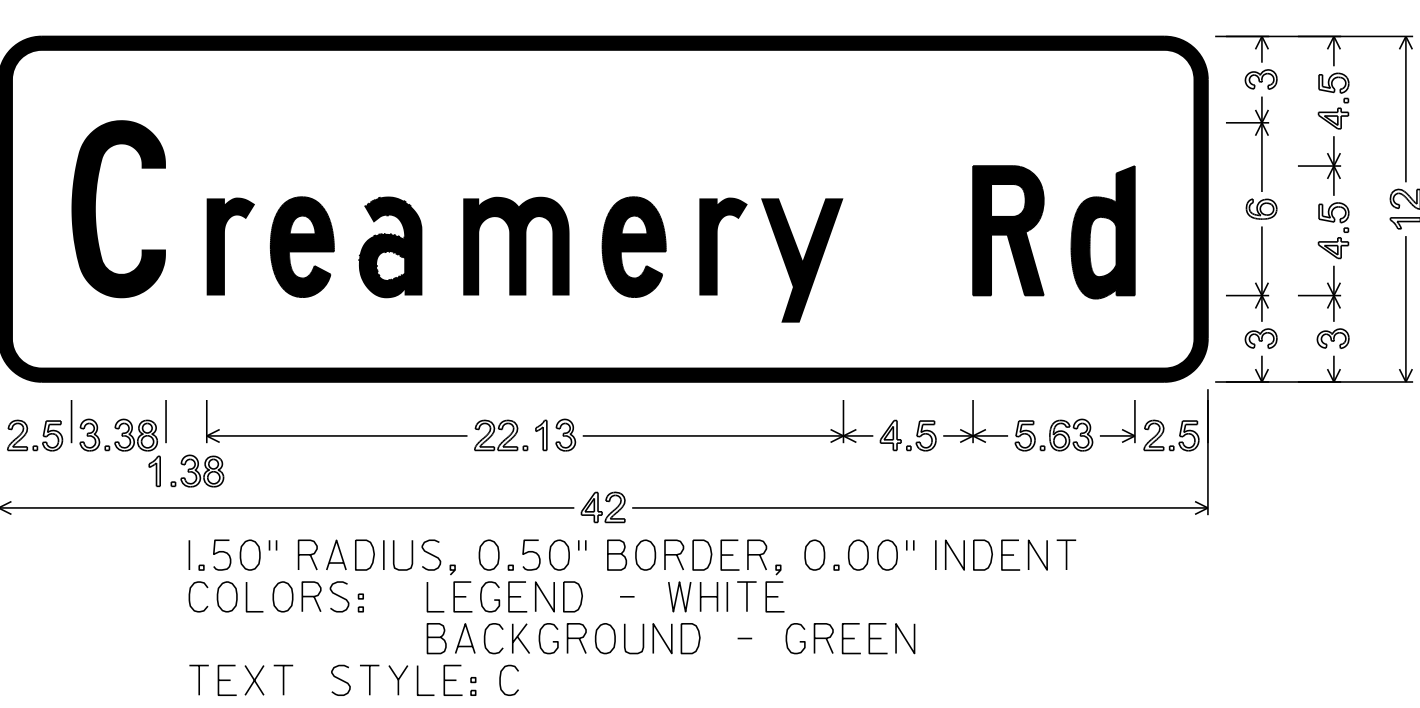


D3-1

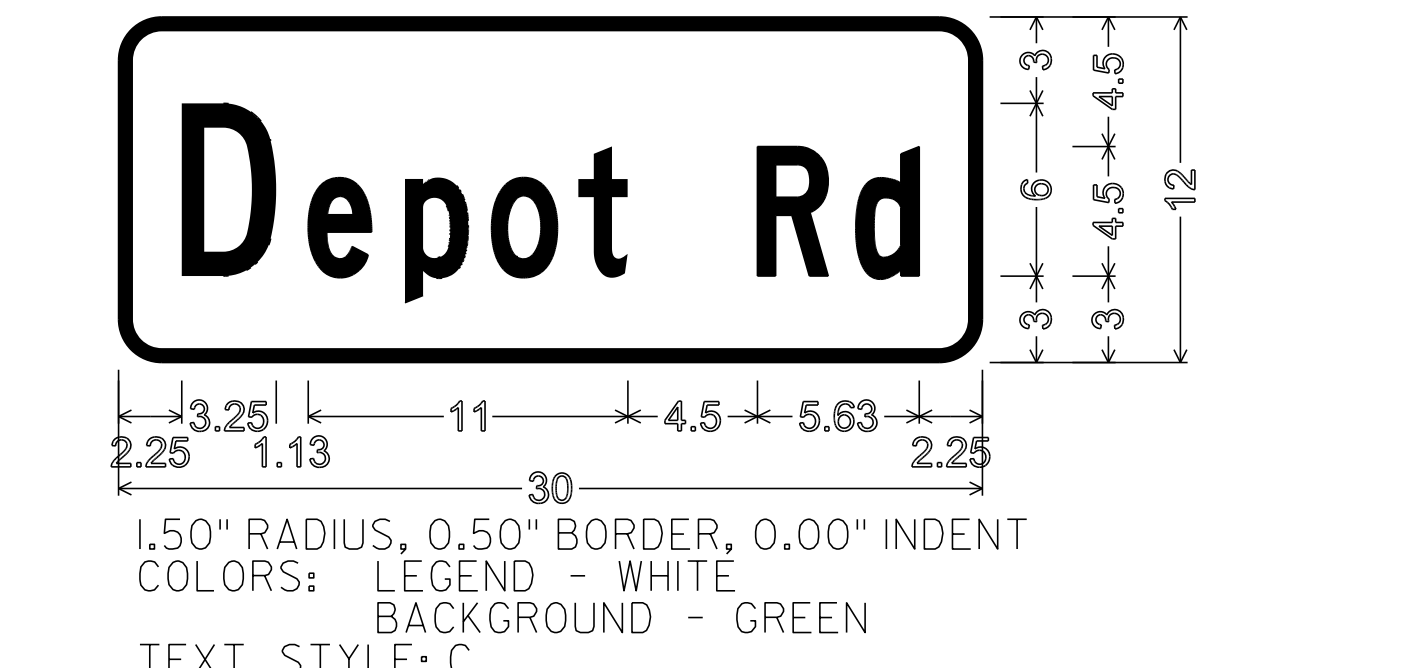


D3-1




D3-1

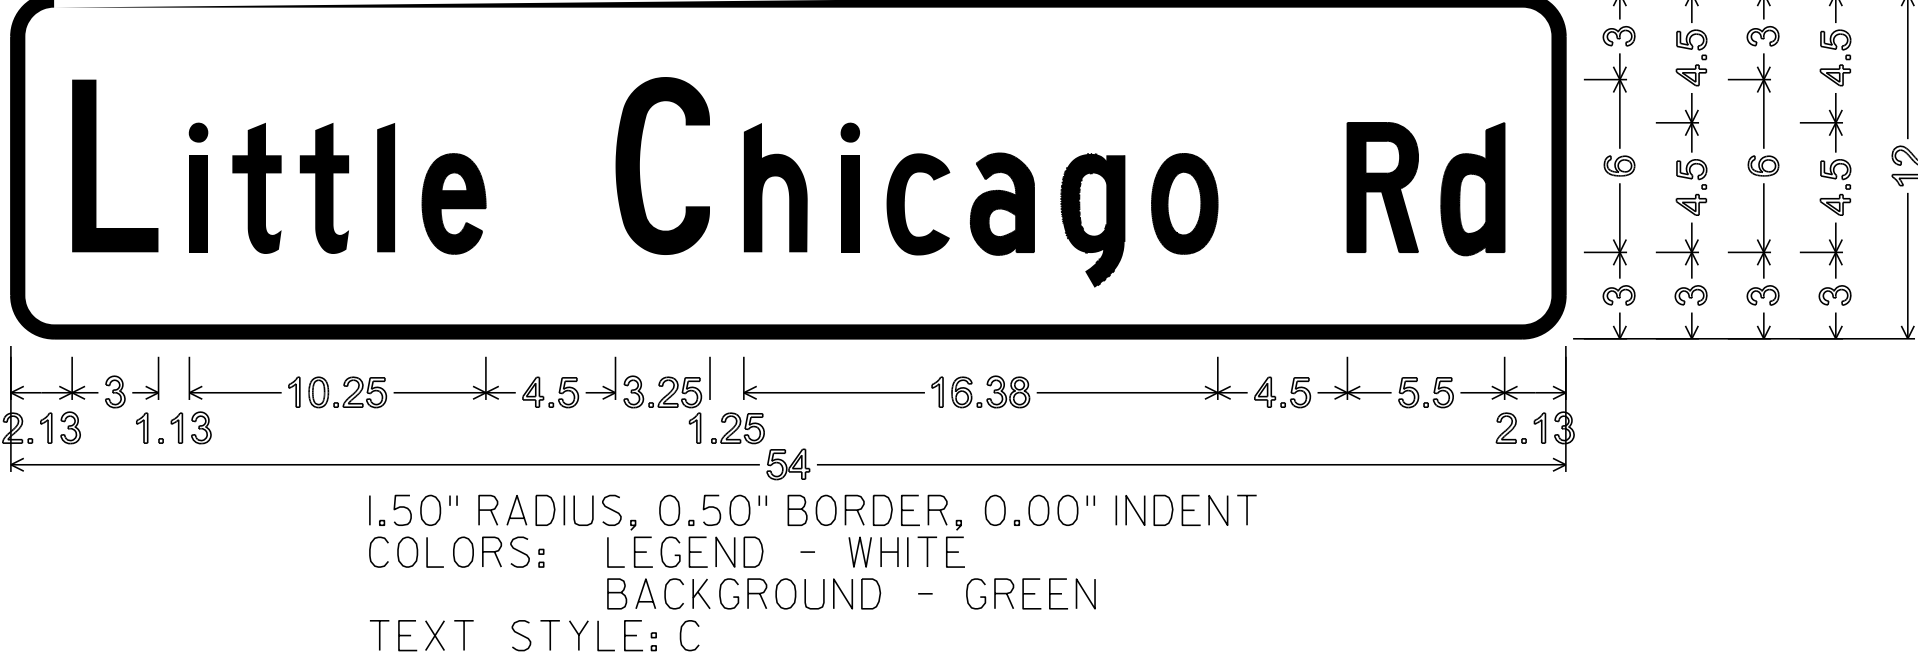


D3-1

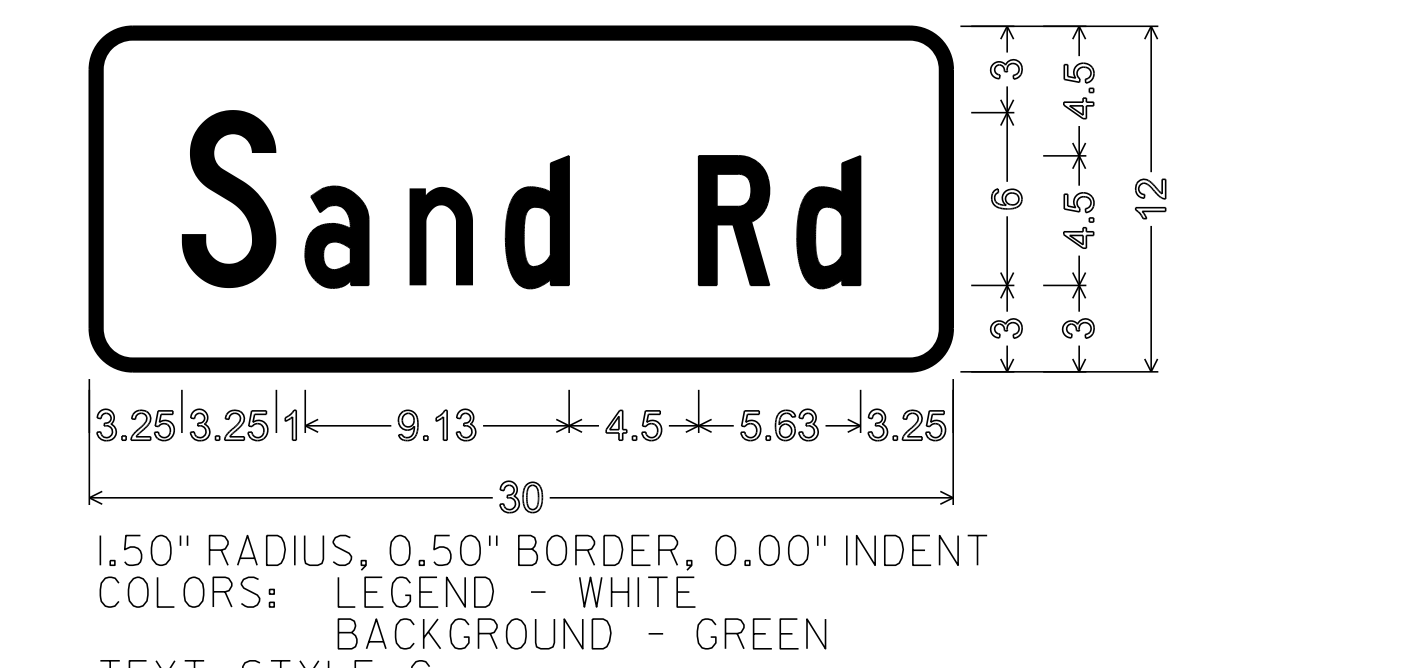

D3-1

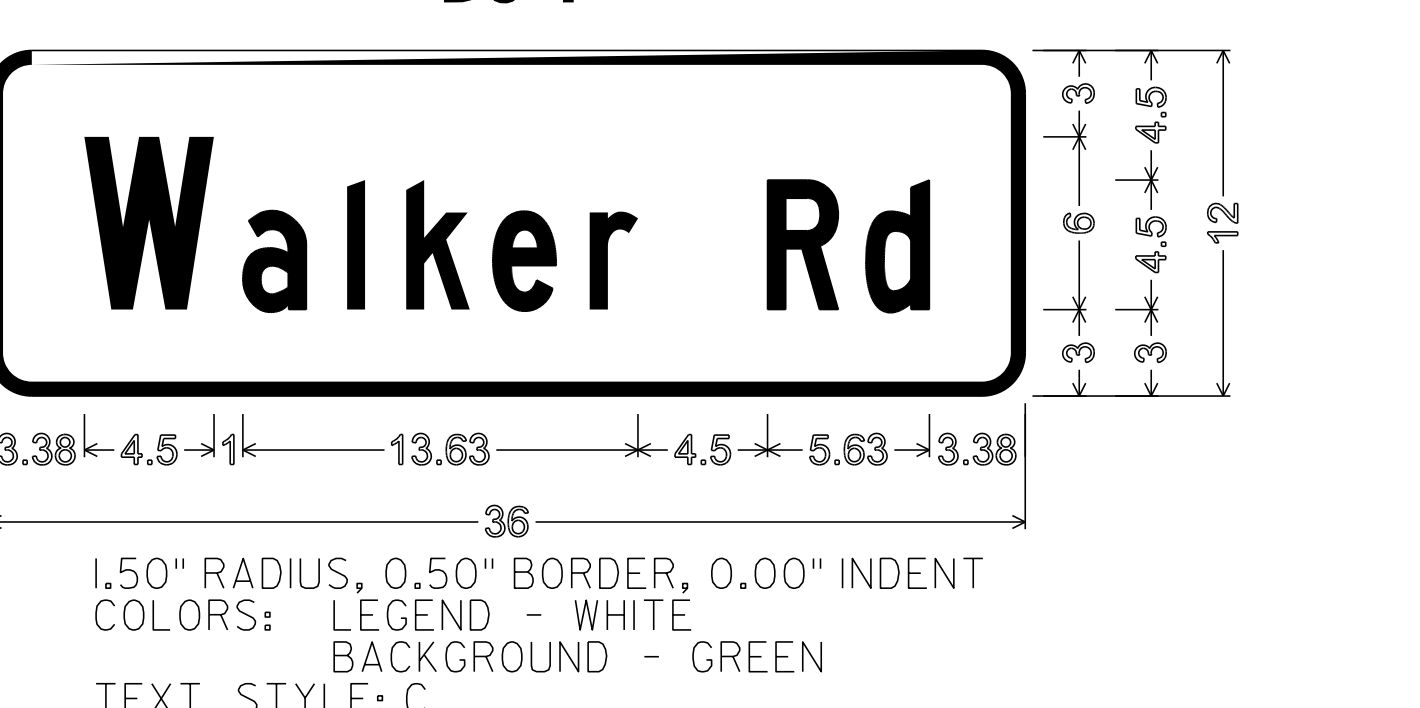


D3-1

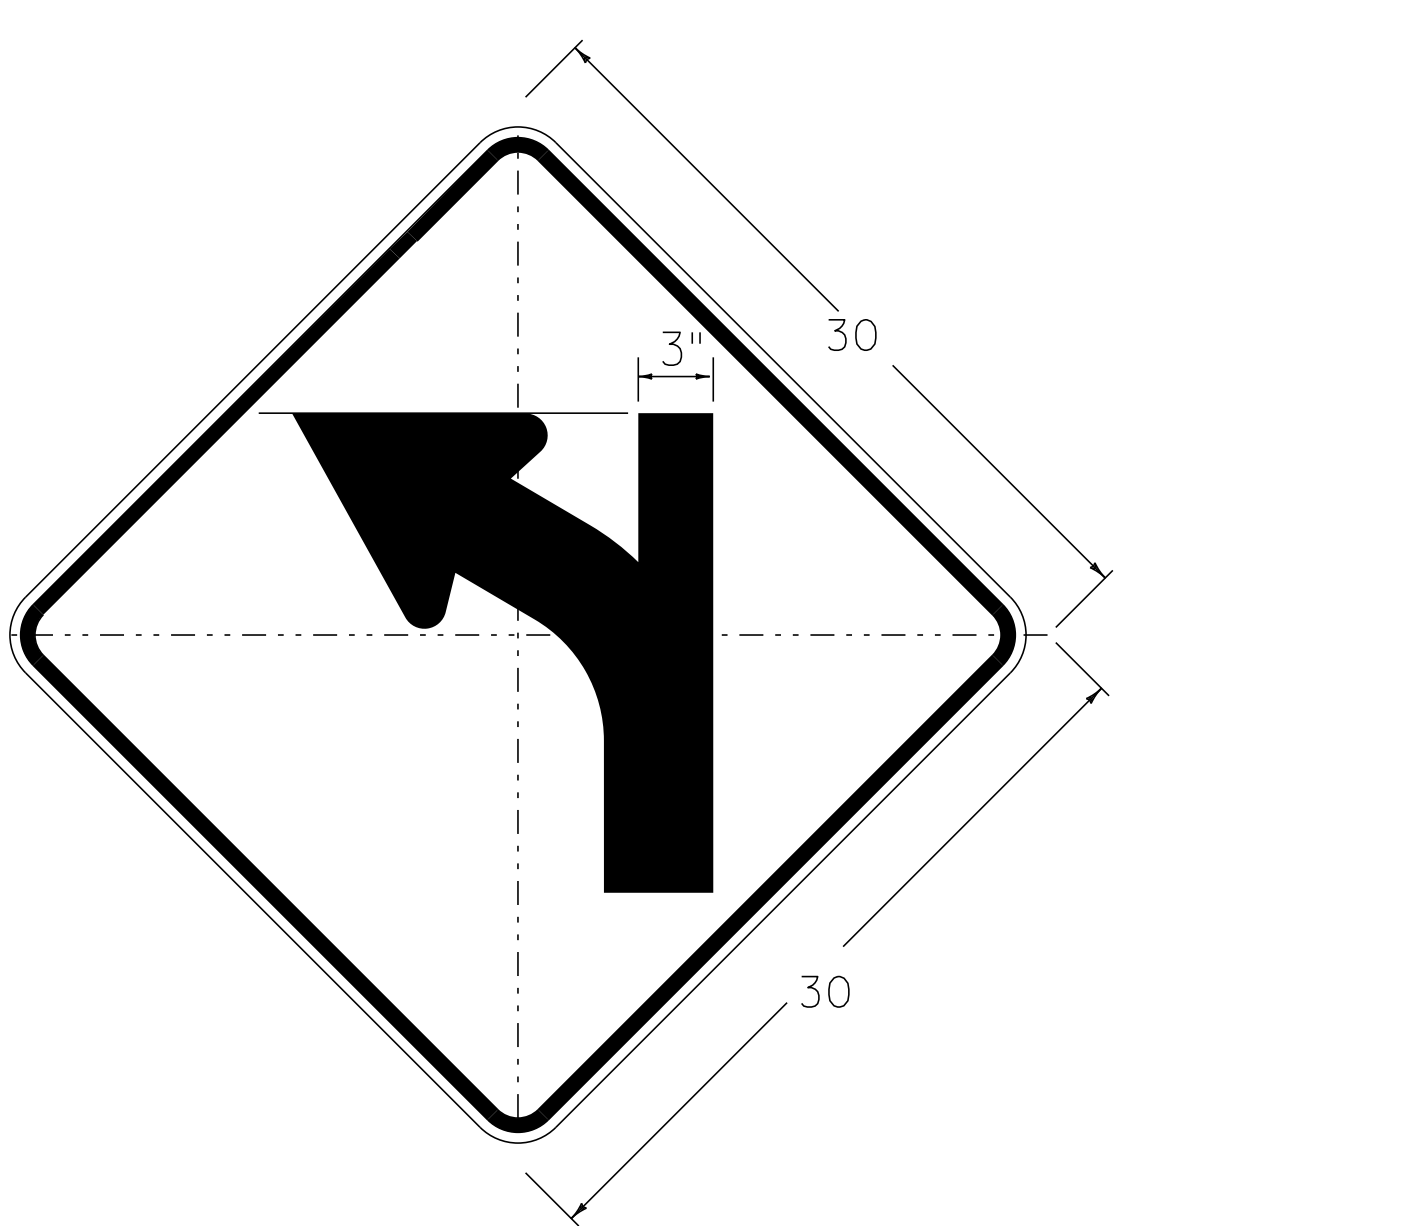


W1-2Mg L(R)


DIMENSIONS NOT SHOWN
FOR THIS DETAIL SHALL CONFORM
TO THE LATEST EDITION OF THE 2009 MUTCD
FOR A 30"x30" SIGN DETAIL W1-2.
UNLESS OTHERWISE NOTED FOR THIS DETAIL

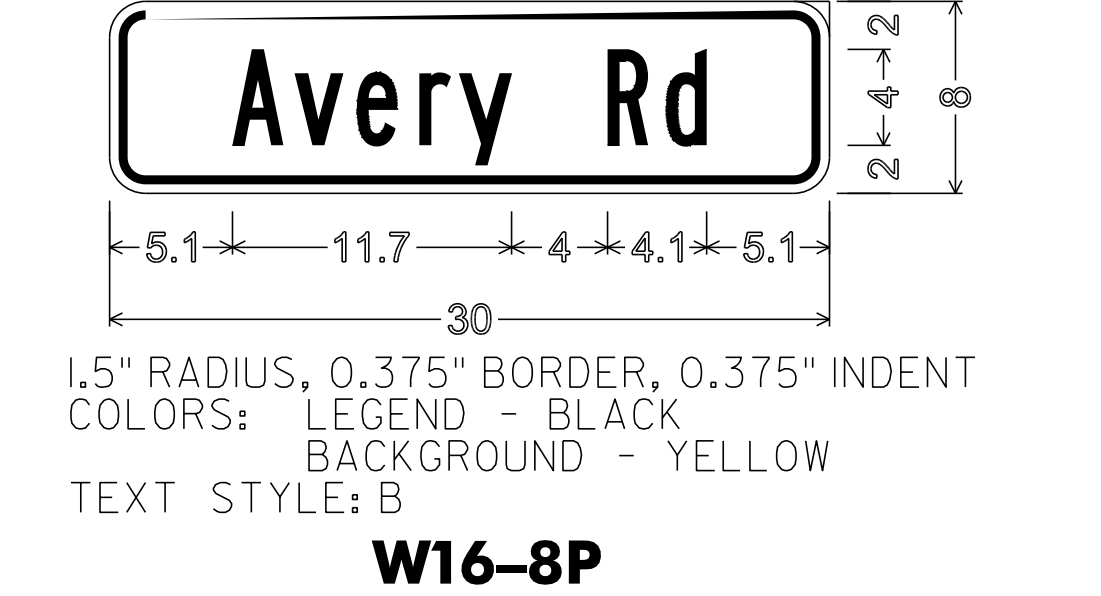


W16-8P

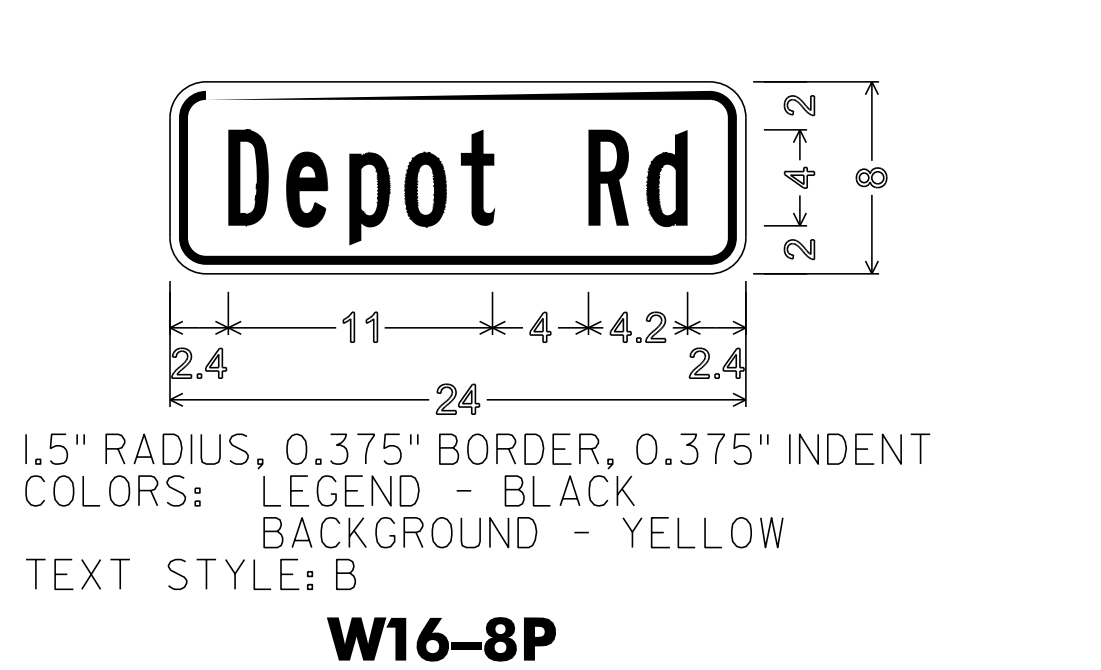


W16-8P

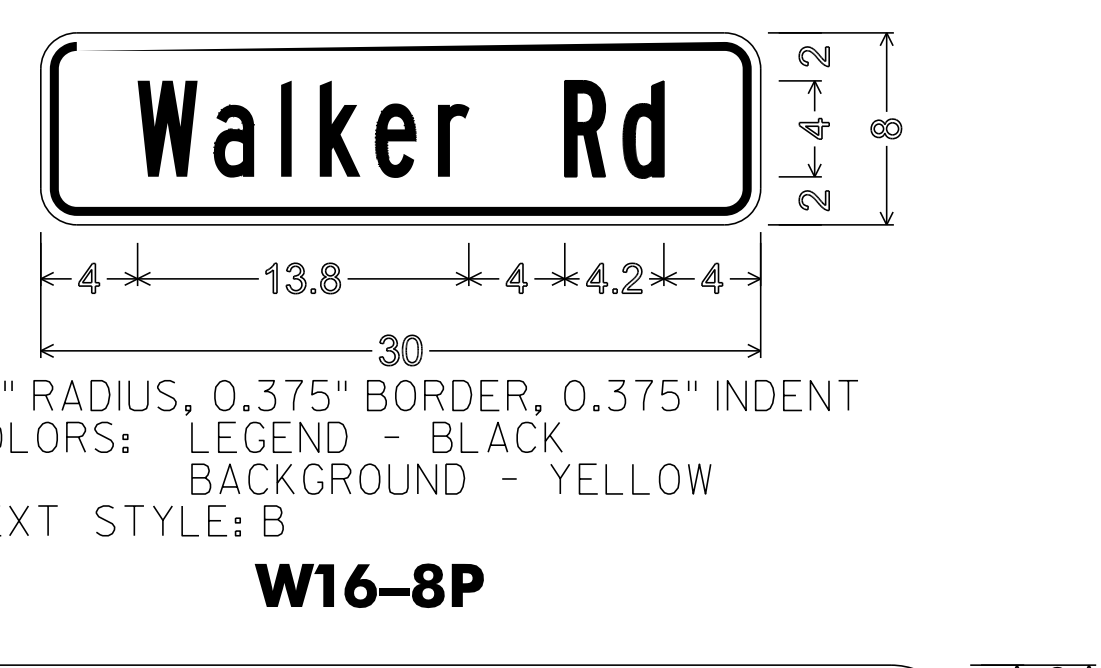

W16-8P

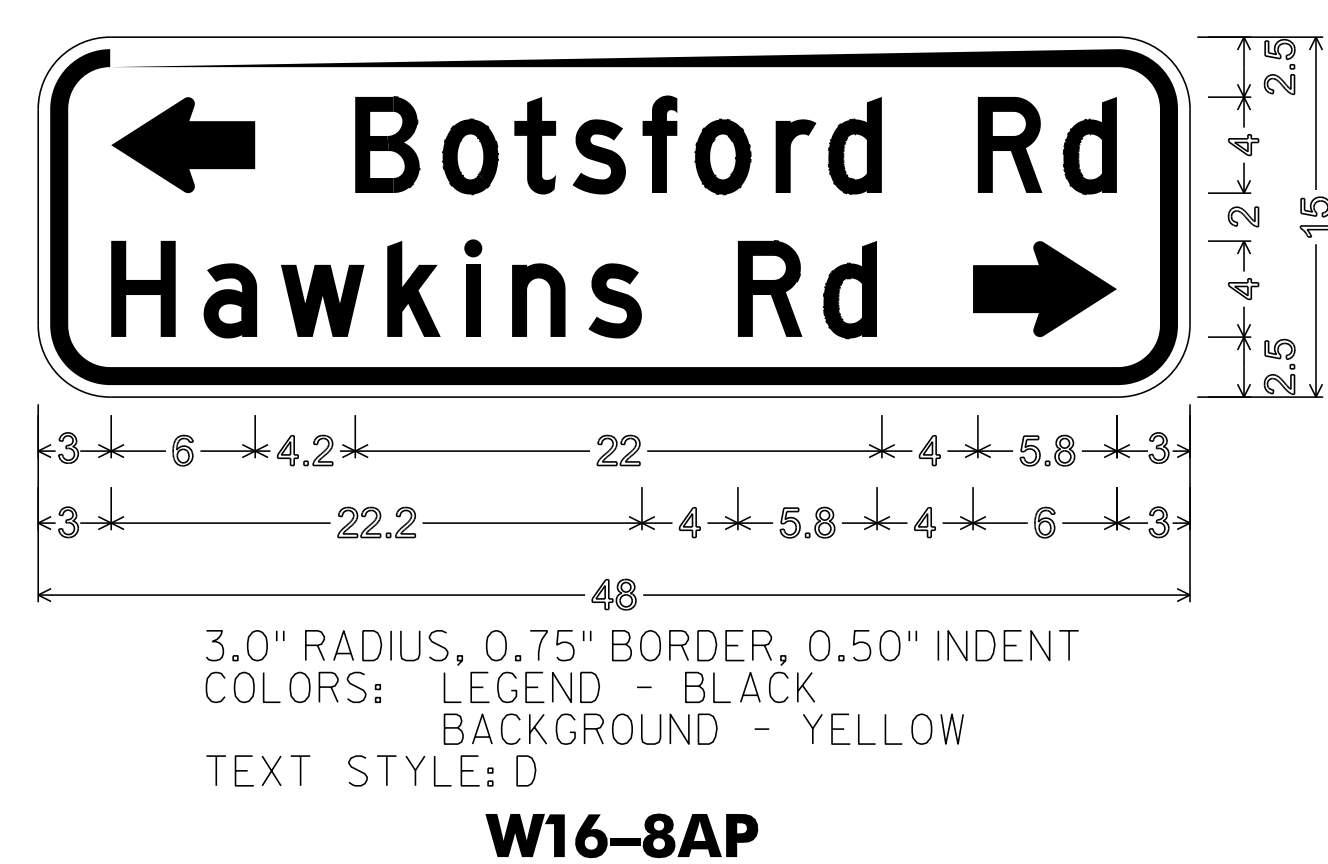

W16-8AP

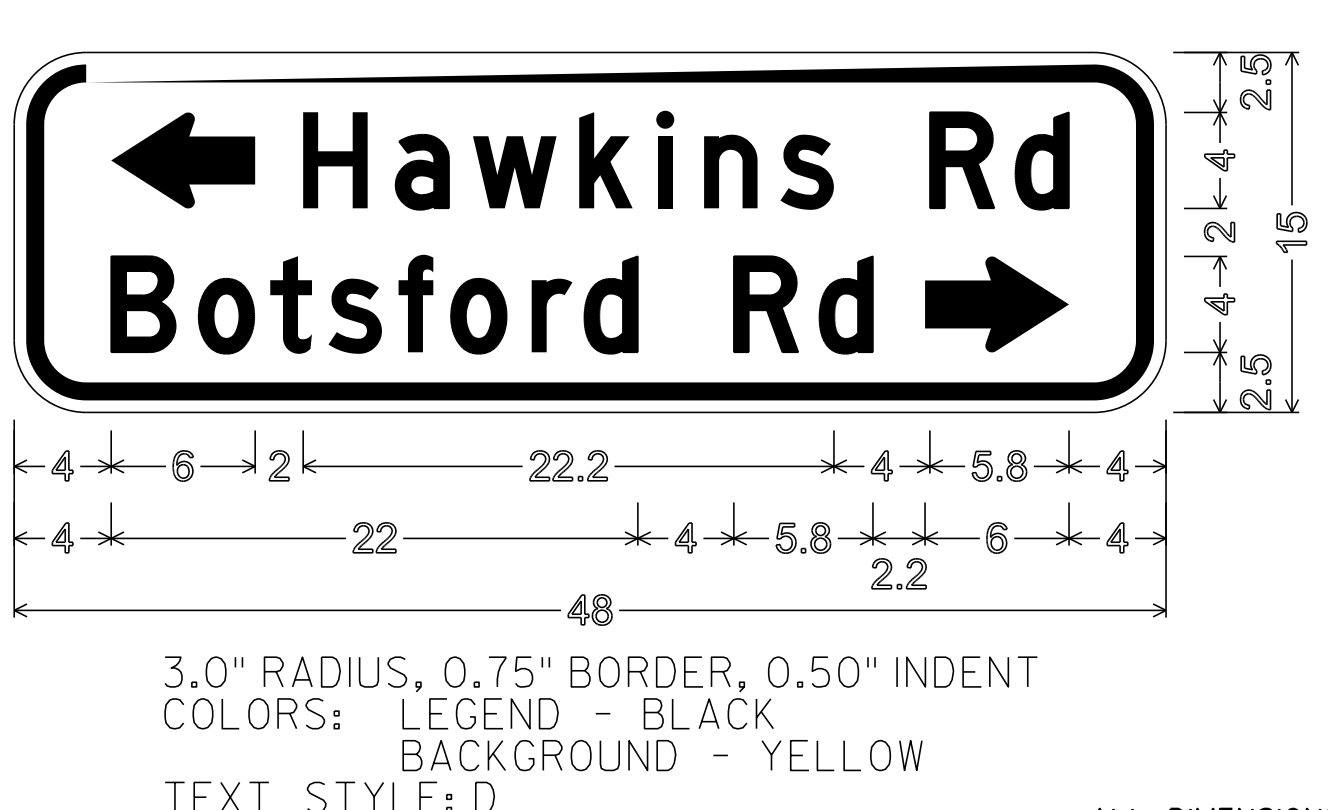


W16-8AP

FERRISBURGH

ALL DIMENSIONS SHOWN IN INCHES UNLESS OTHERWISE NOTED.

PROJECT NAME: STATEWIDE NORTHWEST REGION
PROJECT NUMBER: STP HRRR(5)

FILE NAME: I0K0I8_wrk.dgn
PROJECT LEADER: JLS
DESIGNED BY: NLA
SPECIFIC SIGN DETAILS FERRISBURGH
PLOT DATE: 17-SEP-2012 11:31
DRAWN BY: NLA
CHECKED BY: JLS
SHEET 9 OF 51

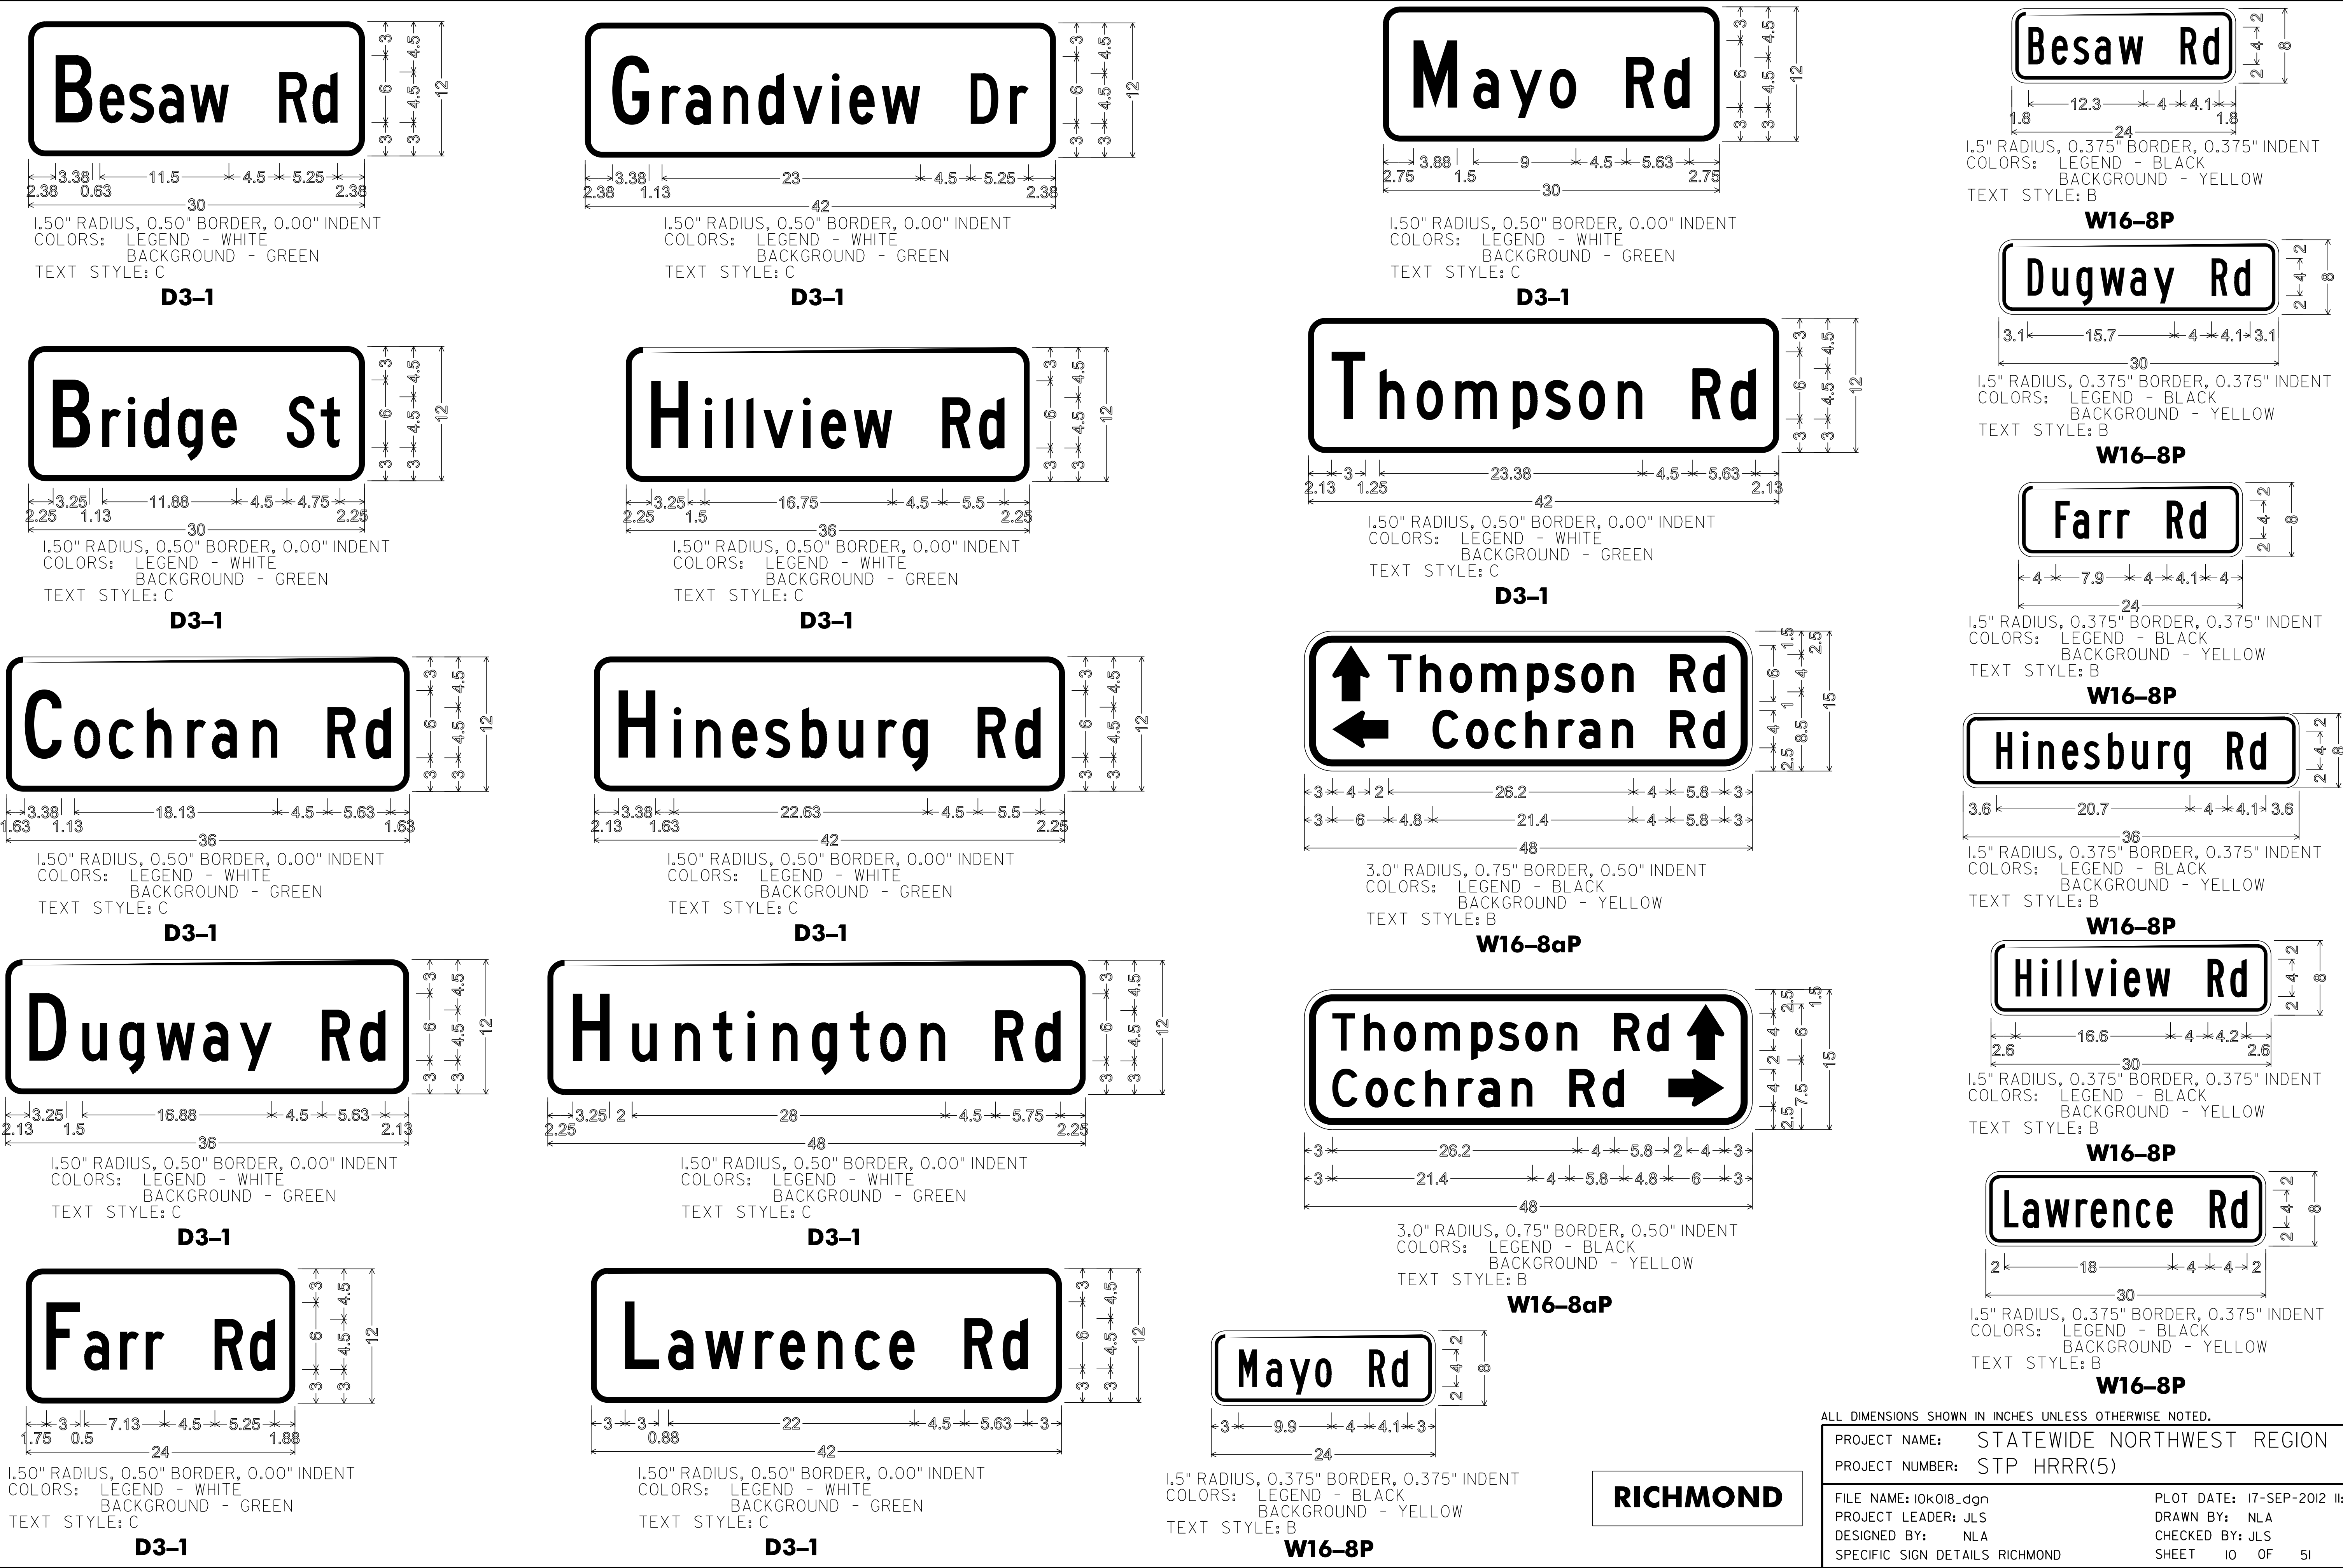

ALL DIMENSIONS SHOWN IN INCHES UNLESS OTHERWISE NOTED.

PROJECT NAME:	STATEWIDE NORTHWEST REGION	
PROJECT NUMBER:	STP HRRR(5)	
FILE NAME:	I0K018.dgn	PLOT DATE: 17-SEP-2012 11:31
PROJECT LEADER:	JLS	DRAWN BY: NLA
DESIGNED BY:	NLA	CHECKED BY: JLS
SPECIFIC SIGN DETAILS	RICHMOND	SHEET 10 OF 51



0.375" RADIUS, 0.375" BORDER, NO INDENT
COLORS: LEGEND - WHITE
BACKGROUND - GREEN
TEXT STYLE: C

D2-1




0.375" RADIUS, 0.375" BORDER, NO INDENT
COLORS: LEGEND - WHITE
BACKGROUND - GREEN
TEXT STYLE: C

D2-1




0.375" RADIUS, 0.375" BORDER, NO INDENT
COLORS: LEGEND - WHITE
BACKGROUND - GREEN
TEXT STYLE: C

D1-1

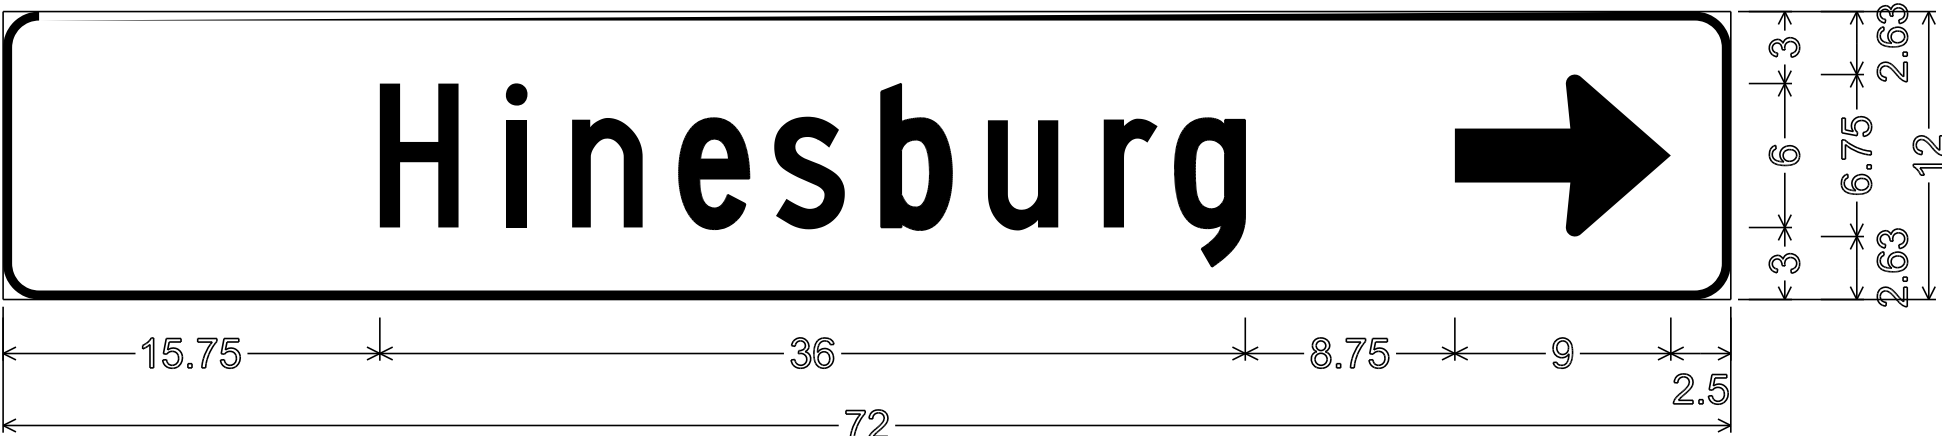

0.375" RADIUS, 0.375" BORDER, NO INDENT
COLORS: LEGEND - WHITE
BACKGROUND - GREEN
TEXT STYLE: C


D1-1

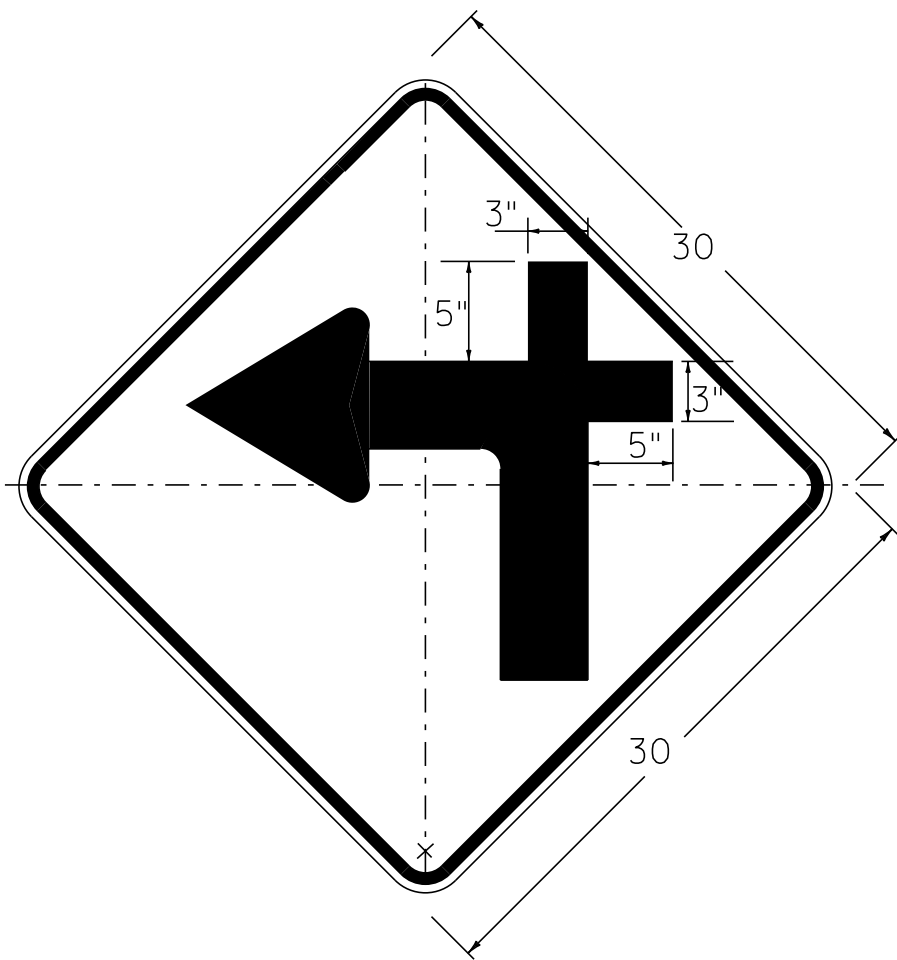

W1-1Mc L(R)


DIMENSIONS NOT SHOWN
FOR THIS DETAIL SHALL CONFORM
TO THE LATEST EDITION OF THE 2009 MUTCD
FOR SIGN DETAIL W1-1.
UNLESS OTHERWISE NOTED FOR THIS DETAIL

RICHMOND

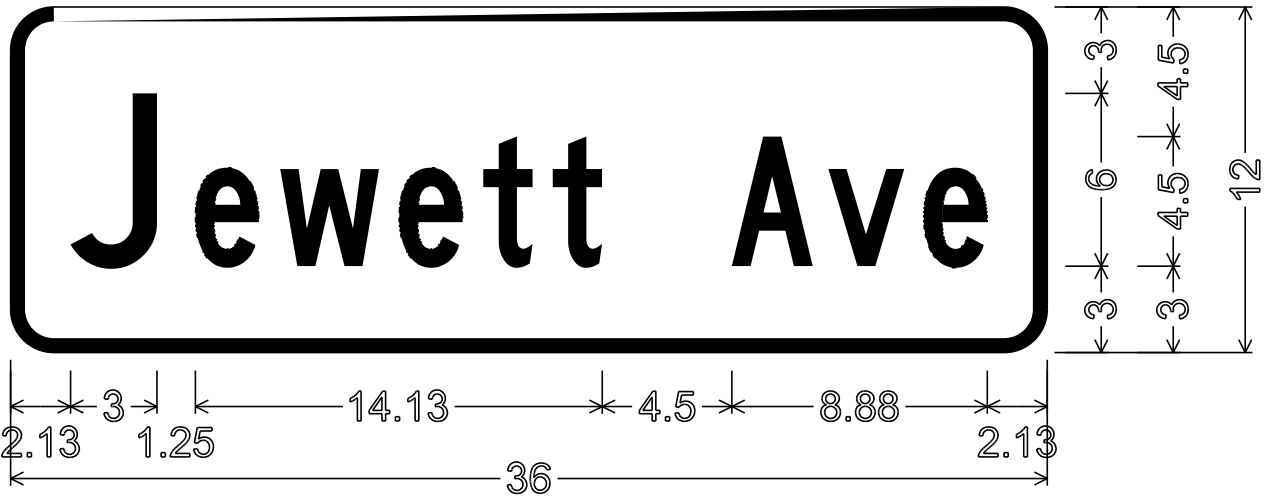


1.50" RADIUS, 0.50" BORDER, 0.00" INDENT
COLORS: LEGEND - WHITE
BACKGROUND - GREEN
TEXT STYLE: C

D3-1

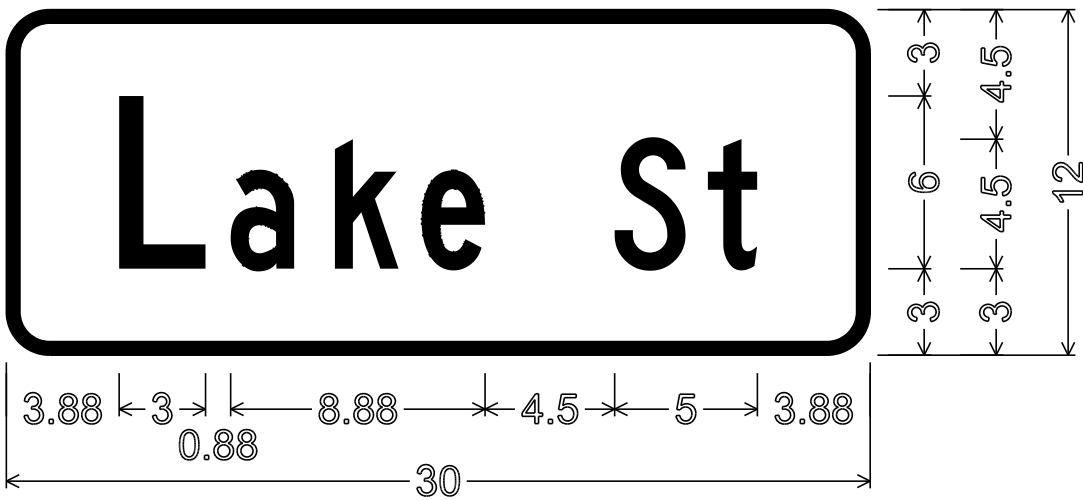

1.50" RADIUS, 0.50" BORDER, 0.00" INDENT
COLORS: LEGEND - WHITE
BACKGROUND - GREEN
TEXT STYLE: C

D3-1

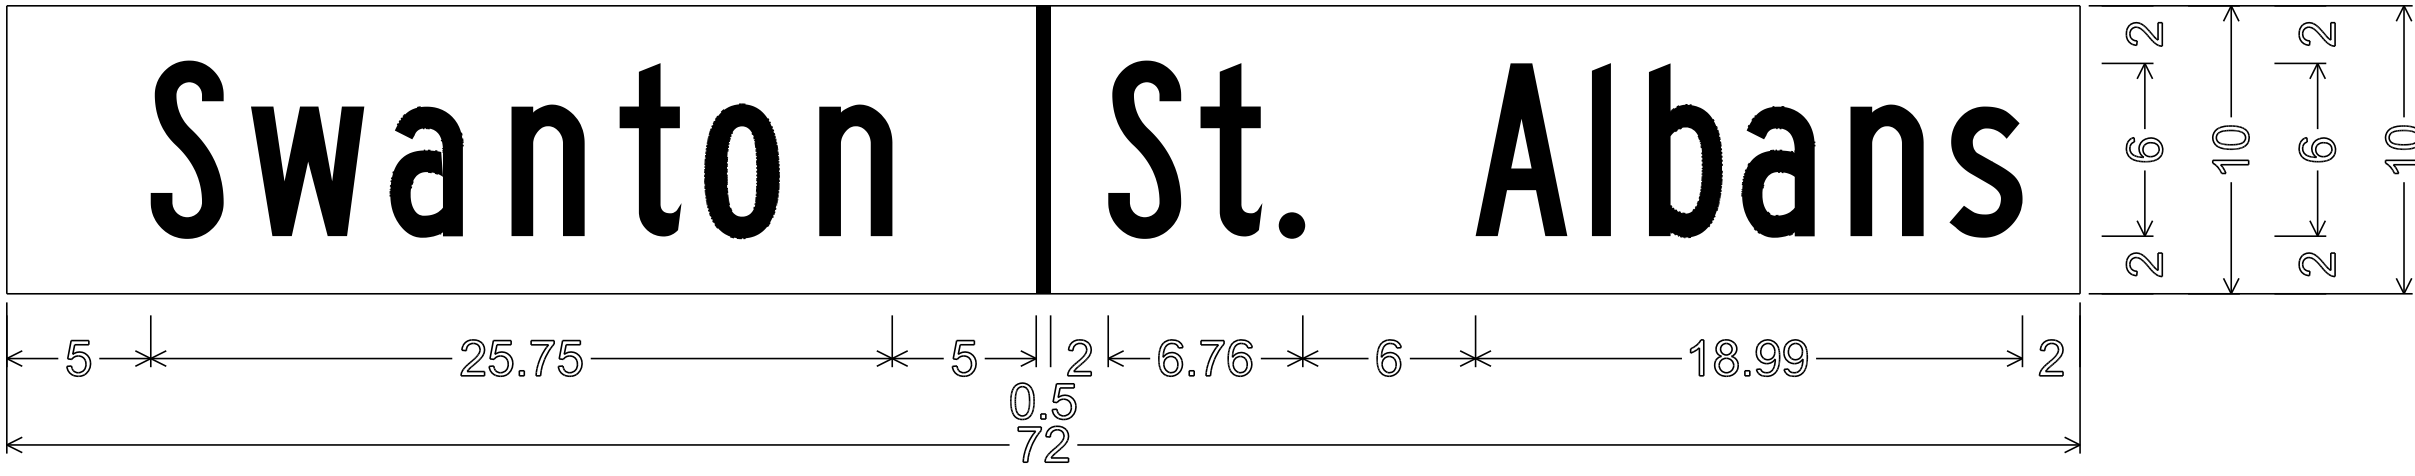


NO BORDER.
COLORS: LEGEND - WHITE
BACKGROUND - GREEN
TEXT STYLE: B

VD-024




1.50" RADIUS, 0.50" BORDER, 0.00" INDENT
COLORS: LEGEND - WHITE
BACKGROUND - GREEN
TEXT STYLE: C

D3-1

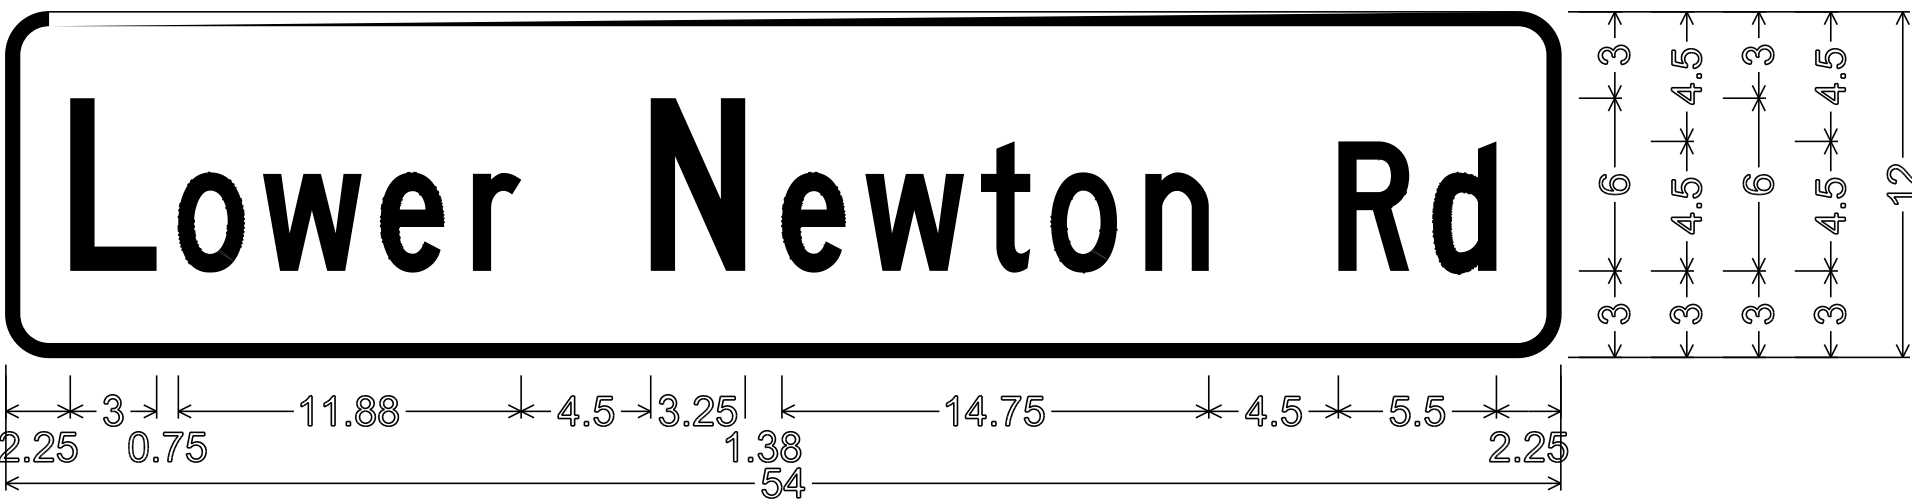

1.50" RADIUS, 0.50" BORDER, 0.00" INDENT
COLORS: LEGEND - WHITE
BACKGROUND - GREEN
TEXT STYLE: C

D3-1

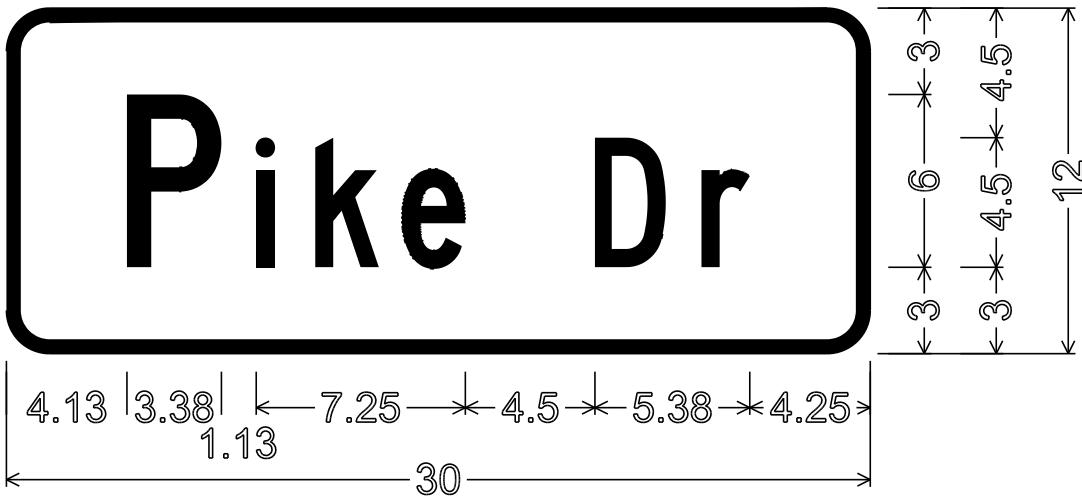

1.50" RADIUS, 0.50" BORDER, 0.00" INDENT
COLORS: LEGEND - WHITE
BACKGROUND - GREEN
TEXT STYLE: C

D3-1

ST ALBANS

ALL DIMENSIONS SHOWN IN INCHES UNLESS OTHERWISE NOTED.

PROJECT NAME: STATEWIDE NORTHWEST REGION
PROJECT NUMBER: STP HRRR(5)


FILE NAME: I0k0I8_wrk.dgn
PROJECT LEADER: JLS
DESIGNED BY: NLA
SPECIFIC SIGN DETAILS RICHMOND/ST ALBANS SHEET II OF 5I
PLOT DATE: 17-SEP-2012 11:31
DRAWN BY: NLA
CHECKED BY: JLS

DIRECTION	MILEMARKER, STATION, OR SIGN NUMBER	LOCATION	MANUAL ON UNIFORM TRAFFIC DEVICES OR STATE CODE	SIGN DIMENSIONS		SHEETING REMARKS	SIGN LEGEND	NEW SIGNS		EXISTING SIGNS				EXISTING POST		NO. OF NEW POSTS	SQUARE STEEL (in)			TUBULAR STEEL O/(in)				SIGN FRAME REQUIRED	REMARKS SHS = STANDARD HIGHWAY SIGN BOOK	SIGN DETAIL				
				WIDTH	HEIGHT			RETAIN	SALVAGE FROM	SALVAGE TO	REMOVE	RE-MAIN	RE-MOVE	1.75 lb/ft	2.00 lb/ft		2.50	FOUNDATION	3.00	3.50	4.00	5.00	DETAIL IN SHS			DETAIL ON SHEET NUMBER	STANDARD SHEET NUMBER			
"A"	"B"																													
							BOSTON POST ROAD																							
EB	MM 0.003, RT	A	W3-I	36	36			9.00					X		X	2		X								INSTALL NEW SIGN ON 2-POSTS ACROSS FROM POLE# 37 AND 15 FT EAST	X			
WB	MM 0.027, LT	F	R2-I	24	30			5.00								1		X								INSTALL NEW SIGN AND POST 48 FT WEST OF POLE# 2	X			
EB	MM 0.099, RT	A	RI-I	30	30			6.25					X		X	1		X								REMOVE SIGN AND POST AND INSTALL NEW SIGN AND POST AT SAME LOCATION	X			
EB	MM 0.100, RT	A/B	D3-I	54	12			4.50					X			2		X								INSTALL NEW SIGN ON 2-POSTS 5' SOUTH OF STOP SIGN.INSTALL SIGN AS NOT TO OBSTRUCT VIEW OF STOP SIGN		8		
		C/D	D3-I	54	12			4.50					X													INSTALL NEW SIGN ABOVE BOSTON POST RD SIGN ON SAME POSTS		8		
WB	MM 0.099, LT	F	RI-I	30	30			6.25					X		X	1		X								REMOVE SIGN AND POST AND INSTALL NEW SIGN AND POST AT SAME LOCATION	X			
WB	MM 0.115, RT	F	RI-I	30	30			6.25					X		X	1		X								REMOVE SIGN AND POST AND INSTALL NEW SIGN AND POST AT SAME LOCATION	X			
WB	MM 0.116, RT	A/B	D3-I	54	12			4.50					X			2		X								INSTALL NEW SIGN ON 2-POSTS 5' NORTH OF STOP SIGN.INSTALL SIGN A AS NOT TO OBSTRUCT VIEW OF STOP SIGN		8		
		C/D	D3-I	54	12			4.50					X													REMOVE SIGN AND INSTALL ABOVE NEW BOSTON POST RD STREET NAME SIGN		8		
EB	MM 0.176, LT	A	R2-I	24	30			5.00								+		✗								INSTALL NEW SIGN AND POST 37 FT WEST OF POLE# 3	X			
WB	MM 0.207, RT	F	W3-I	36	36			9.00					X		X	2		X								INSTALL NEW SIGN ON 2-POSTS ACROSS FROM POLE# 4 AND 48 FT WEST	X			
							TYLER BRANCH ROAD																							
NB	MM 0.053, RT	A	W2-I	30	30			6.25								1		X								INSTALL NEW SIGN AND POST 97 FT SOUTH OF POLE# 170/146	X			
		A	W16-8P	42	8			2.33 2.749																		INSTALL NEW SIGN BENEATH INTERSECTION, WARNING SIGN AT THE CORRECT SIGN HEIGHT		8		
NB	MM 0.094, RT	A	W20-I	36	18								X		X											REMOVE SIGN AND POST				
FINAL POST LENGTHS ARE TO BE DETERMINED IN THE FIELD. POST SIZES ARE COMPUTED BASED ON INFORMATION FURNISHED ON THE STANDARD SHEETS AND THE VTRANS "SIGN POST DESIGN GUIDELINE".											EA	EA	EA	EA	EA	EA	6		FT	FT	FT			LB	LB	LB	LB	PROJECT NAME: STATEWIDE NORTHWEST REGION PROJECT NUMBER: STP HRRR(5) FILE NAME: IOK018_wrk.dgn PLOT DATE: 17-SEP-2012 11:31 PROJECT LEADER: JLS DRAWN BY: ITS DESIGNED BY: NLA CHECKED BY: JLS ENOSBURG TRAFFIC SIGN SUMMARY SHEET 1 SHEET 12 OF 51		
							SHEET SUBTOTALS							SF	SF	EA				EA	EA	EA	6	FT	FT	FT	EA			

STATE OF VERMONT
AGENCY OF TRANSPORTATION

TRAFFIC SIGN SUMMARY SHEET 2









ENOSBURG

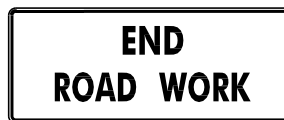DIRECTION	MILEMARKER, STATION, OR SIGN NUMBER	LOCATION	MANUAL ON UNIFORM TRAFFIC DEVICES OR STATE CODE	SIGN DIMENSIONS		SHEETING REMARKS	SIGN LEGEND	NEW SIGNS		EXISTING SIGNS				EXISTING POST		NO. OF NEW POSTS	SQUARE STEEL (in)			TUBULAR STEEL 0/(in)				SIGN FRAME REQUIRED	REMARKS SHS = STANDARD HIGHWAY SIGN BOOK	SIGN DETAIL			
				WIDTH	HEIGHT			"A"	"B"	RETAIN	SALVAGE FROM	SALVAGE TO	REMOVE	RETAIN	REMOVE		1.75 lb/ft	2.00 lb/ft	2.50 lb/ft	FOUNDATION	3.00	3.50	4.00			5.00	DETAIL IN SHS	DETAIL ON SHEET NUMBER	STANDARD SHEET NUMBER
NB	MM 0.095, RT	A	W5-3	36	36			9.00								2		X						INSTALL NEW SIGN ON 2-POSTS 23 FT SOUTH OF POLE# 4/I45	X				
SB	MM 0.103, LT	F	G20-2	36	18								X		X									REMOVE SIGN AND POST					
NB	MM 0.134, RT	A	TOWN SIGN	30	30								X		X									REMOVE SIGN AND POST					
		A	W3-2	36	36			9.00								2		X						INSTALL NEW SIGN AND POST 32 FT NORTH OF POLE# 144	X				
SB	MM 0.168, LT	F	R2-1	24	30			5.00								1		X						INSTALL NEW SIGN AND POST ACROSS FROM POLE# 16/I43/E51	X				
NB	MM 0.200, LT	A	RI-2	36	36			3.89					X		X	1		X						INSTALL NEW SIGN AND POST 4 FT NORTH OF POLE# 66/4/I42	X				
		A	RI-2AP	24	18			3.00																INSTALL NEW SIGN BENEATH YIELD SIGN ON SAME POST AT CORRECT SIGN HEIGHT	X				
NB	MM 0.204, LT	A	RI-2	36	36								X		X									REMOVE SIGN AND POST					
NB	MM 0.237, RT	A	OM3-R	12	36			3.00					X		X	1		X						INSTALL NEW SIGN AND POST AT SAME LOCATION AT SOUTHEAST END OF BRIDGE FACING SOUTH	X				
SB	MM 0.237, LT	E	OM3-L	12	36			3.00					X		X	1		X						INSTALL NEW SIGN AND POST AT SAME LOCATION AT SOUTHWEST END OF BRIDGE FACING SOUTH	X				
NB	MM 0.250, RT	B	OM3-L	12	36			3.00					X		X	1		X						INSTALL NEW SIGN AND POST AT SAME LOCATION AT NORTHEAST END OF BRIDGE FACING NORTH	X				
SB	MM 0.250, LT	F	OM3-R	12	36			3.00					X		X	1		X						INSTALL NEW SIGN AND POST AT SAME LOCATION AT NORTHWEST END OF BRIDGE FACING NORTH	X				
NB	MM 0.284, RT	A	R2-1	24	30			5.00								1		X						INSTALL NEW SIGN AND POST 180 FT NORTH OF THE NORTH END OF THE BRIDGE	X				
SB	MM 0.284, LT	F	RI-2	36	36								X		X									REMOVE SIGN AND POST					
		F	RI-2AP	24	18								X											REMOVE SIGN					
SB	MM 0.302, LT	F	W5-3	36	36			9.00								2		X						INSTALL NEW SIGN ON 2-POSTS 290 FT SOUTH OF POLE# 3	X				
FINAL POST LENGTHS ARE TO BE DETERMINED IN THE FIELD. POST SIZES ARE COMPUTED BASED ON INFORMATION FURNISHED ON THE STANDARD SHEETS AND THE VTRANS "SIGN POST DESIGN GUIDELINE".										EA	EA	EA	EA 10	EA	EA 9		FT	FT 195	FT		LB	LB	LB	LB	PROJECT NAME: STATEWIDE NORTHWEST REGION PROJECT NUMBER: STP HRRR(5)				
							SHEET SUBTOTALS	SF 55.89	SF	EA 10				EA 9	EA 13		FT 195		EA	LB				FILE NAME: I0K018_wrk.dgn PROJECT LEADER: JLS DESIGNED BY: NLA ENOSBURG TRAFFIC SIGN SUMMARY SHEET 2			PLOT DATE: 17-SEP-2012 11:31 DRAWN BY: ITS CHECKED BY: JLS SHEET 13 OF 51		

STATE OF VERMONT
AGENCY OF TRANSPORTATION

TRAFFIC SIGN SUMMARY SHEET 3

ENOSBURG

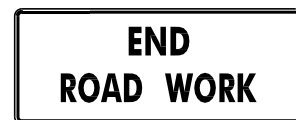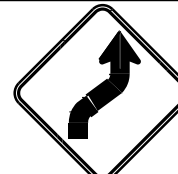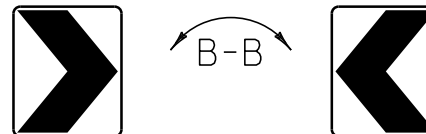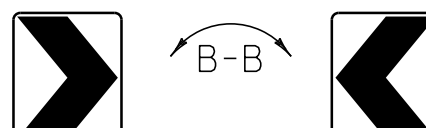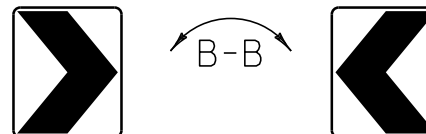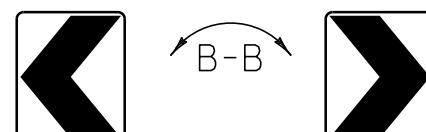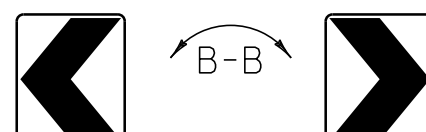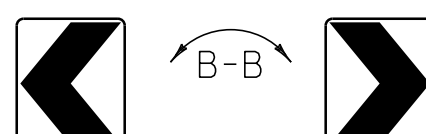DIRECTION	MILEMARKER, STATION, OR SIGN NUMBER	LOCATION	MANUAL ON UNIFORM TRAFFIC DEVICES OR STATE CODE	SIGN DIMENSIONS		SHEETING REMARKS	SIGN LEGEND	NEW SIGNS		EXISTING SIGNS				EXISTING POST		NO. OF NEW POSTS	SQUARE STEEL (in)			TUBULAR STEEL 0/(in)				SIGN FRAME REQUIRED	REMARKS SHS = STANDARD HIGHWAY SIGN BOOK	SIGN DETAIL				
				WIDTH	HEIGHT			“A”	“B”	RETAIN	SALVAGE FROM	SALVAGE TO	REMOVE	RETAIN	REMOVE		1.75	2.00	2.50	FOUNDATION	3.00	3.50	4.00			5.00	DETAIL IN SHS	DETAIL ON SHEET NUMBER	STANDARD SHEET NUMBER	
1.88	2.42	3.35																												
SB	MM 0.336, LT	F	TOWNSIGN	30	30								X		X									REMOVE SIGN AND POST						
SB		F	R2-1	24	30								X											REMOVE SIGN						
SB	MM 0.346, LT	F	RI-2	36	36								X		X									REMOVE SIGN AND POST						
		F	W2-1	30	30			6.25					X		X	1		X						INSTALL NEW SIGN ON POST 90 FT SOUTH OF POLE# 3	X					
		F	W16-8P	42	8			2.33																INSTALL NEW SIGN BENEATH INTERSECTION WARNING SIGN AT THE CORRECT SIGN HEIGHT		8				
NB	MM 0.359, RT	A	G20-2	36	18								X		X									REMOVE SIGN AND POST						
		A	W1-4R	30	30			6.25					X		X	1		X						INSTALL SIGN AND POST 21FT SOUTH OF POLE# 3	X					
SB	MM 0.363, LT	E	W1-8 R	18	24			3.00								1		X						INSTALL NEW CHEVRONS BACK-TO-BACK ON SIGN BRACKET AND SINGLE POST 185 FT SOUTH OF POLE# E/5/4A	X					
		F	W1-8 L	18	24			3.00																X						
SB	MM 0.381, LT	E	W1-8 R	18	24			3.00								1		X						INSTALL NEW CHEVRONS BACK-TO-BACK ON SIGN BRACKET AND SINGLE POST 90 FT SOUTH OF POLE# E/5/4A	X					
		F	W1-8 L	18	24			3.00																X						
NB	MM 0.398, RT	A	W1-2	30	30								X		X									REMOVE SIGN AND POST						
SB	MM 0.399, LT	E	W1-8 R	18	24			3.00								1		X						INSTALL NEW CHEVRONS BACK-TO-BACK ON SIGN BRACKET AND SINGLE POST 5 FT NORTH OF POLE# E/5/4A	X					
		F	W1-8 L	18	24			3.00																X						
SB	MM 0.404, LT	F	W20-1	36	18								X		X									REMOVE SIGN AND 2-POSTS						
NB	MM 0.444, RT	A	W1-8 L	18	24			3.00								1		X						INSTALL CHEVRONS BACK-TO-BACK ON SIGN BRACKET AND SINGLE POST 53 FT NORTH OF POLE# 45/5	X					
		B	W1-8 R	18	24			3.00																X						
NB	MM 0.461, RT	A	W1-8 L	18	24			3.00								1		X						INSTALL CHEVRONS BACK-TO-BACK ON SIGN BRACKET AND SIGNLE POST 37 FT SOUTH OF POLE# 158	X					
		B	W1-8 R	18	24			3.00																X						
NB	MM 0.478, RT	A	W1-8 L	18	24			3.00								1		X						INSTALL CHEVRONS BACK-TO-BACK ON SIGN BRACKET AND SINGLE POST 26 FT NORTH OF THE CENTER OF DRIVE# 3859	X					
		B	W1-8 R	18	24			3.00																X						
FINAL POST LENGTHS ARE TO BE DETERMINED IN THE FIELD. POST SIZES ARE COMPUTED BASED ON INFORMATION FURNISHED ON THE STANDARD SHEETS AND THE VTRANS "SIGN POST DESIGN GUIDELINE".																	FT	FT	FT		LB	LB	LB	LB	PROJECT NAME: STATEWIDE NORTHWEST REGION PROJECT NUMBER: STP HRRR(5) FILE NAME: 10k018_wrk.dgn PROJECT LEADER: JLS DESIGNED BY: NLA ENOSBURG TRAFFIC SIGN SUMMARY SHEET 3			PLOT DATE: 17-SEP-2012 11:31 DRAWN BY: ITS CHECKED BY: JLS SHEET 14 OF 51		
							SHEET SUBTOTALS	SF 50.83	SF	EA 8				EA 8		EA 8	FT 120			EA	LB									

[illegible]

STATE OF VERMONT
AGENCY OF TRANSPORTATION

TRAFFIC SIGN SUMMARY SHEET 1 - FERRISBURGH

DIRECTION	MILEMARKER, STATION, OR SIGN NUMBER	LOCATION	MANUAL ON UNIFORM TRAFFIC DEVICES OR STATE CODE	SIGN DIMENSIONS		SHEETING REMARKS	SIGN LEGEND	NEW SIGNS		EXISTING SIGNS				EXISTING POST		NO. OF NEW POSTS	SQUARE STEEL (in)			TUBULAR STEEL 0/(in)				SIGN FRAME REQUIRED	REMARKS	SIGN DETAIL			
				WIDTH	HEIGHT			“A”	“B”	RETAIN	SALVAGE FROM	SALVAGE TO	REMOVE	RETAIN	REMOVE		1.75	2.00	2.50	FOUNDATION	3.00	3.50	4.00			5.00	DETAIL IN SHS	DETAIL ON SHEET NUMBER	STANDARD SHEET NUMBER
																	lb/ft				lb/ft								
																	1.88	2.42	3.35		7.60	9.00	10.80			14.60			
EB	MM 0.014, RT	A/B	D3-I	54	12		Little Chicago Rd	4.50					X 1		X	2		X						INSTALL NEW SIGN ON 2-POSTS JUST RIGHT OF THE STOP SIGN		9			
EB	MM 0.014, RT	A	RI-I	30	30		STOP	6.25					X 2		X	1		X						REMOVE SIGN AND POST AND INSTALL NEW SIGN AND POST AT SAME LOCATION	X				
WB	MM 0.018, LT	F	VR-017	24	30		LEGAL LOAD LIMIT 24,000 POUNDS	5.00									1	X						INSTALL NEW SIGN AND POST 95 FT WEST OF US ROUTE 7 INTERSECTION WITH LITTLE CHICAGO ROAD		7			
WB	MM 0.035, LT	F	R2-I	24	30		SPEED LIMIT 35	5.00					X 1		X	1		X						GAVE TO TOWN INSTALL NEW SIGN AND POST 359 FT SOUTH OF POLE* 408/2/1	X				
		F	SI-I	36	36	F-Y-G		9.00									2	X						INSTALL NEW SIGN ON 2-POSTS 359 FT EAST OF AND ACROSS FROM POLE# 24/2/10595	X				
		F	W16-9P	24	12	F-Y-G	AHEAD	2.00															INSTALL BENEATH ADVANCE SCHOOL SYMBOL SIGN AT THE CORRECT SIGN HEIGHT	X					
WB	MM 0.067, LT	H	RI-I	30	30		STOP	6.25									1	X						INSTALL NEW SIGN AND POST 190 FT EAST OF AND ACROSS FROM POLE# 24/2/10595	X				
WB	MM 0.082, LT	F	R2-I	24	30		SPEED LIMIT 35	5.00									1	X						INSTALL NEW SIGN AND POST 111FT EAST OF AND ACROSS FROM POLE# 24/2/10595	X				
NB	MM 0.111, RT	A	W3-I	30	30		STOP AHEAD						X 1		X									REMOVE SIGN AND POST					
		A	W3-I	36	36			9.00									2	X						INSTALL NEW SIGN ON 2-POSTS 26 FT WEST POLE# 24/2/10595	X				
NB	MM 0.191, RT	A	SI-I	36	36	F-Y-G		9.00									2	X						INSTALL NEW SIGN ON 2-POSTS 10 FT WEST OF POLE# 22/10601/4	X				
		A	W16-9P	24	12	F-Y-G	AHEAD	2.00															INSTALL BENEATH ADVANCE SCHOOL SYMBOL SIGN AT THE CORRECT SIGN HEIGHT	X					
WB	MM 0.198, LT	F	W1-2Mg L	30	30			6.25									1	X						INSTALL NEW SIGN AND POST 50 FT WEST OF POLE# 22/1060 NEAR ENTRANCE TO TOWN GARAGE		9			
		F	W16-8P	24	8		Depot Rd	1.33															INSTALL BENEATH MODIFIED LEFT CURVE WARNING SIGN AT THE CORRECT SIGN HEIGHT		9				
FINAL POST LENGTHS ARE TO BE DETERMINED IN THE FIELD. POST SIZES ARE COMPUTED BASED ON INFORMATION FURNISHED ON THE STANDARD SHEETS AND THE VTRANS "SIGN POST DESIGN GUIDELINE".											EA	EA	EA	EA 4-5	EA	EA 4		FT	FT 210	FT		LB	LB	LB	LB	PROJECT NAME: STATEWIDE NORTHWEST REGION PROJECT NUMBER: STP HRRR(5)			
							SHEET SUBTOTALS		SF 65.58 70.58	SF		EA 4-5			EA 4	EA 4			FT 210		EA		LB						FILE NAME: 10k018_wrk.dgn PROJECT LEADER: JLS DESIGNED BY: NLA FERRISBURGH TRAFFIC SIGN SUMMARY SHEET 1SHEET 17 OF 51


STATE OF VERMONT
AGENCY OF TRANSPORTATION

TRAFFIC SIGN SUMMARY SHEET 2 - FERRISBURGH


DIRECTION	MILEMARKER, STATION, OR SIGN NUMBER	LOCATION	MANUAL ON UNIFORM TRAFFIC DEVICES OR STATE CODE	SIGN DIMENSIONS		SHEETING REMARKS	SIGN LEGEND	NEW SIGNS		EXISTING SIGNS				EXISTING POST		NO. OF NEW POSTS	SQUARE STEEL (in)			TUBULAR STEEL 0/(in)				SIGN FRAME REQUIRED	REMARKS SHS = STANDARD HIGHWAY SIGN BOOK	SIGN DETAIL			
				WIDTH	HEIGHT			“A”	“B”	RETAIN	SALVAGE FROM	SALVAGE TO	REMOVE	RETAIN	REMOVE		1.75 lb/ft	2.00 lb/ft	2.50 lb/ft	FOUNDATION	3.00	3.50	4.00			5.00	DETAIL IN SHS	DETAIL ON SHEET NUMBER	STANDARD SHEET NUMBER
WB	MM 0.251, LT	E/F	D3-I	30	12			2.50					X										INSTALL SIGN ABOVE STOP WITH UPDATED DESIGN		9				
		H	RI-I	30	30			6.25					X		X	I		X						REMOVE SIGN AND POST AND INSTALL NEW SIGN AND POST AT SAME LOCATION	X				
EB	MM 0.258, RT	A/B	D3-I	42	12			3.50					X										INSTALL SIGN ABOVE STOP WITH UPDATED DESIGN		9				
		A	RI-I	30	30			6.25					X		X	I		X						REMOVE SIGN AND POST AND INSTALL NEW SIGN AND POST AT SAME LOCATION	X				
WB	MM 0.301, LT	F	W10-I	30	30			4.91								I		X					INSTALL NEW SIGN AND POST 533 FT EAST OF AND ACROSS FROM POLE# 2/36 AND POLE# 111204/15/11	X					
EB	MM 0..440, RT	A	W10-I	30	30			4.91					X		X	I		X					INSTALL NEW SIGN AND POST 201FT WEST OF POLE# 2/36 AND POLE# 111204/15/11	X					
WB	MM 0.612, LT	F	OM3-R	12	36			3.00								I		X					INSTALL OBJECT MARKER AT THE EAST END OF THE BRIDGE ON THE NORTHEAST (LEFT) CORNER - 1172FT WEST OF AND ACROSS FROM POLE# 2/36 AND POLE# 111204/15/11	X					
EB	MM 0.624, RT	B	OM3-L	12	36			3.00								I		X					INSTALL OBJECT MARKER AT THE EAST END OF THE BRIDGE ON THE SOUTHEAST (RIGHT) CORNER - 1172FT WEST OF POLE# 2/36 AND POLE# 111204/15/11	X					
EB	MM 0.624, RT	B	R2-I	24	30								X		X								REMOVE SIGN AND POST						
WB	MM 0.635, LT	E	OM3-L	12	36			3.00								I		X					INSTALL OBJECT MARKER AT THE WEST END OF THE BRIDGE ON THE NORTHWEST (LEFT) CORNER - 1230 FT WEST OF AND ACROSS FROM POLE# 2/36 AND POLE# 111204/15/11	X					
EB	MM 0.643, RT	A	OM3-R	12	36			3.00								I		X					INSTALL OBJECT MARKER AT THE WEST END OF THE BRIDGE ON THE SOUTHWEST (RIGHT) CORNER - 1272 FT WEST OF POLE# 2/36 AND POLE# 111204/15/11	X					
EB	MM 0.668, RT	A	R2-I	24	30			5.00								I		X					INSTALL NEW SIGN AND POST 1404 FT WEST OF POLE# 2/36 AND POLE# 111204/15/11	X					
EB	MM 0.691, RT	A/B	D3-I	30	12			2.50					X										INSTALL SIGN ABOVE STOP WITH UPDATED DESIGN		9				
		A	RI-I	30	30			6.25					X		X	I		X					REMOVE SIGN AND POST AND INSTALL NEW SIGN AND POST AT SAME LOCATION	X					
FINAL POST LENGTHS ARE TO BE DETERMINED IN THE FIELD. POST SIZES ARE COMPUTED BASED ON INFORMATION FURNISHED ON THE STANDARD SHEETS AND THE VTRANS "SIGN POST DESIGN GUIDELINE".									EA	EA	EA	EA	EA	EA		FT	FT	FT		LB	LB	LB	LB	PROJECT NAME: STATEWIDE NORTHWEST REGION PROJECT NUMBER: STP HRRR(5) FILE NAME: 10k018_wrk.dgn PROJECT LEADER: JLS DESIGNED BY: NLA FERRISBURGH TRAFFIC SIGN SUMMARY SHEET 2SHEET 18 OF 51					
							SHEET SUBTOTALS		SF 54.07	SF	EA				EA	EA	EA	FT	FT	FT	EA	LB							

STATE OF VERMONT
AGENCY OF TRANSPORTATION


TRAFFIC SIGN SUMMARY SHEET 3 – FERRISBURGH

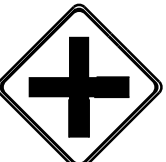DIRECTION	MILEMARKER, STATION, OR SIGN NUMBER	LOCATION	MANUAL ON UNIFORM TRAFFIC DEVICES OR STATE CODE	SIGN DIMENSIONS		SHEETING REMARKS	SIGN LEGEND	NEW SIGNS		EXISTING SIGNS				EXISTING POST		NO. OF NEW POSTS	SQUARE STEEL (in)			TUBULAR STEEL 0/(in)				SIGN FRAME REQUIRED	REMARKS SHS = STANDARD HIGHWAY SIGN BOOK	SIGN DETAIL			
				WIDTH	HEIGHT			"A"	"B"	RETAIN	SALVAGE FROM	SALVAGE TO	REMOVE	RETAIN	REMOVE		1.75 lb/ft	2.00 lb/ft	2.50 lb/ft	FOUNDATION	3.00	3.50	4.00			5.00	DETAIL IN SHS	DETAIL ON SHEET NUMBER	STANDARD SHEET NUMBER
EB	MM 0.734, RT	A	WI-10 L	36	36		9.00								2		X						INSTALL NEW SIGN ON 2-POSTS 30 FT WEST OF POLE# 4762/3/18	X					
		A	WI6-8P	30	8		1.67																INSTALL BENEATH HORIZONTAL ALIGNMENT WARNING SIGN AT THE CORRECT SIGN HEIGHT		9				
EB	MM 0.781, RT	A	R2-5A	24	30							X		X									REMOVE SIGN AND POST						
WB	MM 0.734, RT	F	W2-1	30	30		6.25								2		X						INSTALL NEW SIGN ON 2-POSTS 143 FT WEST OF POLE# 2/95	X					
		F	WI6-8AP	48	15		5.00																INSTALL BENEATH INTERSECTION WARNING SIGN AT THE CORRECT SIGN HEIGHT		9				
EB	MM 0.912, RT	A/B	D3-1	36	12		3.00						X										INSTALL SIGN ABOVE STOP WITH UPDATED DESIGN		9				
		D	RI-1	30	30		6.25						X		X	1		X					REMOVE SIGN AND POST AND INSTALL NEW SIGN AND POST AT SAME LOCATION	X					
WB	MM 0.913, LT	E/F	D3-1	36	12								X		X								REMOVE SIGN AND POST						
WB	MM 0.920, LT	E/F	D3-1	36	12		3.00																INSTALL SIGN ABOVE STOP WITH UPDATED DESIGN		9				
		H	RI-1	30	30		6.25						X		X	1		X					REMOVE SIGN AND POST AND INSTALL NEW SIGN AND POST AT SAME LOCATION	X					
EB	MM 0.981, RT	A	W2-1	30	30		6.25								2		X						INSTALL NEW SIGN ON 2-POSTS 32 FT EAST OF POLE# 103801/2/2	X					
		A	WI6-8AP	48	15		5.00																INSTALL BENEATH INTERSECTION WARNING SIGN AT THE CORRECT SIGN HEIGHT		9				
WB	MM 1.553, LT	F	W2-2 L	30	30		6.25								1		X						INSTALL NEW SIGN AND POST 30 FT EAST OF POLE# 103812/13/13	X					
		F	WI6-8P	30	8		1.67																INSTALL BENEATH SIDE ROAD WARNING SIGN AT THE CORRECT SIGN HEIGHT		9				
FINAL POST LENGTHS ARE TO BE DETERMINED IN THE FIELD. POST SIZES ARE COMPUTED BASED ON INFORMATION FURNISHED ON THE STANDARD SHEETS AND THE VTRANS "SIGN POST DESIGN GUIDELINE".										EA	EA	EA	EA 5	EA	EA 4		FT	FT 135	FT		LB	LB	LB	LB	PROJECT NAME: STATEWIDE NORTHWEST REGION PROJECT NUMBER: STP HRRR(5) FILE NAME: 10k018_wrk.dgn PROJECT LEADER: JLS DESIGNED BY: NLA FERRISBURGH TRAFFIC SIGN SUMMARY SHEET 3SHEET 19 OF 51			PLOT DATE: 17-SEP-2012 11:32 DRAWN BY: ITS CHECKED BY: JLS	
							SHEET SUBTOTALS	SF 59.59	SF	EA 5				EA 4	EA 9		FT 135		EA	LB									

TRAFFIC SIGN SUMMARY SHEET 4 – FERRISBURGH

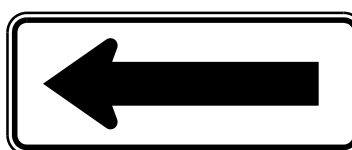DIRECTION	MILEMARKER, STATION, OR SIGN NUMBER	LOCATION	MANUAL ON UNIFORM TRAFFIC DEVICES OR STATE CODE	SIGN DIMENSIONS		SHEETING REMARKS	SIGN LEGEND	NEW SIGNS		EXISTING SIGNS				EXISTING POST		NO. OF NEW POSTS	SQUARE STEEL (in)			TUBULAR STEEL 0/(in)				SIGN FRAME REQUIRED	REMARKS	SIGN DETAIL				
				WIDTH	HEIGHT			“A”	“B”	RETAIN	SALVAGE FROM	SALVAGE TO	REMOVE	RETAIN	REMOVE		1.75	2.00	2.50	lb/ft	3.00	3.50	4.00			5.00	lb/ft	DETAIL IN SHS	DETAIL ON SHEET NUMBER	STANDARD SHEET NUMBER
1.88	2.42	3.35	FOUNDATION	7.60	9.00	10.80	14.60	SHS = STANDARD HIGHWAY SIGN BOOK																						
EB	MM 1.600, RT	A/B	D3-I	36	12			3.00					X										INSTALL SIGN ABOVE STOP WITH UPDATED DESIGN		9					
		A	RI-I	30	30			6.25					X		X	I		X					REMOVE SIGN AND POST AND INSTALL NEW SIGN AND POST AT SAME LOCATION	X						
WB	MM 1.603, LT	E/F	D3-I	30	6								X		X								REMOVE SIGN AND POST							
EB	MM 1.707, RT	A	W2-2 R	30	30			6.25								I		X					INSTALL NEW SIGN AND POST 296 FT WEST OF POLE# 103814/15/2-13/15	X						
		A	WI6-8P	30	8			1.67															INSTALL BENEATH SIDE ROAD WARNING SIGN AT THE CORRECT SIGN HEIGHT		9					
EB	MM 1.919, RT	B	WI-6 R	48	24			8.00								2		X					INSTALL NEW SIGN ON 2-POSTS 1167 FT WEST OF POLE# 103815/15-50/15 1/2 AT RIGHT ANGLES TO APPROACHING TRAFFIC	X						
EB	MM 1.928, LT	C	WI-6 L	48	24			8.00								2		X					INSTALL NEW SIGN ON 2-POSTS 1214 FT WEST OF POLE# 103815/15-50/15 1/2 AT RIGHT ANGLES TO APPROACHING TRAFFIC	X						
WB	MM 2.625, LT	F	W5-2	36	36			9.00								2		X					INSTALL NEW SIGN ON 2-POSTS 232 FT EAST OF AND ACROSS FROM POLE# 103833/31/31	X						
WB	MM 2.676, LT	F	OM3-R	12	36			3.00								I		X					INSTALL OBJECT MARKER AT THE EAST END OF THE BRIDGE ON THE NORTHEAST (LEFT) CORNER - 37 FT WEST OF AND ACROSS FROM POLE# 103833/31/31	X						
EB	MM 2.676, RT	B	OM3-L	12	36			3.00								I		X					INSTALL OBJECT MARKER AT THE EAST END OF THE BRIDGE ON THE SOUTHEAST (RIGHT) CORNER - 1172FT WEST OF POLE# 2/36 AND POLE# 111204/15/11	X						
WB	MM 2.692, LT	E	OM3-L	12	36			3.00								I		X					INSTALL OBJECT MARKER AT THE WEST END OF THE BRIDGE ON THE NORTHWEST (LEFT) CORNER - 121FT WEST OF AND ACROSS FROM POLE# 103833/31/31	X						
EB	MM 2.692, RT	A	OM3-R	12	36			3.00								I		X					INSTALL OBJECT MARKER AT THE WEST END OF THE BRIDGE ON THE SOUTHWEST (RIGHT) CORNER - 121FT WEST OF POLE# 103833/31/31	X						
WB	MM 2.625, LT	F	W5-2	36	36			9.00								2		X					INSTALL NEW SIGN ON 2-POSTS 69 FT EAST OF AND ACROSS FROM POLE# 04872/33	X						
WB	MM 3.287, LT	F	WI-2 L	30	30			6.25								I		X					INSTALL NEW SIGN AND POST 121FT WEST OF POLE# 103844/39-50/39 1/2 AND 25 FT WEST OF THE CENTER OF THE FIELD DRIVE	X						
EB	MM 3.398, RT	A	WI-2 R	30	30			6.25								I		X					INSTALL NEW SIGN AND POST 20 FT FT WEST OF POLE# 103847/41/41	X						
FINAL POST LENGTHS ARE TO BE DETERMINED IN THE FIELD. POST SIZES ARE COMPUTED BASED ON INFORMATION FURNISHED ON THE STANDARD SHEETS AND THE VTRANS "SIGN POST DESIGN GUIDELINE".											EA	EA	EA	EA	3	EA	EA	2		FT	FT	FT		LB	LB	LB	LB	PROJECT NAME: STATEWIDE NORTHWEST REGION PROJECT NUMBER: STP HRRR(5) FILE NAME: 10K018_wrk.dgn PROJECT LEADER: JLS DESIGNED BY: NLA FERRISBURGH TRAFFIC SIGN SUMMARY SHEET 4SHEET 20 OF 51		
							SHEET SUBTOTALS							SF 75.67	SF	EA 3				EA -2-	EA -16-	FT 240		EA	LB					




TRAFFIC SIGN SUMMARY SHEET 5 – FERRISBURGH

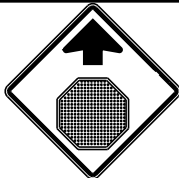DIRECTION	MILEMARKER, STATION, OR SIGN NUMBER	LOCATION	MANUAL ON UNIFORM TRAFFIC DEVICES OR STATE CODE	SIGN DIMENSIONS		SHEETING REMARKS	SIGN LEGEND	NEW SIGNS		EXISTING SIGNS				EXISTING POST		NO. OF NEW POSTS	SQUARE STEEL (in)			TUBULAR STEEL Ø/(in)				SIGN FRAME REQUIRED	REMARKS	SIGN DETAIL			
				WIDTH	HEIGHT			“A”	“B”	RETAIN	SALVAGE FROM	TO SALVAGE	REMOVE	RETAIN	REMOVE		1.75	2.00	2.50	FOUNDATION	3.00	3.50	4.00			5.00	DETAIL IN SHS	DETAIL ON SHEET NUMBER	STANDARD SHEET NUMBER
																	lb/ft				lb/ft								
WB	MM 3.474, LT	F	W3-I	36	36			9.00							2		X							INSTALL NEW SIGN ON 2- POSTS 79 FT EAST OF AND ACROSS FROM POLE# I03849/42-50/2-13/42 ½	X				
EB	MM 0.014, RT	A/B	D3-I	36	12			2.50					X											INSTALL SIGN ABOVE STOP WITH UPDATED DESIGN		9			
		G/H	D3-I	54	12			4.50					X		2		X							INSTALL NEW SIGN ON 2-POSTS JUST RIGHT OF THE STOP SIGN		9			
		F	RI-I	30	30			6.25					X		X	I	X							REMOVE SIGN AND POST AND INSTALL NEW SIGN AND POST AT SAME LOCATION	X				
FINAL POST LENGTHS ARE TO BE DETERMINED IN THE FIELD. POST SIZES ARE COMPUTED BASED ON INFORMATION FURNISHED ON THE STANDARD SHEETS AND THE VTRANS "SIGN POST DESIGN GUIDELINE".																							PROJECT NAME: STATEWIDE NORTHWEST REGION PROJECT NUMBER: STP HRRR(5) FILE NAME: I0K0I8_wrk.dgn PROJECT LEADER: JLS DESIGNED BY: NLA FERRISBURGH TRAFFIC SIGN SUMMARY SHEET 5SHEET 21 OF 51						

TRAFFIC SIGN SUMMARY SHEET 6 – FERRISBURGH




[illegible]

TRAFFIC SIGN SUMMARY SHEET 1 - NEW HAVEN

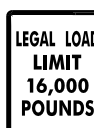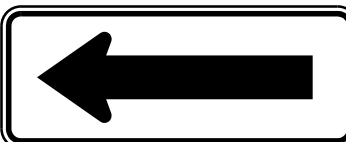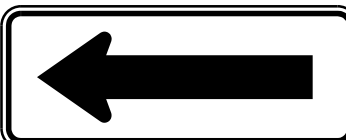DIRECTION	MILEMARKER, STATION, OR SIGN NUMBER	LOCATION	MANUAL ON UNIFORM TRAFFIC DEVICES OR STATE CODE	SIGN DIMENSIONS		SHEETING REMARKS	SIGN LEGEND	NEW SIGNS		EXISTING SIGNS				EXISTING POST		NO. OF NEW POSTS	SQUARE STEEL (in)			TUBULAR STEEL 0/(in)				SIGN FRAME REQUIRED	REMARKS	SIGN DETAIL			
				WIDTH	HEIGHT			A	B	RETAIN	SALVAGE FROM	SALVAGE TO	REMOVE	RETAIN	REMOVE		1.75	2.00	2.50	FOUNDATION	3.00	3.50	4.00			5.00	DETAIL IN SHS	DETAIL ON SHEET NUMBER	STANDARD SHEET NUMBER
SHS = STANDARD HIGHWAY SIGN BOOK																													
NB	MM 0.016, RT	B	OM3-L	12	36					X				X										RETAIN SIGN AND POST					
SB	MM 0.016, LT	F	TOWN SIGN	30	36								X		X									REMOVE SIGN AND POST					
		F	OM3-R	12	30					X					X	I		X						RETAIN SIGN SIDE UP TO CORRECT HEIGHT					
SB	MM 0.016, LT	F	WI-8 L	18	24								X		X									REMOVE SIGN AND POST					
		F	VR-017	24	30			5.00								I		X						INSTALL NEW SIGN AND POST AT THE SAME LOCATION AS REVIOUSLY REMOVED CHEVRON SIGN ASSEMBLY		7			
SB	MM 0.021, LT TO MM 0.080, LT	E/F		6	8		(20) TYPE II - 6" X 8" WHITE DELINEATORS	6.67								10	X							INSTALLED BACK-TO-BACK AT 35 FT± SPACING BEGINNING 26 FT NORTH OF LEFT BRIDGE CORNER TYPE 3 OBJECT MARKER BLOCKING OFF PULL-OFF AND D.J.		7			
NB	MM 0.020, RT TO MM 0.041, RT	A/B		6	8		(8) TYPE II - 6" X 8" WHITE DELINEATORS	2.67								4	X							INSTALLED BACK-TO-BACK AT 35 FT± SPACING BEGINNING 21FT± NORTH OF RIGHT BRIDGE CORNER TYPE 3 OBJECT MARKER,INSTALL BEHIND GUARDRAIL		7			
SB	MM 0.028, LT	F	WI-6 L	48	24			8.00								2		X						INSTALL NEW SIGN ON 2-POSTS 63 FT NORTH OF LEFT BRIDGE CORNER - AT RIGHT ANGLE TO APPROACHING TRAFFIC	X				
SB	MM 0.035, LT	F	RI-2	36	36			3.89								1		X						INSTALL NEW SIGN AND POST 132 FT NORTH OF LEFT BRIDGE CORNER - TYPE 3 OBJECT MARKER	X				
		F	RI-2A	24	18			3.00										X						INSTALL BENEATH YIELD SIGN AT THE CORRECT SIGN HEIGHT	X				
NB	MM 0.041, RT	A	R2-1	24	30					X				X										RETAIN SIGN AND POST					
NB	MM 0.065, RT	C	WI-6 R	48	24									X		X								REMOVE SIGN AND POSTS					
NB	MM 0.072, RT	B	WI-6 R	48	24			8.00								2		X						INSTALL NEW SIGN ON 2-POSTS 296 FT NORTH OF RIGHT BRIDGE CORNER AND 32 FT NORTH OF PVT DRIVE JUST NORTH OF PULL-OFF	X				
NB	MM 0.073, RT	C	WI-6 L	48	24			8.00								2		X						INSTALL NEW SIGN ON 2-POSTS 301FT NORTH OF RIGHT BRIDGE CORNER AND 37 FT NORTH OF PVT DRIVE JUST NORTH OF PULL-OFF	X				
SB	MM 0.080, LT	F	W3-2A	36	36			9.00								2		X						INSTALL NEW SIGN AND POST 338 FT NORTH OF LEFT BRIDGE CORNER - 74 NORTH OF AND ACROSS FROM PVT DRIVE	X				
FINAL POST LENGTHS ARE TO BE DETERMINED IN THE FIELD. POST SIZES ARE COMPUTED BASED ON INFORMATION FURNISHED ON THE STANDARD SHEETS AND THE VTRANS "SIGN POST DESIGN GUIDELINE".											EA 3	EA	EA	EA 3	EA 2	EA 4		FT 112	FT 165	FT		LB	LB	LB	LB	PROJECT NAME: STATEWIDE NORTHWEST REGION PROJECT NUMBER: STP HRRR(5) FILE NAME: 10K018_wrk.dgn PROJECT LEADER: JLS DESIGNED BY: NLA NEW HAVEN TRAFFIC SIGN SUMMARY SHEET I SHEET 23 OF 51			
							SHEET SUBTOTALS							SF 54.23	SF	EA 6				EA -6	EA -25	FT 277			EA				LB




STATE OF VERMONT
AGENCY OF TRANSPORTATION


TRAFFIC SIGN SUMMARY SHEET 2 - NEW HAVEN

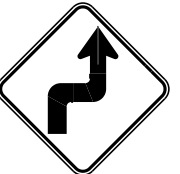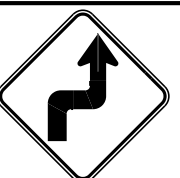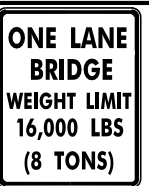DIRECTION	MILEMARKER, STATION, OR SIGN NUMBER	LOCATION	MANUAL ON UNIFORM TRAFFIC DEVICES OR STATE CODE	SIGN DIMENSIONS		SHEETING REMARKS	SIGN LEGEND	NEW SIGNS		EXISTING SIGNS				EXISTING POST		NO. OF NEW POSTS	SQUARE STEEL (in)			TUBULAR STEEL 0/(in)				SIGN FRAME REQUIRED	REMARKS SHS = STANDARD HIGHWAY SIGN BOOK	SIGN DETAIL			
				WIDTH	HEIGHT			"A"	"B"	RETAIN	SALVAGE FROM	SALVAGE TO	REMOVE	RETAIN	REMOVE		1.75 lb/ft	2.00 lb/ft	2.50 lb/ft	FOUNDATION	3.00	3.50	4.00			5.00	DETAIL IN SHS	DETAIL ON SHEET NUMBER	STANDARD SHEET NUMBER
SB	MM 0.118, LT	F	W5-3	36	36			9.00					X		X	2		X						INSTALL NEW SIGN ON 2-POSTS 200 FT NORTH OF NEWLY INSTALLED YIELD AHEAD SIGN ASSEMBLY	X				
		F	TOWN SIGN	24	30								X											REMOVE SIGN					
SB	MM 0.156, LT	F	WI-3 R	30	30			6.25								I		X						INSTALL NEW SIGN AND POST 200 FT NORTH OF NEWLY INSTALLED "ONE LANE BRIDGE" ASSEMBLY	X				
		F	WI3-IP	18	18			2.25																INSTALL BENEATH CURVE WARNING SIGN AT THE CORRECT SIGN HEIGHT	X				
NB	MM 0.170, RT TO MM 0.210, RT	A/B		6	8		(8) TYPE II - 6" X 8" WHITE DELINEATORS	2.67								4	X							INSTALLED BACK-TO-BACK AT 70 FT± SPACING BEGINING 1679 FT SOUTH THE CENTER OF TWITCHELL HILL ROAD INTERSECTION		7			
SB	MM 0.170, LT TO MM 0.210, LT	E/F		6	8		(8) TYPE II - 6" X 8" WHITE DELINEATORS	2.67								4	X							INSTALLED BACK-TO-BACK AT 70 FT± SPACING BEGINING 1679 FT SOUTH OF THE CENTER OF TWITCHELL HILL RD INTERSECTION		7			
SB	MM 0.283, LT	F	WI-3 R	30	30								X		X									REMOVE SIGN AND POST					
		F	WI3-IP	18	18								X											REMOVE SIGN PLAQUE					
SB	MM 0.283, LT	F	WI-8R	18	24								X		X									REMOVE SIGN AND POST					
SB	MM 0.436, LT	F	W5-3	36	36			9.00								2		X						INSTALL NEW SIGN ON 2-POSTS 275 FT SOUTH OF THE CENTER OF THE TWITCHELL HILL ROAD INTERSECTION	X				
		F	WI6-3AP	30	12			2.50																INSTALL BENEATH ONE LANE BRIDGE SIGN AT THE CORRECT SIGN HEIGHT	X				
SB	MM 0.478, LT	F	R2-I	24	30		 RESET 10-21-11	5.00					X		X	I		X						INSTALL NEW SIGN AND POST 75 FT SOUTH OF THE CENTER OF THE TWITCHELL HILL ROAD INTERSECTION	X				
		F	TOWN SIGN	30	36								X											REMOVE SIGN					
SB	MM 0.482, LT	H	RI-I	30	30			6.25					X		X	I		X						REMOVE SIGN AND POST INSTALL NEW SIGN AND POST AT SAME LOCATION	X				
NB	MM 0.513, RT	A	R2-I	24	30			5.00					X		X	I		X						INSTALL NEW SIGN AND POST 1236 FT SOUTH OF POLE# 408/2/1	X				
FINAL POST LENGTHS ARE TO BE DETERMINED IN THE FIELD. POST SIZES ARE COMPUTED BASED ON INFORMATION FURNISHED ON THE STANDARD SHEETS AND THE VTRANS "SIGN POST DESIGN GUIDELINE".										EA	EA	EA	EA	EA	EA		FT 64	FT 120	FT		LB	LB	LB	LB	PROJECT NAME: STATEWIDE NORTHWEST REGION PROJECT NUMBER: STP HRRR(5)				
							SHEET SUBTOTALS	SF 50.59	SF	EA 9			EA 6	EA 6	EA 6		FT 184		EA	LB									


STATE OF VERMONT
AGENCY OF TRANSPORTATION

TRAFFIC SIGN SUMMARY SHEET 3 - NEW HAVEN

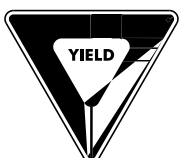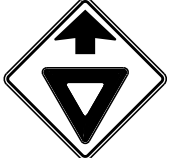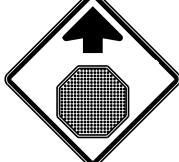
DIRECTION	MILEMARKER, STATION, OR SIGN NUMBER	LOCATION	MANUAL ON UNIFORM TRAFFIC DEVICES OR STATE CODE	SIGN DIMENSIONS		SHEETING REMARKS	SIGN LEGEND	NEW SIGNS		EXISTING SIGNS				EXISTING POST		NO. OF NEW POSTS	SQUARE STEEL (in)			TUBULAR STEEL 0/(in)				SIGN FRAME REQUIRED	REMARKS SHS = STANDARD HIGHWAY SIGN BOOK	SIGN DETAIL			
				WIDTH	HEIGHT			“A”	“B”	RETAIN	SALVAGE FROM	SALVAGE TO	REMOVE	RETAIN	REMOVE		1.75 lb/ft	2.00 lb/ft	2.50 lb/ft	FOUNDATION	3.00	3.50	4.00			5.00	DETAIL IN SHS	DETAIL ON SHEET NUMBER	STANDARD SHEET NUMBER
NB	MM 0.513, RT	A	W2-2 R	30	30		6.25					X		X	1		X						INSTALL NEW SIGN AND POST 1236 FT SOUTH OF POLE* 408/2/1	X					
		A	W16-8P	36	8		2.00																INSTALL BENEATH SIDE ROAD WARNING SIGN AT THE CORRECT SIGN HEIGHT		8				
SB	MM 0791, LT	F	R2-1	24	30		5.00					X		X	1		X						INSTALL NEW SIGN AND POST 1236 FT SOUTH OF POLE* 408/2/1	X					
SB	0.837, LT	G	W1-7	48	24		8.00								2		X						INSTALL NEW SIGN ON 2-POSTS DIRECTLY ACROSS FROM THE INTERSECTION WITH CAMPGROUND ROAD	X					
NB	MM 0.862, RT	A	R2-1	24	30		5.00					X		X	1		X						INSTALL NEW SIGN AND POST 364 FT SOUTH OF POLE* 4/34	X					
SB	MM 0.903, LT	F	W2-2 L	30	30		6.25					X		X	1		X						INSTALL NEW SIGN AND POST 148 FT SOUTH OF AND ACROSS FROM POLE* 4/34	X					
		F	W16-8P	36	8		2.00																INSTALL BENEATH SIDE ROAD WARNING SIGN AT THE CORRECT SIGN HEIGHT		8				
							CAMPGROUND ROAD																						
EB	STA 0+15, RT	A					EMPTY POST							X									REMOVE POST						
EB	STA 0+52, RT	A					EMPTY POST							X									REMOVE POST						
WB	STA 0+79, LT	F	R1-2	36	36		3.89								1		X						INSTALL NEW SIGN ON 2-POSTS 224 FT WEST OF AND ACROSS FROM POLE* 3	X					
EB	STA 1+08, RT	A	R2-1	24	30		5.00					X		X	1		X						INSTALL NEW SIGN AND POST 195 FT WEST OF POLE* 3	X					
WB	STA 4+40, LT	F	W3-2A	36	36		9.00								2		X						INSTALL NEW SIGN ON 2-POSTS 137 FT EAST OF AND ACROSS FROM POLE* 3	X					
							TWITCHELL HILL ROAD																						
WB	STA 0+99, LTT	A	R2-1	24	30		5.00					X		X	1		X						INSTALL NEW SIGN AND POST 99 FT WEST OF THE PEARSON RD INTERSECTION WITH TWITCHELL HILL RD	X					
EB	STA 3+62, RT	A	W3-1	36	36		9.00								2		X						INSTALL NEW SIGN ON 2- POSTS 362 FT WEST OF THE INTERSECTION OF PEARSON RD ON THE SOUTH (RIGHT) SIDE OF TWITCHELL HILL RD	X					
FINAL POST LENGTHS ARE TO BE DETERMINED IN THE FIELD. POST SIZES ARE COMPUTED BASED ON INFORMATION FURNISHED ON THE STANDARD SHEETS AND THE VTRANS DIVISION'S "SIGN POST DESIGN GUIDELINE."									EA	EA	EA	EA	EA	EA		FT	FT	FT		LB	LB	LB	LB	PROJECT NAME: STATEWIDE NORTHWEST REGION					
							SHEET SUBTOTALS			SF 66.39	SF	EA 6-7			EA 8-8	EA 13-13	FT 195	EA	LB			PROJECT NUMBER: STP HRRR(5)							
									EA 6-7			EA 8-8	EA 13-13	FT 195	EA	LB			FILE NAME: 10k018_wrk.dgn			PLOT DATE: 17-SEP-2012 11:32							
									EA 6-7			EA 8-8	EA 13-13	FT 195	EA	LB			PROJECT LEADER: JLS			DRAWN BY: ITS							
									EA 6-7			EA 8-8	EA 13-13	FT 195	EA	LB			DESIGNED BY: NLA			CHECKED BY: JLS							
									EA 6-7			EA 8-8	EA 13-13	FT 195	EA	LB			NEW HAVEN TRAFFIC SIGN SUMMARY SHEET 3 SHEET 25 OF 51										

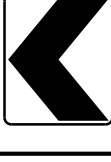STATE OF VERMONT AGENCY OF TRANSPORTATION				TRAFFIC SIGN SUMMARY SHEET 1 - NORTHFIELD																									
DIRECTION	MILEMARKER, STATION, OR SIGN NUMBER	LOCATION	MANUAL ON UNIFORM TRAFFIC DEVICES OR STATE CODE	SIGN DIMENSIONS		SHEETING REMARKS	SIGN LEGEND	NEW SIGNS		EXISTING SIGNS				EXISTING POST		NO. OF NEW POSTS	SQUARE STEEL (in)			TUBULAR STEEL 0/(in)				SIGN FRAME REQUIRED	REMARKS SHS = STANDARD HIGHWAY SIGN BOOK	SIGN DETAIL			
				WIDTH	HEIGHT			"A"	"B"	RETAIN	SALVAGE FROM	SALVAGE TO	REMOVE	RETAIN	REMOVE		1.75	2.00	2.50	FOUNDATION	3.00	3.50	4.00			5.00	DETAIL IN SHS	DETAIL ON SHEET NUMBER	STANDARD SHEET NUMBER
																	lb/ft				lb/ft								
																	1.88	2.42	3.35		7.60	9.00	10.80			14.60			
NB	MM 0.000, RT	A	WI-2R	30	30			6.25							I		X							INSTALL NEW SIGN AND POST ACROSS FROM POLE #29	X				
NB	MM 0.0295, RT	A	VW-054	30	30			6.25							I		X							INSTALL NEW SIGN AND POST 182 FT SOUTH OF THE CENTER OF THE DRIVE AT HOUSE# 552 UNION BROOK RD		8			
SB	MM 0.030, LT	H	RI-1	30	30			6.25					X		X	I		X						REMOVE SIGN AND POST AND INSTALL NEW SIGN AND POST AT SAME LOCATION	X				
SB	MM 0.039, LT	F	D3-1	54	12			4.50					X		X	2		X						INSTALL NEW SIGN ON 2-POSTS 48 FT SOUTH OF STOP SIGN ACROSS THE ROAD HOCKMAN HILL ROAD		8			
NB	MM 0.039, RT	A	VW-054	30	30								X		X									REMOVE SIGN AND POST					
SB	MM 0.043, LT	E	WI-8 R	18	24		 B-B 	3.00							I		X							INSTALL NEW CHEVRONS BACK-TO-BACK ON SIGN BRACKET AND SINGLE POST 58 FT NORTH FROM THE CENTER OF HOCKMAN HILL RD	X				
		F	WI-8 L	18	24			3.00																X					
SB	MM 0.053, LT	E	WI-8 R	12	18		 B-B 						X		X									REMOVE SIGN AND POSTS					
		F	WI-8 L	12	18							X																	
SB	MM 0.058, LT	E	WI-8 R	18	24		 B-B 	3.00							I		X							INSTALL NEW CHEVRONS BACK-TO-BACK ON SIGN BRACKET ON A SINGLE POST 80 FT NORTH OF NEW CHEVRON AT MM 0.043	X				
		F	WI-8 L	18	24			3.00																X					
SB	MM 0.063, LT	E	WI-8 R	12	18		 B-B 						X		X									REMOVE SIGN AND POST					
		F	WI-8 L	12	18							X																	
SB	MM 0.073, LT	E	WI-8 R	18	24		 B-B 	3.00					X		X	I		X						INSTALL NEW CHEVRONS BACK-TO-BACK ON SIGN BRACKET AND A SINGLE POST 80 FT NORTH OF NEW CHEVRON AT MM 0.058.	X				
		F	WI-8 L	18	24			3.00					X											X					
SB	MM 0.083, LT	F	S3-1	30	30	F-Y-G		6.25					X		X	I		X						INSTALL NEW SIGN AT EXISTING LOCATION 68 FT SOUTH OF POLE# 31	X				
NB	MM 0.095, RT	F	R2-1	24	30			5.00					X		X	I		X						INSTALL NEW SIGN AND POST 5 FT SOUTH OF POLE# 31	X				
SB	MM 0.098, LT	A	WI-2	30	30								X		X									REMOVE SIGN AND POST					
SB	MM 0.098, LT	F	WI-10L	36	36			9.00								2		X						INSTALL NEW SIGN ON 2-POSTS 10 FT NORTH OF POLE# 31	X				
SB		F	WI6-8P	42	8			2.33																INSTALL BENEATH HORIZONTAL ALIGNMENT WITH SIDE ROAD WARNING SIGN AT CORRECT SIGN HEIGHT		8			
FINAL POST LENGTHS ARE TO BE DETERMINED IN THE FIELD. POST SIZES ARE COMPUTED BASED ON INFORMATION FURNISHED ON THE STANDARD SHEETS AND THE VTRANS "SIGN POST DESIGN GUIDELINE".										EA	EA	EA	EA	EA	EA		FT	FT	FT		LB	LB	LB	LB	PROJECT NAME: STATEWIDE NORTHWEST REGION PROJECT NUMBER: STP HRRR(5) FILE NAME: I0k018_wrk.dgn PROJECT LEADER: JLS DESIGNED BY: NLA NORTHFIELD TRAFFIC SIGN SUMMARY SHEET 1 SHEET 27 OF 51			PLOT DATE: 17-SEP-2012 11:32 DRAWN BY: ITS CHECKED BY: JLS	
							SHEET SUBTOTALS				SF 63.83	SF	EA 12			EA 9	EA 12	FT 180	EA	LB									

TRAFFIC SIGN SUMMARY SHEET 2 - NORTHFIELD

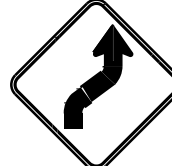DIRECTION	MILEMARKER, STATION, OR SIGN NUMBER	LOCATION	MANUAL ON UNIFORM TRAFFIC DEVICES OR STATE CODE	SIGN DIMENSIONS		SHEETING REMARKS	SIGN LEGEND	NEW SIGNS		EXISTING SIGNS				EXISTING POST		NO. OF NEW POSTS	SQUARE STEEL (in)			TUBULAR STEEL 0/(in)				SIGN FRAME REQUIRED	REMARKS SHS = STANDARD HIGHWAY SIGN BOOK	SIGN DETAIL			
				WIDTH	HEIGHT			“A”	“B”	RETAIN	SALVAGE FROM	SALVAGE TO	REMOVE	RETAIN	REMOVE		1.75 lb/ft	2.00 lb/ft	2.50 lb/ft	FOUNDATION	3.00 lb/ft	3.50 lb/ft	4.00 lb/ft			5.00 lb/ft	DETAIL IN SHS	DETAIL ON SHEET NUMBER	STANDARD SHEET NUMBER
NB	MM 1.204, RT	A	TOWN SIGN	30	30								X		X								REMOVE SIGN AND POST						
NB	MM 1.204, RT	A	VW-054	30	30			6.25								I		X						INSTALL NEW SIGN AND POST 53 FT SOUTH OF POLE# 63/87		8			
NB	MM 1.412, RT	A	WI-4R	30	30			6.25								I		X						INSTALL BENEATH THE WI-4 SIGN WITH THE BOTTOM OF THE SIGN AT LEAST 4 FT ABOVE THE ROAD SURFACE.	X				
SB	MM 1.428, RT	A F		6	8		(2) TYPE II - 6" X 8" WHITE DELINEATORS	0.667								I	X							INSTALL DELINEATORS BACK-TO-BACK 350 SOUTH OF POLE #73		7			
SB	MM 1.438, RT	A F		6	8		(2) TYPE II - 6" X 8" WHITE DELINEATORS	0.667								I	X							INSTALL DELINEATORS BACK-TO-BACK 300 SOUTH OF POLE #73		7			
SB	MM 1.447, RT	A F		6	8		(2) TYPE II - 6" X 8" WHITE DELINEATORS	0.667								I	X							INSTALL DELINEATORS BACK-TO-BACK 250 SOUTH OF POLE #73		7			
SB	MM 1.457, RT	A F		6	8		(2) TYPE II - 6" X 8" WHITE DELINEATORS	0.667								I	X							INSTALL DELINEATORS BACK-TO-BACK 200 SOUTH OF POLE #73		7			
SB	MM 1.466, RT	A F		6	8		(2) TYPE II - 6" X 8" WHITE DELINEATORS	0.667								I	X							INSTALL DELINEATORS BACK-TO-BACK 150 SOUTH OF POLE #73		7			
SB	MM 1.476, RT	A F		6	8		(2) TYPE II - 6" X 8" WHITE DELINEATORS	0.667								I	X							INSTALL DELINEATORS BACK-TO-BACK 100 SOUTH OF POLE #73		7			
SB	MM 1.485, RT	A F		6	8		(2) TYPE II - 6" X 8" WHITE DELINEATORS	0.667								I	X							INSTALL DELINEATORS BACK-TO-BACK 50 SOUTH OF POLE #73		7			
SB	MM 1.498, LT	F	WI-2L					6.25								I		X						INSTALL 20 FT NORTH OF POLE #73	X				
FINAL POST LENGTHS ARE TO BE DETERMINED IN THE FIELD. POST SIZES ARE COMPUTED BASED ON INFORMATION FURNISHED ON THE STANDARD SHEETS AND THE VTRANS "SIGN POST DESIGN GUIDELINE".										EA	EA	EA	EA	EA	EA		FT 56	FT 45	FT		LB	LB	LB	LB	PROJECT NAME: STATEWIDE NORTHWEST REGION PROJECT NUMBER: STP HRRR(5) FILE NAME: I0K0I8_wrk.dgn PROJECT LEADER: JLS DESIGNED BY: NLA NORTHFIELD TRAFFIC SIGN SUMMARY SHEET 2 SHEET 28 OF 51				
							SHEET SUBTOTALS				SF 23.42	SF	EA I				EA +	EA +	FT 101	EA	LB								

DIRECTION	MILEMARKER, STATION, OR SIGN NUMBER	LOCATION	MANUAL ON UNIFORM TRAFFIC DEVICES OR STATE CODE	SIGN DIMENSIONS		SHEETING REMARKS	SIGN LEGEND	NEW SIGNS		EXISTING SIGNS				EXISTING POST		NO. OF NEW POSTS	SQUARE STEEL (in)			TUBULAR STEEL 0/(in)				SIGN FRAME REQUIRED	REMARKS	SIGN DETAIL				
				WIDTH	HEIGHT			A	B	RETAIN	SALVAGE FROM	SALVAGE TO	REMOVE	RETAIN	REMOVE		1.75	2.00 lb/ft	2.50	FOUNDATION	3.00	3.50	4.00			5.00	DETAIL IN SHS	DETAIL ON SHEET NUMBER	STANDARD SHEET NUMBER	
SHS = STANDARD HIGHWAY SIGN BOOK																														
SB	MM 0.189, LT	F	VWI-IMcR	36	36			9.00							2		X							INSTALL NEW SIGN AND POSTS 175 FT NORTH OF THE COCHRAN RD INTERSECTION		II				
		F	WI6-8aP	48	15			5.00																INSTALL NEW SIGN BELOW THE NEW TURN/INTERSECTION SIGN		IO				
SB	MM 0.203, LT	F	WI-6	48	24								X		X									REMOVE SIGN AND 2-POSTS	X					
		F	DI-I	36	6								X											REMOVE SIGN						
		F	DI-I	36	6								X											REMOVE SIGN						
NB	MM 0.203, RT	C	WI-6	48	24			8.00							2		X							INSTALL NEW SIGN ON 2-POSTS ON THE LEFT HAND SIDE OF BRIDGE ST NEAR THE STOP SIGN, INSTALL IN LINE WITH THE NORTHBOUND DRIVERS' LINE OF SIGHT	X					
NB	MM 0.222, RT	D	RI-I	30	30			6.25					X		X	I		X						REMOVE STOP SIGN AND POST AND INSTALL NEW SIGN AND POST AT SAME LOCATION (COCHRAN RD)	X					
SB	MM 0.222, LT	F	WII-2	30	30					X			X											RETAIN PEDESTRIAN SIGN AND POST						
		F	WI6-7P	24	12					X			X											RETAIN DOWN ARROW						
NB	MM 0.222, RT	A	RI-I	30	30			6.25					X		X	I		X						REMOVE STOP SIGN AND POST AND INSTALL NEW SIGN AND POST AT SAME LOCATION (THOMPSON RD)	X					
		C/D	D3-I	36	12			3.00							I		X							INSTALL NEW COCHRAN ST STREET NAME SIGN AND POST NEXT TO THE NEW STOP SIGN ON THOMPSON ROAD. INSTALL SIGN ABOVE THE NEW THOMPSON RD STREET NAME SIGN		IO				
		A/B	D3-I	42	12			3.50																INSTALL NEW THOMPSON ST STREET NAME SIGN BELOW THE NEW COCHRAN STREET NAME SIGN		IO				
SB	MM 0.222, LT	E/F	D3-I	30	12			2.50					X		X	I		X						INSTALL NEW SIGN AND POST NEXT TO THE PEDESTRIAN SIGN ASSEMBLY, INSTALL SIGN ABOVE THE HUNTINGTON RD STREET NAME SIGN ON THE SAME POST		IO				
		G/H	D3-I	48	12			4.00					X											INSTALL NEW HUNTINGTON RD STREET NAME SIGN BENEATH THE BRIDGE ST STREET NAME SIGN ON THE SAME POST		IO				
NB	MM 0.223, RT	C	WI-6	48	24			8.00							2		X							INSTALL NEW SIGN ON 2-POSTS DIRECTLY ACROSS THE ROAD FROM THE PREVIOUSLY REMOVED LARGE ARROW SIGN ASSEMBLY	X					
FINAL POST LENGTHS ARE TO BE DETERMINED IN THE FIELD. POST SIZES ARE COMPUTED BASED ON INFORMATION FURNISHED ON THE STANDARD SHEETS AND THE VTRANS "SIGN POST DESIGN GUIDELINE".											EA 2	EA	EA	EA 7	EA 2	EA 4		FT 150	FT		LB	LB	LB	LB	PROJECT NAME: STATEWIDE NORTHWEST REGION PROJECT NUMBER: STP HRRR(5) FILE NAME: I0K0I8_wrk.dgn PROJECT LEADER: JLS DESIGNED BY: NLA RICHMOND TRAFFIC SIGN SUMMARY SHEET I			PLOT DATE: 17-SEP-2012 11:32 DRAWN BY: ITS CHECKED BY: JLS SHEET 30 OF 51		
							SHEET SUBTOTALS							SF 55.50	SF	EA 9-7				EA 6	EA 10	FT 150		EA						

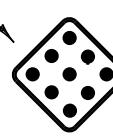STATE OF VERMONT AGENCY OF TRANSPORTATION				TRAFFIC SIGN SUMMARY SHEET 3 – RICHMOND																										
DIRECTION	MILEMARKER, STATION, OR SIGN NUMBER	LOCATION	MANUAL ON UNIFORM TRAFFIC DEVICES OR STATE CODE	SIGN DIMENSIONS		SHEETING REMARKS	SIGN LEGEND	NEW SIGNS		EXISTING SIGNS				EXISTING POST		NO. OF NEW POSTS	SQUARE STEEL (in)			TUBULAR STEEL 0/(in)				SIGN FRAME REQUIRED	REMARKS SHS = STANDARD HIGHWAY SIGN BOOK	SIGN DETAIL				
				WIDTH	HEIGHT			"A"	"B"	RETAIN	SALVAGE FROM	SALVAGE TO	REMOVE	RETAIN	REMOVE		1.75 lb/ft	2.00 lb/ft	2.50 lb/ft	FOUNDATION	3.00	3.50	4.00			5.00	DETAIL IN SHS	DETAIL ON SHEET NUMBER	STANDARD SHEET NUMBER	
SB	MM 0.612, LT	F	WI-3R	30	30			6.25					X		X	I		X							INSTALL NEW SIGN AND POST 5 FT SOUTH OF AND ACROSS FROM POLE# 1	X				
		F	TOWN SIGN	24	24								X												REMOVE SIGN					
		F	WI3-IP	18	18			2.25																	INSTALL NEW SIGN BENEATH REVERSE TURN WARNING SIGN AT THE CORRECT SIGN HEIGHT	X				
NB	MM 0.630, RT	A B	WI-8 R WI-8 L	18 18	24 24		 B-B 	3.00 3.00								I		X							INSTALL NEW CHEVRONS BACK-TO-BACK ON SIGN BRACKET ON A SINGLE POST 246 FT NORTH OF POLE# 11550	X X				
NB	MM 0.650, RT	A B	WI-8 R WI-8 L	18 18	24 24		 B-B 	3.00 3.00								I		X							INSTALL NEW CHEVRONS BACK-TO-BACK ON A SIGN BRACKET ON A SINGLE POST 146 FT NORTH OF POLE# 11550	X X				
NB	MM 0.678, RT	A	WII-2	30	30								X		X										REMOVE SIGN AND POST					
		A	TOWN SIGN	30	15								X												REMOVE SIGN					
SB	MM 0.698, LT	F	WI-2L	30	30								X		X										REMOVE SIGN AND POST					
		F	WI-IL	30	30			6.25								I		X							INSTALL NEW SIGN AND POST 100 FT SOUTH AND OPPOSITE OF POLE# 11550	X				
SB	MM 0.737, LT	E	WI-8 R	18	24								X		X										REMOVE SIGN AND POST					
		E	OM-I	18	18								X		X										REMOVE SIGN AND POST					
SB	MM 0.737, LT	F E	WI-8 L WI-8 R	18 18	24 24	F-Y	 B-B 	3.00 3.00								I		X							INSTALL NEW CHEVRONS BACK-TO-BACK ON A SIGN BRACKET ON A SINGLE POST 206 FT SOUTH OF NEWLY INSTALLED CURVE LEFT WARNING SIGN - SAME LOCATION A REMOVED SINGLE CHEVRON SIGN ASSEMBLY	X X				
SB	MM 0.758, LT	F E	WI-8 L WI-8 R	18 18	24 24	F-Y	 B-B 	3.00 3.00					X X		X	I		X							INSTALL NEW CHEVRONS BACK-TO-BACK ON A SINGLE POST 111FT SOUTH OF PREVIOUSLY INSTALLED CHEVRON ASSEMBLY - SAME LOCATION AS REMOVED ASSEMBLY	X X				
SB	MM 0.758, LT	F E	OM-I OM-I	18 18	18 18		 B-B 						X X		X										REMOVE SIGN AND POST					
SB	MM 0.781, LT	F E	WI-8 L WI-8 R	18 18	24 24	F-Y	 B-B 	3.00 3.00					X X		X	I		X							INSTALL NEW CHEVRONS BACK-TO-BACK ON A SINGLE POST 121FT SOUTH OF PREVIOUSLY INSTALLED CHEVRON ASSEMBLY - SAME LOCATION AS REMOVED ASSEMBLY	X X				
SB	MM 0.804, LT	F	WI-8 L	18	24								X		X										REMOVE SIGN AND POST					
FINAL POST LENGTHS ARE TO BE DETERMINED IN THE FIELD. POST SIZES ARE COMPUTED BASED ON INFORMATION FURNISHED ON THE STANDARD SHEETS AND THE VTRANS "SIGN POST DESIGN GUIDELINE".										EA	EA	EA	EA	EA	EA		FT	FT	FT		LB	LB	LB	LB	PROJECT NAME: STATEWIDE NORTHWEST REGION					
							SHEET SUBTOTALS			SF 44.75	SF	EA 14 15			EA 9	EA 7	FT 105	EA	LB	PROJECT NUMBER: STP HRRR(5)			FILE NAME: 10k018_wrk.dgn			PLOT DATE: 17-SEP-2012 11:33				
										EA	EA	EA	EA	EA	EA		FT	FT	FT		LB	LB	LB	LB	PROJECT LEADER: JLS			DRAWN BY: ITS		
										EA	EA	EA	EA	EA	EA		FT	FT	FT		LB	LB	LB	LB	DESIGNED BY: NLA			CHECKED BY: JLS		
										EA	EA	EA	EA	EA	EA		FT	FT	FT		LB	LB	LB	LB	RICHMOND TRAFFIC SIGN SUMMARY SHEET 3			SHEET 32 OF 51		

STATE OF VERMONT
AGENCY OF TRANSPORTATION


TRAFFIC SIGN SUMMARY SHEET 4 – RICHMOND

DIRECTION	MILEMARKER, STATION, OR SIGN NUMBER	LOCATION	MANUAL ON UNIFORM TRAFFIC DEVICES OR STATE CODE	SIGN DIMENSIONS		SHEETING REMARKS	SIGN LEGEND	NEW SIGNS		EXISTING SIGNS				EXISTING POST		NO. OF NEW POSTS	SQUARE STEEL (in)			TUBULAR STEEL 0/(in)				SIGN FRAME REQUIRED	REMARKS SHS = STANDARD HIGHWAY SIGN BOOK	SIGN DETAIL				
				WIDTH	HEIGHT			"A"	"B"	RETAIN	SALVAGE FROM	SALVAGE TO	REMOVE	RETAIN	REMOVE		1.75 lb/ft	2.00 lb/ft	2.50 lb/ft	FOUNDATION	3.00	3.50	4.00			5.00	DETAIL IN SHS	DETAIL ON SHEET NUMBER	STANDARD SHEET NUMBER	
SB	MM 0.804, LT	F	OM-I	18	18								X											REMOVE SIGN						
SB	MM 0.805, LT	E	WI-6	48	24								X		X X										REMOVE SIGN AND 2-POSTS					
		E	OM-I	18	18								X												REMOVE SIGN					
		F E	WI-8 L WI-8 R	18 18	24 24	F-Y		3.00 3.00							I		X								INSTALL NEW CHEVRONS BACK-TO-BACK ON SIGN BRACKET ON A SINGLE POST WHERE THE LARGE ARROW WARNING SIGN WAS REMOVED	X X				
NB	MM 0.873, RT	A	WI-3	30	30								X		X										REMOVE REVERSE TURN SIGN AND POST (LOCATED 500 FT NORTH OF THE HINESBURG RD INTERSECTION)					
		A	TOWN SIGN	24	24								X												REMOVE SIGN					
NB	MM 0.873, RT	A	WI-3	30	30			6.25							I		X								INSTALL SIGN AND POST 100 FT SOUTH OF PREVIOUSLY REMOVED REVERSE TURN SIGN ASSEMBLY 400 FT NORTH OF HINESBURG RD INTERSECTION	X				
		A	WI3-IP	18	18			2.25																	INSTALL NEW SIGN BENEATH REVERSE TURN WARNING SIGN AT THE CORRECT SIGN HEIGHT	X				
SB	MM 0.905, LT	F	DI-I	36	6			6.00					X												REMOVE SIGN					
		F	DI-I	36	6			6.00					X		X										REMOVE SIGN AND POST					
NB	MM 0.911, RT	A	R2-I	24	30								X		X										REMOVE SIGN AND POST					
		A	TOWN SIGN	24	12								X												REMOVE SIGN					
SB	MM 0.916, LT	F	DI-I	72	12		ABOVE @ 0.905' LT	6.00							2		X								INSTALL NEW SIGN ON 2- POSTS 221FT NORTH OF THE HINESBURG RD INTERSECTION		II			
		F	DI-I	72	12		ABOVE @ 0.905' LT	6.00																	INSTALL NEW SIGN BENEATH THE HUNTINGTON DESTINATION SIGN ON THE SAME POSTS		II			
SB	MM 0.934, LT	F	DI-I	36	6								X		X										REMOVE SIGN AND POST					
NB	MM 0.947, RT	C	WI-7	48	24			8.00					X		X	2		X							INSTALL NEW SIGN ON 2-POSTS AT THE SAME LOCATION DIRECTLY ACROSS THE HINESBURG ROAD FACING APPROACHING TRAFFIC	X				
FINAL POST LENGTHS ARE TO BE DETERMINED IN THE FIELD. POST SIZES ARE COMPUTED BASED ON INFORMATION FURNISHED ON THE STANDARD SHEETS AND THE VTRANS "SIGN POST DESIGN GUIDELINE".										EA	EA	EA	EA + 10	EA	EA 7		FT	FT 90	FT		LB	LB	LB	LB	PROJECT NAME: STATEWIDE NORTHWEST REGION PROJECT NUMBER: STP HRRR(5) FILE NAME: I0K018_wrk.dgn PROJECT LEADER: JLS DESIGNED BY: NLA RICHMOND TRAFFIC SIGN SUMMARY SHEET 4			PLOT DATE: 17-SEP-2012 11:33 DRAWN BY: ITS CHECKED BY: JLS SHEET 33 OF 51		
							SHEET SUBTOTALS			SF 34.50	SF	EA + 10			EA 7	EA 6	FT 90			EA	LB									

STATE OF VERMONT
AGENCY OF TRANSPORTATION

TRAFFIC SIGN SUMMARY SHEET 5


RICHMOND

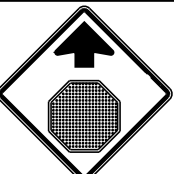DIRECTION	MILEMARKER, STATION, OR SIGN NUMBER	LOCATION	MANUAL ON UNIFORM TRAFFIC DEVICES OR STATE CODE	SIGN DIMENSIONS		SHEETING REMARKS	SIGN LEGEND	NEW SIGNS		EXISTING SIGNS				EXISTING POST		NO. OF NEW POSTS	SQUARE STEEL (in)			TUBULAR STEEL 0/(in)				SIGN FRAME REQUIRED	REMARKS SHS = STANDARD HIGHWAY SIGN BOOK	SIGN DETAIL			
				WIDTH	HEIGHT			"A"	"B"	RETAIN	SALVAGE FROM	SALVAGE TO	REMOVE	RETAIN	REMOVE		1.75 lb/ft	2.00 lb/ft	2.50 lb/ft	FOUNDATION	3.00	3.50	4.00			5.00	DETAIL IN SHS	DETAIL ON SHEET NUMBER	STANDARD SHEET NUMBER
SB	MM 0.971, LT	F	R2-I	24	30		5.00					X		X	1		X						INSTALL NEW SIGN AND POST ABOUT 79 FT SOUTH OF THE CENTER OF THE HINESBURG RD INTERSECTION	X					
SB	MM 0.997, LT	F	WI-2 L	30	30		6.25								1		X						INSTALL NEW SIGN AND POST 50 FT NORTH OF POLE# 56-20	X					
SB	MM 1.021, LT TO MM 1.165, LT	F		6	8	(24) TYPE II- 6" X 8" WHITE DELINEATORS	8.00								12	X							INSTALL 12 DELINEATORS BACK-TO-BACK (24 TOTAL) 70 FT APART GOING SOUTH. INSTALL THE FIRST ONE 36 FT SOUTH OF THE END OF THE FIRST GUARDRAIL OR 84 FT NORTH OF THE OTHER BUSINESS SIGNS (OWL'S HEAD BERRY FARM, BIRDS EYE BUILDING CO)		7				
SB	MM 1.147, LT	F	W2-3R	30	30		6.25								1		X						INSTALL NEW SIGN AND POST 200 FT NORTH OF THE CENTER OF HILLVIEW RD	X					
		F	WI6-8P	30	8		1.67																INSTALL BENEATH MODIFIED SIDE ROAD INTERSECTION WARNING SIGN AT THE CORRECT SIGN HEIGHT		10				
SB	MM 1.190, LT	E/F	D3-I	36	12		3.00					X		X									INSTALL NEW SIGN ABOVE HUNTINGTON RD STREET NAME SIGN ON SAME POST		10				
		G/H	D3-I	48	12		4.00					X											INSTALL NEW SIGN ABOVE STOP SIGN ON THE SAME POST		10				
SB	MM 1.190, LT	H	RI-I	30	30		6.25					X		X	1		X						REMOVE STOP SIGN AND POST AND INSTALL NEW SIGN AND POST AT A LOCATION 10 FT WEST OF THE CURRENT LOCATION (HILLVIEW RD)	X					
SB	MM 1.190, LT +359 FT	H	W3-I	36	36		9.00								2		X						INSTALL NEW SIGN ON 2-POSTS ON HILLVIEW ROAD, ABOUT 359 FT FROM THE INTERSECTION AND 33 FT WEST OF POLE# 119600 2	X					
SB	MM 1.217, LT	F	R2-I	24	30							X		X									REMOVE SIGN AND POST						
SB	MM 1.223, LT	F	R2-I	24	30		5.00								1		X						INSTALL NEW SIGN AND POST 168 FT SOUTH OF THE CENTER OF HILLVIEW RD	X					
NB	MM 1.233, RT	A	W2-3L	30	30		6.25								1		X						INSTALL NEW SIGN AND POST 200 FT SOUTH OF THE CENTER OF HILLVIEW RD	X					
		A	WI6-8P	30	8		1.67																INSTALL NEW SIGN BENEATH THE MODIFIED SIDE ROAD INTERSECTION WARNING SIGN AT THE CORRECT SIGN HEIGHT.		10				
SB	MM 1.486, LT	F	W2-2	30	30							X		X									REMOVE SIGN AND POST						
NB	MM 1.529, RT	A	R2-I	24	30							X		X									REMOVE SIGN AND POST						
FINAL POST LENGTHS ARE TO BE DETERMINED IN THE FIELD. POST SIZES ARE COMPUTED BASED ON INFORMATION FURNISHED ON THE STANDARD SHEETS AND THE VTRANS "SIGN POST DESIGN GUIDELINE".										EA	EA	EA	EA 7	EA	EA 6		FT 96	FT 120	FT		LB	LB	LB	LB	PROJECT NAME: STATEWIDE NORTHWEST REGION PROJECT NUMBER: STP HRRR(5)				
							SHEET SUBTOTALS		SF 62.34	SF	EA 7				EA 6	EA 20		FT 216		EA	LB				FILE NAME: 10k018_wrk.dgn PROJECT LEADER: JLS DESIGNED BY: NLA RICHMOND TRAFFIC SIGN SUMMARY SHEET 5			PLOT DATE: 17-SEP-2012 11:33 DRAWN BY: ITS CHECKED BY: JLS SHEET 34 OF 51	

STATE OF VERMONT
AGENCY OF TRANSPORTATION

TRAFFIC SIGN SUMMARY SHEET 6


RICHMOND

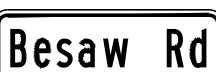DIRECTION	MILEMARKER, STATION, OR SIGN NUMBER	LOCATION	MANUAL ON UNIFORM TRAFFIC DEVICES OR STATE CODE	SIGN DIMENSIONS		SHEETING REMARKS	SIGN LEGEND	NEW SIGNS		EXISTING SIGNS				EXISTING POST		NO. OF NEW POSTS	SQUARE STEEL (in)			TUBULAR STEEL 0/(in)				SIGN FRAME REQUIRED	REMARKS SHS = STANDARD HIGHWAY SIGN BOOK	SIGN DETAIL				
				WIDTH	HEIGHT			“A”	“B”	RETAIN	SALVAGE FROM	SALVAGE TO	REMOVE	RETAIN	REMOVE		1.75 lb/ft	2.00 lb/ft	2.50 lb/ft	FOUNDATION	3.00	3.50	4.00			5.00	DETAIL IN SHS	DETAIL ON SHEET NUMBER	STANDARD SHEET NUMBER	
SB	MM 1.560, LT	F	W2-2	30	30			6.25							I		X						INSTALL NEW SIGN AND POST 258 FT NORTH OF THE CENTER OF LAWRENCE RD 25 FT NORTH OF POLE# 60-6	X						
		F	W16-8P	30	8			1.67															INSTALL NEW SIGN BENEATH SIDE ROAD INTERSECTION WARNING SIGN AT THE CORRECT HEIGHT		10					
SB	MM 1.616, LT	H	RI-1	30	30			6.25					X		X	I		X						REMOVE STOP SIGN AND POST AND INSTALL NEW SIGN AND POST AT SAME LOCATION (LAWRENCE RD)	X					
		E/F	D3-1	42	12			3.50					X											INSTALL NEW SIGN ABOVE HUNTINGTON ROAD STREET NAME SIGN ON THE SAME POST		10				
		G/H	D3-1	48	12			4.00																INSTALL NEW SIGN ABOVE THE STOP SIGN AND BELOW THE LAWRENCE ST STREET NAME SIGN ON THE SAME POST		10				
SB	MM 1.637, LT	F	R2-1	24	30			5.00							I		X							INSTALL NEW SIGN AND POST 150 FT SOUTH OF THE CENTER OF LAWRENCE RD	X					
NB	MM 1.646, RT	A	W2-2	30	30			6.25								I		X						INSTALL NEW SIGN AND POST 200 FT SOUTH OF AND ACROSS FROM THE CENTER OF LAWRENCE RD	X					
		A	W16-8P	30	8			1.67																INSTALL NEW SIGN BENEATH SIDE ROAD INTERSECTION WARNING SIGN AT THE CORRECT SIGN HEIGHT		10				
NB	MM 1.818, RT	A	W2-2L	30	30			6.25								I		X						INSTALL NEW SIGN AND POST AT POLE# 111589	X					
		A	W16-8P	24	8			1.33																INSTALL NEW SIGN BENEATH SIDE ROAD INTERSECTION WARNING SIGN AT THE CORRECT SIGN HEIGHT		10				
NB	MM 1.836, RT	A	W2-2L	30	30								X		X									REMOVE SIGN AND POST						
NB	MM 1.854, RT	A	R2-1	24	30			5.00								I		X						INSTALL NEW SIGN AND POST 168 FT NORTH OF THE CENTER OF LAWRENCE RD	X					
NB	MM 1.864, RT	A	R2-1	24	30								X		X									REMOVE SIGN AND POST						
NB	MM 1.878, RT	D	RI-1	30	30			6.25					X		X	I		X						REMOVE STOP SIGN AND POST AND INSTALL NEW SIGN AND POST AT SAME LOCATION (BESAW RD)	X					
		A/B	D3-1	30	12			2.50					X											INSTALL NEW SIGN ABOVE THE STOP SIGN ON THE SAME POST		10				
SB	MM 1.911, LT	F	R2-1	24	30			5.00								I		X						INSTALL NEW SIGN AND POST 132 FT SOUTH OF THE CENTER OF BESAW RD	X					
FINAL POST LENGTHS ARE TO BE DETERMINED IN THE FIELD. POST SIZES ARE COMPUTED BASED ON INFORMATION FURNISHED ON THE STANDARD SHEETS AND THE VTRANS "SIGN POST DESIGN GUIDELINE".										EA	EA	EA	EA 6	EA	EA 4		FT	FT 120	FT		LB	LB	LB	LB	PROJECT NAME: STATEWIDE NORTHWEST REGION PROJECT NUMBER: STP HRRR(5) FILE NAME: 10k018_wrk.dgn PROJECT LEADER: JLS DESIGNED BY: NLA RICHMOND TRAFFIC SIGN SUMMARY SHEET 6			PLOT DATE: 17-SEP-2012 11:33 DRAWN BY: ITS CHECKED BY: JLS SHEET 35 OF 51		
							SHEET SUBTOTALS							SF 60.92	SF	EA 6				EA 4	EA 8	FT 120	EA	LB						


STATE OF VERMONT
AGENCY OF TRANSPORTATION



TRAFFIC SIGN SUMMARY SHEET 7

RICHMOND

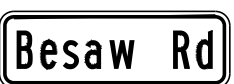DIRECTION	MILEMARKER, STATION, OR SIGN NUMBER	LOCATION	MANUAL ON UNIFORM TRAFFIC DEVICES OR STATE CODE	SIGN DIMENSIONS		SHEETING REMARKS	SIGN LEGEND	NEW SIGNS		EXISTING SIGNS				EXISTING POST		NO. OF NEW POSTS	SQUARE STEEL (in)			TUBULAR STEEL 0/(in)				SIGN FRAME REQUIRED	REMARKS SHS = STANDARD HIGHWAY SIGN BOOK	SIGN DETAIL			
				WIDTH	HEIGHT			“A”	“B”	RETAIN	SALVAGE FROM	SALVAGE TO	REMOVE	RETAIN	REMOVE		1.75	2.00 lb/ft	2.50	FOUNDATION	3.00	3.50	4.00			5.00	DETAIL IN SHS	DETAIL ON SHEET NUMBER	STANDARD SHEET NUMBER
NB	MM 1.931, RT	A	W2-2R	30	30			6.25								1		X						INSTALL NEW SIGN AND POST 238 FT SOUTH OF THE CENTER OF BESAW RD	X				
		A	W16-8P	24	8			1.33																INSTALL NEW SIGN BENEATH SIDE ROAD INTERSECTION WARNING SIGN AT THE CORRECT SIGN HEIGHT		10			
NB	MM 2.033, RT	D	RI-1	30	30			6.25					X		X	1		X							REMOVE STOP SIGN AND POST AND INSTALL NEW SIGN AND POST AT SAME LOCATION (GRANDVIEW DR)	X			
NB	MM 2.041, RT	A/B	D3-1	42	12			3.50					X		X										INSTALL NEW SIGN ABOVE STOP SIGN ON THE SAME POST		10		
NB	MM 2.071, RT	A	W7-1	30	30			6.25					X		X	1		X							INSTALL NEW SIGN AND POST OPPOSITE POLE# 1875	X			
SB	MM 2.186, LT	F	R2-1	24	30			5.00								1		X							INSTALL NEW SIGN AND POST 180 FT SOUTH OF THE CENTER OF GRANDVIEW DR	X			
SB	MM 2.530, LT	F	WI-2	30	30			6.25								1		X							INSTALL NEW SIGN AND POST 25 FT NORTH OF POLE# 56-50/32	X			
SB	MM 2.610, LT TO MM 2.550, LT	F E		6	8		(10) TYPE II - 6" X 8" WHITE DELINEATORS	3.33								5	X								INSTALL 5 DELINEATORS BACK-TO-BACK (10 TOTAL) 70 FT APART GOING NORTH. INSTALL THE FIRST ONE 60 FT NORTH OF POLE# 57-50/34		7		
NB	MM 2.977, RT	A	R2-1	24	30			5.00					X		X	1		X							INSTALL NEW SIGN AND POST NEXT TO BOX# 2683	X			
SB	MM 2.984, LT	F	R2-1	24	30			5.00					X		X	1		X							INSTALL NEW SIGN AND POST AT BOX# 2881	X			
NB	MM 3.193, RT	A	R2-1	24	30			5.00					X		X	1		X							INSTALL NEW SIGN AND POST 770 FT NORTH OF THE CENTER OF HILLVIEW RD	X			
SB	MM 3.277, LT	F	WI0-IL	36	36			9.00					X		X	2		X							INSTALL NEW CURVE/INTERSECTION SIGN ON 2-POSTS 315 FT NORTH OF THE CENTER OF HILLVIEW RD	X			
		F	W16-8P	30	8			1.67																	INSTALL BENEATH THE CURVE/INTERSECTION WARNING SIGN AT THE CORRECT SIGN HEIGHT		10		
SB	MM 3.304, LT	F E	WI-8 L WI-8 R	18 18	24 24		  	3.00 3.00								1		X							INSTALL NEW CHEVRONS BACK-TO-BACK ON A SIGN BRACKET ON A SINGLE POST SPACED AT 120 FT APART GOING SOUTH. INSTALL THE FIRST ASSEMBLY 120 FT NORTH OF POLE# 77/755	X X			
SB	MM 3.327, LT	F E	WI-8 L WI-8 R	18 18	24 24		  	3.00 3.00								1		X							INSTALL NEW CHEVRONS BACK-TO-BACK ON A SIGN BRACKET ON A SINGLE POST ADJACENT TO POLE# 77/755	X X			
FINAL POST LENGTHS ARE TO BE DETERMINED IN THE FIELD. POST SIZES ARE COMPUTED BASED ON INFORMATION FURNISHED ON THE STANDARD SHEETS AND THE VTRANS "SIGN POST DESIGN GUIDELINE".										EA	EA	EA	EA 7	EA	EA 7		FT 40	FT 180	FT 0			LB	LB	LB	LB	PROJECT NAME: STATEWIDE NORTHWEST REGION PROJECT NUMBER: STP HRRR(5)			
							SHEET SUBTOTALS	SF 75.83	SF	EA 7				EA 7	EA 7	EA 7	FT 220	EA	LB				FILE NAME: I0K018_wrk.dgn PROJECT LEADER: JLS DESIGNED BY: NLA RICHMOND TRAFFIC SIGN SUMMARY SHEET 7			PLOT DATE: 17-SEP-2012 11:33 DRAWN BY: ITS CHECKED BY: JLS SHEET 36 OF 51			

STATE OF VERMONT AGENCY OF TRANSPORTATION				TRAFFIC SIGN SUMMARY SHEET 8 – RICHMOND																									
DIRECTION	MILEMARKER, STATION, OR SIGN NUMBER	LOCATION	MANUAL ON UNIFORM TRAFFIC DEVICES OR STATE CODE	SIGN DIMENSIONS		SHEETING REMARKS	SIGN LEGEND	NEW SIGNS		EXISTING SIGNS				EXISTING POST		NO. OF NEW POSTS	SQUARE STEEL (in)			TUBULAR STEEL 0/(in)				SIGN FRAME REQUIRED	REMARKS SHS = STANDARD HIGHWAY SIGN BOOK	SIGN DETAIL			
				WIDTH	HEIGHT			“A”	“B”	RETAIN	SALVAGE FROM	SALVAGE TO	REMOVE	RETAIN	REMOVE		1.75 lb/ft	2.00 lb/ft	2.50 lb/ft	FOUNDATION	3.00	3.50	4.00			5.00	DETAIL IN SHS	DETAIL ON SHEET NUMBER	STANDARD SHEET NUMBER
SB	MM 3.344, LT	E/F	D3-I	36	12			3.00					X											INSTALL NEW SIGN ABOVE HUNTINGTON ROAD STREET NAME SIGN ON SAME POST		10			
		G/H	D3-I	48	12			4.00					X											INSTALL NEW SIGN ABOVE STOP SIGN ON THE SAME POST		10			
		H	RI-I	30	30			6.25					X		X	1		X						REMOVE STOP SIGN AND POST AND INSTALL NEW SIGN AND POST AT THE SAME LOCATION AS THE PREVIOUSLY REMOVED STREET NAME SIGN ASSEMBLY CLOSER TO THE INTERSECTION	X				
SB	MM 3.350, LT	F E	WI-8 L WI-8 R	18 18	24 24			3.00 3.00								1		X						INSTALL NEW CHEVRONS BACK-TO-BACK ON A SIGN BRACKET ON A SINGLE POST 116 FT SOUTH OF POLE* 77/755	X X				
SB	MM 3.373, LT	F E	WI-8 L WI-8 R	18 18	24 24			3.00 3.00								1		X						INSTALL NEW CHEVRONS BACK-TO-BACK ON A SIGN BRACKET ON A SINGLE POST 232 FT SOUTH OF POLE* 77/755	X X				
SB	MM 3.432, LT	F	R2-I	24	30			5.00					X		X	1		X						INSTALL NEW SIGN AND POST 220 FT SOUTH OF HILLVIEW ROAD	X				
NB	MM 3.457, RT	A	W10-IR	36	36			9.00					X		X	2		X						INSTALL NEW SIGN ON 2-POSTS 353 FT SOUTH OF THE CENTER OF HILLVIEW RD	X				
		A	W16-8P	30	8			1.67																INSTALL NEW SIGN BENEATH HORIZONTAL ALIGNMENT WITH SIDE ROAD WARNING SIGN AT THE CORRECT SIGN HEIGHT		10			
SB	MM 3.551, LT	F	W1-5L	30	30			6.25								1		X						INSTALL NEW WINDING ROAD SIGN AND POST AT POLE # 85	X				
NB	MM 3.739, RT	A	R2-I	24	30								X		X									REMOVE SIGN AND POST					
SB	MM 3.739, LT	F	W10-IR	36	36			9.00								2		X						INSTALL NEW SIGN ON 2-POSTS 375 FT NORTH OF AND ACROSS FROM THE CENTER OF DUGWAY RD INTERSECTION	X				
		F	W16-8P	30	8			1.67																INSTALL NEW SIGN BENEATH HORIZONTAL ALIGNMENT WITH SIDE ROAD WARNING SIGN AT THE CORRECT SIGN HEIGHT		10			
NB	MM 3.747, RT	A	W1-5R	30	30			6.25								1		X						INSTALL NEW SIGN AND POST OPPOSITE HOUSE# 3420	X				
NB	MM 3.799, RT	D	RI-I	30	30			6.25					X		X	1		X						REMOVE SIGN AND POST AND INSTALL NEW SIGN AND POST AT SAME LOCATION (DUGWAY RD)	X				
		A/B	D3-I	36	12			3.00																INSTALL SIGN ABOVE THE STOP SIGN ON THE SAME POST		10			
NB	MM 3.847, RT	A	W10-IL	36	36			9.00								2		X						INSTALL NEW SIGN ON 2-POSTS 200 FT SOUTH OF THE CENTER OF DUGWAY RD	X				
FINAL POST LENGTHS ARE TO BE DETERMINED IN THE FIELD. POST SIZES ARE COMPUTED BASED ON INFORMATION FURNISHED ON THE STANDARD SHEETS AND THE VTRANS "SIGN POST DESIGN GUIDELINE".											EA	EA	EA	EA	EA	EA		FT	FT	FT		LB	LB	LB	LB	PROJECT NAME: STATEWIDE NORTHWEST REGION			
							SHEET SUBTOTALS							SF 82.34	SF		EA	EA	EA	EA	EA	EA		FT	FT	FT	EA	LB	
											EA	EA	EA	EA	EA	EA		FT	FT	FT		LB			FILE NAME: I0k018_wrk.dgn				
											EA	EA	EA	EA	EA	EA		FT	FT	FT		LB			PLOT DATE: 17-SEP-2012 11:33				
											EA	EA	EA	EA	EA	EA		FT	FT	FT		LB			DRAWN BY: ITS				
											EA	EA	EA	EA	EA	EA		FT	FT	FT		LB			CHECKED BY: JLS				
											EA	EA	EA	EA	EA	EA		FT	FT	FT		LB			RICHMOND TRAFFIC SIGN SUMMARY SHEET 8 SHEET 37 OF 51				

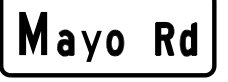STATE OF VERMONT AGENCY OF TRANSPORTATION				TRAFFIC SIGN SUMMARY SHEET 9 - RICHMOND																											
DIRECTION	MILEMARKER, STATION, OR SIGN NUMBER	LOCATION	MANUAL ON UNIFORM TRAFFIC DEVICES OR STATE CODE	SIGN DIMENSIONS		SHEETING REMARKS	SIGN LEGEND	NEW SIGNS		EXISTING SIGNS				EXISTING POST		NO. OF NEW POSTS	SQUARE STEEL (in)			TUBULAR STEEL 0/(in)				SIGN FRAME REQUIRED	REMARKS SHS = STANDARD HIGHWAY SIGN BOOK	SIGN DETAIL					
				WIDTH	HEIGHT			"A"	"B"	RETAIN	SALVAGE FROM	SALVAGE TO	REMOVE	RETAIN	REMOVE		1.75 lb/ft	2.00 lb/ft	2.50 lb/ft	FOUNDATION	3.00	3.50	4.00			5.00	DETAIL IN SHS	DETAIL ON SHEET NUMBER	STANDARD SHEET NUMBER		
		A	W16-8P	30	8			1.67															INSTALL NEW SIGN BENEATH THE HORIZONTAL ALIGNMENT WITH SIDE ROAD WARNING SIGN LISTED ON THE PREVIOUS PAGE AT THE CORRECT SIGN HEIGHT		10						
SB	MM 4.006, LT	F	W5-2	36	36			9.00							2		X							INSTALL NEW SIGN ON 2-POSTS 175 FT NORTH OF THE BEGINNING OF THE BRIDGE	X						
SB	MM 4.040, LT	F	OM3-R	12	36			3.00							1		X							INSTALL OBJECT MARKER AT THE NORTH END OF THE BRIDGE ON THE RIGHT HAND SIDE	X						
NB	MM 4.400, RT	A	OM3-L	12	36			3.00							1		X							INSTALL OBJECT MARKER AT THE NORTH END OF THE BRIDGE ON THE LEFT HAND SIDE	X						
SB	MM 4.112, LT	E	OM3-L	12	36			3.00							1		X							INSTALL OBJECT MARKER AT THE SOUTH END OF THE BRIDGE ON THE RIGHT HAND SIDE (SIGN FACING NORTHBOUND TRAFFIC)	X						
NB	MM 4.112, RT	B	OM3-R	12	36			3.00							1		X							INSTALL OBJECT MARKER AT THE SOUTH END OF THE BRIDGE ON THE LEFT HAND SIDE (SIGN FACING NORTHBOUND TRAFFIC)	X						
NB	MM 4.145, LT	A	W5-2	36	36			9.00							2		X							INSTALL NEW SIGN ON 2-POSTS 175 FT SOUTH OF THE END OF THE BRIDGE	X						
SB	MM 4.283, LT	F	W10-1R	36	36			9.00							2		X							INSTALL NEW CURVE/INTERSECTION SIGN AND POSTS 150 FT NORTH OF THE CENTER OF MAYO RD	X						
SB	MM 4.283, LT	F	W16-8P	24	8			1.33																INSTALL BELOW THE NEW CURVE/INTERSECTION SIGN		10					
NB	M 4.303, RT	B	W1-8 L	18	24		 B-B 	3.00							1		X							INSTALL NEW CHEVRONS BACK-TO-BACK ON A SIGN BRACKET ON A SINGLE POST 10 FT NORTH OF THE STOP SIGN FOR MAYO RD	X						
		A	W1-8 R	18	24			3.00																X							
NB	MM 4.305, RT	D	RI-1	30	30			6.25					X		X	1		X						★	REMOVE STOP SIGN AND POST AND INSTALL NEW SIGN AND POST AT SAME LOCATION (MAYO RD)	X					
NB	MM 4.322, RT	A/B	D3-1	30	12			2.50					X		X	1		X						★	INSTALL SIGN ABOVE NEW HUNTINGTON RD STREET NAME SIGN AT THE SAME LOCATION BEHIND GUARDRAIL		10				
NB	MM 4.322, RT	C/D	D3-1	48	12			4.00																INSTALL NEW SIGN BENEATH MAYO RD SIGN ON THE SAME POST AT THE SAME LOCATION BEHIND GUARDRAIL ACROSS FROM STOP SIGN ON MAYO RD		10					
NB	MM 4.326, RT	B	W1-8	18	24		 B-B 	3.00							1		X							INSTALL NEW CHEVRONS BACK-TO-BACK ON A SIGN BRACKET ON A SINGLE POST 120 FT SOUTH OF THE PREVIOUS PAIR	X						
		A	W1-8	18	24			3.00																INSTALL 10 FT NORTH OF THE STOP SIGN FOR MAYO RD	X						
SB	MM 4.361, LT	F	W1-2 L	30	30			6.25							1		X							REMOVE SIGN AND POST							
FINAL POST LENGTHS ARE TO BE DETERMINED IN THE FIELD. POST SIZES ARE COMPUTED BASED ON INFORMATION FURNISHED ON THE STANDARD SHEETS AND THE VTRANS "SIGN POST DESIGN GUIDELINE".											EA	EA	EA	EA	EA	EA		FT	FT	FT		LB	LB	LB	LB	PROJECT NAME: STATEWIDE NORTHWEST REGION PROJECT NUMBER: STP HRRR(5) FILE NAME: 10k018_wrk.dgn PROJECT LEADER: JLS DESIGNED BY: NLA RICHMOND TRAFFIC SIGN SUMMARY SHEET 9			PLOT DATE: 17-SEP-2012 11:33 DRAWN BY: ITS CHECKED BY: JLS SHEET 38 OF 51		
							SHEET SUBTOTALS							SF 73.00	SF	EA 2 6				EA 2	EA 15	FT 225	EA	LB							

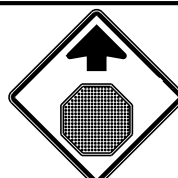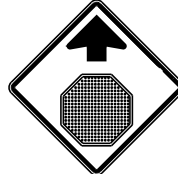DIRECTION	MILEMARKER, STATION, OR SIGN NUMBER	LOCATION	MANUAL ON UNIFORM TRAFFIC DEVICES OR STATE CODE	SIGN DIMENSIONS		SHEETING REMARKS	SIGN LEGEND	NEW SIGNS		EXISTING SIGNS				EXISTING POST		NO. OF NEW POSTS	SQUARE STEEL (in)			TUBULAR STEEL 0/(in)				SIGN FRAME REQUIRED	REMARKS	SIGN DETAIL			
				WIDTH	HEIGHT			A	B	RETAIN	SALVAGE FROM	SALVAGE TO	REMOVE	RETAIN	REMOVE		1.75	2.00	2.50	FOUNDATION	3.00	3.50	4.00			5.00	DETAIL IN SHS	DETAIL ON SHEET NUMBER	STANDARD SHEET NUMBER
																	lb/ft				lb/ft								
																	1.88	2.42	3.35		7.60	9.00	10.80			14.60			
NB	MM 4.380, RT	A	WI-2 L	36	36								X		X								REMOVE SIGN AND POST						
		A	WIO-I L	36	36			9.00					X		X	2		X						INSTALL NEW SIGN ON 2-POSTS 364 FT SOUTH OF THE CENTER OF MAYO RD	X				
		A	WI6-8P	24	8			1.33																INSTALL NEW SIGN BENEATH HORIZONTAL ALIGNMENT WITH SIDE ROAD WARNING SIGN AT THE CORRECT SIGN HEIGHT		10			
SB	MM 4.380, LT	F	TOWN SIGN	30	30								X		X									REMOVE SIGN AND POST					
SB	MM 4.390, LT TO MM 4.440, LT	F E		6	8		(6) TYPE II - 6" X 8" WHITE DELINEATORS	2.00								3	X							INSTALL DELINEATORS BACK-TO-BACK (6 TOTAL) 70 FT APART GOING SOUTH, INSTALL FIRST ONE AT POLE #107		7			
							HINESBURG RD																						
EB	MM 3.782, RT	A	W3-I	30	30								X		X									REMOVE SIGN AND POST					
EB	MM 3.823, RT	A	W3-I	36	36			9.00								2		X						INSTALL NEW SIGN ON 2-POSTS 260 FT EAST OF POLE# 113868 3 4	X				
EB	MM 3.842, RT	A	DI-I	36	6					X	I			X										RETAIN SIGN AND 2-POSTS					
		A	DI-I	36	6					X	I													RETAIN SIGN BENEATH HUNTINGTON (TOWN SIGN) ON THE SAME POSTS					
		A	DI-I	32	6					X	I			X										RETAIN SIGN BENEATH ROUND CHURCH (TOWN) SIGN ON THE SAME POSTS					
EB	MM 3.885, RT	A	RI-I	30	30			6.25					X		X	I		X						REMOVE EXISTING STOP SIGN AND POST AND INSTALL NEW SIGN AND POST AT THE SAME LOCATION (HUNTINGTON RD INTERSECTION)	X				
		A	D3-I	36	6								X											REMOVE SIGN					
		A	D3-I	36	6								X											REMOVE SIGN					
		A	D3-I	42	12			3.50																INSTALL NEW SIGN ABOVE THE NEW HUNTINGTON RD SIGN ON THE SAME POST		10			
		A	D3-I	48	12			4.00								I		X						INSTALL NEW SIGN AND POST 5 FT EAST OF THE STOP SIGN		10			
FINAL POST LENGTHS ARE TO BE DETERMINED IN THE FIELD. POST SIZES ARE COMPUTED BASED ON INFORMATION FURNISHED ON THE STANDARD SHEETS AND THE VTRANS "SIGN POST DESIGN GUIDELINE".									EA 3	EA 3	EA 7	EA 2	EA 5	FT 24	FT 90	FT		LB	LB	LB	LB	PROJECT NAME: STATEWIDE NORTHWEST REGION PROJECT NUMBER: STP HRRR(5) FILE NAME: 10K018_wrk.dgn PROJECT LEADER: JLS DESIGNED BY: NLA RICHMOND TRAFFIC SIGN SUMMARY SHEET 10							
							SHEET SUBTOTALS			SF 35.08	SF	EA 10 7	EA 7	EA 9	FT 114	EA	LB												
																						PLOT DATE: 17-SEP-2012 11:33 DRAWN BY: ITS CHECKED BY: JLS SHEET 39 OF 51							

TRAFFIC SIGN SUMMARY SHEET 11 - RICHMOND

DIRECTION	MILEMARKER, STATION, OR SIGN NUMBER	LOCATION	MANUAL ON UNIFORM TRAFFIC DEVICES OR STATE CODE	SIGN DIMENSIONS		SHEETING REMARKS	SIGN LEGEND	NEW SIGNS		EXISTING SIGNS				EXISTING POST		NO. OF NEW POSTS	SQUARE STEEL (in)			TUBULAR STEEL 0/(in)				SIGN FRAME REQUIRED	REMARKS SHS = STANDARD HIGHWAY SIGN BOOK	SIGN DETAIL																																																																																																																																																																																																																																																																																																																																																																																																																																																																																																																																																																																																																																																																																																																																																																																																																																																																																																																																																																																																																																																																																																																																																																																																																																																
				WIDTH	HEIGHT			“A”	“B”	RETAIN	SALVAGE FROM	SALVAGE TO	REMOVE	RETAIN	REMOVE		1.75	2.00	2.50	FOUNDATION	3.00	3.50	4.00			5.00	DETAIL IN SHS	DETAIL ON SHEET NUMBER	STANDARD SHEET NUMBER																																																																																																																																																																																																																																																																																																																																																																																																																																																																																																																																																																																																																																																																																																																																																																																																																																																																																																																																																																																																																																																																																																																																																																																																																																													

STATE OF VERMONT
AGENCY OF TRANSPORTATION


TRAFFIC SIGN SUMMARY SHEET 1 - ST. ALBANS

DIRECTION	MILEMARKER, STATION, OR SIGN NUMBER	LOCATION	MANUAL ON UNIFORM TRAFFIC DEVICES OR STATE CODE	SIGN DIMENSIONS		SHEETING REMARKS	SIGN LEGEND	NEW SIGNS		EXISTING SIGNS				EXISTING POST		NO. OF NEW POSTS	SQUARE STEEL (in)			TUBULAR STEEL 0/(in)				SIGN FRAME REQUIRED	REMARKS SHS = STANDARD HIGHWAY SIGN BOOK	SIGN DETAIL			
				WIDTH	HEIGHT			"A"	"B"	RETAIN	SALVAGE FROM	SALVAGE TO	REMOVE	RETAIN	REMOVE		1.75 lb/ft	2.00 lb/ft	2.50 lb/ft	FOUNDATION	3.00	3.50	4.00			5.00	DETAIL IN SHS	DETAIL ON SHEET NUMBER	STANDARD SHEET NUMBER
SB	MM 0.011, LT	E	D3-I	24	6							X		X									REMOVE SIGN AND POST						
		G	D3-I	30	6							X											REMOVE SIGN						
SB	MM 0.015, LT	F	RI-I	30	30			6.25				X		X	I		X						REMOVE SIGN AND POST AND INSTALL NEW SIGN AND POST AT SAME LOCATION	X					
		E/F	D3-I	30	12			2.50															INSTALL NEW SIGN ABOVE THE STOP SIGN ON THE SAME POST		II				
		G/H	D3-I	36	12			3.00															INSTALL NEW SIGN ABOVE THE LAKE ST STREET NAME SIGN		II				
NB	MM 0.029, RT	A	VR-017	24	30					X			X										RETAIN SIGN AND POST 150 FT NORTH OF THE CENTER OF LAKE ST						
NB	MM 0.060, RT	A	R2-I	24	30			5.00				X		X	I		X						INSTALL NEW SIGN AND POST 215 FT SOUTH OF POLE# 7/8	X					
SB	MM 0.087, LT	F	W3-I	36	36			9.00							2		X						INSTALL NEW SIGN ON 2-POSTS 75 SOUTH OF POLE# 7/8	X					
SB	MM 0.769, LT	F	TOWN SIGN	12	18							X		X									REMOVE SIGN AND POST						
SB	MM 1.149, LT	F	R2-I	24	30			5.00				X		X	I		X						INSTALL NEW SIGN AND POST 15 FT NORTH OF POLE# 29	X					
NB	MM 1.223, RT	A	R2-I	24	30			5.00				X		X	I		X						INSTALL NEW SIGN AND POST 400 FT NORTH OF POLE# 29	X					
NB	MM 1.395, RT	A	WI-2R	30	30			6.25				X		X	I		X						INSTALL NEW SIGN AND POST 495 FT SOUTH OF POLE# 29	X					
		A	WI3-IP	18	18							X											REMOVE SIGN						
NB	MM 1.485, RT	A					EMPTY POST							X									REMOVE POST						
NB	MM 1.504, RT	A					EMPTY POST							X									REMOVE POST						
SB	MM 1.595, LT	F	WI-2L	30	30			6.25				X		X	I		X						INSTALL NEW SIGN AND POST 575 FT NORTH OF POLE# 29	X					
FINAL POST LENGTHS ARE TO BE DETERMINED IN THE FIELD. POST SIZES ARE COMPUTED BASED ON INFORMATION FURNISHED ON THE STANDARD SHEETS AND THE VTRANS "SIGN POST DESIGN GUIDELINE".									EA I	EA	EA	EA 10-9	EA I	EA 10		FT	FT 120	FT		LB	LB	LB	LB	PROJECT NAME: STATEWIDE NORTHWEST REGION PROJECT NUMBER: STP HRRR(5) FILE NAME: 10k018_wrk.dgn PROJECT LEADER: JLS DESIGNED BY: NLA ST. ALBANS TRAFFIC SIGN SUMMARY SHEET 1 SHEET 41 OF 51					
							SHEET SUBTOTALS				SF 48.25	SF	EA 11-9				EA 11-	EA 8-	FT 120		EA	LB							

STATE OF VERMONT
AGENCY OF TRANSPORTATION

TRAFFIC SIGN SUMMARY SHEET 2

ST. ALBANS

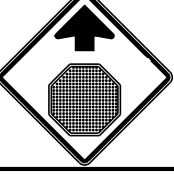DIRECTION	MILEMARKER, STATION, OR SIGN NUMBER	LOCATION	MANUAL ON UNIFORM TRAFFIC DEVICES OR STATE CODE	SIGN DIMENSIONS		SHEETING REMARKS	SIGN LEGEND	NEW SIGNS		EXISTING SIGNS				EXISTING POST		NO. OF NEW POSTS	SQUARE STEEL (in)			TUBULAR STEEL 0/(in)				SIGN FRAME REQUIRED	REMARKS SHS = STANDARD HIGHWAY SIGN BOOK	SIGN DETAIL			
				WIDTH	HEIGHT			"A"	"B"	RETAIN	SALVAGE FROM	SALVAGE TO	REMOVE	RETAIN	REMOVE		1.75	2.00	2.50	FOUNDATION	3.00	3.50	4.00			5.00	DETAIL IN SHS	DETAIL ON SHEET NUMBER	STANDARD SHEET NUMBER
SB	MM 1.595, LT	F	WI3-IP	18	18							X											REMOVE SIGN						
NB	MM 1.844, RT	A	WI-5	30	30							X		X									REMOVE SIGN AND POST						
		A	WI3-IP	18	18							X											REMOVE SIGN						
		A	WI-4	30	30		6.25								I		X						INSTALL NEW SIGN AND POST 5 FT SOUTH OF POLE# 16/NET/6						
NB	MM 1.886, RT TO MM 1.9525, RT	A/B		6	8	(12) TYPE II- 6" X 8" WHITE DELINEATORS	4.00								6 @7.5 EA.	X							INSTALL DELINEATORS BACK-TO-BACK 70 FT APART. INSTALL FIRST DELINEATOR 75 FT NORTH OF AND ACROSS FROM POLE# 41/1/4415		7				
NB	MM 1.898, RT	A	VN-054	30	30		6.25								I		X						INSTALL NEW SIGN AND POST 120 FT SOUTH OF AND ACROSS FROM POLE# 4/3/13		8				
NB	MM 1.931, RT	A	VR-072 VR-072	24 24	30 30	 B-B 			X X				X										RETAIN BACK-TO-BACK ENCASE SIGNS AND POST						
SB	MM 1.985, LT	F	TOWN SIGN	18	24							X		X									REMOVE SIGN AND POST						
SB	MM 2.029, LT	F	WI-5	30	30							X		X									REMOVE SIGN AND POST						
		F	WI3-IP	18	18							X											REMOVE SIGN						
		F	WI-4	30	30		6.25								I		X						INSTALL NEW SIGN AND POST 280 FT NORTH OF AND ACROSS FROM POLE# 12	X					
NB	MM 2.394, RT	A	W3-I	36	36		9.00					X		X	2		X						INSTALL NEW SIGN ON 2-POSTS 137 FT SOUTH OF POLE# 413/2	X					
SB	MM 2.425, LT	F	VR-017	24	30		5.00					X		X	1		X						INSTALL NEW SIGN AND POST 26 FT NORTH OF AND ACROSS FROM POLE# 413/2	X					
		F	R2-I	24	30		5.00																INSTALL NEW SIGN BENEATH THE LEGAL LOAD LIMIT SIGN ON THE SAME POST	X					
SB	MM 2.455, LT	F	VR-017	24	30							X		X									REMOVE SIGN AND POST						
NB	MM 2.459, RT	A	RI-I	30	30				X				X										RETAIN EXISTING SIGN AND POST	X					
FINAL POST LENGTHS ARE TO BE DETERMINED IN THE FIELD. POST SIZES ARE COMPUTED BASED ON INFORMATION FURNISHED ON THE STANDARD SHEETS AND THE VTRANS "SIGN POST DESIGN GUIDELINE".									EA 3	EA	EA	EA 9 8	EA 2	EA 6		FT 48	FT 90	FT		LB	LB	LB	LB	PROJECT NAME: STATEWIDE NORTHWEST REGION PROJECT NUMBER: STP HRRR(5) FILE NAME: 10k018_wrk.dgn PROJECT LEADER: JLS DESIGNED BY: NLA ST. ALBANS TRAFFIC SIGN SUMMARY SHEET 2 SHEET 42 OF 51			PLOT DATE: 17-SEP-2012 11:33 DRAWN BY: ITS CHECKED BY: JLS		
							SHEET SUBTOTALS				SF 35.50-41.75	SF	EA 12 8			EA 8		EA 12		FT 138		EA	LB						

STATE OF VERMONT
AGENCY OF TRANSPORTATION

TRAFFIC SIGN SUMMARY SHEET 3 – ST. ALBANS

DIRECTION	MILEMARKER, STATION, OR SIGN NUMBER	LOCATION	MANUAL ON UNIFORM TRAFFIC DEVICES OR STATE CODE	SIGN DIMENSIONS		SHEETING REMARKS	SIGN LEGEND	NEW SIGNS		EXISTING SIGNS				EXISTING POST		NO. OF NEW POSTS	SQUARE STEEL (in)			TUBULAR STEEL 0/(in)				SIGN FRAME REQUIRED	REMARKS SHS = STANDARD HIGHWAY SIGN BOOK	SIGN DETAIL			
				WIDTH	HEIGHT			“A”	“B”	RETAIN	SALVAGE FROM	SALVAGE TO	REMOVE	RETAIN	REMOVE		1.75 lb/ft	2.00 lb/ft	2.50 lb/ft	FOUNDATION	3.00	3.50	4.00			5.00	DETAIL IN SHS	DETAIL ON SHEET NUMBER	STANDARD SHEET NUMBER
SB	MM 2.462, LT	F	D3-I	36	6								X		X								REMOVE SIGN AND POST						
SB		G	D3-I	30	6								X		X								REMOVE SIGN						
NB	MM 2.475, RT	C	D3-I	36	12			3.00					X		X								INSTALL NEW SIGN ABOVE LOWER KELLOGG RD STREET NAME SIGN ON SAME POSTS		II				
NB		A	D3-I	54	12			4.50								2		X					INSTALL NEW SIGN ON 2-POSTS 5 FT TO THE RIGHT OF RETAINED STOP SIGN WITHOUT OBSTRUCTING STOP SIGN'S VISIBILITY		II				
NB	MM 2.476, RT	A	VR-017	24	30								X		X								REMOVE SIGN AND POST						
SB	MM 2.476, LT	F	RI-I	30	30					X				X									RETAIN STOP SIGN AND POST						
NB	MM 2.487, RT	A	TOWN SIGN	18	24								X										REMOVE SIGN						
NB	MM 2.487, RT	A	R2-I	24	30			5.00					X		X	I		X					INSTALL NEW SIGN AND POST 275 FT SOUTH OF AND ACROSS FROM POLE# 412/2	X					
NB		A	VR-017	24	30			5.00															INSTALL NEW SIGN ABOVE THE 30 MPH SPEED LIMIT SIGN ON SAME POST	X					
SB	MM 2.542, LT	F	W3-I	36	36			9.00					X		X	2		X					INSTALL NEW SIGN ON 2-POSTS 16 FT NORTH OF AND ACROSS FROM POLE# 412/2	X					
NB	MM 2.673, RT	A	W11-4	30	30								X		X								REMOVE SIGN AND POST						
SB	MM 2.740, LT	F	W11-4	30	30								X		X								REMOVE SIGN AND POST						
SB	MM 2.878, LT	F	R2-I	24	30			5.00					X		X	I		X					INSTALL NEW SIGN AND POST 148 FT SOUTH OF THE CENTER OF JEWETT AVENUE	X					
SB	MM 2.906, LT	G	WI-7	48	24					X				X	X								RETAIN SIGN AND 2-POSTS						
NB	MM 2.912, RT	D	RI-I	30	30			6.25					X		X	I		X					REMOVE SIGN AND POST AND INSTALL NEW SIGN AND POST AT SAME LOCATION (JEWETT AVENUE)	X					
NB		A	D3-I	36	12			3.00															INSTALL NEW SIGN ABOVE STOP SIGN ON THE SAME POST		II				
FINAL POST LENGTHS ARE TO BE DETERMINED IN THE FIELD. POST SIZES ARE COMPUTED BASED ON INFORMATION FURNISHED ON THE STANDARD SHEETS AND THE VTRANS "SIGN POST DESIGN GUIDELINE".									EA 2	EA	EA	EA 10	EA 3	EA 10		FT	FT 105	FT		LB	LB	LB	LB	PROJECT NAME: STATEWIDE NORTHWEST REGION PROJECT NUMBER: STP HRRR(5)					
							SHEET SUBTOTALS				SF 40.75	SF	EA 13 10				EA 13	EA 7		FT 105		EA	LB				FILE NAME: 10k018_wrk.dgn PROJECT LEADER: JLS DESIGNED BY: NLA ST. ALBANS TRAFFIC SIGN SUMMARY SHEET 3 SHEET 43 OF 51		
																							PLOT DATE: 17-SEP-2012 11:34 DRAWN BY: ITS CHECKED BY: JLS						

DIRECTION	MILEMARKER, STATION, OR SIGN NUMBER	LOCATION	MANUAL ON UNIFORM TRAFFIC DEVICES OR STATE CODE	SIGN DIMENSIONS		SHEETING REMARKS	SIGN LEGEND	NEW SIGNS		EXISTING SIGNS			EXISTING POST		NO. OF NEW POSTS	SQUARE STEEL (in)			TUBULAR STEEL 0/(in)				SIGN FRAME REQUIRED	REMARKS	SIGN DETAIL				
				WIDTH	HEIGHT			A	B	RETAIN	SALVAGE FROM	SALVAGE TO	REMOVE	RETAIN		REMOVE	1.75	2.00	2.50	FOUNDATION	3.00	3.50			4.00	5.00	DETAIL IN SHS	DETAIL ON SHEET NUMBER	STANDARD SHEET NUMBER
1.88	2.42	3.35	7.60	9.00	10.80	14.60	SHS = STANDARD HIGHWAY SIGN BOOK																						
NB	MM 2.914, RT	A	D3-I	30	6		Jewett Ave						X		X								REMOVE SIGN AND POST						
NB	MM 2.945, RT	A	R2-I	24	30		SPEED LIMIT 30	5.00					X		X	I		X					INSTALL NEW SIGN AND POST 205 FT NORTH OF THE CENTER OF JEWETT AVENUE	X					
NB	MM 3.012, RT	D	RI-I	30	30		STOP	6.25					X		X	I		X					REMOVE SIGN AND POST AND INSTALL NEW SIGN AND POST AT SAME LOCATION (PIKE DR)	X					
NB		A	D3-I	30	12		Pike Dr	2.50															INSTALL NEW SIGN ABOVE STOP SIGN ON THE SAME POST		II				
NB	MM 3.014, RT	A	D3-I	24	6		Pike Dr						X		X								REMOVE SIGN AND POST						
SB	MM 3.212, LT	F	R2-I	24	30		SPEED LIMIT 30						X		X								REMOVE SIGN AND POST						
SB	MM 3.212, LT	F	TOWN SIGN	18	24		SLOW CHILDREN						X										REMOVE SIGN						
SB	MM 3.223, LT	F	R2-I	24	30		SPEED LIMIT 30 NEW AGAIN 10-21-II	5.00 5.00								I		X					INSTALL NEW SIGN AND POST 1156 FT NORTH OF THE CENTER OF PIKE DR	X					
NB	MM 3.228, RT	C	VD-024	72	10		Swanton St. Albans	5.00								2		X					INSTALL NEW SIGN ON 2-POSTS AT THE TOWN LINE WHERE THE PAVEMENT CHANGES COLOR 1165 FT NORTH FROM THE CENTER OF PIKE DR		II				
FINAL POST LENGTHS ARE TO BE DETERMINED IN THE FIELD. POST SIZES ARE COMPUTED BASED ON INFORMATION FURNISHED ON THE STANDARD SHEETS AND THE VTRANS "SIGN POST DESIGN GUIDELINE".									EA	EA	EA	EA	EA	EA		FT	FT	FT		LB	LB	LB	LB	PROJECT NAME: STATEWIDE NORTHWEST REGION PROJECT NUMBER: STP HRRR(5) FILE NAME: 10K018_wrk.dgn PROJECT LEADER: JLS DESIGNED BY: NLA ST. ALBANS TRAFFIC SIGN SUMMARY SHEET 4 SHEET 44 OF 51					
							SHEET SUBTOTALS							SF 23.75 28.75	SF	EA 6				EA 5	EA 5	FT 75					EA	LB	

TRAFFIC SIGN SUMMARY SHEET 5 – ST. ALBANS

[illegible]

TRAFFIC SIGN SUMMARY SHEET 1 – WEYBRIDGE


DIRECTION	MILEMARKER, STATION, OR SIGN NUMBER	LOCATION	MANUAL ON UNIFORM TRAFFIC DEVICES OR STATE CODE	SIGN DIMENSIONS		SHEETING REMARKS	SIGN LEGEND	NEW SIGNS		EXISTING SIGNS				EXISTING POST		NO. OF NEW POSTS	SQUARE STEEL (in)			TUBULAR STEEL 0/(in)				SIGN FRAME REQUIRED	REMARKS	SIGN DETAIL		
				WIDTH	HEIGHT			A	B	RETAIN	SALVAGE FROM	SALVAGE TO	REMOVE	RETAIN	REMOVE		1.75	2.00	2.50	3.00	3.50	4.00	5.00			DETAIL IN SHS	DETAIL ON SHEET NUMBER	STANDARD SHEET NUMBER
																	lb/ft			lb/ft								
																	1.88	2.42	3.35									
SB	MM 0.015, LT	E	OM3-L	12	36					X				X	I		X						RETAIN SIGN AND REPLACE POST					
NB	MM 0.015, RT	A	TOWN SIGN	30	36							X											REMOVE SIGN AND POST					
		A	OM3-R	12	30					X			X	I		X							RETAIN SIGN SLIDE UP TO CORRECT HEIGHT					
NB	MM 0.023, RT	A	VR-017	24	30			5.00						I		X							INSTALL NEW SIGN AND POST 40 FT SOUTH OF TYPE 3 OBJECT MARKER AT END OF BRIDGE, BEHIND GUARDRAIL		7			
NB	MM 0.104, RT	A	W5-3	36	36			9.00						2		X							INSTALL NEW SIGN ON 2-POSTS 16 FT NORTH OF POLE# 421/57/29-2	X				
NB	MM 1.582, RT	A	W5-3	36	36			9.00						2		X							INSTALL NEW SIGN ON 2-POSTS 174 FT NORTH OF AND ACROSS FROM POLE# 421/27	X				
		A	W16-3AP	30	12			2.50															INSTALL BENEATH ONE LANE BRIDGE SIGN AT THE CORRECT SIGN HEIGHT	X				
NB	MM 1.610, RT	A	TOWN SIGN	24	30							X	X										REMOVE SIGN AND POST					
NB	MM 1.617, RT	A	TOWN SIGN	30	30							X	X										REMOVE SIGN AND POST					
		A	VR-493M	36	36			9.00						2		X							INSTALL NEW SIGN AND POST 11 FT SOUTH OF AND ACROSS FROM POLE# 421/27		8			
		A	VR-017	24	30			5.00															INSTALL NEW SIGN BENEATH RATTLIN BRIDGE REGULATORY SIGN ON LEFT POST AT THE CORRECT SIGN HEIGHT		7			
NB	MM 1.628, RT	A	W1-2R	30	30							X	X										REMOVE SIGN AND POST					
FINAL POST LENGTHS ARE TO BE DETERMINED IN THE FIELD. POST SIZES ARE COMPUTED BASED ON INFORMATION FURNISHED ON THE STANDARD SHEETS AND THE VTRANS DIVISION'S "SIGN POST DESIGN GUIDELINE."									EA 2	EA	EA 4	EA 5		FT 135	FT		LB	LB	LB	LB	PROJECT NAME: STATEWIDE NORTHWEST REGION PROJECT NUMBER: STP HRRR(5) FILE NAME: 10K018_wrk.dgn PROJECT LEADER: JLS DESIGNED BY: NLA WEYBRIDGE TRAFFIC SIGN SUMMARY SHEET				PLOT DATE: 17-SEP-2012 11:34 DRAWN BY: ITS CHECKED BY: JLS SHEET 46 OF 51			
							WEYBRIDGE SHEET TOTALS				SF 39.50	SF	EA 6		EA 5 4	EA 9	FT 135		EA	LB								

TRAFFIC SIGN SUMMARY SHEET 1 - TOWN TOTALS

DIRECTION	MILEMARKER, STATION, OR SIGN NUMBER	LOCATION	MANUAL ON UNIFORM TRAFFIC DEVICES OR STATE CODE	SIGN DIMENSIONS		SHEETING REMARKS	SIGN LEGEND	NEW SIGNS		EXISTING SIGNS				EXISTING POST		NO. OF NEW POSTS	SQUARE STEEL (in)			FOUNDATION	TUBULAR STEEL 0/(in)				SIGN FRAME REQUIRED	REMARKS SHS = STANDARD HIGHWAY SIGN BOOK	SIGN DETAIL		
				WIDTH	HEIGHT			RETAIN	SALVAGE FROM	SALVAGE TO	REMOVE	RETAIN	REMOVE	1.75	2.00		2.50	3.00	3.50		4.00	5.00	DETAIL IN SHS	DETAIL ON SHEET NUMBER			STANDARD SHEET NUMBER		
														lb/ft			lb/ft												
														1.88	2.42		3.35	7.60	9.00		10.80	14.60							
							ENOSBURG TOTAL TSS SHEET	186.30 181.719					29 28		24 36		540 480.5												
							FERRISBURGH TOTAL TSS SHEET	277.16 282.16					23 25		16 54		810 754.5												
							NEW HAVEN TOTAL TSS SHEET	171.21		3			18 19	2	18	54	176	480 633											
							NORTHFIELD TOTAL TSS SHEET	87.25					13		10	22	56	225 280											
							RICHMOND TOTAL TSS SHEET	585.09		5			77 82	4	54	15	160	1425 1487											
							ST. ALBANS TOWN TOTAL TSS SHEET	148.25 159.5		6			36 33	6	31	32	48	390 403.5											
							WEYBRIDGE TOTAL TSS SHEET	39.50		2			4		5	9		135 121											
													</																

TOWN/STATE HIGHWAY INVENTORY FOR PAVING MARKINGS

* NOTE ALL LOCATIONS ARE MEASURED FROM THE CENTER OF THE INTERSECTING ROADWAYS FOR THAT INTERSECTION AND ARE APPROXIMATE. FIELD VERIFY BEFORE INSTALLING OR AS DIRECTED BY THE ENGINEER.

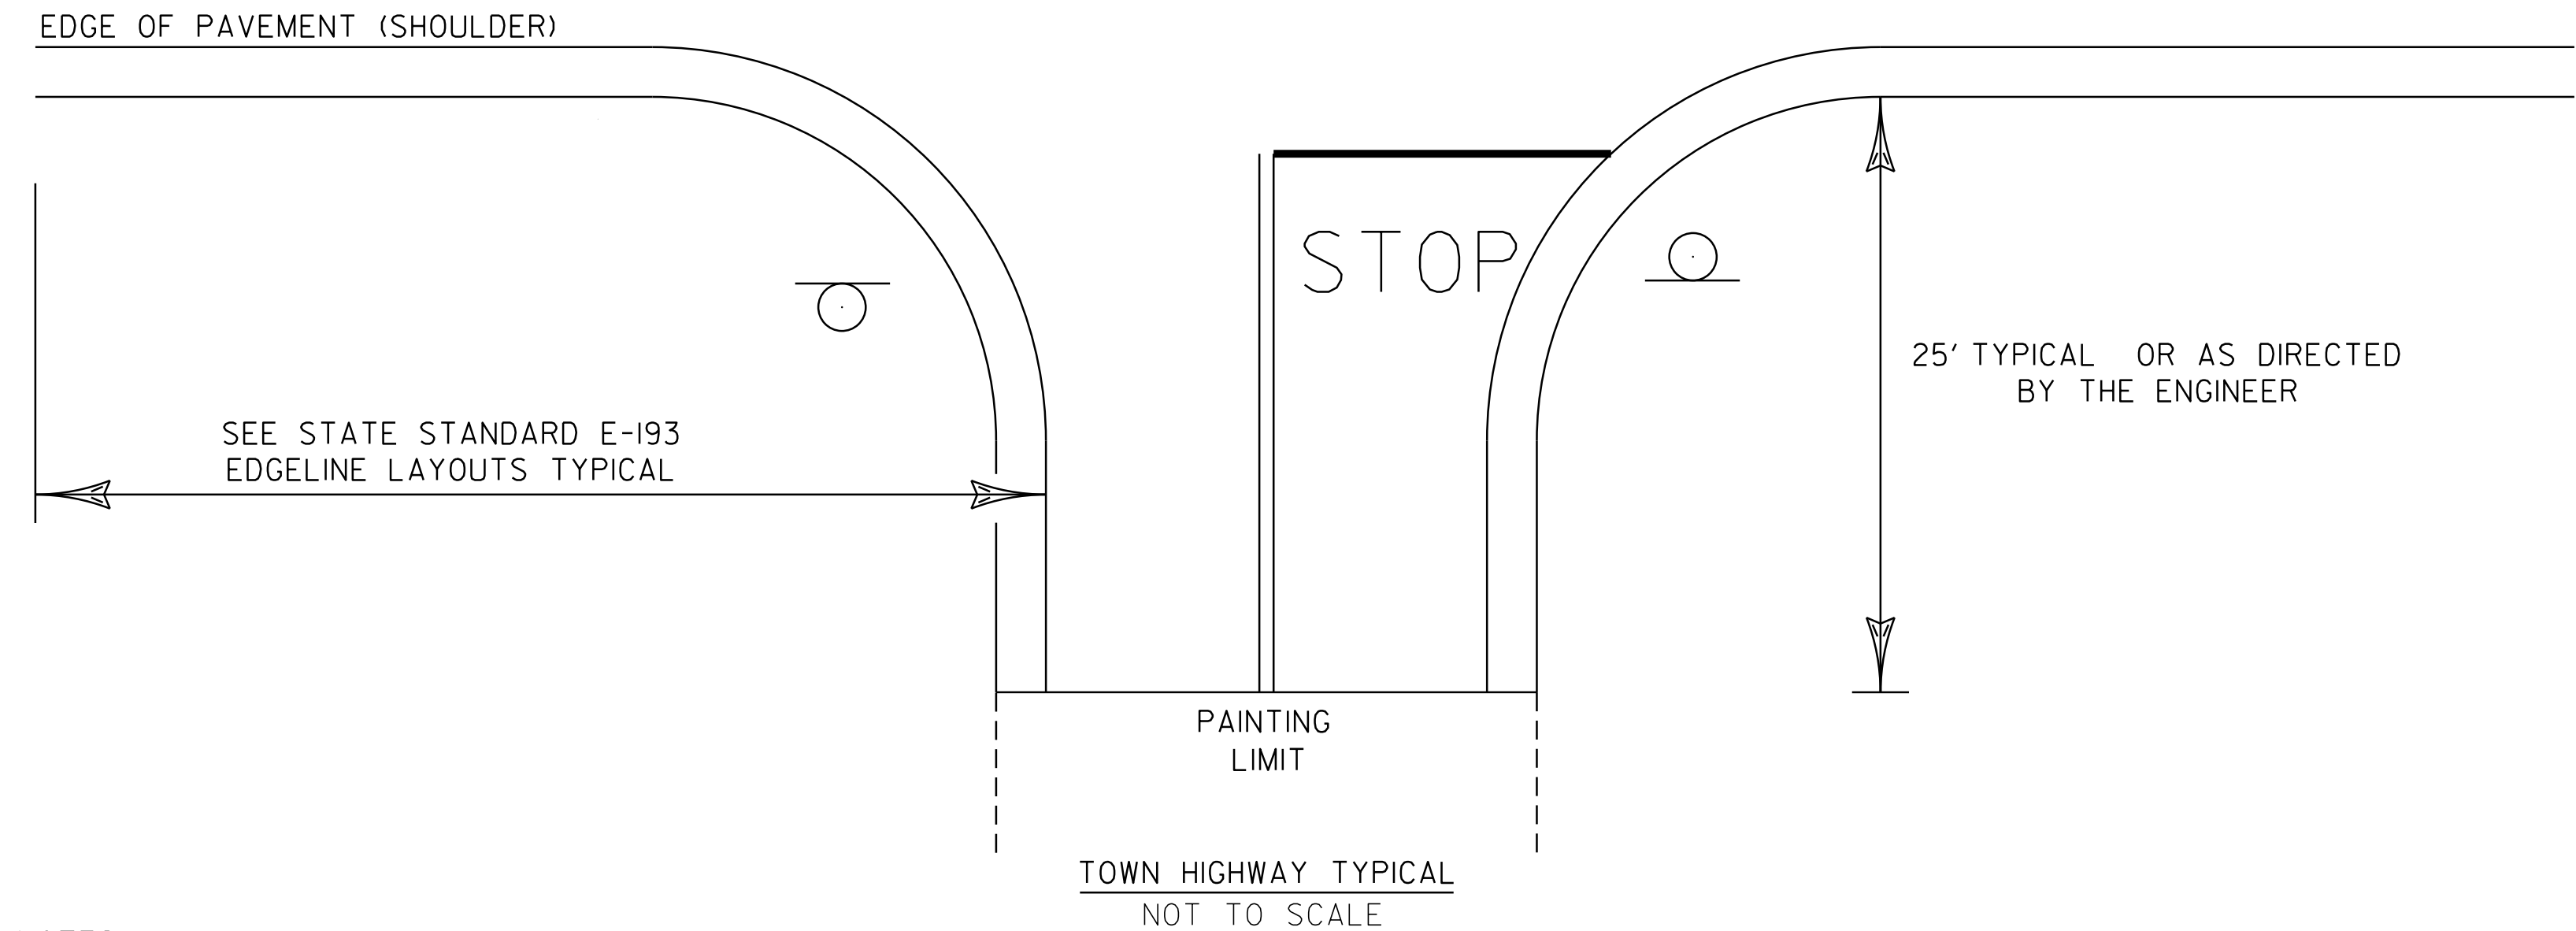[illegible]



NOTES:

- 1.) SEE STD E-121 FOR THE PLACEMENT OF STOP AND LEGAL LOAD LIMIT SIGNS.
- 2.) SEE STD E-193 FOR THE PLACEMENT OF CENTERLINE, EDGELINE, STOP BARS, AND STOP LETTERS.

TOWN HIGHWAY PAVEMENT MARKINGS	PROJECT NAME: STATEWIDE NORTHWEST REGION	
	PROJECT NUMBER: STP HRRR(5)	
	FILE NAME: I0K0I8_wrk.dgn	PLOT DATE: 17-SEP-2012 11:51
	PROJECT LEADER: JLS	DRAWN BY: ITS
	DESIGNED BY: NLA	CHECKED BY: JLS
TOWN HIGHWAY PAVEMENT MARKINGS SHEET SHEET 48 OF 51		

BEGIN STATION	END STATION	POS.	203.28	203.30	525.10	525.41	525.60	621.20	621.206	621.215	621.60	621.80	621.95	653.20	676.10	676.12	TERMINAL END SECTIONS	REMARKS
			EXCAVATION OF SURFACES AND PAVEMENTS	EARTH BORROW	REMOVAL OF EXISTING RAILING	BRIDGE RAILING, GALV HD STEEL BEAM/FASCIA MOUNTED	BRIDGE RAILING REPAIR, TYPE III	STEEL BEAM GUARDRAIL GALVANIZED	STEEL BEAM GUARDRAIL GALVANIZED NESTED	HD STEEL BEAM GUARDRAIL GALV/W 8' POST	ANCHOR FOR STEEL BEAM RAIL	REMOVE AND DISPOSE OF GUARDRAIL	REMOVE AND RESET TEMPORARY TRAFFIC BARRIER	TEMPORARY EROSION MATTING	TYPE I DELINEATOR WITH STEEL POST	REMOVAL OF EXISTING DELINEATOR		
			CY	CY	LF	LF	LF	LF	LF	LF	EACH	LF	LF	SY	EACH	EACH		
RICHMOND			SEE BOOKS FOR LOCATION					439.5			1		75				1	
HUNTINGTON RD								39.5			1		75				1	
MM 0.720	MM 0.731	RT		25.0 10				14.5			1	2.0		25.0 0			1	INSTALL G1-D APPROACH SECTION. TIE INTO EXISTING GUARDRAIL.
				10				12.5									1	
MM 1.889	MM 1.940	LT		25.0 10				39.5 266.5			1	2.0	50	25.0 0			1	EXTEND EXISTING GUARDRAIL SOUTH OF BESAW RD. (STATE STANDARD G1-D)
				10				102			1							
MM 3.870	MM 3.890+26 FT	RT	10.0 0	50.0 10				125.0				14.5		56.5 0			1	INSTALL 125 FT OF GUARDRAIL. TIE INTO EXISTING GUARDRAIL FROM HINESBURG RD TO HUNTINGTON RD TO CLOSE RADIUS. SEE LOCATION DETAILS THIS SHEET AND STATE STANDARD G1-D. NOTE THAT THE 26 FT RT OF GUARDRAIL EXTENDS AROUND RADIUS ALONG HUNTINGTON ROAD.
								202			1							
ROUNDING																		
TOTAL				100.0 60.0				406.0 849.5			2 6	18.5 862.5	200	106.5 0				

CONCEPTUAL SKETCH
ALL DIMENSIONS AND
MEASUREMENTS
ARE APPROXIMATE

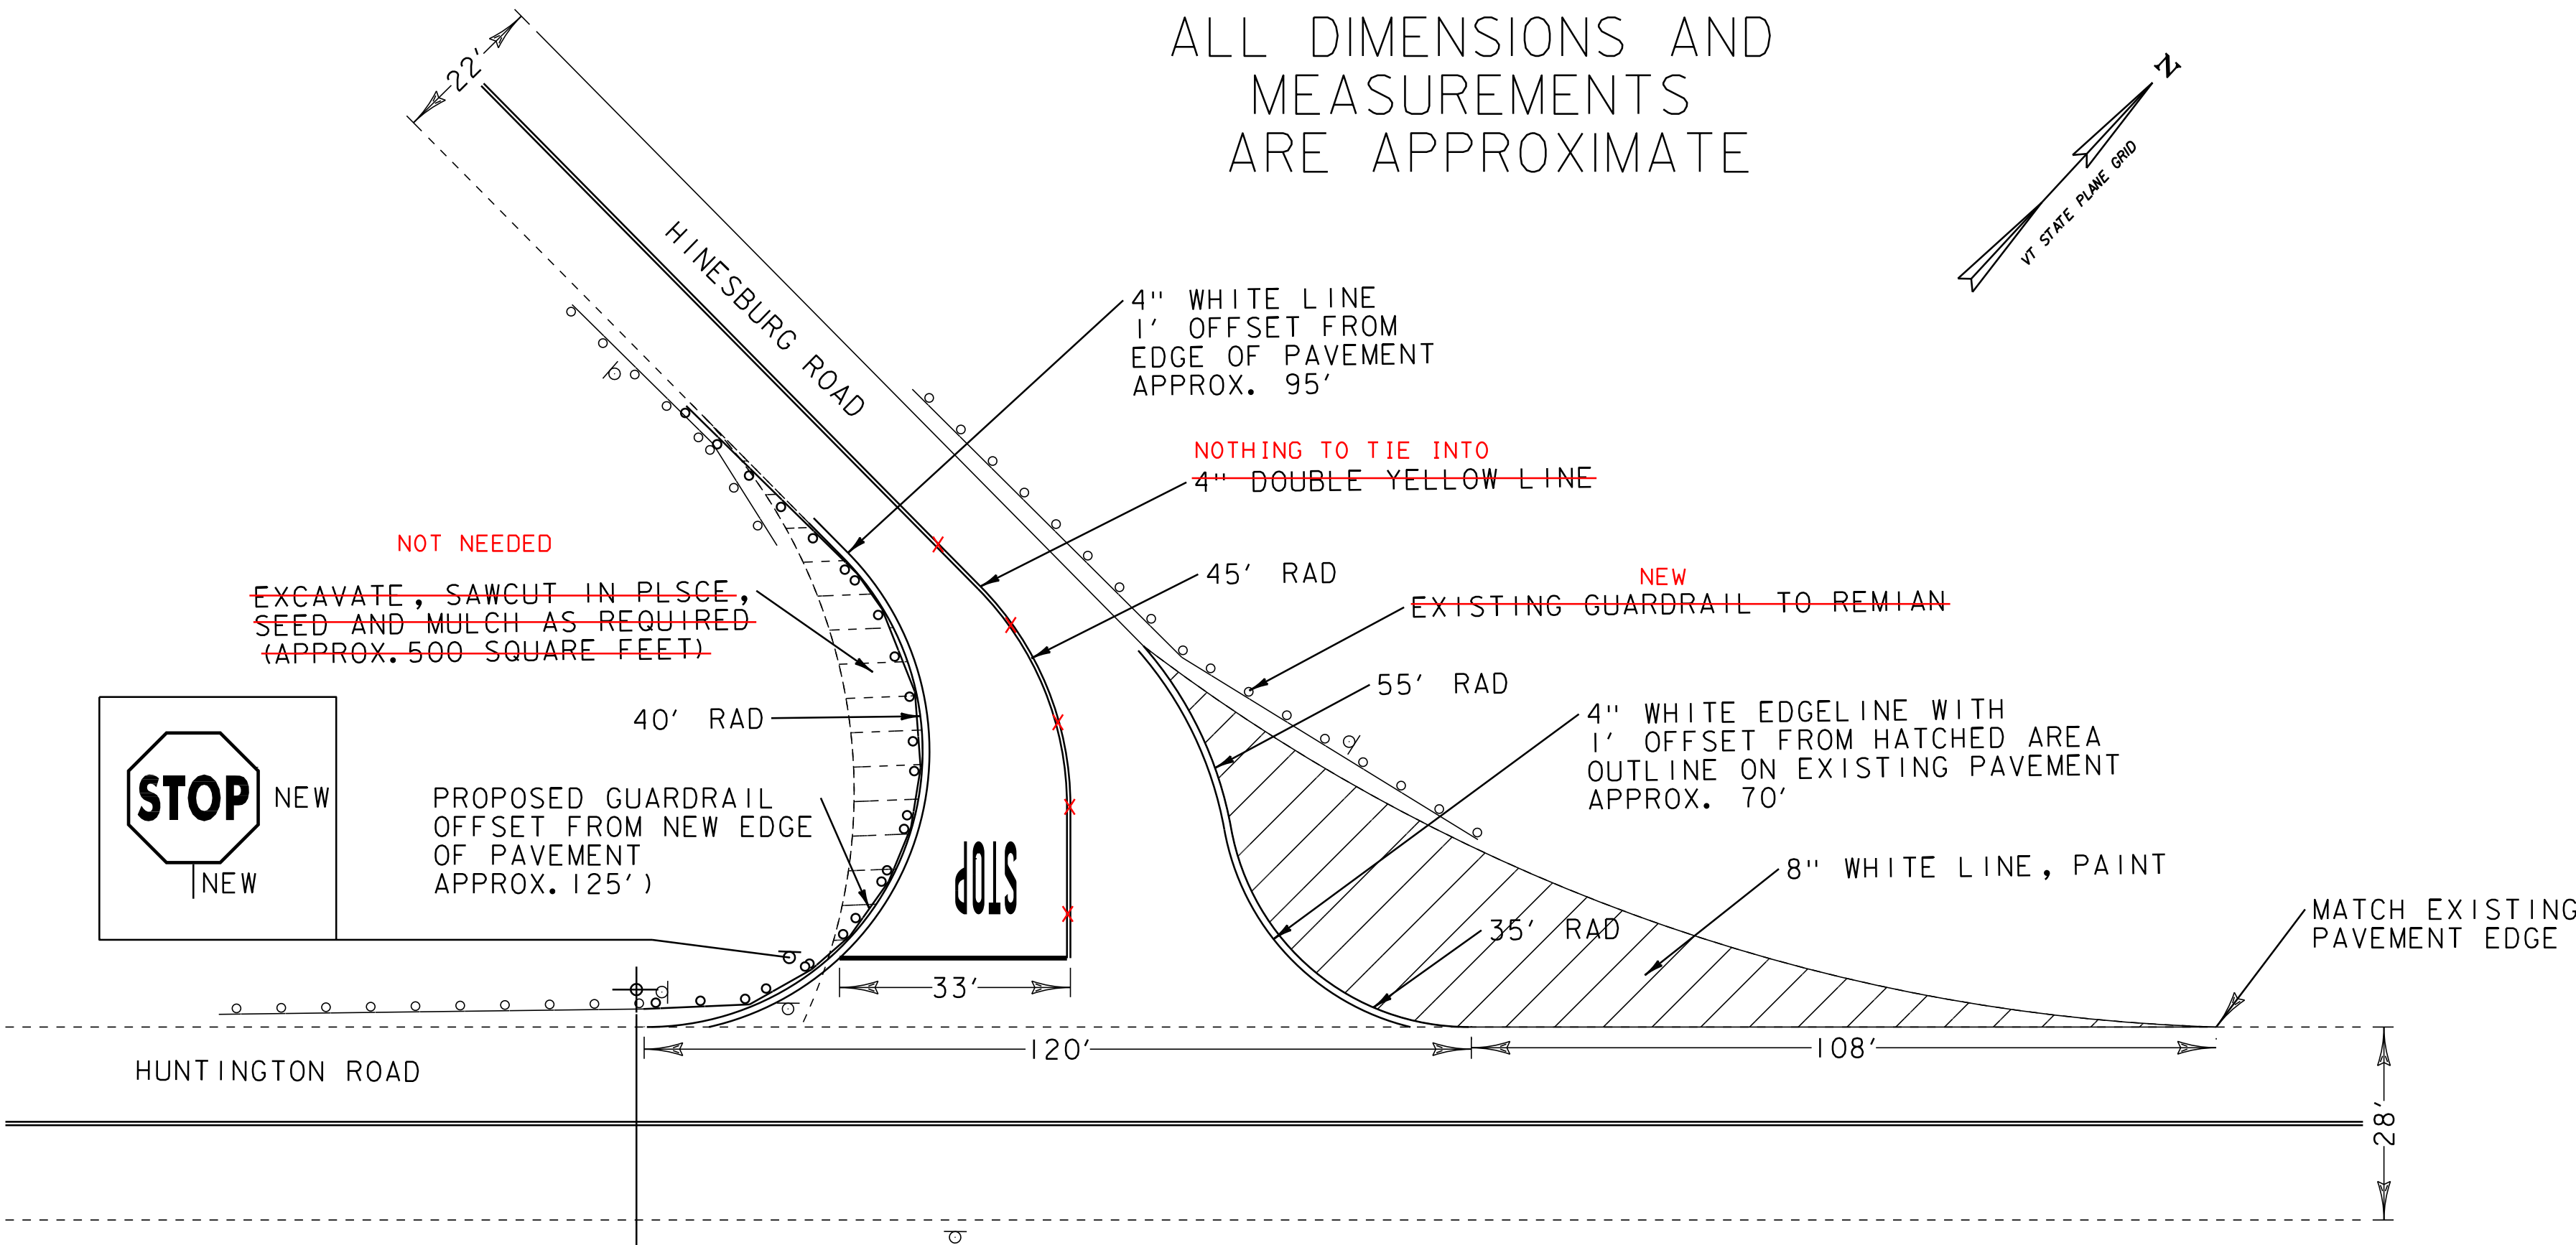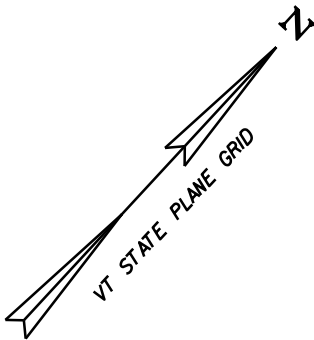

LOCATION DETAIL FOR
MM 3.870 TO MM 3.890 + 26 FT RT
NOT TO SCALE

ITEM
DETAIL
SUMMARY
SHEET

PROJECT NAME: STATEWIDE NORTHWEST REGION
PROJECT NUMBER: STP HRRR(5)

FILE NAME: I0K0I8_wrk.dgn
PROJECT LEADER: JLS
DESIGNED BY: NLA
ITEM DETAIL SUMMARY SHEET
PLOT DATE: 17-SEP-2012 11:34
DRAWN BY: ITS
CHECKED BY: JLS
SHEET 49 OF 51

Table 6H-2. Meaning of Symbols on Typical Application Diagrams	
	Arrow board
	Arrow board support or trailer (shown facing down)
	Changeable message sign or support trailer
	Channelizing device
	Crash cushion
	Direction of temporary traffic detour
	Direction of traffic
	Flagger
	High-level warning device (flag tree)
	Longitudinal channelizing device
	Luminaire
	Pavement markings that should be removed for a long-term project
	Shadow vehicle
	Sign (shown facing left)
	Surveyor
	Temporary barrier
	Temporary barrier with warning light
	Traffic or pedestrian signal
	Truck-mounted attenuator
	Type 3 barricade
	Warning light
	Work space
	Work vehicle

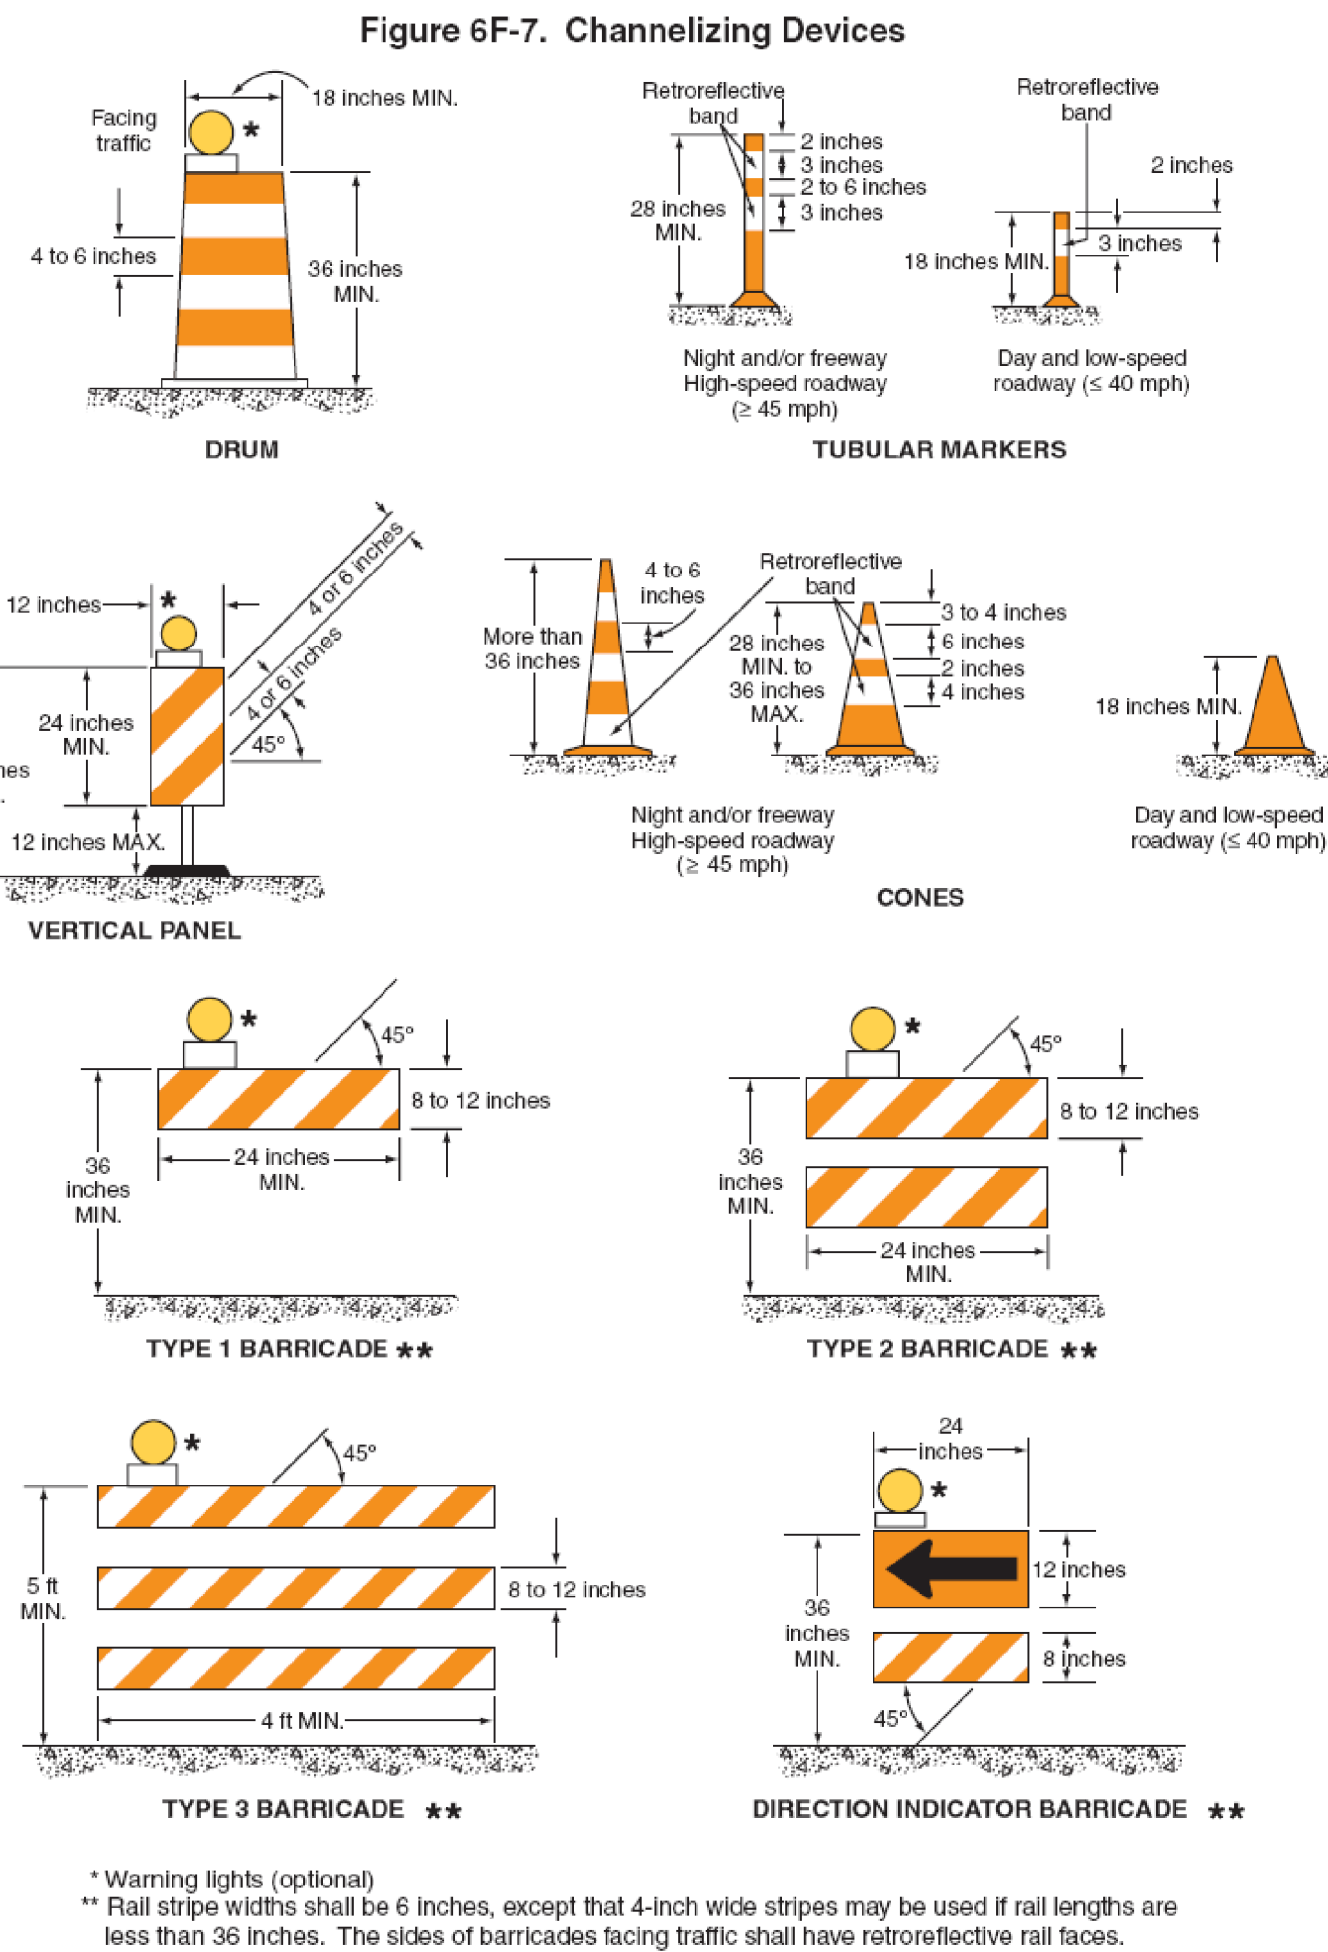
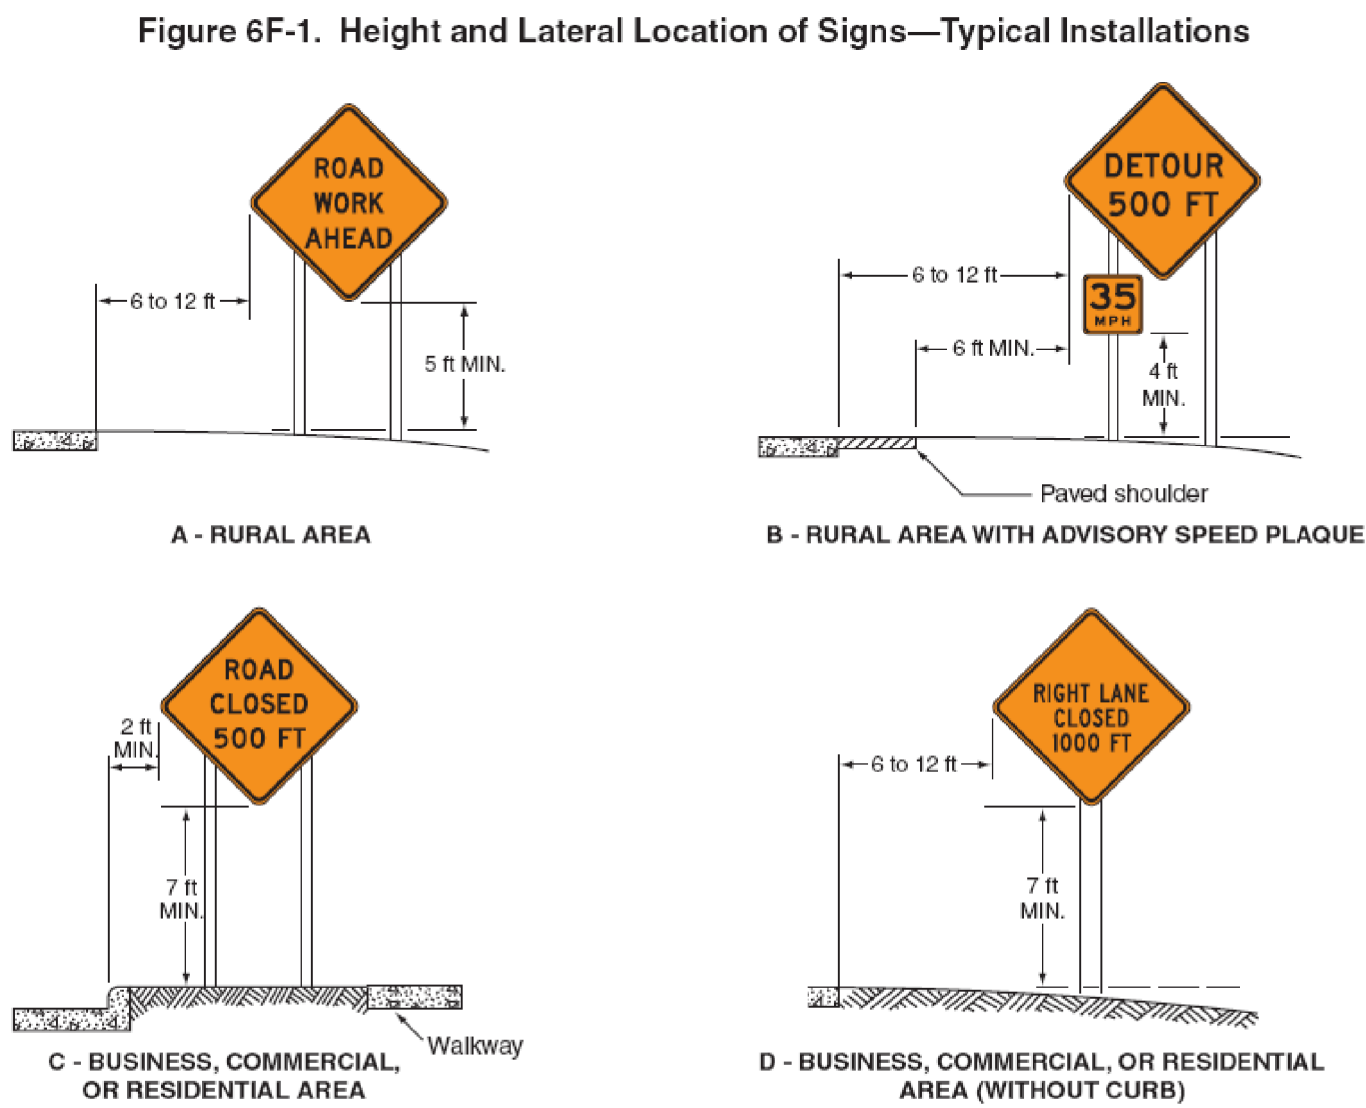
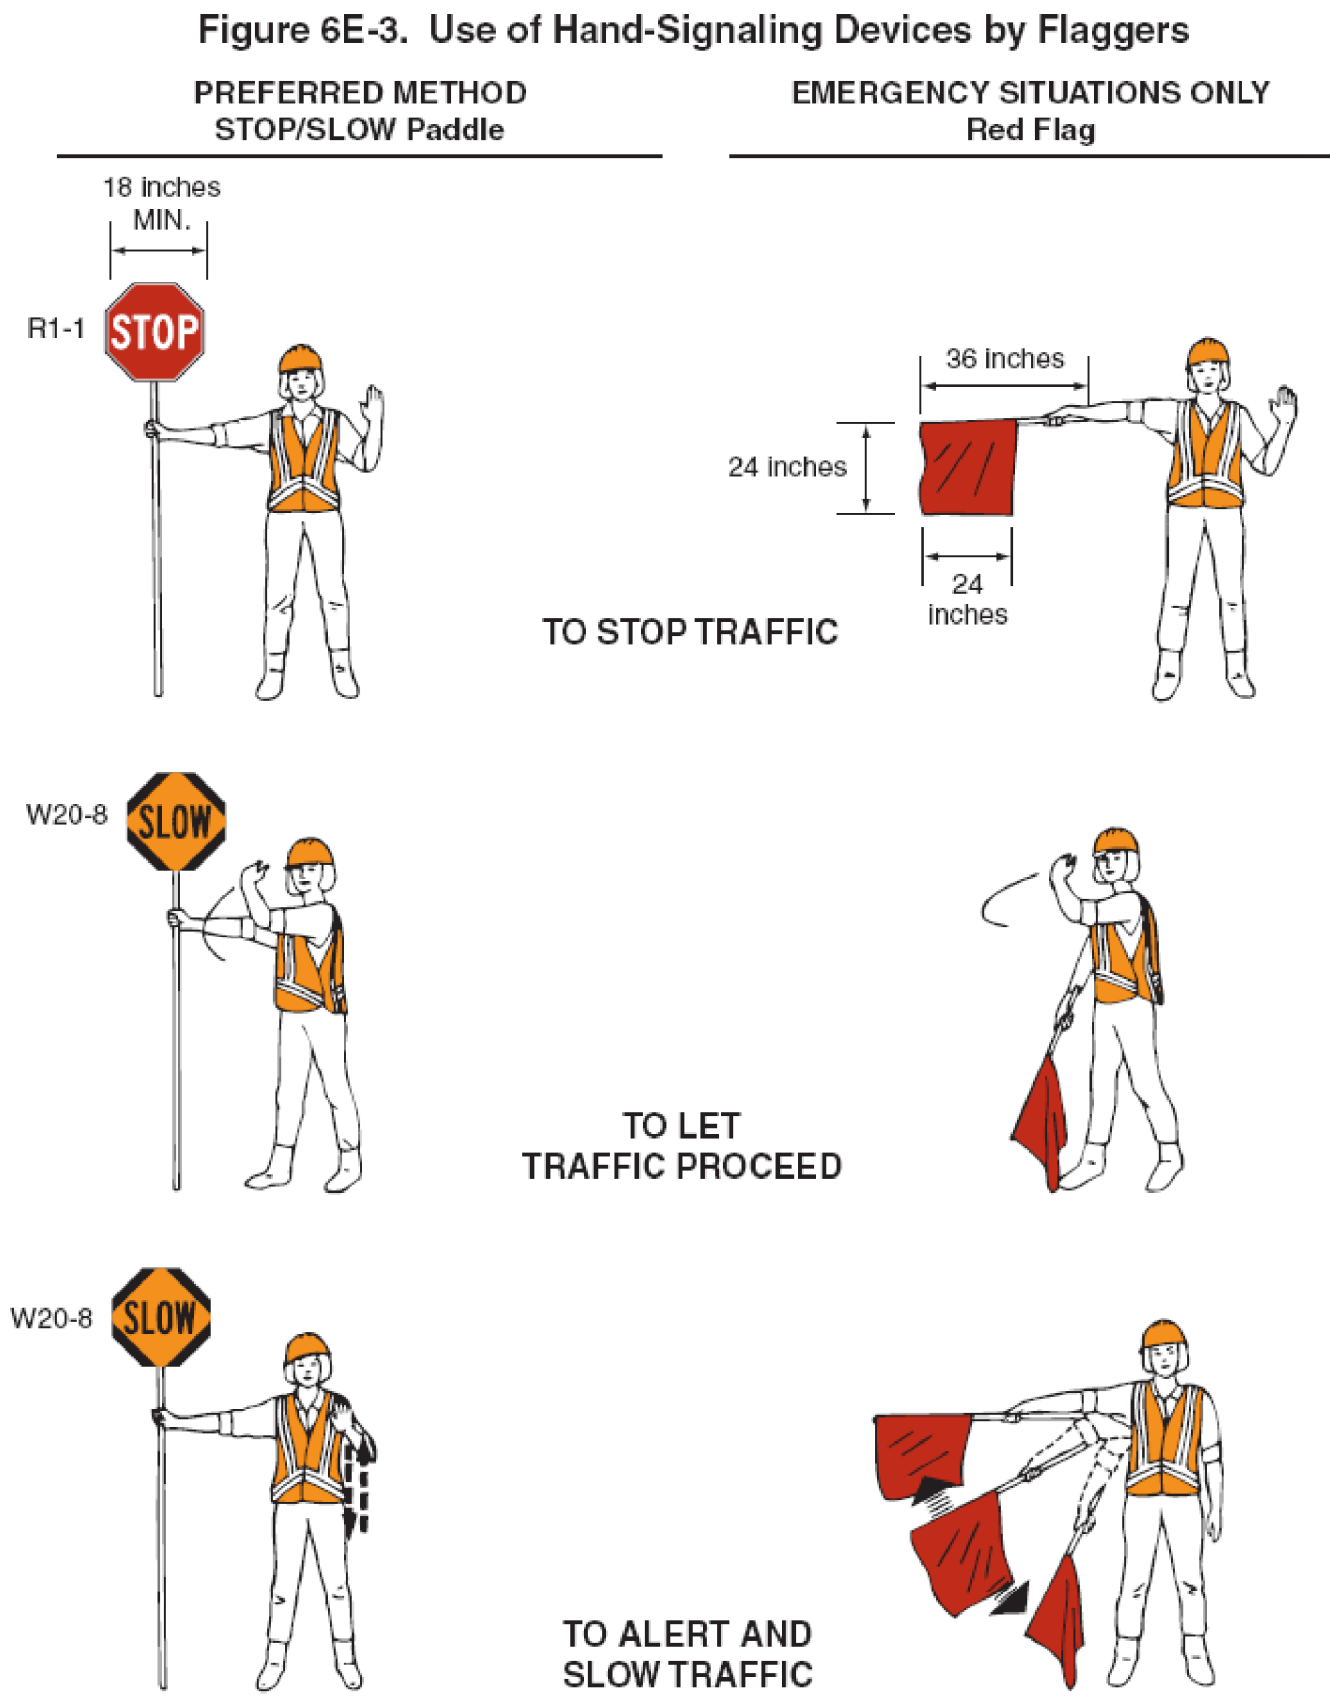


Table 6C-3. Taper Length Criteria for Temporary Traffic Control Zones

Type of Taper	Taper Length
Merging Taper	at least L
Shifting Taper	at least 0.5 L
Shoulder Taper	at least 0.33 L
One-Lane, Two-Way Traffic Taper	50 feet minimum, 100 feet maximum
Downstream Taper	50 feet minimum, 100 feet maximum

Note: Use Table 6C-4 to calculate L

Table 6C-4. Formulas for Determining Taper Length

Speed (S)	Taper Length (L) in feet
40 mph or less	$L = \frac{WS^2}{60}$
45 mph or more	$L = WS$

Where: L = taper length in feet
W = width of offset in feet
S = posted speed limit, or off-peak 85th-percentile speed prior to work starting, or the anticipated operating speed in mph

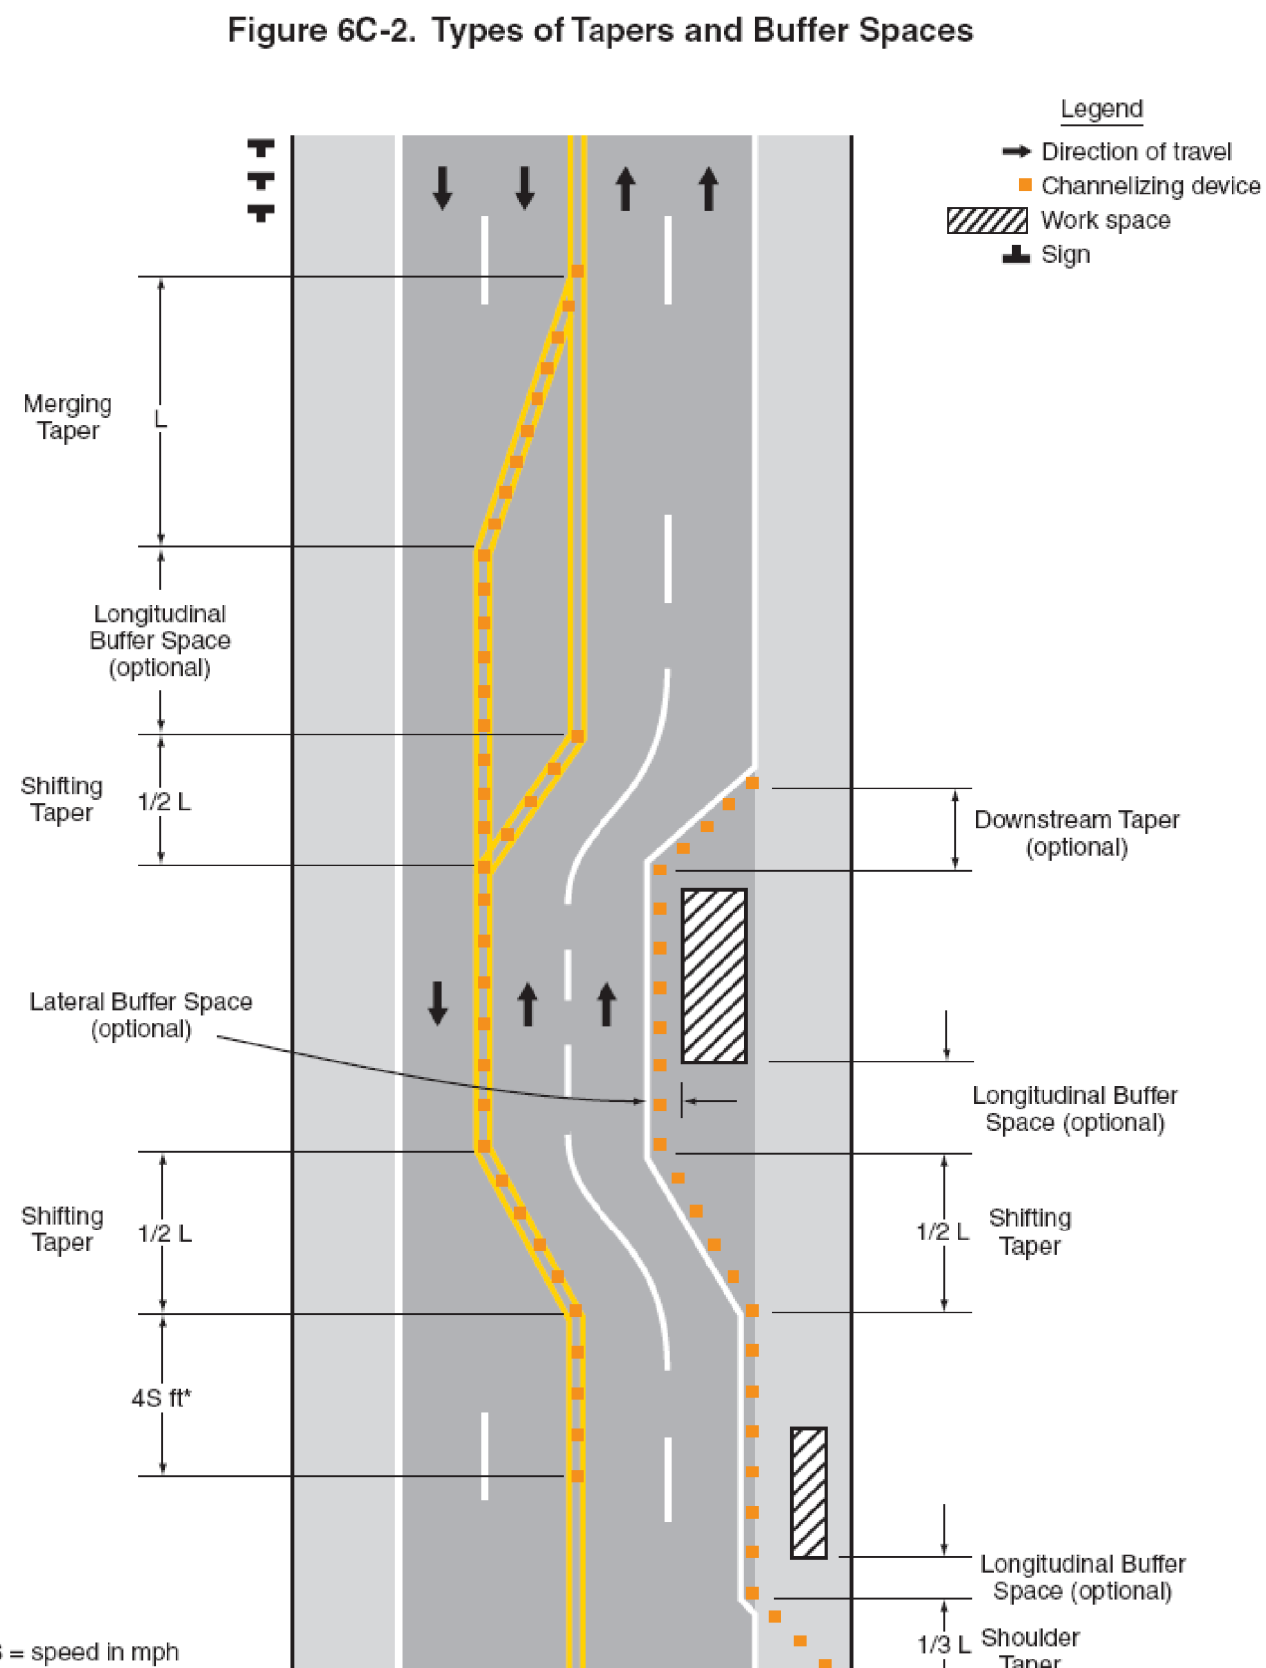


Figure 6H-1. Work Beyond the Shoulder (TA-1)

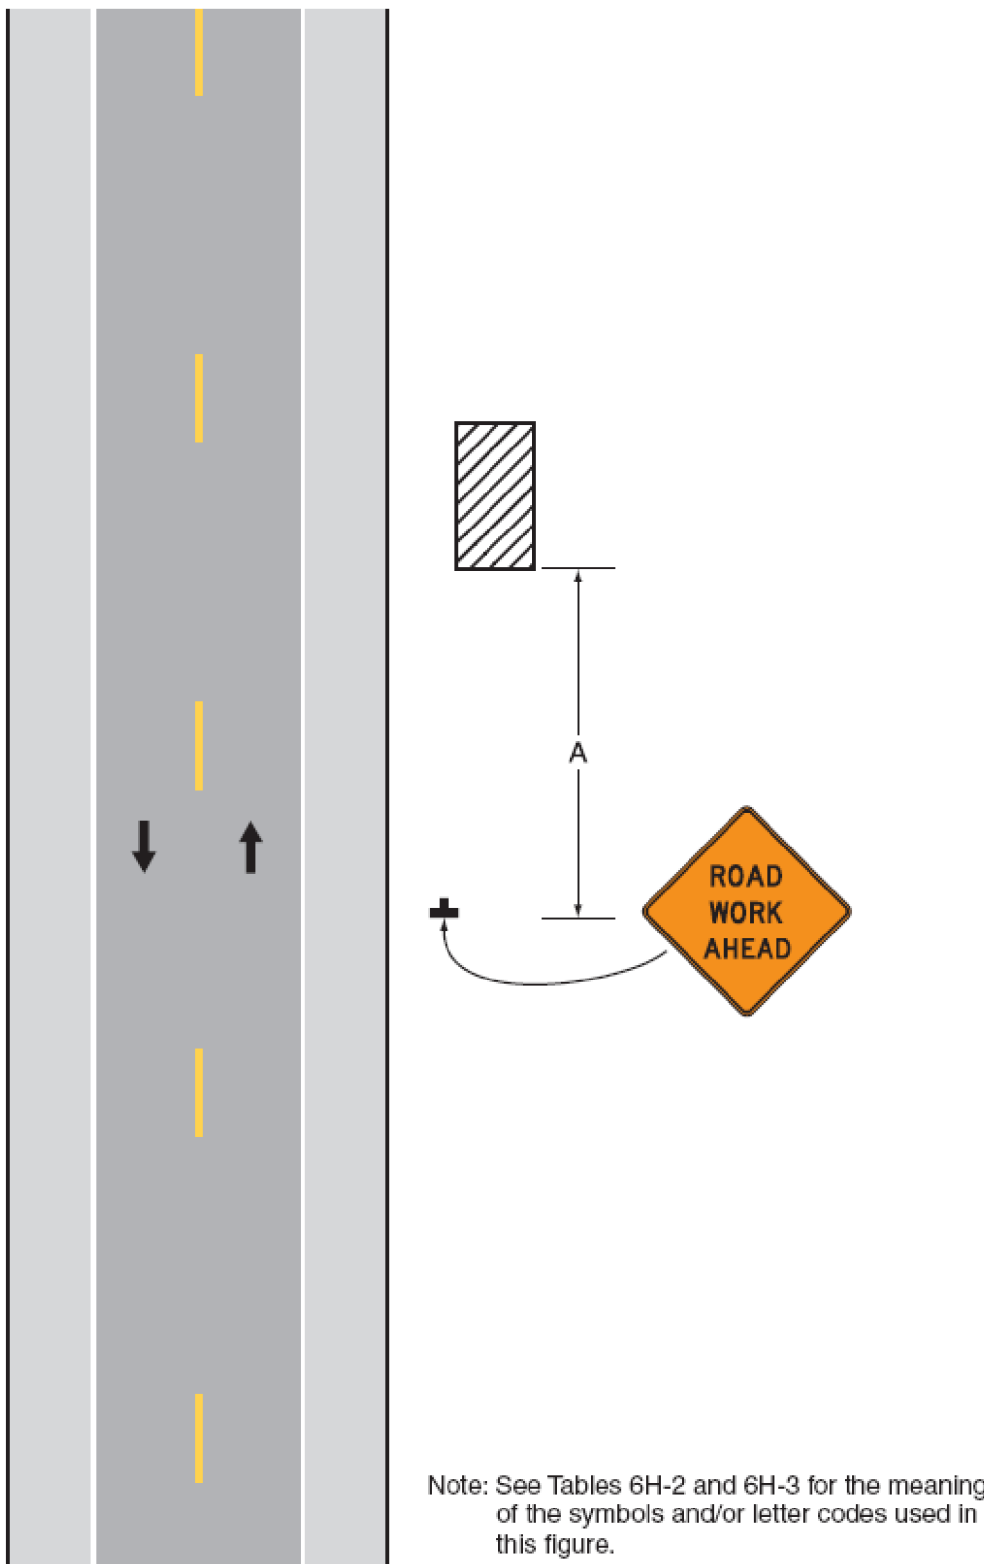


Table 6H-3. Meaning of Letter Codes on Typical Application Diagrams

Road Type	Distance Between Signs**		
	A	B	C
Urban (low speed)*	100 feet	100 feet	100 feet
Urban (high speed)*	350 feet	350 feet	350 feet
Rural	500 feet	500 feet	500 feet
Expressway / Freeway	1,000 feet	1,500 feet	2,640 feet

* Speed category to be determined by highway agency
** The column headings A, B, and C are the dimensions shown in Figures 6H-1 through 6H-46. The A dimension is the distance from the transition or point of restriction to the first sign. The B dimension is the distance between the first and second signs. The C dimension is the distance between the second and third signs. (The "first sign" is the sign in a three-sign series that is closest to the TTC zone. The "third sign" is the sign that is furthest upstream from the TTC zone.)

Table 6C-2. Stopping Sight Distance as a Function of Speed

Speed*	Distance
20 mph	115 feet
25 mph	155 feet
30 mph	200 feet
35 mph	250 feet
40 mph	305 feet
45 mph	360 feet
50 mph	425 feet
55 mph	495 feet
60 mph	570 feet
65 mph	645 feet
70 mph	730 feet
75 mph	820 feet

* Posted speed, off-peak 85th-percentile speed prior to work starting, or the anticipated operating speed

TEMPORARY TRAFFIC CONTROL NOTES


- ALL TEMPORARY TRAFFIC CONTROL SHALL BE IN ACCORDANCE WITH THESE PROJECT PLANS, APPLICABLE VTRANS E-SERIES STANDARD DRAWINGS, AND THE MANUAL ON UNIFORM TRAFFIC CONTROL DEVICES (MUTCD), DATED 2009, AND ITS LATEST REVISIONS, OR AS DIRECTED BY THE RESIDENT ENGINEER. IF THE CONTRACTOR DOES NOT WISH TO FOLLOW THE TEMPORARY TRAFFIC CONTROL PROVIDED, HE/SHE MAY SUBMIT AN ALTERNATE PROPOSAL AS STATED IN SECTION 641.02 GENERAL CONSTRUCTION REQUIREMENTS OF THE 2006 STANDARD SPECIFICATIONS.
- THE CONTRACTOR MUST PROVIDE ACCESS THROUGH THE WORK ZONE FOR EMERGENCY VEHICLES AT ALL TIMES.
- THE CONTRACTOR SHALL CONDUCT THE WORK AT ALL TIMES IN SUCH A MANNER AND IN SUCH SEQUENCE SO AS TO ENSURE THE LEAST INTERFERENCE WITH TRAFFIC OCCURS.
- SIGNS SHALL ONLY BE VISIBLE TO MOTORIST AT THE TIMES WHEN THE MESSAGE IS PERTINENT, I.E. A "FLAGGER AHEAD" SIGN SHALL ONLY BE VISIBLE TO MOTORIST WHEN THE FLAGGER IS ACTUALLY PRESENT PERFORMING THEIR DUTIES.
- PAYMENT FOR CONSTRUCTION SIGNING WILL BE MADE UNDER CONTRACT ITEM 641.10.

PROJECT NAME: STATEWIDE NORTHWEST REGION
PROJECT NUMBER: STP HRRR(5)

FILE NAME: I0K018_wrk.dgn
PROJECT LEADER: JLS
DESIGNED BY: NLA
TRAFFIC CONTROL SHEET 1


PLOT DATE: 17-SEP-2012 11:34
DRAWN BY: NLA
CHECKED BY: JLS
SHEET 50 OF 51

Figure 6H-3. Work on the Shoulders (TA-3)

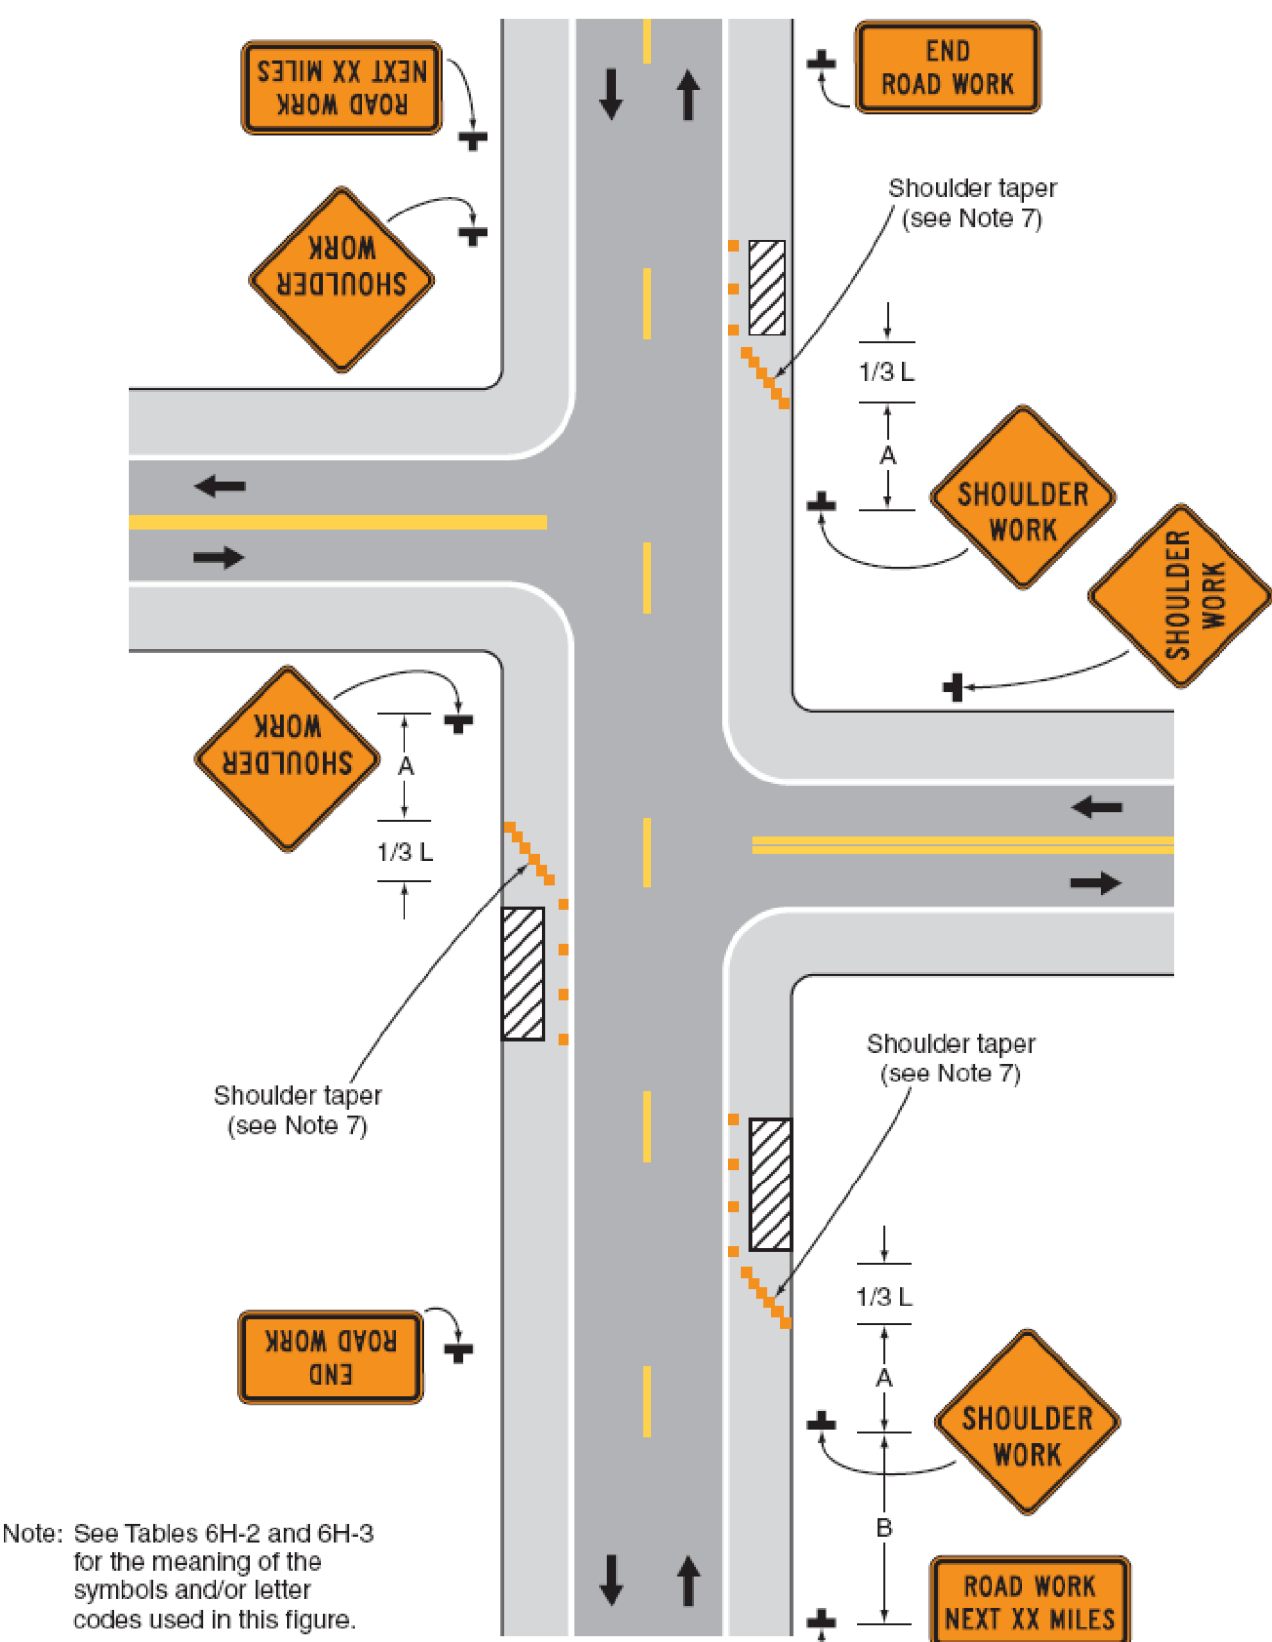


Typical Application 3

Figure 6H-4. Short-Duration or Mobile Operation on a Shoulder (TA-4)

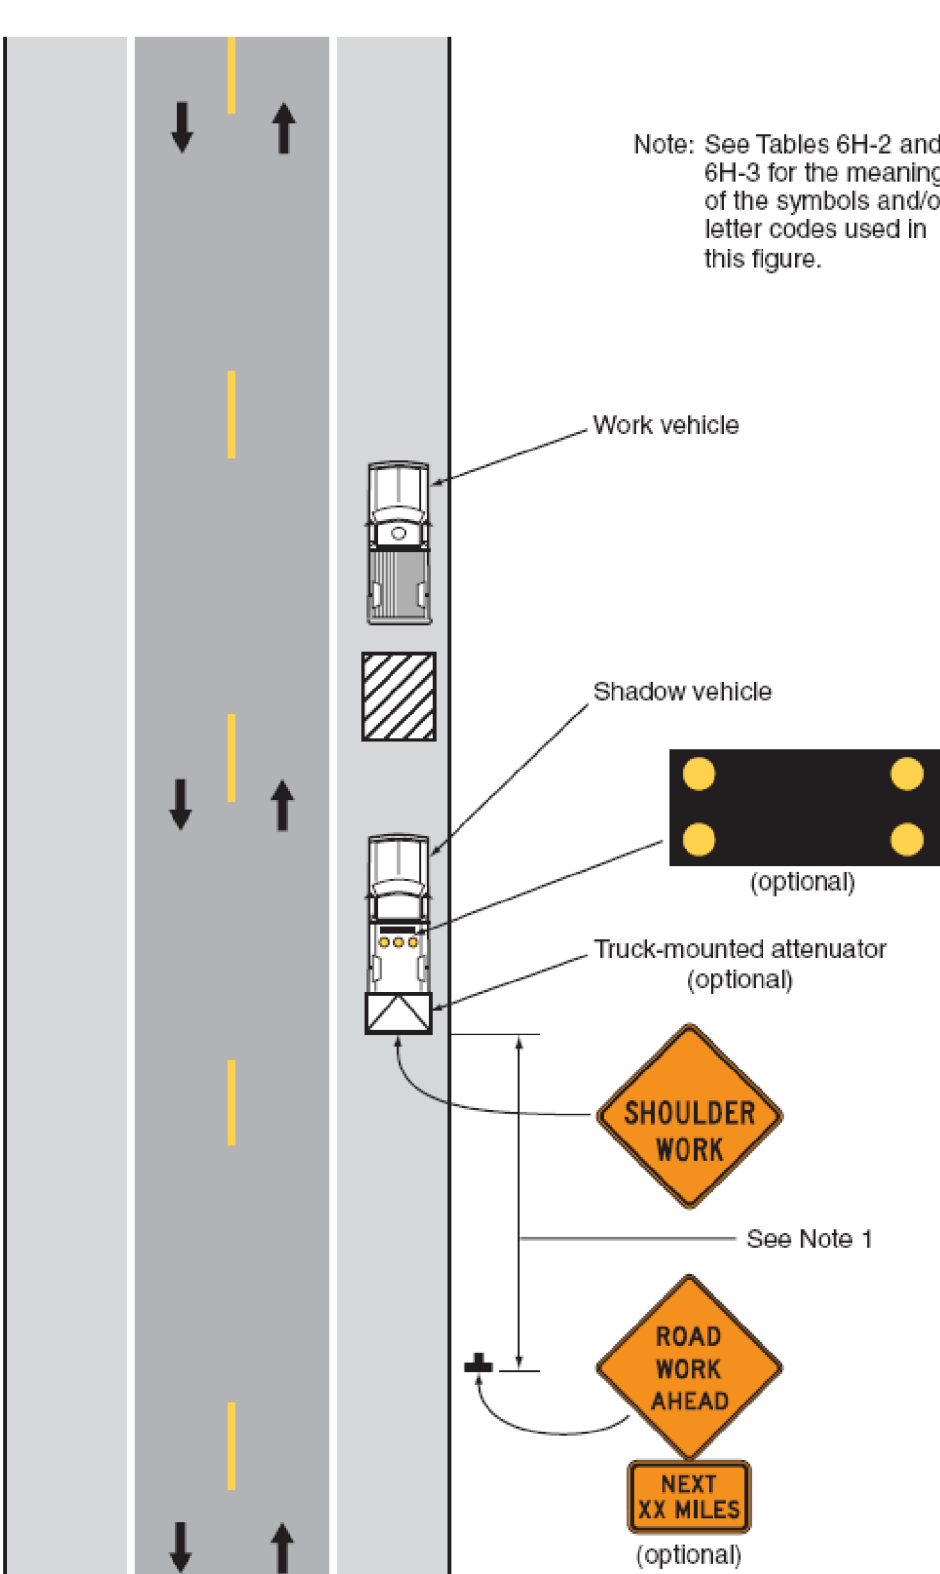


Typical Application 4

Figure 6H-6. Shoulder Work with Minor Encroachment (TA-6)

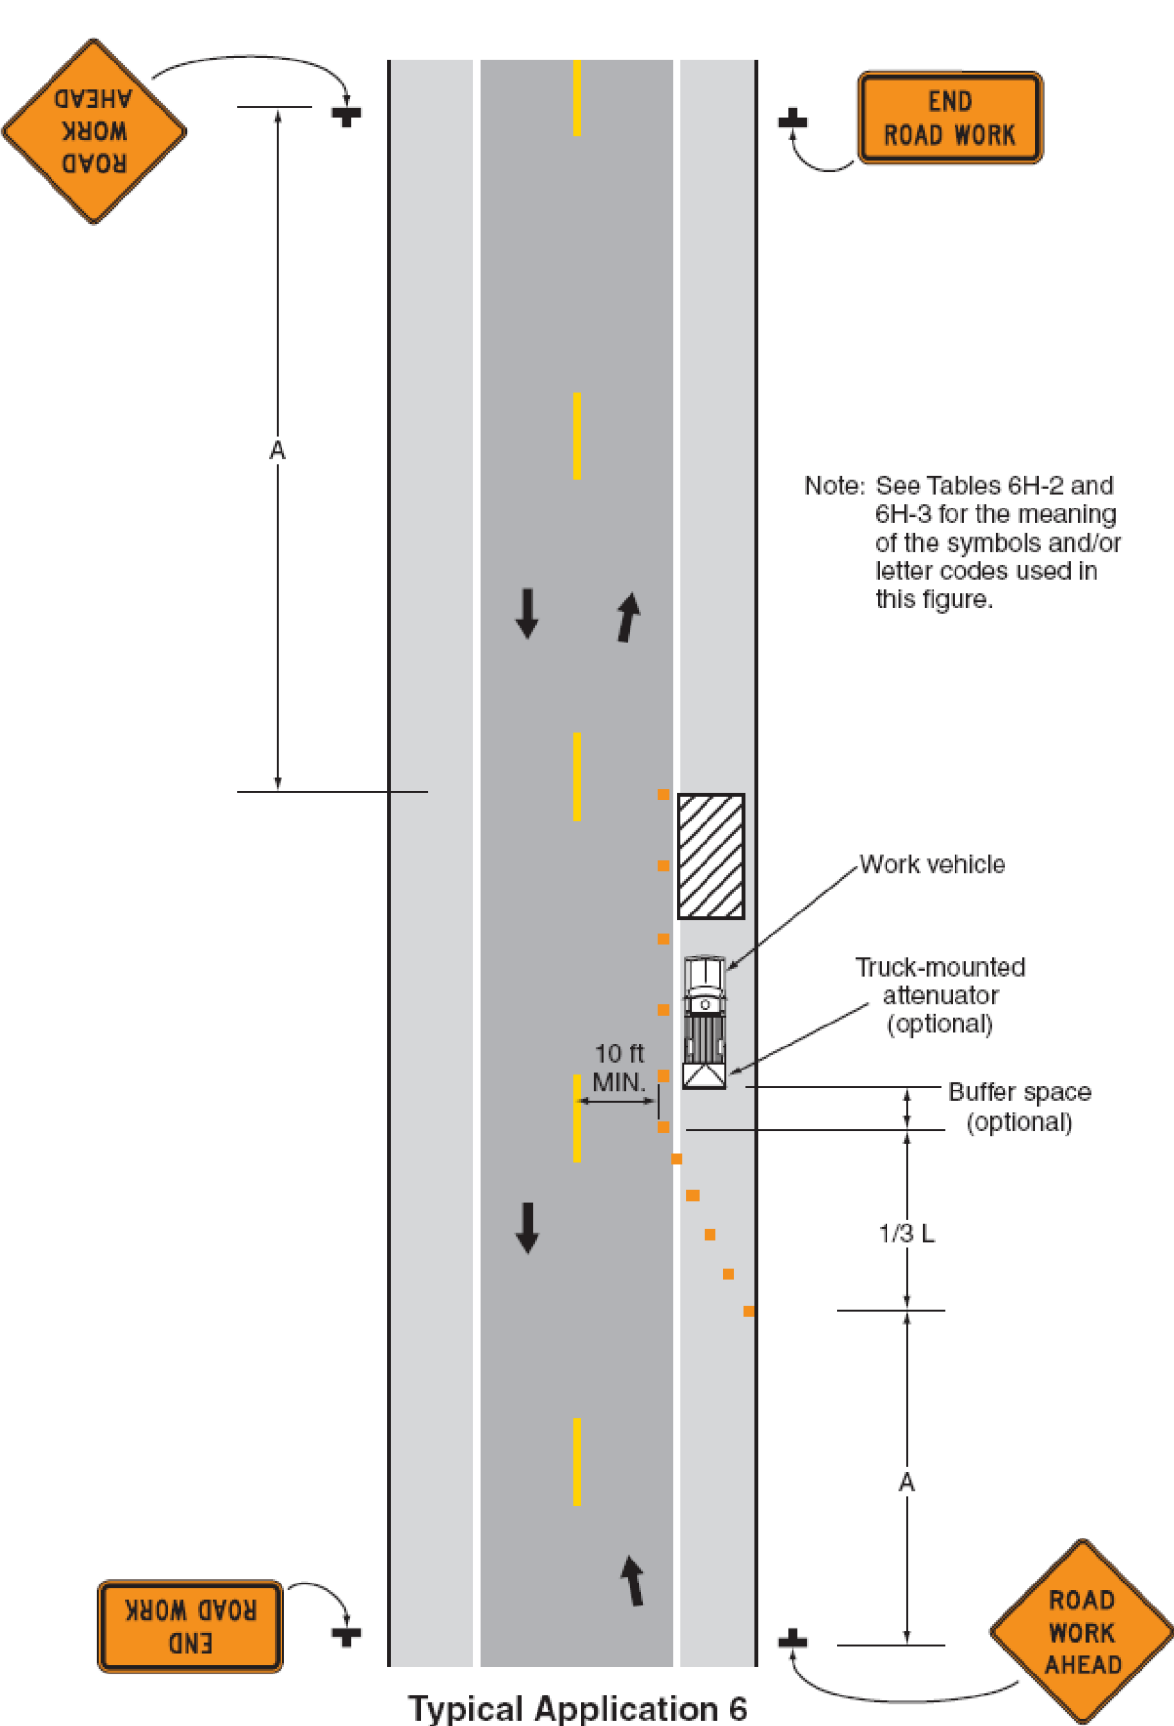

Typical Application 6

Figure 6H-10. Lane Closure on a Two-Lane Road Using Flaggers (TA-10)

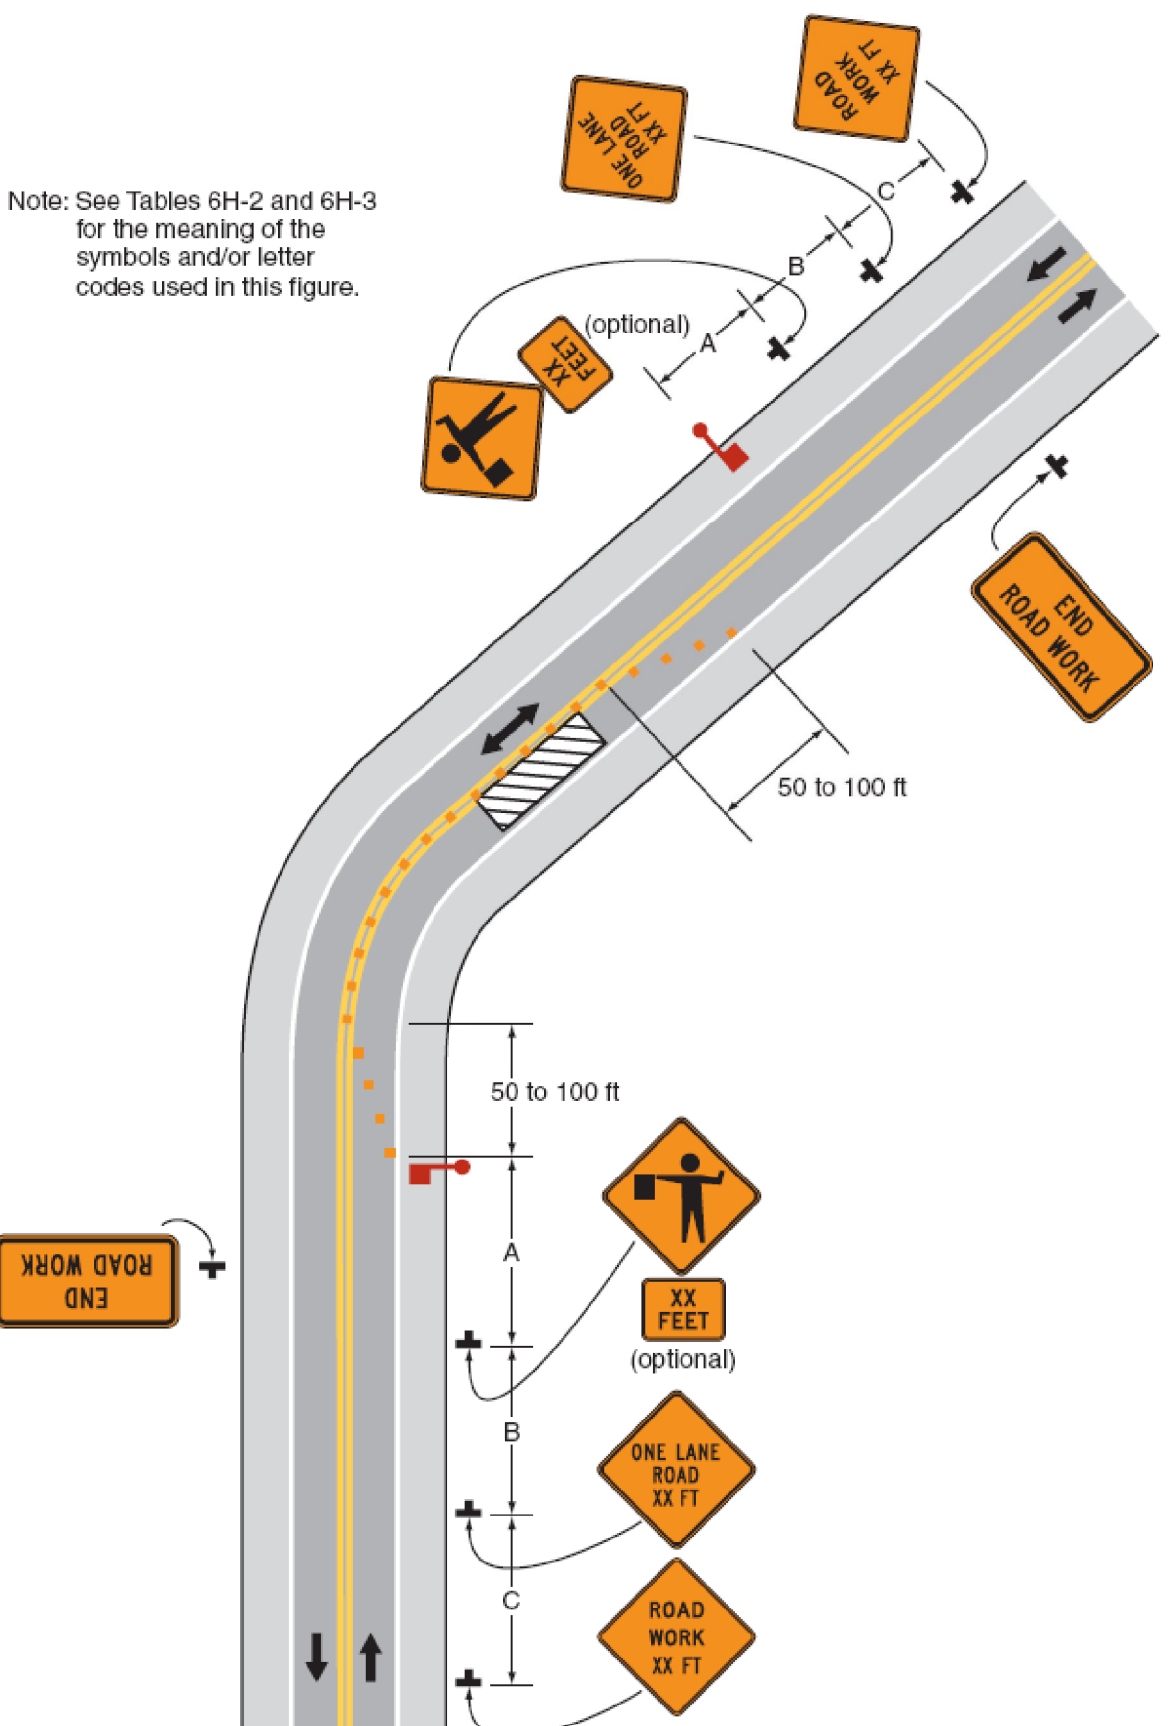

Typical Application 10