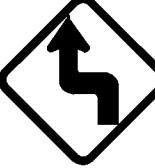


STATE OF VERMONT
AGENCY OF TRANSPORTATION

TRAFFIC SIGN SUMMARY SHEET 1 - NEWFANE

DIRECTION	MILEMARKER, STATION, OR SIGN NUMBER	LOCATION	MANUAL ON UNIFORM TRAFFIC DEVICES OR STATE CODE	SIGN DIMENSIONS		SHEETING REMARKS	SIGN LEGEND	NEW SIGNS		EXISTING SIGNS				EXISTING POST		NO. OF NEW POSTS	SQUARE STEEL (In)			TUBULAR STEEL 0/(In)				SIGN FRAME REQUIRED	REMARKS SHS = STANDARD HIGHWAY SIGN BOOK	SIGN DETAIL			
				WIDTH	HEIGHT			A	B	RETAIN	SALVAGE FROM	SALVAGE TO	REMOVE	RETAIN	REMOVE		1.75	2.00	2.50	FOUNDATION	3.00	3.50	4.00			5.00	DETAIL IN SHS	DETAIL ON SHEET NUMBER	STANDARD SHEET NUMBER
NB	MM 0.011, RT	A	RI-I	30	30			0 6.25		X			X	X	+		X		SIGN ALREADY REPLACED IN 200 AS PART OF NEWFANE-TOWNSHEND STP 240(K) PAVING PROJECT.					REMOVE SIGN AND POST AND INSTALL NEW SIGN AND POST AT THE SAME LOCATION	X				
SB	MM 0.033, LT	F	VR-017	24	30			0 5.00		X			X	X	+		X							INSTALL NEW SIGN AND POST 175 FT FROM THE CENTER OF THE VT 30 INTERSECTION		7			
NB	MM 0.039, RT TO MM 0.112, RT	A		6	8		(16) TYPE II - 6" X 8" WHITE DELINEATORS	5.33							8	X								INSTALL 8 DELINEATORS (16 TOTAL) BACK-TO-BACK 55 FT APART. INSTALL FIRST DELINEATOR BEGINNING AT THE END OF THE GUARDRAIL GOING TOWARDS VT 30)		7			
SB	MM 0.049, LT	F	R2-I	24	30					X				X										RETAIN SIGNS AND POST					
SB			TOWN SIGN	24	30					X														RETAIN SIGNS					
SB	MM 0.062, LT	F	WI-3L	30	30			6.25							1		X							INSTALL NEW SIGN AND POST 264 FT NORTH OF AND OPPOSITE THE NORTH END OF THE GUARDRAIL	X				
SB	MM 0.031, LT TO MM 0.104, LT	F E		6	8		(8) TYPE II - 6" X 8" WHITE DELINEATORS	2.67							4	X								INSTALL 4 DELINEATORS (8 TOTAL) BACK-TO-BACK 40 FT APART. INSTALL FIRST DELINEATOR BEGINNING 42 FT NORTH OF AND ACROSS FROM THE NORTH END OF THE GUARDRAIL.		7			
NB	MM 0.136, RT	B	WI-6R	48	24			8.00							2		X							INSTALL NEW SIGN ON 2-POSTS BEHIND THE GUARDRAIL, ABOUT 126 FT FROM THE NORTH END OF THE GUARDRAIL WITH THE ARROW POINTING SOUTH AND IN LINE WITH THE SOUTHBOUND DRIVERS' LINE OF SIGHT	X				
NB	MM 0.136, RT	A	WI-6L	48	24			8.00							2		X							INSTALL SIGN ON 2- POSTS BEHIND THE GUARDRAIL, ABOUT 126 FT FROM THE NORTH END OF THE GUARDRAIL WITH THE ARROW POINTING NORTH AND IN LINE WITH THE NORTHBOUND DRIVERS' LINE OF SIGHT	X				
NB	MM 0.184, RT	A	W5-2	30	30								X	X										REMOVE HAND PAINTED SIGN AND POST					
		A	WI-3L	30	30			6.25							1		X		ON 11-9-11 THIS POST WAS FOUND DAMAGED. THE CONTRACTOR INSTALLED A NEW POST.					REMOVE (PAINTED) NARROW ROAD SIGN AND POST AND INSTALL NEW REVERSE CURVE SIGN AND POST AT THE SAME LOCATION (ABOUT 100 FT SOUTH OF THE SOUTH END OF THE GUARDRAIL)	X				
NB	MM 0.184, RT TO MM 0.268, RT	A B		6	8		(20) TYPE II - 6" X 8" WHITE DELINEATORS	6.67							10	X								INSTALL 10 DELINEATORS (20 TOTAL) BACK-TO-BACK 55 FT APART ON THE RIVER SIDE OF THE ROAD. INSTALL FIRST DELINEATOR BEGINNING AT THE REMOVED NARROW ROAD SIGN EXTENDING SOUTH		7			
NB	MM 0.662, RT TO MM 0.755, RT	A B		6	8		(20) TYPE II - 6" X 8" WHITE DELINEATORS	6.67							10	X								INSTALL 10 DELINEATORS (20 TOTAL) BACK-TO-BACK 55 FT APART ON THE RIVER SIDE OF THE ROAD. INSTALL FIRST DELINEATOR BEGINNING 110 FT SOUTH OF POLE# NET/12-1/66/8-1 GOING NORTH		7			
SB	MM 0.713, LT TO MM 0.755, LT	F E		6	8		¹² (10) TYPE II - 6" X 8" WHITE DELINEATORS	4.00 3.33							5	X								INSTALL 56 DELINEATORS (10 TOTAL) BACK-TO-BACK 55 FT APART ON THE CEMETARY SIDE OF THE ROAD. INSTALL FIRST DELINEATOR BEGINNING 100 FT NORTH OF POLE# 60/12/66/8 GOING NORTH		7			
NB	MM 0.310, RT	A	R2-I	24	30					X				X										RETAIN SIGN AND POST					
SB	MM 0.330, LT	F	RI-I	30	30			6.25					X	X	1		X							REMOVE SIGN AND POST AND INSTALL NEW SIGN AND POST AT THE SAME LOCATION	X				
FINAL POST LENGTHS ARE TO BE DETERMINED IN THE FIELD. POST SIZES ARE COMPUTED BASED ON INFORMATION FURNISHED ON THE STANDARD SHEETS AND THE VTRANS "SIGN POST DESIGN GUIDE".									EA	EA	EA	EA	EA	EA		FT	FT	FT		LB	LB	LB	LB	PROJECT NAME: STATEWIDE SOUTHEAST REGION PROJECT NUMBER: STP HRRR(6) FILE NAME: IOK020_wrk.dgn PROJECT LEADER: JLS DESIGNED BY: NLA NEWFANE TRAFFIC SIGN SUMMARY I PLOT DATE: 04-JUN-2010 DRAWN BY: ITS CHECKED BY: JLS SHEET 17 OF 44					
							SHEET SUBTOTALS				SF 70.67 60.09	SF	EA 7			EA 6		EA 46	FT 431			EA	LB						