

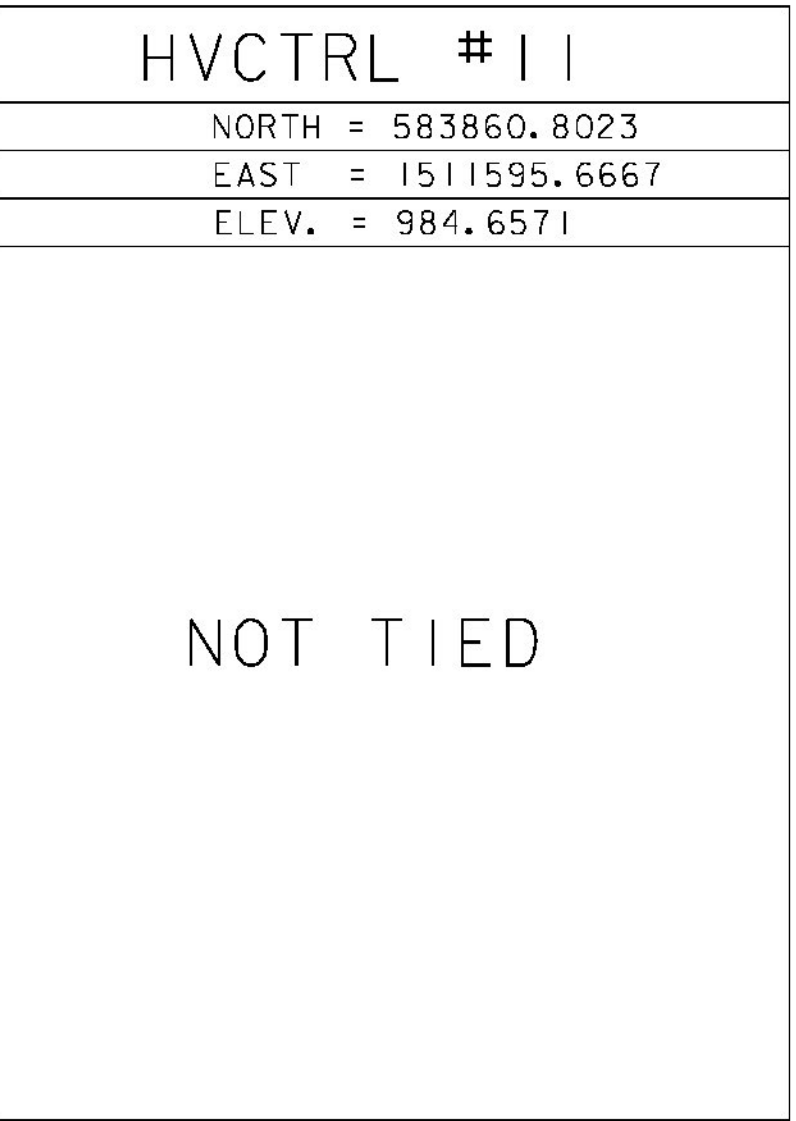
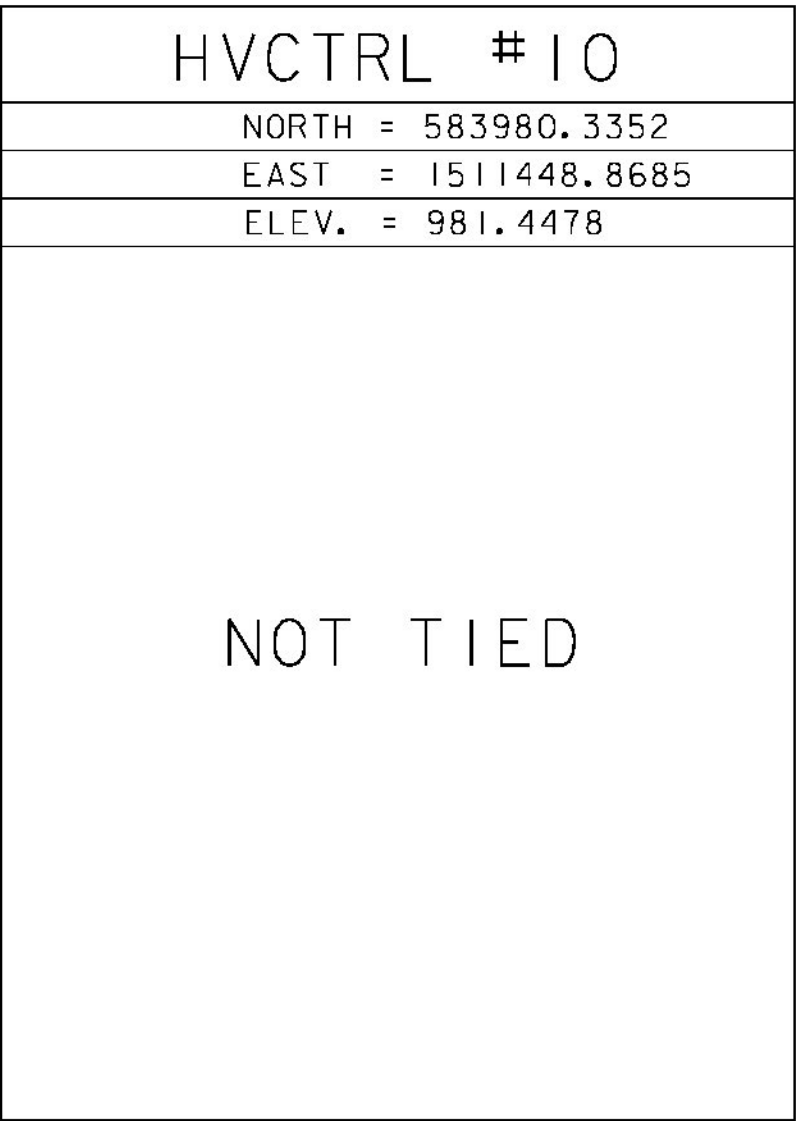
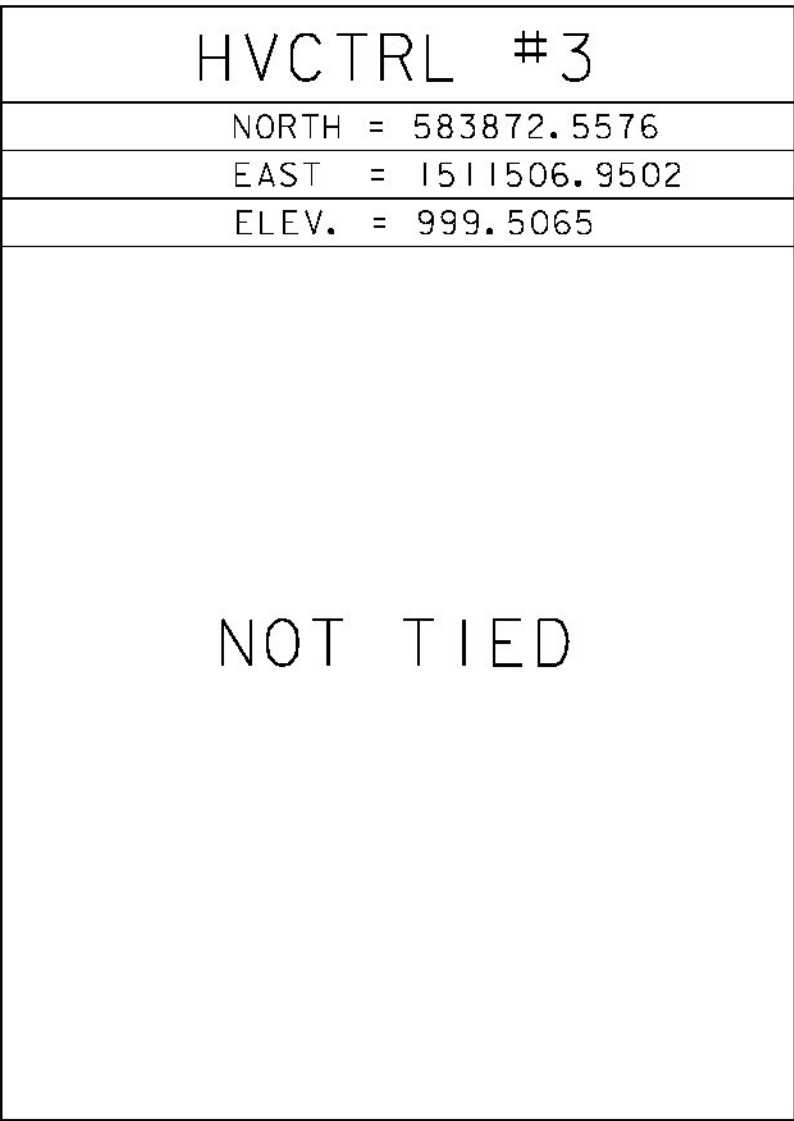
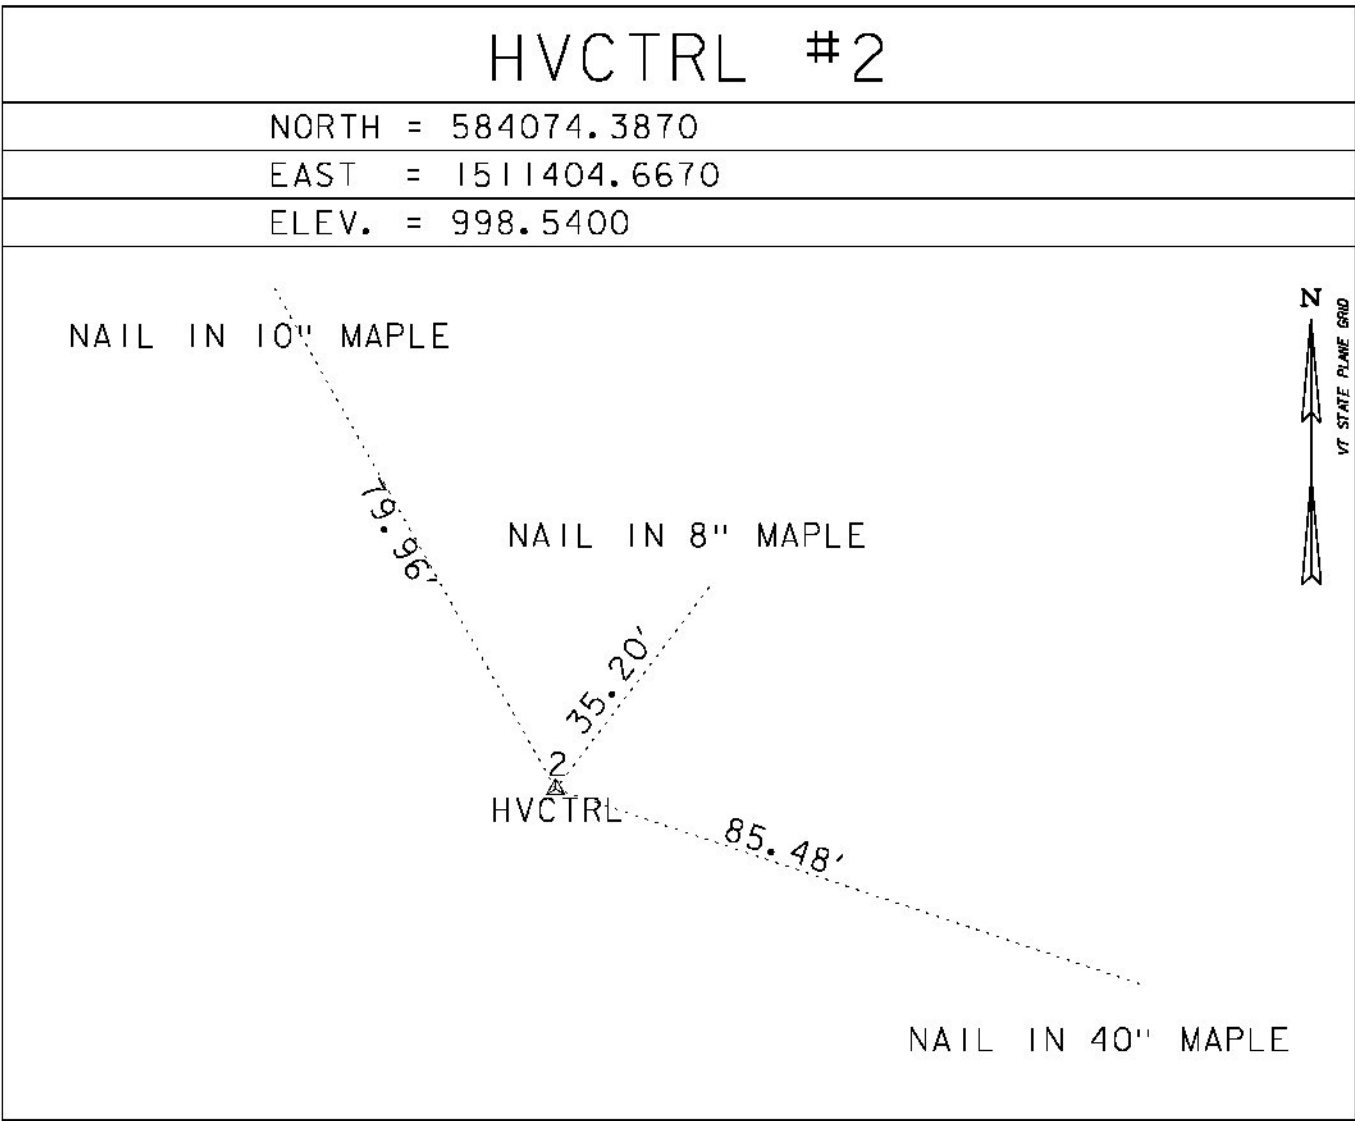
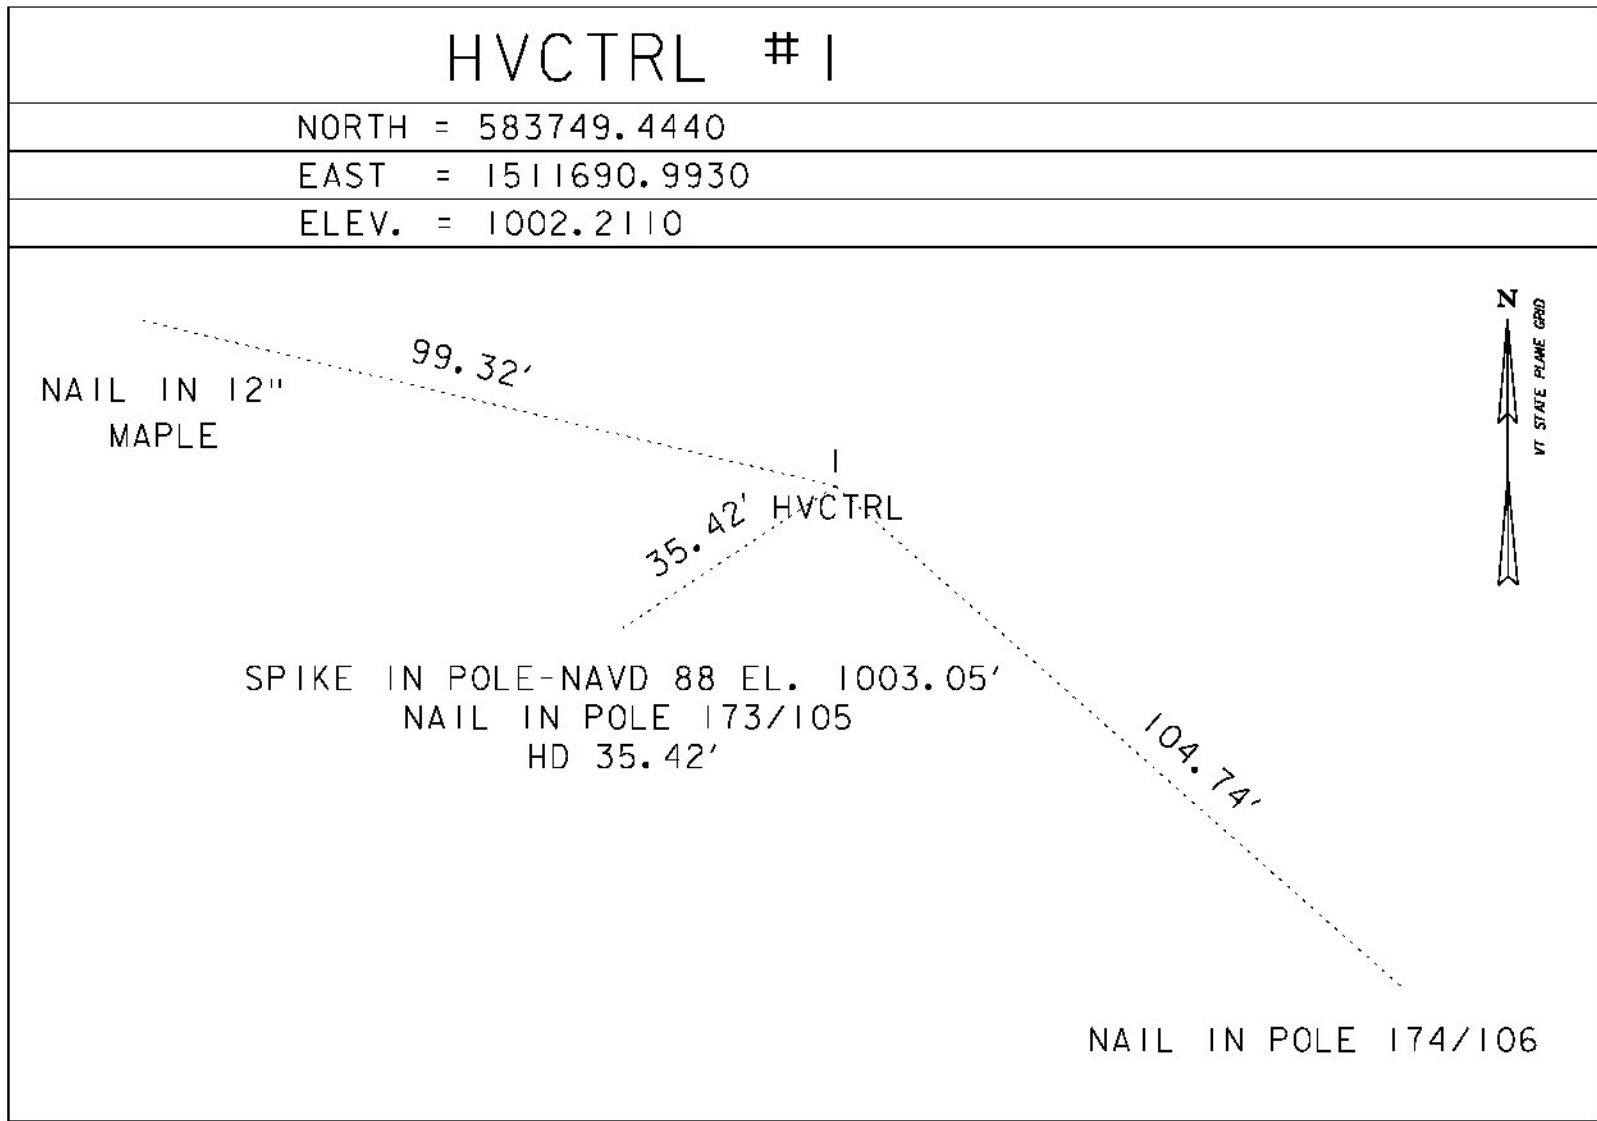
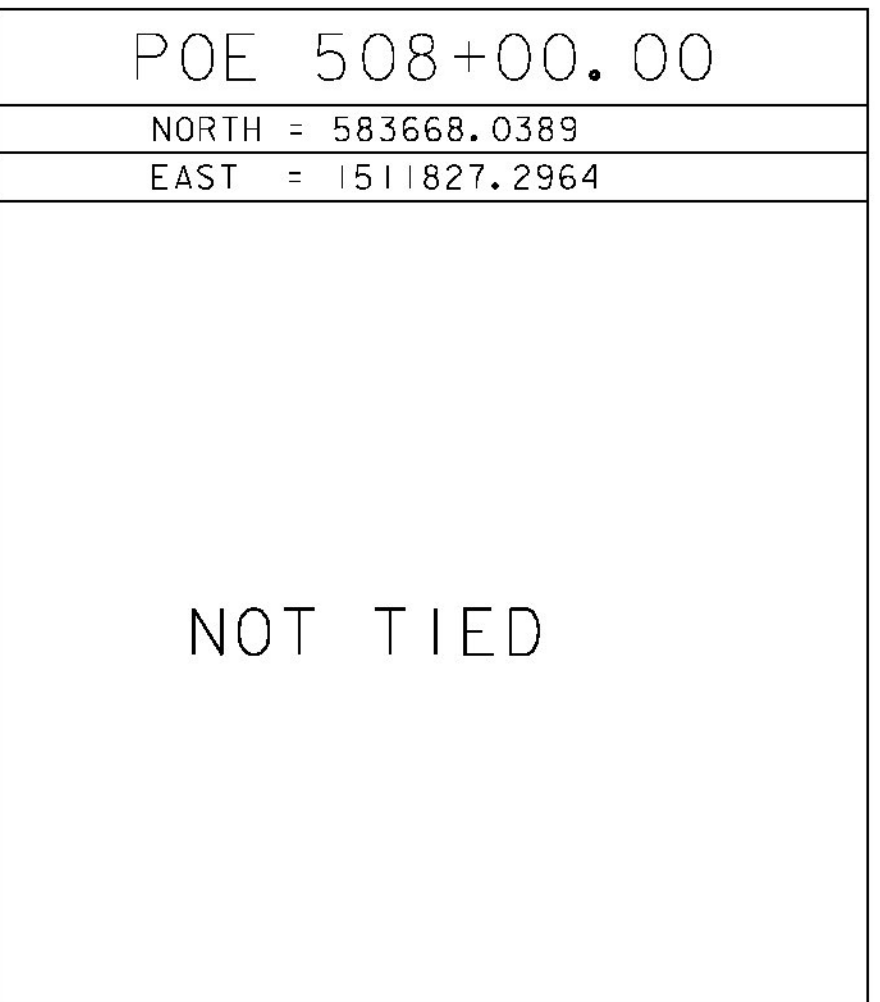
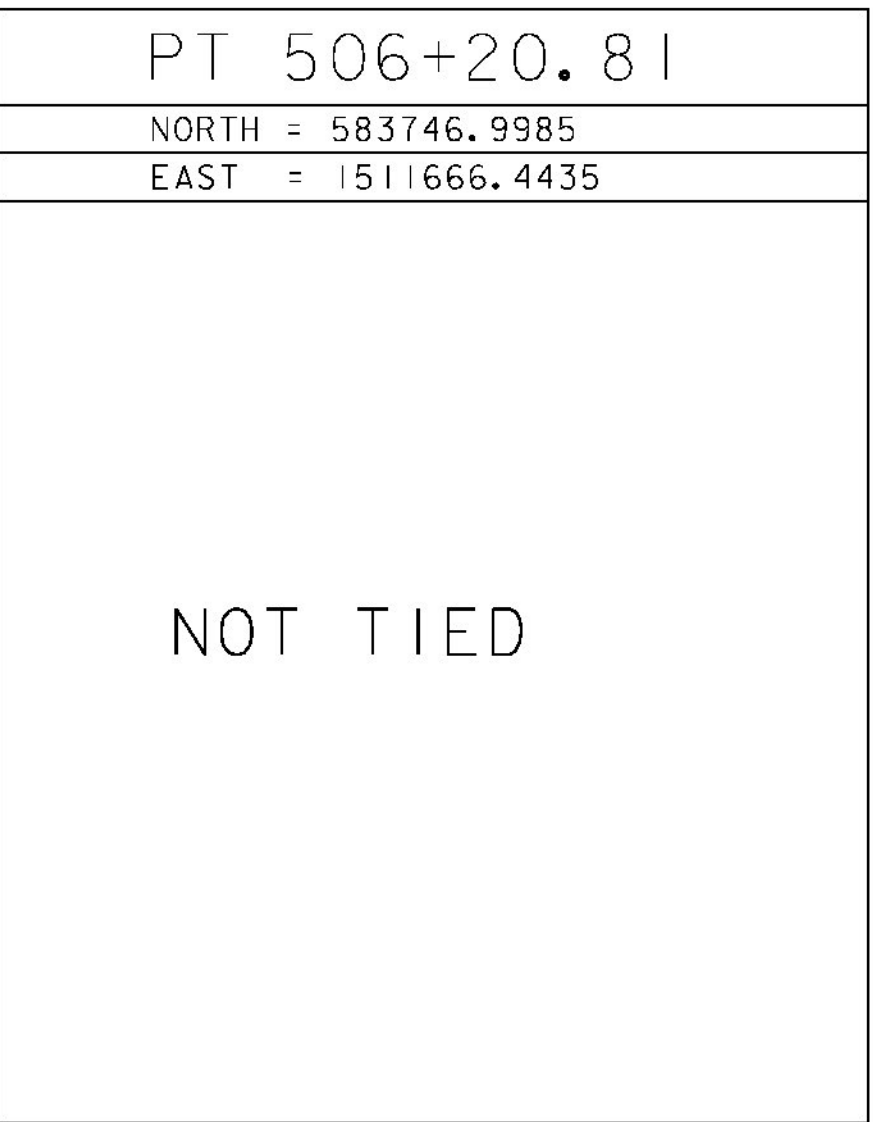
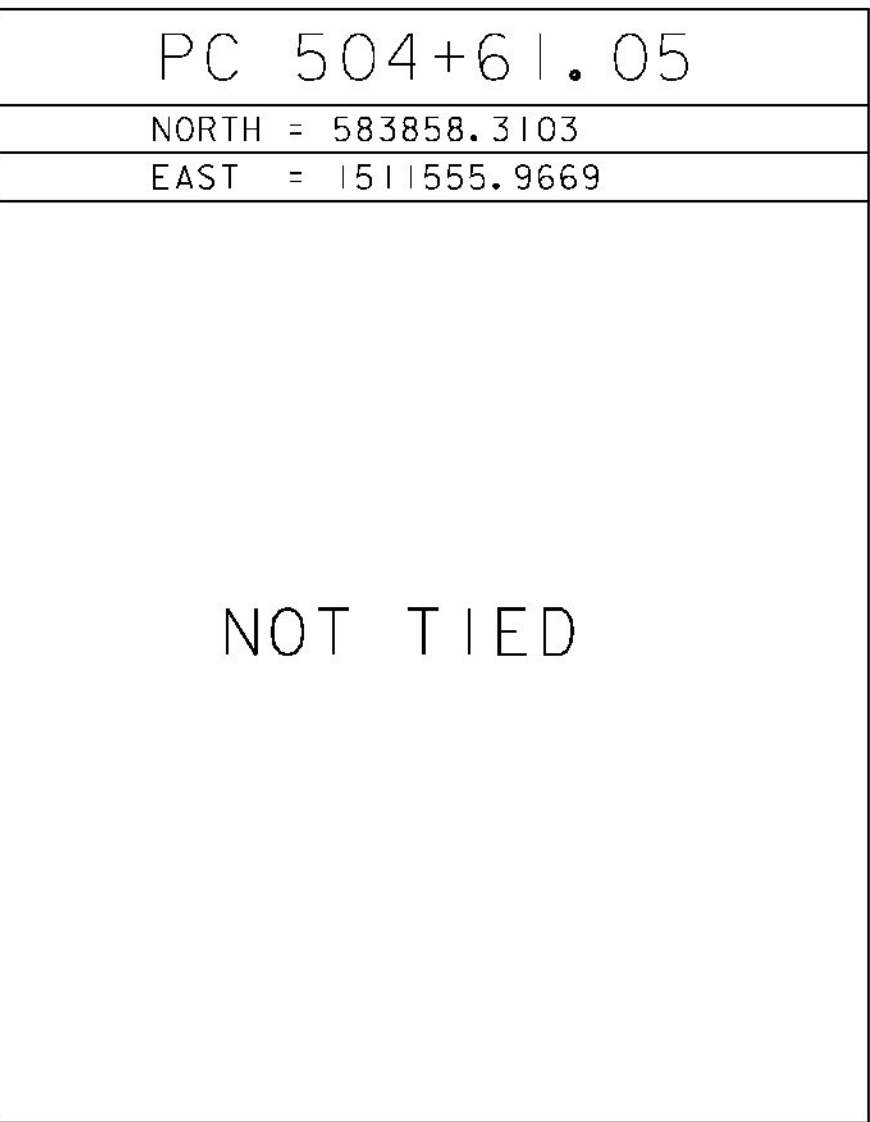
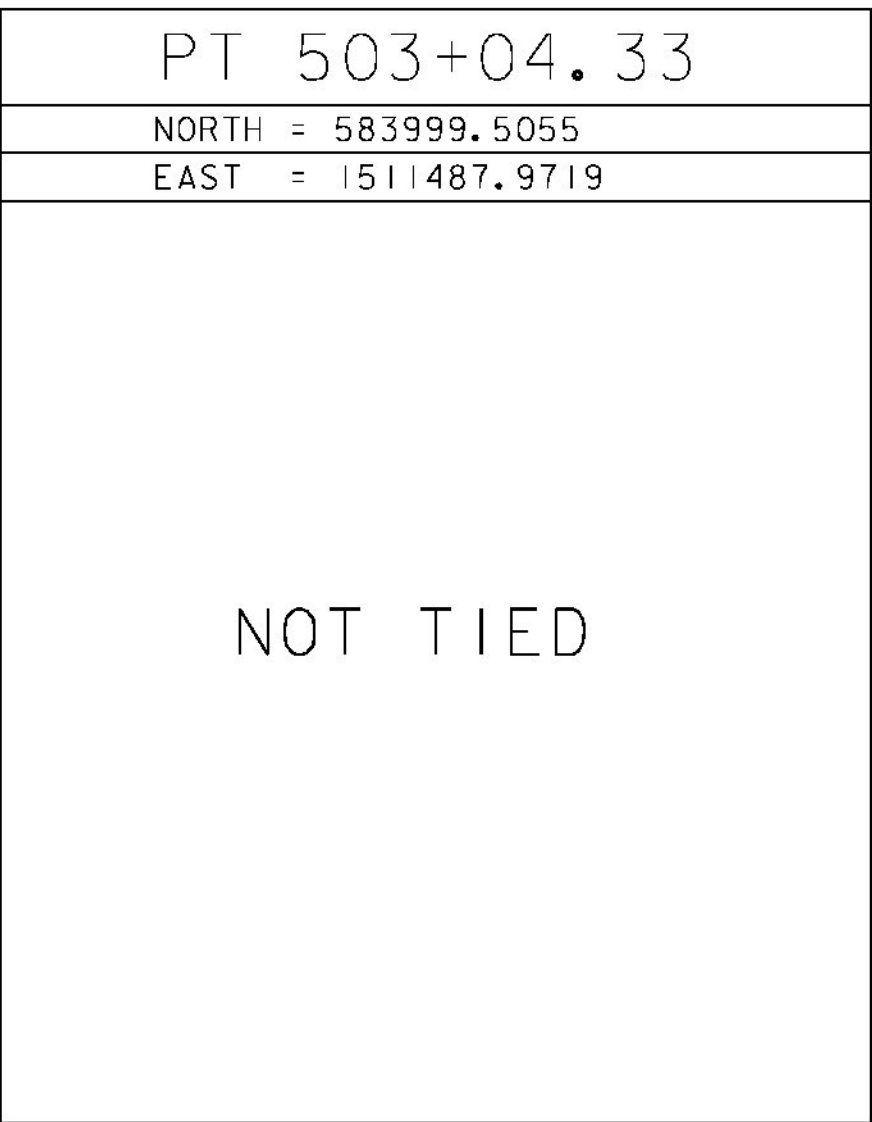


GPS CONTROL POINTS

TRAVERSE TIES

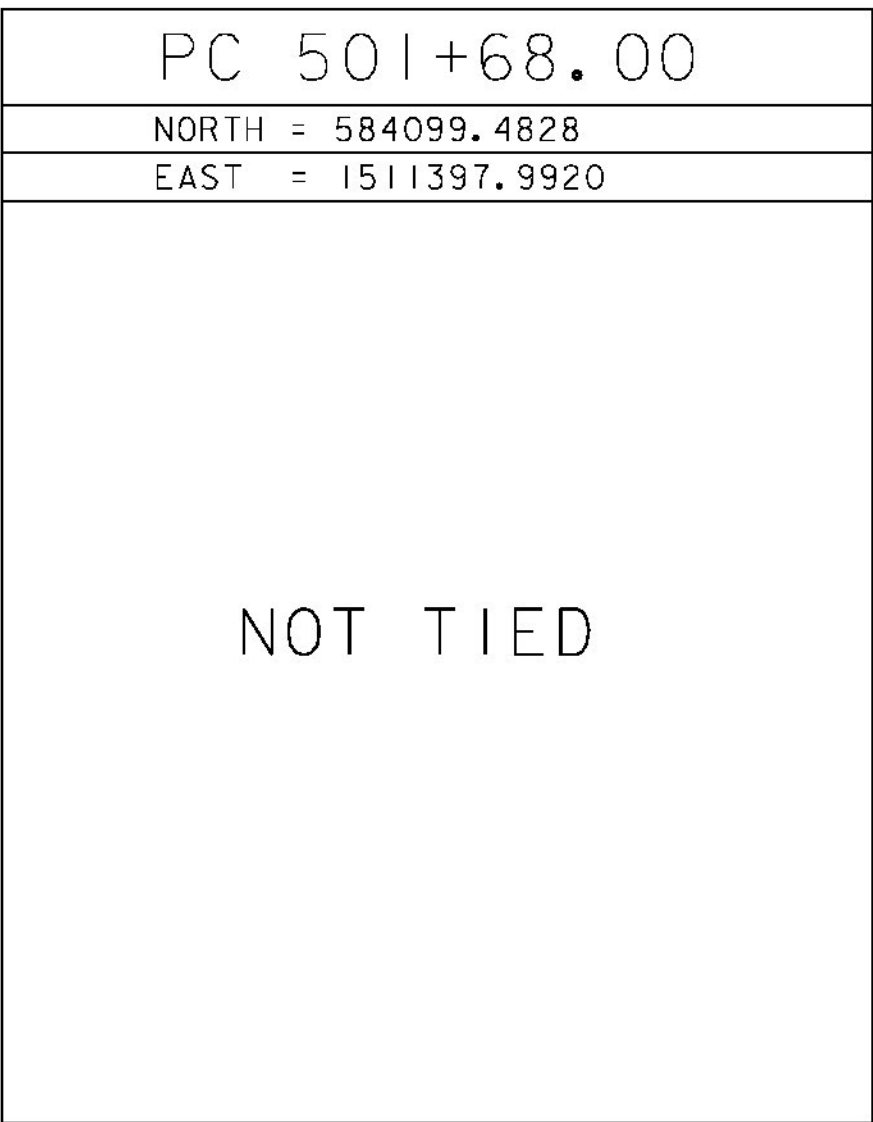

ALIGNMENT TIES

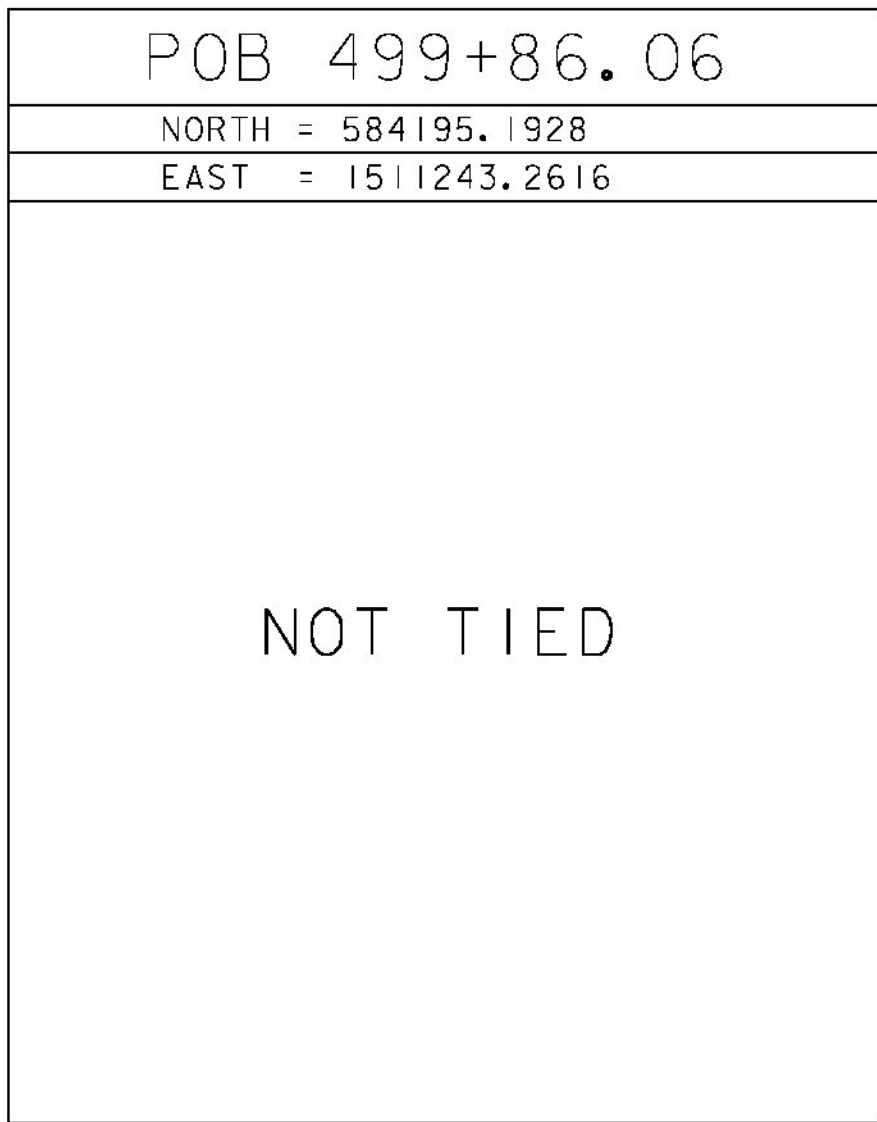

DATUM	
VERTICAL	SEE TITLE SHEET
HORIZONTAL	SEE TITLE SHEET
ADJUSTMENT	NONE

PROJECT NAME: LINCOLN
PROJECT NUMBER: BRF 0188 (8)



FILE NAME: z10j066+1.dgn	PLOT DATE: 8-DEC-2014
PROJECT LEADER: G.K. DONINGTON	DRAWN BY: C CARNEY
DESIGNED BY: C CARNEY	CHECKED BY: R BENJAMIN
SURVEY TIE SHEET	SHEET 9 OF 62