

File 5.1.2

Contractor:	J.A. McDonald
Job Name:	Lincoln BRF 0188 (8)
Location:	Lincoln, Vt.
Job #	167-15
Date:	6/19/2015



CAMP Precast Concrete Products, Inc.
78 Precast Road, Milton, VT 05468
Phone (802) 893-2401 Fax (802) 893-

Product I.D. DI 506 + 14 **Diameter:** 60"
Invert: No Ladders: No Coating: No Access Size: 24" x 48"
Cast Iron / Hatch: Neenah R-3587-4

Rim:	1001.26	Cone:		Riser#1:		Riser#4:	
Inv. Out:	996.58	Cover:	13" (special)	Riser#2:		Riser#5:	
Diff:	4.68	Base:	3'	Riser#3:		Riser#6:	
Sump:	0.50						
Gross V.F.:	5.18	Angle	0				
C.I. Height:	0.67	Boot:	8029				
Net V.F.:	4.51	Dist. Up:	18" to ctr				
Brick Space:	0.43	Pipe Type:	HDPE				
Actual V.F.	4.08	Pipe Size:	24"				


Quality Control	Prepour	Form Cleaning:		Form Release:	
		Rein. Steel:	Std. Spec.	Form Closure:	
		Block Out:		Rein. Size:	
		Comments:		Q.C. by/date:	
Postpour	Finish:		Bricking:		
	Invert:		Ladders:		
	Coating:		Boots:		
	Comments:		Q.C. by/date:		

Special Info. / Comments: ****VT AOT Specs including 8" thick base****

Mold #:		YDS ³		Wt.	
---------	--	------------------	--	-----	--

BASE

SUBMITTAL REVIEW	
Review is only for general conformity to the contract drawings and specifications and shall not relieve the contractor of his entire responsibility under the contract, including among other things, dimensions to be confirmed and correlated at the job site, and information that pertains to the fabrication processes or to techniques of construction.	
☒	NO EXCEPTIONS TAKEN
☐	MAKE CORRECTIONS NOTED
☐	RESUBMITTAL NOT REQUIRED
☐	AMEND AND RESUBMIT
☐	REJECTED - SEE REMARKS
PB AMERICAS, INC.	
By:	JMR
Date:	6/23/15

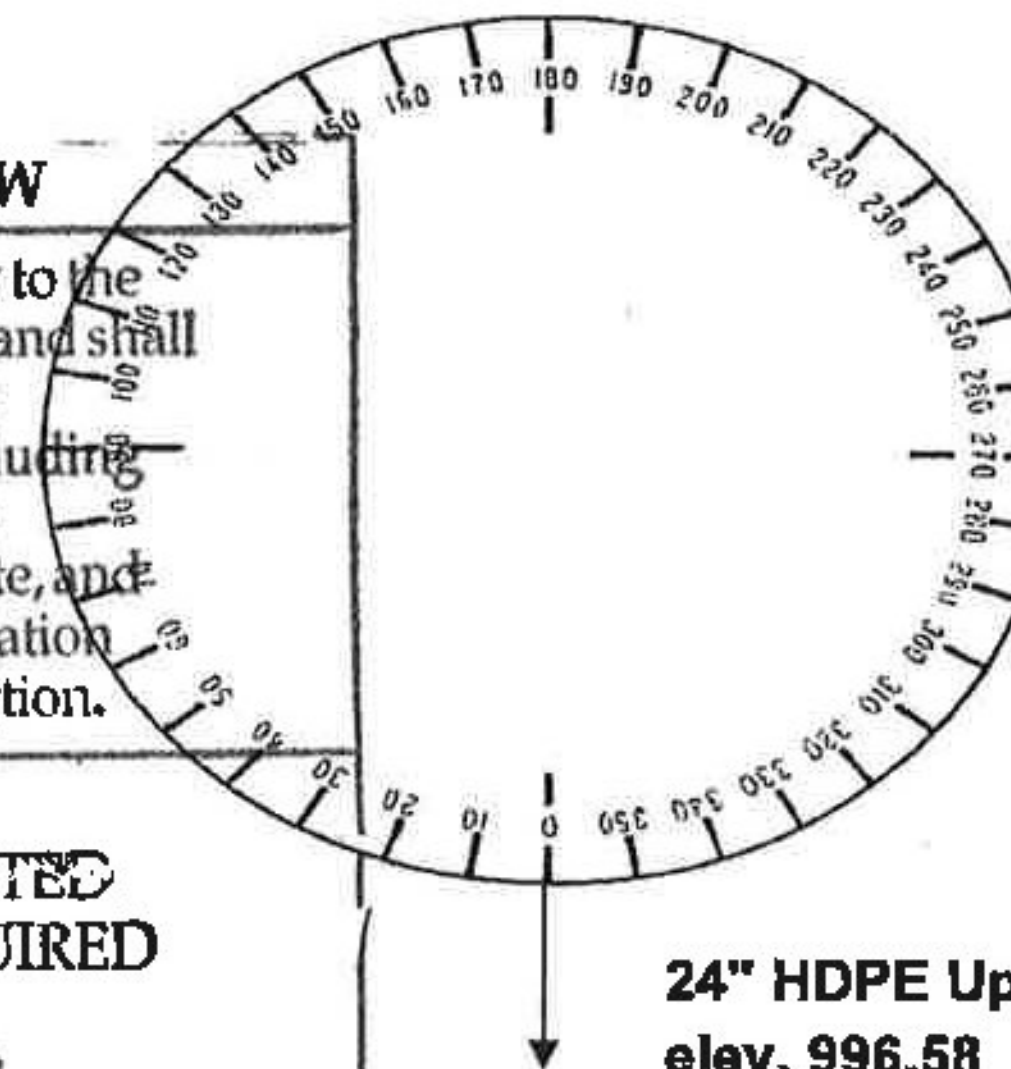

Vermont Agency of Transportation

RECEIVED

ON: June 23, 2015

and Checked for

CONFORMANCE

BY: Todd A. Sumner DATE: 06/24/2015